

Our Ref: 19465

30 April 2021

Kambala School c/o Carmichael Tompkins Property Group Level 14, Aurora Place, 88 Phillip Street Sydney, NSW, 2000

Attention: Mr Sufian Supa'at

Dear Sufian,

RE: KAMBALA SCHOOL SPORTS PRECINCT
TRAFFIC RESPONSE TO SUBMISSIONS #2

Background

A SSDA was submitted for the proposed Kambala School Sports Precinct development. A number of submissions have been received from Authorities. The Transport Planning Partnership (TTPP) has responded to each of the traffic and parking related comments in a letter dated 23 February 2021.

Following this response, Woollahra Municipal Council (Council) has issued an additional Request for Information (RFI) to address outstanding queries. The traffic related queries are as follows.

- 'Kambala School Sports Precinct Traffic Response to Submissions' indicates that "new motorcycle spaces can be provided at the existing vehicle garage at Fernbank cottage". The location of these proposed motorcycle spaces are to be shown in an updated Architectural package.
- The location of the proposed shuttle bus drop off and pick up areas along Bayview
 Hill Road should be clearly identified on the set of Architectural plans that have
 been provided.

The architectural plans have been revised in response to the above comments are provided in **Attachment One**. In addition, TTPP has responded to the above comments in the following.



Motorcycle Parking Spaces

The DCP requires one motorcycle spaces per ten car space. There are no increases to car parking as part of the proposed development. The motorcycle parking requirement is considered to be zero.

However, following advice from Council, five motorcycle parking spaces has been provided along the existing driveway at Fernbank Cottage at 1 Bayview Hill Road. It is understood that this driveway will not be used for car access in the future.

The motorcycle spaces are 1.2m wide and 2.5m long, which accords with the requirements of AS2890.1. Manoeuvring area around each space has been ensured with a 2m wide driveway and 2.5m wide aisle width between spaces.

Shuttle Bus Service

Kambala currently own two shuttle buses that seat 15 persons and are parked within the Fernbank Boarding site at 3 Bayview Hill Road.

Kambala is to provide two shuttle bus services for staff, one in the morning and one in the afternoon. If required, Kambala has capacity to increase the number of services noting that there are multiple buses. The provision of services would be based on demand.

As part of the proposed development, it is proposed to use these buses to transport staff between Kambala and Edgecliff Railway Station. Staff would be collected and dropped off from the existing loading dock at the ground floor car park off Tivoli Avenue.

The loading dock accommodates two 8.8m long bays, which is of sufficient length to accommodate Kambala's shuttle bus, which is 6.2m long, and ensure sufficient room for loading and off-loading of staff.

We trust the above is to your satisfaction. Should you have any queries regarding the above or require further information, please do not hesitate to contact the undersigned on 8437 7800.

Yours sincerely,


Ken Hollyoak Director

Encl. Attachment One - Architectural Plans




Attachment One

Architectural Plans

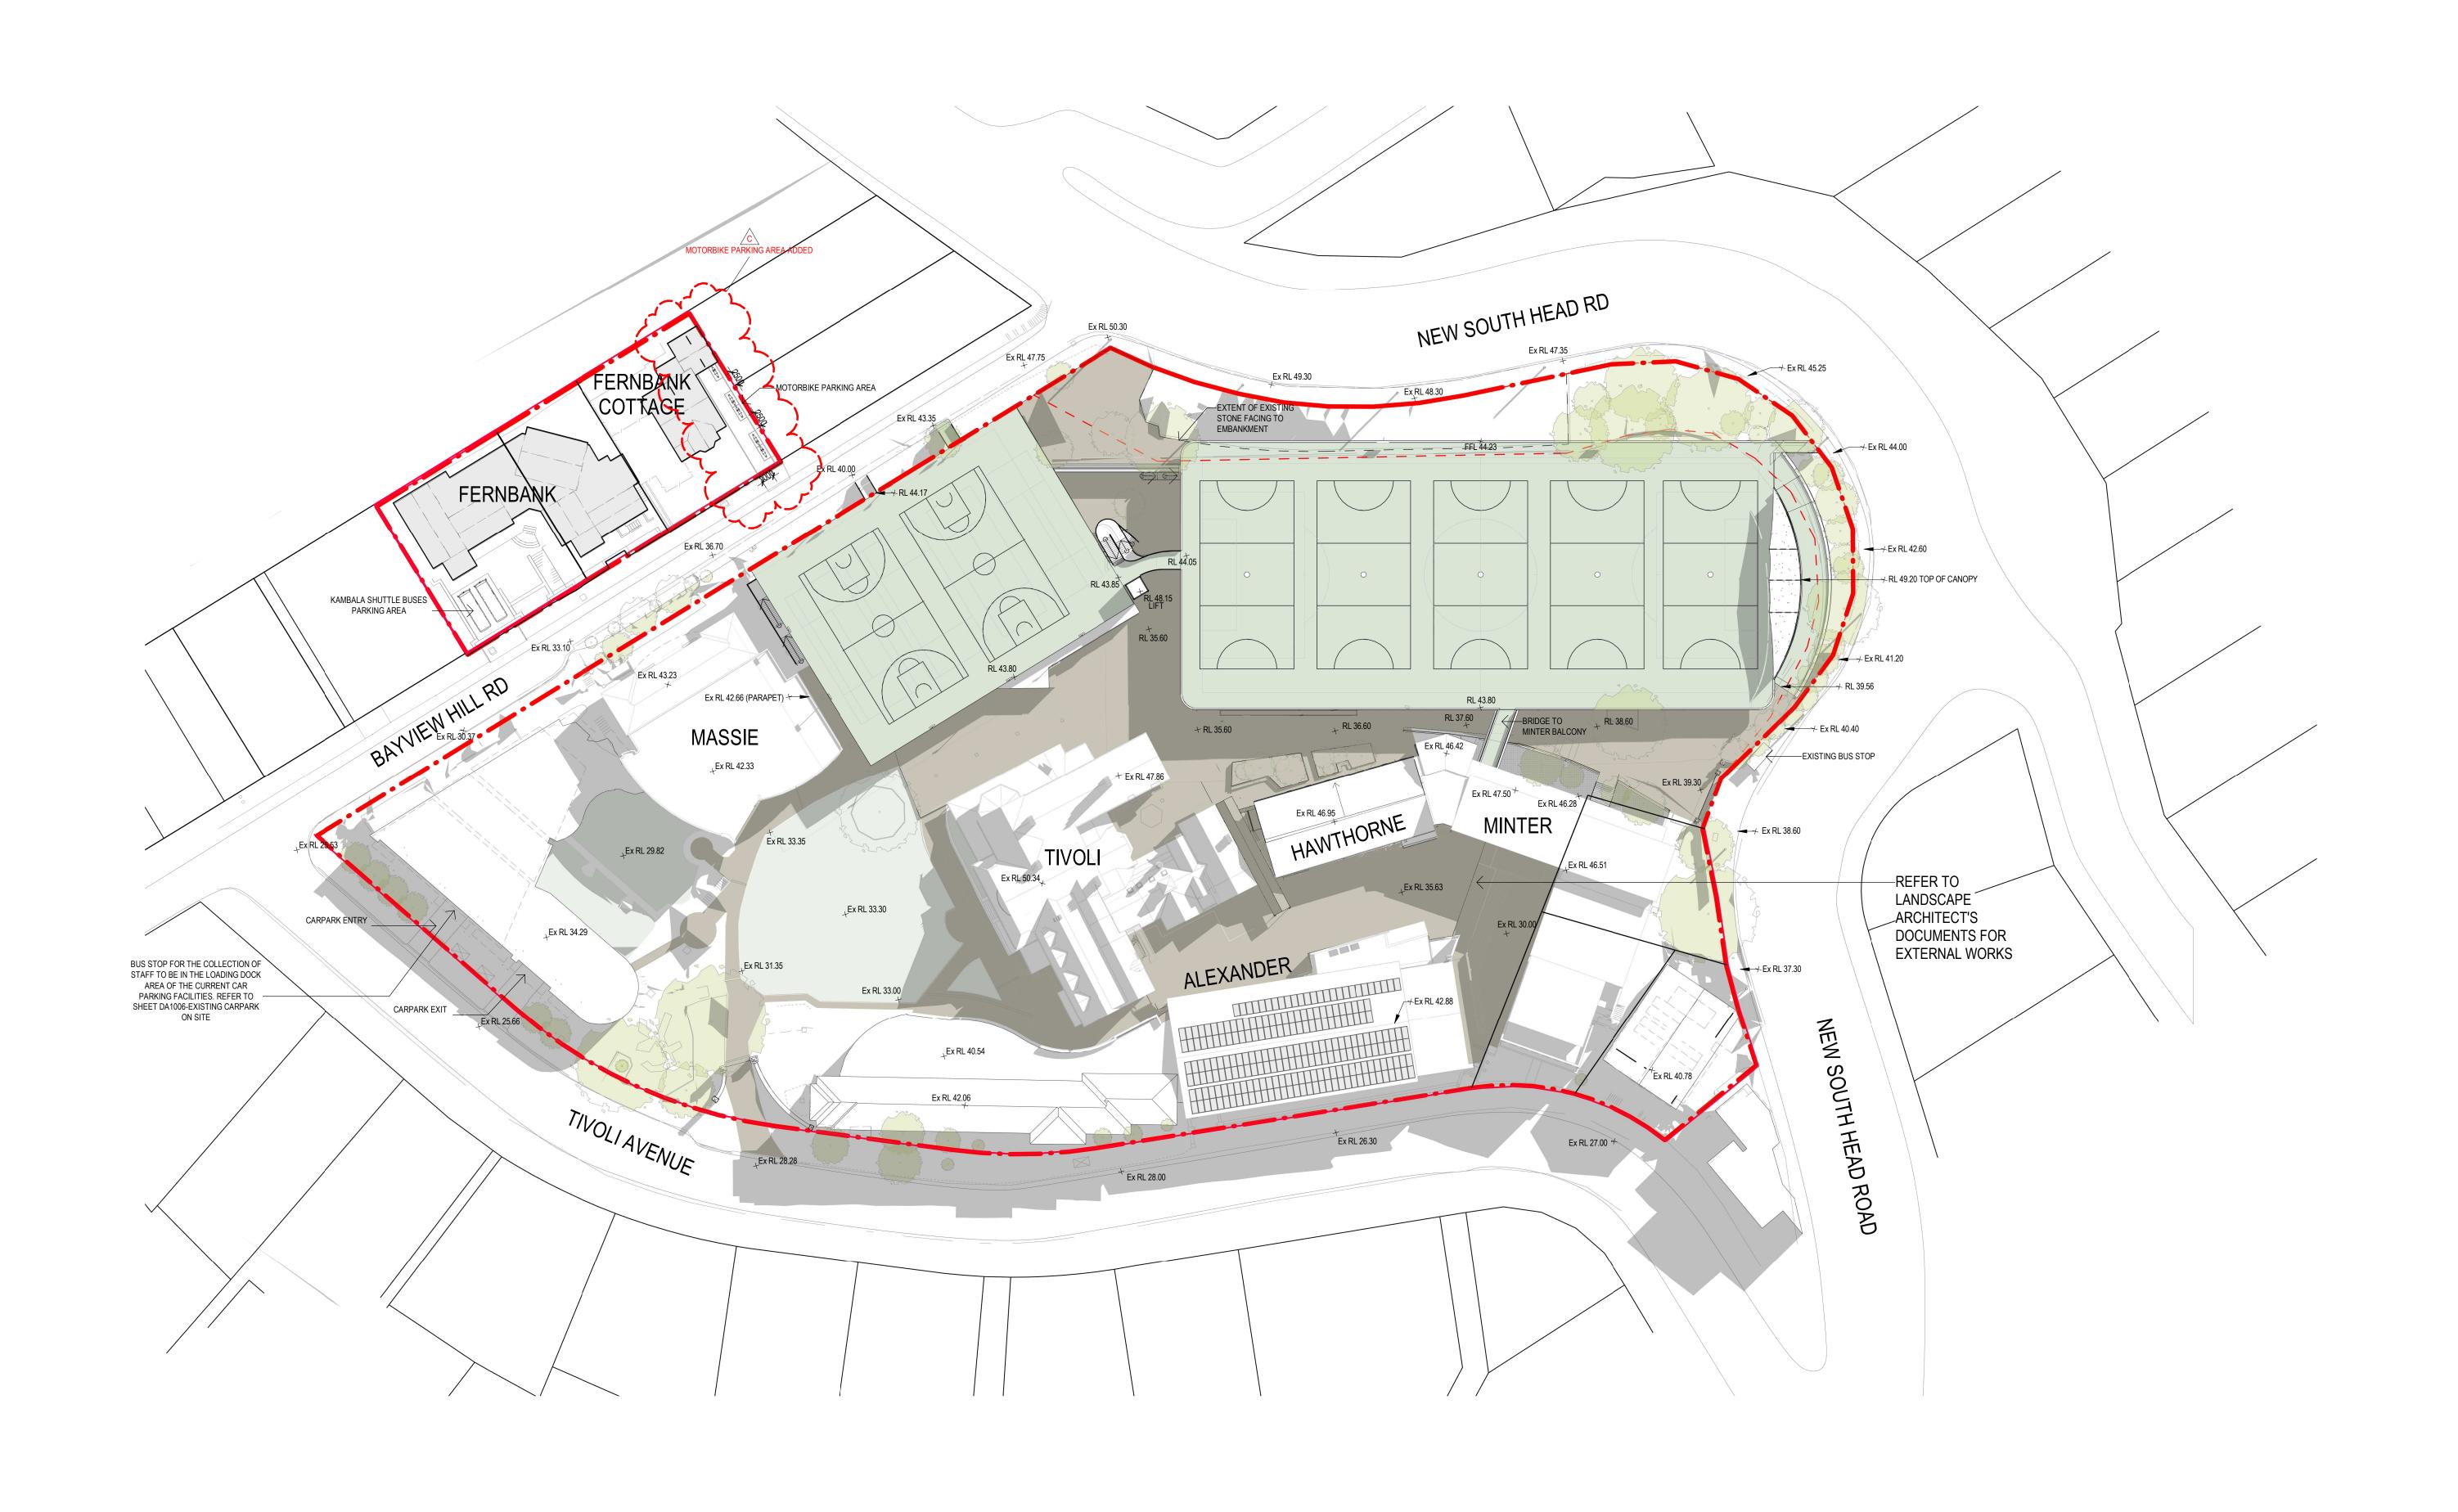


Ver App'd



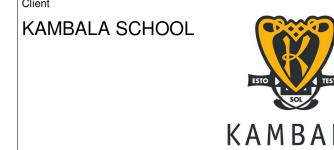



	Drawing Title	Scale	Drawing No.	Issue
BALA SPORT, WELL-BEING AND OR LEARNING PRECINCT	PROPOSED CAMPUS PLAN	1 : 500 @B1	DA1005	С
EW SOUTH HEAD ROAD BAY NSW 2029				
18049	NOT FOR CONSTRUCTION	0 5 10	20	40 m
	1			

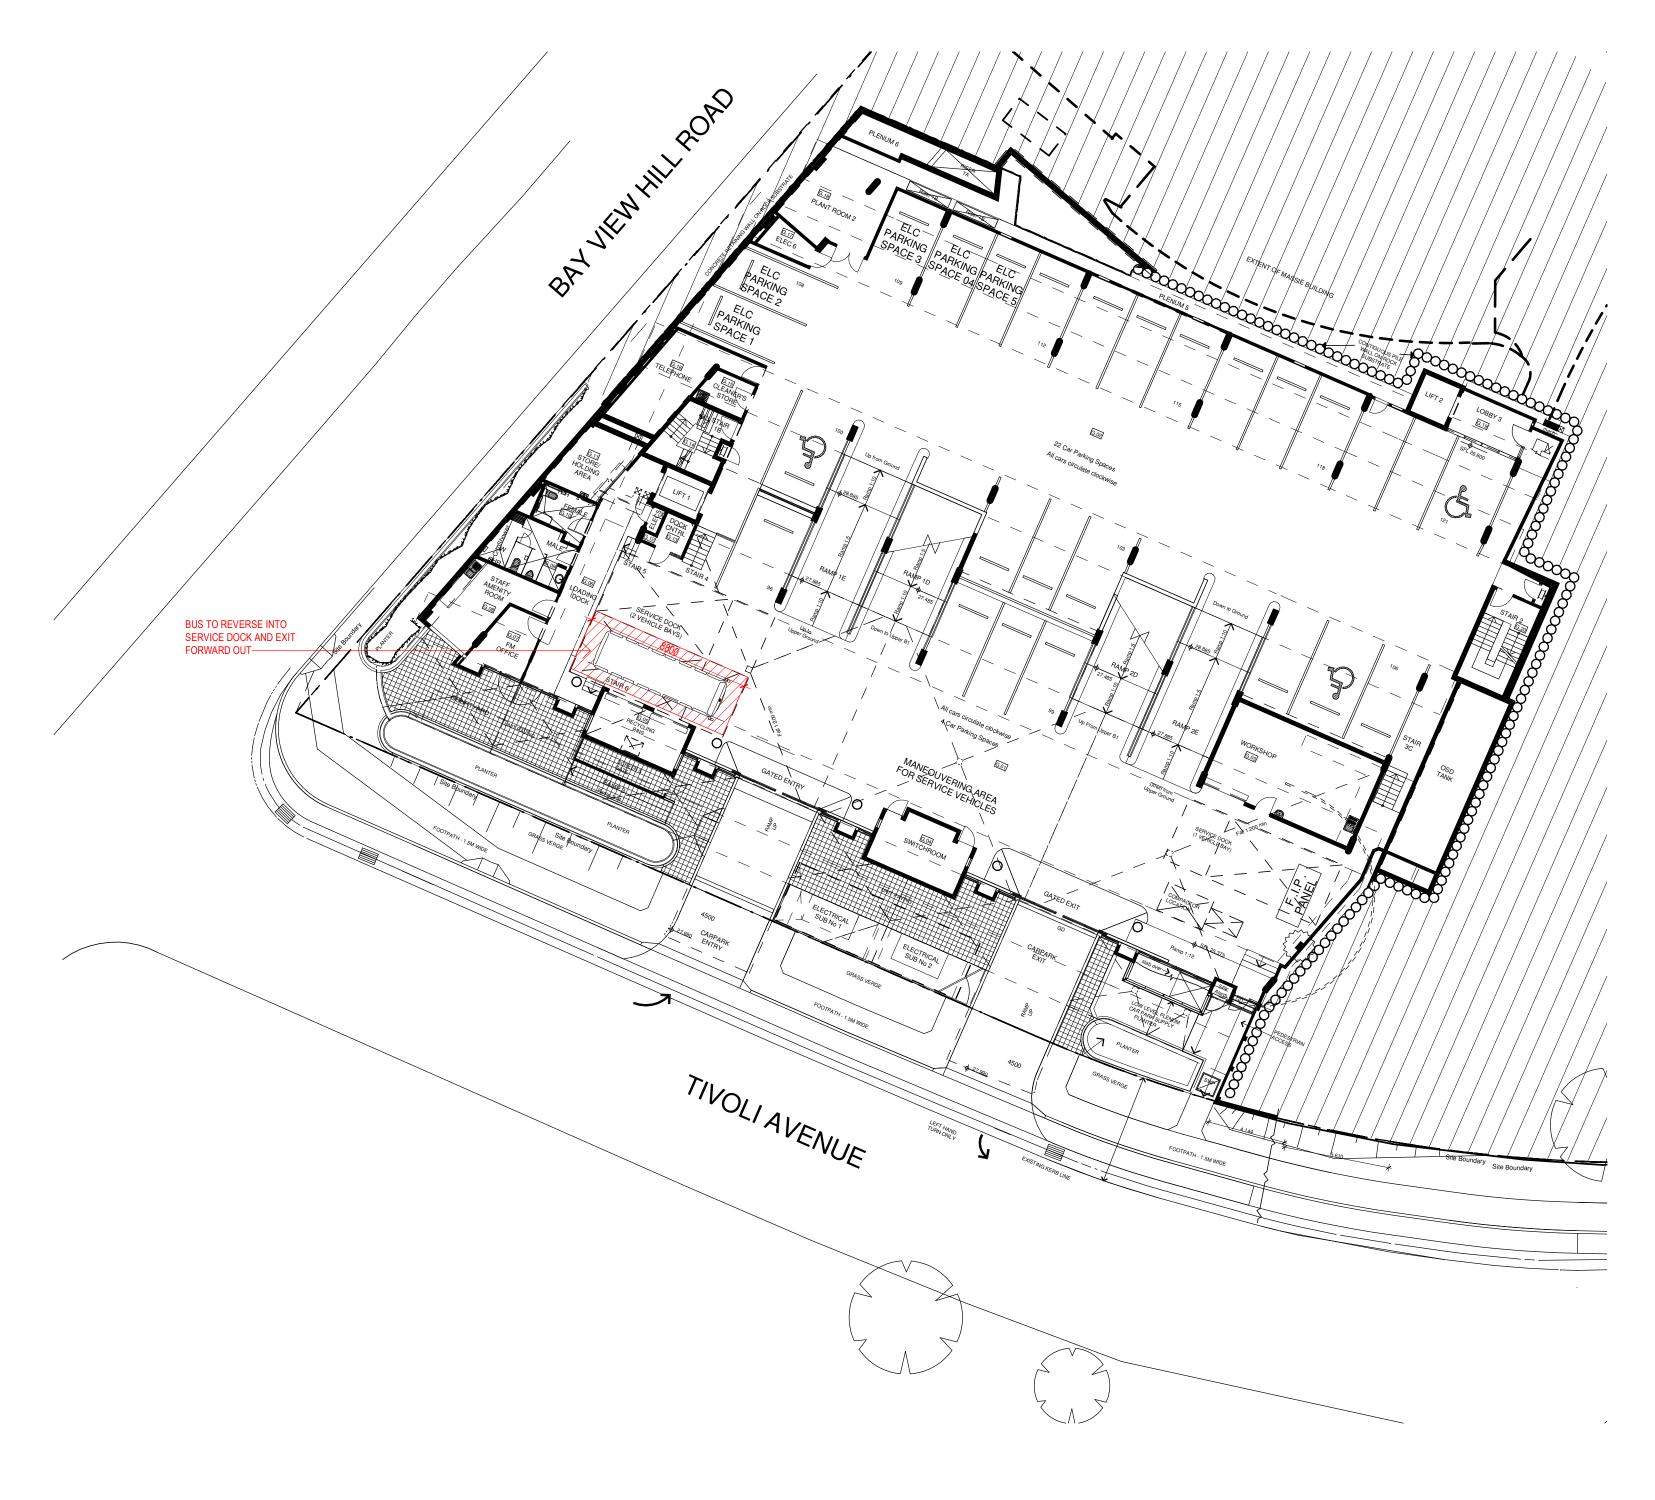

HAMPSHIRE BASEMENT 1- EXISTING CARPARK
(KAMBALA RECORD DRAWING) 1:200

Revisions
No. Date Description
A 22/04/2021 ISSUED FOR SSDA

Do not scale drawings. Use figured dimensions only. Check & verify levels and dimensions on site prior to the commencement of any work, the preparation of shop drawings or the fabrication of components. This drawing is the copyright Act 1968. Do not alter, reproduce or transmitt in any form, or by any means without the express permission of Allen Jack + Cottier Architects. Nominated Architects: Michael Heenan 5264, Peter Ireland 6661

Ver App'd MD MJ

N

KAMBALA SCHOOL



A J + C
ALLEN JACK+COTTIER

79 Myrtle Street Chippendale NSW 2008 AUSTRALIA
ph +61 2 9311 8222 fx +61 2 9311 8200
ABN 53 003 782 250

Project

KAMBALA SPORT, WELL-BEING AND SENIOR LEARNING PRECINCT

794 NEW SOUTH HEAD ROAD ROSE BAY NSW 2029

Project Status

Proj. No. 18049

Drawing Title
EXISTING CARPARK

Project Status
NOT FOR CONSTRUCTION

Drawing No.

1: 200 @B1 DA1006

A

16 n