

ME-MEMO-061_A

Enquiries:	Keith Ryan
Project No:	44311

To: Hanan Husaini

From: Lydia Angus

Date: 22/07/21

Subject: Oxygen VIE Tank Compound

Summary: This memo details the propose Oxygen VIE Compound to serve the PSB and existing CHW campus.

Oxygen VIE Tank Overview

The existing Children's Hospital at Westmead (CHW) is served from a 15,000L primary Oxygen VIE tank and a 1,200L secondary VIE tank. These are located in the Main Medical Gas Compound off Redbank Road as shown below



Figure 1 Existing Oxygen Delivery Procedure

Air Liquide have advised that a 48,000L VIE vessel should be allowed for to serve Stage 2 PSB and the existing Children's Hospital site, based on preliminary consumption calculations and current consumption from the existing hospital at 470m3/day. This sizing allows for fortnightly deliveries and ~20% constant fill level. Air Liquide propose that both the existing and future site is served from one primary vessel. Utilising the existing 15,000L is technically an option however their preference is to avoid unnecessary engineering complexity. Mis-matched vessel sizes can cause imbalanced supply from the vessels.

Due to the relatively small size of the existing backup VIE, this vessel will need upgraded to a 5,000L VIE to provide 24-hour supply to the whole CHW campus.

The new tanks to serve the development will be split between the existing lower-level platform and the upper level within the existing CHW loading dock. The primary 48,000 L Oxygen VIE tank will be located on the lower level and the emergency VIE vessel will be located in the loading dock with the vaporisers and regulators. The fill point will be located on lower level with an extended fill line to the secondary vessel.

This option is the preference of LHD, as upgrading the existing main oxygen compound avoids a remote VIE location. Refer to appended layouts for detailed Oxygen VIE tank layout dimensions. The fixing and structural details are being finalised by Arup and Air Liquide.

Design with community in mind

DOCUMENT: D:\WORK\2_STANTEC PROJECT\44311 CHWMARKUPS\MEMOS\MEMO-014\ME-MEMO-05X_A.DOCX (LA)



ME-MEMO-061_A

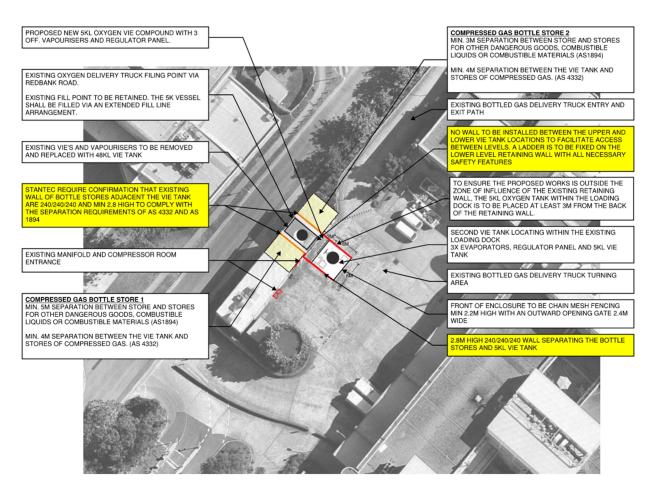


Figure 1 Proposed Bulk Oxygen Facility

Delivery Procedure

The existing oxygen fill point is located beside the 15kL primary VIE vessel and is accessed via Redbank road. As shown in figure 1, the current delivery procedure involves the 19m tanker parking on the curb and filling the oxygen storage from the rear of the tanker. This is fill locating is to be retained with an extended fill line to the tank within the loading dock.


Continuity of Supply During Installation


With these significant medical oxygen upgrades, focus is required to prevent any oxygen supply downtime to the existing CHW. The options to ensure continuous oxygen supply are dependent on the structural works required and the tank location.


The Douglas Partners Geotechnical Report 13/05/21 and Arup advice have confirmed that the upper and lower concrete pads are sufficient for the installation of the new 48,000 L and 5,000 L tanks.

Based on this, there is no concern of continuity of supply. The 5k vessel will be installed on the upper platform and commissioned to supply the hospital, before taking out the existing vessels.

Design with community in mind

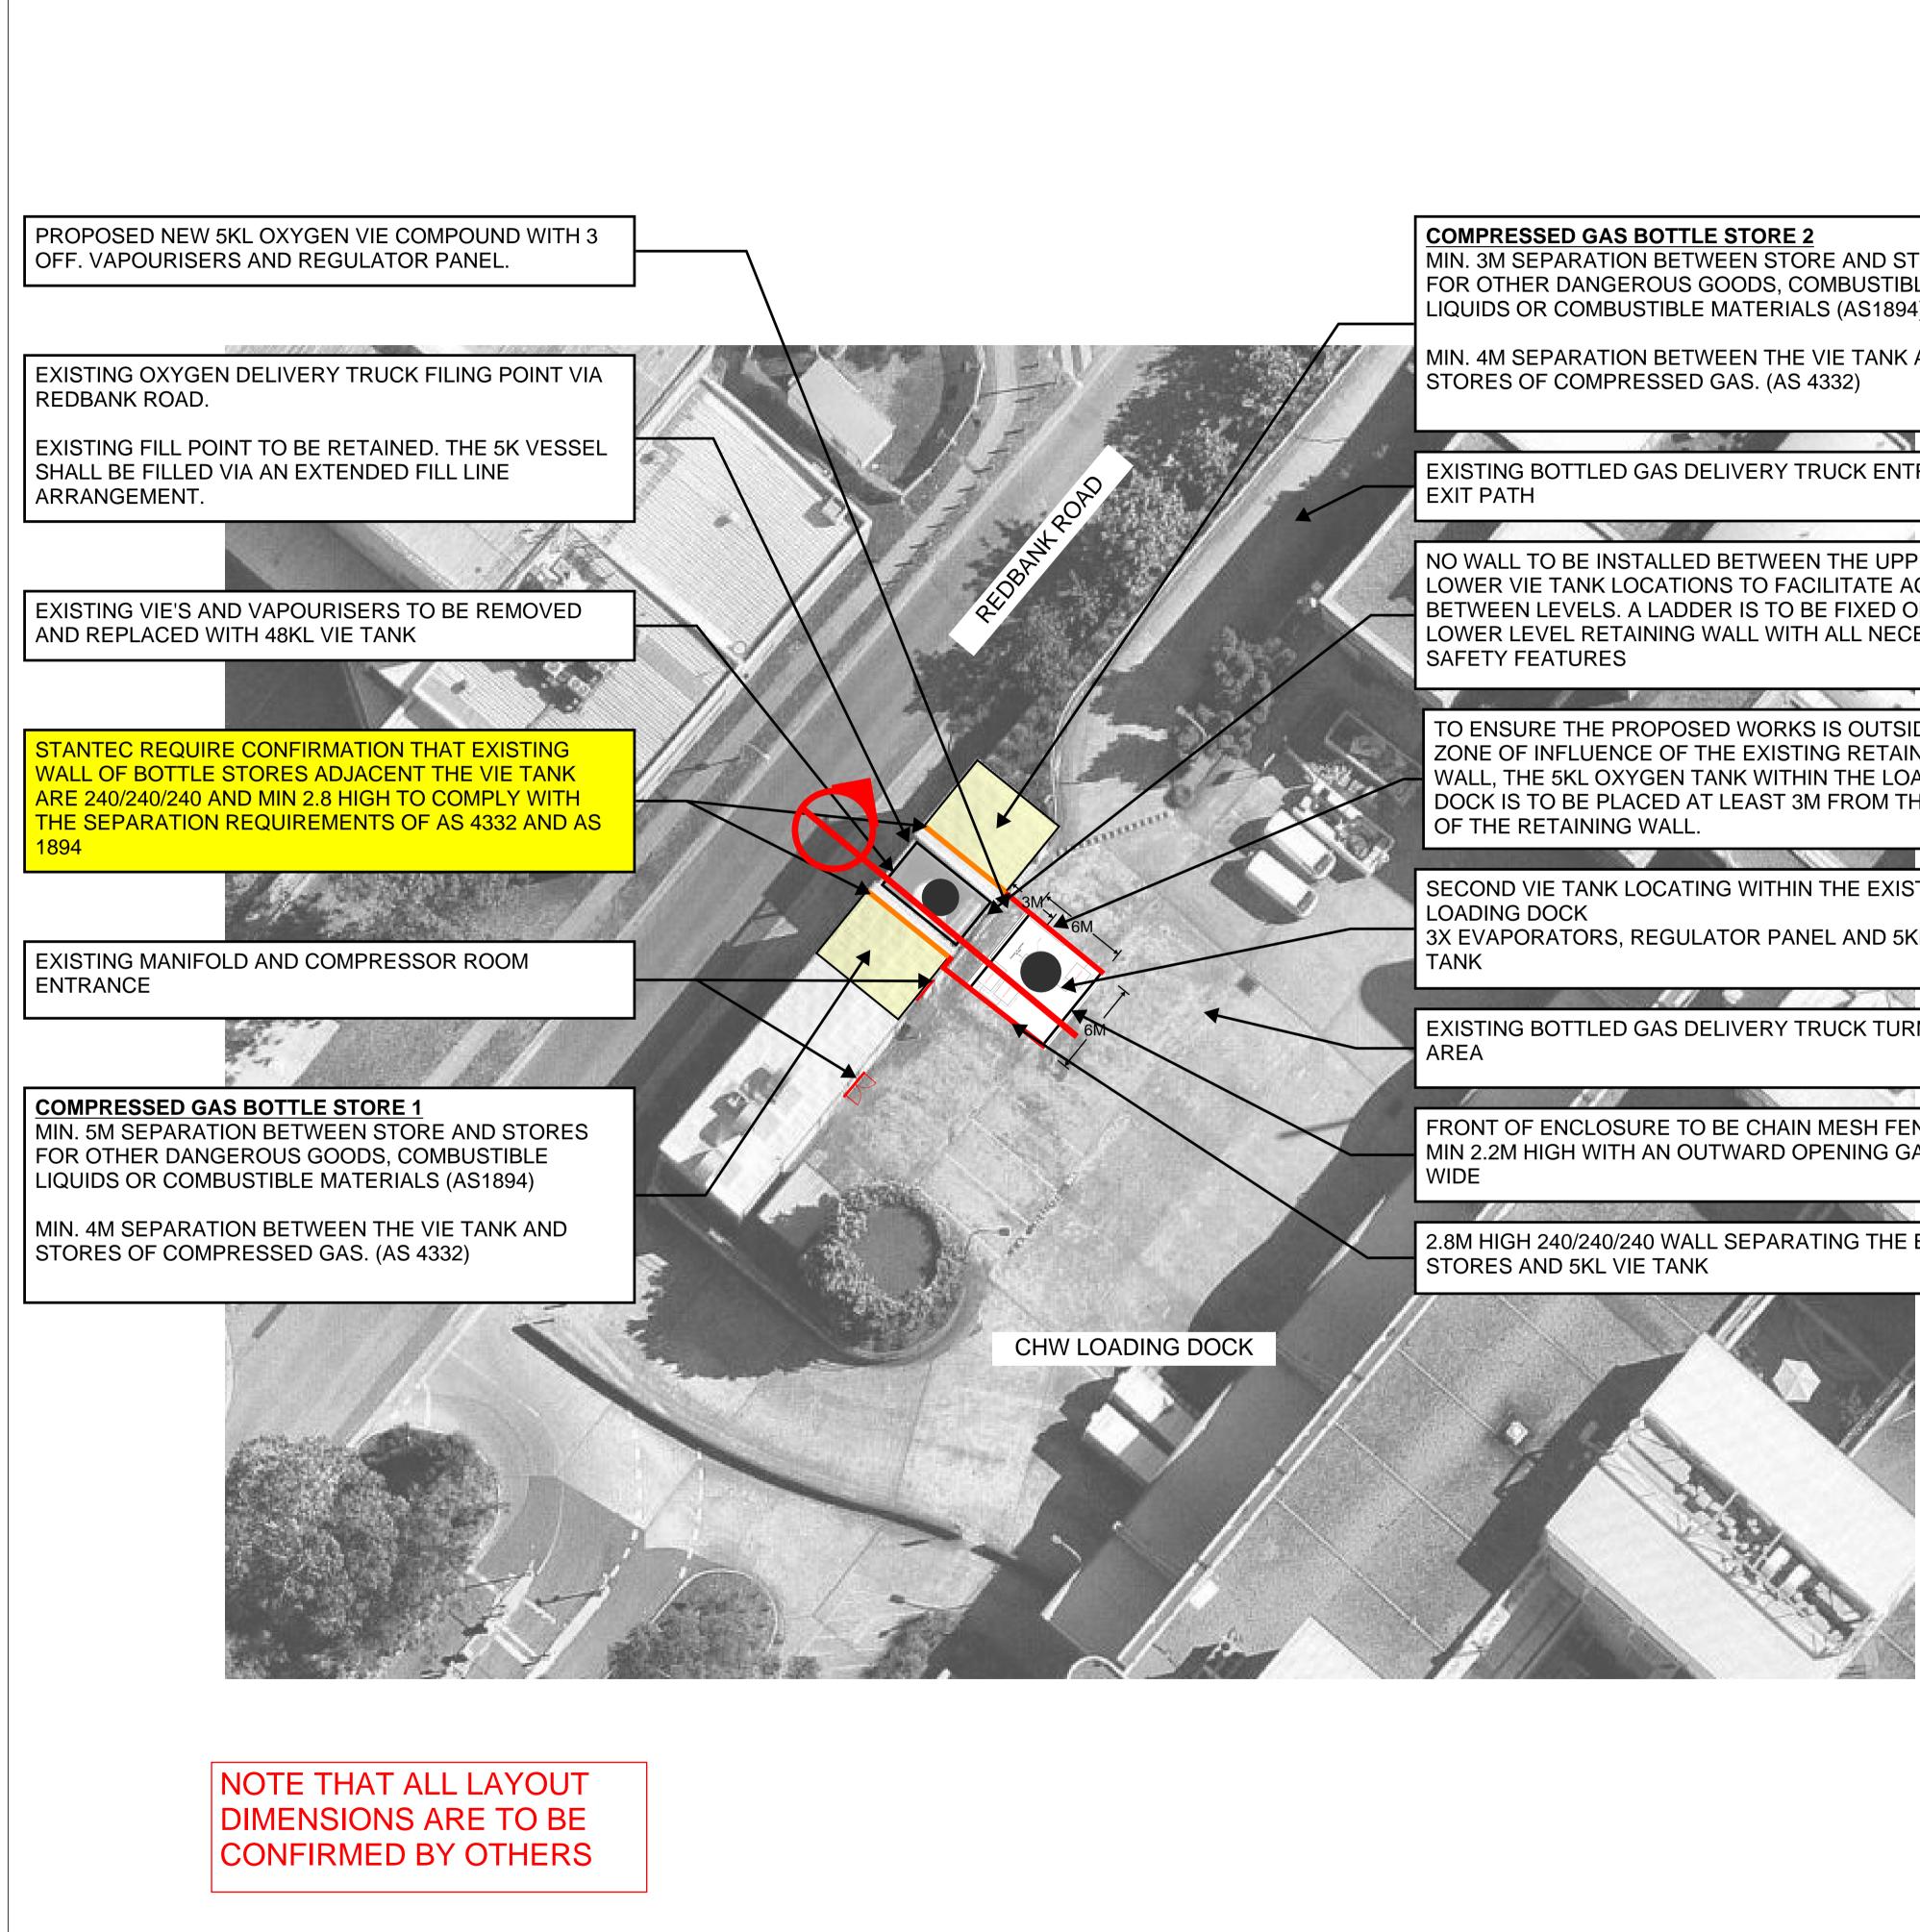

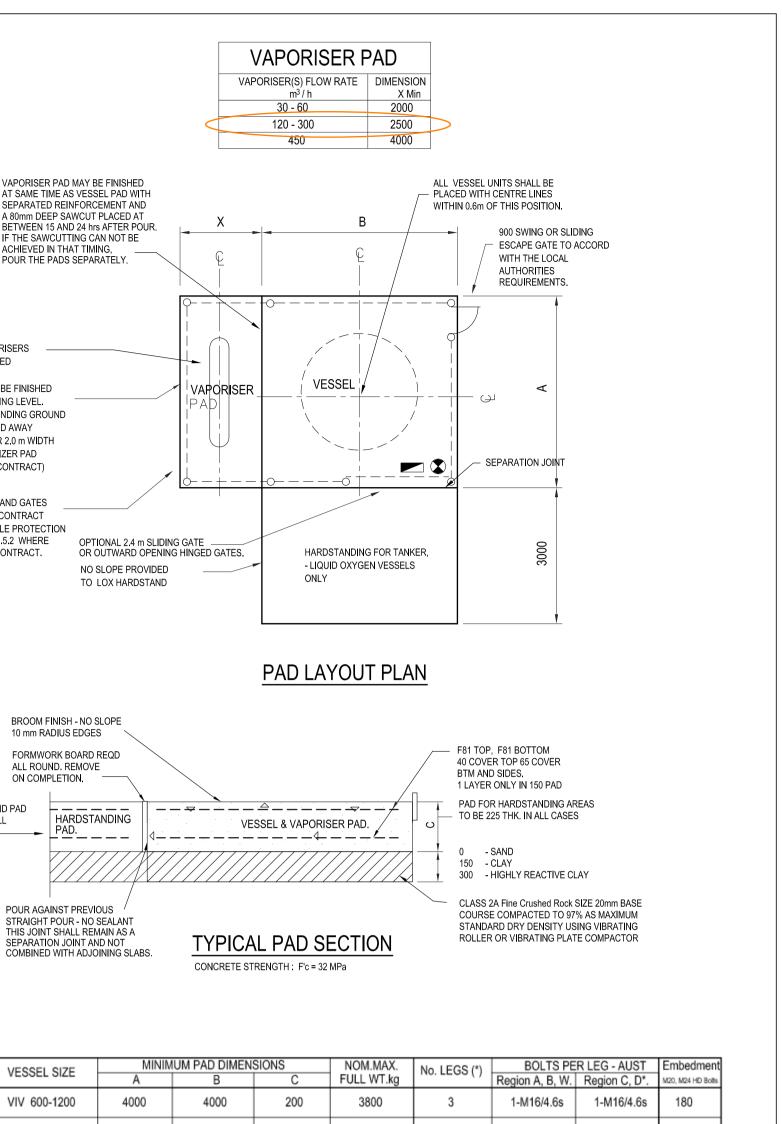

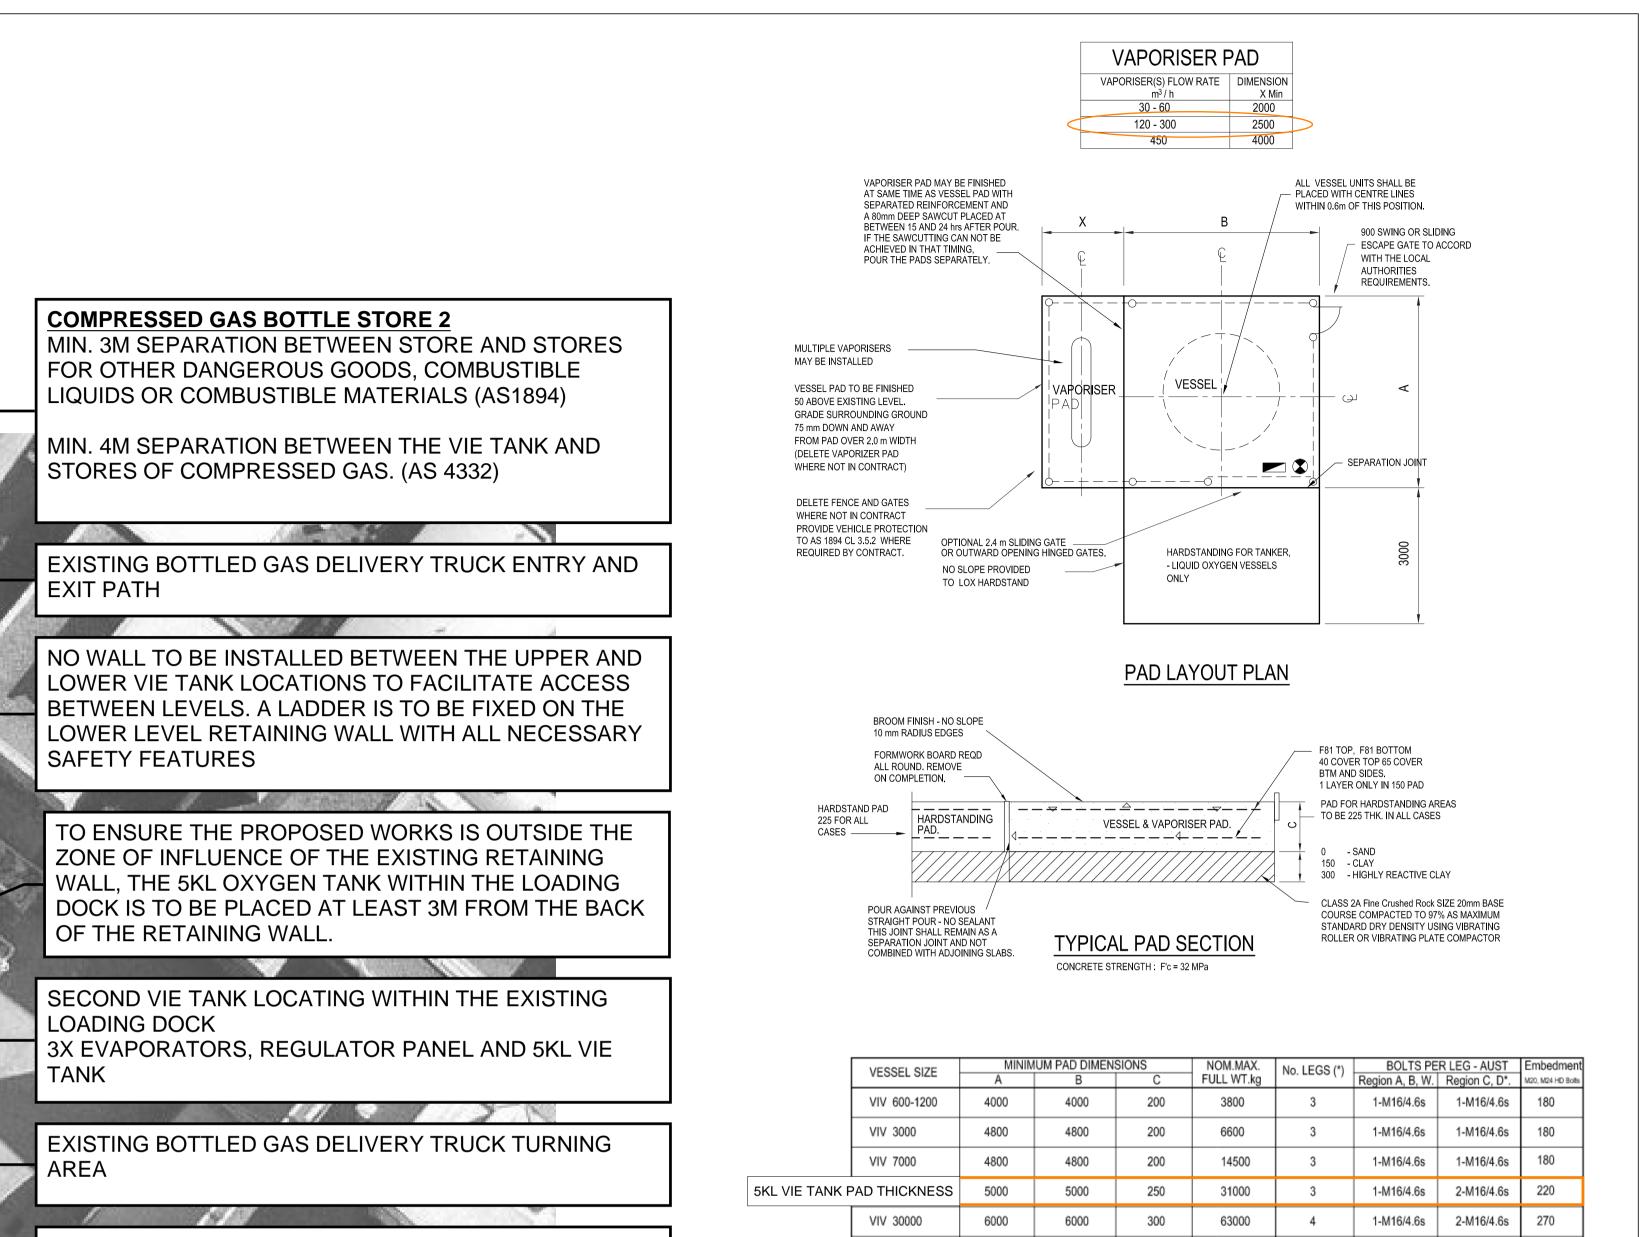

FRONT OF ENCLOSURE TO BE CHAIN MESH FENCING MIN 2.2M HIGH WITH AN OUTWARD OPENING GATE 2.4M

2.8M HIGH 240/240/240 WALL SEPARATING THE BOTTLE

VIV 4 48KL VIE TANK PAD TH

600-1200	4000	4000	200	3800	3	1-M16/4.6s	1-M16/4.6s	180
3000	4800	4800	200	6600	3	1-M16/4.6s	1-M16/4.6s	180
7000	4800	4800	200	14500	3	1-M16/4.6s	1-M16/4.6s	180
HICKNESS	5000	5000	250	31000	3	1-M16/4.6s	2-M16/4.6s	220
30000	6000	6000	300	63000	4	1-M16/4.6s	2-M16/4.6s	270
45000	6000	6000	400	87000	3 OR 4	2-M16/4.6s	2-M20/4.6s	300
HICKNESS	6000	6000	500	112000	4	2-M20/4.6s	3-M24/4.6s	300


SCALE @ A1 PROJECT No

	G	FOR INFORMATION	LA	KPR	16/07/21
	F	FOR INFORMATION	LA	KPR	18/01/21
	Е	FOR INFORMATION	LA	KPR	06/01/21
	D	FOR INFORMATION	LA	KPR	09/10/20
	С	FOR INFORMATION	LA	KPR	18/08/20
	В	FOR INFORMATION	ALH	KPR	05/08/20
	А	FOR INFORMATION	ALH	KPR	29/06/20
R	REV	DESCRIPTION	DRAWN	APP'D	DATE

CONSULTANT		P	ARCHITECT/CLIENT		
	Stante	eC			
PROJECT					
CHW STAGE 2 - PSB					
MEDIC	al gas co	OMPOUND - OPTIC	DN 2.1		
		PRELIMINAR NOT FOR CONSTRUCTION MECHANICAL			
NTS	44311	MG-SK-001	G		

DRAWING No

THIS DRAWING HAS BEEN DOCUMENTED IN COLOUR THIS DRAWING IS REQUIRED TO BE PRINTED IN COLOUR FAILURE TO DO SO MAY RESULT IN LOSS OF INFORMATION BLACK & WHITE PRINTING MAY BE USED IF SPECIFIC BLACK & WHITE DOCUMENTS HAVE BEEN OBTAINED FROM STANTEC

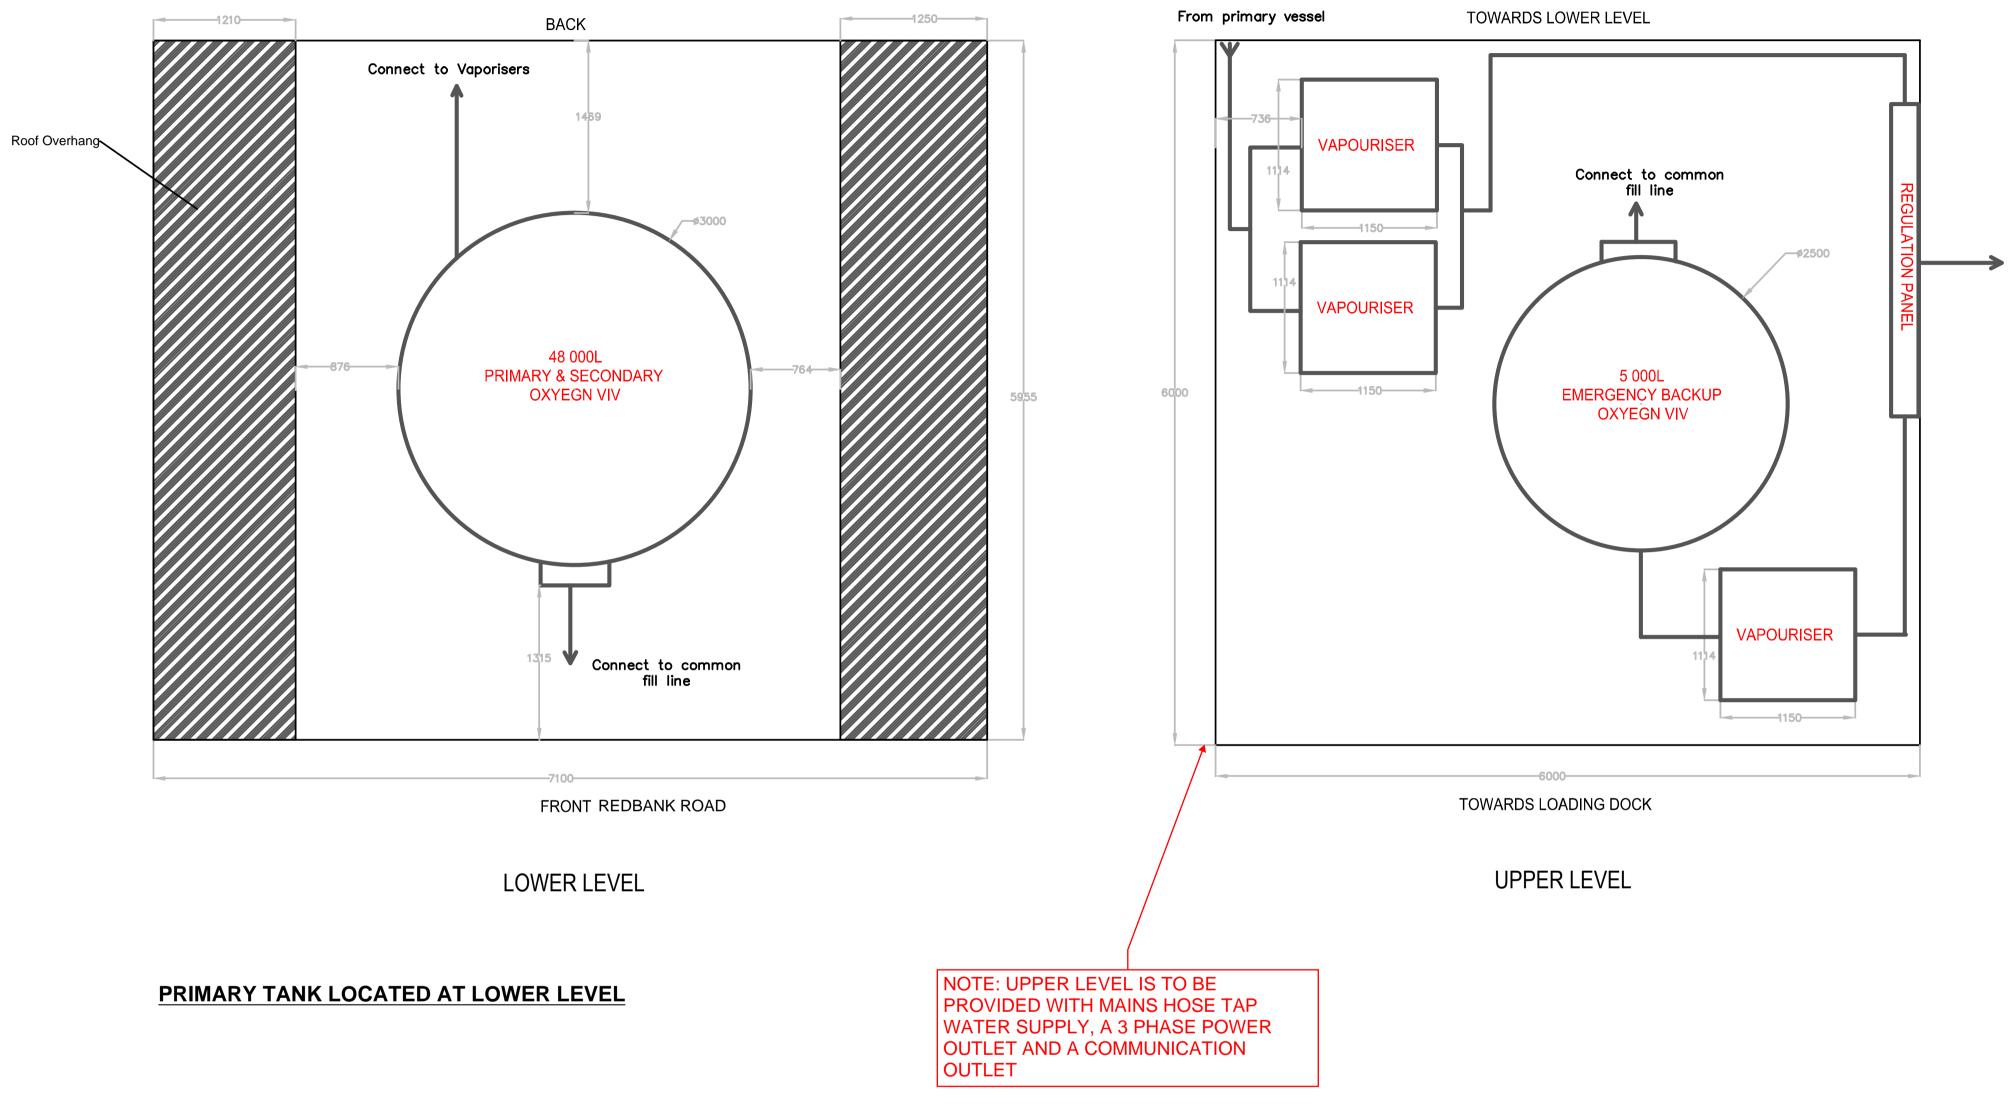

NOTE THAT ALL LAYOUT DIMENSIONS ARE TO BE CONFIRMED BY OTHERS

Connect to customer supply line (415 kPa)

Е	FOR INFORMATION	LA	KPR	16/07/21
D	FOR INFORMATION	LA	KPR	18/01/21
С	FOR INFORMATION	LA	KPR	06/01/21
В	FOR INFORMATION	LA	KPR	09/10/20
А	FOR INFORMATION	LA	KPR	18/08/20
REV	DESCRIPTION	DRAWN	APP'D	DATE


	CONSULTANT	Stante		ECT/CLIENT			
	CHW STAGE 2 - PSB						
	TITLE OXYGE	EN VIE TAN	ik plant layouts				
_			PRELIMINARY NOT FOR CONSTRUCTION MECHANICAL				
	NTS	44311	MG-SK-001	Е			

REV


DRAWING No

SCALE @ A1 PROJECT No


THIS DRAWING HAS BEEN DOCUMENTED IN COLOUR THIS DRAWING IS REQUIRED TO BE PRINTED IN COLOUR FAILURE TO DO SO MAY RESULT IN LOSS OF INFORMATION BLACK & WHITE PRINTING MAY BE USED IF SPECIFIC BLACK & WHITE DOCUMENTS HAVE BEEN OBTAINED FROM STANTEC

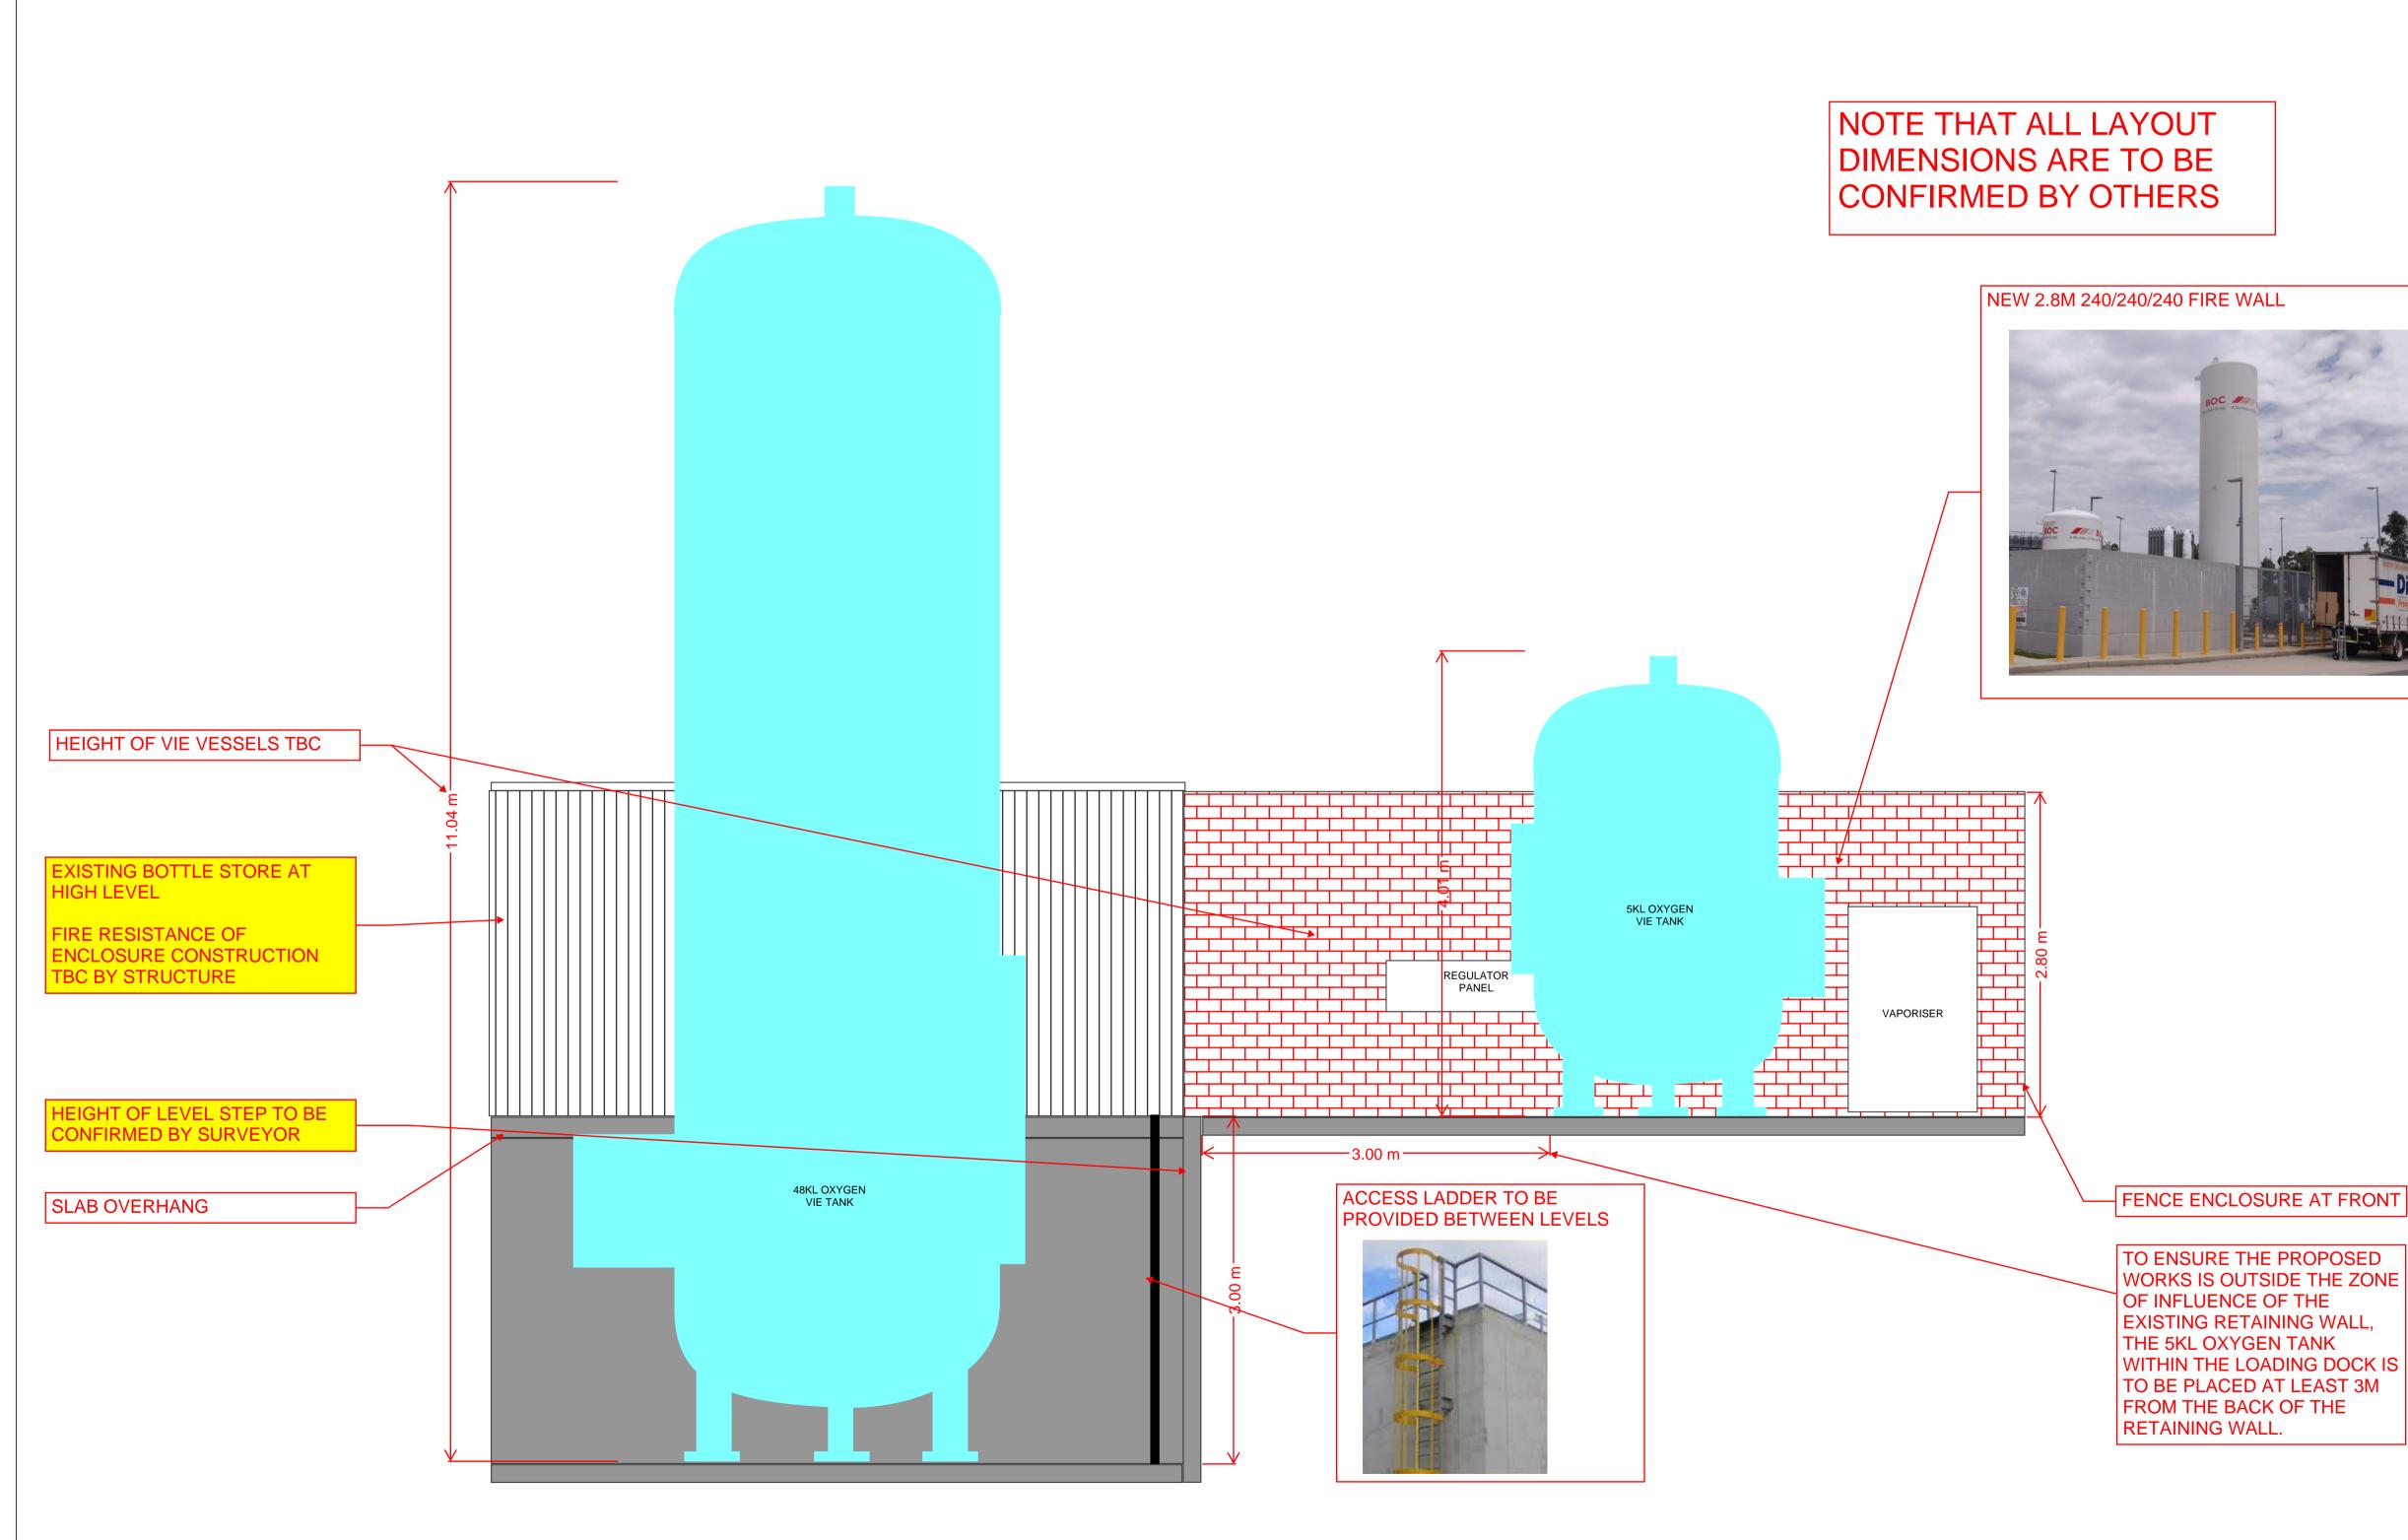

TANK SECTION. NTS

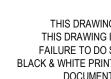



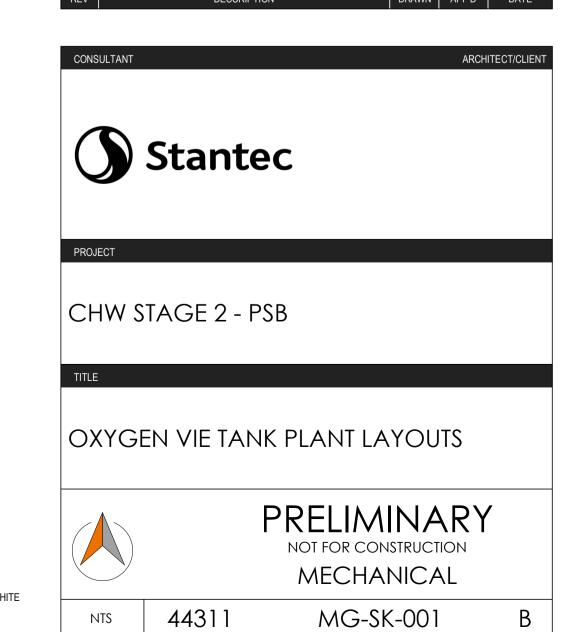

THIS DRAWING HAS BEEN DOCUMENTED IN COLOUR THIS DRAWING IS REQUIRED TO BE PRINTED IN COLOUR FAILURE TO DO SO MAY RESULT IN LOSS OF INFORMATION BLACK & WHITE PRINTING MAY BE USED IF SPECIFIC BLACK & WHITE DOCUMENTS HAVE BEEN OBTAINED FROM WGE

SCALE @ A1

PROJECT No

В	FOR INFORMATION	LA	KPR	16/07/21
А	FOR INFORMATION	LA	KPR	18/01/21
REV	DESCRIPTION	DRAWN	APP'D	DATE

REV

DRAWING No