


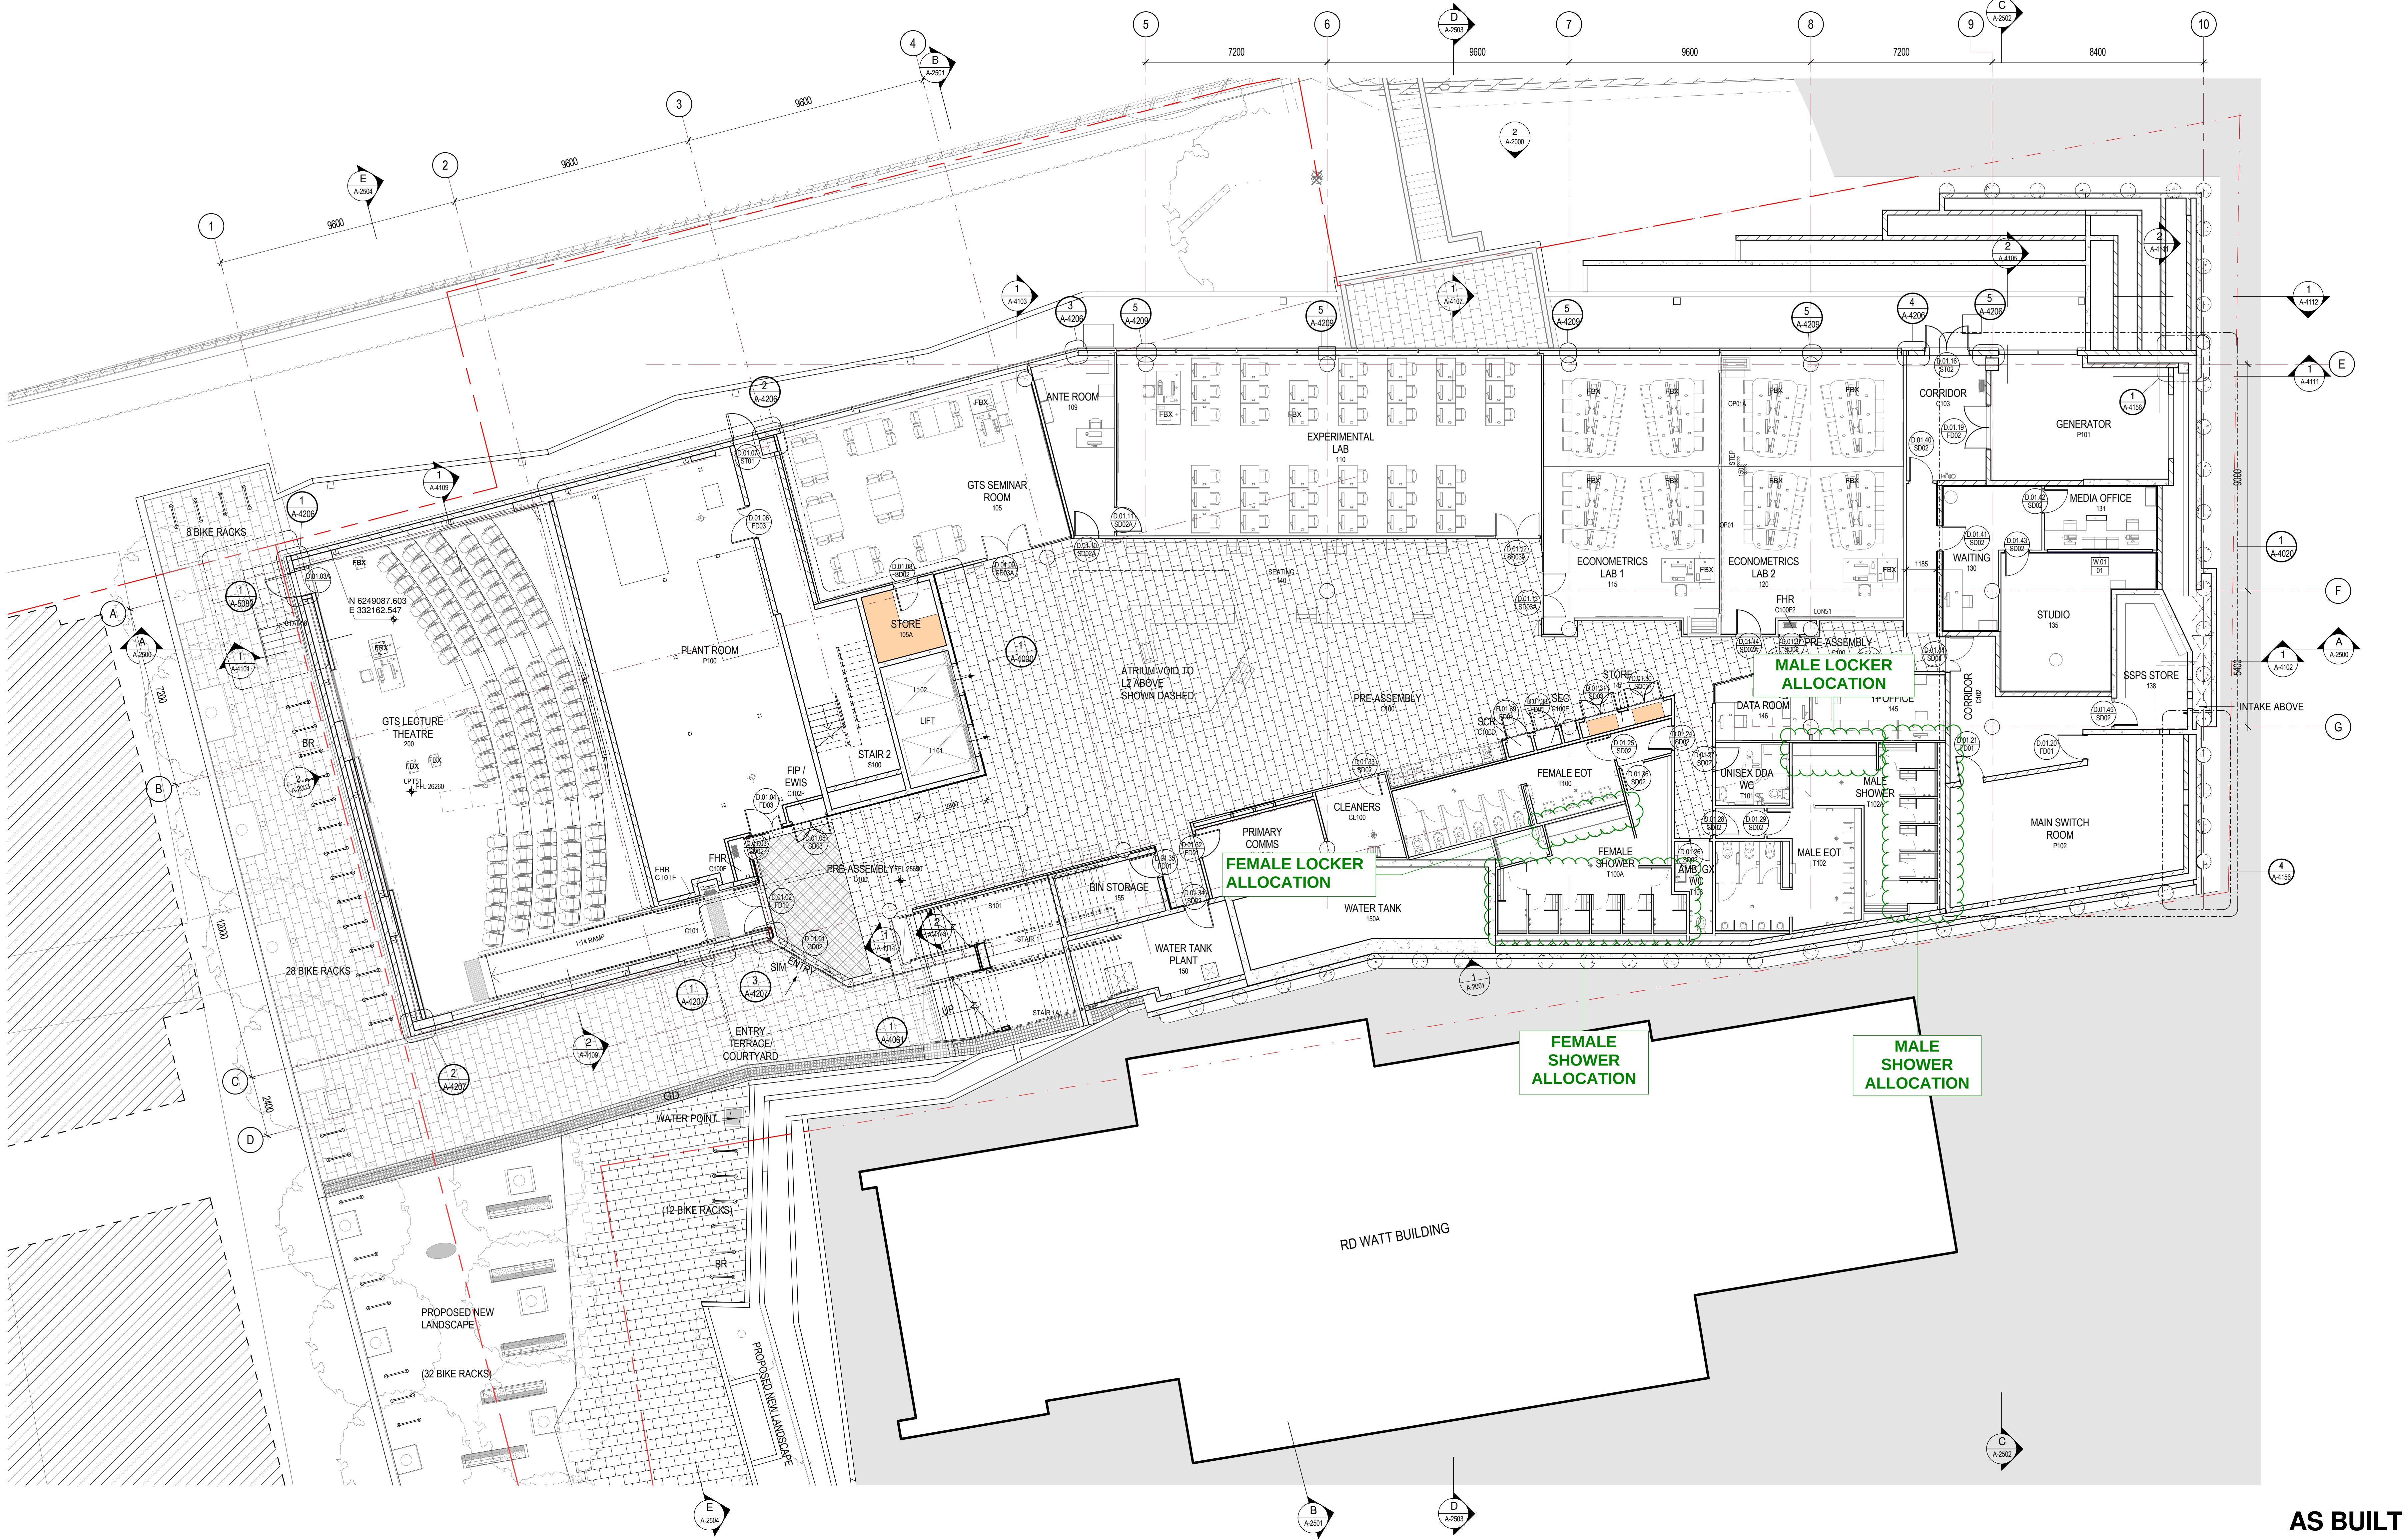

AS BUILT

architectus

Architectus Group Pty Ltd is the owner of the copyright subsisting in these drawings, plans, designs and specifications. They must not be used, reproduced or copied, in whole or in part, nor may the information, ideas and concepts therein contained (which are confidential to Architectus Group Pty Ltd) be disclosed to any person without the prior written consent of that company.

Do not scale drawings. Verify all dimensions on site. Dimensions in millimetres unless otherwise stated. Levels are in metres above Australian Height Datum unless otherwise stated. All discrepancies to be notified in writing to Architectus.

Do not scale drawings. Verify all dimensions on site

issue	amendment	date
J	FOR CONSTRUCTION	17.11.2017
K	FOR CONSTRUCTION	24.11.2017
L	FOR CONSTRUCTION	04.12.2017
M	FOR CONSTRUCTION	15.01.2018
N	FOR CONSTRUCTION	23.01.2018
O	FOR CONSTRUCTION	25.01.2018
P	FOR CONSTRUCTION	07.02.2018
Q	FOR CONSTRUCTION	27.02.2018
R	FOR CONSTRUCTION	23.03.2018
S	FOR CONSTRUCTION	06.04.2018
T	FOR CONSTRUCTION	04.05.2018
U	FOR CONSTRUCTION	12.06.2018
V	FOR CONSTRUCTION	25.06.2018
W	AS BUILT	30.06.2018

- notes
- REFER TO GENERAL NOTES ON A-0001
 - REFER TO INTERIOR FINISHES SCHEDULE AND INTERIOR CONCEPT REPORT
 - NEW LANDSCAPING AS PER PROPOSED LANDSCAPE PLANS
 - REFER TO CIVIL ENGINEERING DOCUMENTATION
 - REFER TO EXTERNAL WORKS A-1100 SERIES DRAWINGS

- legend
- BR BIKE RACKS
 - CLR CLEANERS ROOM
 - EXP EXPANSION OFFICE
 - RW LANDSCAPE RETAINING WALL
 - OF OVERFLOW
 - FG FIELD GULLY (REFER TO CIVIL ENG. DRAWINGS)
 - GD GRATED DRAIN (REFER TO CIVIL ENG. DRAWINGS)
 - DP SIPHONIC DOWNSPIPE
 - AP ACCESS PANEL
 - HT HOSE TAP - DETAIL TBC

client



architectus™

Sydney
Melbourne
Adelaide
Auckland
Christchurch
Brisbane

Architectus Sydney
Level 18 MLC Centre
19 Martin Place
Sydney NSW 2000
T (61 2) 8252 8400
F (61 2) 8252 8600
sydney@architectus.com.au
ABN 90 131 245 884

checked	AC/ID	scale	1 : 100@B1
drawn	HD/HZ	project no	150479.00

project
F.A.S.S - Faculty of Arts & Social Sciences

drawing
GENERAL ARRANGEMENT - LEVEL 1 - FASS

drawing no.	issue
A-1001	W

6/30/2018 3:13:24 PM

