

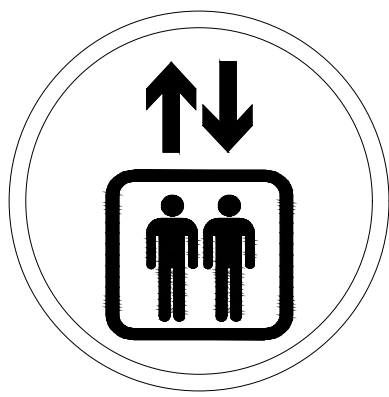
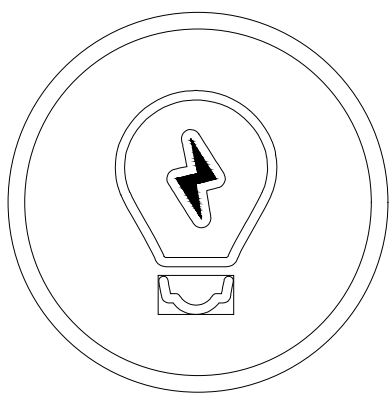
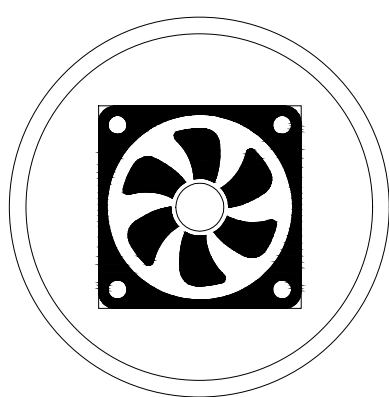
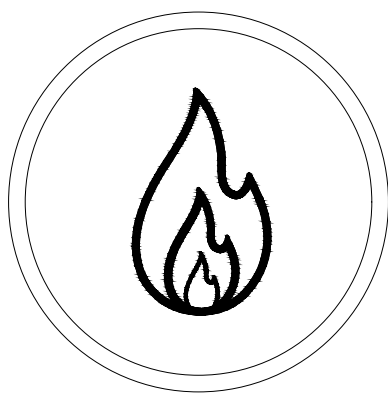
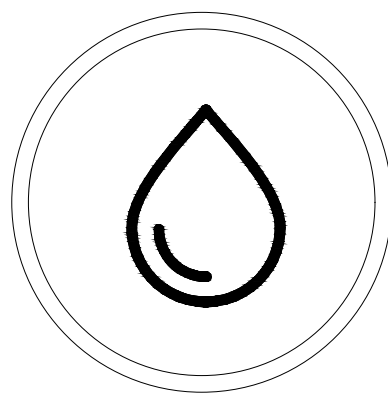
NCC: 2019 AMDT 1

FER: xxxxxx

SPEC: xxxxxx

*ALL DRAWINGS ARE TO BE READ IN CONJUNCTION
WITH THE ABOVE SPECIFICATION AND NCC.*

C000	COVER SHEET AND DRAWING LIST
C100	BASEMENT 5 SPATIAL LAYOUT
C101	BASEMENT 4 SPATIAL LAYOUT
C102	BASEMENT 3 SPATIAL LAYOUT
C103	BASEMENT 2 SPATIAL LAYOUT
C104	BASEMENT 1 SPATIAL LAYOUT
C105	GROUNDFLOOR SPATIAL LAYOUT
C106	LEVEL 1 SPATIAL LAYOUT
C107	LEVEL 2 SPATIAL LAYOUT
C108	LEVEL 3 SPATIAL LAYOUT
C143	LEVEL 38 SPATIAL LAYOUT
C144	ROOF SPATIAL LAYOUT



PROJECT: BTR & AFFORDABLE HOUSING + COMMERCIAL OFFICE DEVELOPMENT

ADDRESS: 2-4 BURLEIGH ST & 20-24 RAILWAY PDE, BURWOOD

CLIENT: PTI ARCHITECTURE

SERVICES: CO-ORDINATION SET



Client



Architect



Office: Level 2, 68 Sophia Street, Surry Hills NSW 2010
 • 01 2 9283 8800 | www.gpiarchitecture.com.au
 Nominated Registered Architect: Peter Israel (reg no 5084)

[illegible]

Project
**BTR & AFFORDABLE HOUSING
+ COMMERCIAL OFFICE
DEVELOPMENT**

2-4 BURLEIGH ST & 20-24
RAILWAY PDE, BURWOOD

Drawing Title

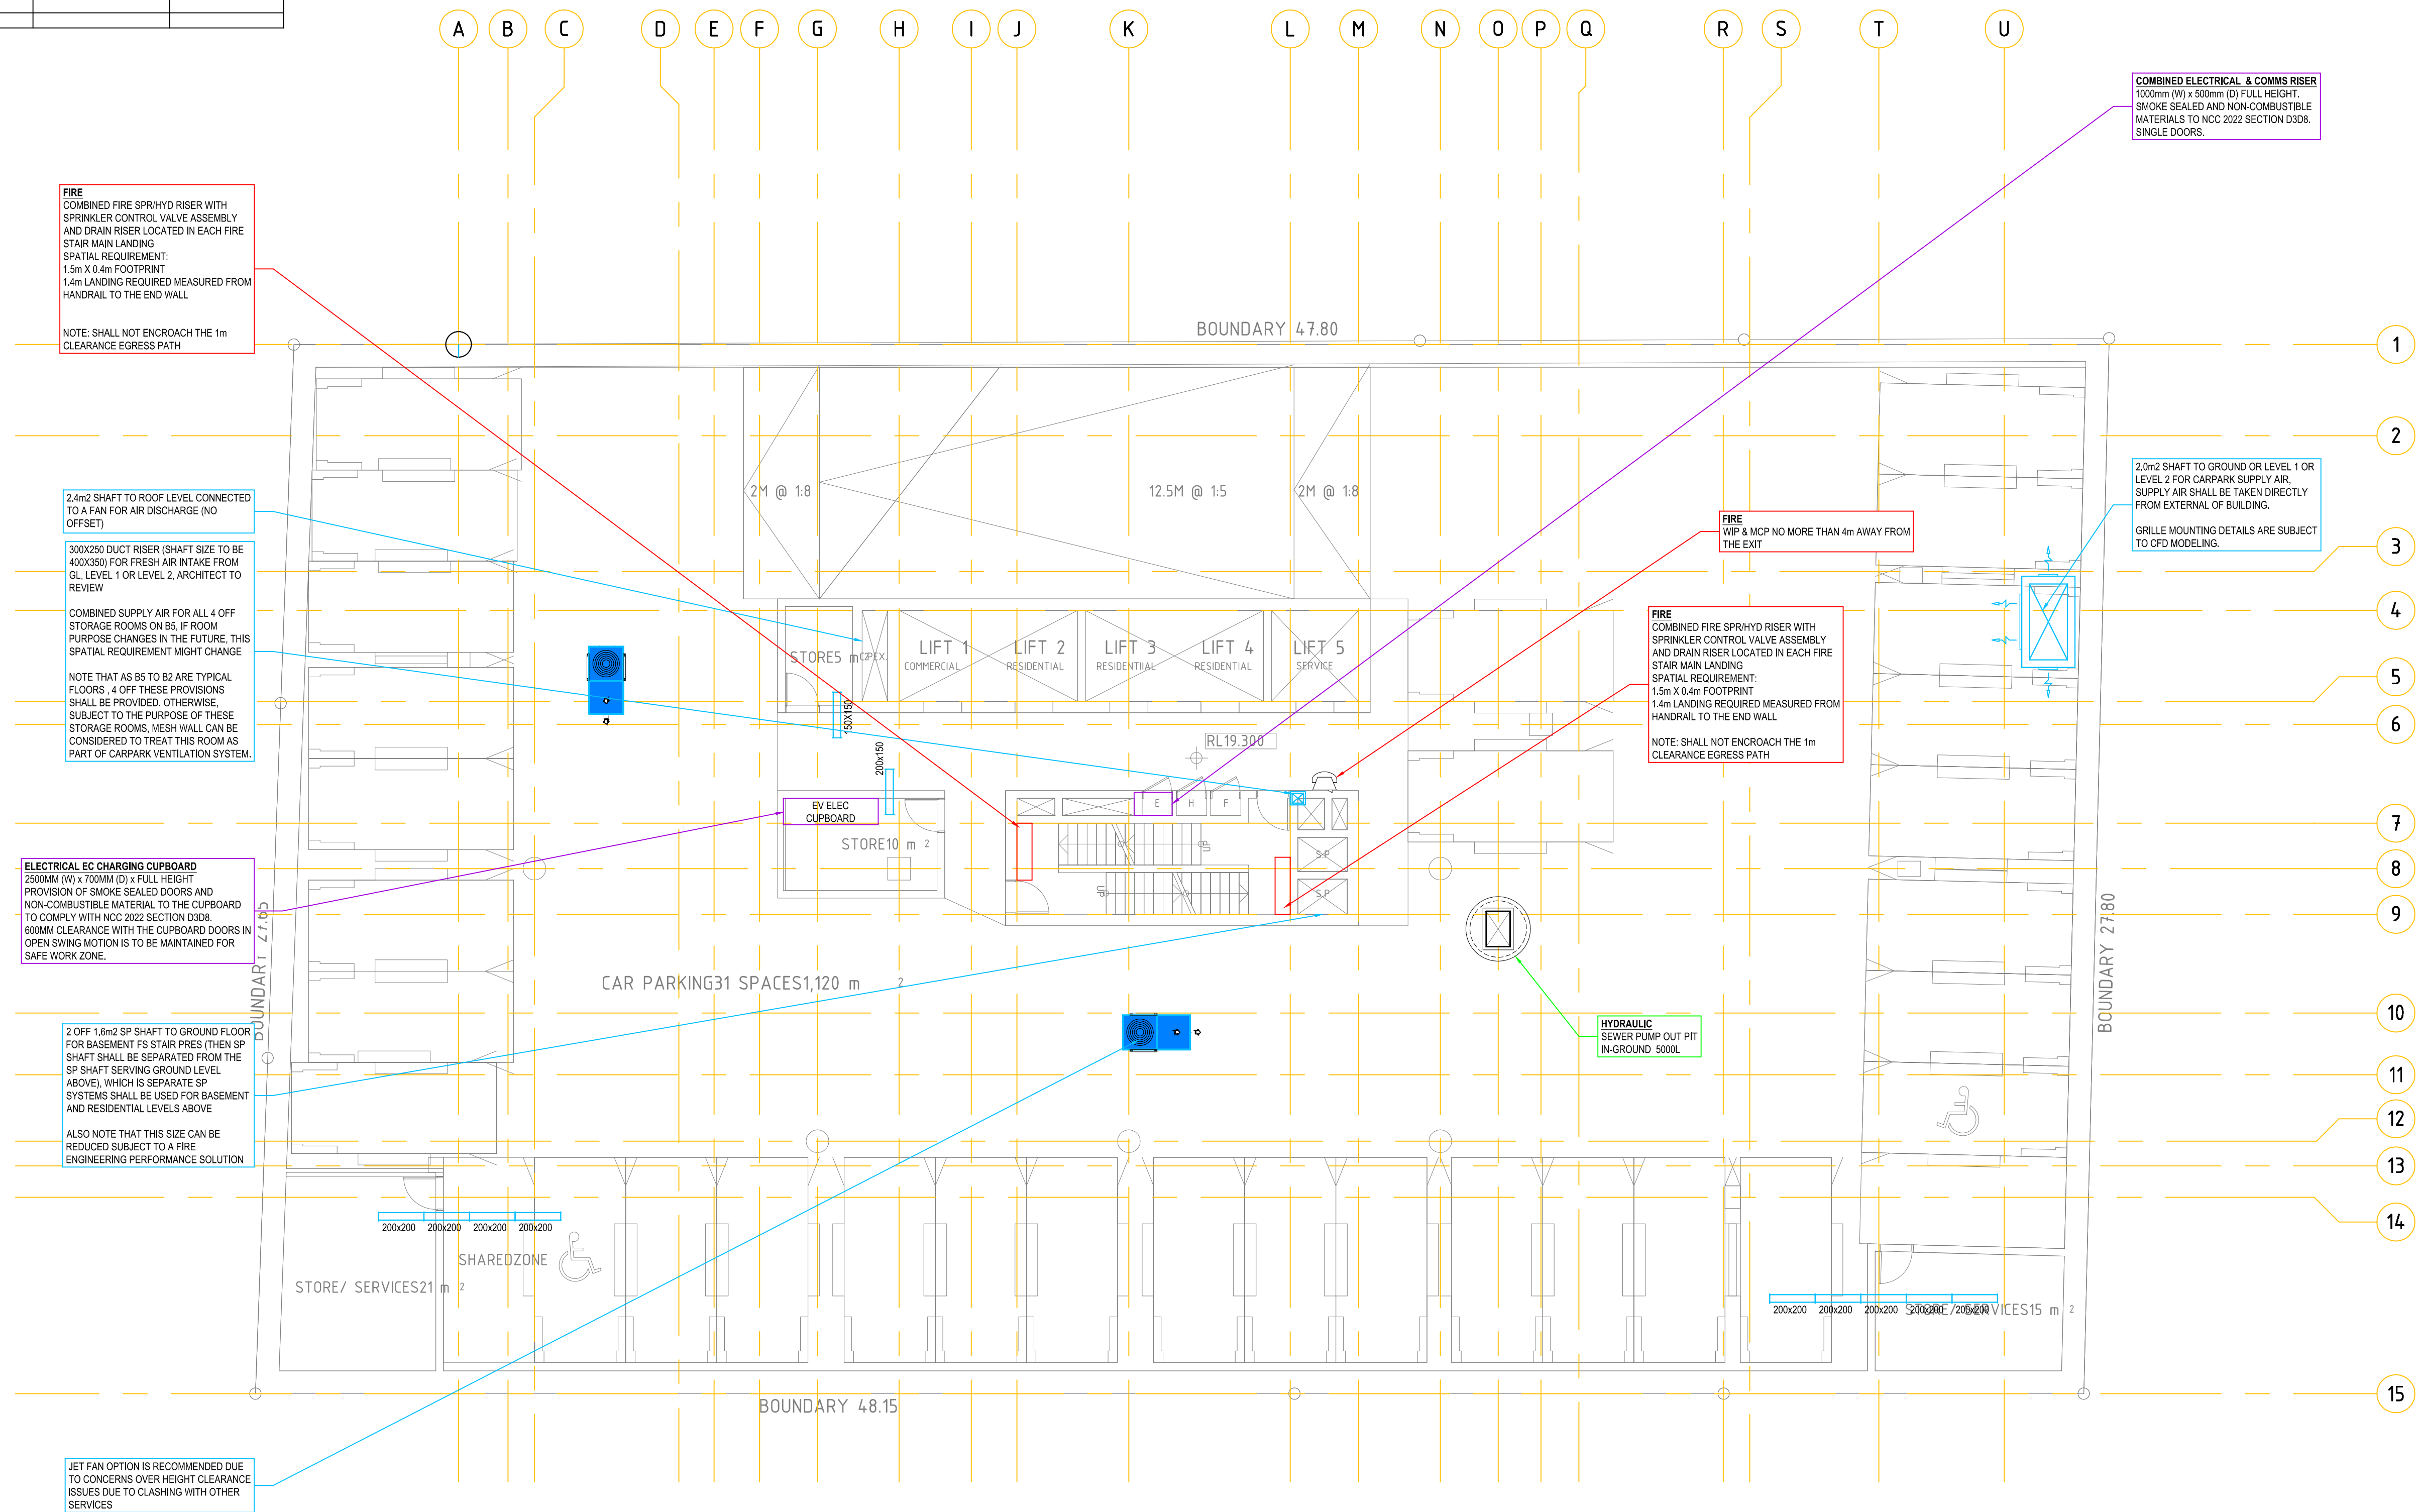
CO-ORDINATION SET

COVER SHEET AND DRAWING LIST




Project No. 24021		  	
Drawing No. C000			
Scale @ A1: N.T.S.	North		Revision
Chk: M.A.			P1
Dwn: M.A.			
Date: FEB 2024			

PRELIMINARY ISSUE

[illegible]

Client



Architect

[illegible]

Project
**BTR & AFFORDABLE HOUSING
+ COMMERCIAL OFFICE
DEVELOPMENT**

2-4 BURLEIGH ST & 20-24
RAILWAY PDE, BURWOOD

Drawing Title
CO-ORDINATION SET
BASEMENT 5
SPATIAL
LAYOUT

Project No. 24021

Drawing No. 0100

Scale @ A1:	1:100
-------------	-------

Chk:	M.A.
------	------

Drn:	M.A.
------	------

Date: FEB 2024

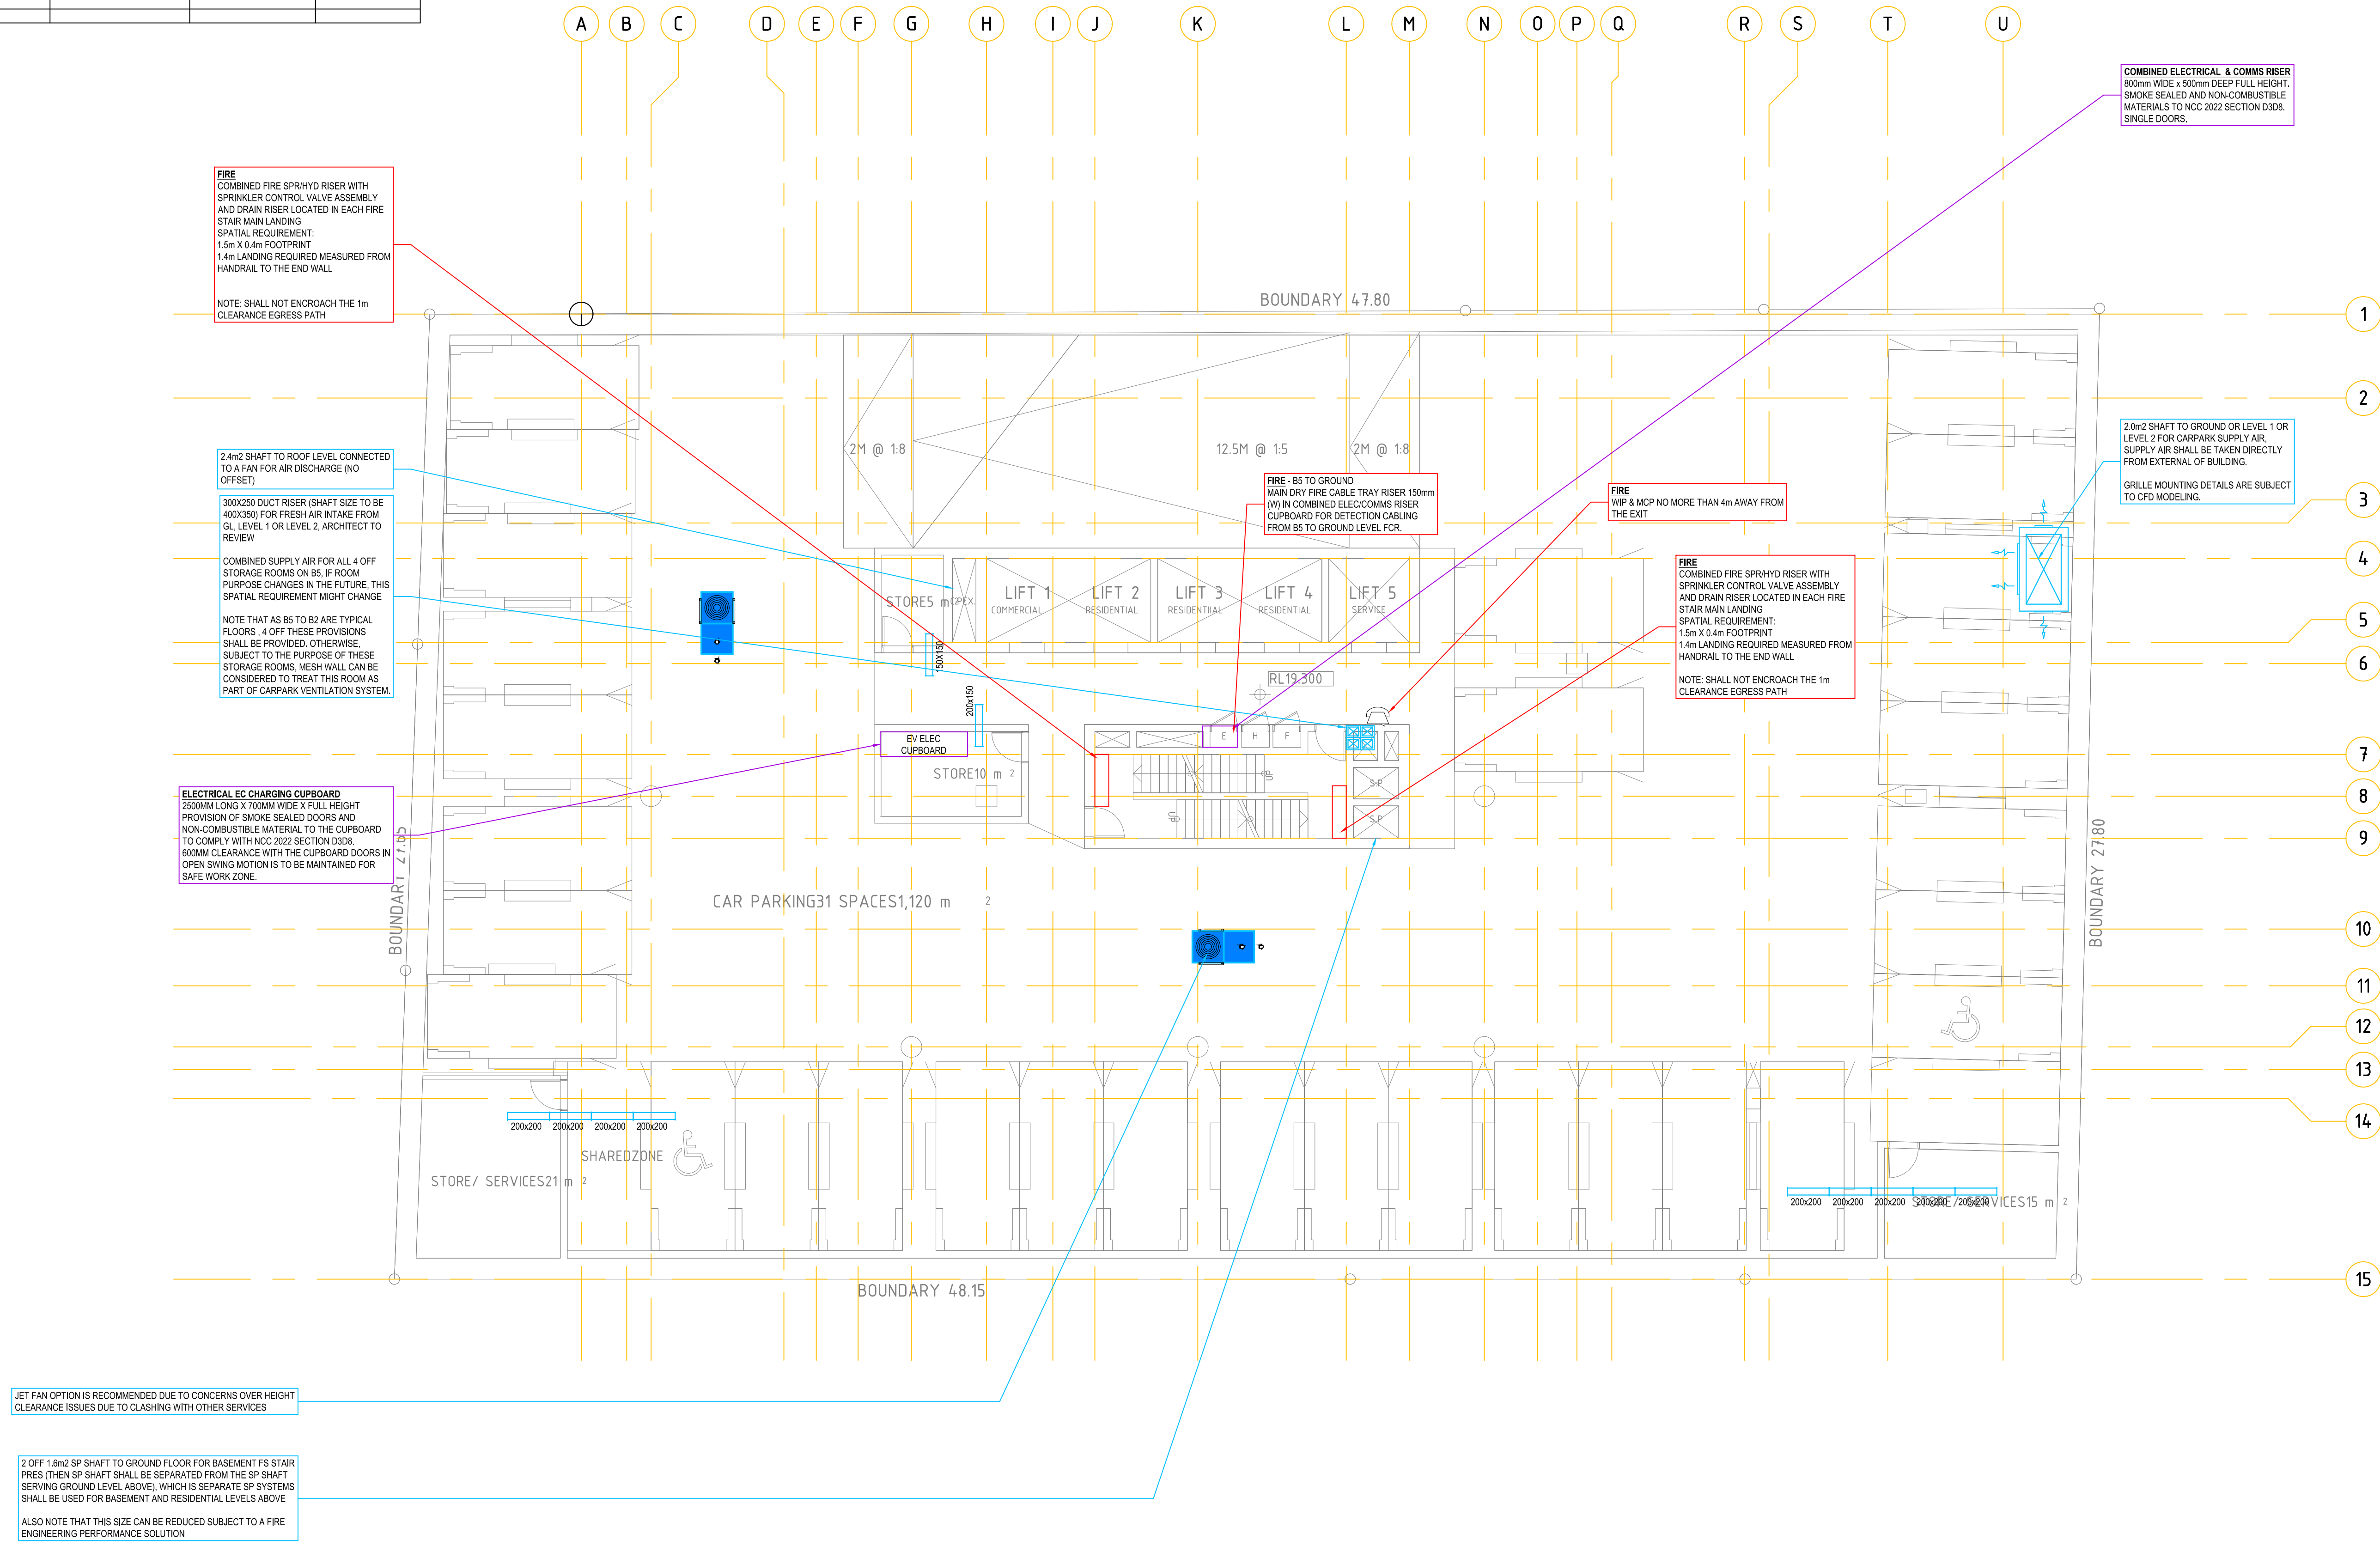
North

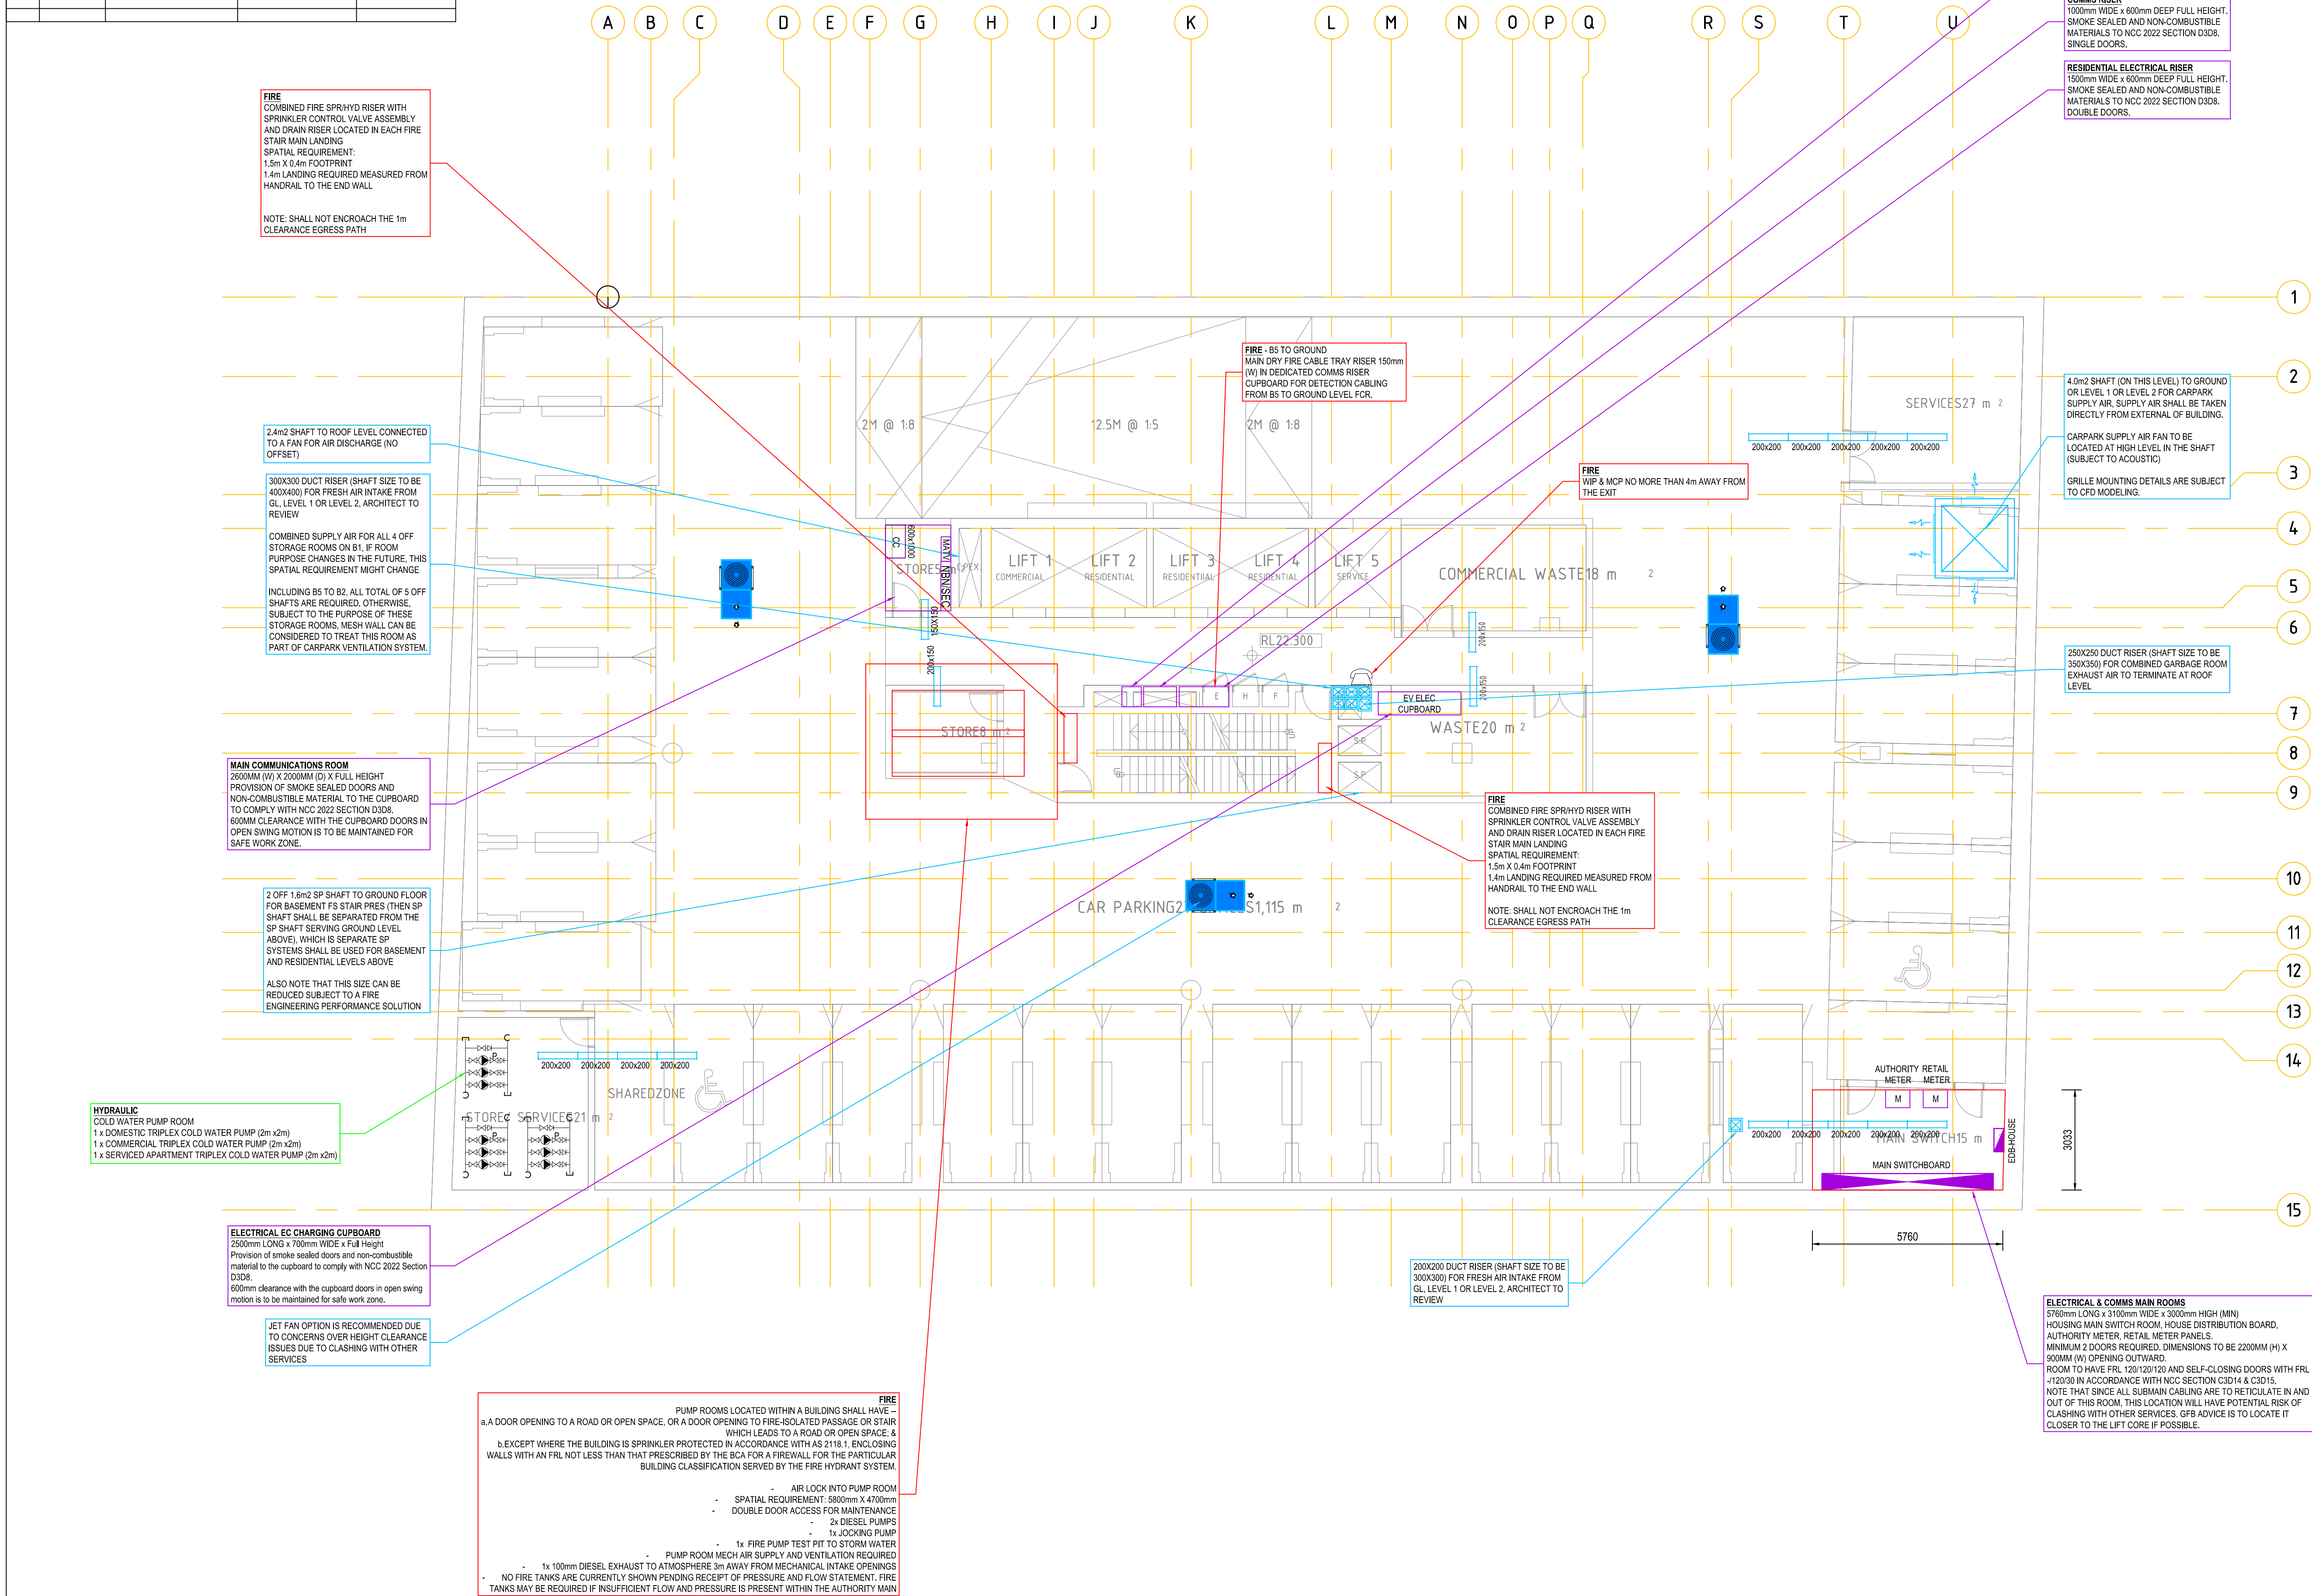
Revision

D1

F

PRELIMINARY ISSUE

[illegible][illegible]

[illegible]

Client



Architect



No.	Description	Date	In
P1	PRELIMINARY ISSUE	20.02.24	M.A.

Project
**BTR & AFFORDABLE HOUSING
+ COMMERCIAL OFFICE
DEVELOPMENT**

2-4 BURLEIGH ST & 20-24
RAILWAY PDE, BURWOOD

Drawing Title
CO-ORDINATION SET
BASEMENT 1
SPATIAL
LAYOUT

Project No. 24021

Drawing No. C104

Scale @ A1:	1:100	North
-------------	-------	-------

Chk: M.A.

Drn: M.A.

Date: FEB 2024

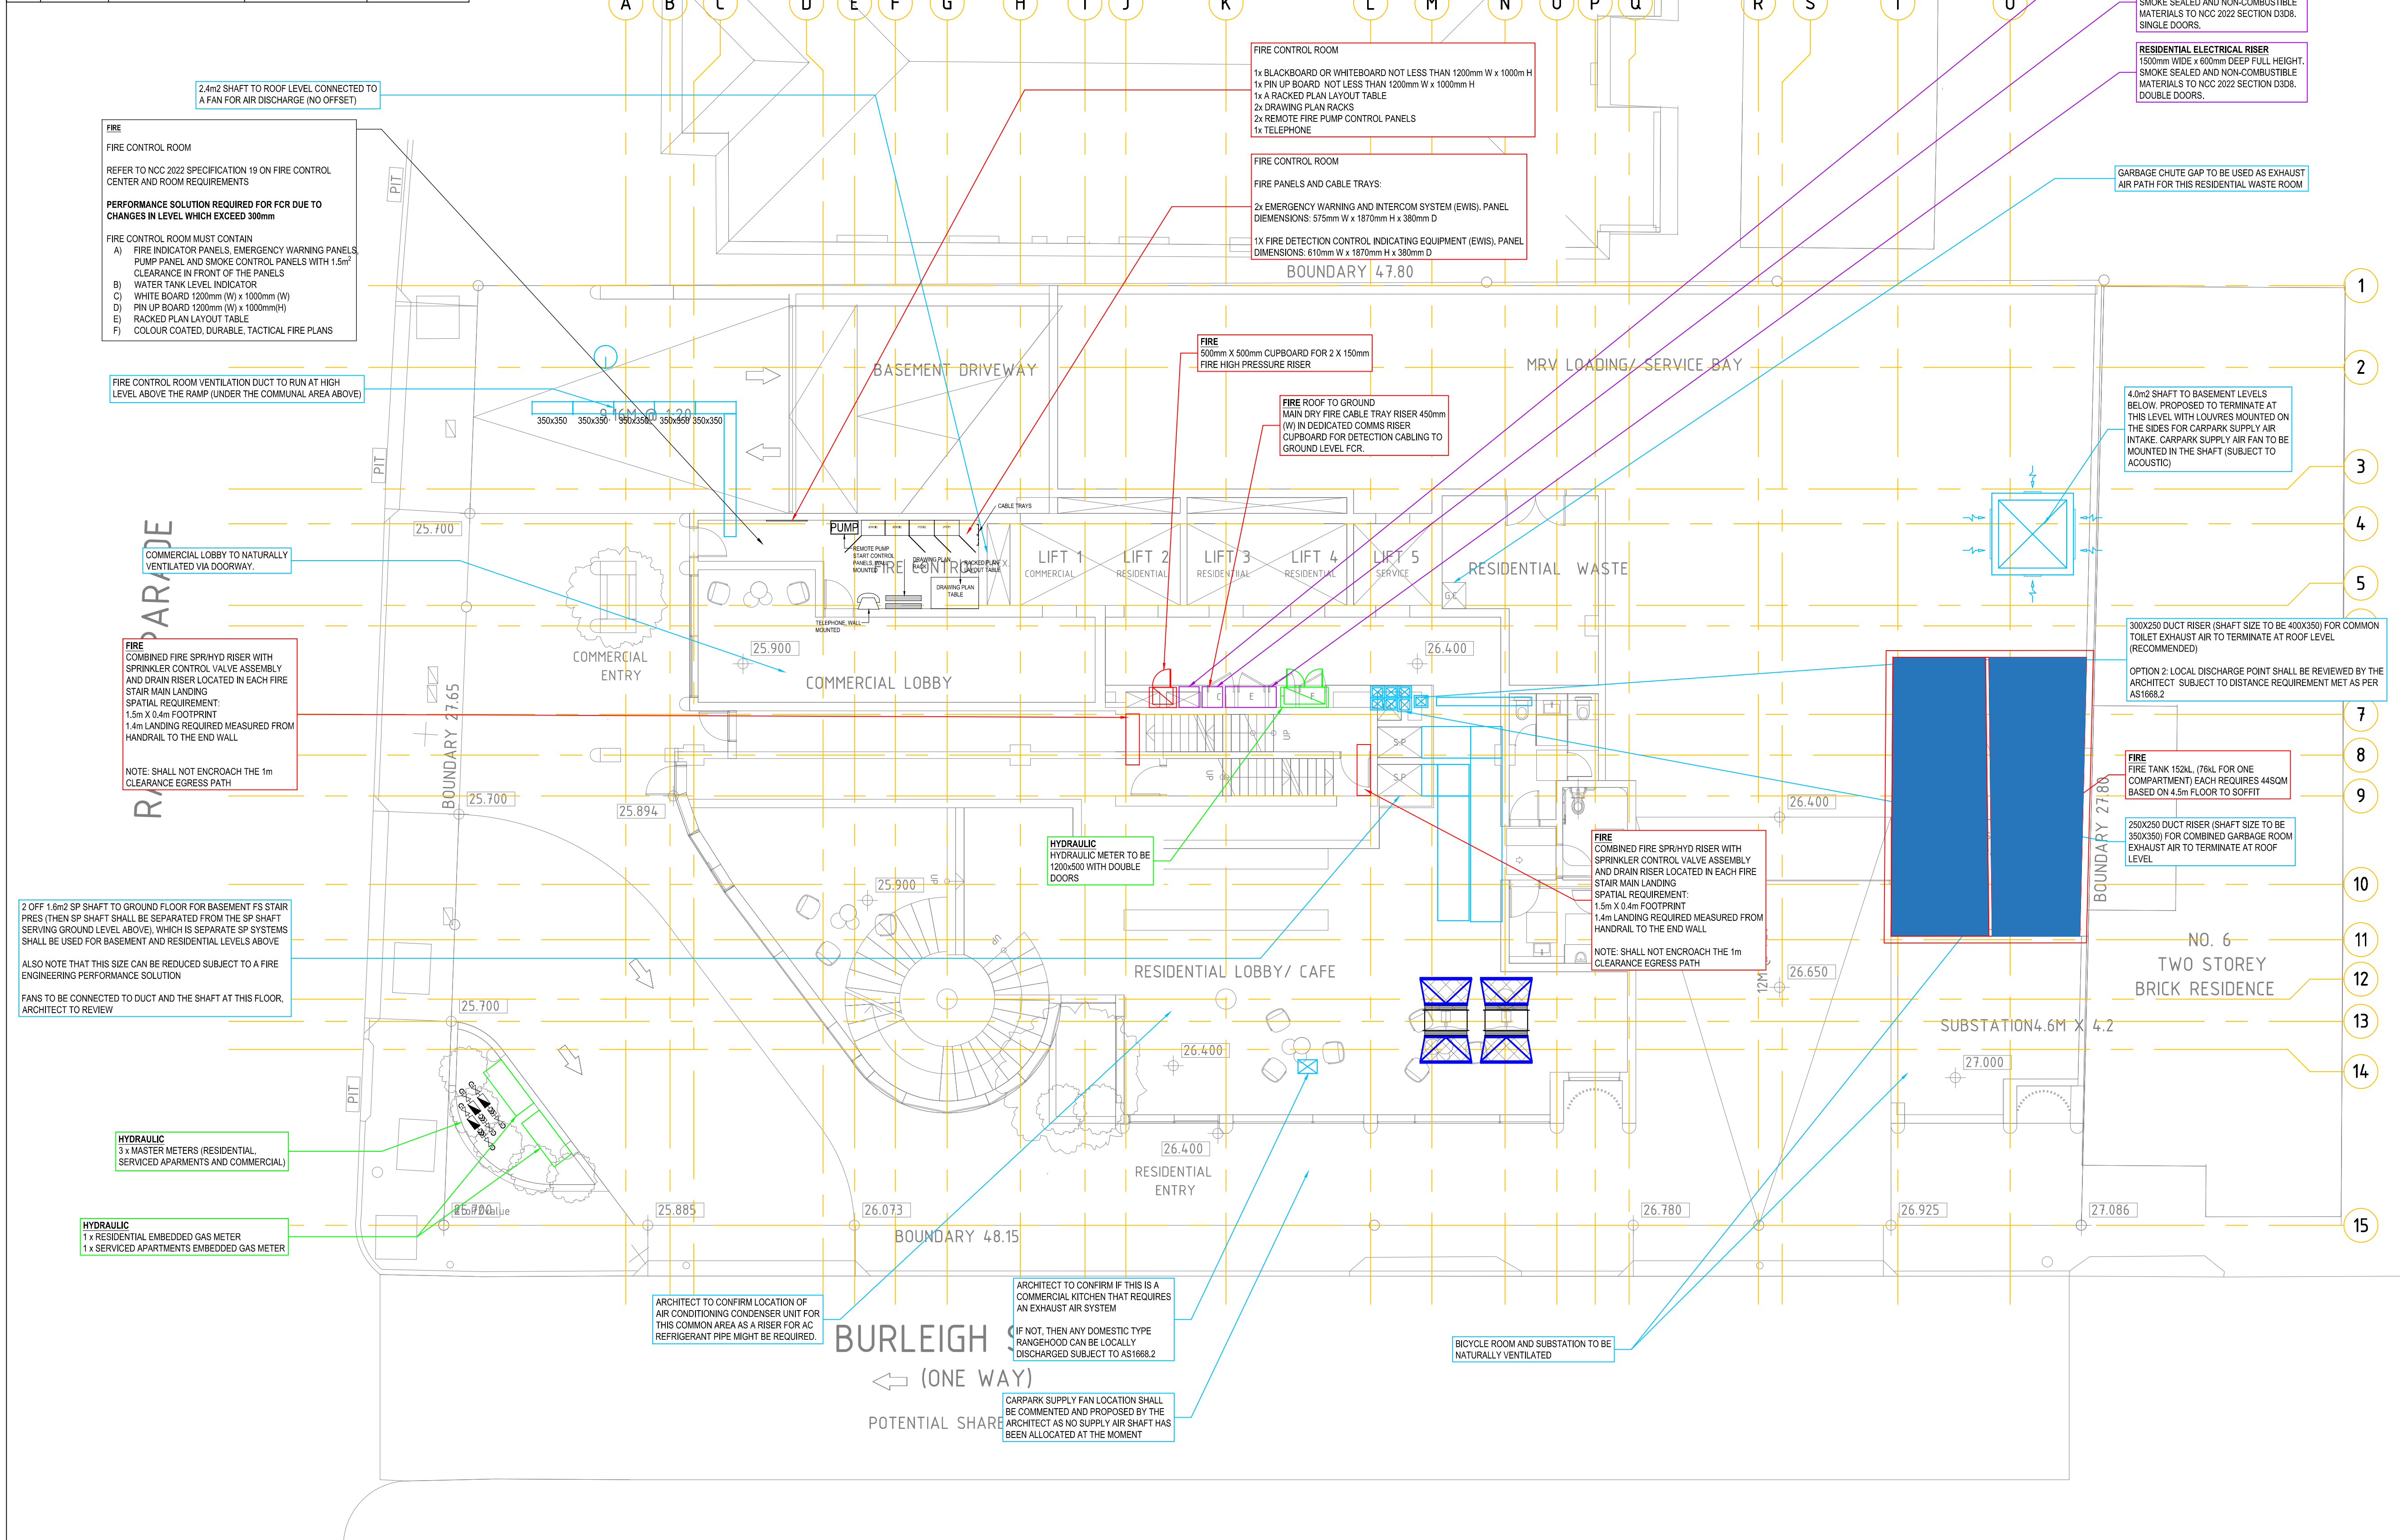
Revision

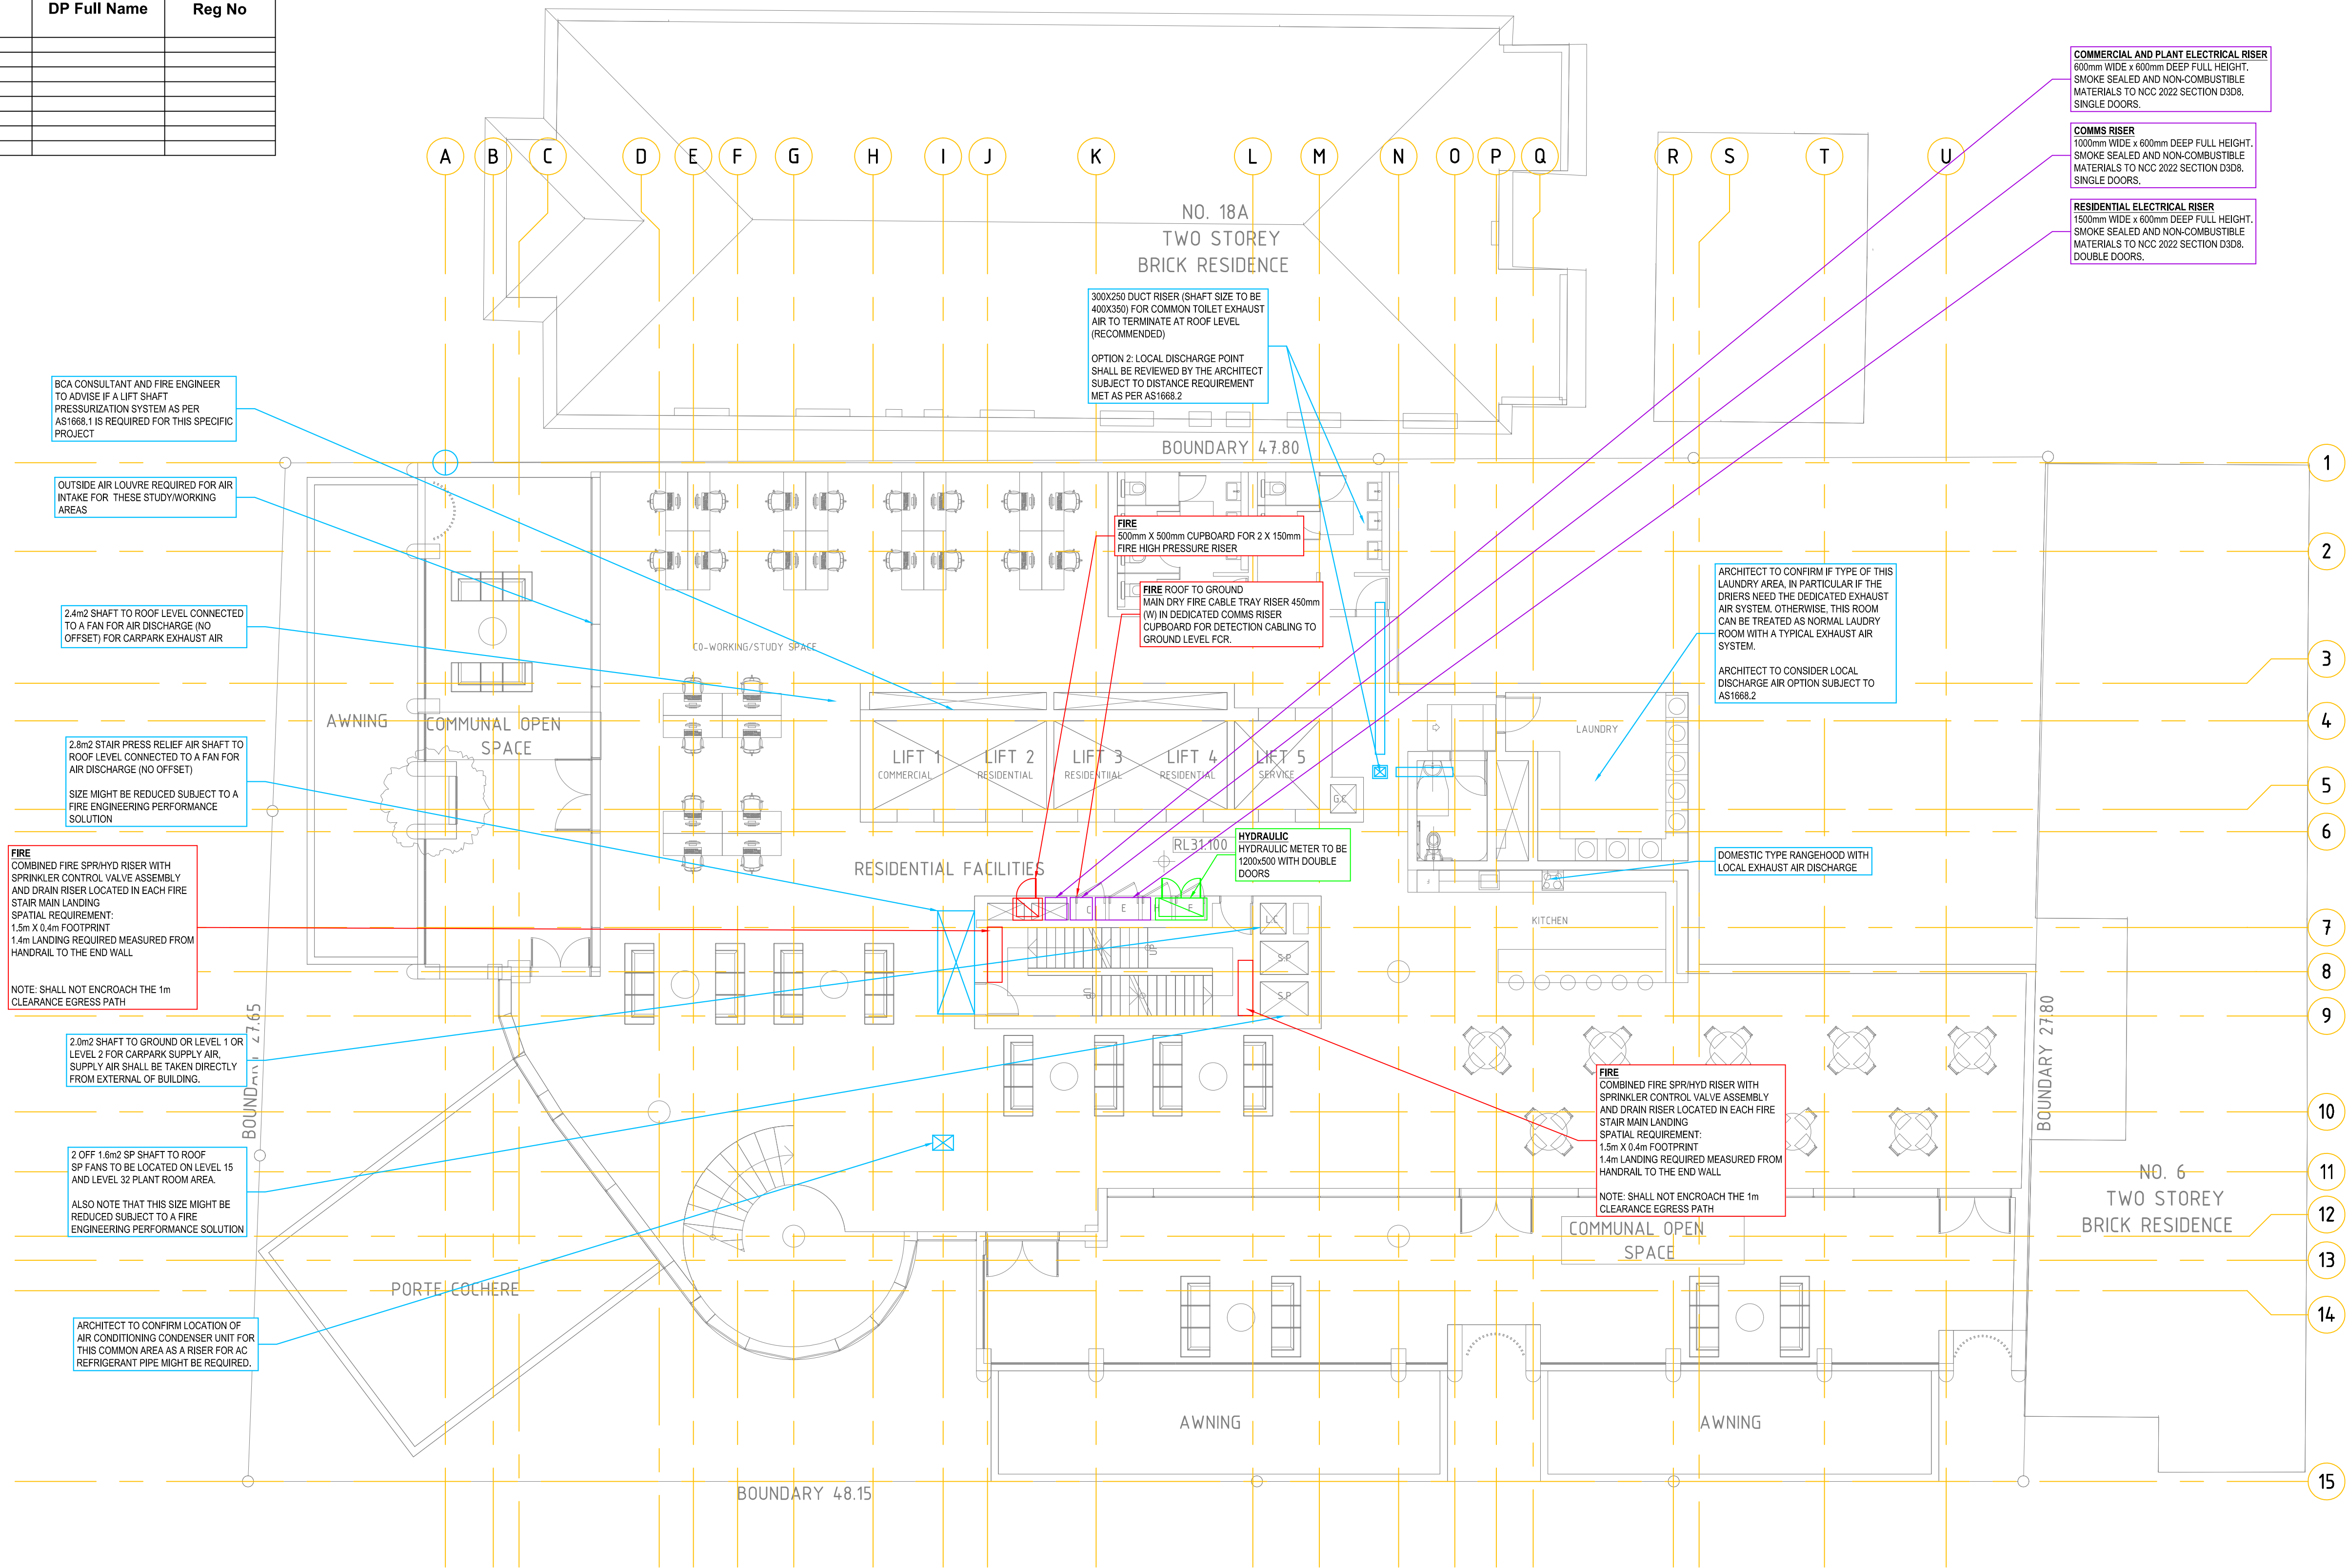
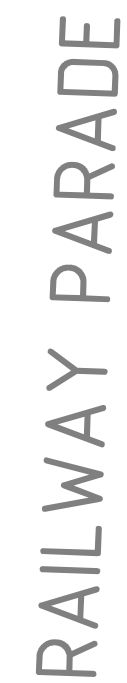
D1

11

--	--

PRELIMINARY ISSUE

[illegible][illegible]

[illegible]

Client



Architect

[illegible]

Project
**BTR & AFFORDABLE HOUSING
+ COMMERCIAL OFFICE
DEVELOPMENT**

2-4 BURLEIGH ST & 20-24
RAILWAY PDE, BURWOOD

Drawing Title
CO-ORDINATION SET
LEVEL 1
SPATIAL
LAYOUT

Project No. 24021

Drawing No. **C106**

Scale @ A1: 1:100 North

Chk:	M.A.
------	------

Drn:	M.A.
------	------

Date:	FEB 2024
-------	----------

North

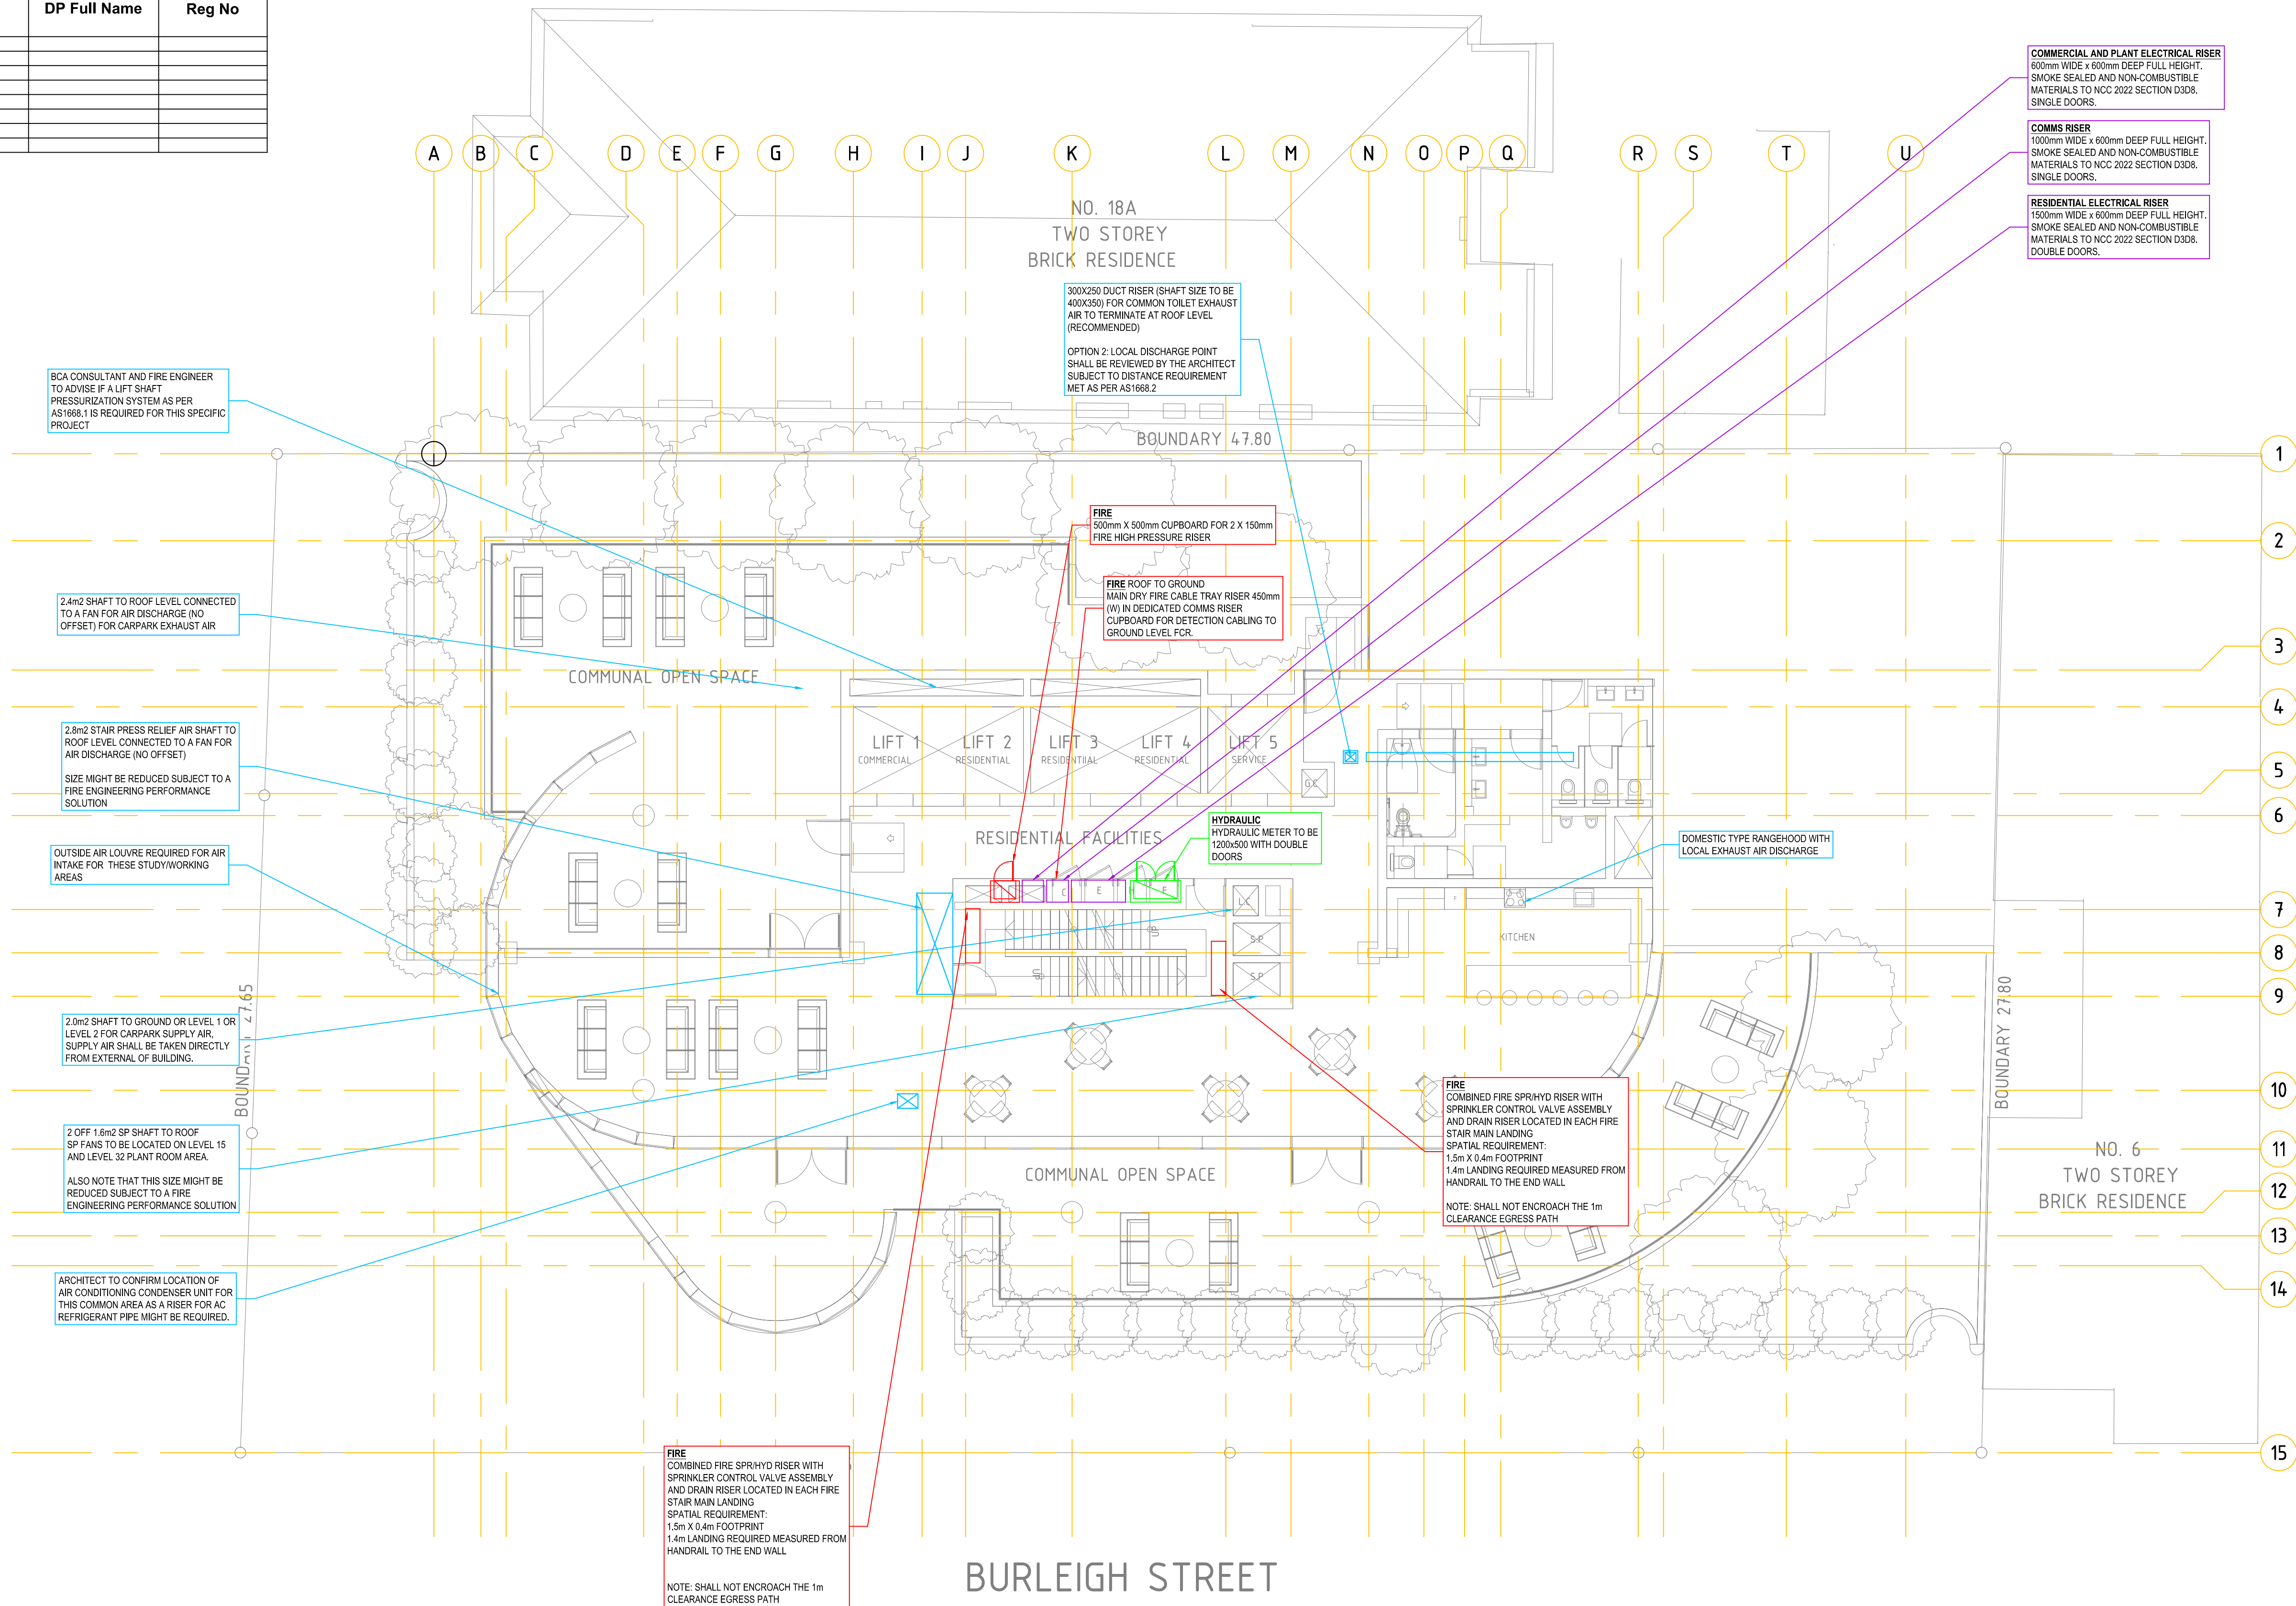
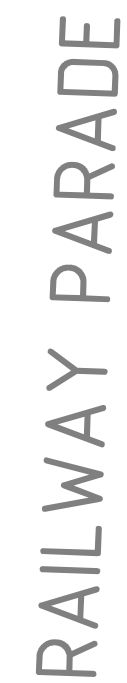
Revision

D1

PI

--	--

PRELIMINARY ISSUE

[illegible]

Client



Architect

[illegible]

Project
**BTR & AFFORDABLE HOUSING
+ COMMERCIAL OFFICE
DEVELOPMENT**

2-4 BURLEIGH ST & 20-24
RAILWAY PDE, BURWOOD

Drawing Title
CO-ORDINATION SET
LEVEL 2
SPATIAL
LAYOUT

Project No. 24021

Drawing No. **C107**

Scale @ A1:	1:100
-------------	-------

Chk:	M.A.
------	------

Drn:	M.A.
------	------

Date: FEB 2024

North



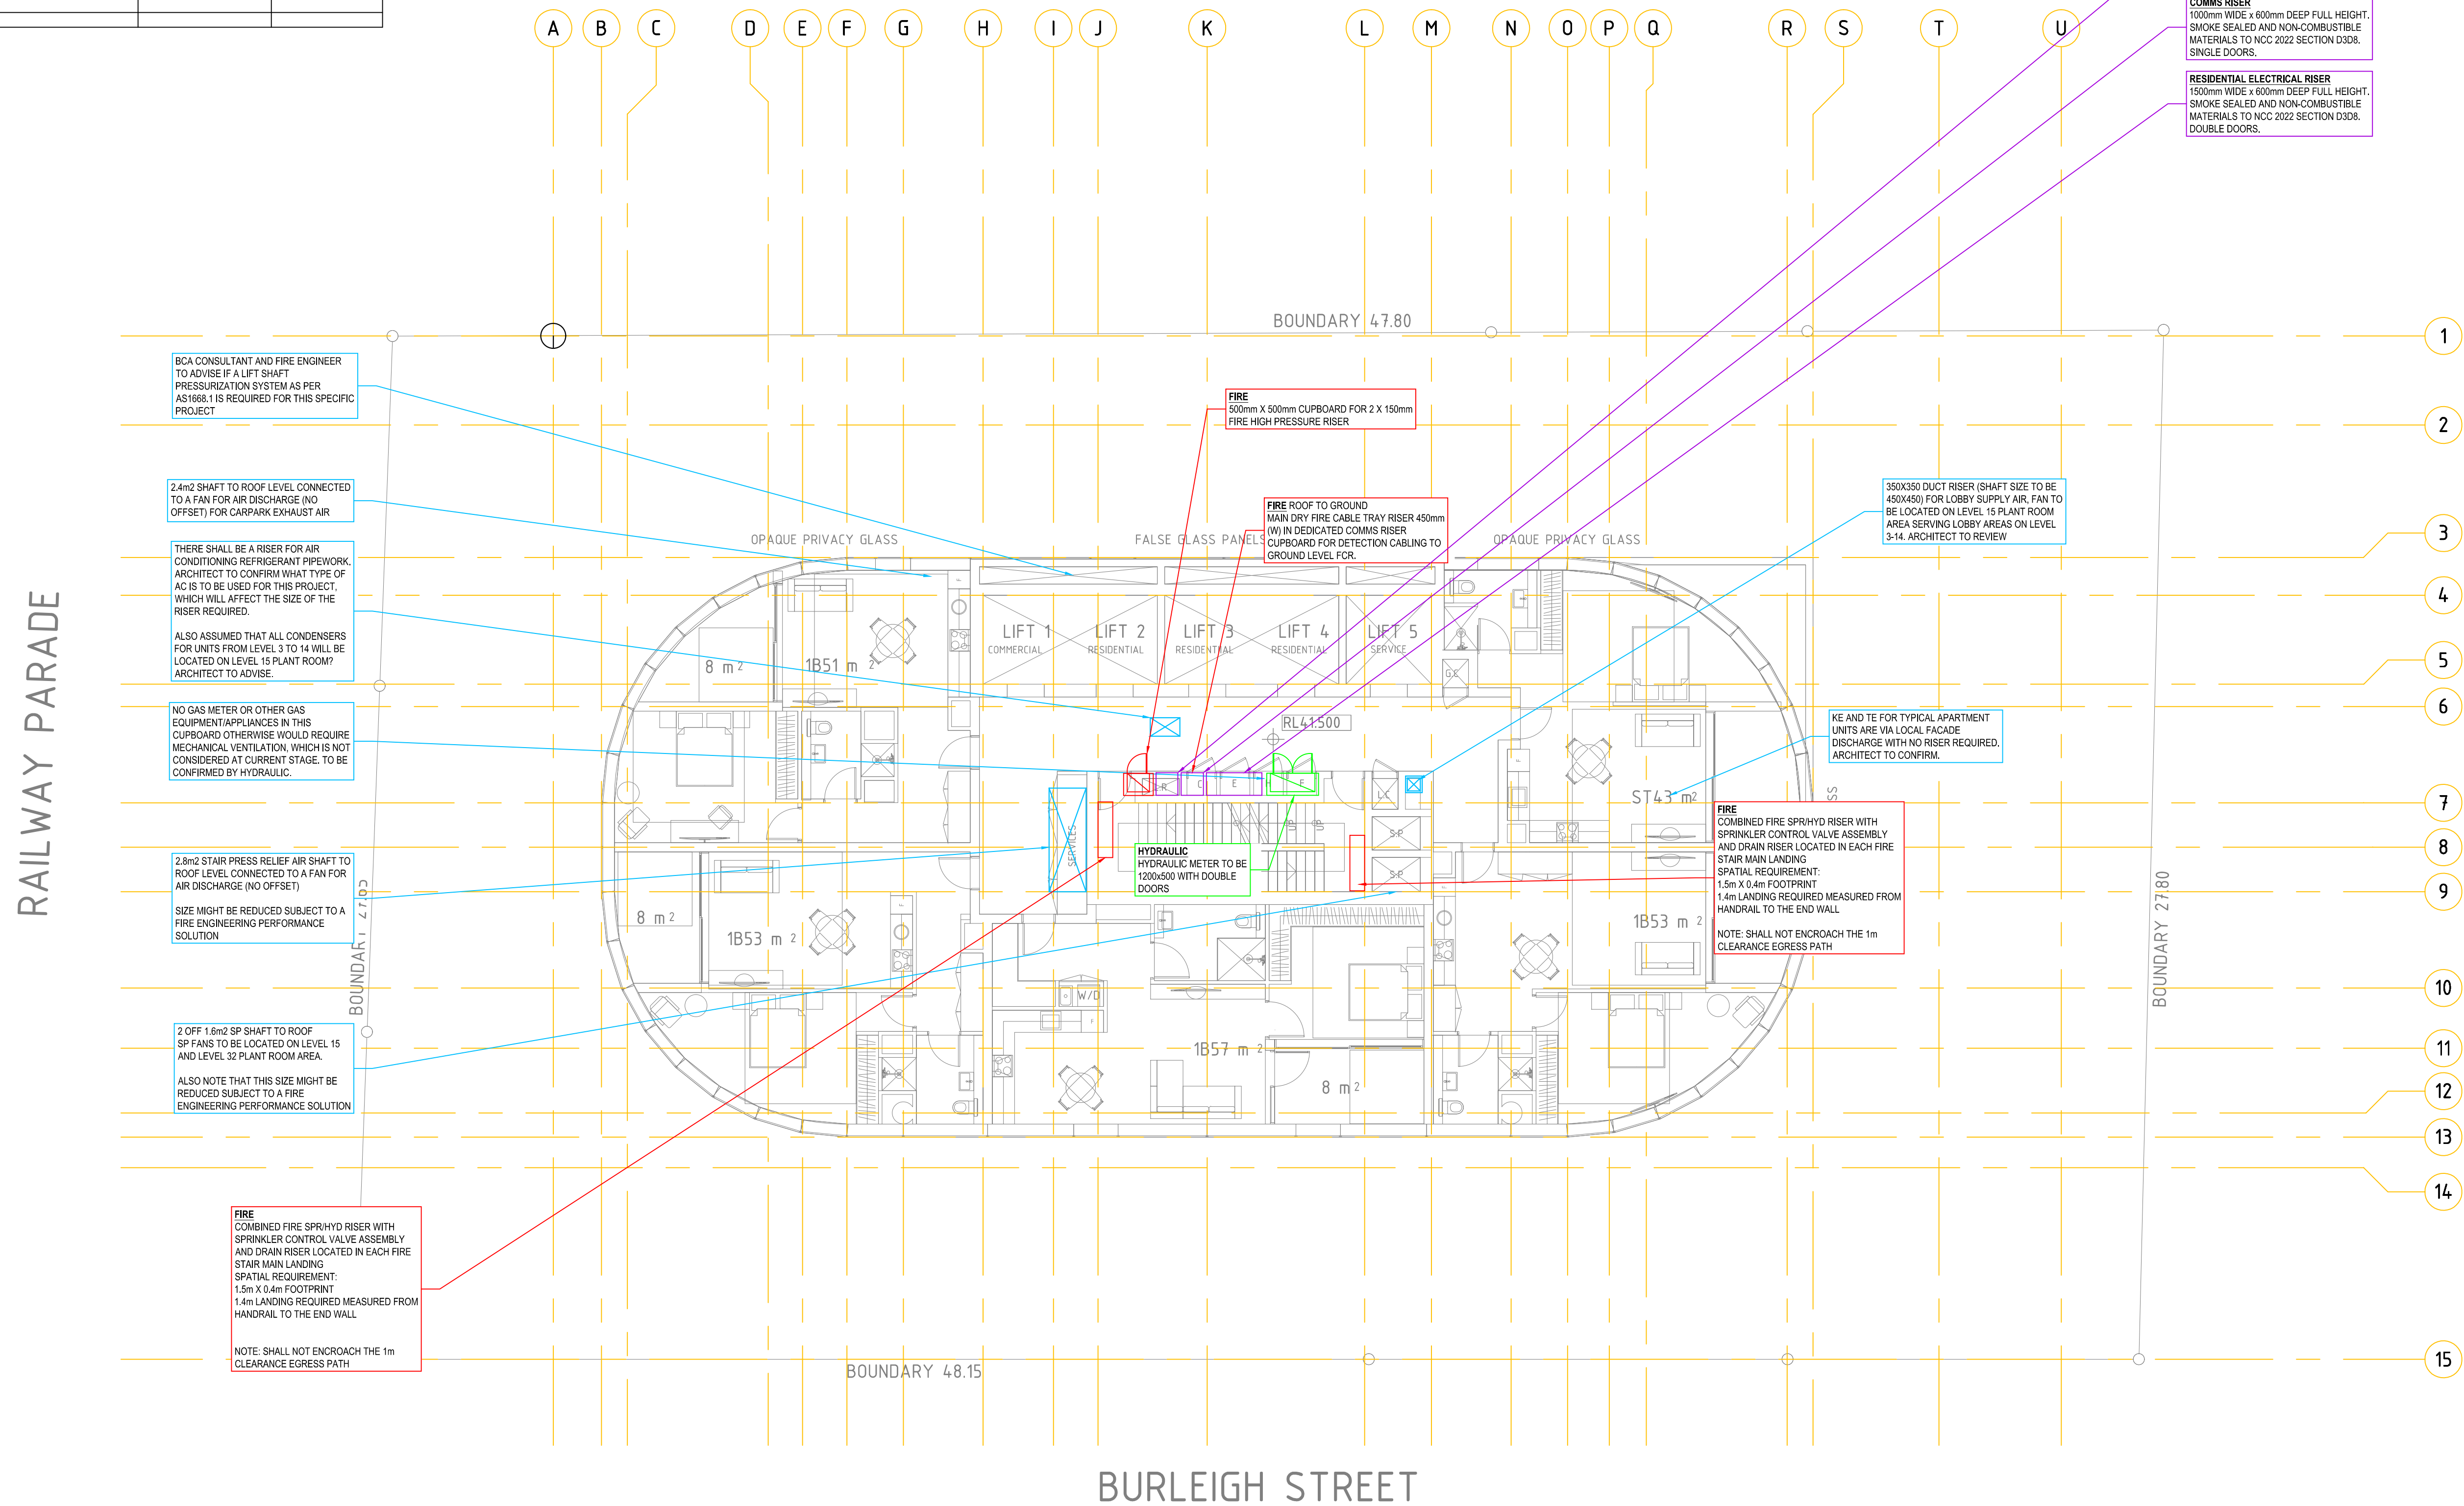
Revision

D1 

PI

1	2	3	466
---	---	---	---	---	---	---	---	---	----	----	-----	-----	
PRELIMINARY ISSUE

[illegible]

DRAWING SHOWN FOR LEVEL 3 IS TYPICAL FOR LEVEL 4-14 (ARCHITECT TO CONFIRM)



Client



Architect

[illegible]

Project
**BTR & AFFORDABLE HOUSING
+ COMMERCIAL OFFICE
DEVELOPMENT**

2-4 BURLEIGH ST & 20-24
RAILWAY PDE, BURWOOD

Drawing Title
CO-ORDINATION SET
LEVEL 3
SPATIAL
LAYOUT

Project No. 24021

Drawing No. **C108**

Scale @ A1:	1:100
-------------	-------

Chk:	M.A.
------	------

Drn:	M.A.
------	------

North

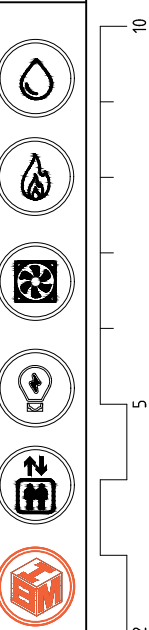


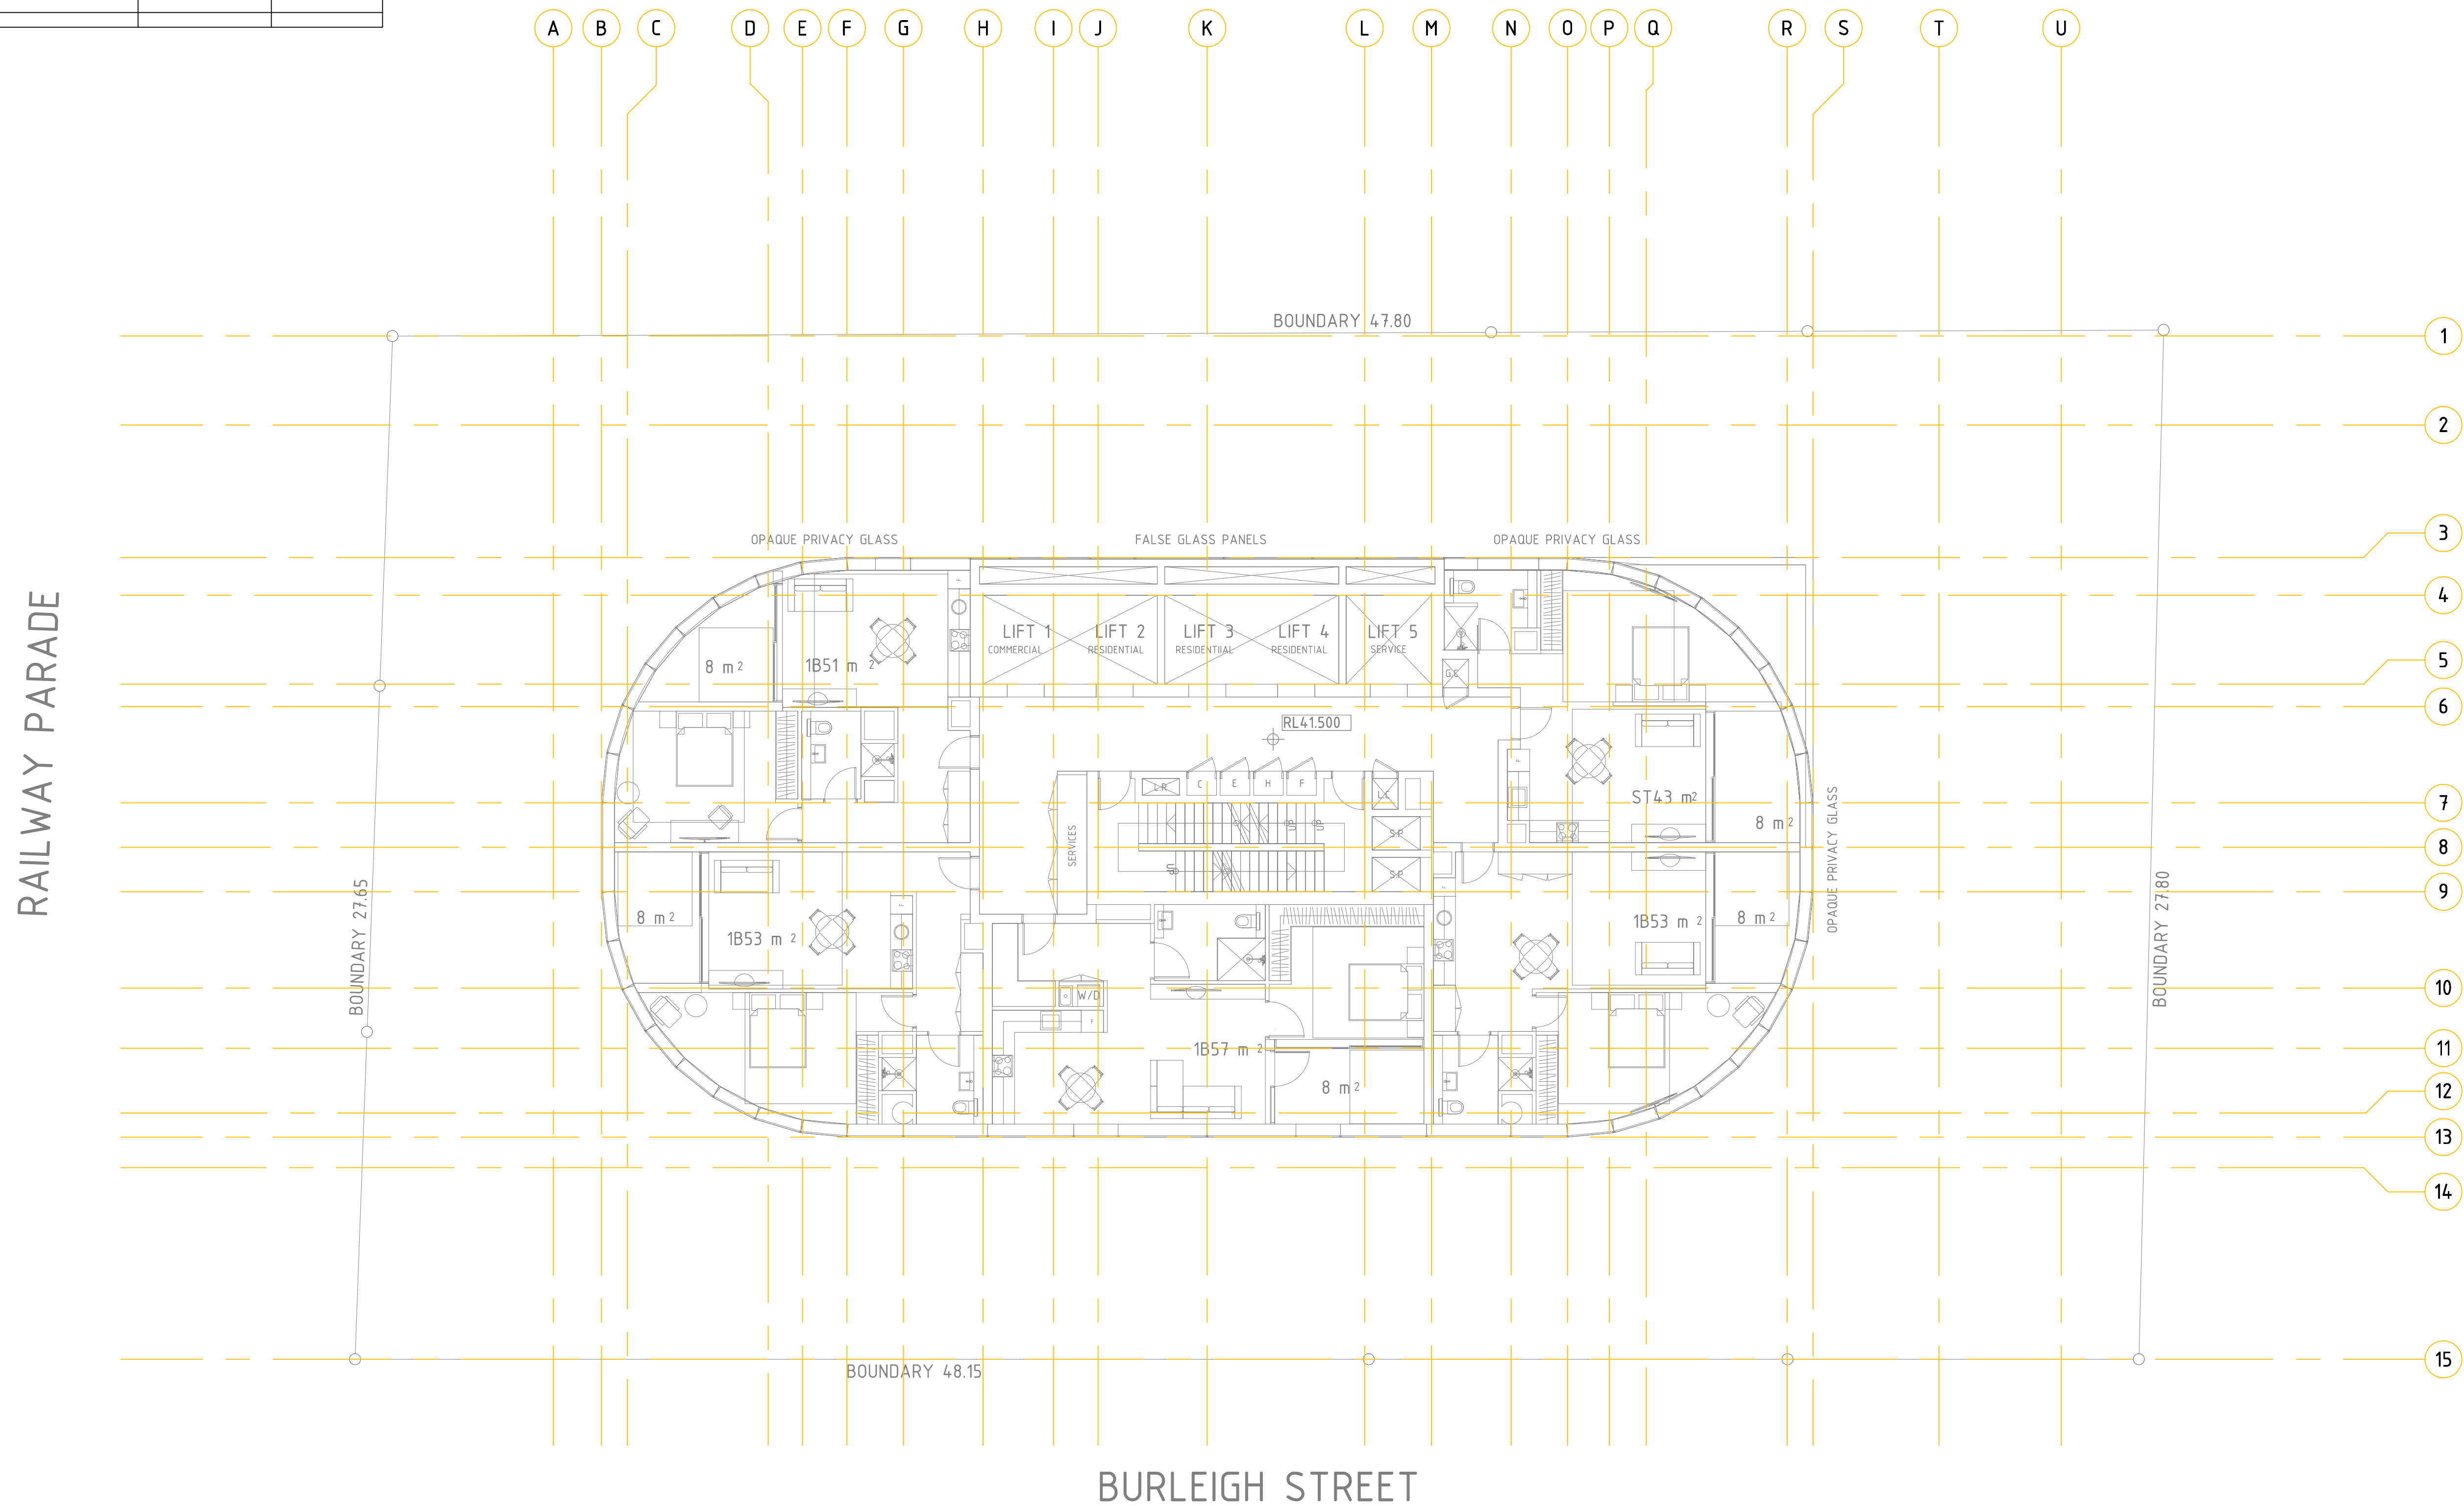
Revision

D1 

PI

PRELIMINARY ISSUE



[illegible]

REFER TO LEVEL 3 FOR TYPICAL LAYOUT



Client



Architect

[illegible]

Project
**BTR & AFFORDABLE HOUSING
+ COMMERCIAL OFFICE
DEVELOPMENT**

2-4 BURLEIGH ST & 20-24
RAILWAY PDE, BURWOOD

Drawing Title
CO-ORDINATION SET
LEVEL 9
SPATIAL
LAYOUT

Project No. 24021

Drawing No. **000000**

Scale @ A1:	1:100
-------------	-------

Chk:	M.A.
------	------

Drn:	M.A.
------	------

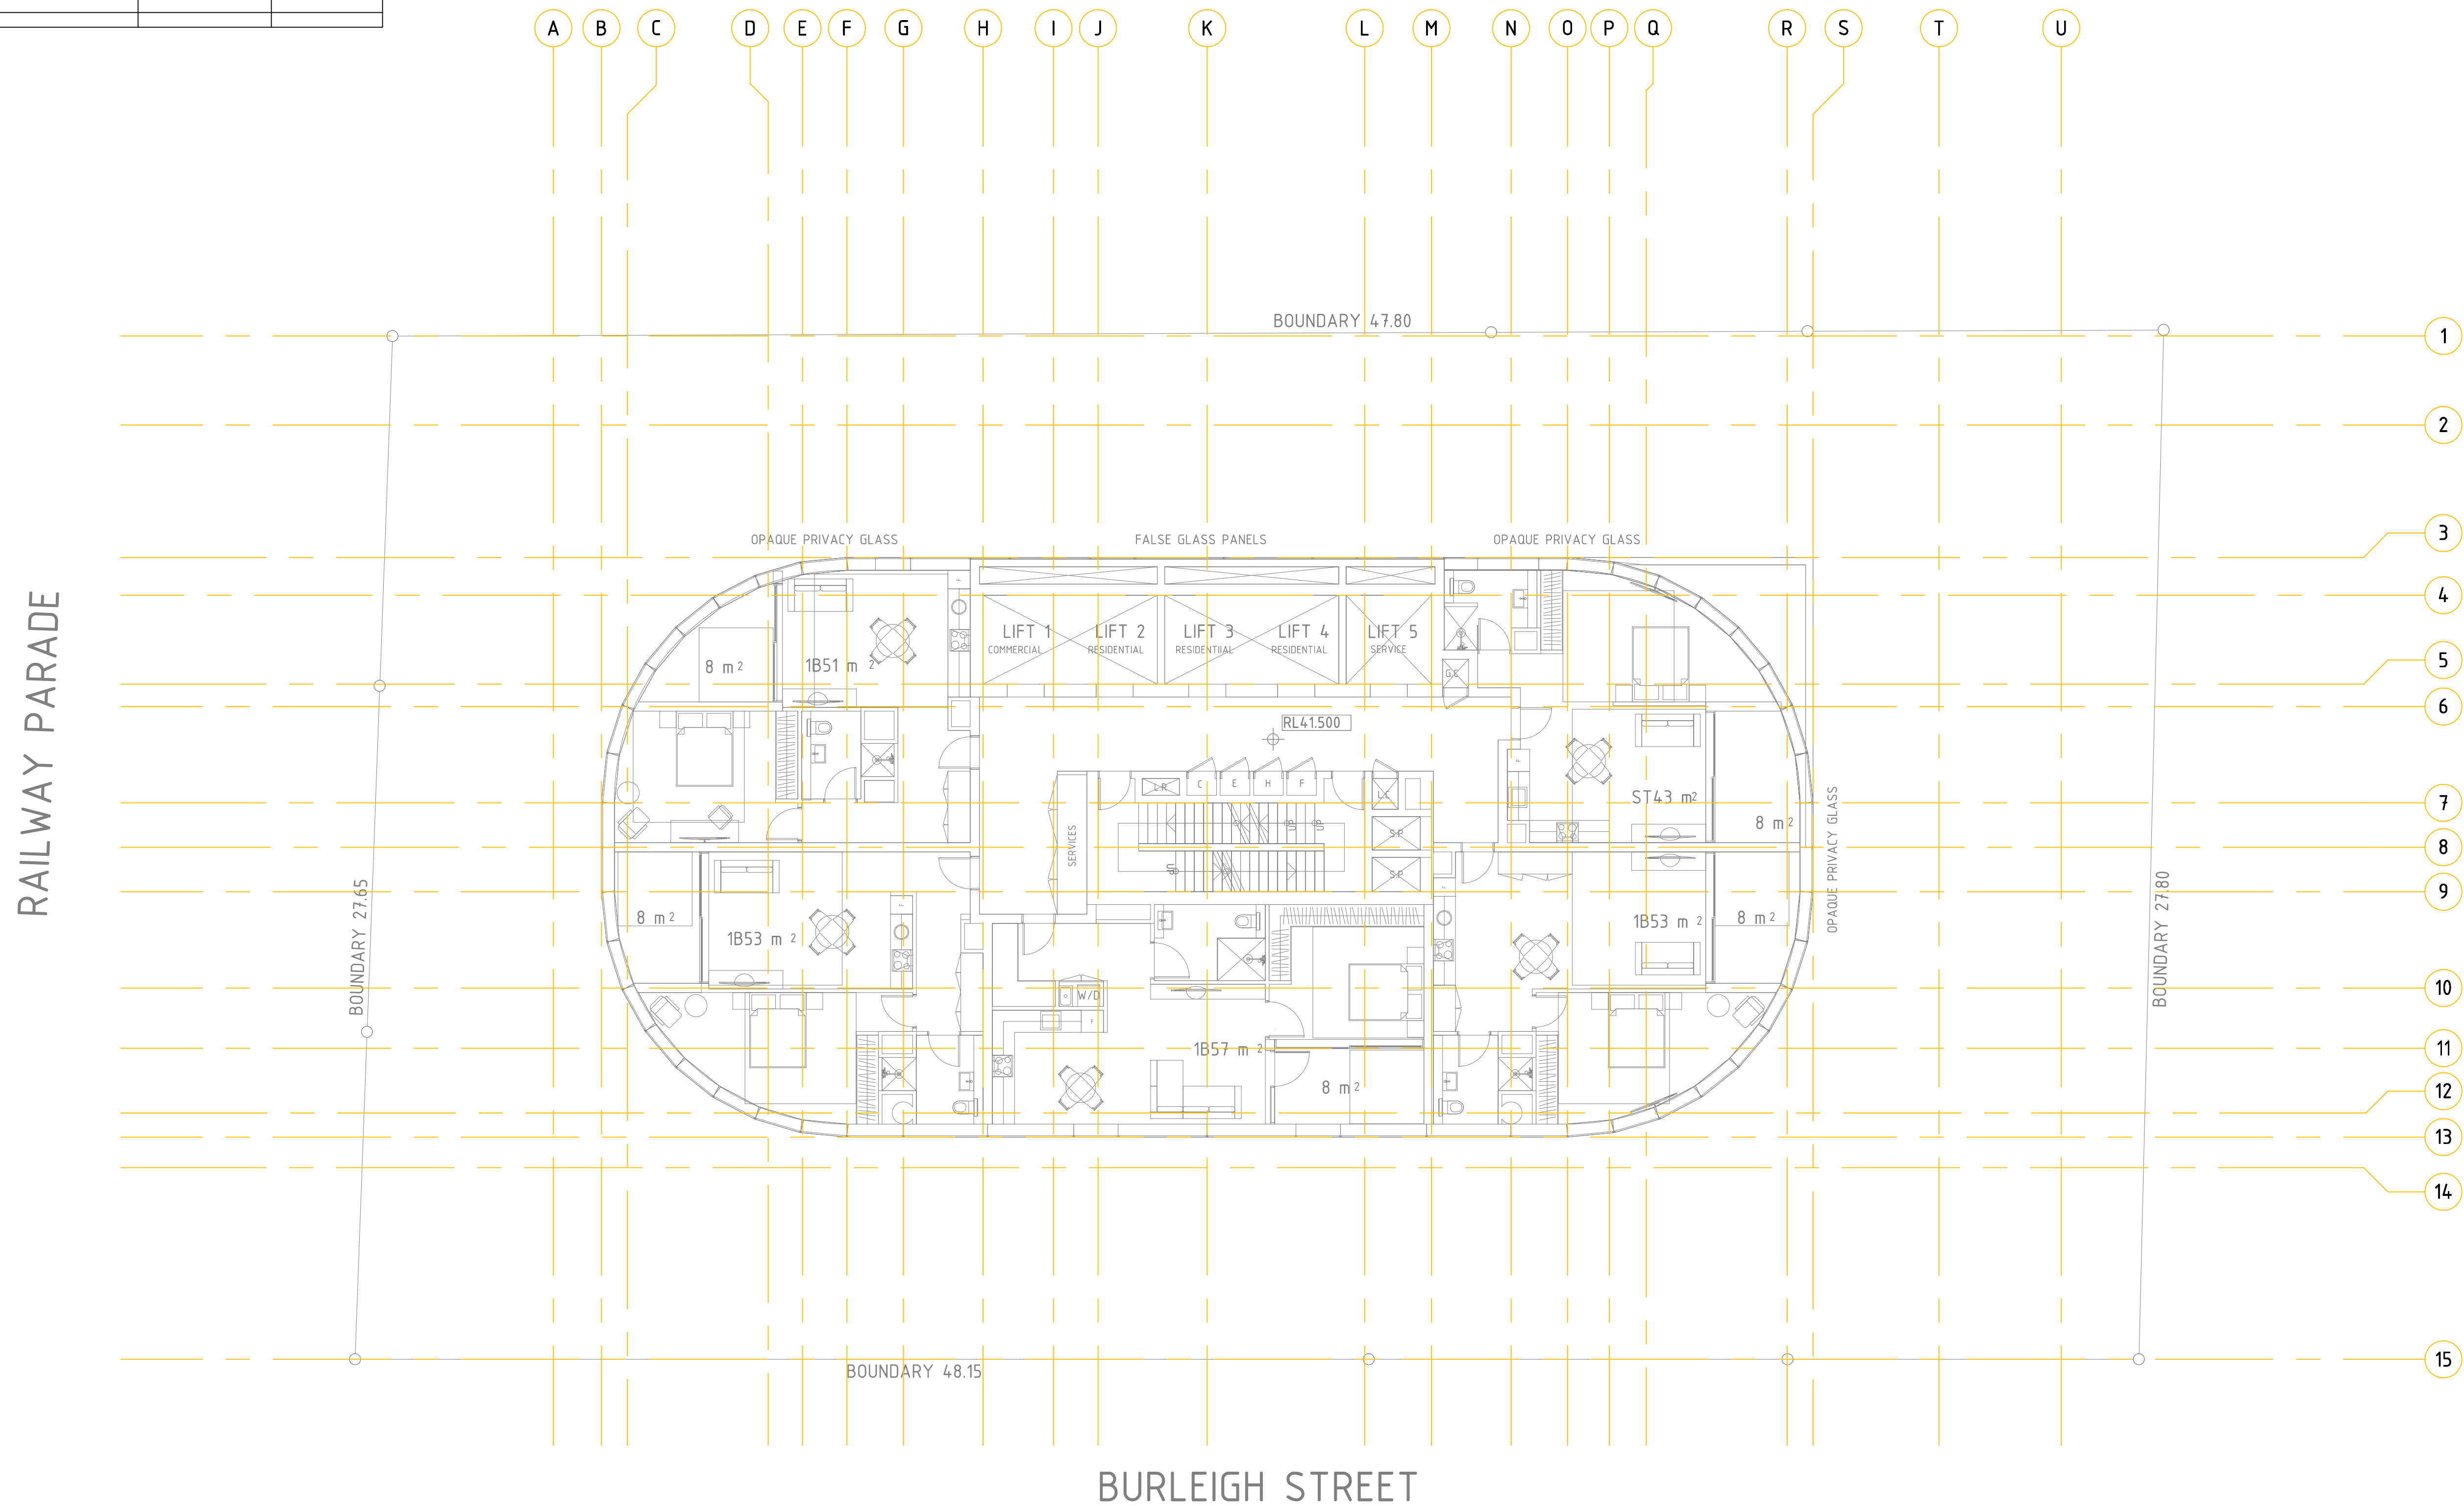
North

Revision

D1

PI

PRELIMINARY ISSUE

[illegible]

REFER TO LEVEL 3 FOR TYPICAL LAYOUT



Client



Architect

[illegible]

Project
**BTR & AFFORDABLE HOUSING
+ COMMERCIAL OFFICE
DEVELOPMENT**

2-4 BURLEIGH ST & 20-24
RAILWAY PDE, BURWOOD

Drawing Title
CO-ORDINATION SET
LEVEL 13
SPATIAL
LAYOUT

Project No. 24021

Drawing No. 0440

Scale @ A1:	1:100
-------------	-------

Chk:	M.A.
------	------

Drn:	M.A.
------	------

Date: FEB 2024

0	North
---	-------

A.

4

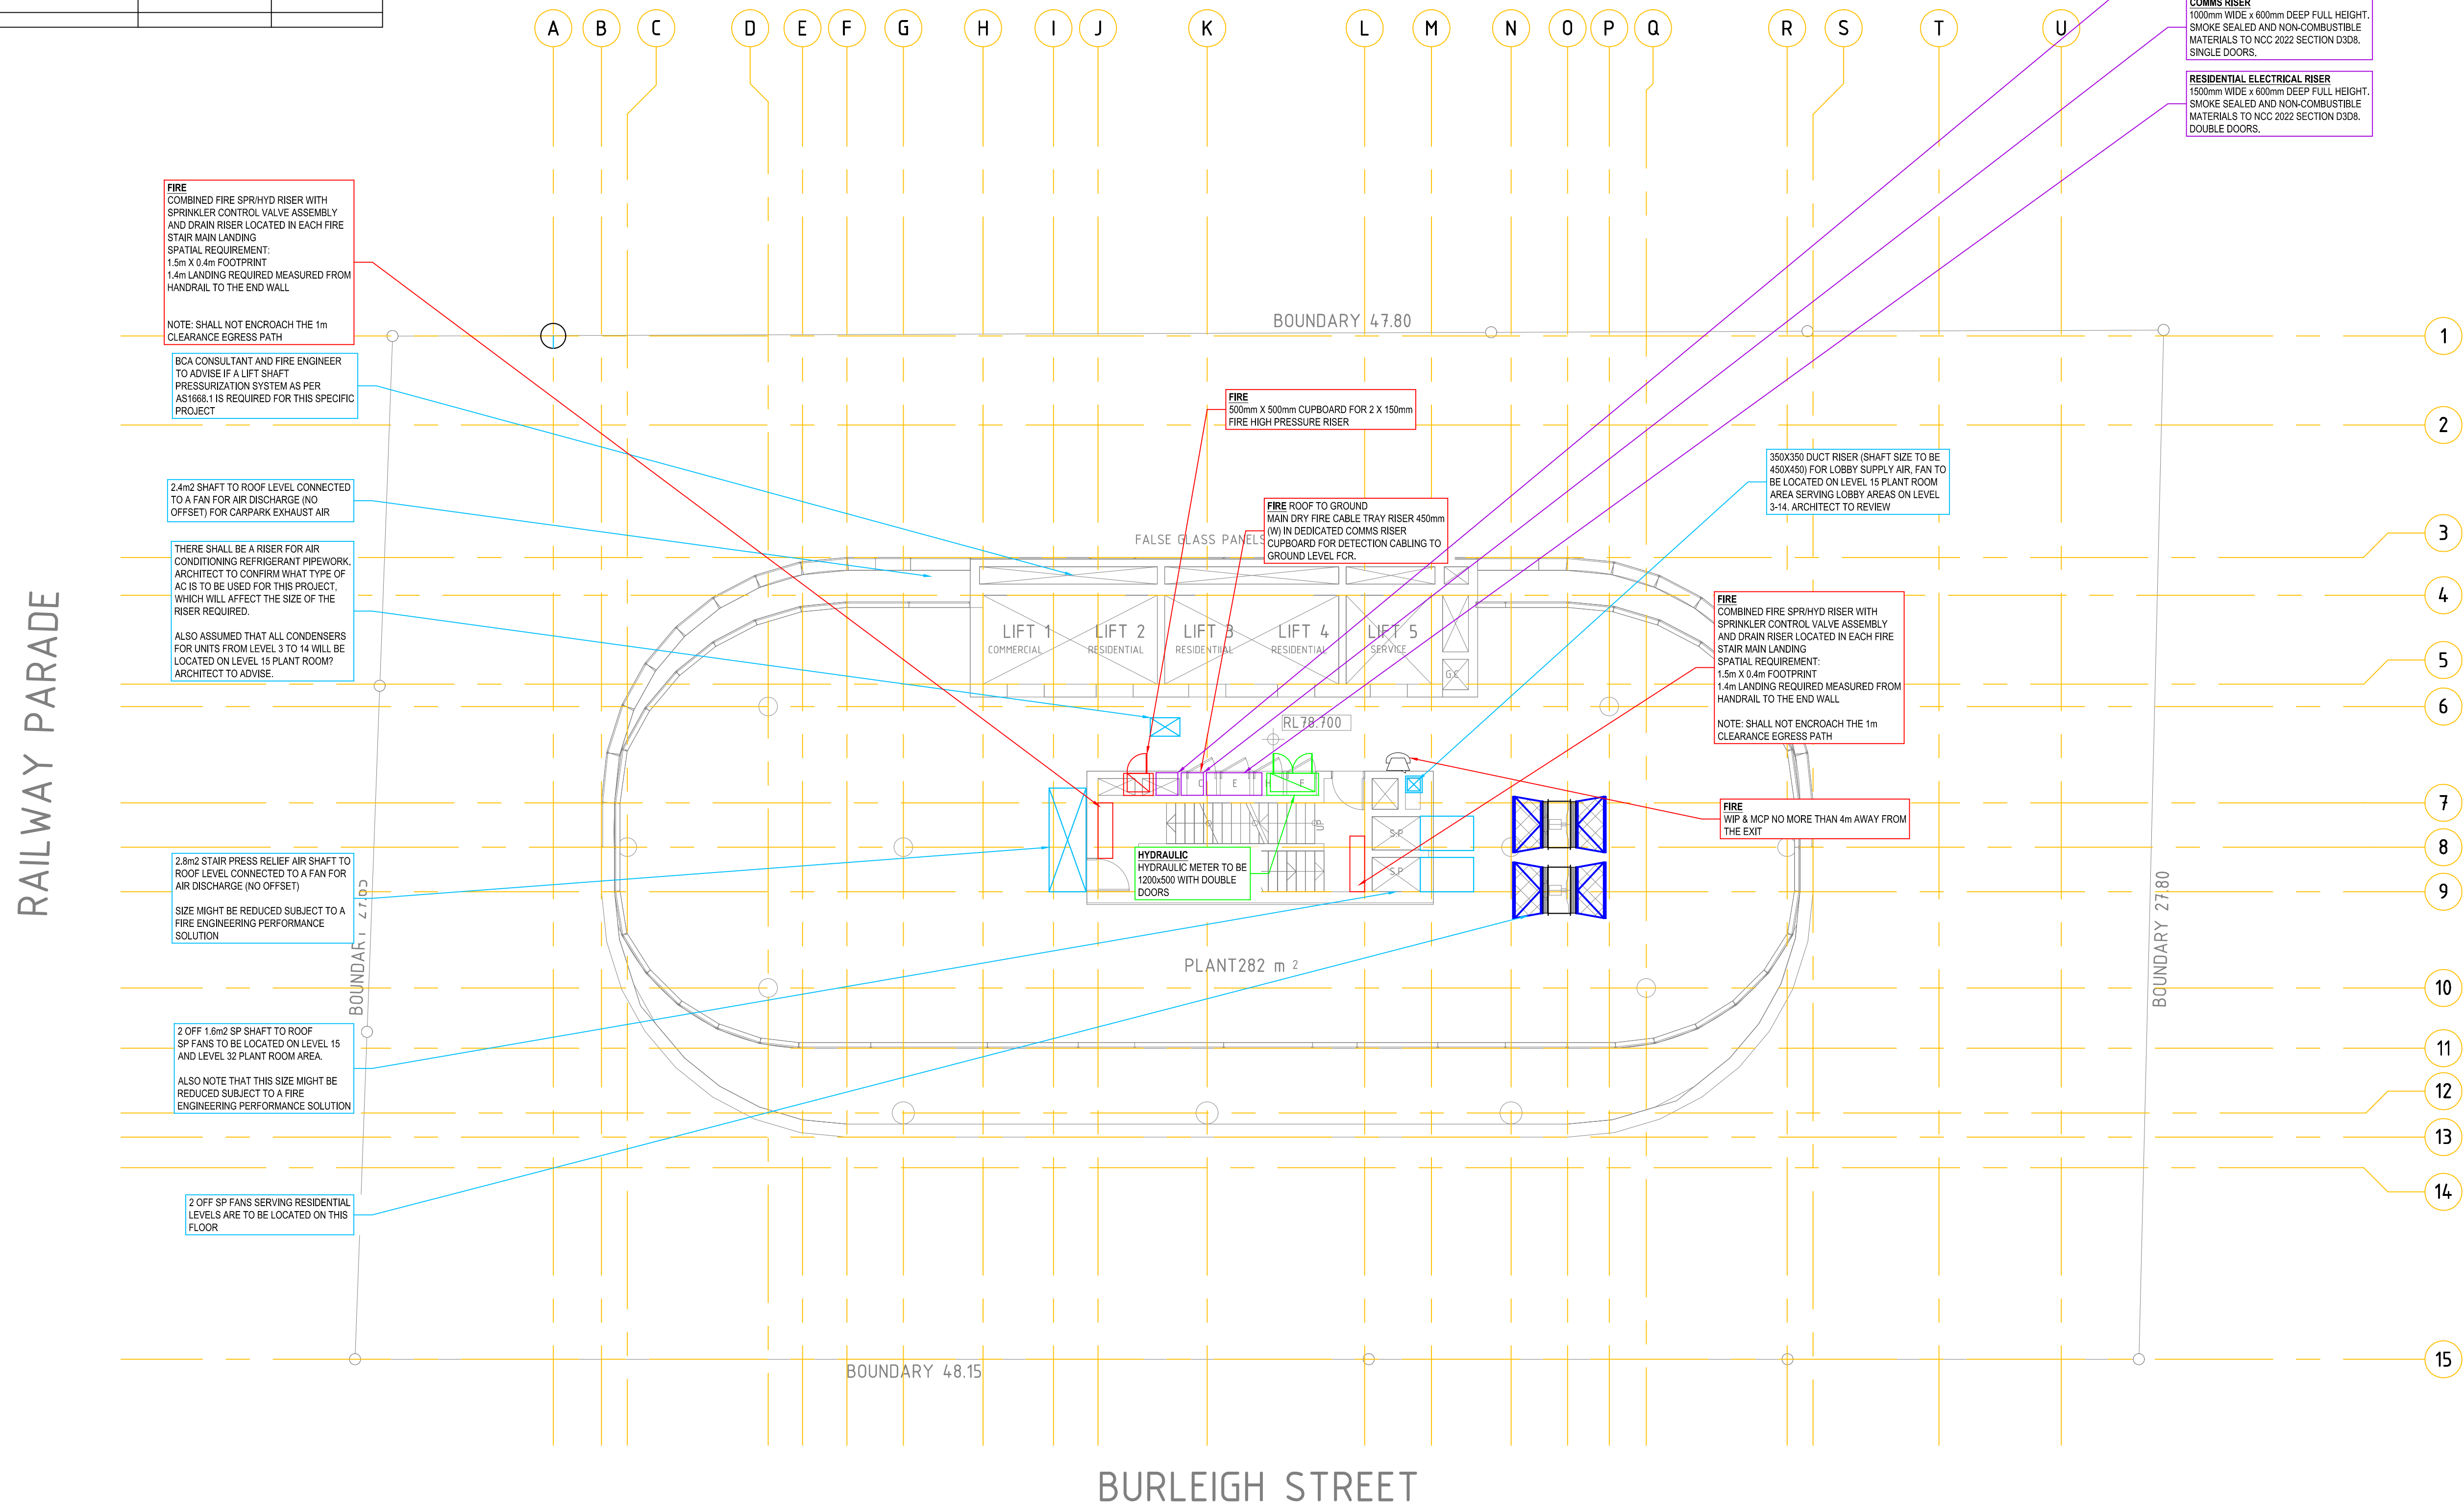
Revision

D1

PI

100

PRELIMINARY ISSUE

[illegible]

Client



Architect

[illegible]

Project
**BTR & AFFORDABLE HOUSING
+ COMMERCIAL OFFICE
DEVELOPMENT**

2-4 BURLEIGH ST & 20-24
RAILWAY PDE, BURWOOD

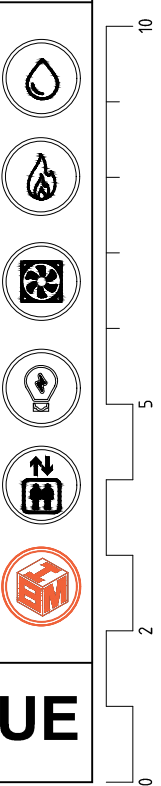
Drawing Title
CO-ORDINATION SET
LEVEL 15
SPATIAL
LAYOUT

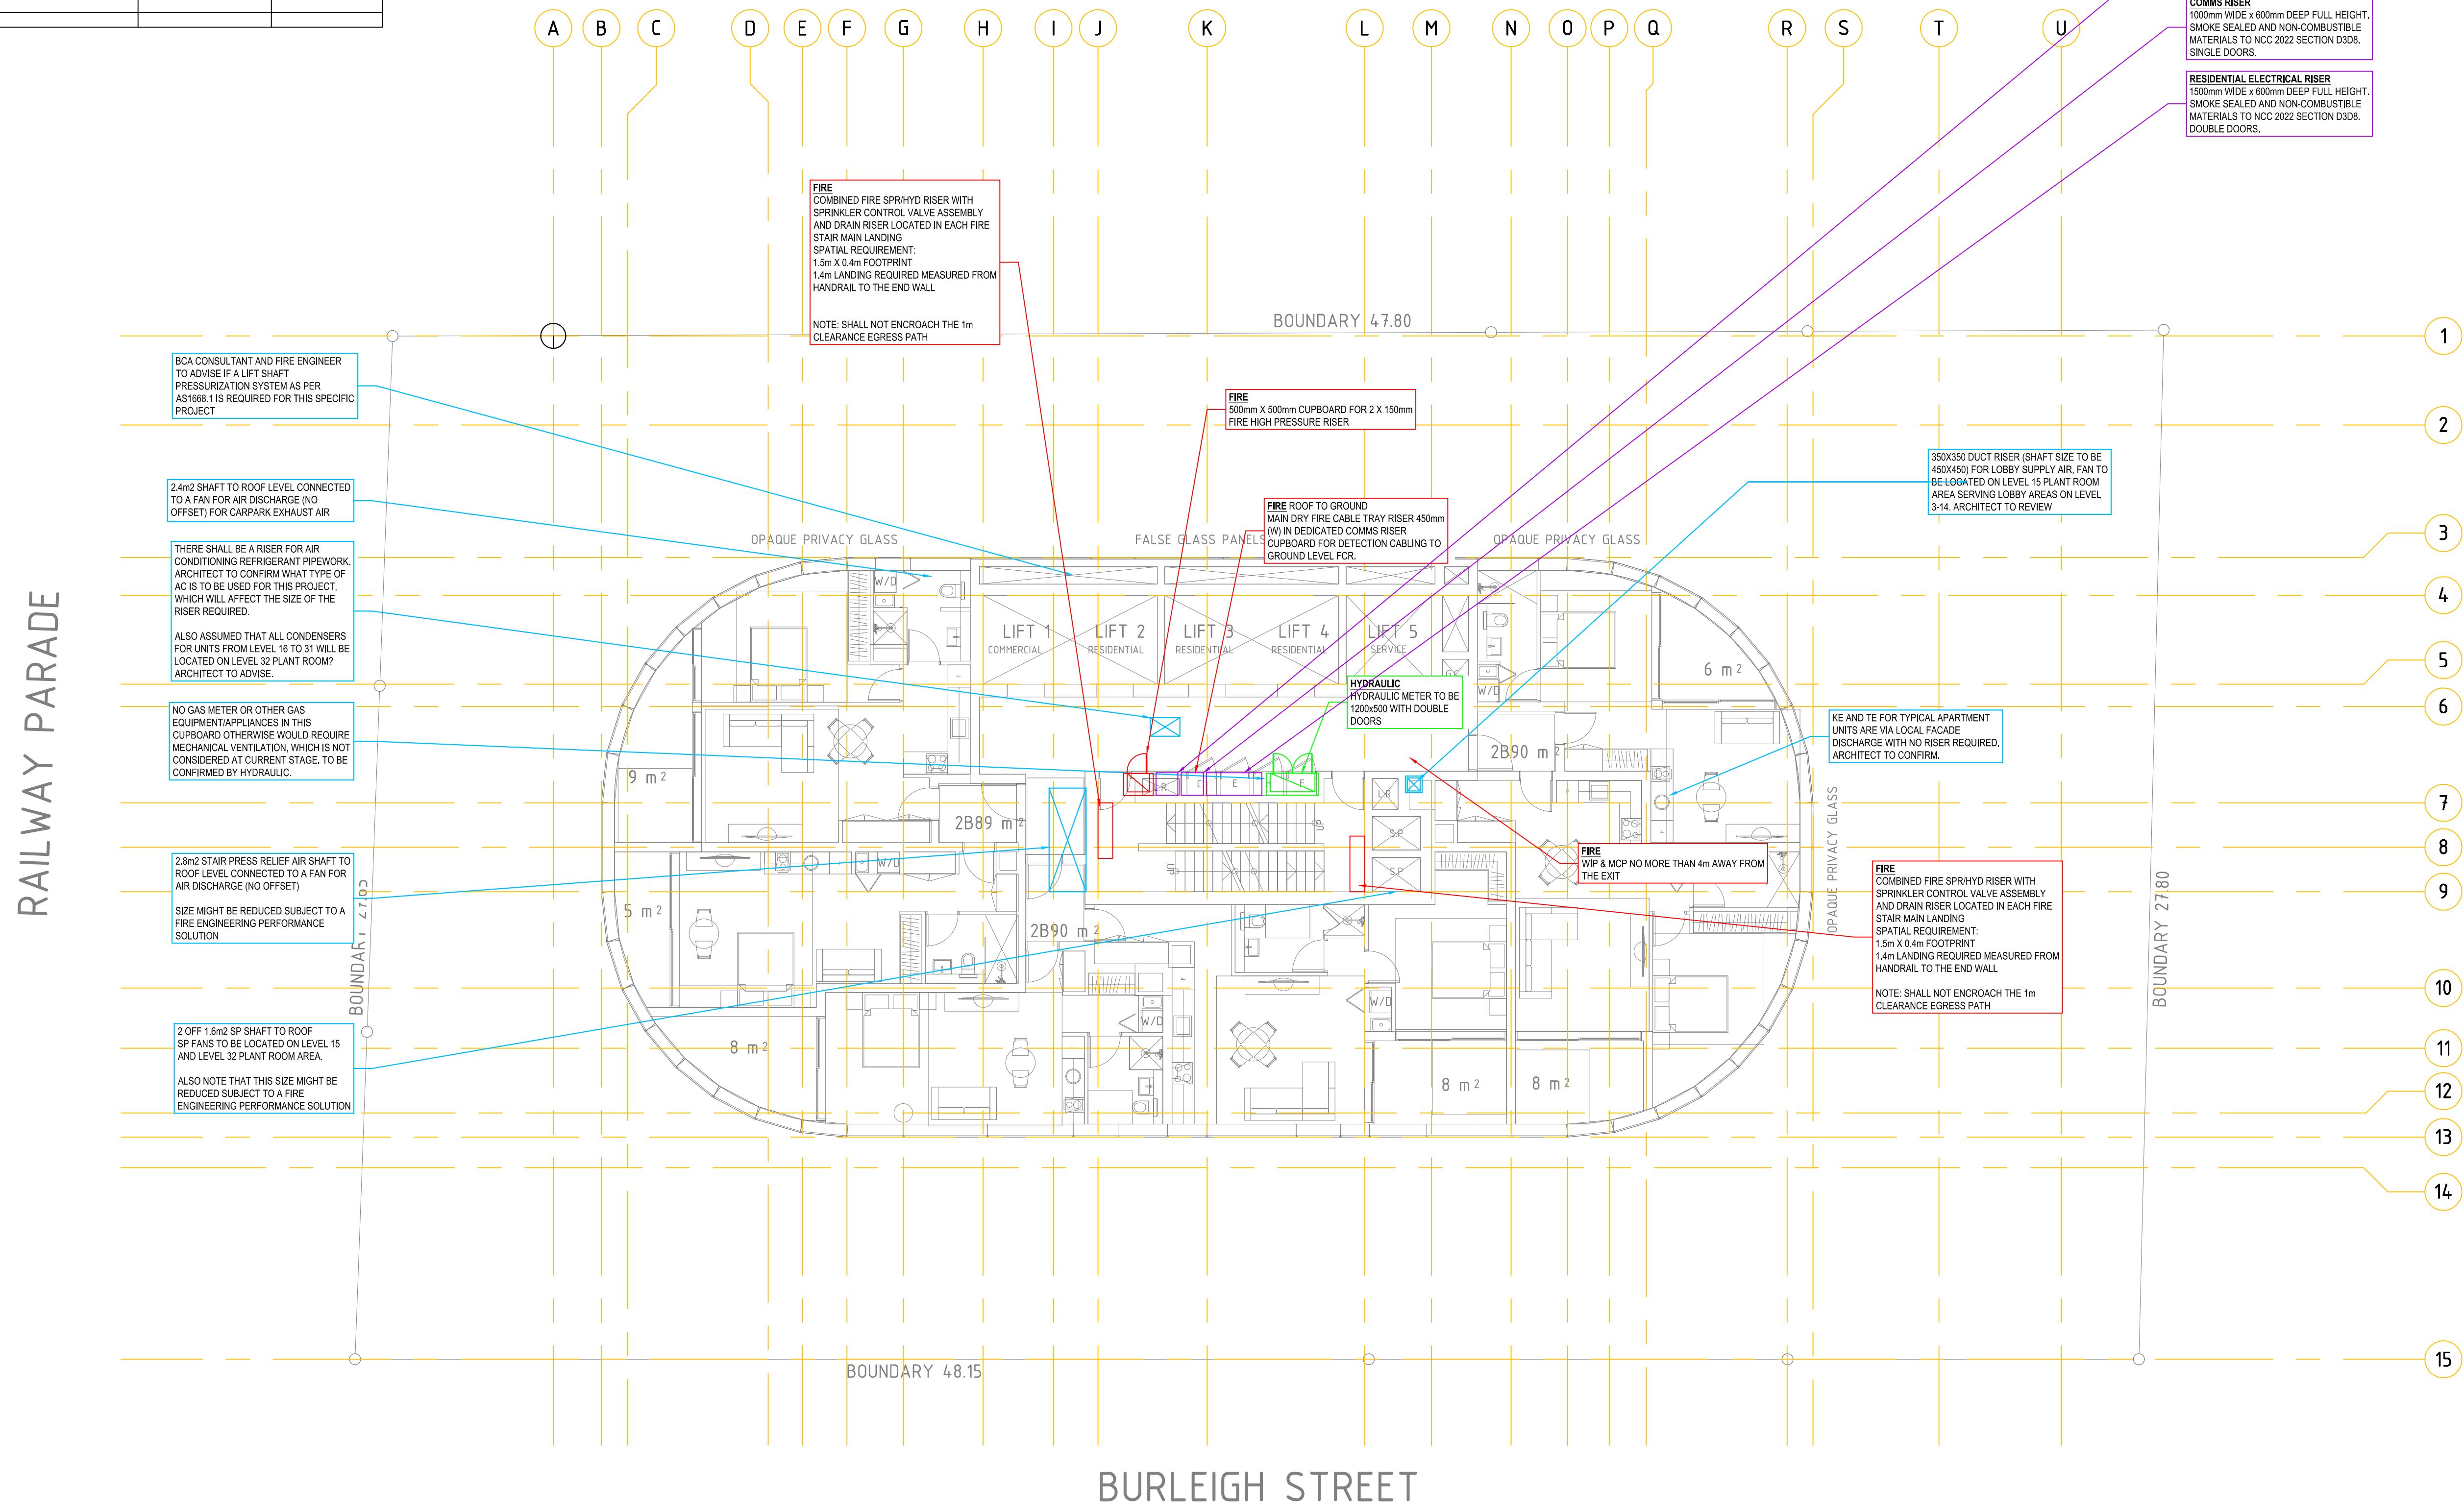
Project No. 24021

Drawing No. **C120**

Scale @ A1:	1:100	North	Revision
Chk:	M.A.		P1
Drn:	M.A.		
Date:	FEB 2024		

PRELIMINARY ISSUE



[illegible]

DRAWING SHOWN FOR LEVEL 16 IS TYPICAL FOR LEVEL 17-31 (ARCHITECT TO CONFIRM)



Client



Architect

[illegible]

Project
**BTR & AFFORDABLE HOUSING
+ COMMERCIAL OFFICE
DEVELOPMENT**

2-4 BURLEIGH ST & 20-24
RAILWAY PDE, BURWOOD

Drawing Title
CO-ORDINATION SET
LEVEL 16
SPATIAL
LAYOUT

Project No. 24021

Drawing No. **C121**

Scale @ A1:	1:100
-------------	-------

Chk:	M.A.
------	------

Drn:	M.A.
Date:	FEB 2024

North



Revision

D1

Pf

PRELIMINARY ISSUE

[illegible]

ZONE SMOKE CONTROL TO BE DELETED BY FIRE
ENGINEERING SOLUTION AND THEREFORE IS NOT
CONSIDERED IN THIS SPATIAL MARK-UP



Client



Architect

[illegible]

Project
**BTR & AFFORDABLE HOUSING
+ COMMERCIAL OFFICE
DEVELOPMENT**

2-4 BURLEIGH ST & 20-24
RAILWAY PDE, BURWOOD

Drawing Title
CO-ORDINATION SET
LEVEL 34
SPATIAL
LAYOUT

Project No. 24021

Drawing No. **C139**

Scale @ A1: 1:100

Scale @ A1: 1:100

Scale @ 111	1.100
Chk:	M.A.

Drn:	M.A.
------	------

Date: FEB 2024

North	
-------	--

[illegible]

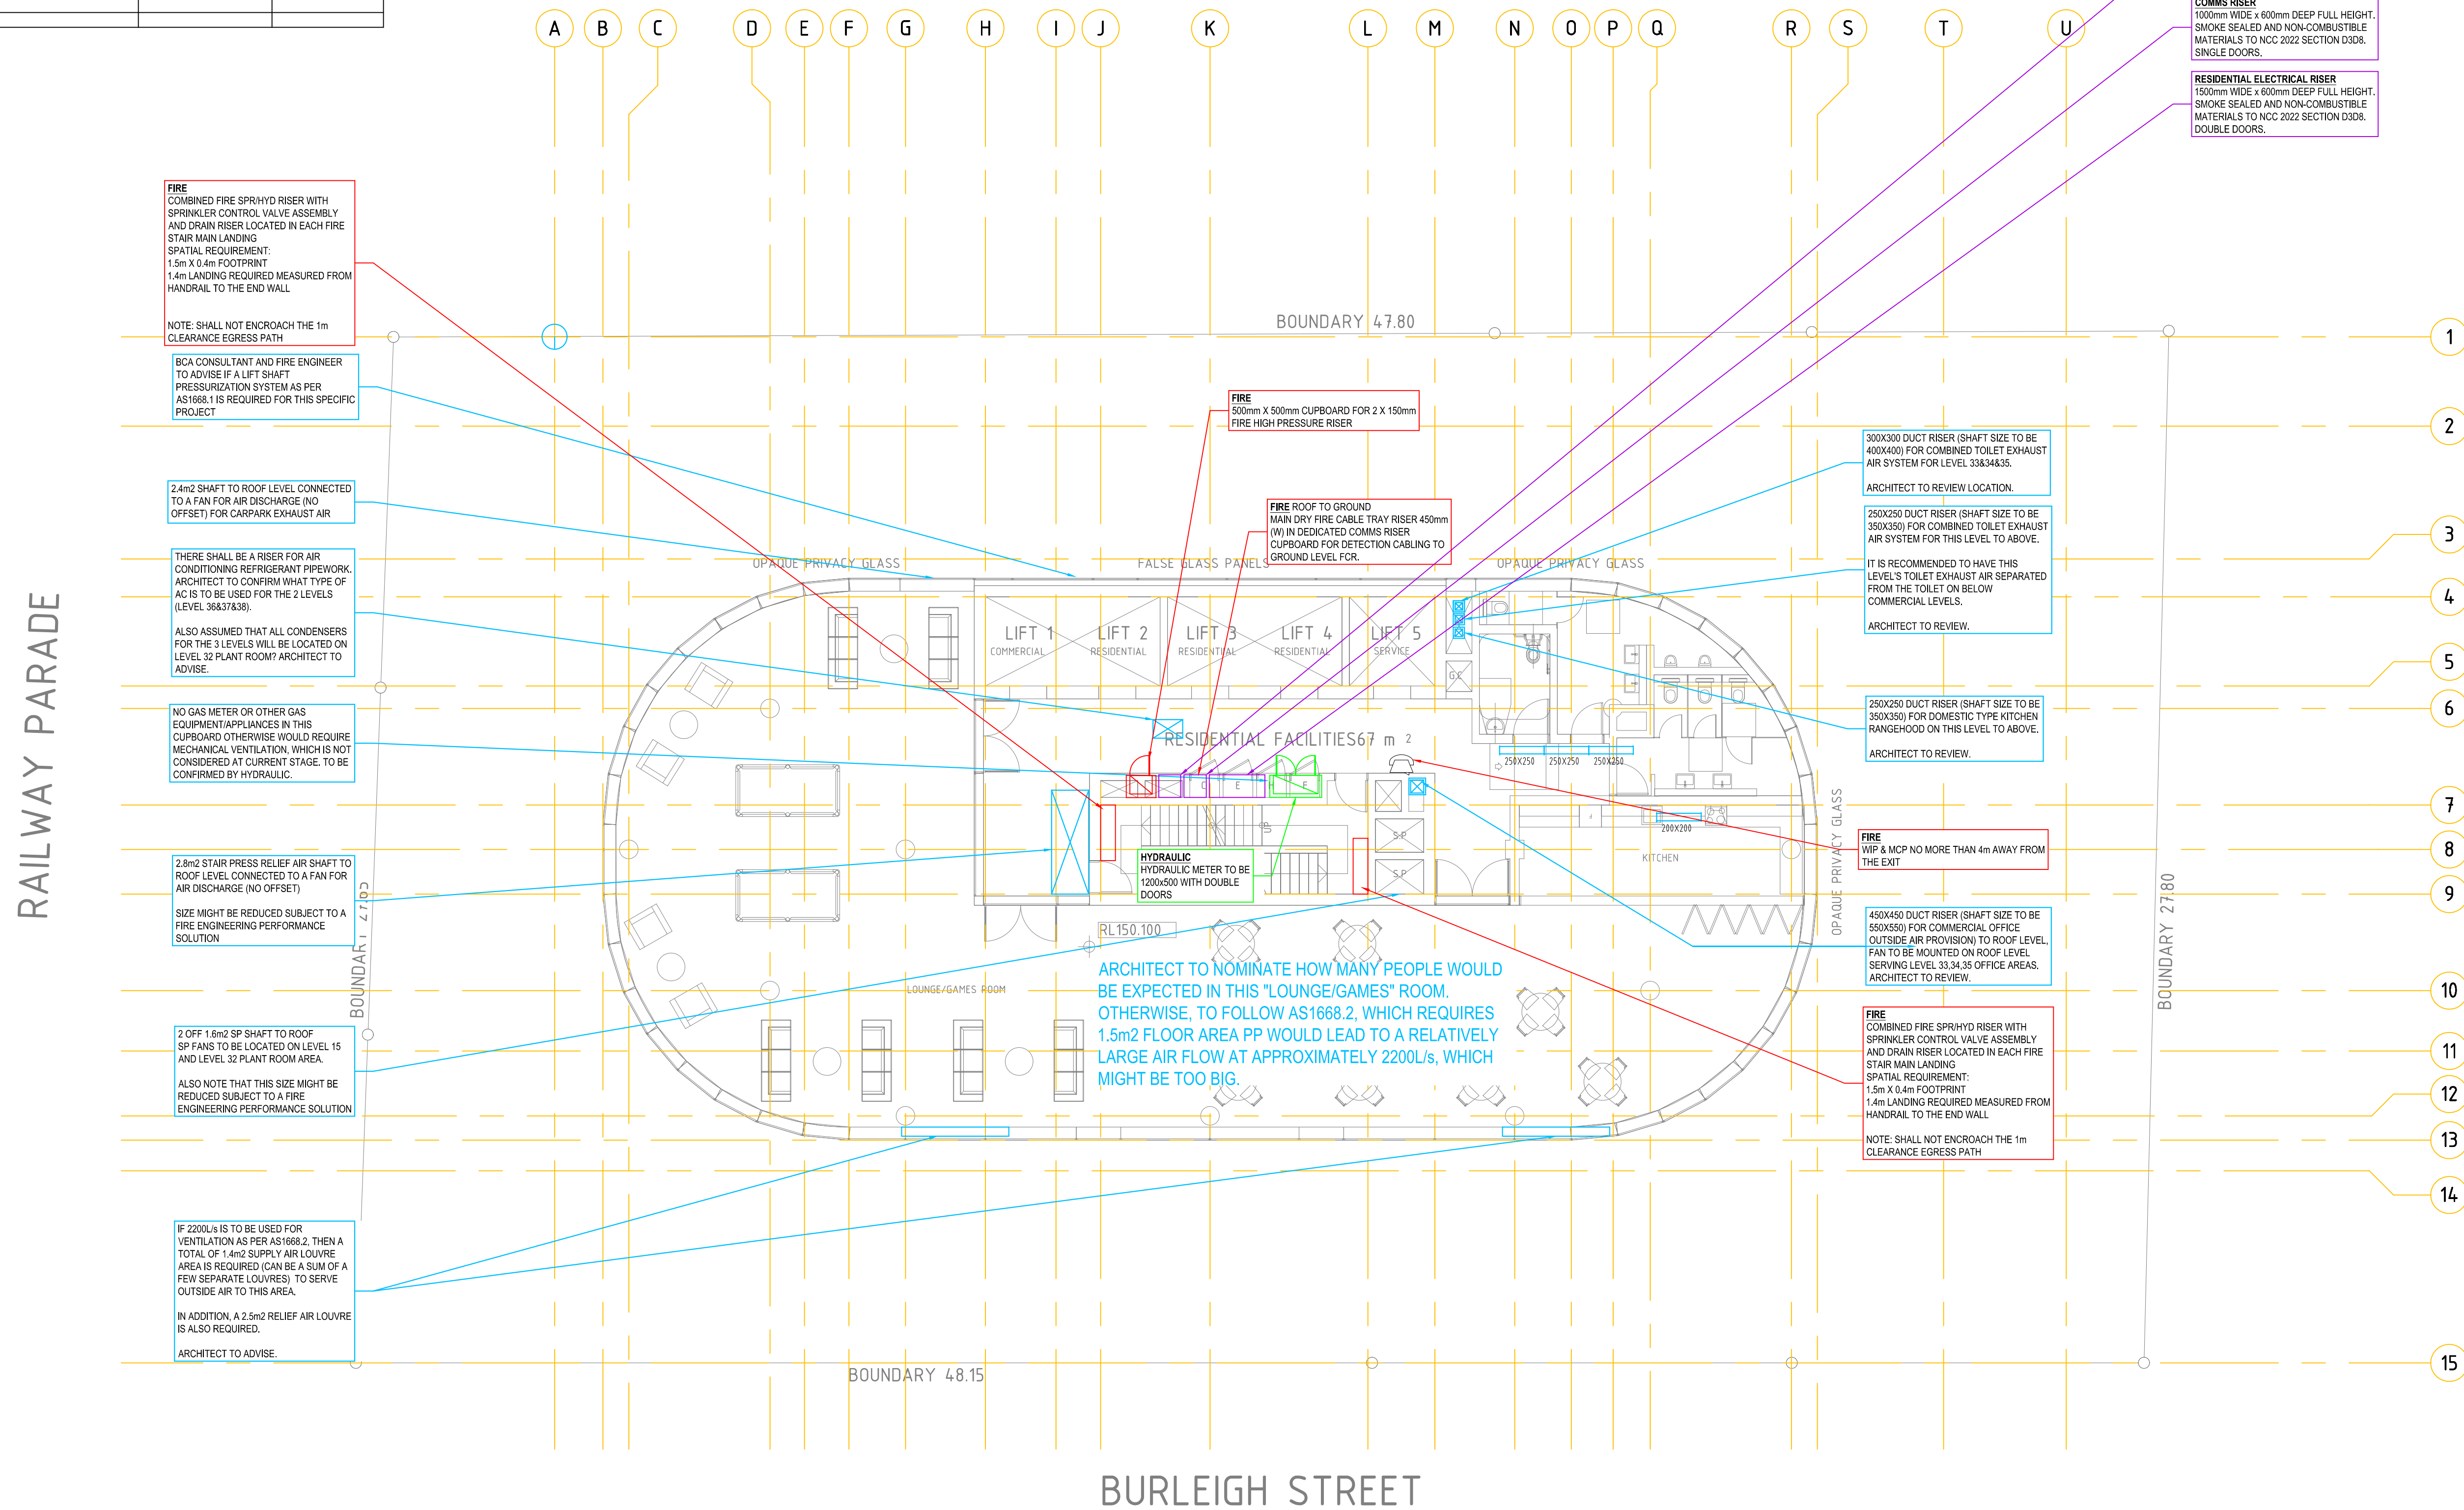
Revisio

D1

P1

--	--

PRELIMINARY ISSUE

[illegible]

Client



Architect

[illegible]

Project
**BTR & AFFORDABLE HOUSING
+ COMMERCIAL OFFICE
DEVELOPMENT**

2-4 BURLEIGH ST & 20-24
RAILWAY PDE, BURWOOD

Drawing Title
CO-ORDINATION SET
LEVEL 36
SPATIAL
LAYOUT

Project No. 24021

Drawing No.

Scale @ A1:	1:100
-------------	-------

Chk:	M.A.
------	------

Drn:	M.A.
------	------

Date: FEB 2024

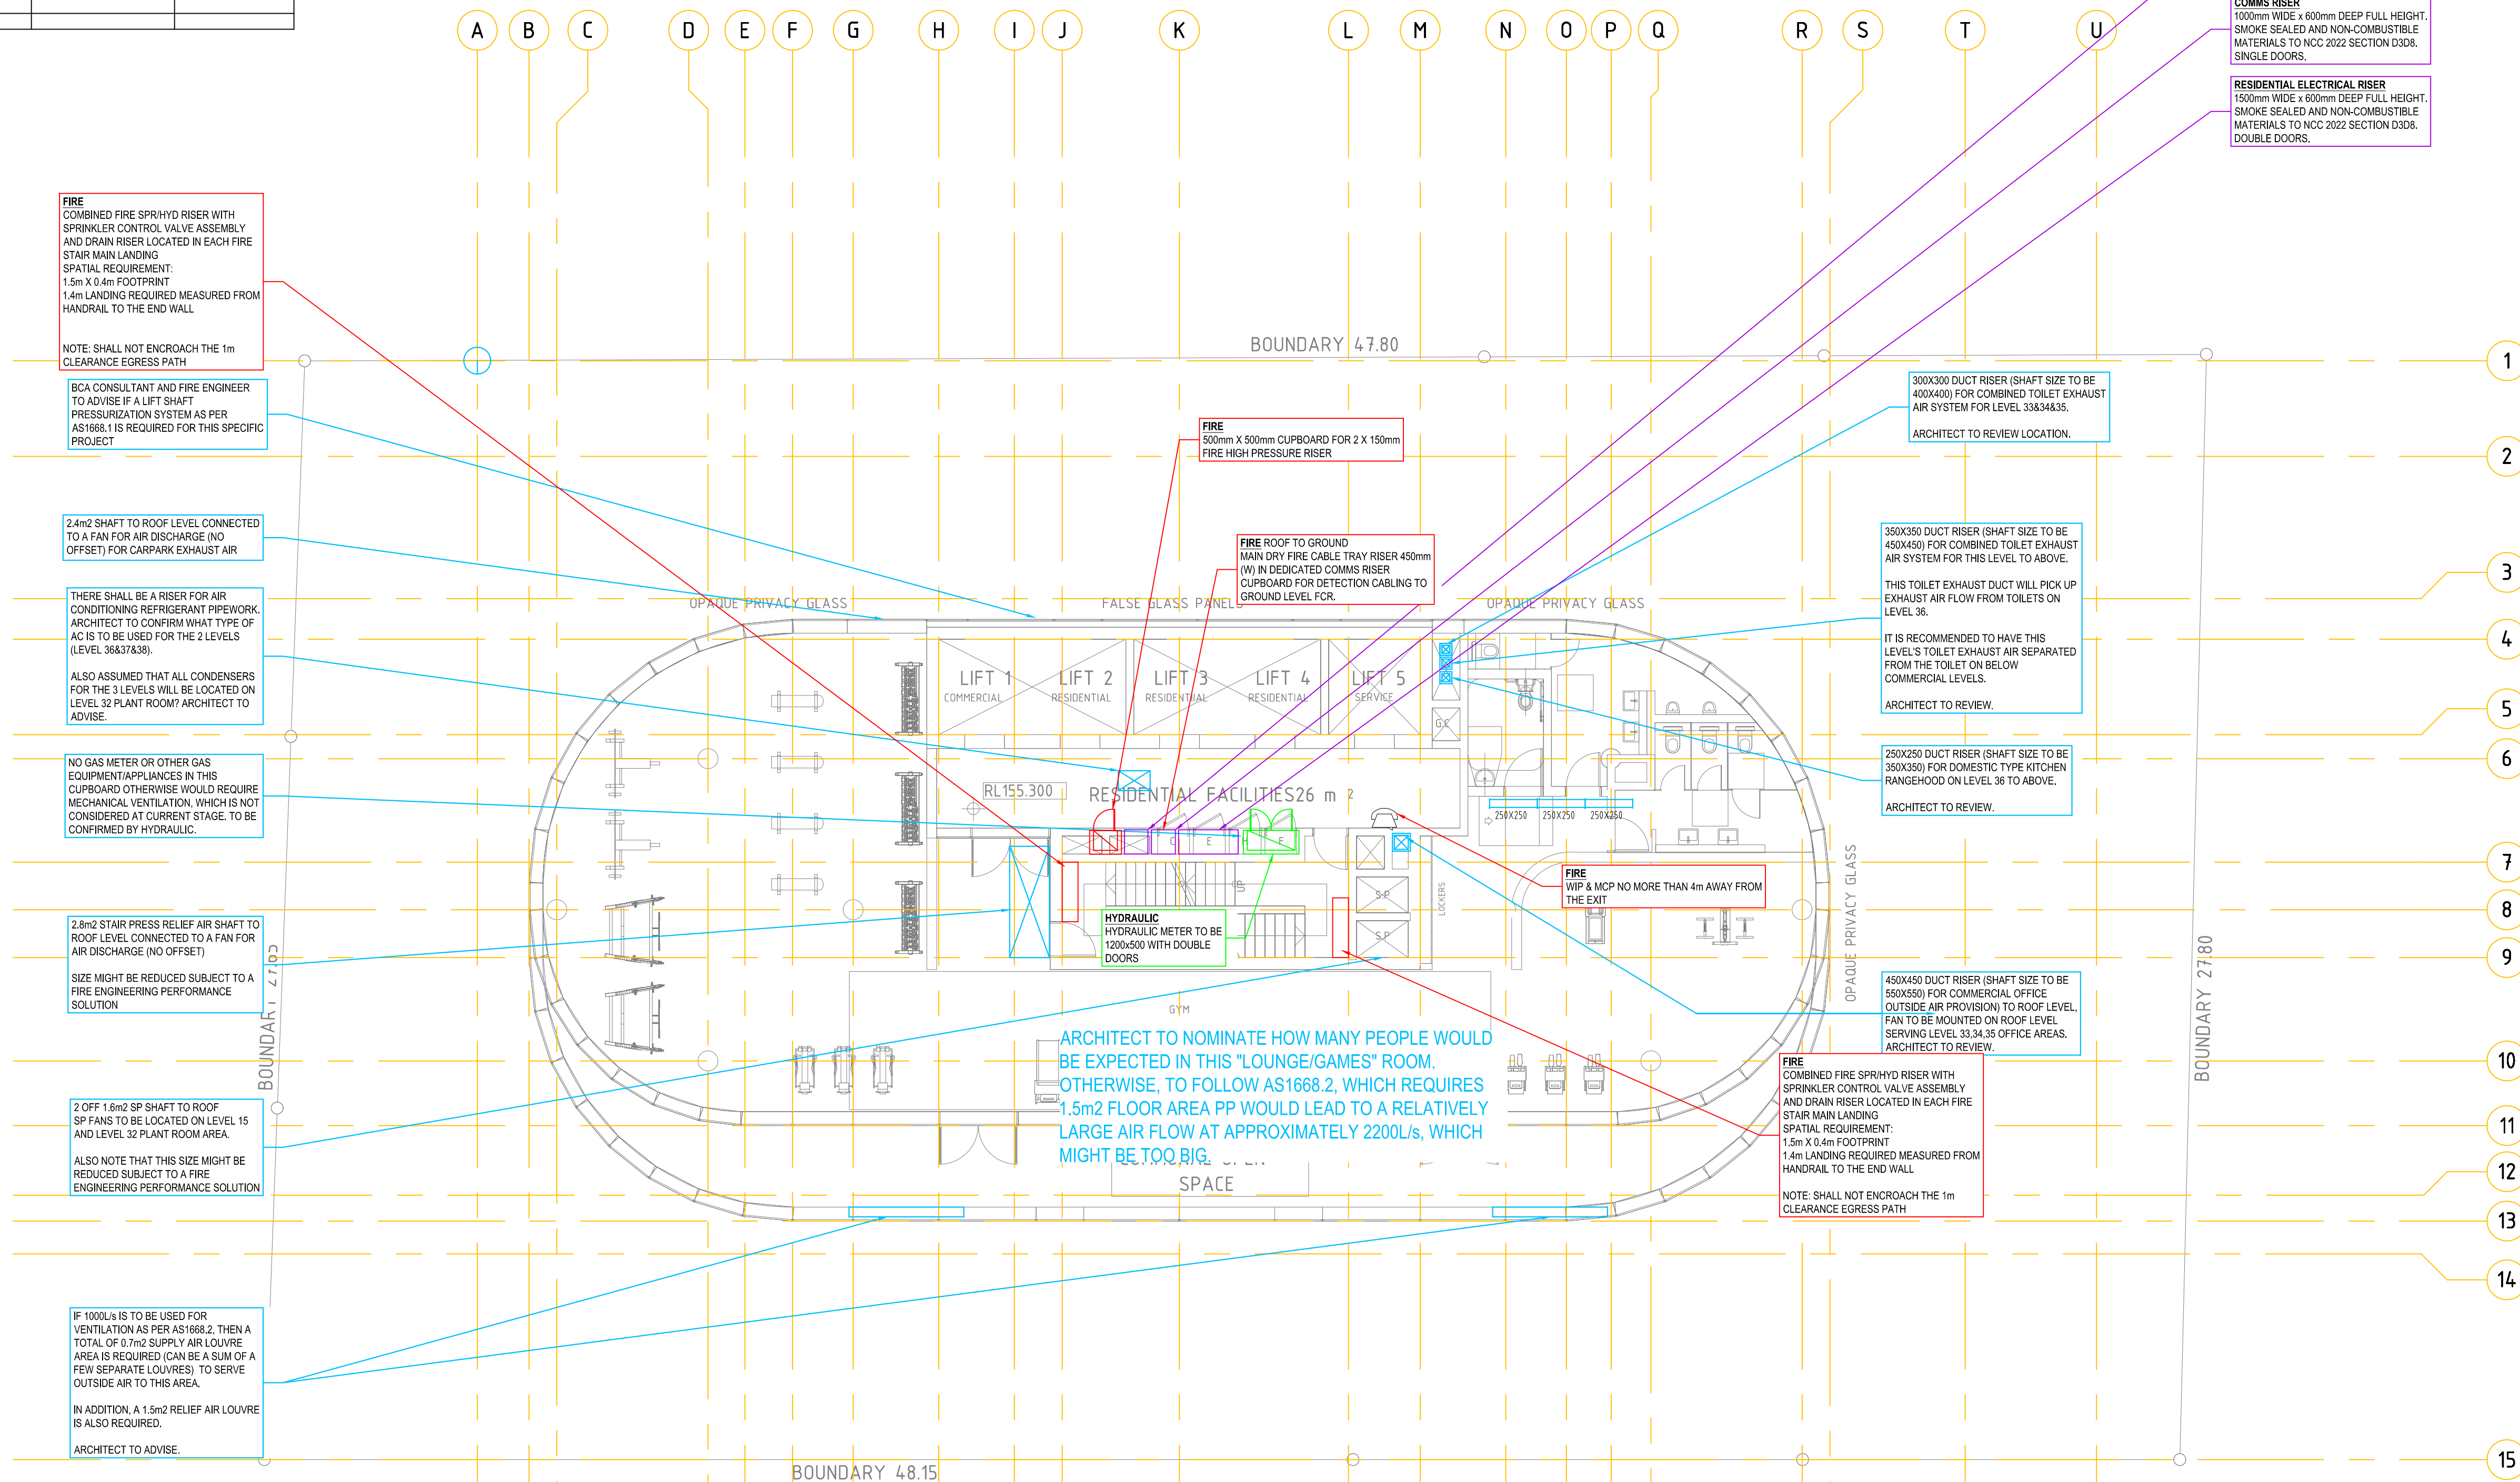
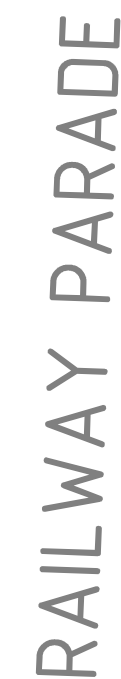
North	Revision
-------	----------

D1

	PI
---	-----------

4		
---	---	--

PRELIMINARY ISSUE

[illegible]

Client



Architect

[illegible]

Project
**BTR & AFFORDABLE HOUSING
+ COMMERCIAL OFFICE
DEVELOPMENT**

2-4 BURLEIGH ST & 20-24
RAILWAY PDE, BURWOOD

Drawing Title
CO-ORDINATION SET
LEVEL 37
SPATIAL
LAYOUT

Project No. 24021

Drawing No.

Scale @ A1: 1:100

Scale @ 111	1.100
Chk:	M.A.

Drn:	M.A.
------	------

Date: FEB 2024

North

•

[illegible]

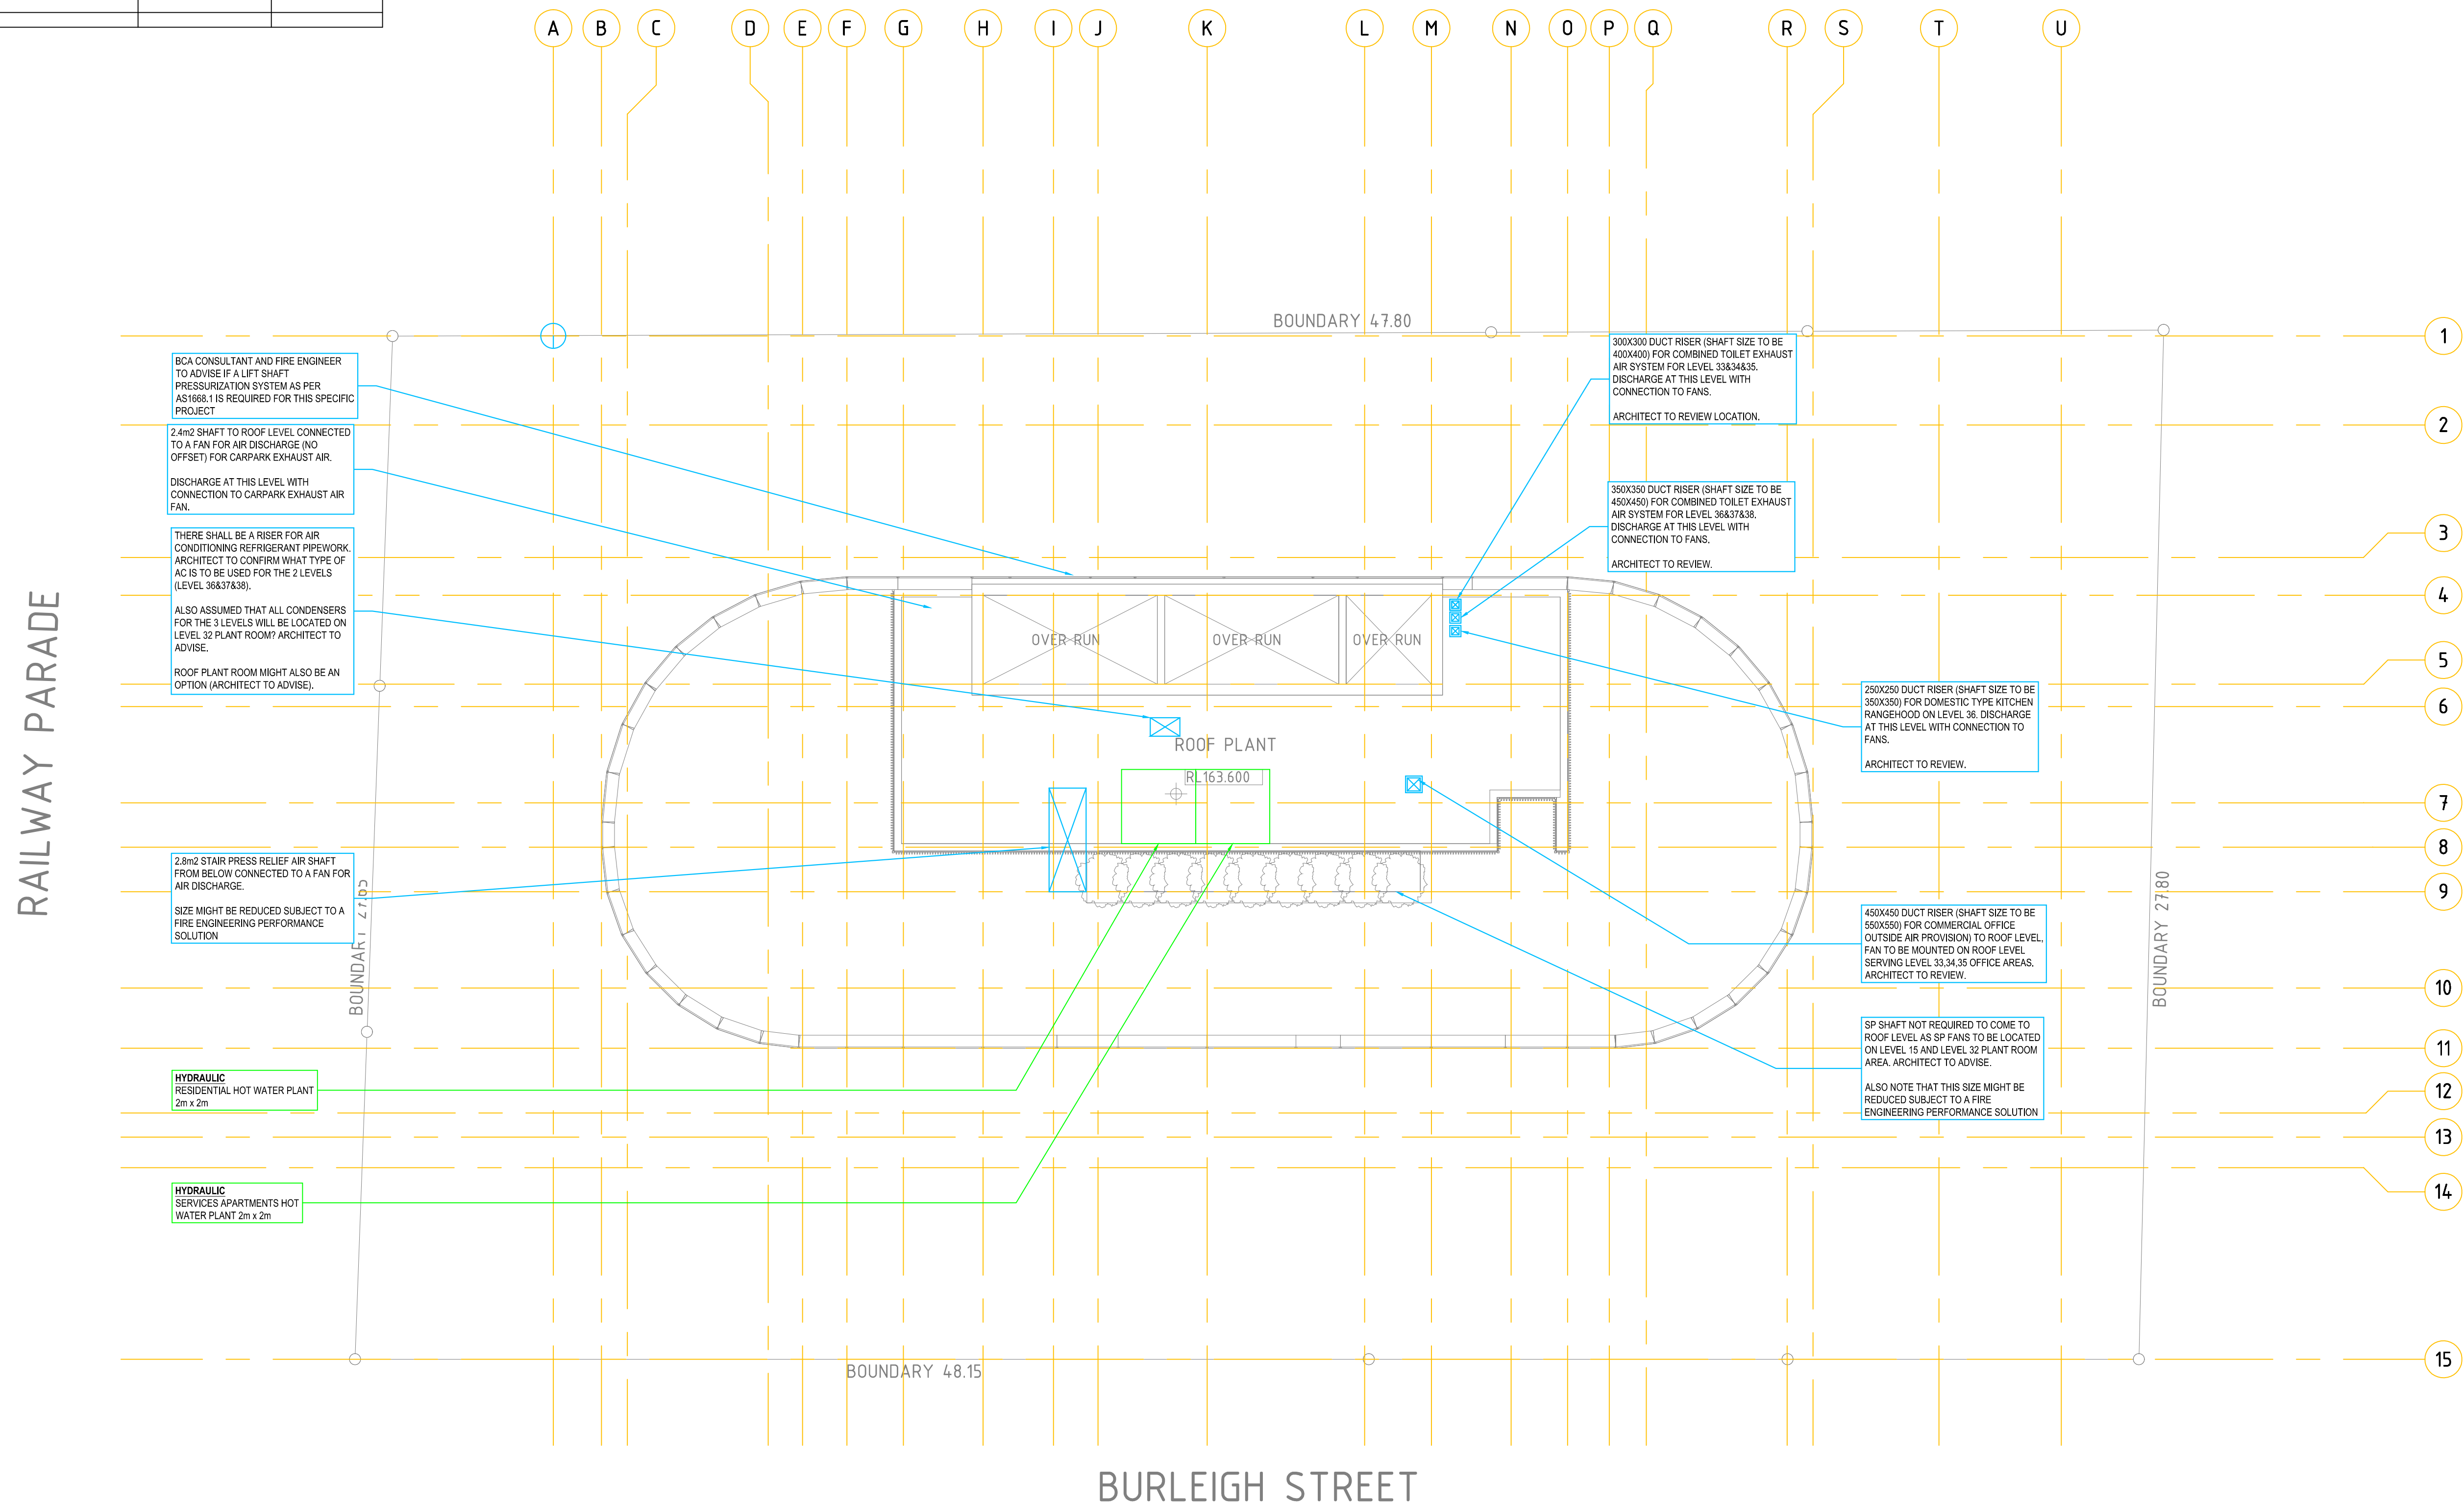
Revision

D1

P1

--	--

PRELIMINARY ISSUE

[illegible]

Client



Architect



Office: Level 2, 68 Sophia Street, Surry Hills NSW 2010
 • 61 2 9293 3880 | www.pjarchitecture.com.au
 Nominated Registered Architect Peter Israel (reg no 5084)

[illegible]

Project
**BTR & AFFORDABLE HOUSING
+ COMMERCIAL OFFICE
DEVELOPMENT**

2-4 BURLEIGH ST & 20-24
RAILWAY PDE, BURWOOD

Drawing Title
CO-ORDINATION SET
ROOF
SPATIAL
LAYOUT

Project No. 24021

Drawing No. **C144**

Scale @ A1: 1:100

Chk: M.A.

Drn: M.A.

North

Revision

D1

FI

--	--

PRELIMINARY ISSUE