

STANDARD NOTES

- THESE DRAWINGS SHALL BE READ IN CONJUNCTION WITH ALL ARCHITECTURAL AND OTHER CONSULTANT'S DRAWINGS AND SPECIFICATIONS AND SUCH OTHER WRITTEN INSTRUCTIONS AS MAY BE ISSUED DURING THE CONTRACT. ANY DISCREPANCY SHALL BE REFERRED TO THE ENGINEER BEFORE PROCEEDING WITH THE WORK.
- MATERIALS AND WORKMANSHIP SHALL BE IN ACCORDANCE WITH THE RELEVANT CODES AND AUTHORITY. THE CONTRACTOR SHALL COMPLY WITH ALL REGULATIONS OF AUTHORITIES HAVING JURISDICTION OVER THE WORKS.
- ALL DIMENSIONS SHALL BE VERIFIED ON-SITE. ALL DIMENSIONS NOTED ARE IN MILLIMETERS UNLESS NOTED OTHERWISE. ENGINEERS' DRAWINGS MUST NOT BE SCALED.
- ALL DIMENSIONS AND REDUCED LEVELS MUST BE VERIFIED ON-SITE BEFORE THE COMMENCEMENT OF ANY WORK. SUBSTITUTIONS MUST BE APPROVED BY THE ENGINEER. ALL LEVELS ARE FROM THE AUSTRALIAN HEIGHT DATUM.
- SERVICE INFORMATION SHOWN IS BASED ON PLANS GIVEN BY AUTHORITIES AND IS APPROXIMATE ONLY. BEFORE COMMENCEMENT OF ANY WORKS, THE CONTRACTOR SHALL LOCATE ALL UNDERGROUND SERVICES AND COMPLY WITH ALL REQUIREMENTS OF THOSE AUTHORITIES.
- EXISTING SURFACE CONTOURS, WHERE SHOWN, ARE INTERPOLATED AND MAY NOT BE ACCURATE.
- UNLESS NOTED OTHERWISE, ALL VEGETATION SHALL BE STRIPPED TO A MINIMUM DEPTH OF 150mm UNDER ALL PROPOSED PAVEMENT AND BUILDING AREAS.
- BEFORE THE PLACEMENT OF ANY PAVEMENTS, BUILDINGS, OR DRAINS THE EXPOSED SUBGRADE SHALL BE COMPACTED TO A MINIMUM OF 100% STANDARD COMPACTION IN ACCORDANCE WITH TEST 'E1.1' OF A.S. 1289 FOR THE TOP 300mm. ANY SOFT SPOTS SHALL BE REMOVED AND REPLACED WITH GRANULAR FILL TO THE ENGINEER'S APPROVAL AND COMPACTED IN ACCORDANCE WITH THE COMPACTION REQUIREMENTS SET OUT BELOW. ON HIGHLY REACTIVE CLAY AREAS SITE EXCAVATED MATERIAL MAY BE USED WITH THE PRIOR AUTHORIZATION OF THE ENGINEER.
- ALL FILL AND PAVEMENT MATERIALS SHALL BE COMPACTED TO 200mm MAXIMUM LOOSE THICKNESS LAYERS TO THE DENSITIES SPECIFIED BELOW:

LANDSCAPED AREAS	90% STD
FILL UNDER ANY FOOTINGS AND FLOOR SLABS FOR ANY STRUCTURE	
- FINE CRUSHED ROCK	95% MOD
- OTHER FILL	95% SMDD
FILL UNDER ROAD PAVEMENTS	
- FINE CRUSHED ROCK	95% MOD
- OTHER FILL	100% SMDD
ROAD PAVEMENT MATERIALS	
- SUB-BASE	95% MOD
- BASE COURSE	98% MOD
- GRADE EVENLY BETWEEN FINISHED SURFACE SPOT LEVELS. FINISHED SURFACE CONTOURS ARE SHOWN FOR CLARITY. WHERE FINISHED SURFACE LEVELS ARE NOT SHOWN, THE SURFACE SHALL BE GRADED SMOOTHLY SO THAT IT WILL DRAIN AND MATCH ADJACENT SURFACES OR STRUCTURES.
- UNLESS NOTED OTHERWISE ON HYDRAULIC CONSULTANT'S DESIGN DRAWINGS, ALL DOWNPIPES AND GRATED INLETS SHALL BE CONNECTED TO PITS OR MAIN STORMWATER DRAINS WITH U.P.V.C OR EARTHENWARE PIPES OF THE FOLLOWING SIZES LAID AT A MINIMUM GRADE OF 1 IN 100:
 - 100 DIA. FOR DOMESTIC CONSTRUCTION
 - 150 DIA. FOR COMMERCIAL/ INDUSTRIAL CONSTRUCTION
 - 100 DIA. FOR BASEMENT GRATED INLETS

FOR SIPHONIC ROOF DRAINAGE SYSTEMS ALL DOWNPIPE CONNECTION DRAIN SIZES TO BE CONNECTED TO MAIN STORMWATER DRAINS SHALL BE IN ACCORDANCE WITH THE HYDRAULIC ENGINEER'S DRAWINGS.
- ALL MAIN STORMWATER DRAINS SHALL BE CONSTRUCTED USING ONE OF THE FOLLOWING TYPES OF PIPES WITH RUBBER RING JOINTS:
 - CLASS 2 RCP IN ACCORDANCE WITH AS 4058
 - SEWER CLASS PVC IN ACCORDANCE WITH AS 1260
 - CLASS 2 FRC TO AS 4139

ANY OTHER TYPES OF PIPE MUST BE REFERRED TO THE ENGINEER FOR APPROVAL PRIOR TO USE. IF UPVC OR OTHER PIPES ARE TO BE USED APPROVAL MUST BE GIVEN BY THE ENGINEER FOR CLASS, BEDDING, AND BACKFILL REQUIREMENTS.
- GENERALLY FOR TRENCHING WORKS THE CONTRACTOR MUST:
 - COMPLY WITH THE GENERAL PROVISIONS OF SECTION 21 OF THE 'OCCUPATIONAL HEALTH AND SAFETY ACT'
 - COMPLY WITH WITH THE 'OCCUPATIONAL HEALTH AND SAFETY CODE OF PRACTICE FOR SAFETY PRECAUTIONS IN TRENCHING OPERATIONS'

STANDARD NOTES

- PRIOR TO THE EXCAVATION OF ANY TRENCH DEEPER THAN 1.5 METERS THE CONTRACTOR MUST:
 - NOTIFY THE OCCUPATIONAL HEALTH AND SAFETY AUTHORITY OF THE APPROPRIATE FORM.
 - NOMINATE THE MINE MANAGER FOR THE PROJECT.
 - CARRY OUT ALL EXCAVATION WORKS IN ACCORDANCE WITH THE REQUIREMENTS OF THE 'MINES ACT 1968 REGULATIONS AND STATUTORY RULES'.
- ALL DIMENSIONS GIVEN ARE TO THE FACE OF THE KERB, CENTER OF PIPE, OR EXTERIOR FACE OF THE BUILDING UNLESS NOTED OTHERWISE.
- ANY STRUCTURES, PAVEMENTS, OR SURFACES DAMAGED, DIRTIED, OR MADE UNSERVICEABLE DUE TO CONSTRUCTION WORK SHALL BE REINSTATED TO THE SATISFACTION OF THE ENGINEER.
- REFER TO STRUCTURAL DRAWINGS FOR FOOTING AND FOUNDATION DETAILS.
- ANY FILL REQUIRED SHALL BE APPROVED BY THE ENGINEER.
- THE CONTRACTOR IS TO ENSURE THAT ALL EXCAVATIONS ARE MAINTAINED IN A DRY CONDITION WITH NO WATER ALLOWED TO REMAIN IN THE EXCAVATIONS.
- ALL WORKMANSHIP AND MATERIALS SHALL COMPLY WITH THE BUILDING CODE OF AUSTRALIA AND THE RELEVANT CURRENT AUSTRALIAN STANDARDS.
- ANY DISCREPANCIES, OMISSIONS OR ERRORS SHALL BE REPORTED TO THE SUPERINTENDENT/ ENGINEER FOR CLARIFICATION BEFORE PROCEEDING WITH THE WORK.
- IF ANY DISCREPANCY OCCURS IN THE ENGINEER DRAWING OR BETWEEN DRAWINGS AND SPECIFICATION, THE CONTRACTOR SHALL DURING TENDER ASSUME THE GREATER/LARGER.
- ALL WORKMANSHIP AND MATERIALS SHALL COMPLY WITH THE BUILDING CODE OF AUSTRALIA AND THE RELEVANT CURRENT AUSTRALIAN STANDARDS. WHERE A STANDARD DOES NOT EXIST SHALL BEAR THE "WATER MARK" APPROVAL. WHERE AN AUSTRALIAN STANDARD EXISTS, NO SUBSTITUTION IS PERMITTED.
- ALL EXISTING PROPERTY SERVICES' LOCATIONS AND DEPTHS ARE APPROXIMATE AND MUST BE VERIFIED ON-SITE.
- THE CONTRACTOR SHOULD SUPPLY PRECISE LOCATIONS AND DEPTHS TO THE ENGINEER FOR REVIEW BEFORE ANY WORKS THAT MAY AFFECT THESE SERVICES.
- BEFORE THE COMMENCEMENT OF BUILDING WORKS ON SITE, THE CONTRACTOR MUST VERIFY THE FEASIBILITY OF THE OUTFALL STORMWATER DRAINAGE SYSTEM/S TO THE LEGAL POINT OF DISCHARGE AS DOCUMENTED BY:
 - VERIFICATION OF THE INVERT LEVEL OF THE DRAIN FORMING THE LEGAL POINT OF DISCHARGE.
 - VERIFICATION THAT THE ROUTE FROM THE SITE TO THE LEGAL POINT/S OF DISCHARGE IS CLEAR OF ALL OTHER AUTHORITY SERVICES
 - IF EITHER OF THE ABOVE CANNOT BE VERIFIED, THE CONTRACTOR MUST IMMEDIATELY NOTIFY THE PROJECT MANAGER OR CONSULTING CIVIL ENGINEER.
- BEFORE THE COMMENCEMENT OF ANY WORKS, THE CONTRACTOR SHALL LOCATE ALL UNDERGROUND SERVICES. NOTIFY THE AUTHORITIES RESPONSIBLE FOR THOSE SERVICES AND COMPLY WITH ALL OF THE REQUIREMENTS OF THOSE AUTHORITIES.
- DURING CONSTRUCTION THE STRUCTURE SHALL BE MAINTAINED IN A STABLE CONDITION AND NO PART SHALL BE OVER-STRESSED.
- SUBSTITUTION MUST BE APPROVED BY THE ENGINEER AND INCLUDED IN ANY TENDER.
- ALL MATERIALS AND WORKMANSHIP SHALL BE IN ACCORDANCE WITH THE REQUIREMENTS OF THE BY-LAWS AND ORDINANCES OF THE RELEVANT BUILDING AUTHORITY EXCEPT WHERE VARIED BY THE PROJECT SPECIFICATION.
- REFER TO ARCHITECTURAL DRAWINGS FOR THE LOCATION OF FIXTURES AND THE BUILDING LAYOUT AND DIMENSIONS WHERE DRAWINGS SHOWING SPECIFIC SERVICES ARE SUPERIMPOSED ON BUILDING PLANS. USE THEM ONLY FOR HYDRAULIC SERVICE PURPOSES. IF THE ULTIMATE CONDITIONS OF THE BUILDING NECESSITATE ANY ALTERATIONS IN ARRANGEMENT OBTAIN APPROVAL OF THE ENGINEER BEFORE PROCEEDING.
- THESE DRAWINGS SHALL BE READ IN CONJUNCTION WITH ALL ARCHITECTURAL AND OTHER CONSULTANT'S DRAWINGS AND SPECIFICATIONS AND WITH SUCH OTHER WRITTEN INSTRUCTIONS AS ISSUED FOR THE DURATION OF THE CONTRACT.
- SAFETY ISSUES MUST BE CONSIDERED AT ALL TIMES, INCORPORATE TRAFFIC CONTROL DEVICES TO THE SATISFACTION OF THE SUPERINTENDENT.

SITWORKS NOTES

- THE CONTRACTOR MUST VERIFY ALL DIMENSIONS AND EXISTING LEVELS ON SITE BEFORE COMMENCEMENT OF WORK. AND REPORT ANY DISCREPANCIES TO THE SUPERINTENDENT.
- MAKE SMOOTH CONNECTIONS WITH EXISTING WORKS.
- ALL EXISTING SERVICES (INCLUDING ANY NOT SHOWN ON THE PLANS) MUST BE ACCURATELY LOCATED IN POSITION AND LEVEL BEFORE ANY EXCAVATION. ANY DISCREPANCIES SHALL BE REPORTED TO THE SUPERINTENDENT. MINIMUM SERVICE CLEARANCES SHALL BE MAINTAINED FROM THE RELEVANT SERVICE AUTHORITY.
- THE CONTRACTOR SHALL ARRANGE FOR ALL SETTING OUT BY A REGISTERED SURVEYOR.
- THE CONTRACTOR SHALL OBTAIN ALL REGULATORY AUTHORITY APPROVALS AT THEIR OWN EXPENSE.
- WHERE NEW WORKS BUT EXISTING, THE CONTRACTOR MUST ENSURE THAT A SMOOTH AND EVEN PROFILE, FREE FROM ABRUPT CHANGES IS OBTAINED.
- ALL DISTURBED AREAS SHALL BE RESTORED TO THEIR ORIGINAL CONDITION UNLESS SPECIFIED OTHERWISE.
- EXCAVATED TRENCHES SHALL BE COMPACTED TO THE SAME DENSITY AS THE ADJACENT NATURAL MATERIAL. ANY SUBSIDIES DURING THE PERIOD TO BE RECTIFIED AS DIRECTED BY THE SUPERINTENDENT.
- ANY EXISTING TREES THAT FORM PART OF THE FINAL LANDSCAPING PLAN WILL BE PROTECTED FROM CONSTRUCTION ACTIVITIES IN ACCORDANCE WITH THE LANDSCAPE ARCHITECT'S DETAILS AND/OR BY PROTECTING THEM WITH BARRIER FENCING OR SIMILAR MATERIALS INSTALLED OUTSIDE THE DRIP LINE, ENSURING THAT NOTHING IS NAILED TO THEM, PROHIBITING PAVING, GRADING, SEDIMENT WASH, OR PLACING OF STOCKPILES WITHIN THE DRIP LINE EXCEPT UNDER THE FOLLOWING CONDITIONS -
 - ENCROACHMENT ONLY OCCURS ON ONE SIDE AND NO CLOSER TO THE TRUNK THAN EITHER 1.5m OR HALF THE DISTANCE BETWEEN THE OUTER EDGE OF THE DRIP LINE AND THE TRUNK, WHICHEVER IS THE GREATER.
 - A DRAINAGE SYSTEM THAT ALLOWS AIR AND WATER TO CIRCULATE THROUGH THE ROOT ZONE (e.g. A GRAVEL BED) IS PLACED UNDER ALL FILL LAYERS OF MORE THAN 300mm, CARE IS TAKEN NOT TO CUT ROOTS UNNECESSARILY NOR TO COMPACT THE SOIL AROUND THEM.
- RECEPTORS FOR CONCRETE AND MORTAR SLURRIES, PAINTS, ACID WASHINGS, LIGHTWEIGHT WASTE MATERIALS, AND LITTER ARE TO BE EMPTIED AS NECESSARY. DISPOSAL OF WASTE SHALL BE IN A MANNER APPROVED BY THE SUPERINTENDENT OR AS SPECIFIED IN THE WORKS CONTRACT.
- ALL SERVICE TRENCHES UNDER VEHICULAR PAVEMENTS SHALL BE BACKFILLED WITH SAND TO 300mm ABOVE PIPE, WHERE PIPE IS UNDER PAVEMENTS BACKFILL REMAINDER OF TRENCH TO UNDERSIDE OF PAVEMENT WITH SAND OR APPROVED GRANULAR MATERIAL. COMPACTED IN 150mm LAYERS TO MINIMUM 98% MODIFIED MAXIMUM DRY DENSITY IN ACCORDANCE WITH AS 1289 5.2.1 (OR A DENSITY INDEX OF NOT LESS THAN 75).
- ALL BASE COURSE MATERIAL SHALL BE IGNEOUS ROCK QUARRIED MATERIAL TO COMPLY WITH R.M.S. FORM 3051, COMPACTED TO MINIMUM 98% MODIFIED DENSITY IN ACCORDANCE WITH AS 1289 5.2.1 FREQUENCY OF COMPACTION TESTING SHALL NOT BE LESS THAN 1 TEST PER 50m² OF BASE COURSE MATERIAL PLACED.
- ALL SUB-BASE COURSE MATERIAL SHALL BE IGNEOUS ROCK QUARRIED MATERIAL TO COMPLY WITH R.M.S. FORM 3051, AND COMPACTED TO MINIMUM 95% MODIFIED DENSITY IN ACCORDANCE WITH AS 1289 5.2.1 FREQUENCY OF COMPACTION TESTING SHALL NOT BE LESS THAN 1 TEST PER 50m² OF SUB-BASE COURSE MATERIAL PLACED.
- AS AN ALTERNATIVE TO THE USE OF IGNEOUS ROCK AS A SUB-BASE MATERIAL IN (9) A CERTIFIED RECYCLED CONCRETE MATERIAL COMPLYING WITH RMS FORM 3051 WILL BE CONSIDERED. SUBJECT TO MATERIAL SAMPLES AND APPROPRIATE CERTIFICATIONS BEING PROVIDED TO THE SATISFACTION OF EIA.
- PROVIDE 10mm WIDE EXPANSION JOINTS BETWEEN BUILDINGS AND ALL CONCRETE OR UNIT PAVEMENTS.
- SHOULD THE CONTRACTOR WISH TO USE A RECYCLED PRODUCT THIS SHALL BE INDICATED IN THEIR TENDER AND THE PRICE DIFFERENCE BETWEEN AN IGNEOUS PRODUCT AND A RECYCLED PRODUCT SHALL BE INDICATED.
- WHERE NOTED ON THE DRAWINGS THAT WORKS ARE TO BE CARRIED BY OTHERS, (LIKE ADJUSTMENT OF SERVICES), THE CONTRACTOR SHALL BE RESPONSIBLE FOR THE COORDINATION OF THESE WORKS.

EXISTING SERVICE NOTES

- EXISTING SERVICES HAVE BEEN PLOTTED FROM SUPPLIED DATA AND AS SUCH THEIR ACCURACY CANNOT BE GUARANTEED. IT IS THE RESPONSIBILITY OF THE CONTRACTOR TO ESTABLISH THE LOCATION AND LEVEL OF ALL EXISTING SERVICES BEFORE THE COMMENCEMENT OF ANY WORK. ANY DISCREPANCIES SHALL BE REPORTED TO THE SUPERINTENDENT.
- THE CONTRACTOR SHALL ALLOW FOR THE CAPPING OFF, EXCAVATION, AND REMOVAL IF REQUIRED OF ALL REDUNDANT EXISTING SERVICES IN AREAS AFFECTED BY WORKS WITHIN THE CONTRACT AREA, AS SHOWN ON THE DRAWINGS UNLESS DIRECTED OTHERWISE BY THE SUPERINTENDENT.
- THE CONTRACTOR SHALL ENSURE THAT AT ALL TIMES SERVICES TO ALL BUILDINGS NOT AFFECTED BY THE WORKS ARE NOT DISRUPTED.
- IF REQUIRED, THE CONTRACTOR SHALL CONSTRUCT TEMPORARY SERVICES TO MAINTAIN EXISTING SUPPLY TO BUILDINGS REMAINING IN OPERATION DURING WORKS TO THE SATISFACTION AND APPROVAL OF THE SUPERINTENDENT. ONCE DIVERSION IS COMPLETE AND COMMISSIONED THE CONTRACTOR SHALL REMOVE ALL SUCH TEMPORARY SERVICES AND MAKE GOOD TO THE SATISFACTION OF THE SUPERINTENDENT AND THE RELEVANT SERVICE AUTHORITY.
- INTERRUPTION TO THE SUPPLY OF EXISTING SERVICES SHALL BE DONE SO AS NOT TO CAUSE ANY INCONVENIENCE TO THE PRINCIPAL. THE CONTRACTOR IS TO GAIN APPROVAL FROM THE SUPERINTENDENT FOR TIMES OF INTERRUPTION - THE CONTRACTOR IS RESPONSIBLE FOR ALL LIAISON.
- ALL BRANCH GAS AND WATER SERVICES UNDER DRIVEWAYS AND BRICK PAVING SHALL BE LOCATED IN 300mm U.P.V.C SEWER GRADE CONDUITS EXTENDING A MINIMUM OF 500mm BEYOND THE EDGE OF PAVING.
- CLEARANCE AND COVER REQUIREMENTS SHALL BE OBTAINED FROM THE RELEVANT SERVICE AUTHORITY BEFORE THE COMMENCEMENT OF WORKS AND SHALL BE ADHERED TO AT ALL TIMES.
- CARE IS TO BE TAKEN WHEN EXCAVATING NEAR EXISTING SERVICES. NO MECHANICAL EXCAVATIONS ARE TO BE UNDERTAKEN OVER TELECOM OR ELECTRICAL SERVICES. HAND EXCAVATE IN THESE AREAS ONLY.

TEMPORARY SITE CONTROL FOR ENTRY/EXIT AREAS

- THE ENTRANCE SHALL BE MAINTAINED IN A CONDITION THAT WILL PREVENT TRACKING OF SEDIMENT ONTO PUBLIC ROADS.
 - PERIODIC TOP DRESSING WITH ADDITIONAL AGGREGATE MAY BE REQUIRED TO KEEP THE SITE CONTROL IN A 'USEABLE STATE'.
 - ALL SEDIMENT SPILLED, DROPPED, OR WASHED ONTO PUBLIC ROADS MUST BE REMOVED IMMEDIATELY AND CHECKED DAILY.
 - REMOVAL AND CLEANING OF PUBLIC ROADS BY BROOMS AND SHOVELS ETC. WASHING DOWN ROADS IS NOT PERMITTED.
- NOTES**
- WHERE POSSIBLE LAY PIPES TO AVOID EXISTING AND PROPOSED TREE.
 - FINISH GROUND SURFACES AROUND BUILDINGS TO BE GENERALLY GRADED AWAY FROM AND AROUND BUILDING TO AVOID LOW POINTS WHERE WATER CAN ACCUMULATE
 - BUILDER TO CARRY OUT A DIAL BEFORE YOU DIG BEFORE WORKS COMMENCING

TELSTRA - DUTY OF CARE NOTES

TELSTRA'S PLANS SHOW ONLY THE PRESENCE OF CABLES AND PLANT. THEY ONLY SHOW THEIR POSITION RELATIVE TO ROAD BOUNDARIES, PROPERTY FENCES ETC. AT THE TIME OF INSTALLATION TELSTRA DOES NOT WARRANT OR HOLD OUT THAT SUCH PLANS ARE ACCURATE THEREAFTER DUE TO CHANGES THAT MAY OCCUR OVER TIME. DO NOT ASSUME THE DEPTH OR ALIGNMENT OF CABLES OR PLANTS AS THESE VARY SIGNIFICANTLY. THE CONTRACTOR HAS A DUTY OF CARE WHEN EXCAVATING NEAR TELSTRA CABLES AND PLANTS. BEFORE USING MACHINE EXCAVATORS TELSTRA PLANT MUST FIRST BE PHYSICALLY EXPOSED BY SOFT DIG POTHOLING TO IDENTIFY ITS LOCATION TELSTRA WILL SEEK COMPENSATION FOR DAMAGES CAUSED TO ITS PROPERTY AND LOSSES CAUSED TO TELSTRA AND ITS CUSTOMERS.

EXISTING UNDERGROUND SERVICES NOTES

THE LOCATIONS OF UNDERGROUND SERVICES SHOWN IN THIS SET OF DRAWINGS HAVE BEEN PLOTTED FROM SURVEY INFORMATION. THE SERVICE INFORMATION HAS BEEN PREPARED ONLY TO SHOW THE APPROXIMATE POSITIONS OF ANY KNOWN SERVICES AND MAY NOT BE AS CONSTRUCTED OR ACCURATE. EI CAN NOT GUARANTEE THAT THE SERVICES INFORMATION SHOWN ON THESE DRAWINGS ACCURATELY INDICATES THE PRESENCE OR ABSENCE OF SERVICES OR THEIR LOCATION AND WILL ACCEPT NO LIABILITY FOR INACCURACIES IN THE SERVICES INFORMATION SHOWN FROM ANY CAUSE WHATSOEVER.

CONTRACTORS SHALL TAKE DUE CARE WHEN EXCAVATING ONSITE INCLUDING HAND EXCAVATION WHERE NECESSARY. CONTRACTORS ARE TO CONTACT THE RELEVANT SERVICE AUTHORITY BEFORE THE COMMENCEMENT OF EXCAVATION WORKS. CONTRACTORS ARE TO UNDERTAKE A SERVICES SEARCH, BEFORE COMMENCEMENT OF WORKS ON SITE. SEARCH RESULTS ARE TO BE KEPT ON-SITE AT ALL TIMES.



DISCLAIMER :


THESE NOTES ARE DOCUMENTED FOR GENERAL CONDITION. SOME NOTES MAY NOT BE APPLICABLE REFER TO DRAWINGS FOR SITE SPECIFIC NOTES.

FOR SUBMISSION

Revision	Amendment	Issued By	Revision Date	Architect	Client	Engineer	Project	Drawn	Designed	Approved
00	ISSUE FOR SUBMISSION	HR	19.12.25				5-9 COWAN RD, ST IVES, NSW 2075	HM	SA	HR
								Project No.		Scale
								S10751		at A1. N.T.S
								Drawing No.		Revision
								C001		00
								Issued By	Checked By	Date
								HR	HR	19.12.25



EI Australia
Suite 6.01
55 Miller Street
Pyrmont, NSW 2009
T 02 9516 0722

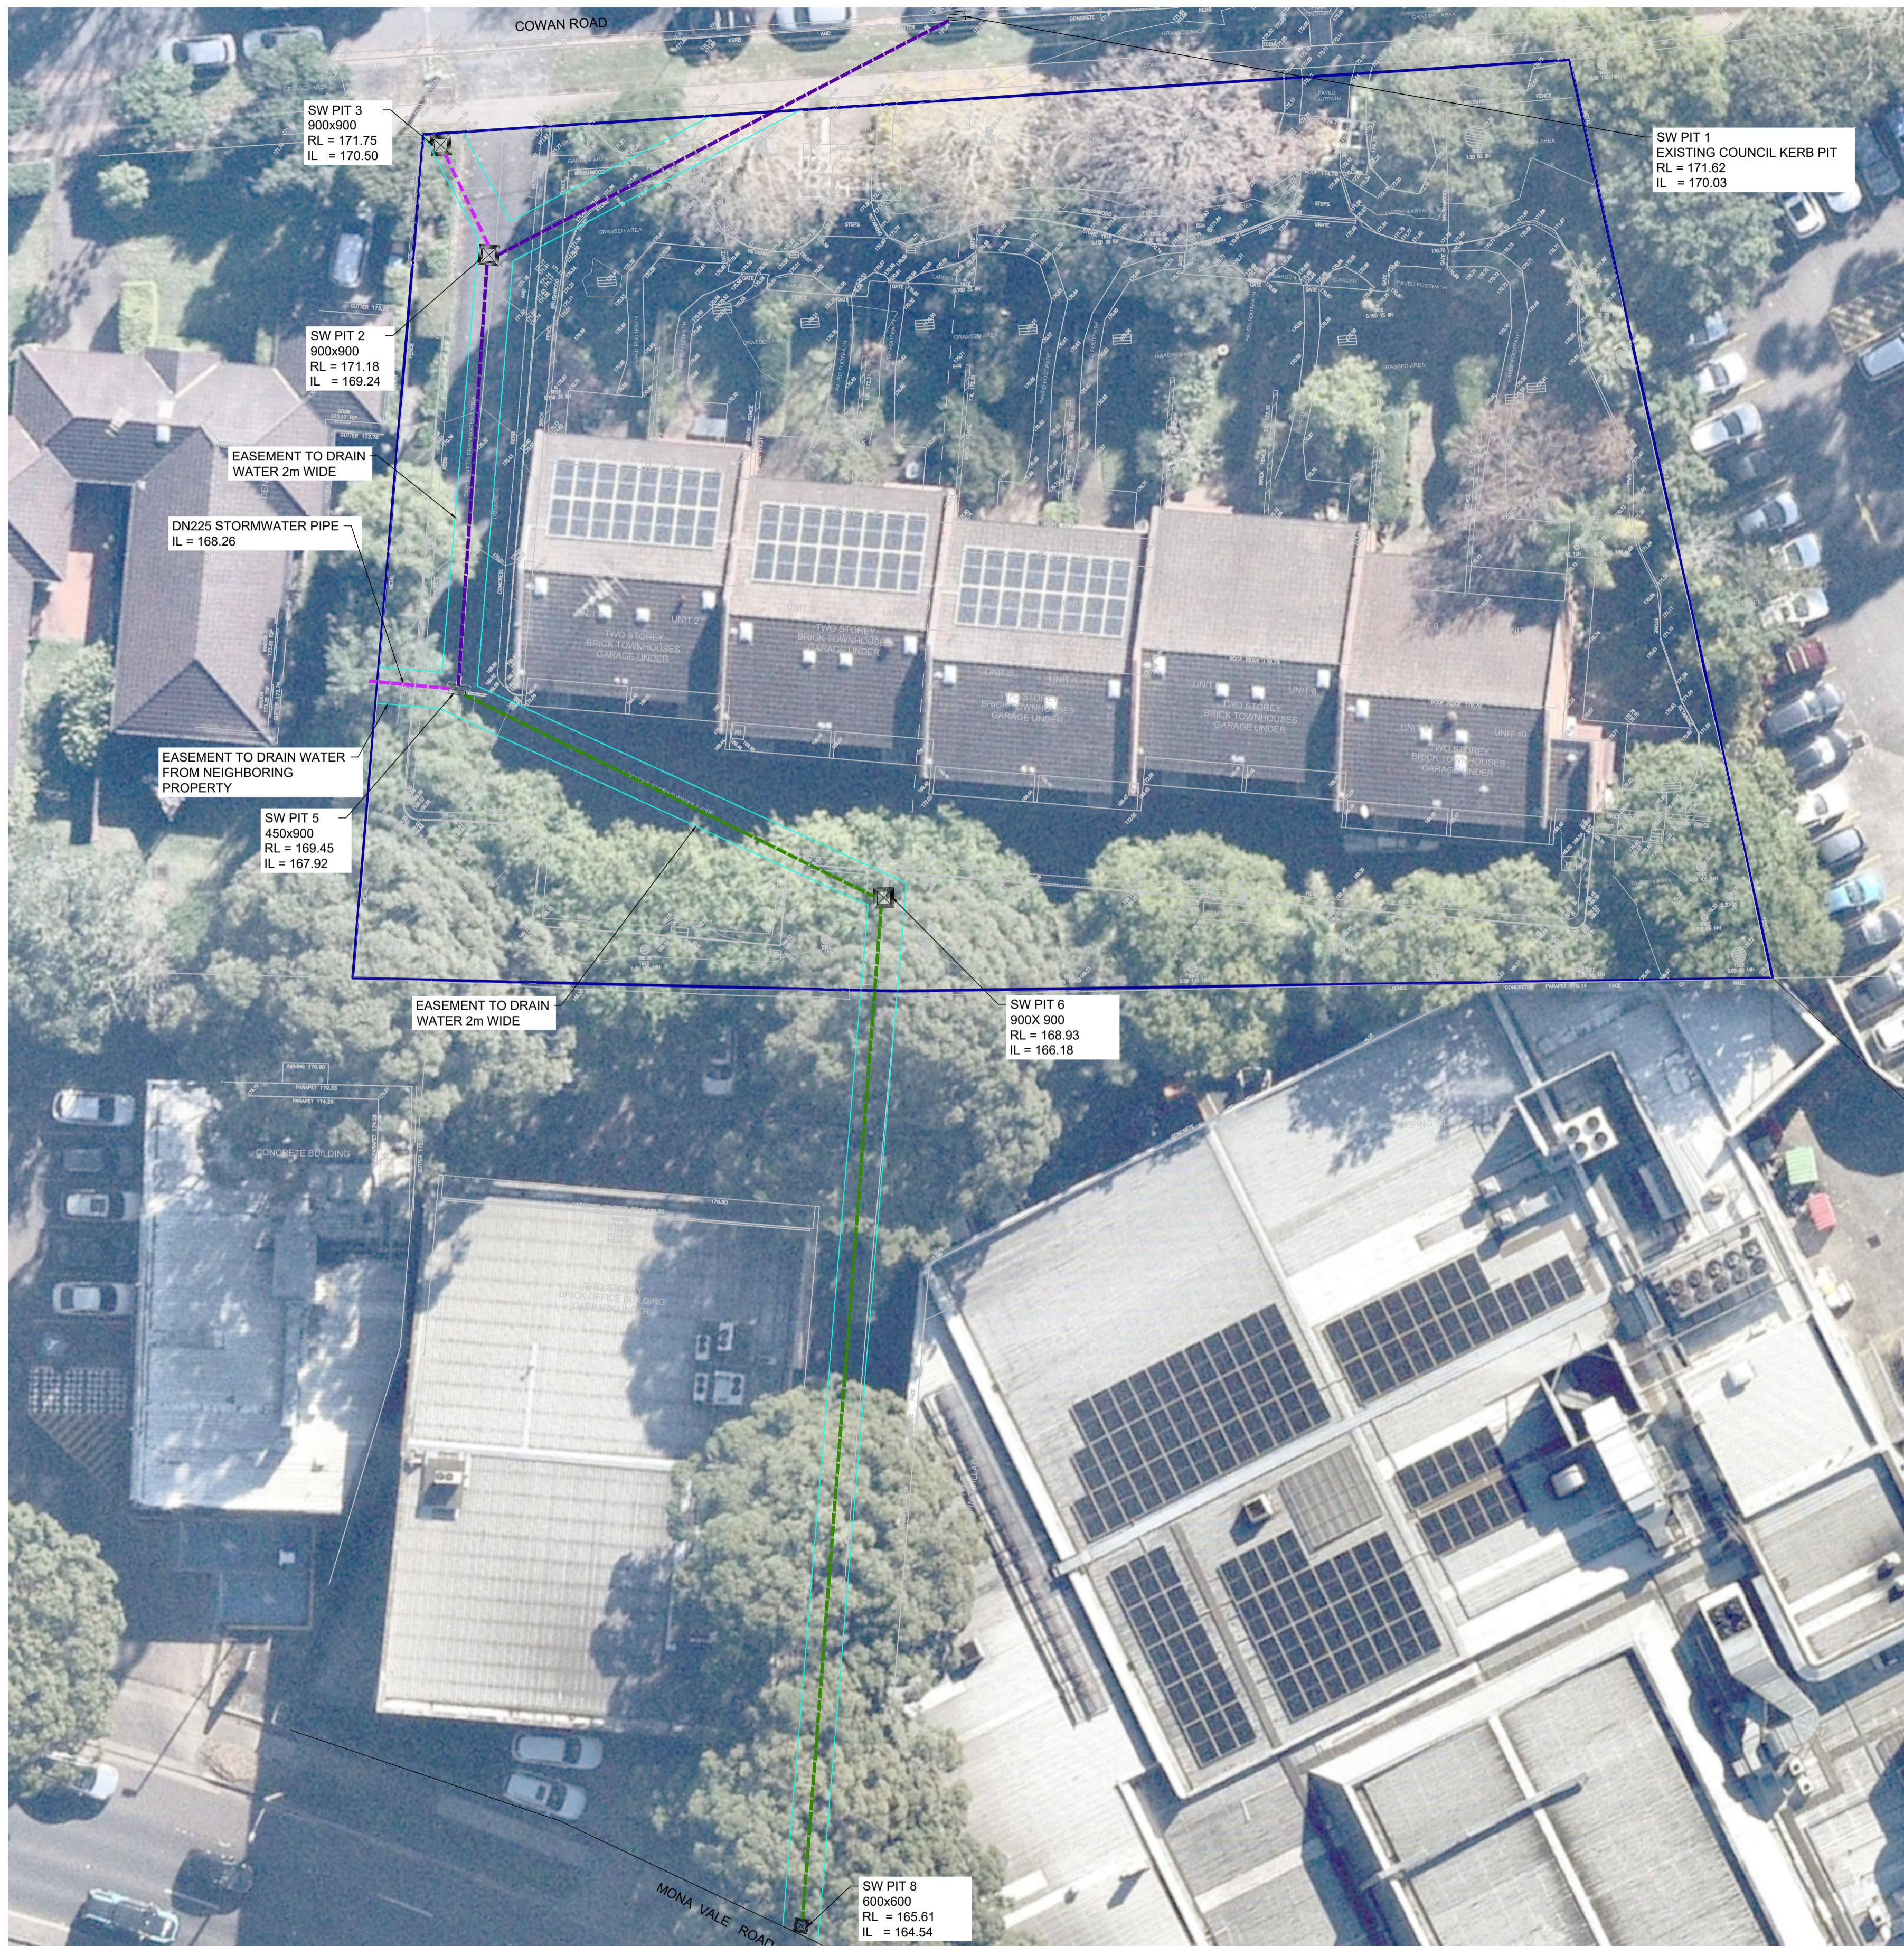

LEGEND


- SWD 225mm DRAINAGE PIPE
- SWD 375mm DRAINAGE PIPE
- SWD 450mm DRAINAGE PIPE

FOR SUBMISSION


Revision	Amendment	Issued By	Revision Date	COPYRIGHT - ALL RIGHTS RESERVED Copying or reproducing the whole or part of this document in any form without the written permission of EI Australia constitutes an infringement of copyright. DISCLAIMER EI Australia accepts no responsibility for the accuracy or for any consequence resulting from the use or alteration of this drawing in electronic form. Drawings in electronic form should be checked for accuracy against the equivalent hard copy issued by EI. DIMENSIONS Prior to commencing construction verify all dimensions against Architect's, other Consultant's and Sub-Contractor's drawings. For building work, dimensions are not to be scaled or read electronically from this drawing. Setout dimensions, unless specifically shown, are to be obtained from the Architect's or other Consultant's drawings. For civil engineering work, dimensions are not to be manually scaled from drawing. Setout dimensions, unless specifically shown, are to be read electronically from this drawing.	Architect	Client	Engineer	Project	Drawn	Designed	Approved
00	ISSUE FOR SUBMISSION	HR	19.12.25					5-9 COWAN RD, ST IVES, NSW 2075	HM	SA	HR
									Project No. S10751 at A1. 220		
									Drawing No. C100 Revision 00		
									Issued By	Checked By	Date
									HR	HR	19.12.25



EI Australia
Suite 6.01
55 Miller Street
Pyrmont, NSW 2009
T 02 9516 0722

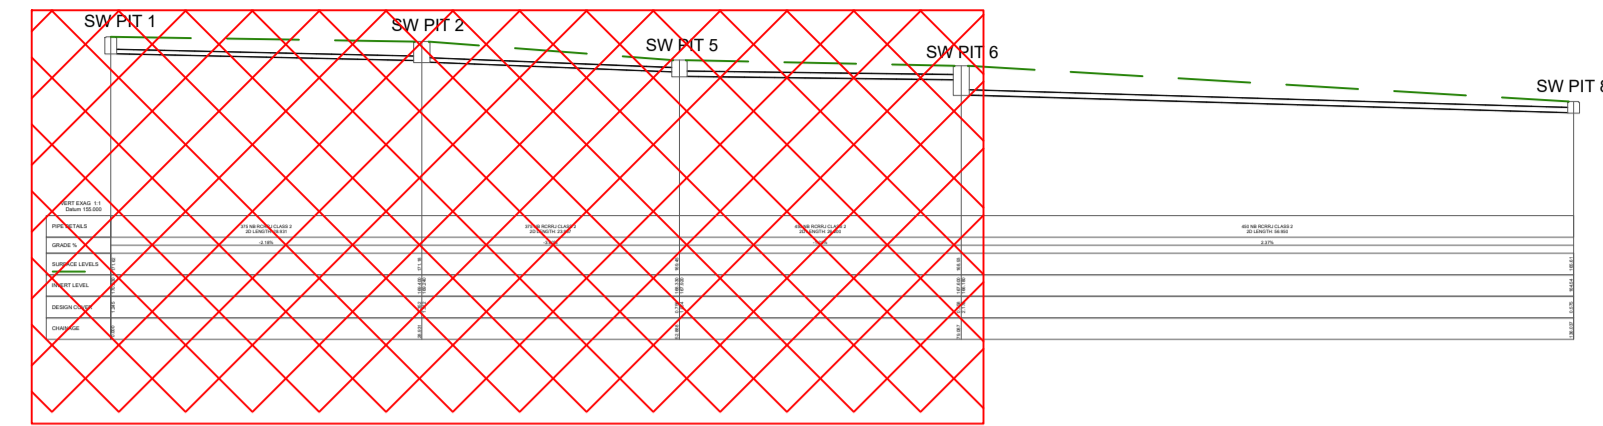

KEY PLAN

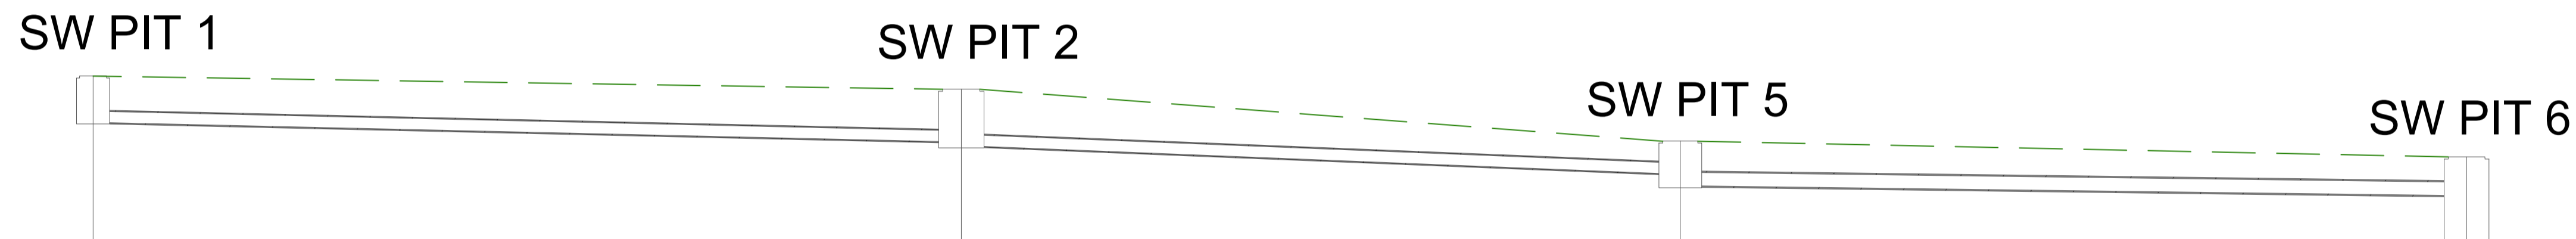

VERT EXAG 1:1
Datum 155.000

PIPE DETAILS	375 NB RCRRJ CLASS 2 ZD LENGTH: 28.931	375 NB RCRRJ CLASS 2 ZD LENGTH: 23.957	450 NB RCRRJ CLASS 2 ZD LENGTH: 26.200
GRADE %	-2.18%	-3.80%	-1.22%
SURFACE LEVELS	170.030 171.62	169.400 171.18	169.45 167.920
INVERT LEVEL	170.030	169.400 169.240	169.45 167.920
DESIGN COVER	1.245	1.352 1.512	0.756 1.084
CHAINAGE	0.000	28.931	52.888


EXISTING PIPE NETWORK LONG-SECTION
SCALE = 1:150

FOR SUBMISSION

Revision	Amendment	Issued By	Revision Date	COPYRIGHT - ALL RIGHTS RESERVED Copying or reproducing the whole or part of this document in any form without the written permission of EI Australia constitutes an infringement of copyright. DISCLAIMER EI Australia accepts no responsibility for the accuracy or for any consequence resulting from the use or alteration of this drawing in electronic form. Drawings in electronic form should be checked for accuracy against the equivalent hard copy issued by EI. DIMENSIONS Prior to commencing construction verify all dimensions against Architect's, other Consultant's and Sub-Contractor's drawings. For building work, dimensions are not to be scaled or read electronically from this drawing. Setout dimensions, unless specifically shown, are to be obtained from the Architect's or other Consultant's drawings. For civil engineering work, dimensions are not to be manually scaled from drawing. Setout dimensions, unless specifically shown, are to be read electronically from this drawing.	Architect	Client	Engineer	Project	Drawn	Designed	Approved
00	ISSUE FOR SUBMISSION	HR	19.12.25				5-9 COWAN RD, ST IVES, NSW 2075	HM	SA	HR	
								Project No. S10751		Scale at A1. 150	
							Title	Drawing No. C101		Revision 00	
								Issued By	Checked By	Date	
								HR	HR	19.12.25	



EI Australia
Suite 6.01
55 Miller Street
Pyrmont, NSW 2009
T 02 9516 0722

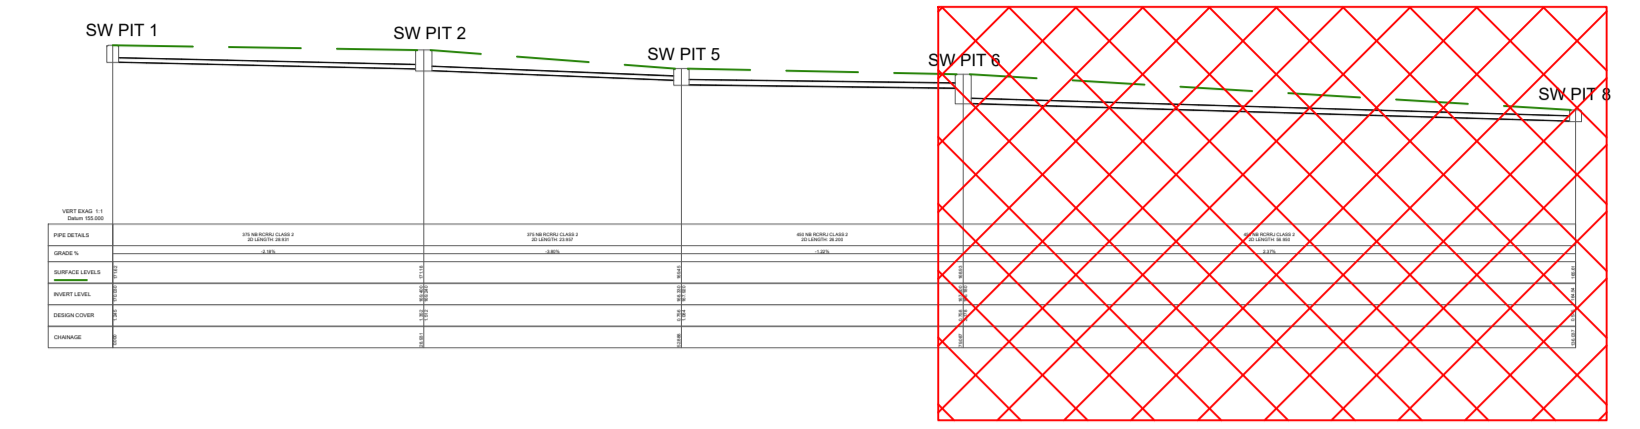


KEY PLAN

300mm
200mm
100
50
0 10mm


SW PIT 6


SW PIT 8

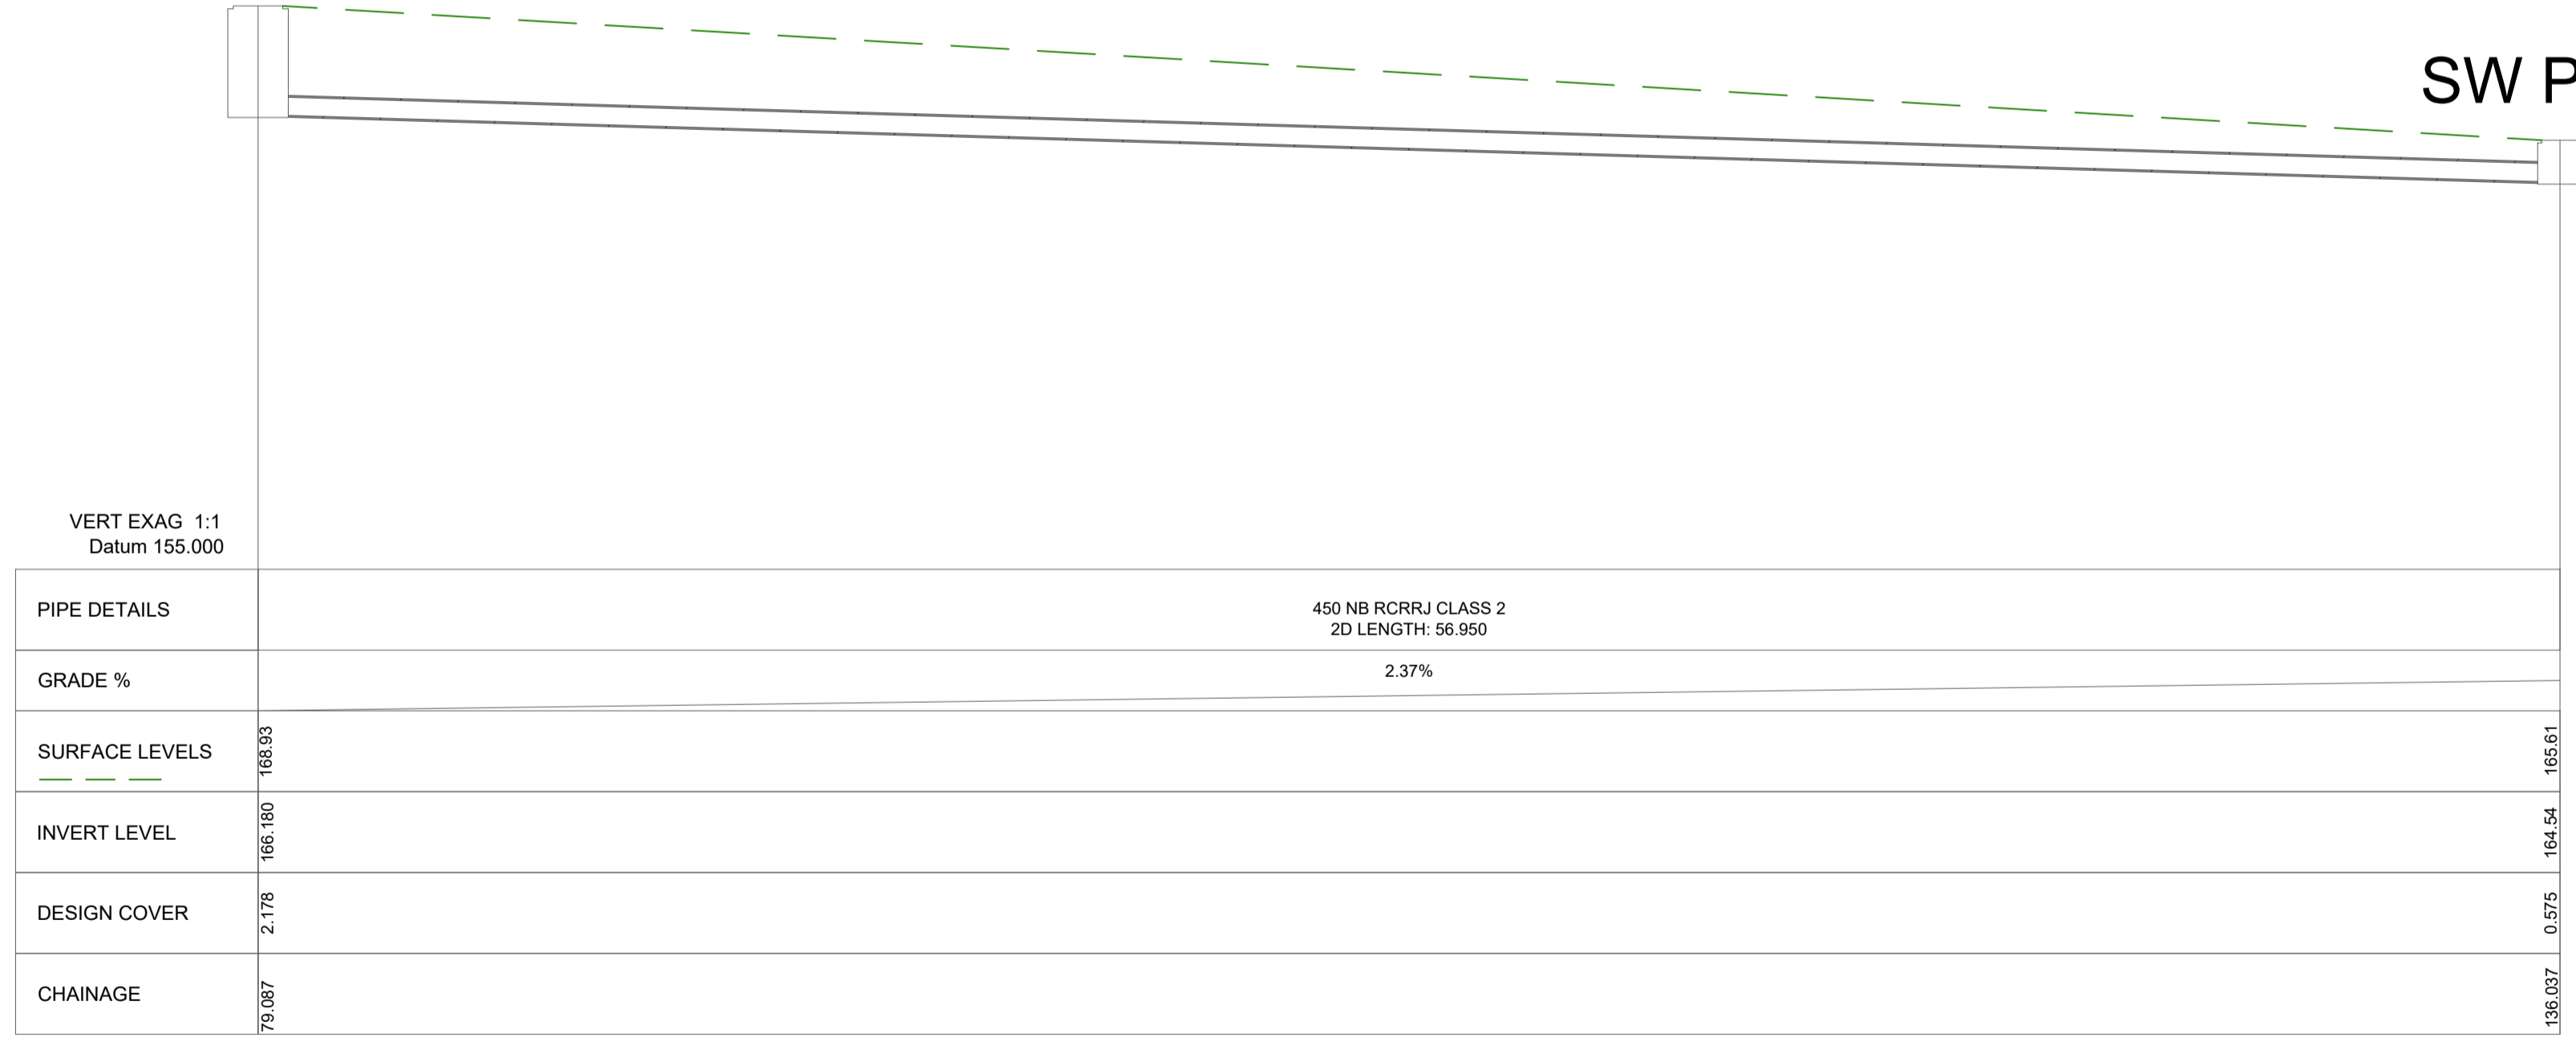

**EXISTING PIPE NETWORK LONG-SECTION
SCALE = 1:150**

FOR SUBMISSION

Revision	Amendment	Issued By	Revision Date	Copyright - ALL RIGHTS RESERVED	Architect	Client	Engineer	Project	Drawn	Designed	Approved
00	ISSUE FOR SUBMISSION	HR	19.12.25	Copying or reproducing the whole or part of this document in any form without the written permission of EI Australia constitutes an infringement of copyright. DISCLAIMER EI Australia accepts no responsibility for the accuracy or for any consequence resulting from the use or alteration of this drawing in electronic form. Drawings in electronic form should be checked for accuracy against the equivalent hard copy issued by EI. DIMENSIONS Prior to commencing construction verify all dimensions against Architect's, other Consultant's and Sub-Contractor's drawings. For building work, dimensions are not to be scaled or read electronically from this drawing. Setout dimensions, unless specifically shown, are to be obtained from the Architect's or other Consultant's drawings. For civil engineering work, dimensions are not to be manually scaled from drawing. Setout dimensions, unless specifically shown, are to be read electronically from this drawing.			 EI Australia Suite 6.01 55 Miller Street Pyrmont, NSW 2009 T 02 9516 0722	5-9 COWAN RD, ST IVES, NSW 2075	HM	SA	HR
									Project No. S10751 Scale at A1. 150		
									Title EXISTING PIPE NETWORK LONG-SECTION-1 Drawing No. C102 Revision 00		
									Issued By HR Checked By HR Date 19.12.25		

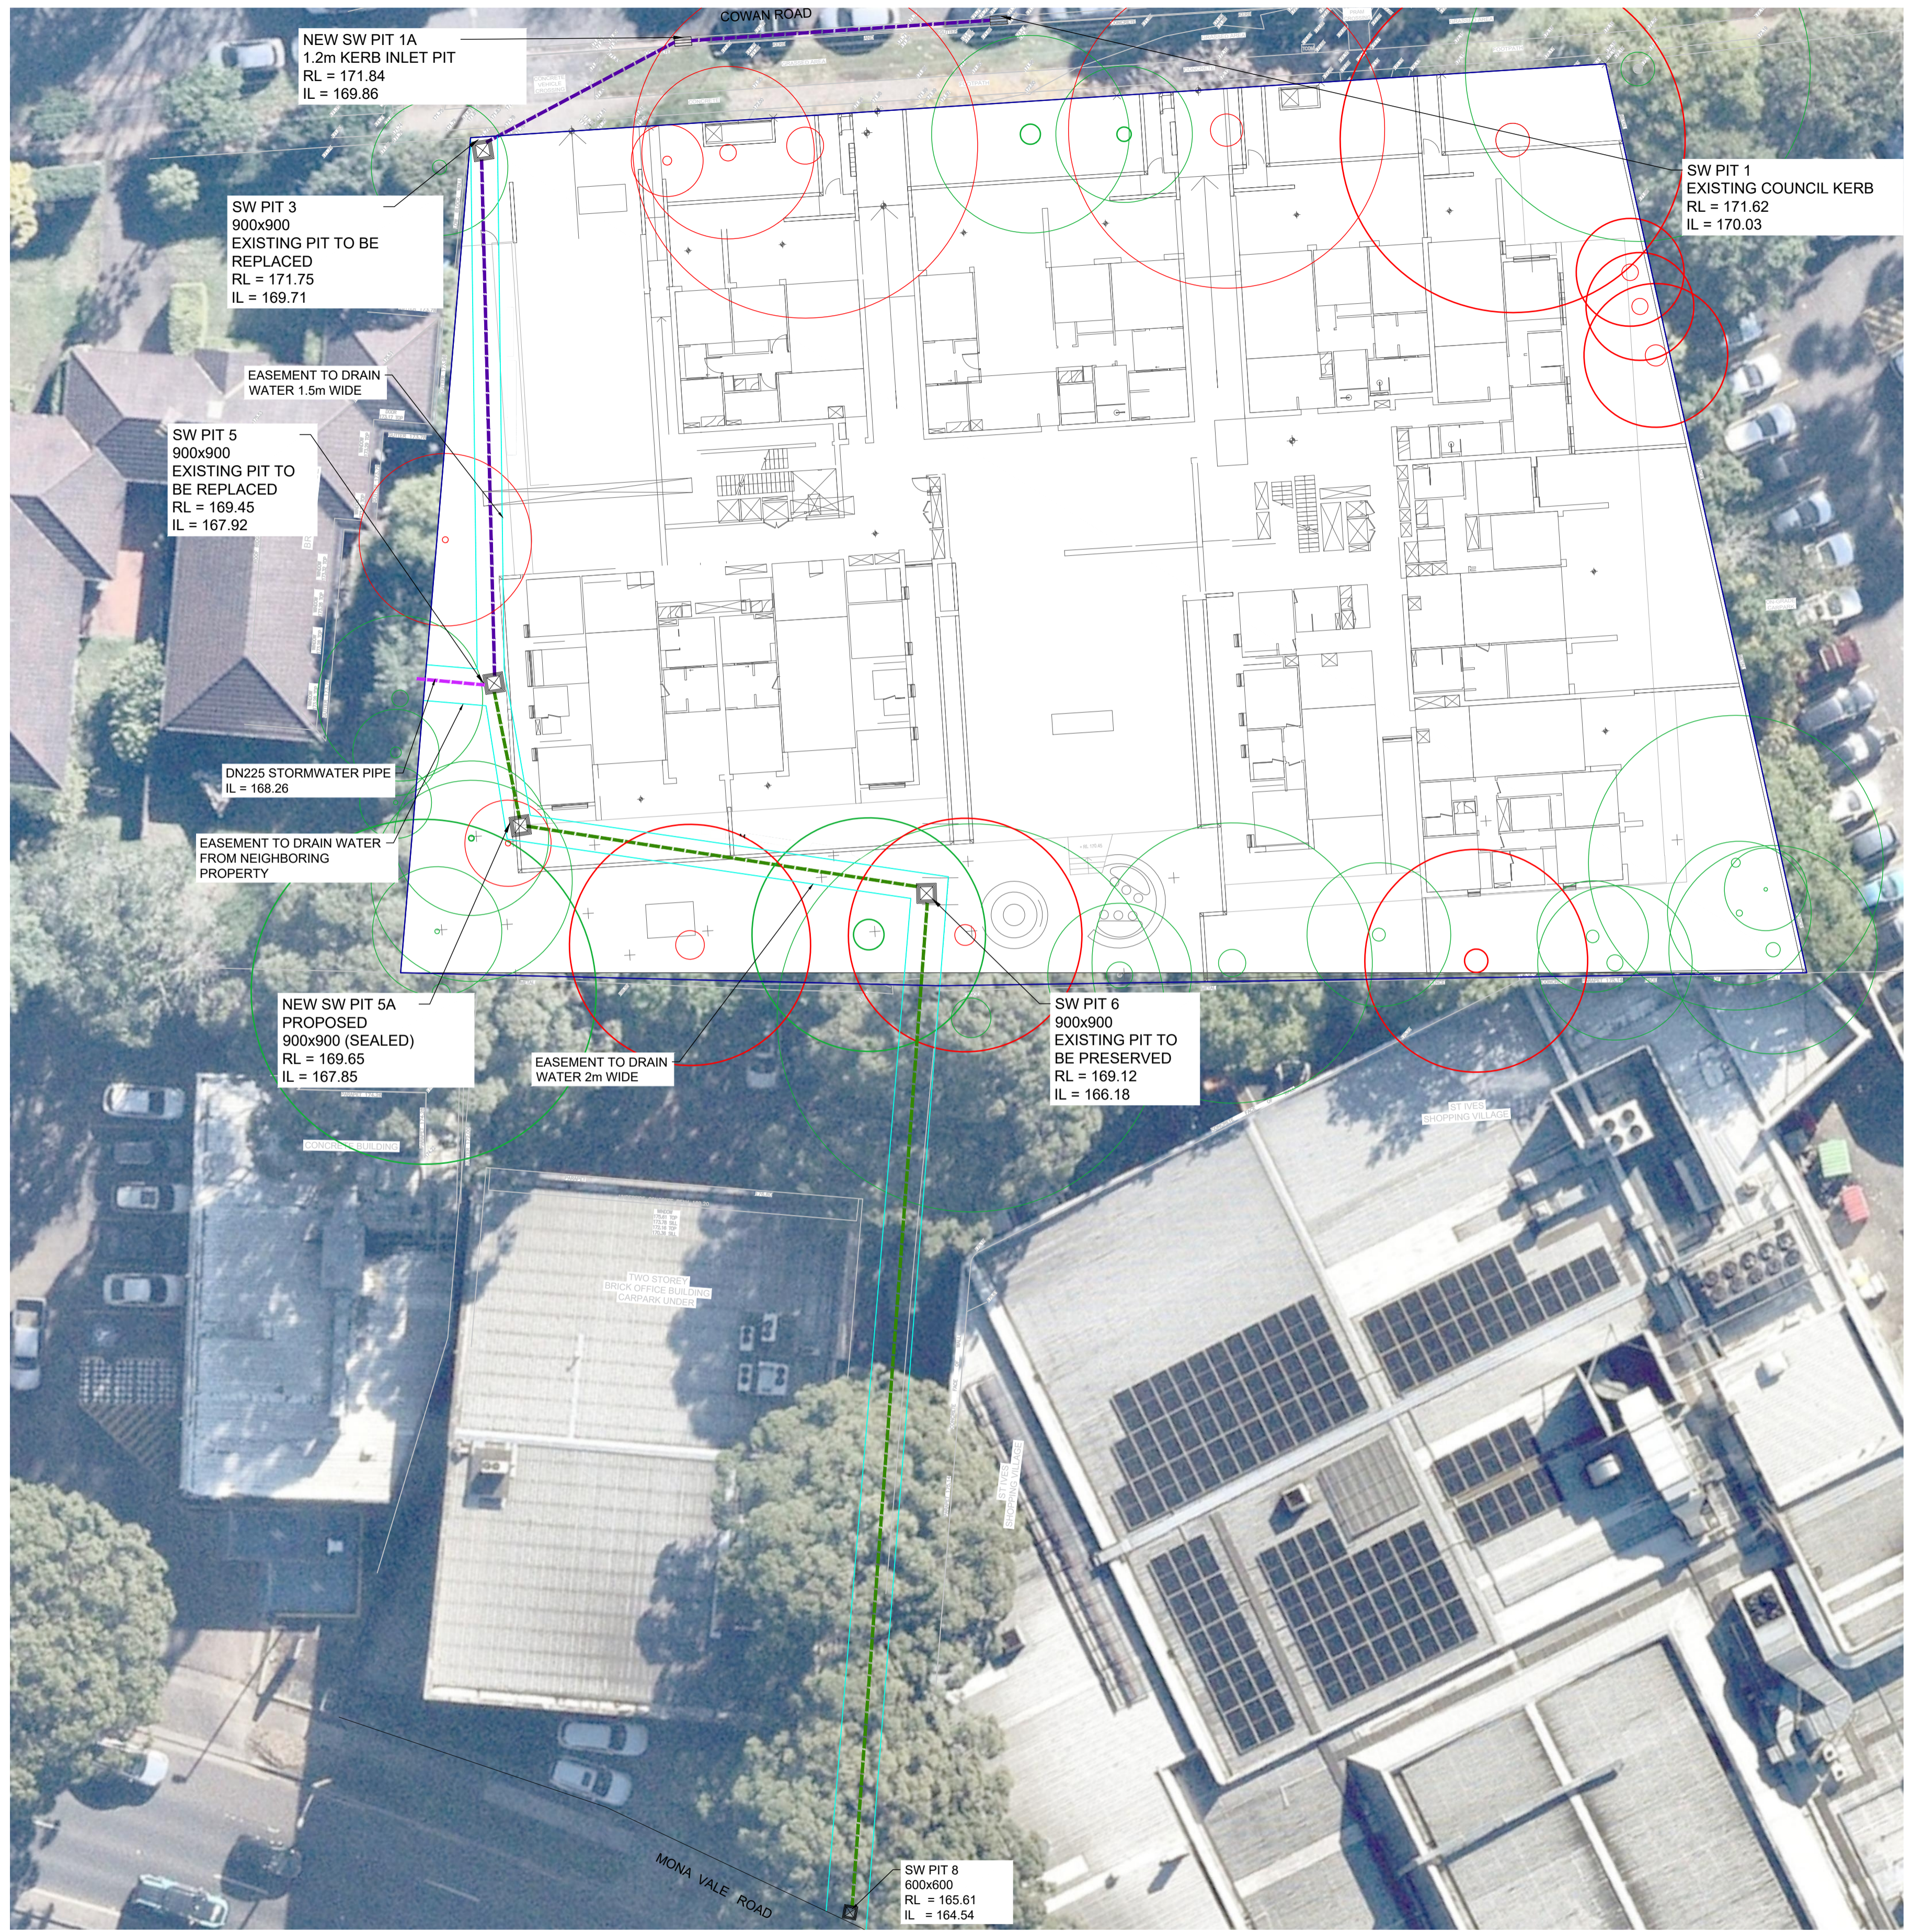

LEGEND

- SWD 225mm DRAINAGE PIPE
- SWD 375mm DRAINAGE PIPE
- SWD 450mm DRAINAGE PIPE
- TREE TO BE REMOVED
REFER TO ARBORIST REPORT
- TREE TO BE PROTECTED
REFER TO ARBORIST REPORT

DOWNSTREAM DRAINAGE EVALUATION NOTES


1. DIGITAL SURVEY SOLUTION HAS UNDERTAKEN A CCTV INVESTIGATION OF THE DOWNSTREAM STORMWATER DRAINAGE NETWORK AND PREPARED A REPORT IN CONJUNCTION WITH THE CCTV FOOTAGE.
2. THE EIC TEAM HAS EVALUATED THE CCTV FOOTAGE AND REPORT, AND HAS ADVISED THE CLIENT THAT A BLOCKAGE WAS OBSERVED IN THE STORMWATER LINE BETWEEN PIT 7 AND PIT 8, CLOSE TO PIT 8 AT THE DOWNSTREAM. THE BLOCKAGE IS MAINLY COMPRISED BY TREE LEAVES AND DEBRIS. EIC RECOMMENDS JET CLEANING FOR DEBRIS REMOVAL.
3. AN EARTHEN PIPE CONNECTION CAN BE SEEN IN THE DOWNSTREAM NETWORK, HOWEVER, IT CONNECTS TO THE NETWORK AT A HIGH ELEVATION. THEREFORE, NO IMPACTS TO THE FUNCTIONALITY OF THE STORMWATER NETWORK DUE TO THE EARTHEN PIPE ARE ANTICIPATED.
4. SOME CRACKING AND SMALL DISPLACEMENTS WERE OBSERVED IN THE CCTV FOOTAGE AND A SUMMARY OF THESE CRACKS IS DOCUMENTED FOR REFERENCE AND RECORD IN A MARKUP PREPARED BY EIC ON THE CCTV SURVEY
5. ASIDE FROM THESE OBSERVATIONS, THE PIPE BETWEEN PIT 7 AND PIT 8 GENERALLY APPEARS TO BE IN FUNCTIONAL ORDER.
6. REFER TO THE EIC INPUT, ALONG WITH CCTV FOOTAGE AND ASSOCIATED REPORT PROVIDED FOR COUNCIL ASSESSMENT AND ADVICE.

FOR SUBMISSION


Revision	Amendment	Issued By	Revision Date	COPYRIGHT - ALL RIGHTS RESERVED Copying or reproducing the whole or part of this document in any form without the written permission of EIAustralia constitutes an infringement of copyright. DISCLAIMER EIAustralia accepts no responsibility for the accuracy or for any consequence resulting from the use or alteration of this drawing in electronic form. Drawings in electronic form should be checked for accuracy against the equivalent hard copy issued by EIAustralia. DIMENSIONS Prior to commencing construction verify all dimensions against Architect's, other Consultant's and Sub-Contractor's drawings. For building work, dimensions are not to be scaled or read electronically from this drawing. Setout dimensions, unless specifically shown, are to be obtained from the Architect's or other Consultant's drawings. For civil engineering work, dimensions are not to be manually scaled from drawing. Setout dimensions, unless specifically shown, are to be read electronically from this drawing.	Architect	Client	Engineer	Project	Drawn	Designed	Approved
00	ISSUE FOR SUBMISSION	HR	19.12.25					5-9 COWAN RD, ST IVES, NSW 2075	HM	SA	HR
									Scale at A1. 220		
									Project No. S10751		
									Drawing No. C103		
									Revision 00		
									Title PROPOSED PIPE NETWORK PLAN		
									Issued By HR		
									Checked By HR		
									Date 19.12.25		



EI Australia
Suite 6.01
55 Miller Street
Pyrmont, NSW 2009
T 02 9516 0722

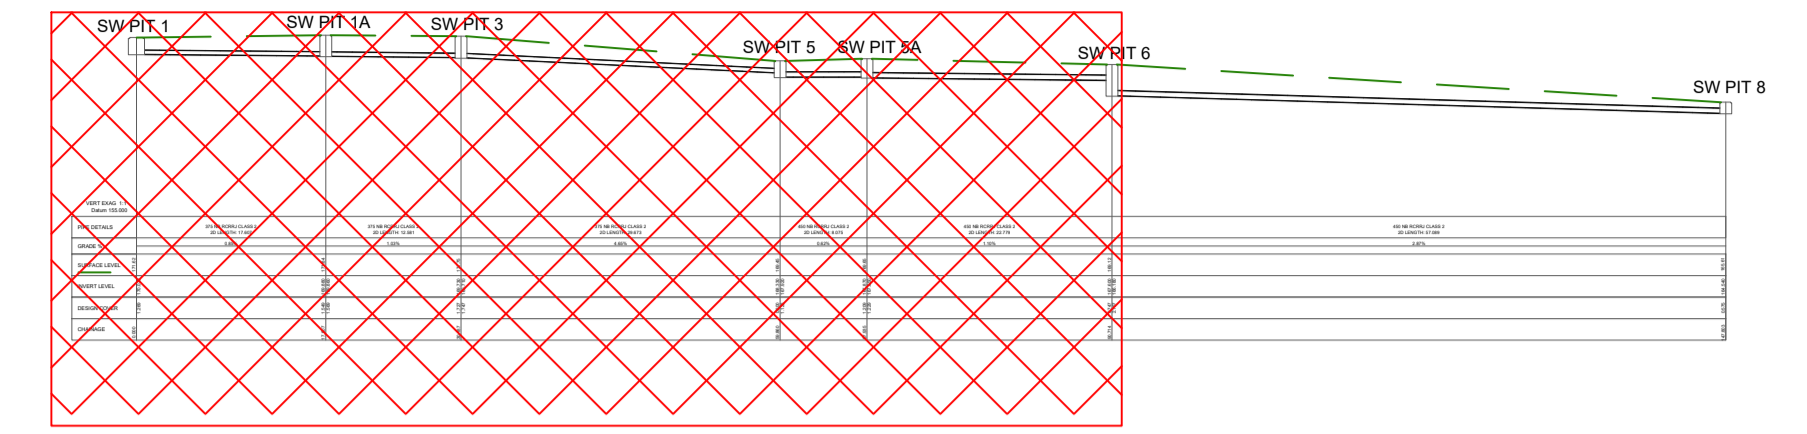

KEY PLAN

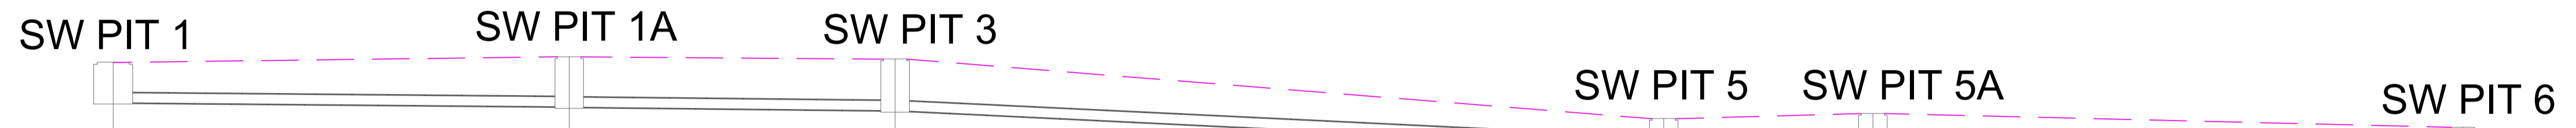

VERT EXAG 1:1
Datum 155.000

PIPE DETAILS	375 NB RCRRJ CLASS 2 2D LENGTH: 17.607	375 NB RCRRJ CLASS 2 2D LENGTH: 12.581	375 NB RCRRJ CLASS 2 2D LENGTH: 29.673	450 NB RCRRJ CLASS 2 2D LENGTH: 8.075	450 NB RCRRJ CLASS 2 2D LENGTH: 22.779
GRADE %	0.85%	1.03%	4.65%	0.62%	1.10%
SURFACE LEVEL	171.62	171.84	171.75	169.45	169.12
INVERT LEVEL	170.030	169.880 169.860	169.790 169.710	167.970 167.850	167.600
DESIGN COVER	1.569	1.549 1.569	1.727 1.747	0.580 1.120	0.747
CHAINAGE	0.000	17.607	30.187	59.860	67.935


PROPOSED PIPE NETWORK LONG-SECTION
SCALE = 1:150

FOR SUBMISSION

Revision	Amendment	Issued By	Revision Date	<small>COPYRIGHT - ALL RIGHTS RESERVED</small> <small>Copying or reproducing the whole or part of this document in any form without the written permission of EI Australia constitutes an infringement of copyright.</small> <small>DISCLAIMER</small> <small>EI Australia accepts no responsibility for the accuracy or for any consequence resulting from the use or alteration of this drawing in electronic form. Drawings in electronic form should be checked for accuracy against the equivalent hard copy issued by EI.</small> <small>DIMENSIONS</small> <small>Prior to commencing construction verify all dimensions against Architect's, other Consultant's and Sub-Contractor's drawings.</small> <small>For building work, dimensions are not to be scaled or read electronically from this drawing. Setout dimensions, unless specifically shown, are to be obtained from the Architect's or other Consultant's drawings.</small> <small>For civil engineering work, dimensions are not to be manually scaled from drawing. Setout dimensions, unless specifically shown, are to be read electronically from this drawing.</small>	Architect	Client	Engineer	Project	Drawn	Designed	Approved
00	ISSUE FOR SUBMISSION	HR	19.12.25					5-9 COWAN RD, ST IVES, NSW 2075	HM	SA	HR
								Project No.	Scale		
								S10751	at A1. 150		
								Title	Drawing No.	Revision	
								PROPOSED PIPE NETWORK LONG-SECTION	C104	00	
								Issued By	Checked By	Date	
								HR	HR	19.12.25	



EI Australia
Suite 6.01
55 Miller Street
Pyrmont, NSW 2009
T 02 9516 0722

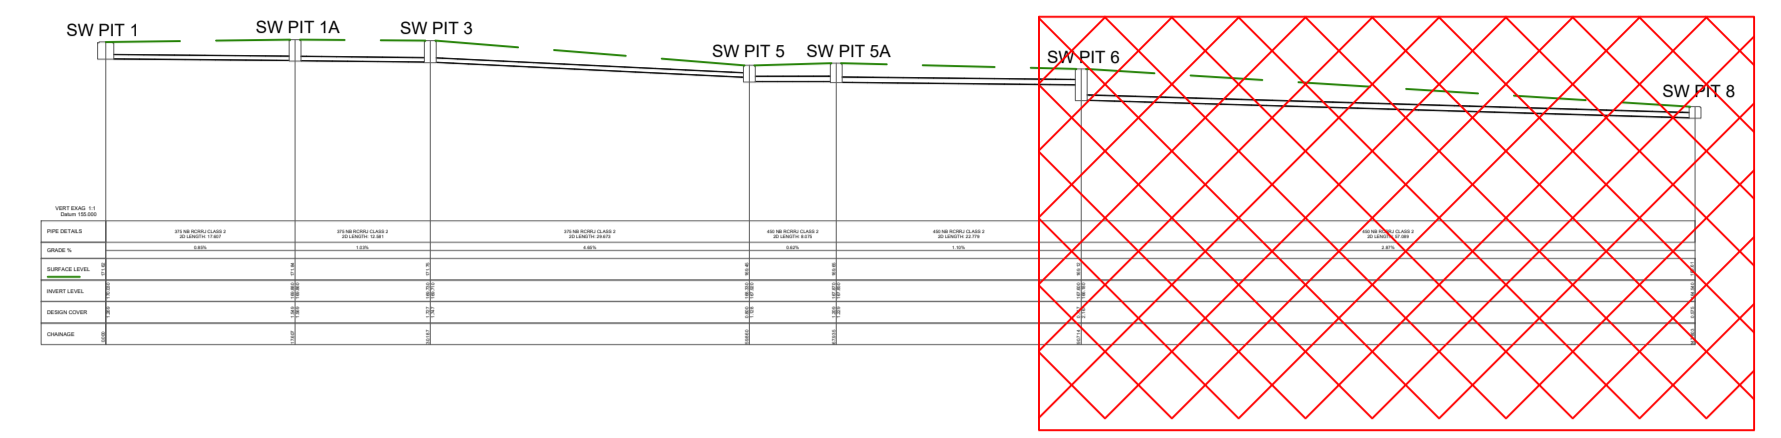

KEY PLAN


SW PIT 6

SW PIT 8


VERT EXAG 1:1 Datum 155.000	
PIPE DETAILS	450 NB RCRRJ CLASS 2 2D LENGTH: 57.089
GRADE %	2.87%
SURFACE LEVEL	166.12
INVERT LEVEL	166.180 164.540 165.61
DESIGN COVER	2.167 0.575
CHAINAGE	90.714 147.803

PROPOSED PIPE NETWORK LONG-SECTION
SCALE = 1:150

FOR SUBMISSION

Revision	Amendment	Issued By	Revision Date	COPYRIGHT - ALL RIGHTS RESERVED Copying or reproducing the whole or part of this document in any form without the written permission of EI Australia constitutes an infringement of copyright. DISCLAIMER EI Australia accepts no responsibility for the accuracy or for any consequence resulting from the use or alteration of this drawing in electronic form. Drawings in electronic form should be checked for accuracy against the equivalent hard copy issued by EI. DIMENSIONS Prior to commencing construction verify all dimensions against Architect's, other Consultant's and Sub-Contractor's drawings. For building work, dimensions are not to be scaled or read electronically from this drawing. Setout dimensions, unless specifically shown, are to be obtained from the Architect's or other Consultant's drawings. For civil engineering work, dimensions are not to be manually scaled from drawing. Setout dimensions, unless specifically shown, are to be read electronically from this drawing.	Architect	Client	Engineer	Project	Drawn	Designed	Approved
00	ISSUE FOR SUBMISSION	HR	19.12.25				 EI Australia Suite 6.01 55 Miller Street Pyrmont, NSW 2009 T 02 9516 0722	5-9 COWAN RD, ST IVES, NSW 2075	HM	SA	HR
								Project No.	Scale		
								S10751		at A1. 150	
								Drawing No.		Revision	
								C105		00	
								Issued By	Checked By	Date	
								HR	HR	19.12.25	

300mm
200mm
100
50
0 10mm

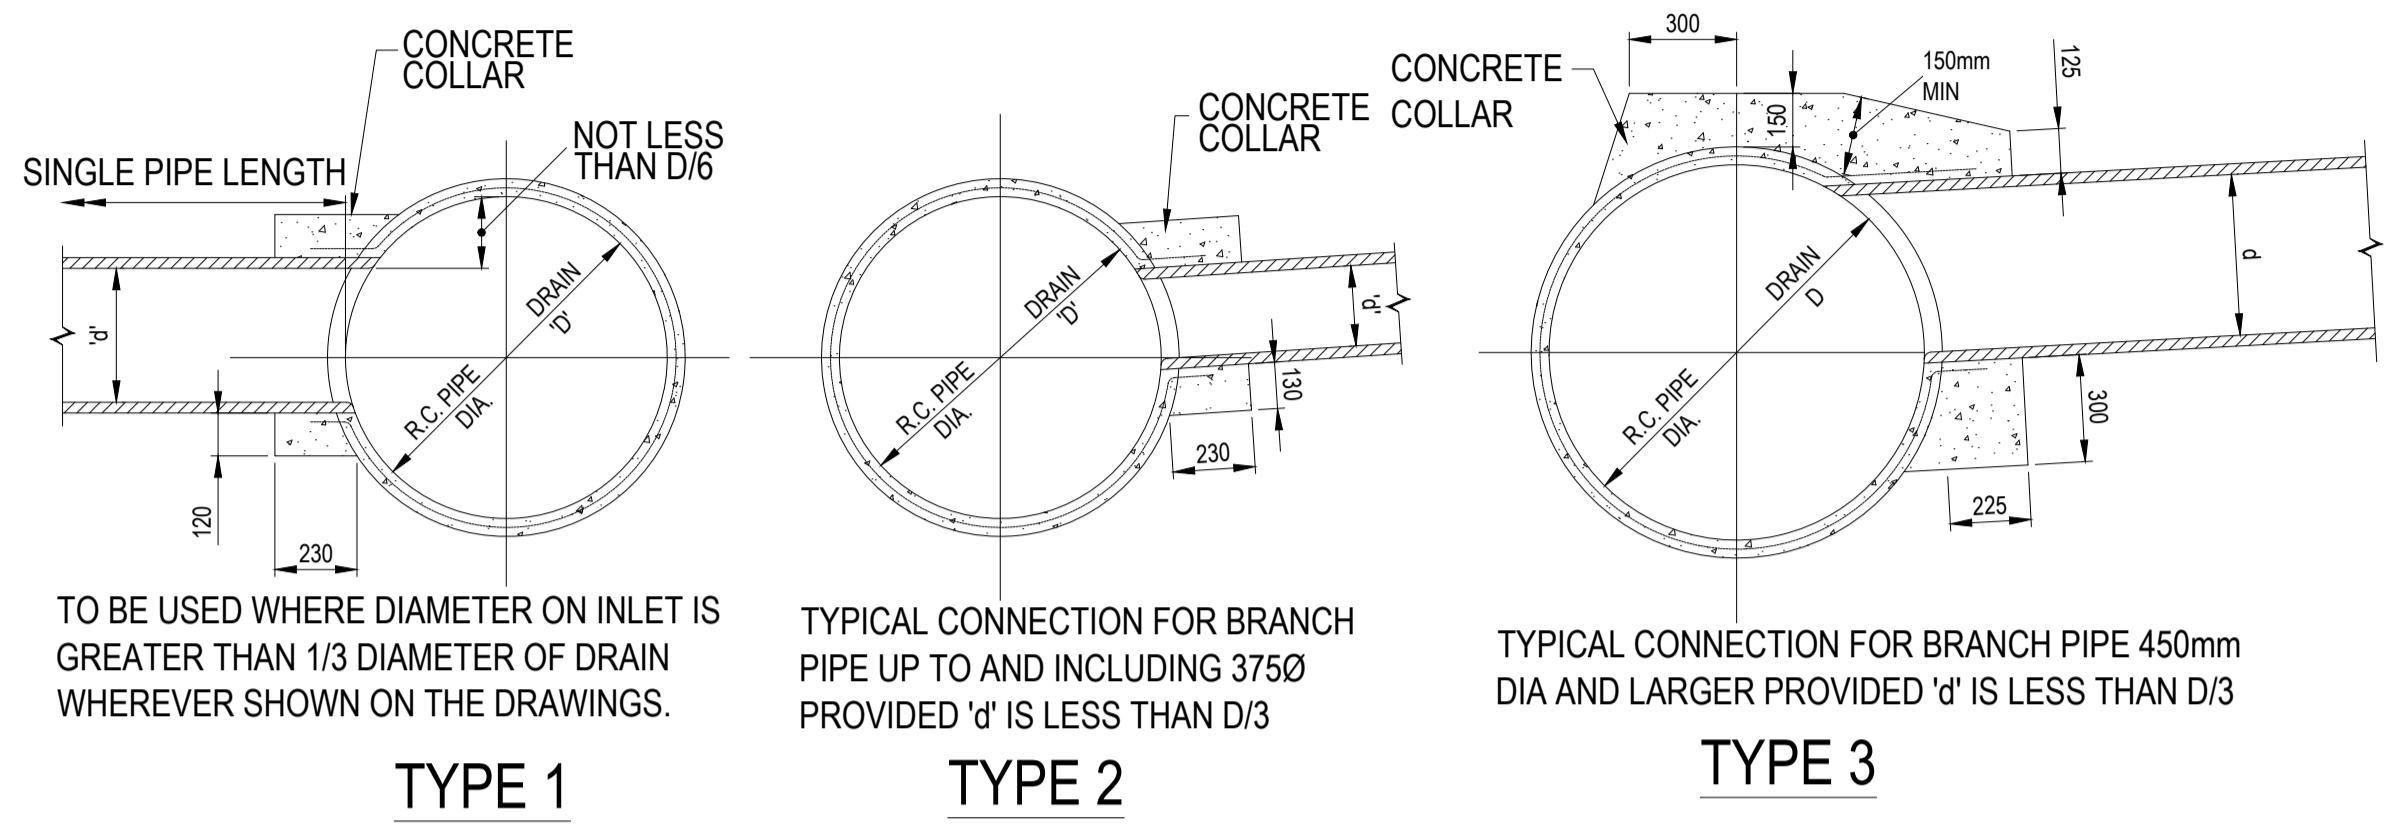


TO BE USED WHERE DIAMETER ON INLET IS GREATER THAN 1/3 DIAMETER OF DRAIN WHEREVER SHOWN ON THE DRAWINGS.

TYPICAL CONNECTION FOR BRANCH PIPE UP TO AND INCLUDING 375Ø PROVIDED 'd' IS LESS THAN D/3


TYPICAL CONNECTION FOR BRANCH PIPE 450mm DIA AND LARGER PROVIDED 'd' IS LESS THAN D/3

TYPE 1 TYPE 2 TYPE 3

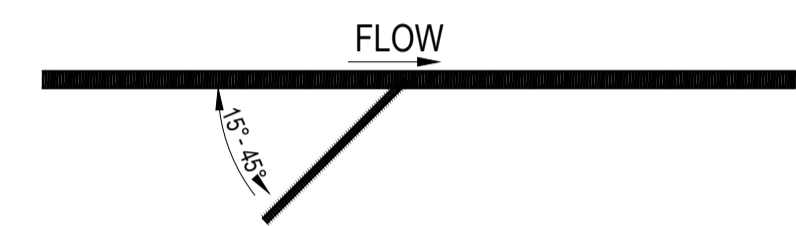

CONNECTION TO MAIN DRAIN

- PREFERENCE SHOULD BE GIVEN TO ANGLING CONNECTION DOWNSTREAM
1. REINFORCEMENT IN PIPE TO BE CUT AND FORMED INTO COLLAR. ALL CARE SHALL BE TAKEN TO PREVENT DAMAGE TO THE PIPE.
 2. CEMENT MORTAR JOINTING TO BE NEATLY RENDERED ON THE INSIDE OF THE DRAIN.
 3. WHERE CONNECTION CANNOT BE RENDERED FROM INSIDE MAIN PIPE, CONNECTION TO CONSIST OF 300mm. MAXIMUM LENGTH INCOMING PIPE TO ALLOW RENDERING FROM OUTSIDE.

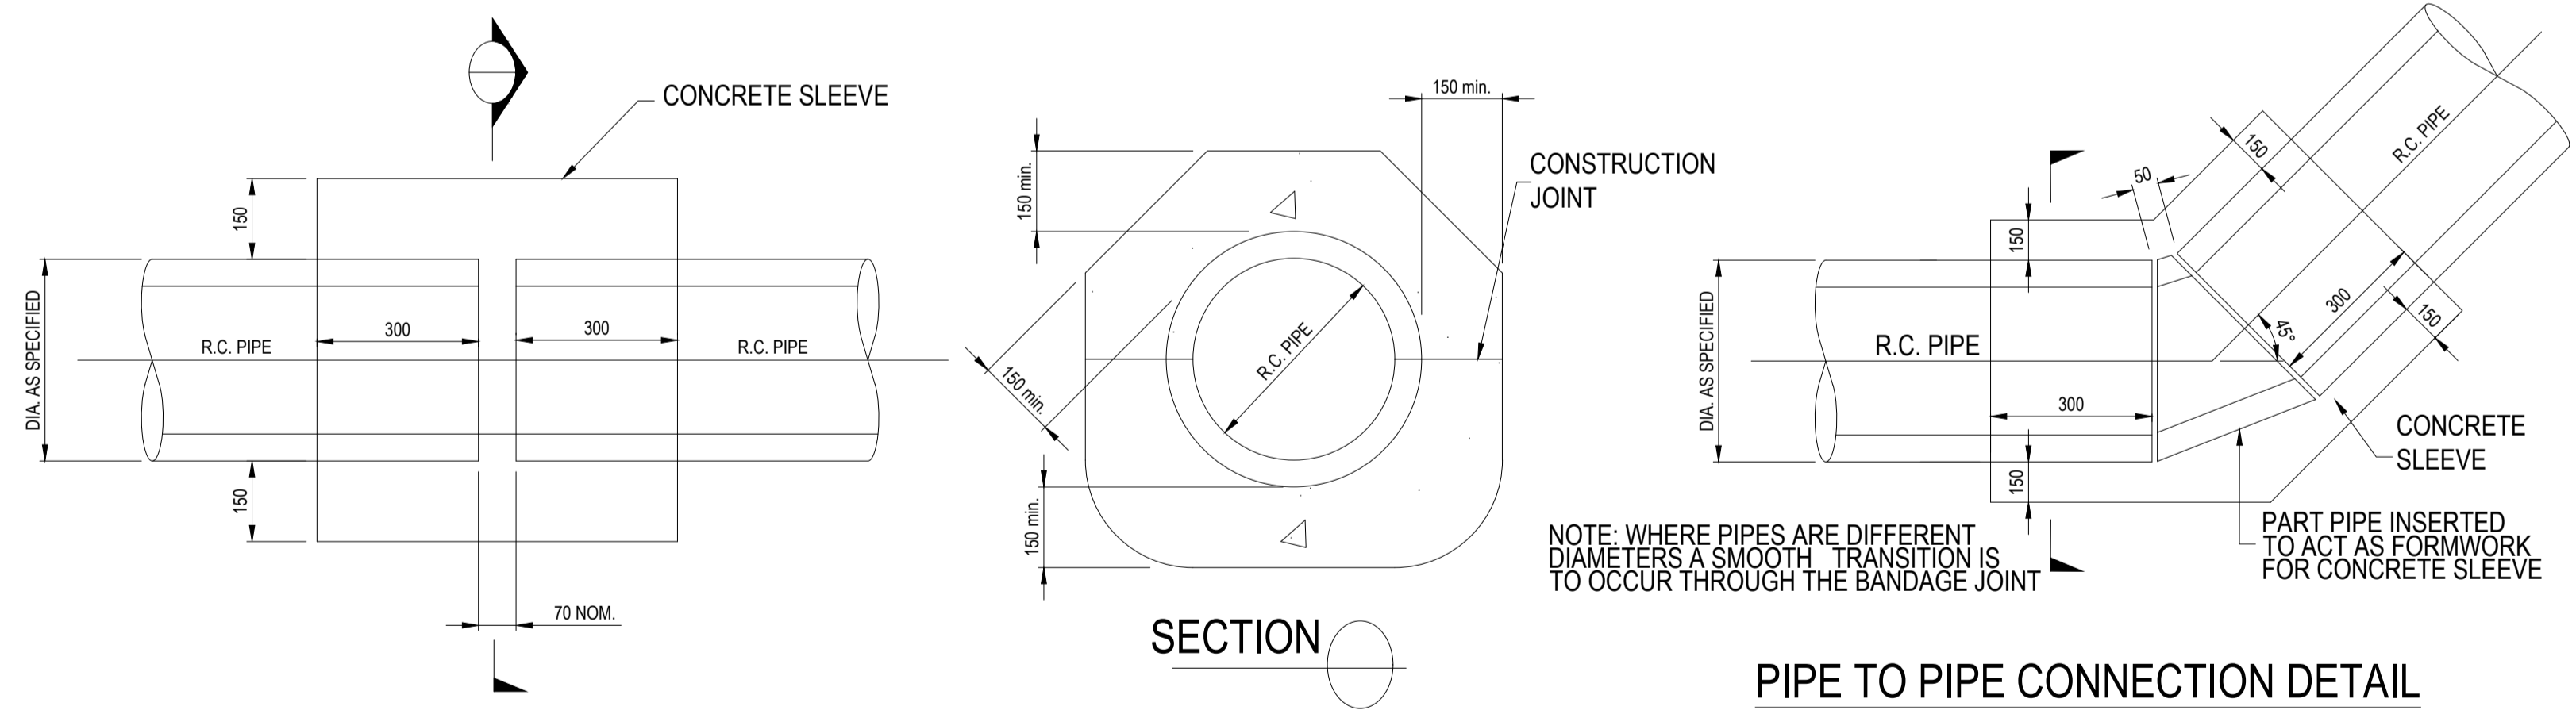

PIPE TO PIPE CONNECTION DETAIL PIPE TO PIPE CONNECTION DETAIL

NOTE: WHERE PIPES ARE DIFFERENT DIAMETERS A SMOOTH TRANSITION IS TO OCCUR THROUGH THE BANDAGE JOINT

PART PIPE INSERTED TO ACT AS FORMWORK FOR CONCRETE SLEEVE

DEPTH OF INVERT OF OUTLET	RECTANGULAR		CIRCULAR
	WIDTH	LENGTH	DIAMETER
<= 600	450	450	600
> 600 <= 900	600	600	900
> 900 <= 1200	600	900	1000
> 1200	900	900	1000


AS3500 03-2015 - TABLE 7.5.2.1

DESIGN NOTES

1. IN-SITU CONCRETE MINIMUM 25MPa IN ACCORDANCE WITH AS1379 AND AS3600. CONCRETE TO BE MINIMUM 150mm THICK.
2. GRATES ON PUBLIC ROADS ARE TO BE CLASS D IN TRAFFICABLE LOCATIONS. MINIMUM CLASS B IN NON-TRAFFICABLE LOCATIONS. GRATE TO BE INSTALLED SO HINGE IS CLOSEST TO APPROACHING VEHICLES.
3. GRATES WITHIN PRIVATE PROPERTIES ARE SUBJECT TO APPROVAL. CLASS D GRATES CAN BE SUBSTITUTED WITH CLASS C 'TERRA FIRMA' TYPE LID IN PEDESTRIAN OR CAR ONLY LOCATIONS WITH LOW RISK OF SURCHARGE. LID TO BE INSTALLED SO LOCK IS FURTHEST AWAY FROM ANY OBSTRUCTIONS.
4. ALL PIPES ARE TO BE LAID IN ACCORDANCE WITH AS3725. REFER TO COUNCIL DRAWING 2004-010.
5. STEP IRONS ARE TO BE INSTALLED IN ACCORDANCE WITH AS1657 FOR PITS DEEPER THAN 1200mm.
6. INSTALL MINIMUM 3m LONG 100 DIAMETER SUB-SOIL PIPE. MAX 50mm ABOVE PIPE INVERT ON ALL INLET PIPES. PROVIDE WEEPHOLE ON UPSTREAM SIDE OF FIRST PIT.
7. MINIMUM INTERNAL PIT DIMENSIONS AS PER AS3500 3-2015 TABLE 7.5.2.1.
8. PITS WITH A DEPTH OF 1.0m OF LESS DOES NOT REQUIRE REINFORCEMENT. PITS WITH A DEPTH OF 1.0m TO 2.0m REQUIRE REINFORCEMENT WITH SL82 OR N12-200 EACH WAY. PITS WITH DEPTH OF 2.0m OR MORE REQUIRE REINFORCEMENT WITH SL82 AND N12-200 EACH WAY. MINIMUM 50mm COVER TO REINFORCEMENT.
9. CONSTRUCTION JOINTS ARE TO INCLUDE N12 GALVANISED STARTER BARS. MINIMUM 600mm LONG EVENLY EMBEDDED. MAXIMUM 150mm SPACING 0500 AS4671.
10. PRIVATE CONNECTION PIPES ARE TO BE LOCATED WITH AN INVERT AT MINIMUM 100mm ABOVE PIT INVERT AND OBVERT MINIMUM 100mm BELOW UNDERSIDE OF GRATE/LID FRAME.
11. USE OF PRECAST PITS ARE SUBJECT TO COUNCIL APPROVAL. IN PUBLIC ROADS OR AREAS SUBJECT TO VEHICULAR TRAFFIC ONLY AUS PRECAST STORMWATER PITS, DURHAM SOLID WALL (MINIMUM 150mm THICK) OR SIMILAR WILL BE CONSIDERED. PUNCH OUT TYPE PITS WILL NOT BE CONSIDERED EXCEPT AS SACRIFICIAL FORMWORK.
12. ALL DIMENSIONS ARE IN MILLIMETRES UNLESS NOTED OTHERWISE.

(SOURCE: KU-RING-GAI COUNCIL TECHNICAL GUIDELINE FOR WATER MANAGEMENT)

NOTES: THESE DETAILS HAVE BEEN SHOWN FOR INFORMATION ONLY USING COUNCIL STANDARD DETAILS

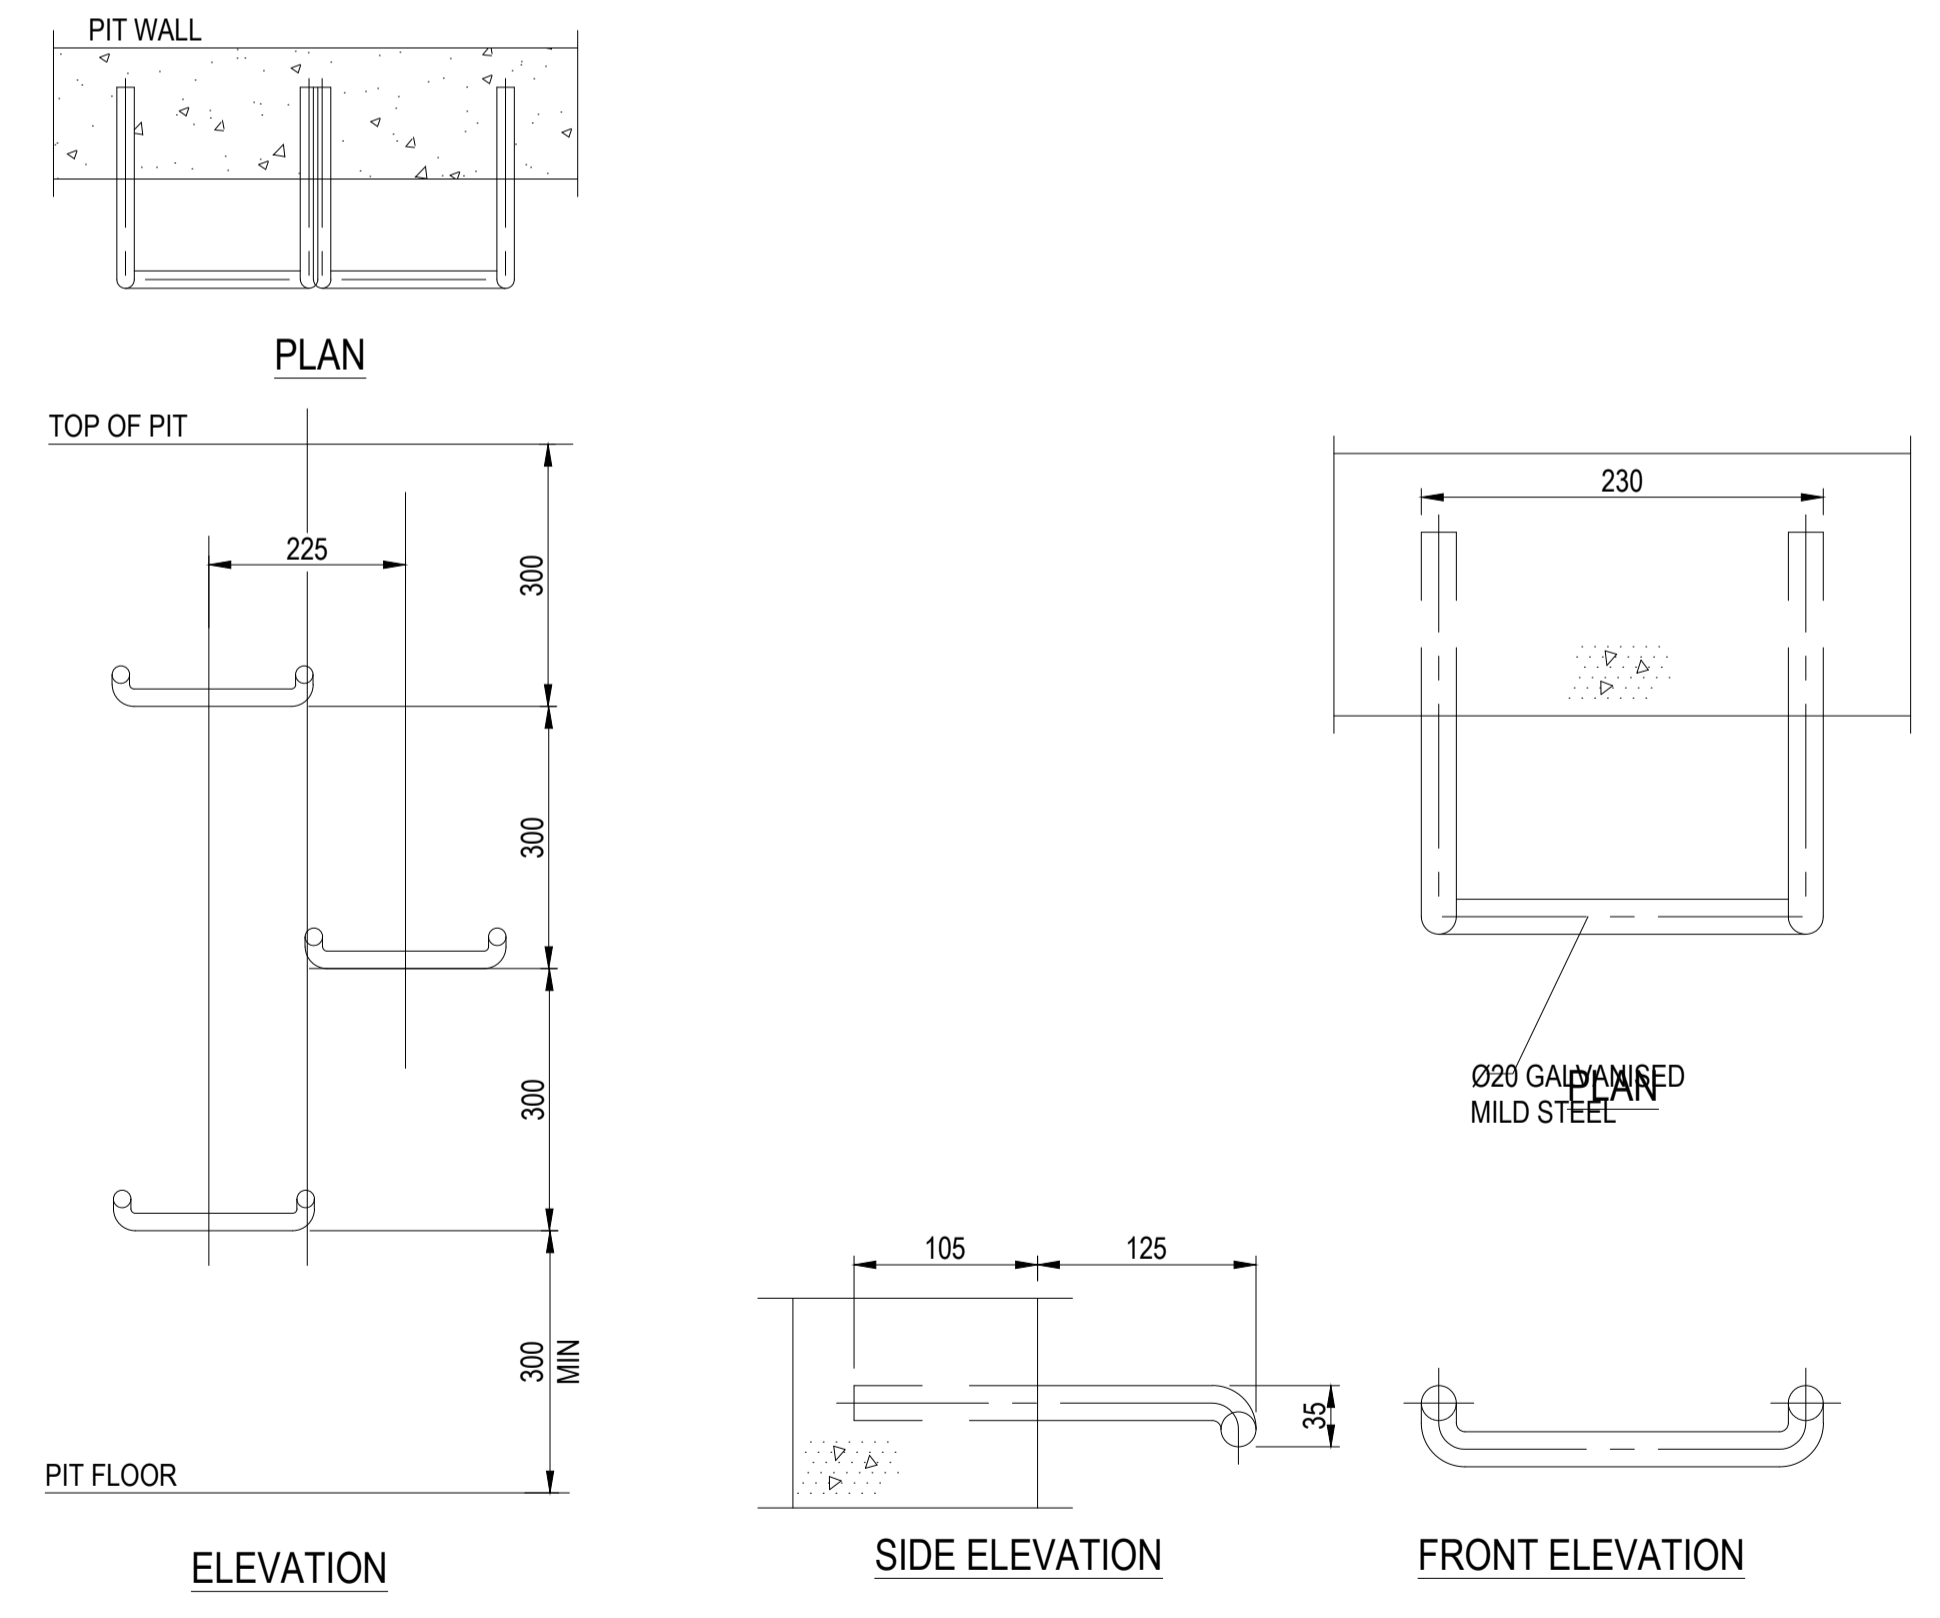


STEP IRON PLACEMENT TO PIT WALL STEP IRON DETAIL

FOR SUBMISSION

Revision	Amendment	Issued By	Revision Date	Copyright - All Rights Reserved	Architect	Client	Engineer	Project	Drawn	Designed	Approved
00	ISSUE FOR SUBMISSION	HR	19.12.25	Copying or reproducing the whole or part of this document in any form without the written permission of EI Australia constitutes an infringement of copyright.				5-9 COWAN RD, ST IVES, NSW 2075	HM	SA	HR
				DISCLAIMER EI Australia accepts no responsibility for the accuracy or for any consequence resulting from the use or alteration of this drawing in electronic form. Drawings in electronic form should be checked for accuracy against the equivalent hard copy issued by EI.					Project No.	Scale	
				DIMENSIONS Prior to commencing construction verify all dimensions against Architect's, other Consultant's and Sub-Contractor's drawings. For building work, dimensions are not to be scaled or read electronically from this drawing. Setout dimensions, unless specifically shown, are to be obtained from the Architect's or other Consultant's drawings. For civil engineering work, dimensions are not to be manually scaled from drawing. Setout dimensions, unless specifically shown, are to be read electronically from this drawing.					Title	Revision	
								STANDARD DETAILS	C106	00	
									Issued By	Checked By	Date
									HR	HR	19.12.25



EI Australia
Suite 6.01
55 Miller Street
Pyrmont, NSW 2009
T 02 9516 0722

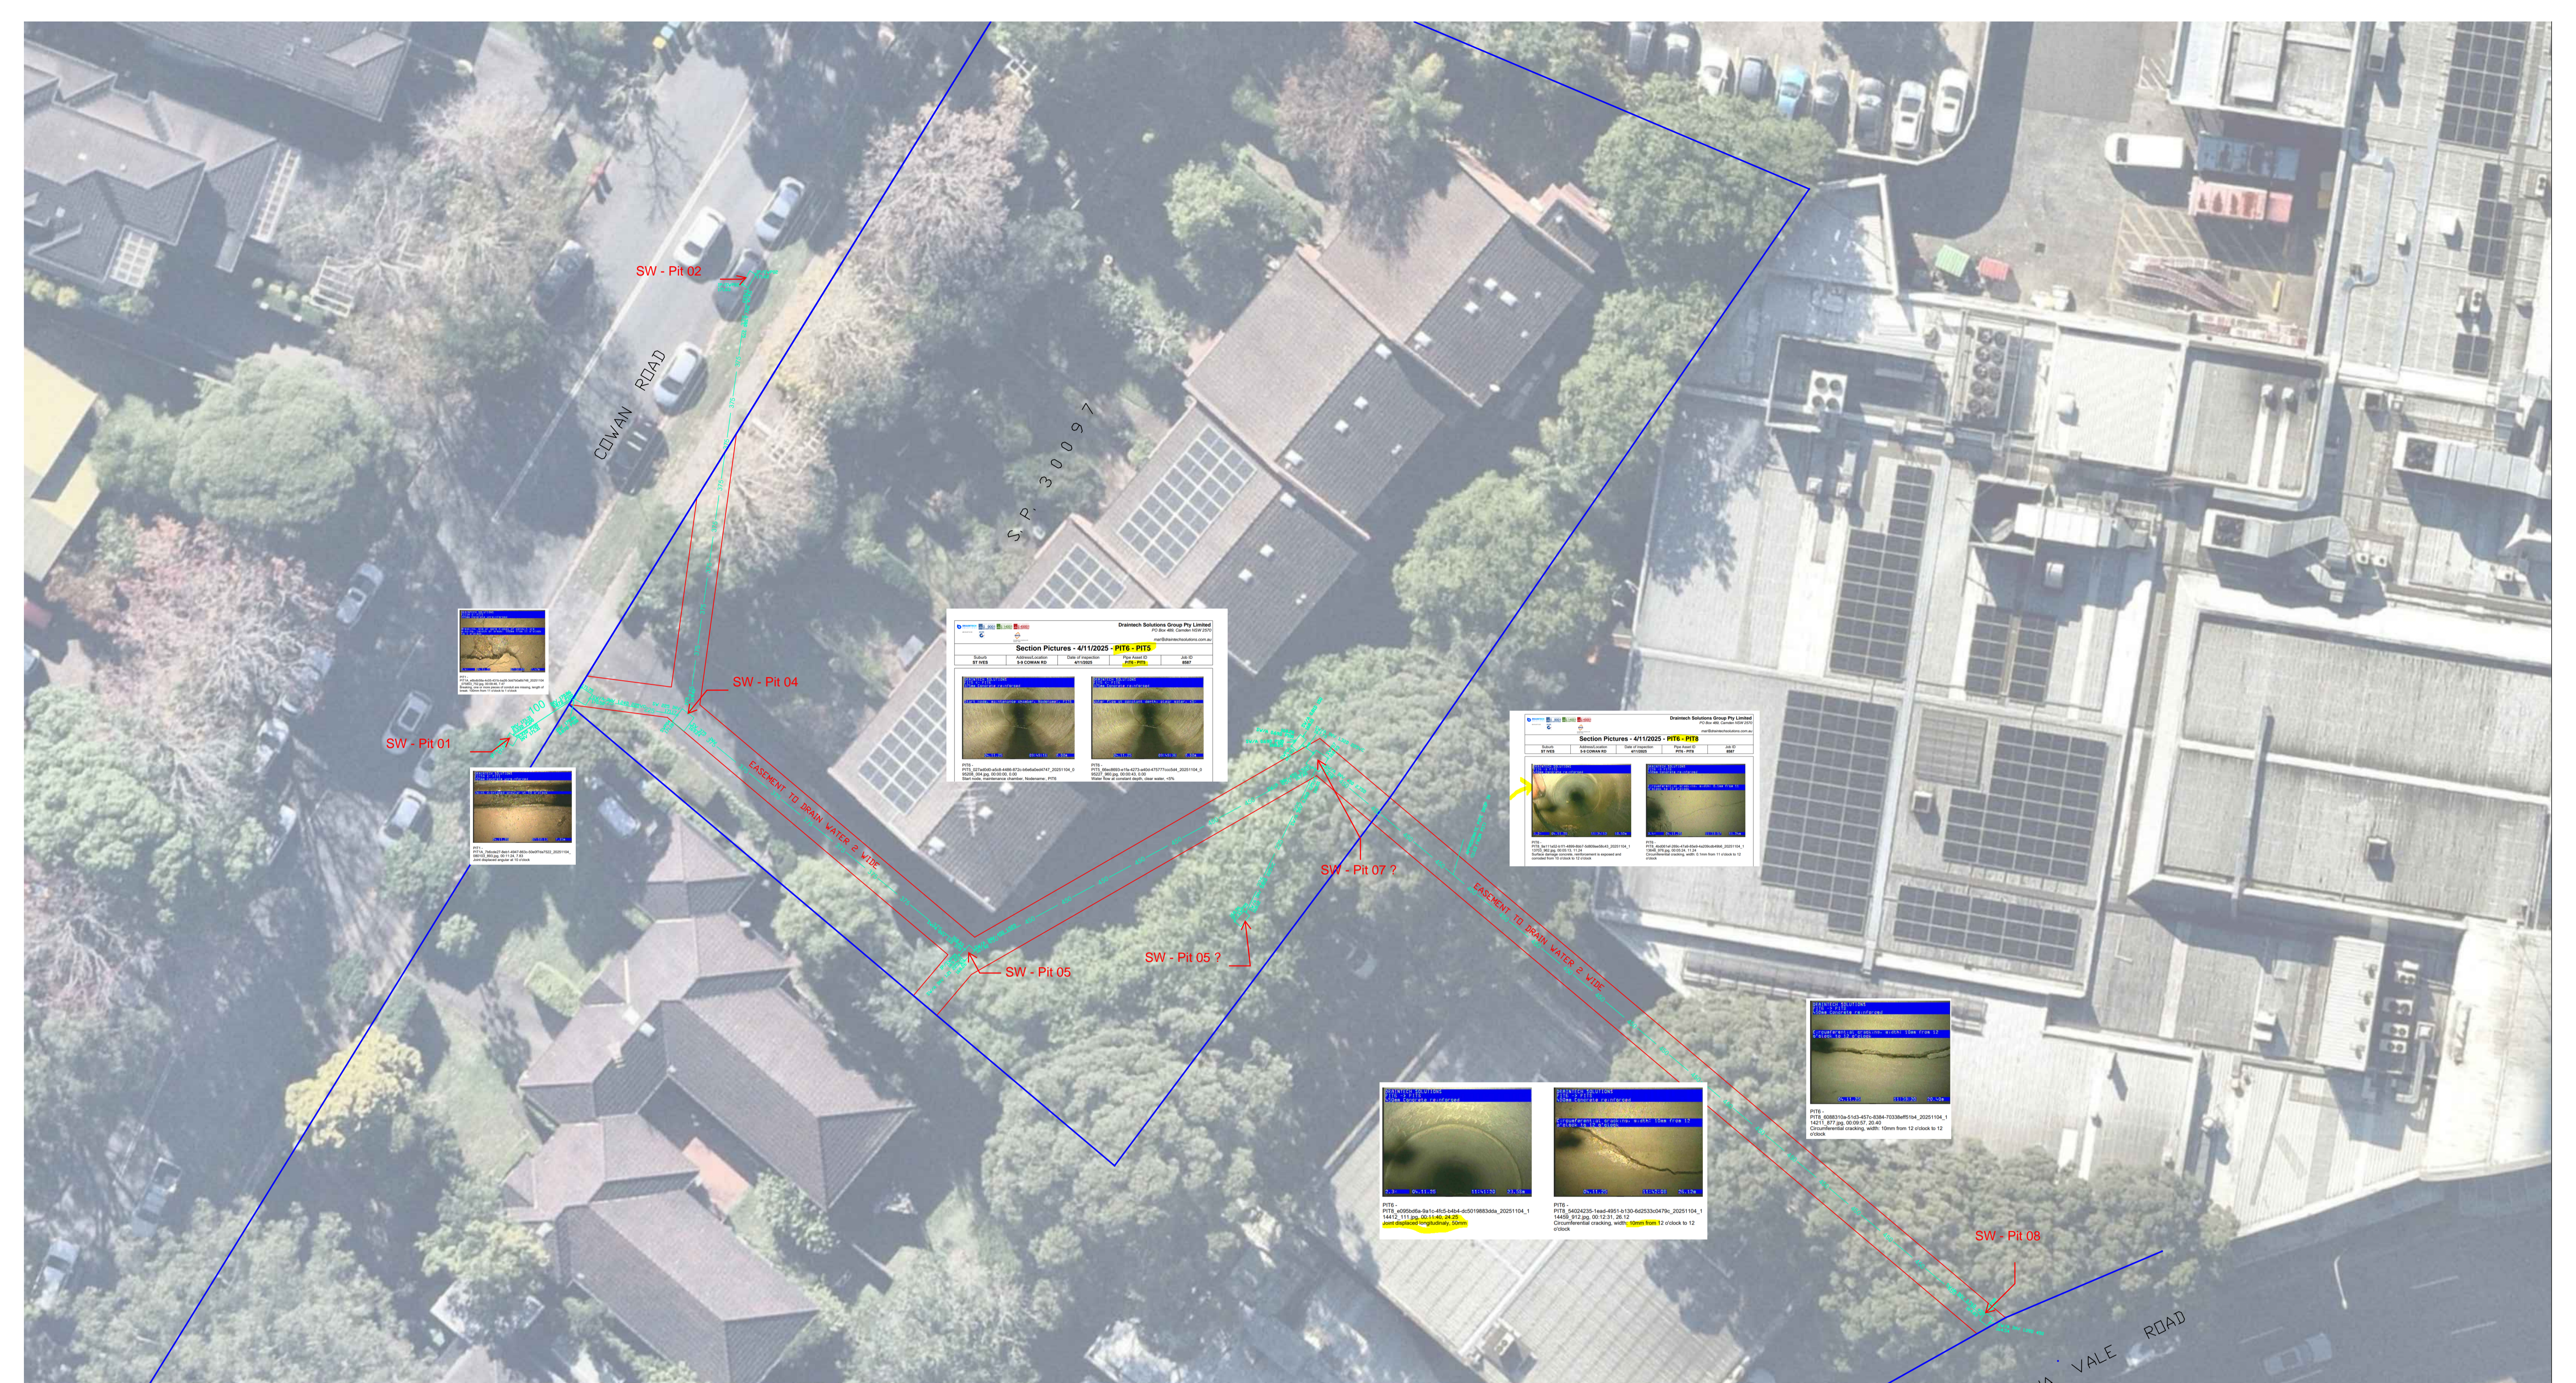

UTILITY ASSETS LEGEND	
ELECTRICITY - DIGITISED	—E2— E2—
COMMS TELEPHONE LINE	—T— T—
COMMS LINE - DIGITISED	—TZ— TZ—
COMMS OPTICAL FIBRE	—OU— OU—
OPTIC FIBRE - DIGITISED	—OZ— OZ—
COMMS HOUSE CONNECTION	—TW— TW—
WATER MAIN - DIGITISED	—WZ— WZ—
WATER MAIN - DIGITISED	—W— W—
WATER HOUSE CONNECTION	—WH— WH—
FIRE HYDRANT CONNECTION	——
HIGH PRESSURE GAS	—HG— HG—
LOW PRESSURE GAS	—LG— LG—
GAS MAIN - DIGITISED	—GZ— GZ—
GAS HOUSE CONNECTION	—GH— GH—
SEWER MAIN	—S— S—
SEWER MAIN - DIGITISED	—SZ— SZ—
STORMWATER PIPE	—SW— SW—
STORMWATER - DIGITISED	—DZ— DZ—
OVERHEAD ELECTRICITY	—OH— OH—
UNIDENTIFIED PIPELINE	—?— ?—

UTILITY MAPPING NOTES:

- Subsurface utility investigation was undertaken by Astrea Pty Ltd. The plan is to be read in conjunction with the subsurface utility investigation report.
- Positions are based on Astrea Class A & B point surface indicator(s) located during field survey. Confirmation of the exact position should be made to the relevant authorities prior to any excavation work. Other services may still exist.
- This plan shows a representation of the utility model. This model should be viewed in a CAD environment to integrate this information.
- This utility plan is valid for 28 days starting from the date of the issue, as underground utility works are often updated.
- Electricity cables are not necessarily enclosed in conduits and are not necessarily covered with markers, tape or other indicators of their presence.
- Services have been electronically traced in the field and are shown here for diagrammatic purposes only. Depths shown are approximate only and should be verified prior to works.
- This plan includes information describing the location of subterranean features, which were purported to exist at the time of the survey. This information was compiled from a combination of field techniques and available data from cooperating utility authorities. Whilst all care has been taken in the preparation of this plan of survey, we cannot guarantee that the plan is without flaw of any kind.

SUBSURFACE UTILITY INFORMATION (SU) AS5488 LOCATION CLASS

Labelling utility information by a classification code allows the user of this information to understand clearly how the information was collected and then place an appropriate amount of reliance on it. Project risks related to underground utilities can then be managed.

GENERAL SURVEY LEGEND:

DP - DRAINAGE PIT
 PJM - DRAINAGE JUNCTION MANHOLE
 PSQL - GULLY PIT
 PSMH - SEWER MANHOLE
 PSLH - SEWER LAMPHOLE
 PSLV - SEWER VENT PIPE
 PWHV - HYDRANT
 PWSV - STOP VALVE
 PWTR - WATER TAP
 PWRM - WATER METER
 PWRB - FIRE BOOSTER
 PRTF - GAS TEST POINT
 PPLP - POWER POLE
 PULP - LIGHT POLE
 PPOL - POLE UNKNOWN
 PERB - ELECTRICITY JUNCTION BOX
 PEMH - ELECTRICITY MANHOLE
 PGLN - GARDEN LIGHT
 PISP - TELEPHONE PIT
 PTPP - TELEPHONE POLE

UP - UNKNOWN PIPELINE
 FH - FIRE SERVICE LINE
 UTO - UNABLE TO OPEN
 FOW - FULL OF WATER
 FOD - FULL OF DIRT
 EOT - END OF TRACE
 UTT - UNABLE TO TRACE
 TKRB - TOP OF KERB
 BK - BACK OF KERB
 PC - PRAM RAMP
 FP - FOOTPATH
 FC - FENCE
 OM - MISCELLANEOUS STRUCTURE
 LP - LIP LINE
 FL - KERB FLOW LINE
 DW - DRIVEWAY
 PSN - SIGN
 BW - BOTTOM OF WALL

Scale: 1:200
 GDA 2020
 ORIGIN: SS 126519 E 329261.337 N 6266322.309
 ORIENTATION: SS 126519 - PM 2486
 AHD ORIGIN: SS 126519 RL 172.58

GENERAL SURVEY NOTES:

- * THIS TITLEBLOCK IS AN INTEGRAL PART OF THIS DWG AND SHOULD NOT BE REMOVED
- * COORDINATE SYSTEM MGA 2020
- * LEVEL DATUM IS AHD
- * IT IS THE RESPONSIBILITY OF ANY USER OF THIS DATA TO ENSURE ANY OTHER DATA BEING INTEGRATED IS ON THE SAME COORDINATE SYSTEM
- * REFER TO THE FACE OF THE PLAN FOR TITLE NOTATIONS
- * BOUNDARIES HAVE NOT BEEN DEFINED BY SURVEY
- * CONTOURS ARE INDICATIVE OF LAND FORM. SPOT LEVELS TAKE PRECEDENCE.

CLIENT : GROWTHBUILT
PLAN IN RELATION TO : 5-9 COWAN ROAD, ST IVES
SHOWING : DRAINAGE INVESTIGATION IN ACCORDANCE WITH AS5488.1-2019
PURPOSE: ENGINEERING DESIGN
SHEET 01 OF 01

DIGITAL SURVEY SOLUTIONS
UTILITY MAPPING
 SUITE 6.01, TRINITY II, TRINITY BUSINESS PARK
 39 DELHI ROAD, NORTH RYDE 2113
 SCOTT DEVERIDGE 0425 285 270
 www.astrea.com.au

JOB REFERENCE : A6155		I/D
DWG No. A6155 ST IVES-REV A		7453
SURVEYOR: SD		SCOTT DEVERIDGE
DATE OF SURVEY: JUN 2025		REGISTERED LAND SURVEYOR
UTILITY LOCATOR:		UNDER THE SURVEYING AND SPATIAL INFORMATION ACT, 2002
© ASTREA 2025 - UNAUTHORISED USE IS PROHIBITED		
A	DROP IN PIPE ADDED	13-11-2025
REV	AMENDMENTS	DATE

