



1 ELEVATION D
1 : 200

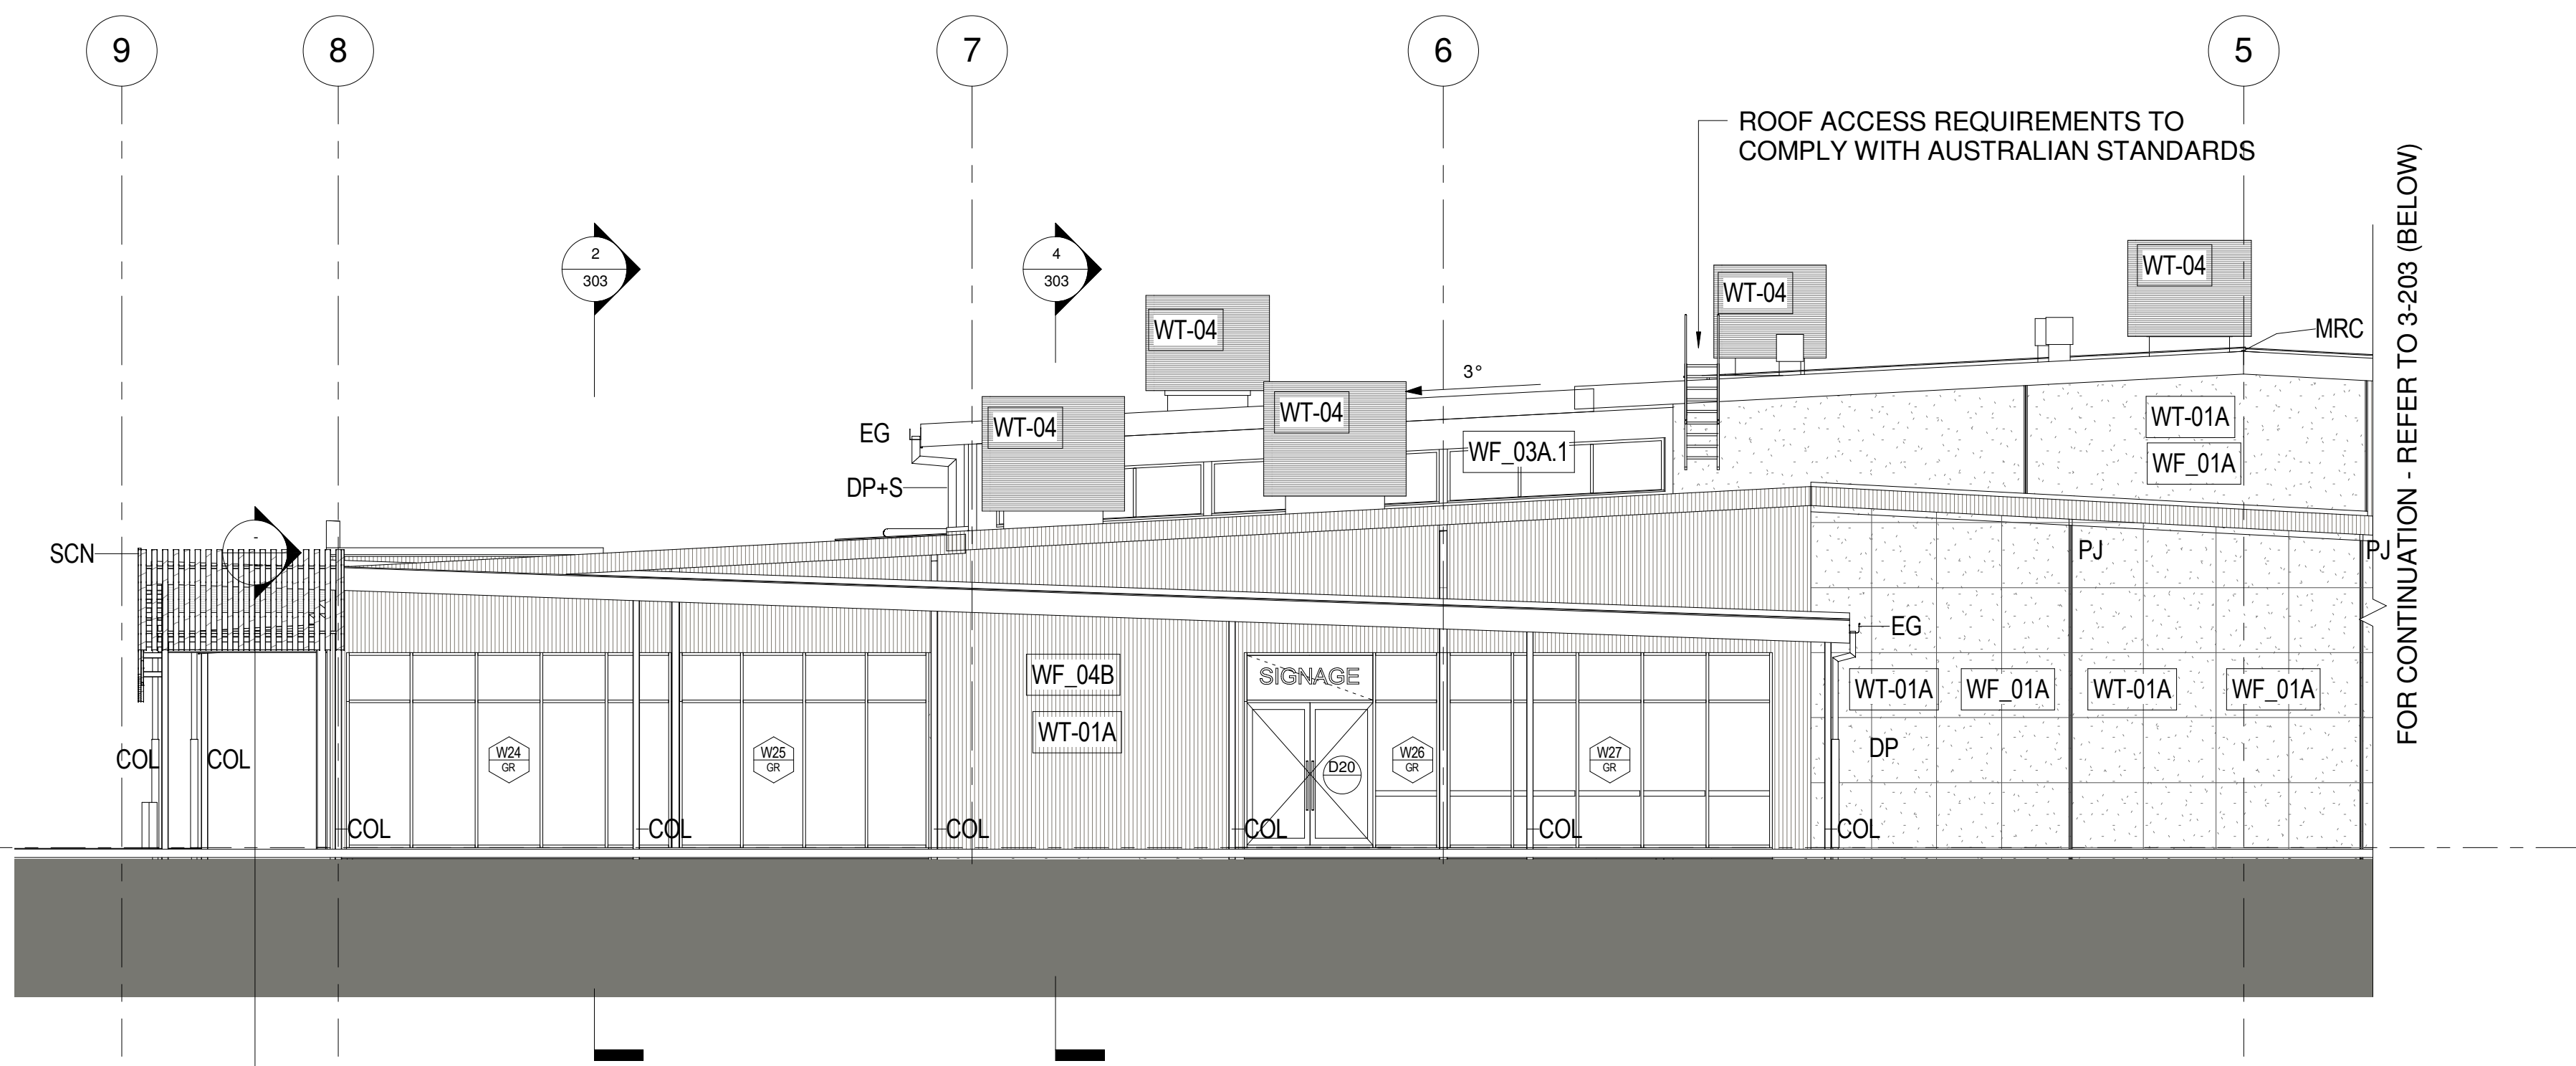

2 ELEVATION D_001
1 : 100

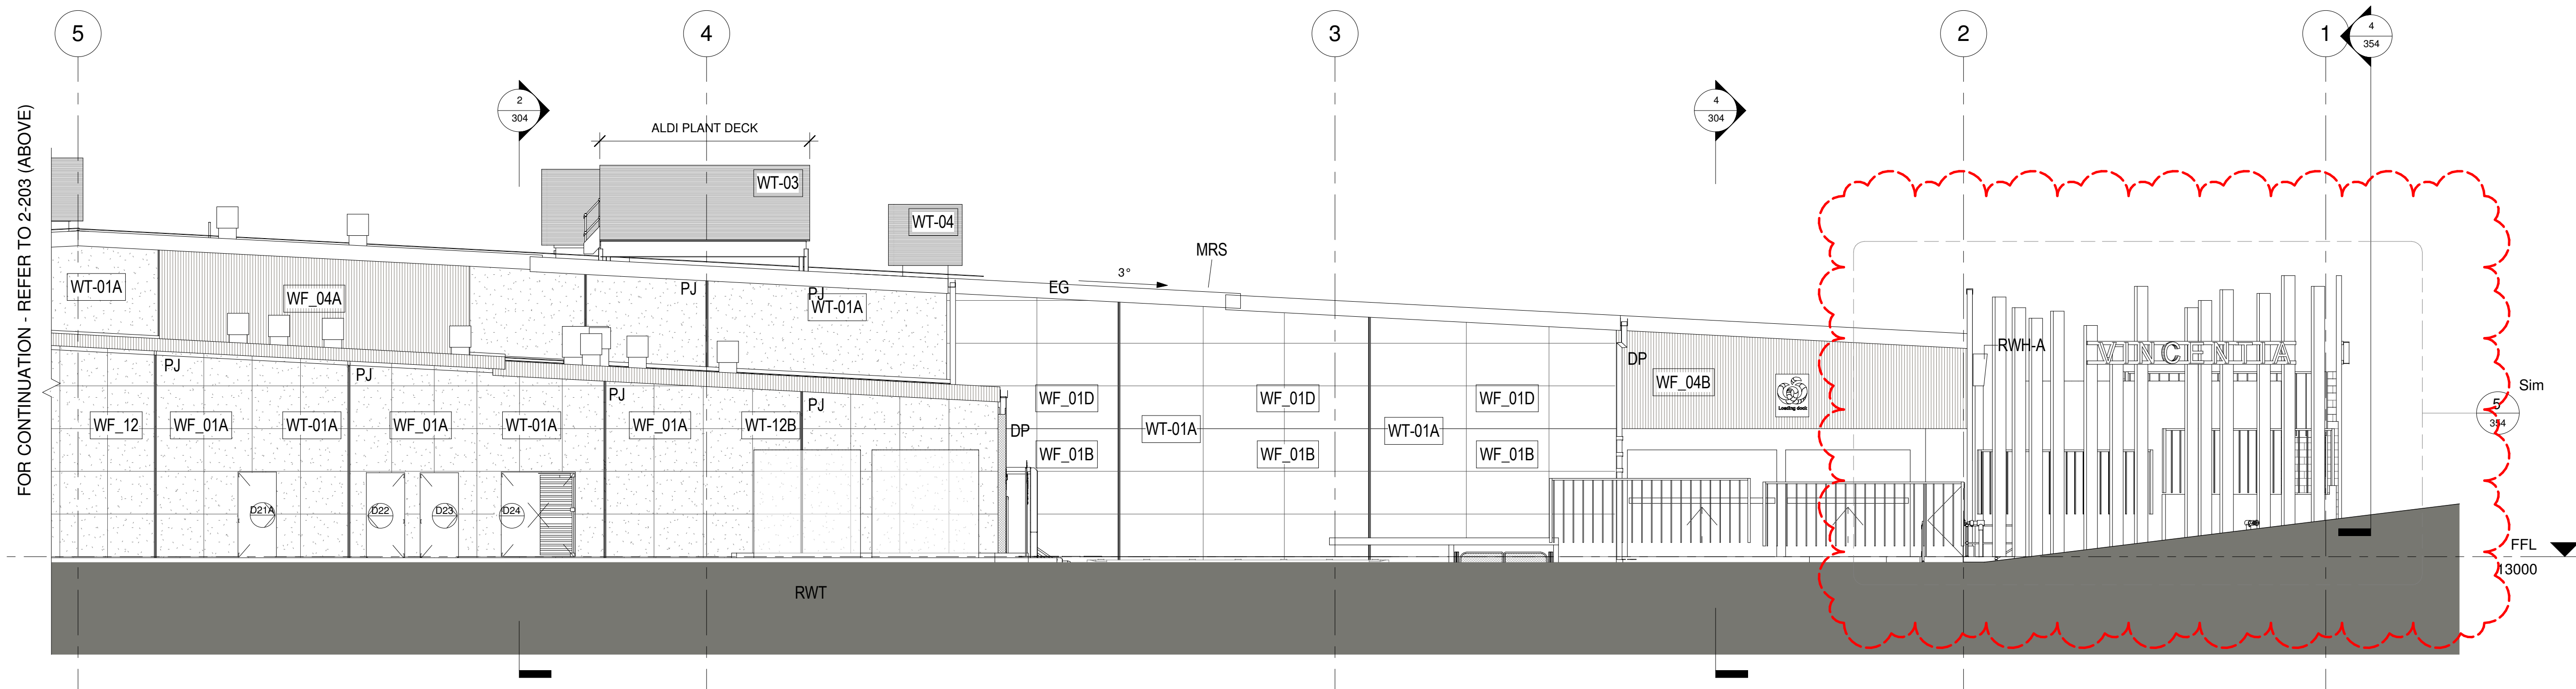

3 ELEVATION D_002
1 : 100

LEGEND - KEYNOTE	
Key Value	Keynote Text
COL	COLUMN - REFER TO ENGINEERS DRAWINGS.
DP	DOWNPIPE - REFER TO ENGINEERS DRAWINGS.
DP+S	DOWNPIPE + SPREADER - REFER TO ENGINEERS DRAWINGS.
EG	EAVES GUTTER - CUSTOM. REFER TO HYD. ENGS DRAWINGS.
MRC	METAL ROOF CAPPING
MRS	METAL ROOF SHEETING
PJ	CONCRETE PANEL JOINT
RWHA	S.S. FOLDED RAINWATER HEAD
RWT	RAINWATER TANK ON SLAB - REFER TO ENGINEERS DRAWINGS.
SCN	SCREENS - TIMBER LOOK ALUMINIUM BATTENS. REFER TO DETAILS.

LEGEND - KEYNOTE - WALL TYPES	
Key Value	Keynote Text
WT-01A	TYPE 01A - CONCRETE PANEL - 150mm. REFER TO ENGINEERS DRAWINGS.
WT-03	TYPE 03 - CONDENSER DECK BAFFLE WALL - TO WW KIT.
WT-04	TYPE 04 - SCREENING TO MECHANICAL UNITS. (TO SATISFY DEVELOPMENT CONDITIONS)
WT-12B	TYPE 12B - METAL STUD - 92mm

LEGEND - KEYNOTE - WALL FINISHES	
Key Value	Keynote Text
WF_01A	EXTERNAL - CONC.PANEL - TEXTURED PAINT FINISH 01.
WF_01B	EXTERNAL - CONC.PANEL - TEXTURED PAINT FINISH 02.
WF_01D	EXTERNAL - CONC.PANEL - TEXTURED PAINT FINISH 04
WF_03A.1	EXTERNAL - FIB CLADDING (1200x2400W EXPRESSED JOINTS) ON TOP HATS - PAINT FINISH 01.
WF_04A	EXTERNAL - METAL WALL CLADDING ON 35mm TOP HATS - FINISH 01.
WF_04B	EXTERNAL - METAL WALL CLADDING ON 35mm TOP HATS - FINISH 02.
WF_12	INTERNAL - FIRE-RATING MIN TOTAL FRL 120/120/120 SYSTEM - CSR07S, 2x13mm FIBROCEK/METAL FRAMING-2x13MM FIBROCEK.

AMENDMENTS			
AMD	DATE	AMENDMENT DETAILS	BY
1	16/01/15	PRELIMINARY - FOR INFO ONLY	KJR
2	06/02/15	PROGRESS UPDATE	KJR
3	19/02/15	FOR INFORMATION	KTR
4	06/03/15	PROGRESS UPDATE	KJR
5	20/03/15	PROGRESS UPDATE	KJR
6	04/06/15	EXTERNAL FINISHES ADVISE	KJR
7	09/12/15	AS CONSTRUCTED	KJR
8	09/11/17	MOD 7 AMENDMENTS	SH

THIS RECORD DRAWING 'AS CONSTRUCTED' HAS BEEN PREPARED, IN PART, PRIOR TO FINAL SITE INSPECTION AND BASED UPON LIMITED INFORMATION FURNISHED BY OTHERS DURING CONSTRUCTION. WHILE THIS INFORMATION IS BELIEVED TO BE RELIABLE, TRG ASSUMES NO RESPONSIBILITY FOR THE ACCURACY OF THIS RECORD DRAWING OR FOR ANY ERRORS OR OMISSIONS THAT MAY HAVE BEEN INCORPORATED INTO IT AS A RESULT OF INSUFFICIENT OR INCORRECT INFORMATION PROVIDED TO THE DESIGNER.

THOSE RELYING ON THIS RECORD DOCUMENT ARE ADVISED TO OBTAIN SITE SURVEY INDEPENDENT VERIFICATION OF ITS ACCURACY.

NOTES

- DO NOT SCALE OFF DRAWINGS. FIGURED DIMENSIONS ONLY.
- ALL DIMENSIONS TO BE CHECKED AND VERIFIED ON SITE PRIOR TO COMMENCING FABRICATION AND CONSTRUCTION.
- TRG IS TO BE MOTIFIED OF ANY VARIATIONS BETWEEN SITE MEASUREMENTS AND THOSE DIMENSIONS SHOWN ON THE DRAWINGS.
- REFER TO COVER SHEET FOR ADDITIONAL NOTES, LEGENDS ETC.
- THESE DRAWINGS ARE TO BE READ IN CONJUNCTION WITH THE ARCHITECTURAL DRAWINGS, SPECIFICATION AND SCHEDULES INCLUDING CONSULTANT DOCUMENTATION, APPROVALS, DOCUMENTATION & CLIENT DOCUMENTS (BRIEF, DRAWINGS AND SPECIFICATIONS).
- LOCATION OF ALL EXISTING UNDERGROUND SERVICES IS INDICATIVE ONLY. REFER TO SUBSURFACE DRAWINGS. THE CONTRACTOR IS TO ACCURATELY PHYSICALLY LOCATE ALL SERVICES PRIOR TO COMMENCING CONSTRUCTION.



TRG Queensland Pty Ltd
ABN 91 119 965 885
15 KURILPA STREET,
WEST END,
QUEENSLAND,
4101 AUSTRALIA
P: +61 7 3392 2200
F: +61 7 3392 2300
E: trg@trg-qa.com
W: www.trg-qa.com

© COPYRIGHT TRG QUEENSLAND PTY LTD. ALL RIGHTS RESERVED. THESE DRAWINGS AND DESIGNS AND THE COPYRIGHT THEREOF ARE THE PROPERTY OF TRG QUEENSLAND PTY LTD AND MUST NOT BE REPRODUCED, REPAIRED OR COPIED WITHOUT THE WRITTEN PERMISSION OF TRG QUEENSLAND PTY LTD. TRADING AS TRG.

VINCENTIA MARKETPLACE
MOONA CREEK ROAD,
VINCENTIA, NSW, 2540

CLIENT
HUTCHINSON BUILDERS
Established 1912

DRAWING TITLE
ELEVATION D - EASTERN

DATE CREATED: 08/11/17
SHEET PRINT SIZE: A0
SCALE: AS SHOWN
DRAWN BY: KJR
CHECKED BY:

PROJECT No: 414163
STAGE: DD
DRAWING: 203
REVISION: 8

AS CONSTRUCTED

FILE PATH: I:\Development\Projects\414163\Drawings\WORKSHEETS\Vincentia Market\414163_VINCENTIA_ARCHITECTURAL.dwg