


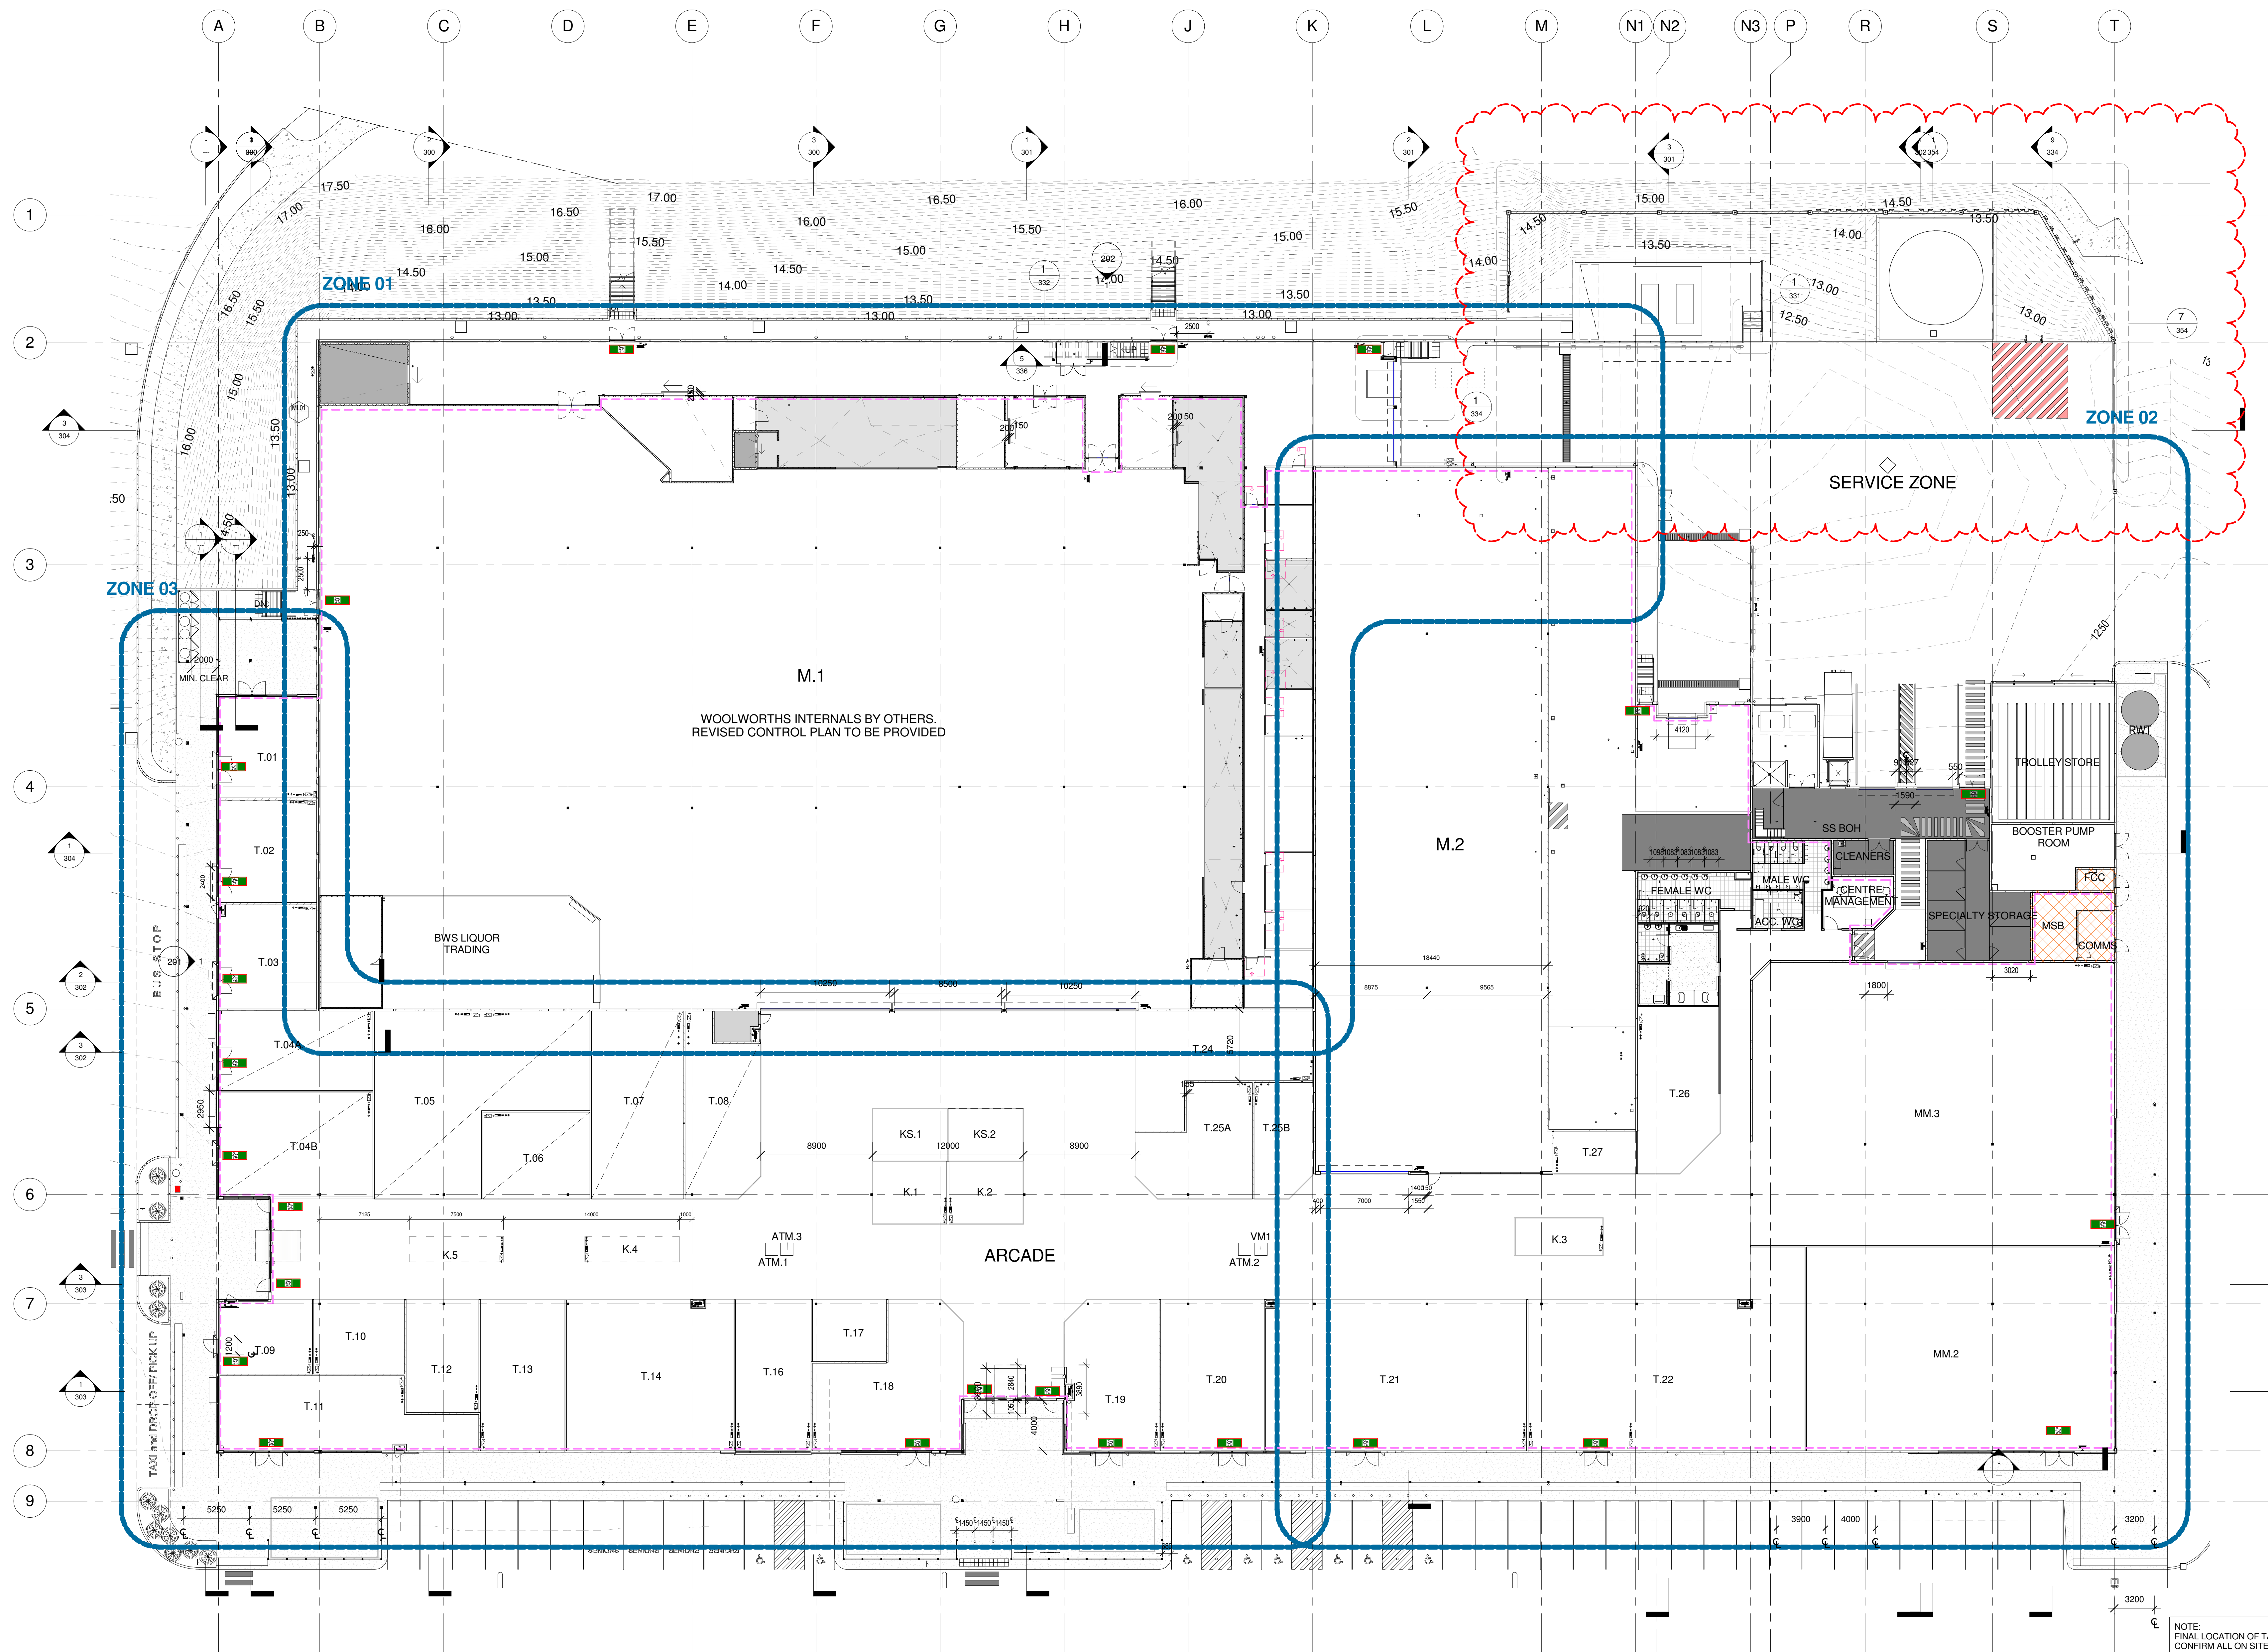

1 PLAN - GROUND 1_200
128 1 : 200

NOTE:
FINAL LOCATION OF TACTILES CO-ORDINATED ON SITE WITH CERTIFIER.
CONFIRM ALL ON SITE.

FIRE-RATING - 120/120/120
(FIRE-RATED WALLS & CEILING)

SECTION J COMPLIANCE.
GRAPHICAL REPRESENTATION - OFFSET FROM
BUILDING SHELL FOR CLARIFICATION PURPOSES.
REFER TO ENERGY EFFICIENCY REPORT FOR
FINAL REQUIREMENTS.

NOTE:
 REQUIRED FIRE EGRESS DOOR

AMENDMENTS			
AMD	DATE	AMENDMENT DETAILS	BY
1	16/01/15	PRELIMINARY - FOR INFO ONLY	KJR
2	20/01/15	PROGRESS UPDATE	KJR
3	06/02/15	PROGRESS UPDATE	KJR
4	06/02/15	PROGRESS UPDATE	KJR
5	21/04/15	UPDATE - CIVIL CO-ORD. GLAZING, FRL	KJR
6	07/05/15	PROGRESS - WW INTERNAL C.15, CEILING	
7	20/05/15	PROGRESS - WW MEZZ MSB, CENTRE MSB, MINI PANEL, ALU MULL RCP FFR, LUGGAGE RCP, CHANGING ROOMS, ELECTRICAL ROOM, REMOVED EXT. POWER, TRAFFIC ADVISE	
8	21/05/15	PROGRESS - SWITCHROOM, ROLLARDS, 24/05/15	
9	24/05/15	PROGRESS - SERVICES, WW STAFF DOOR, PHAUST, POST SECTIN UPROCK, ROCKERS	
10	29/06/15	PROGRESS - EXTERNAL SERVICES REMOVED	
11	10/07/15	PROGRESS - TENANCY BREAK UP FINISHES, DMEBCL SERVICES, CO-ORD. RCP, FEATURE WALL, S. SEC. J.	KJR
12	10/08/15	ISSUE FOR T&B SERVICES	
13	09/12/15	AS CONSTRUCTED	KJR
14	09/11/17	MOD 7 AMENDMENTS	SH

THIS RECORD DRAWING 'AS CONSTRUCTED'
HAS BEEN PREPARED, IN PART, PRIOR TO FINAL
SITE INSPECTION AND BASED UPON LIMITED
INFORMATION FURNISHED BY OTHERS DURING
CONSTRUCTION. WHILE THIS INFORMATION IS
BELIEVED TO BE RELIABLE, TRG ASSUMES NO
RESPONSIBILITY FOR THE ACCURACY OF THIS
RECORD DRAWING OR FOR ANY ERRORS OR
OMISSIONS THAT MAY HAVE BEEN
INCORPORATED INTO IT AS A RESULT OF
INSUFFICIENT OR INCORRECT INFORMATION
PROVIDED TO THE DESIGNER.
THOSE RELYING ON THIS RECORD DOCUMENT
ARE ADVISED TO OBTAIN SITE SURVEY
INDEPENDENT VERIFICATION OF ITS ACCURACY.

- NOTES
- DO NOT SCALE OFF DRAWINGS. FIGURED DIMENSIONS ONLY.
 - ALL DIMENSIONS TO BE CHECKED AND VERIFIED ON SITE PRIOR TO
COMMENCING FABRICATION AND CONSTRUCTION.
 - TRG IS TO BE NOTIFIED OF ANY VARIATIONS BETWEEN SITE
MEASUREMENTS AND THOSE DIMENSIONS SHOWN ON THE DRAWINGS.
 - REFER TO COVER SHEET FOR ADDITIONAL NOTES, LEGENDS ETC.
 - THESE DRAWINGS ARE TO BE READ IN CONJUNCTION WITH THE
ARCHITECTURAL DRAWINGS, SPECIFICATION AND SCHEDULES
INCLUDING CONSULTANT DOCUMENTATION, APPROVALS
DOCUMENTATION & CLIENT DOCUMENTS (BRIEF, DRAWINGS AND
SPECIFICATIONS).
 - LOCATION OF ALL EXISTING UNDERGROUND SERVICES IS INDICATIVE
ONLY. REFER TO SUBSURFACE DRAWINGS. THE CONTRACTOR IS TO
ACCURATELY PHYSICALLY LOCATE ALL SERVICES PRIOR TO
COMMENCING CONSTRUCTION.



TRG Queensland Pty Ltd
ABN 91 119 965 883 QBOC License #1100298
15 KURILPA STREET,
WEST END,
QUEENSLAND,
4101 AUSTRALIA
P: +61 7 3392 2200
F: +61 7 3392 2300
E: trg@trg-qa.com
W: www.trg-qa.com

© COPYRIGHT TRG QUEENSLAND PTY LTD. ALL RIGHTS RESERVED.
THESE DRAWINGS AND DESIGNS AND THE COPYRIGHT THEREOF ARE THE
PROPERTY OF TRG QUEENSLAND PTY LTD AND MUST NOT BE REPRODUCED,
REPAIRED OR COPIED WITHOUT THE WRITTEN PERMISSION OF TRG
QUEENSLAND PTY LTD. TRADING AS TRG.
TRG QUEENSLAND PTY LTD ACCEPTS NO RESPONSIBILITY FOR THE
LIABILITY, COMPLETENESS OR ACCURACY OF DATA TRANSMITTED
ELECTRONICALLY. HELPERS SHOULD WHEN NECESSARY REQUEST A
HARD COPY VERSION FOR VERIFICATION.

PROJECT TITLE & ADDRESS
**VINCENTIA
MARKETPLACE**
MOONA CREEK ROAD,
VINCENTIA, NSW, 2540

CLIENT
**HUTCHINSON
BUILDERS**
Established 1912

DRAWING TITLE
PLAN - GROUND

DATE CREATED: 08/11/17	DATE: 08/11/17
SHEET PRINT SIZE: A0	SCALE: AS SHOWN
DRAWN BY: KJR	REVISION: 14
CHECKED BY:	
PROJECT No: 414163	STAGE: DD
DRAWING No: 101	

AS CONSTRUCTED

FILE PATH: I:\Development\Projects\UP - 144520\Images\01 DRAWINGS\INTERIM\01 Vincentia_Marketplace\VINCENTIA_ARCHITECTURE\PLAN