

DRAWING LIST:

4001_DA-01-C

Basement Plan

4001_DA-02-C

Ground Floor Plan

4001_DA-03-C

Level 1 & 2 Plan

4001_DA-04-C

Level 3 & 4 Plan

4001_DA-05-C

Elevations

4001_DA-06-C

Sections

4001_DA-07-C

Shadow Diagrams

4001_DA-08-C

Apartment Types





THE UNIVERSITY OF SYDNEY

ABERCROMBIE STREET STUDENT ACCOMODATION

s75w Mark Up Set

October 2013



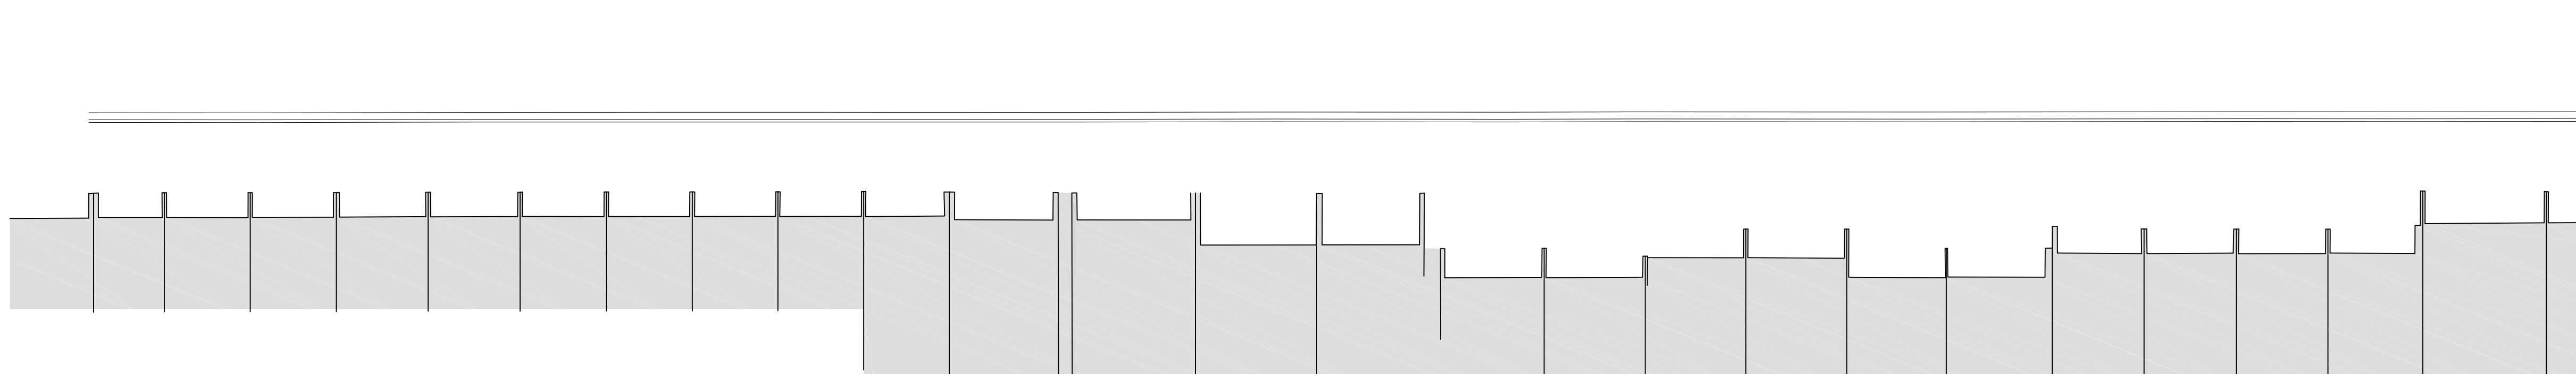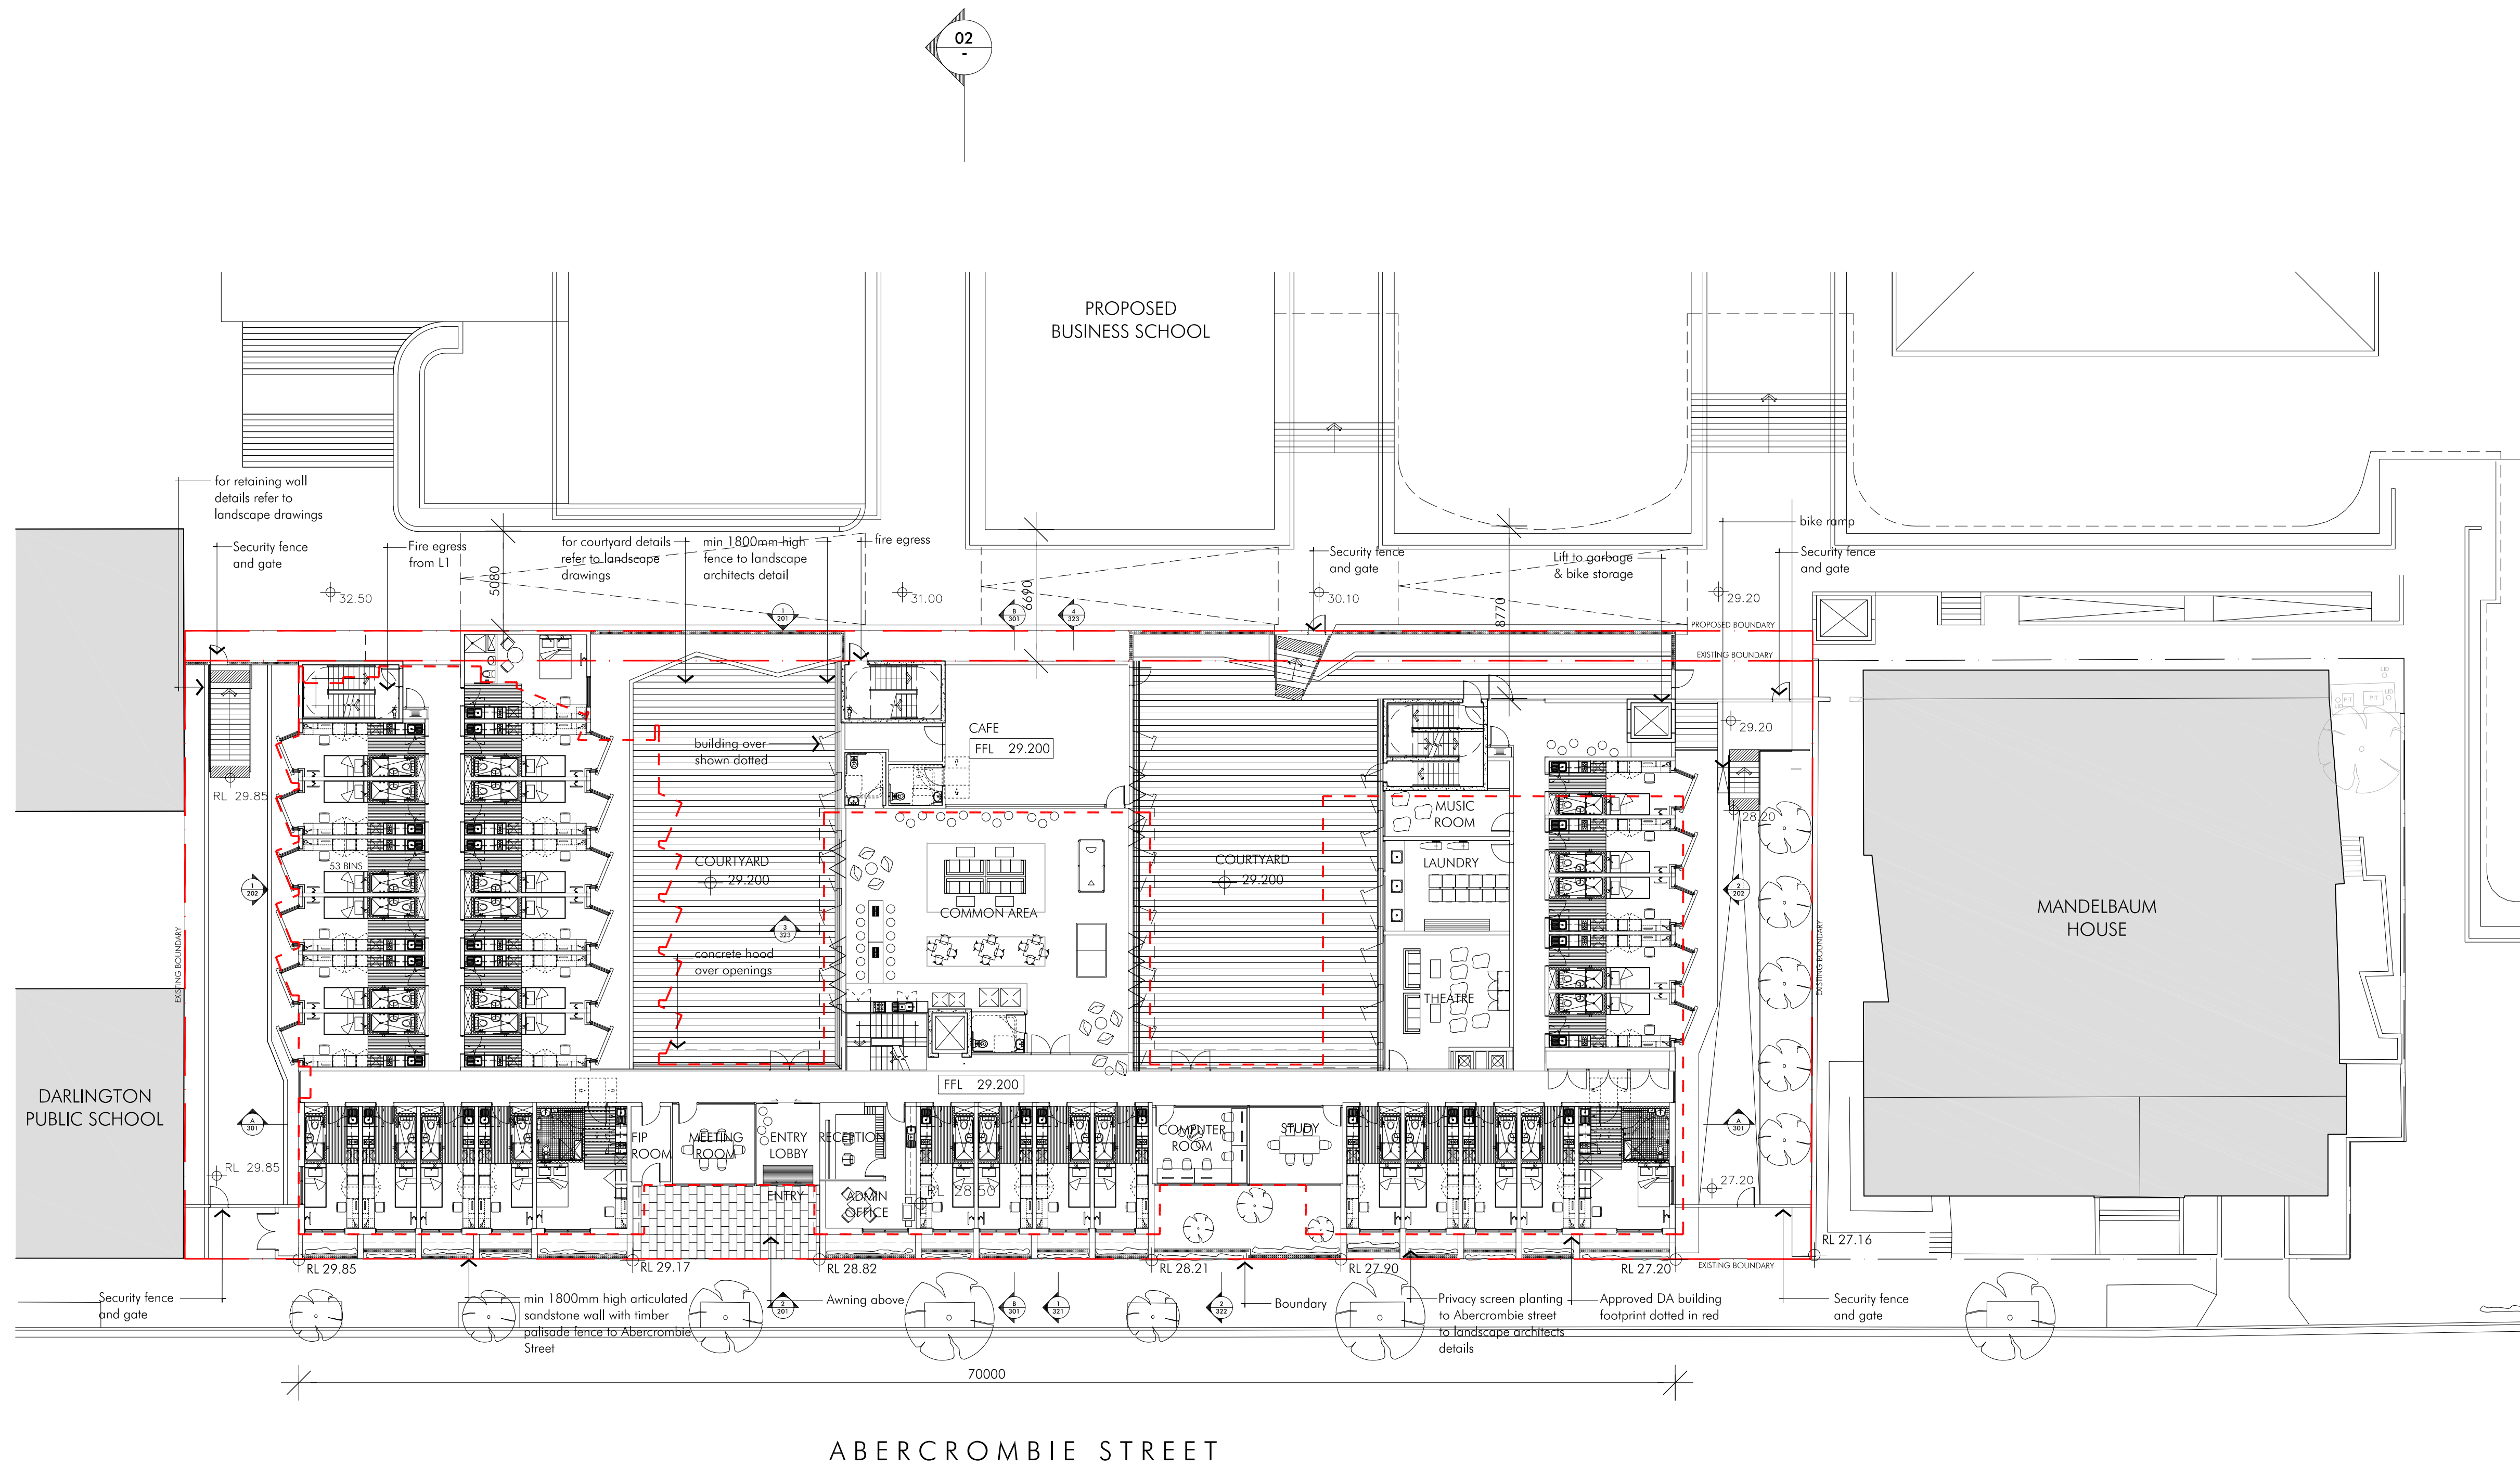


1 GROUND FLOOR PLAN
SCALE 1:200 @ A1

Project
LEGEND
— BOUNDARY
— LINE OF PREVIOUSLY APPROVED DA

Title
Scale
Date
Number
0 2 4
10 20m
Ground Floor Plan
MARK UP SET
1:200@A1
11.10.13
4001_DA02-D
© copyright nettleton tribe partnership pty ltd

nt nettletontribe
nettleton tribe partnership pty ltd ABN 58 161 683 122
117 willoughby road crows nest nsw 2065
t 02 9431 6431 f 02 9439 7474
e sydney@nettletontribe.com.au w nettletontribe.com.au

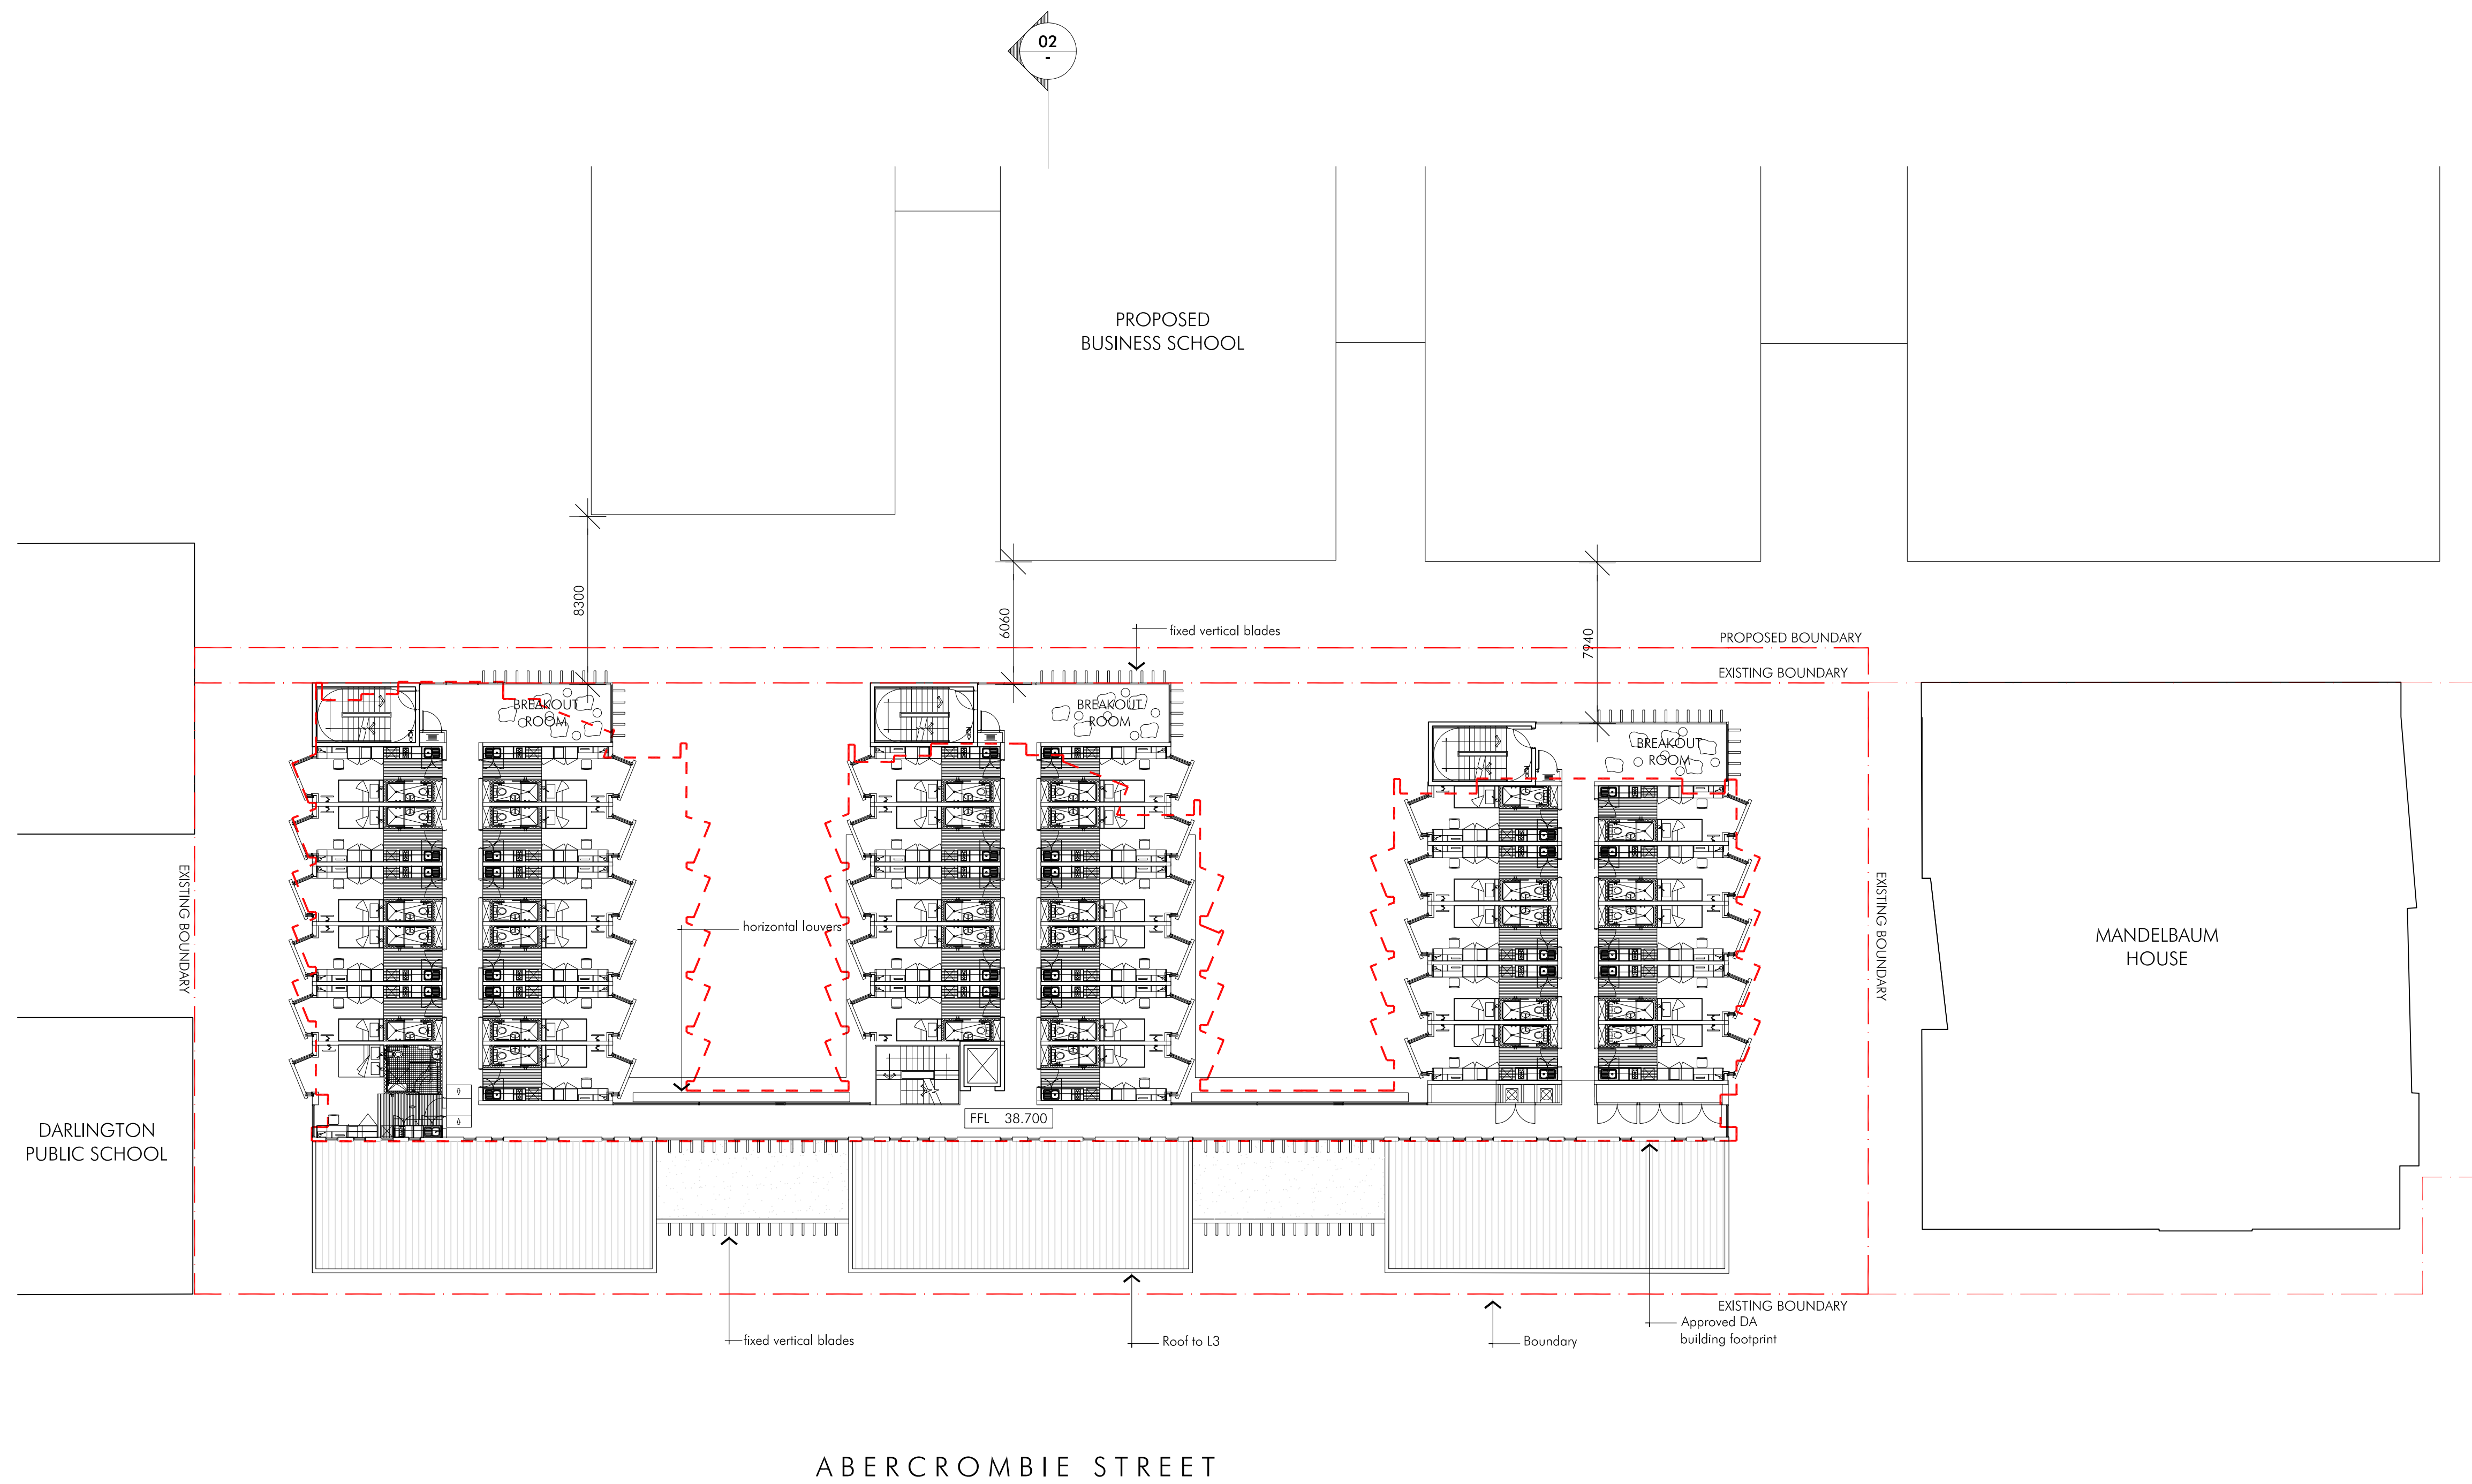

ABERCROMBIE STREET

1 L3 & L4 PLAN
SCALE 1:200 @ A1

Project
LEGEND
— BOUNDARY
- - - LINE OF PREVIOUSLY APPROVED DA


Title
Scale
Date
Number

Level 3 & 4 Plan
MARK UP SET 1:200@A1
11.10.13
4001_DA04-D

© copyright nettleton tribe partnership Pty Ltd

nettletontribe


nettleton tribe partnership Pty Ltd ABN 58 161 683 122
117 willoughby road crows nest nsw 2065
t 02 9431 6431 f 02 9439 7474
e sydney@nettletontribe.com.au w nettletontribe.com.au

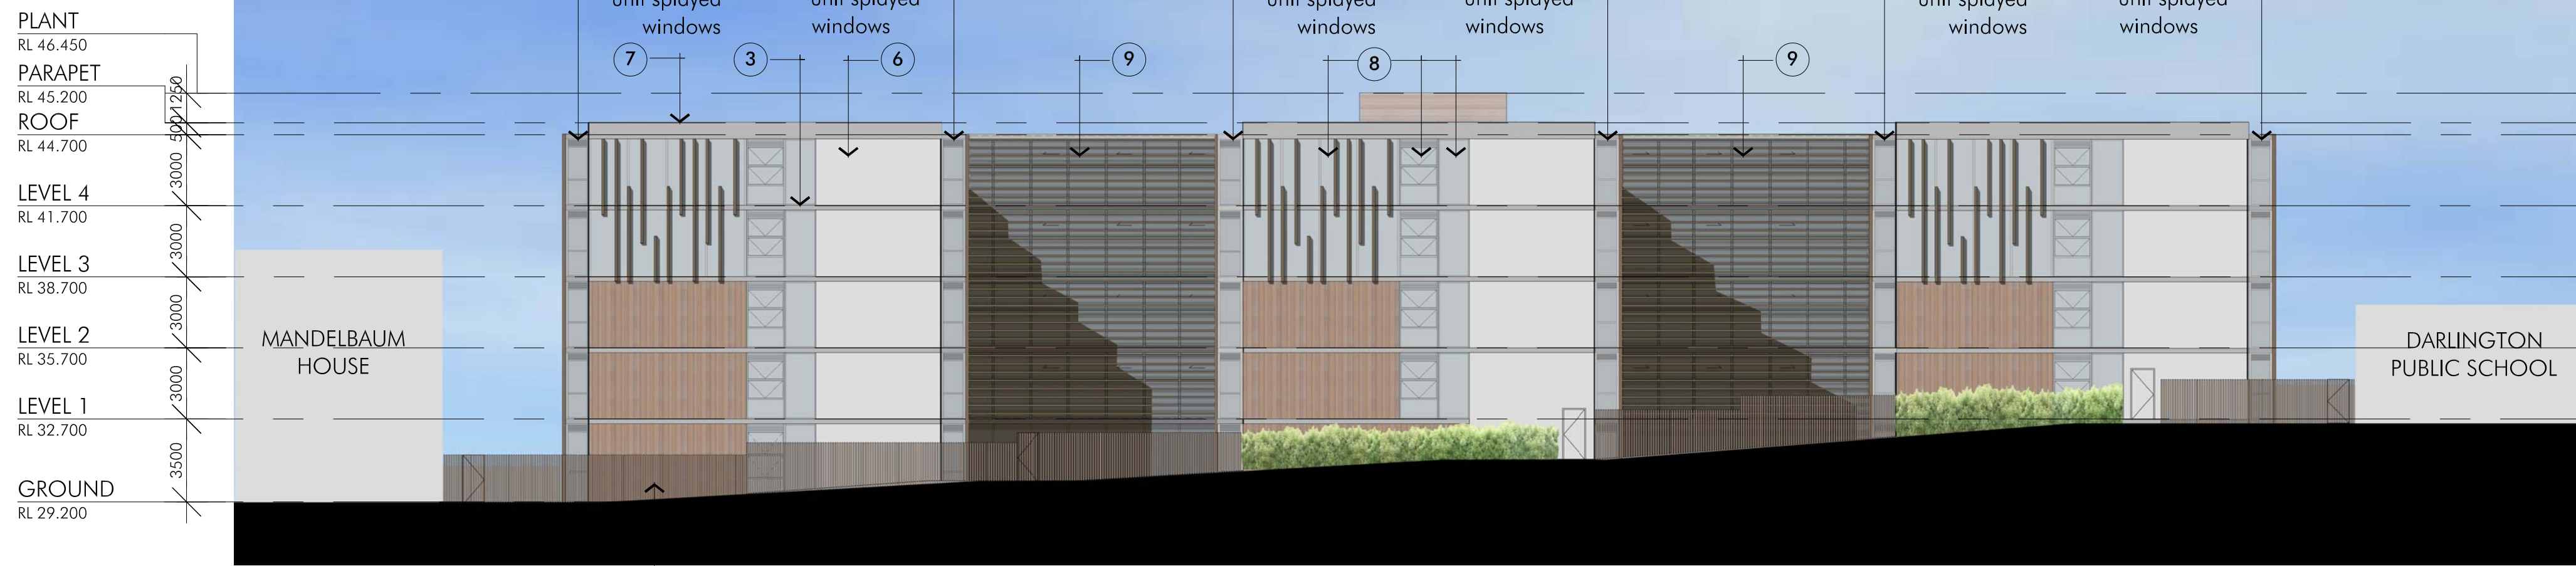


01 ELEVATION NORTH
SCALE 1:200



02 ELEVATION SOUTH (ABERCROMBIE STREET)
SCALE 1:200

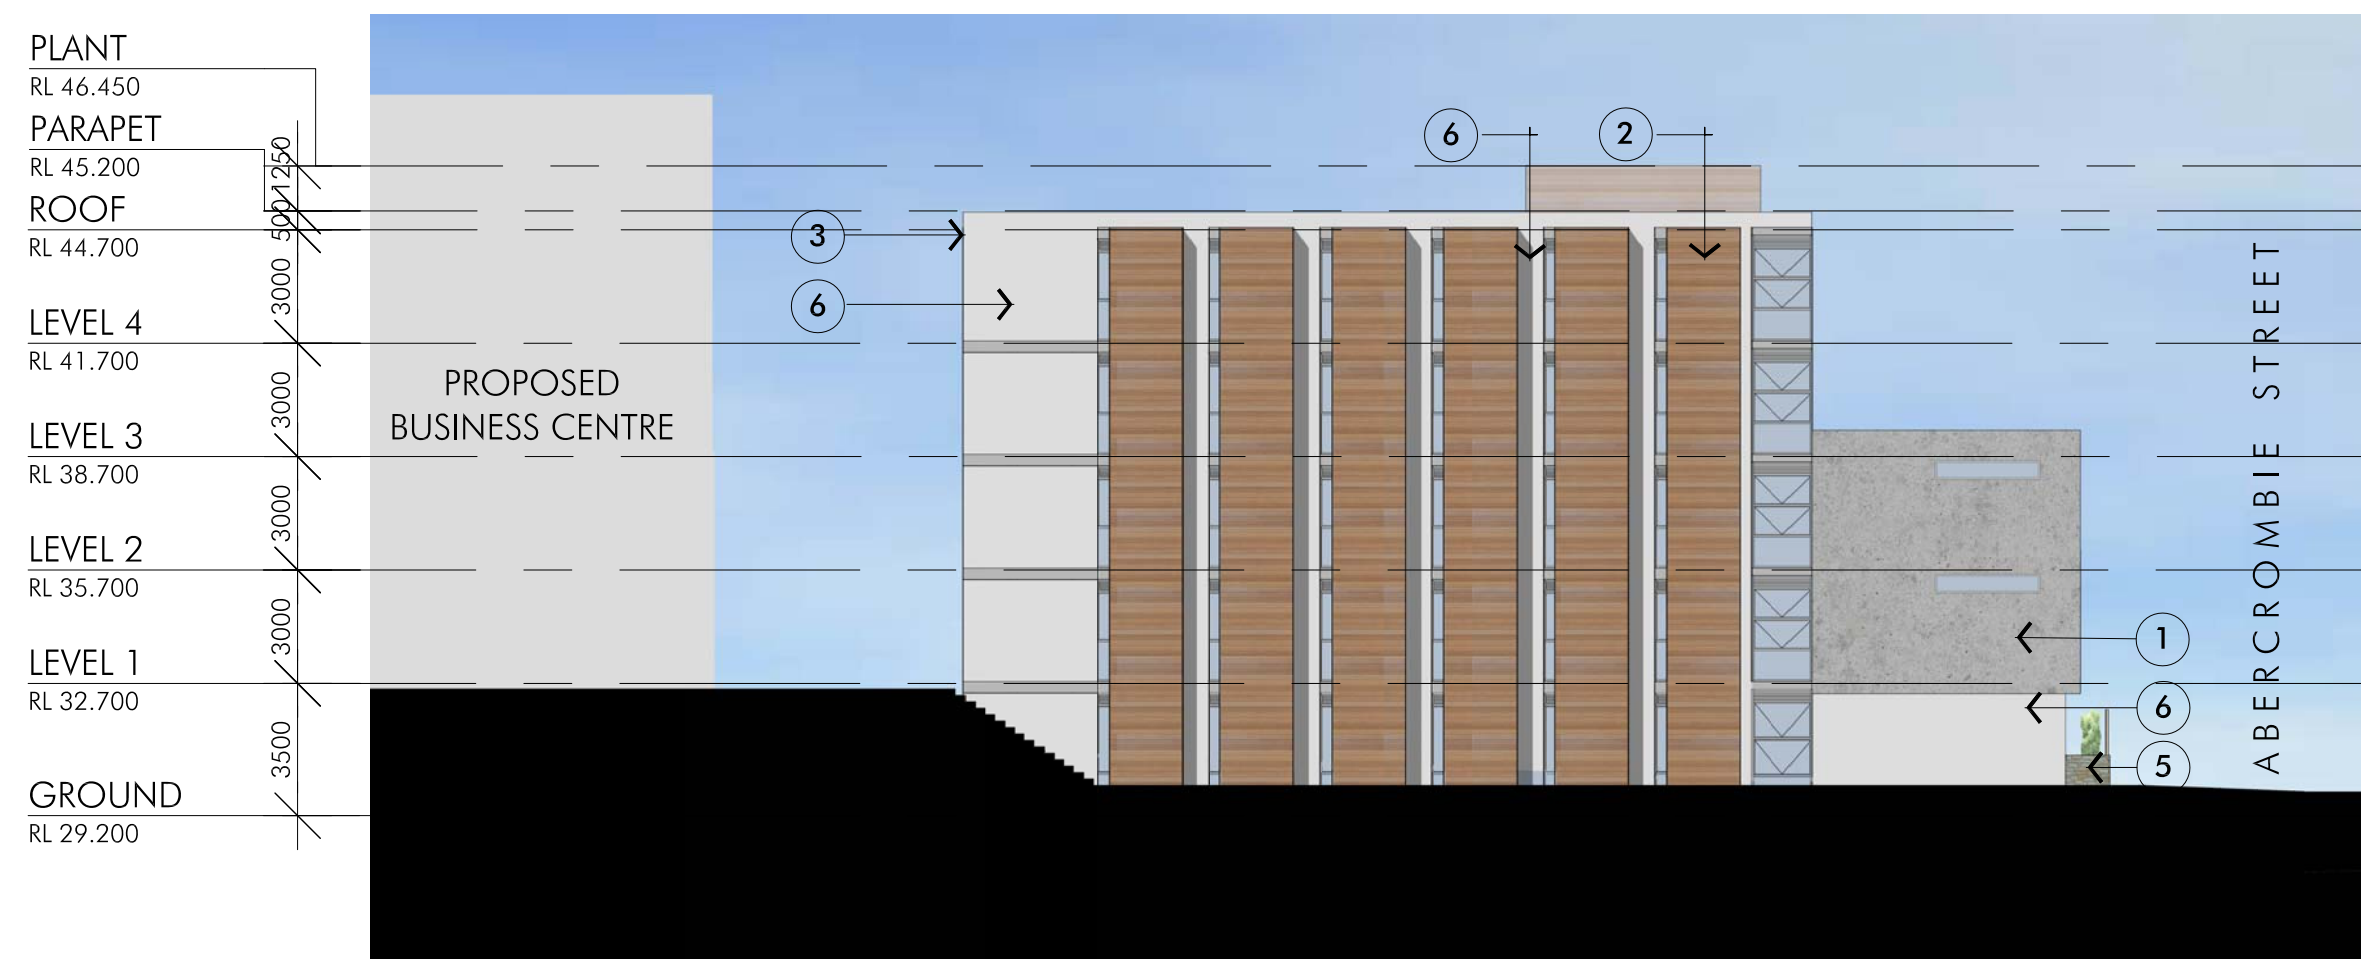


03 ELEVATION WEST
SCALE 1:200

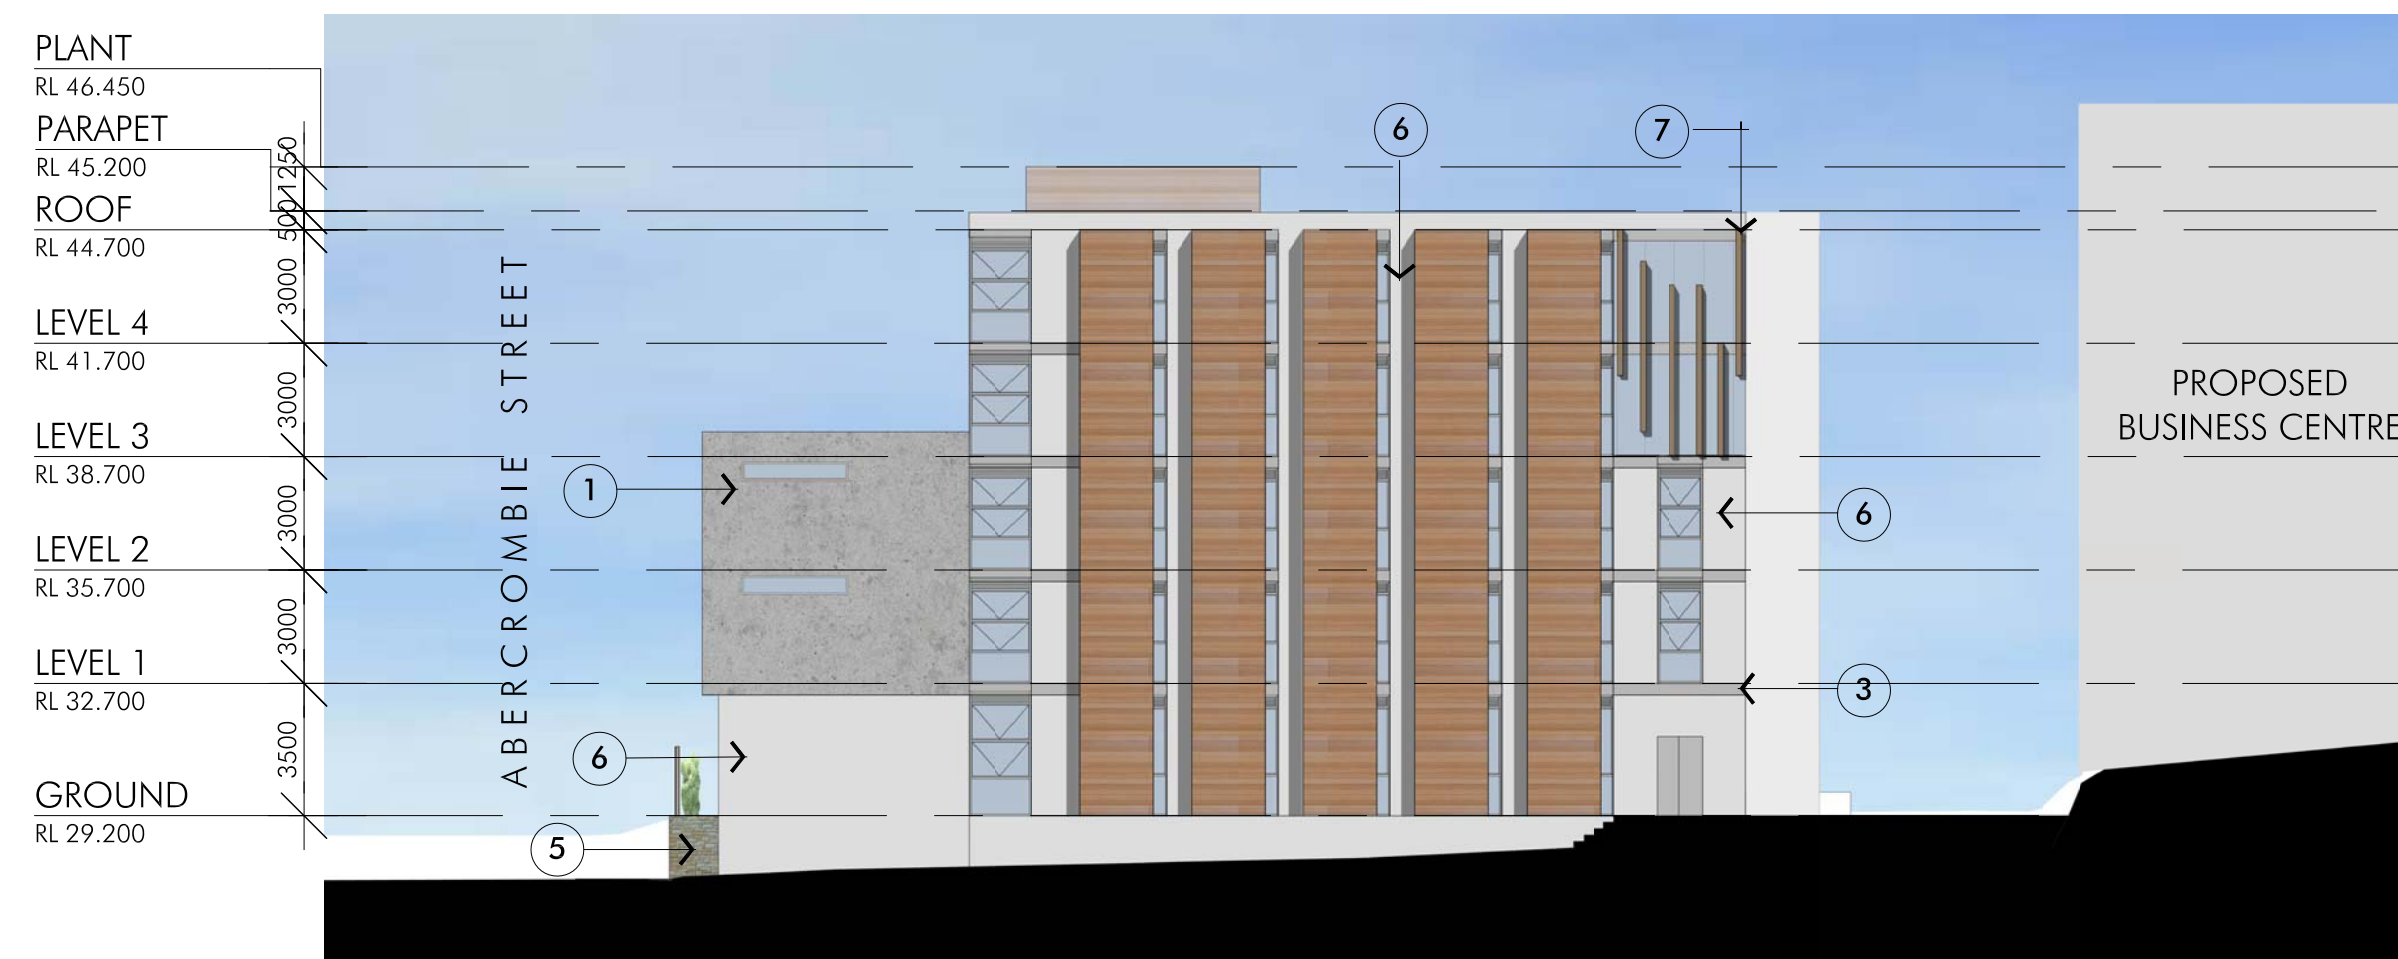


04 ELEVATION EAST
SCALE 1:200

- FINISHES
1. Off form concrete
 2. Timber look panels
 3. Steel frame
 4. Copper coloured screens
 5. Sandstone wall with timber fence
 6. Stained Concrete
 7. Steel vertical blades
 8. Glass
 9. Horizontal louvers




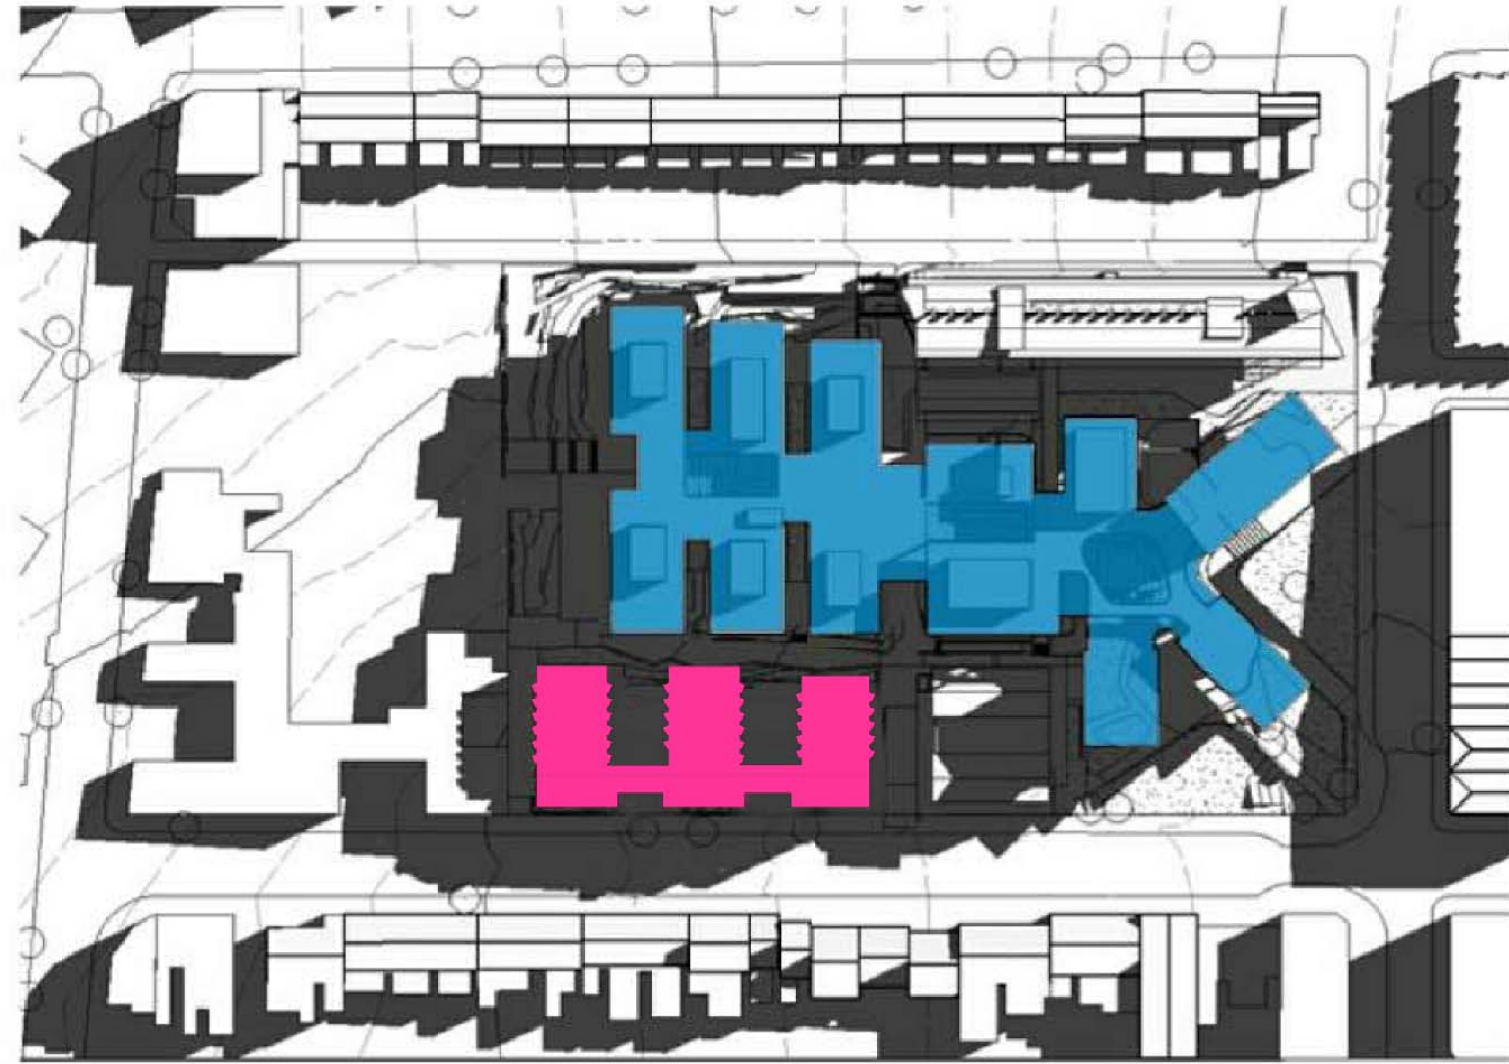


21 June 09:00 AM

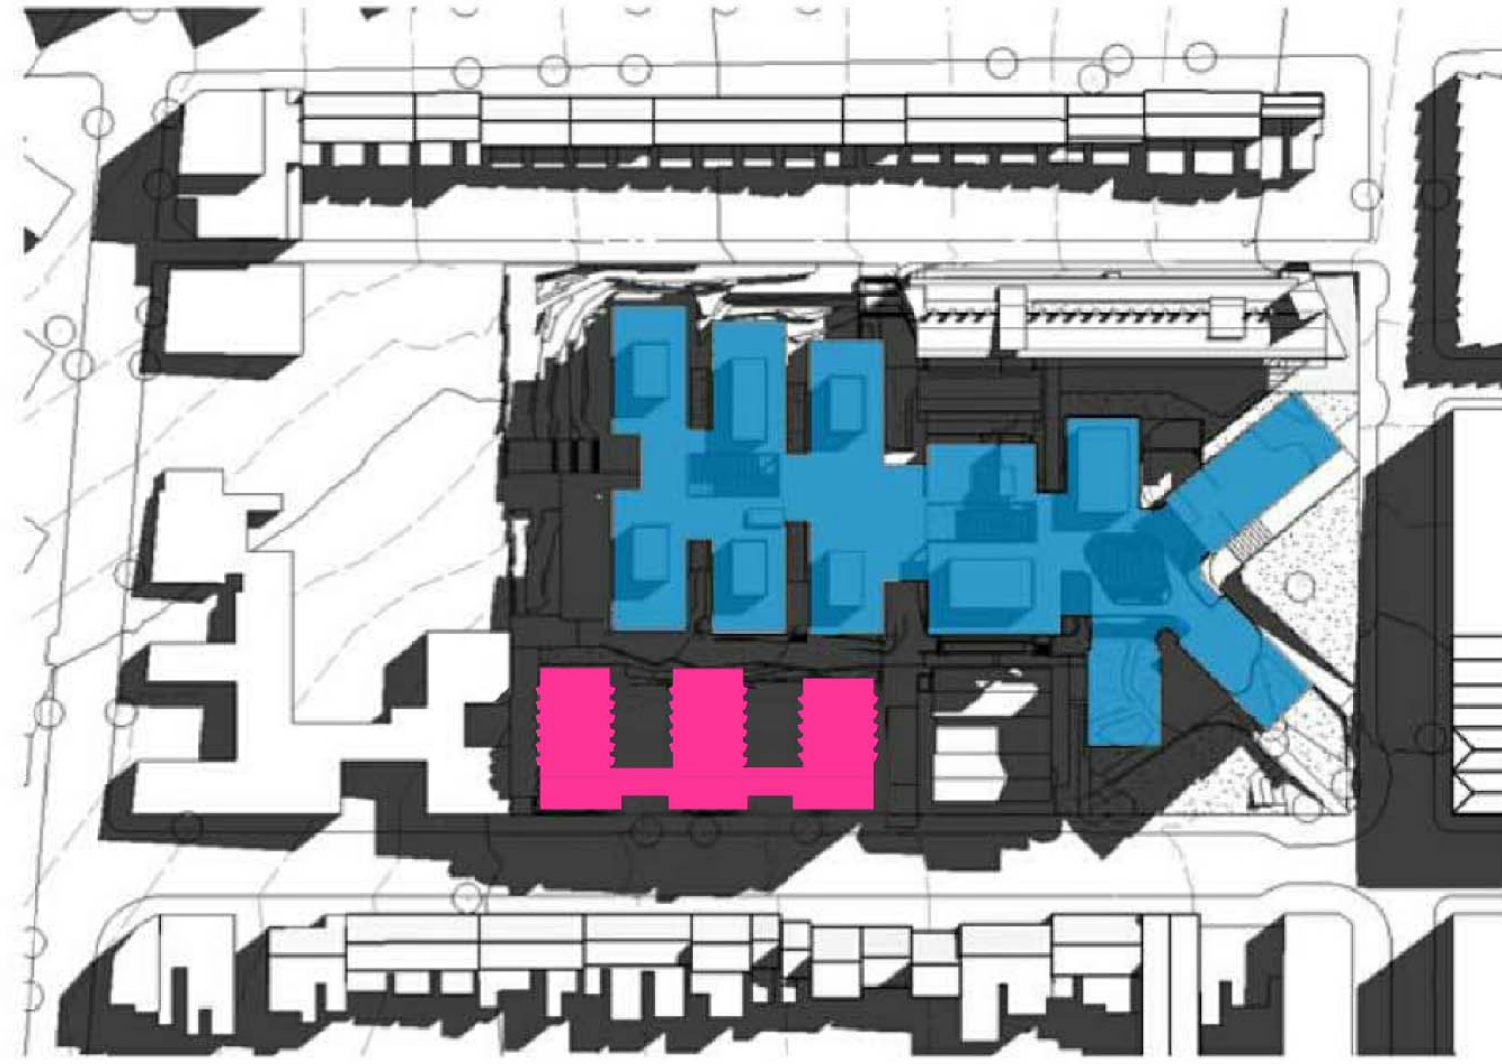


21 June 10:00 AM

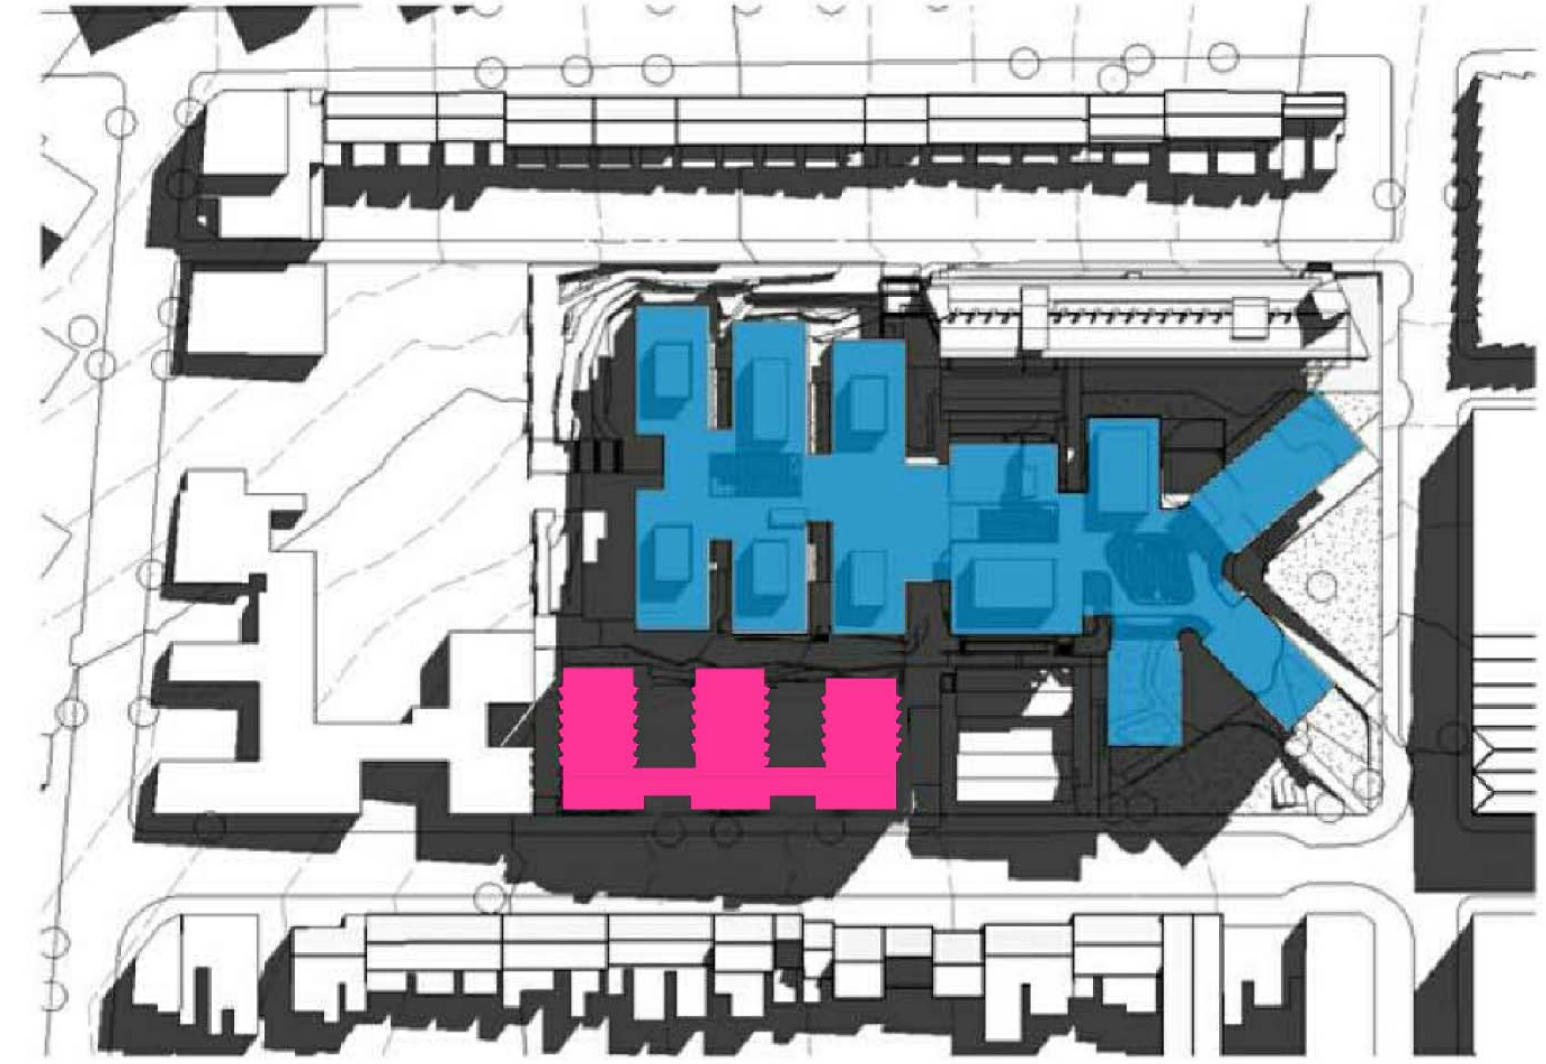

21 June 11:00 AM

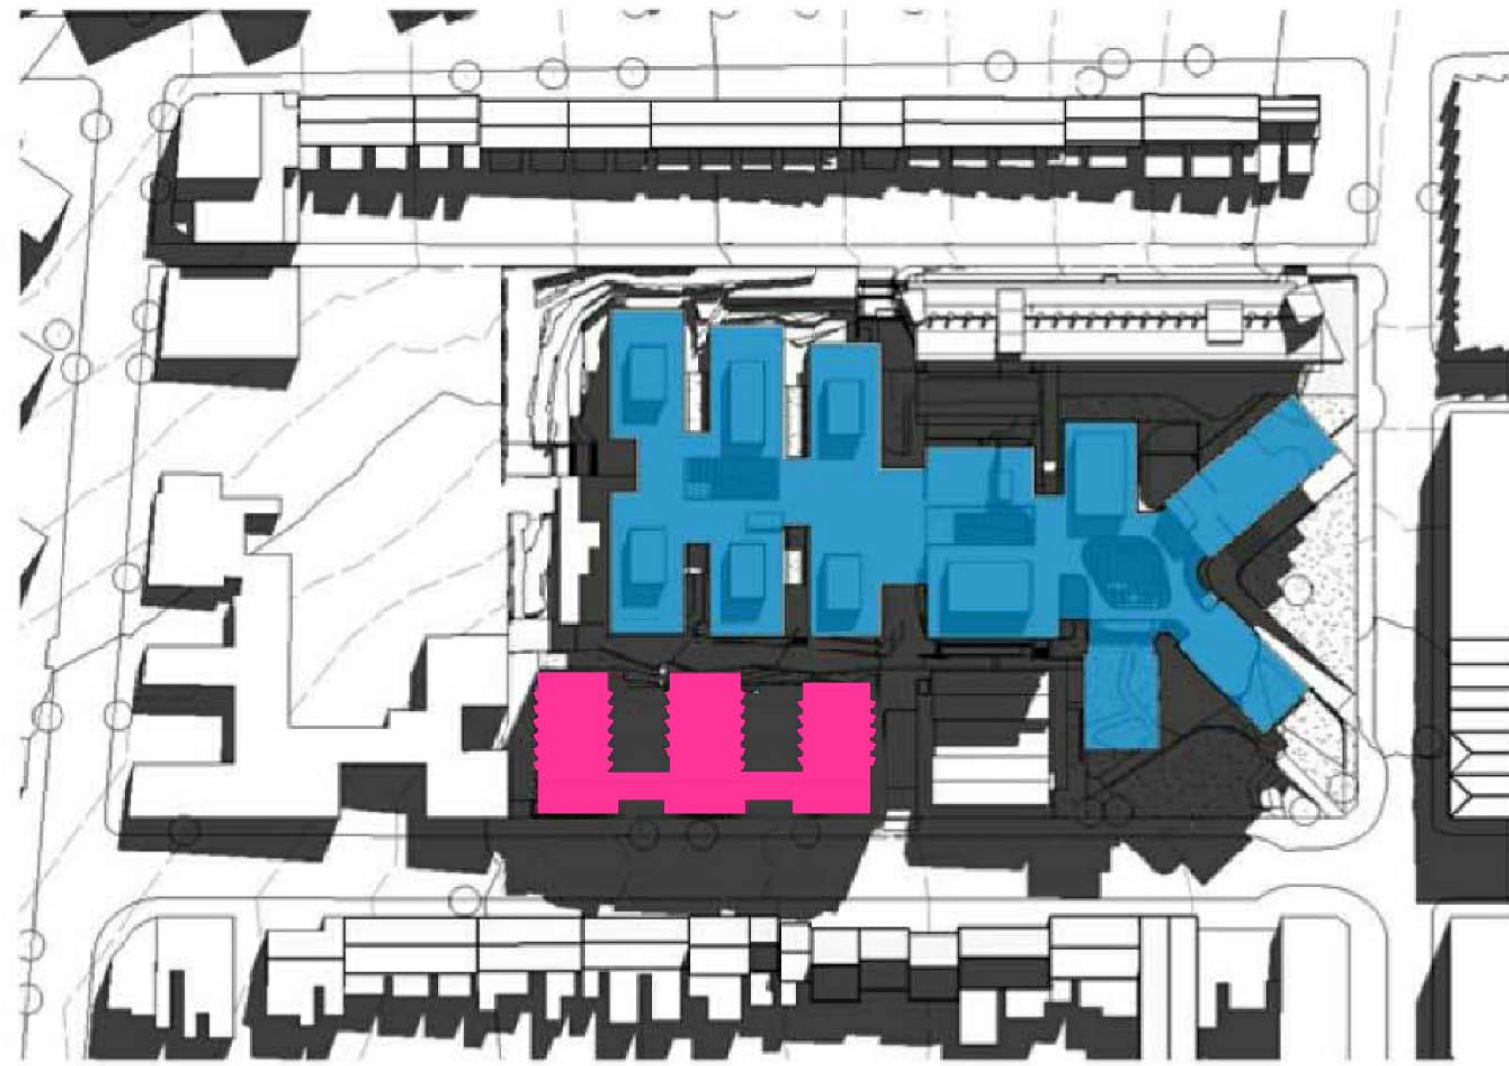


21 June 12:00 PM

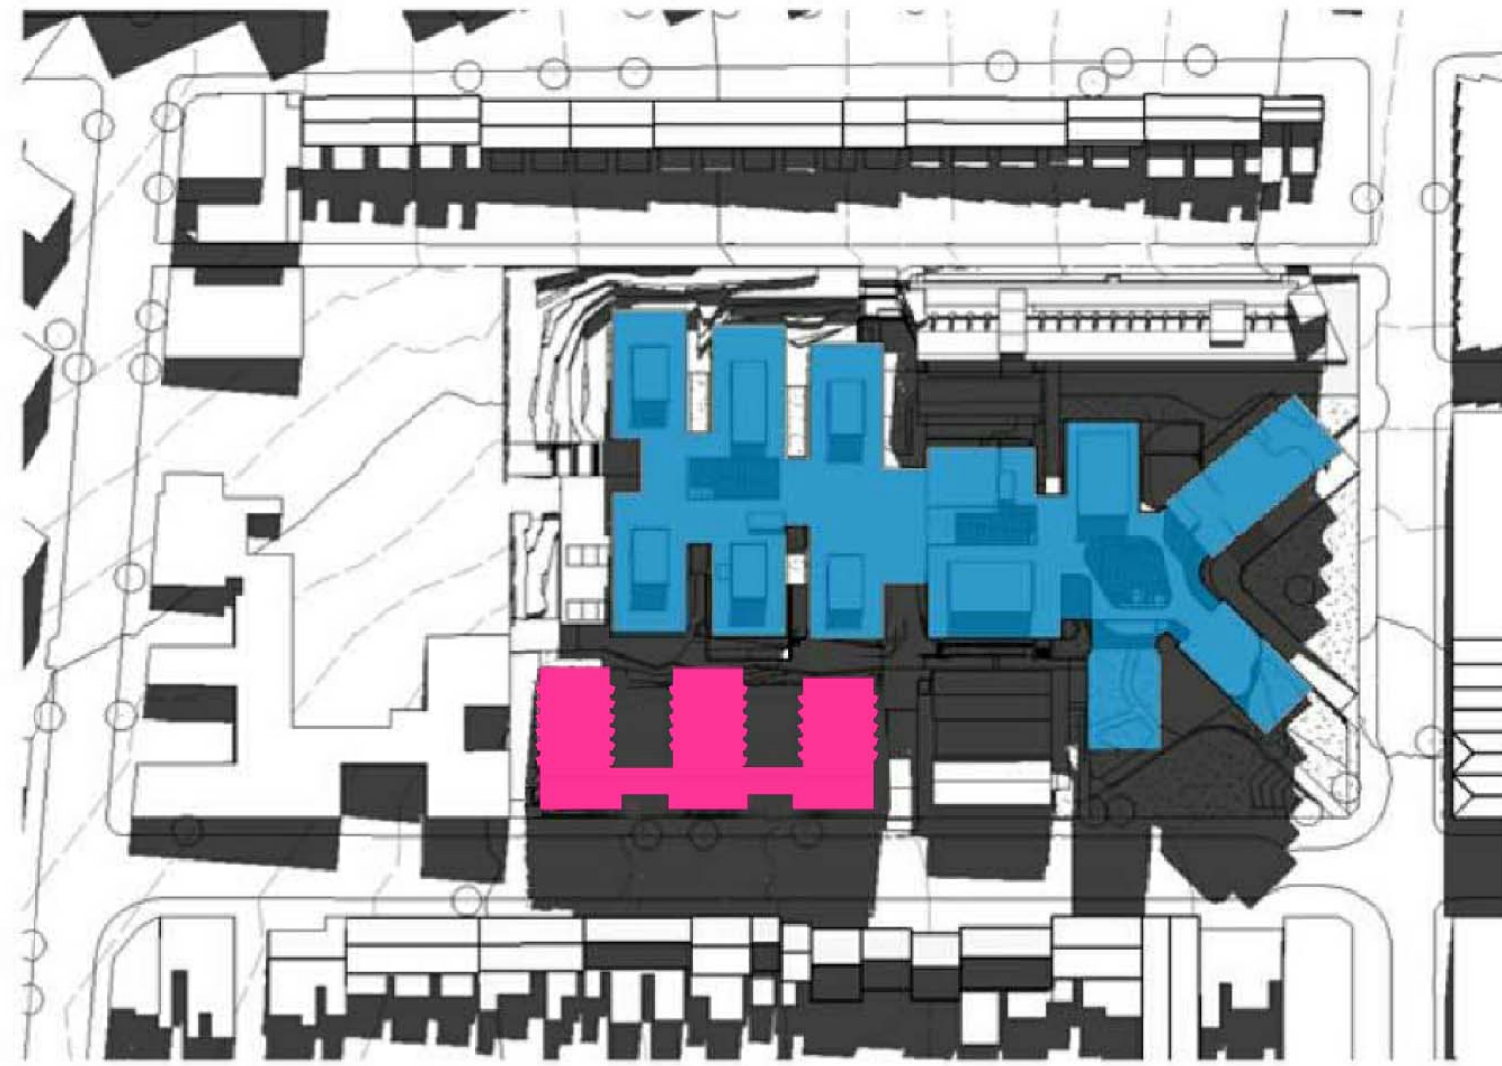

21 June 01:00 PM





21 June 02:00 PM

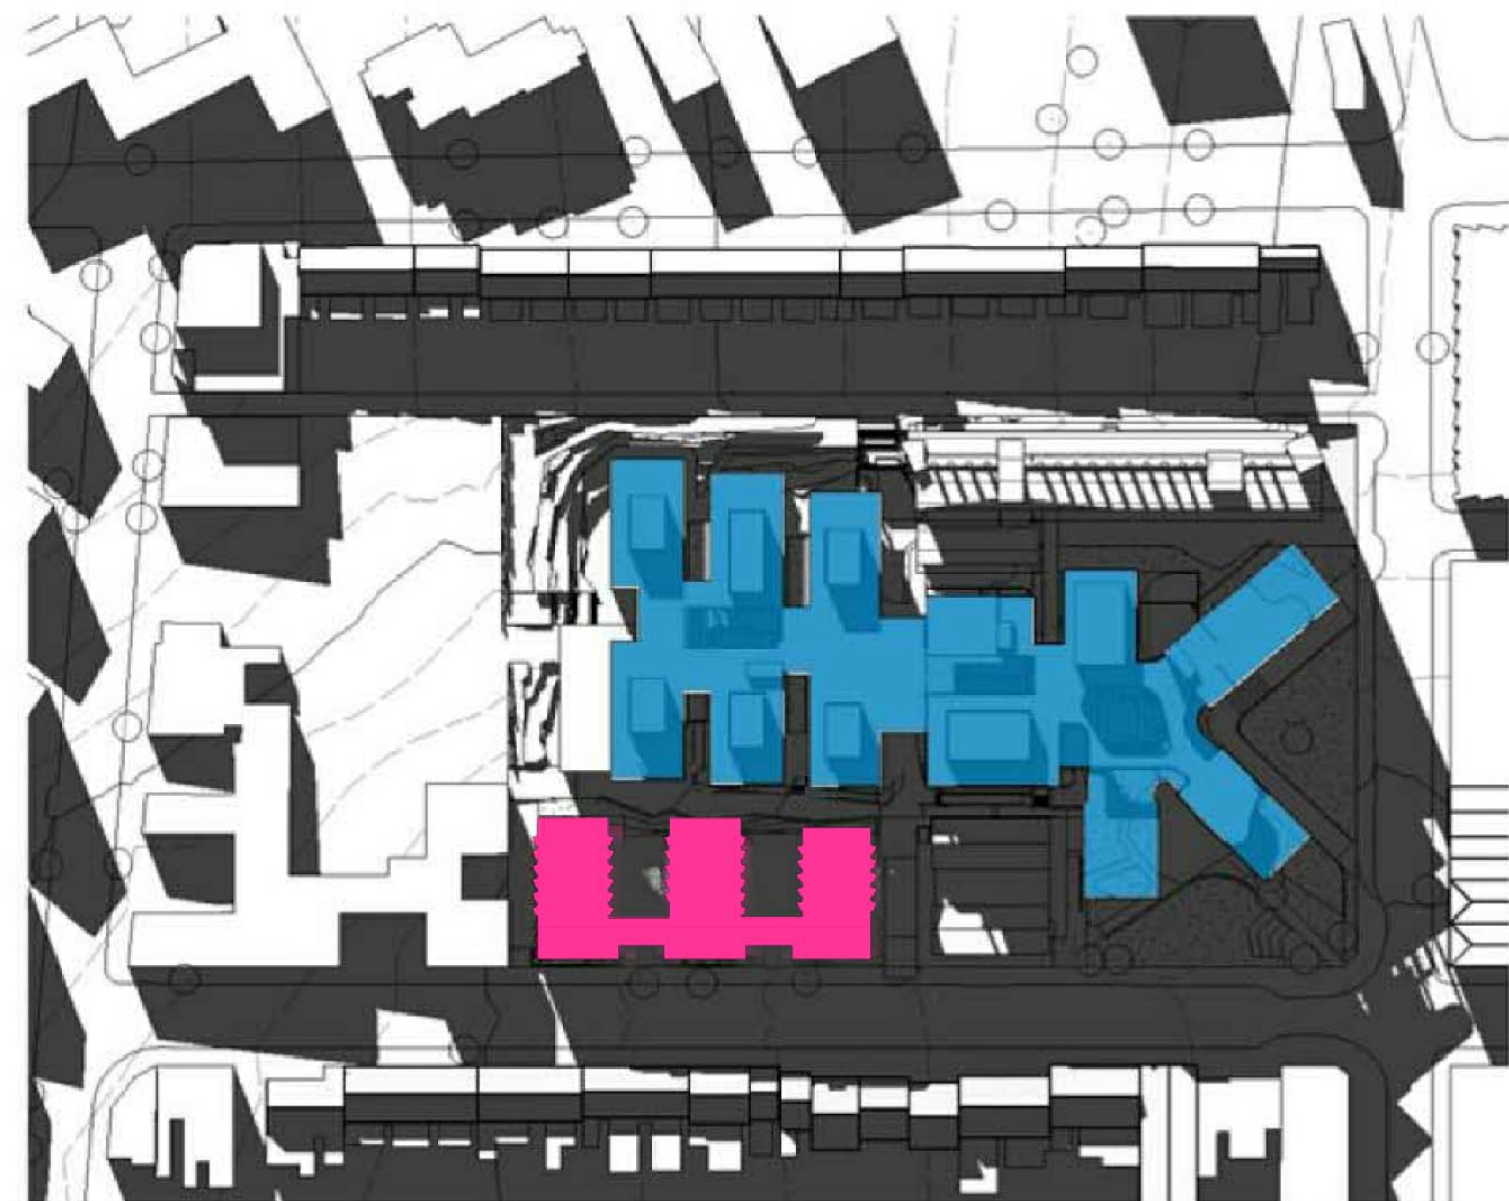


21 June 03:00 PM

PROPOSED BUSINESS SCHOOL
PROPOSED STUDENT ACCOMODATION



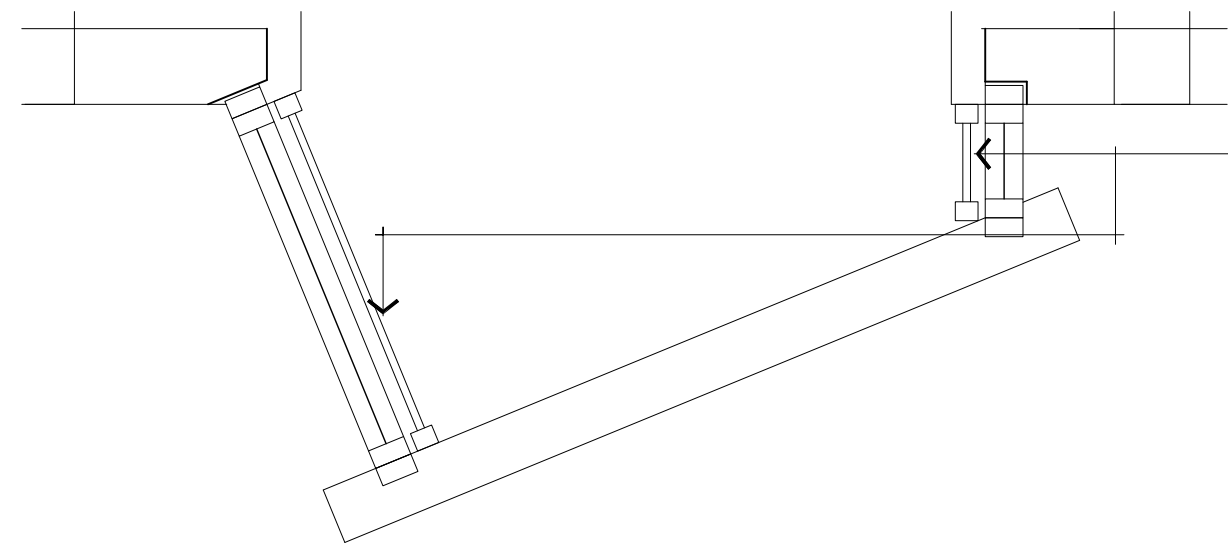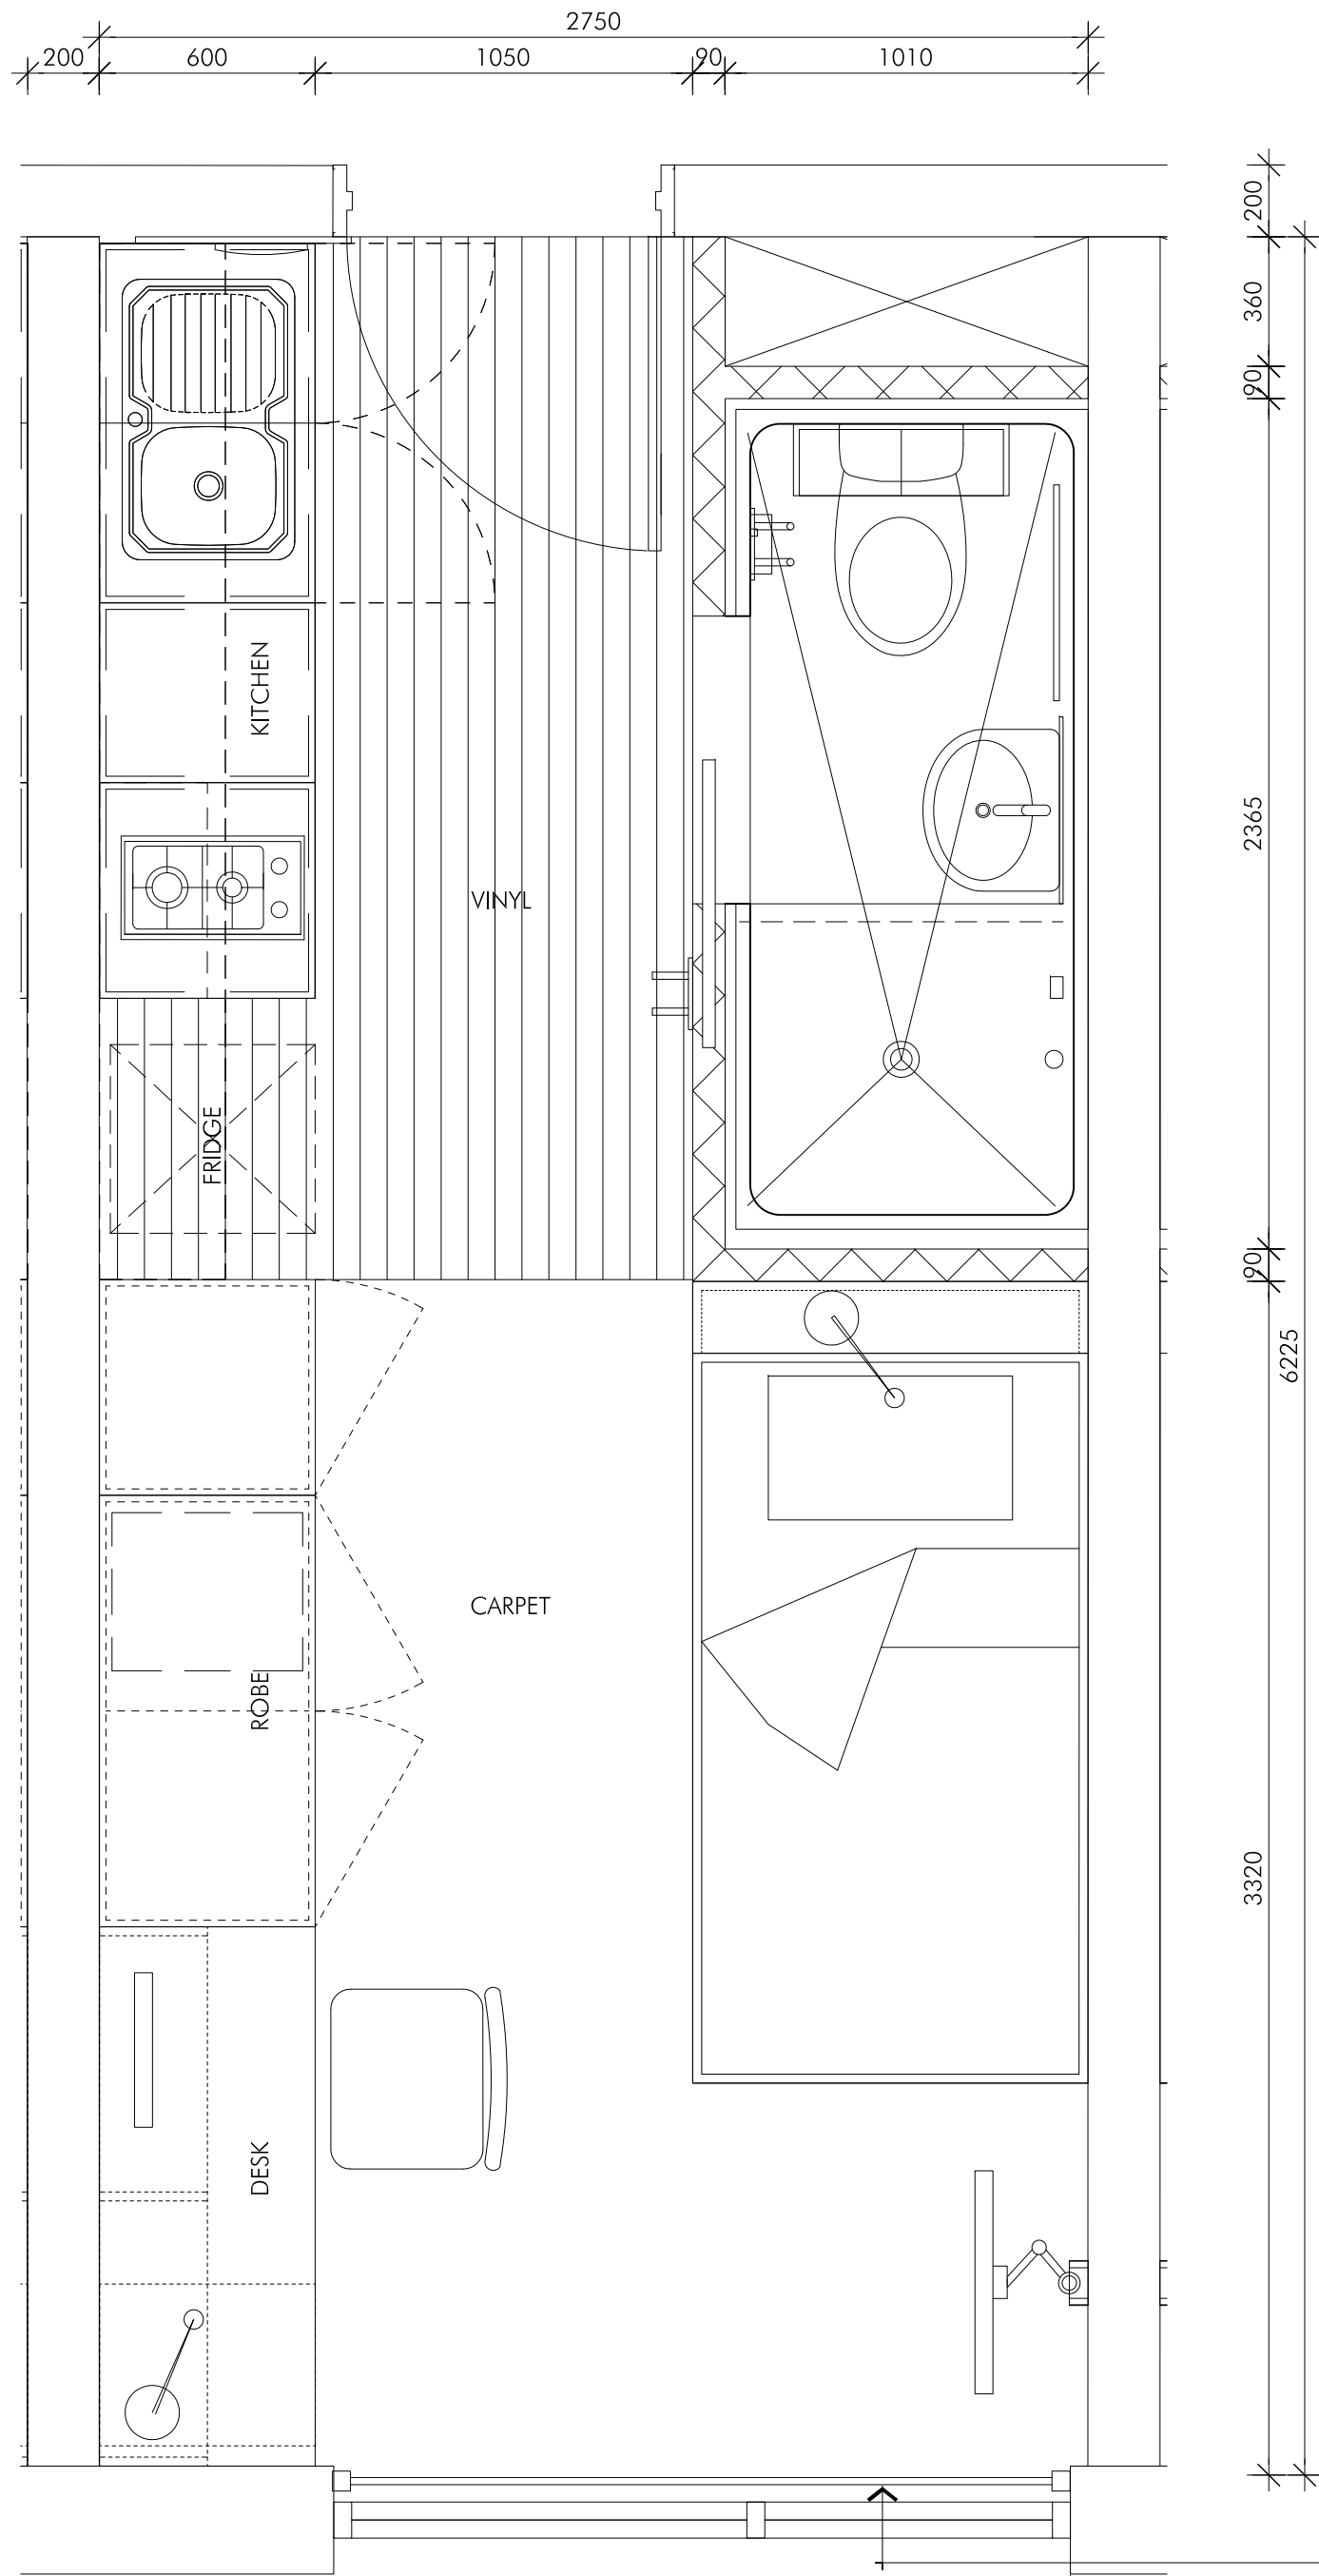

1 STUDIO-TYPE 1
SCALE 1:20 @ A1

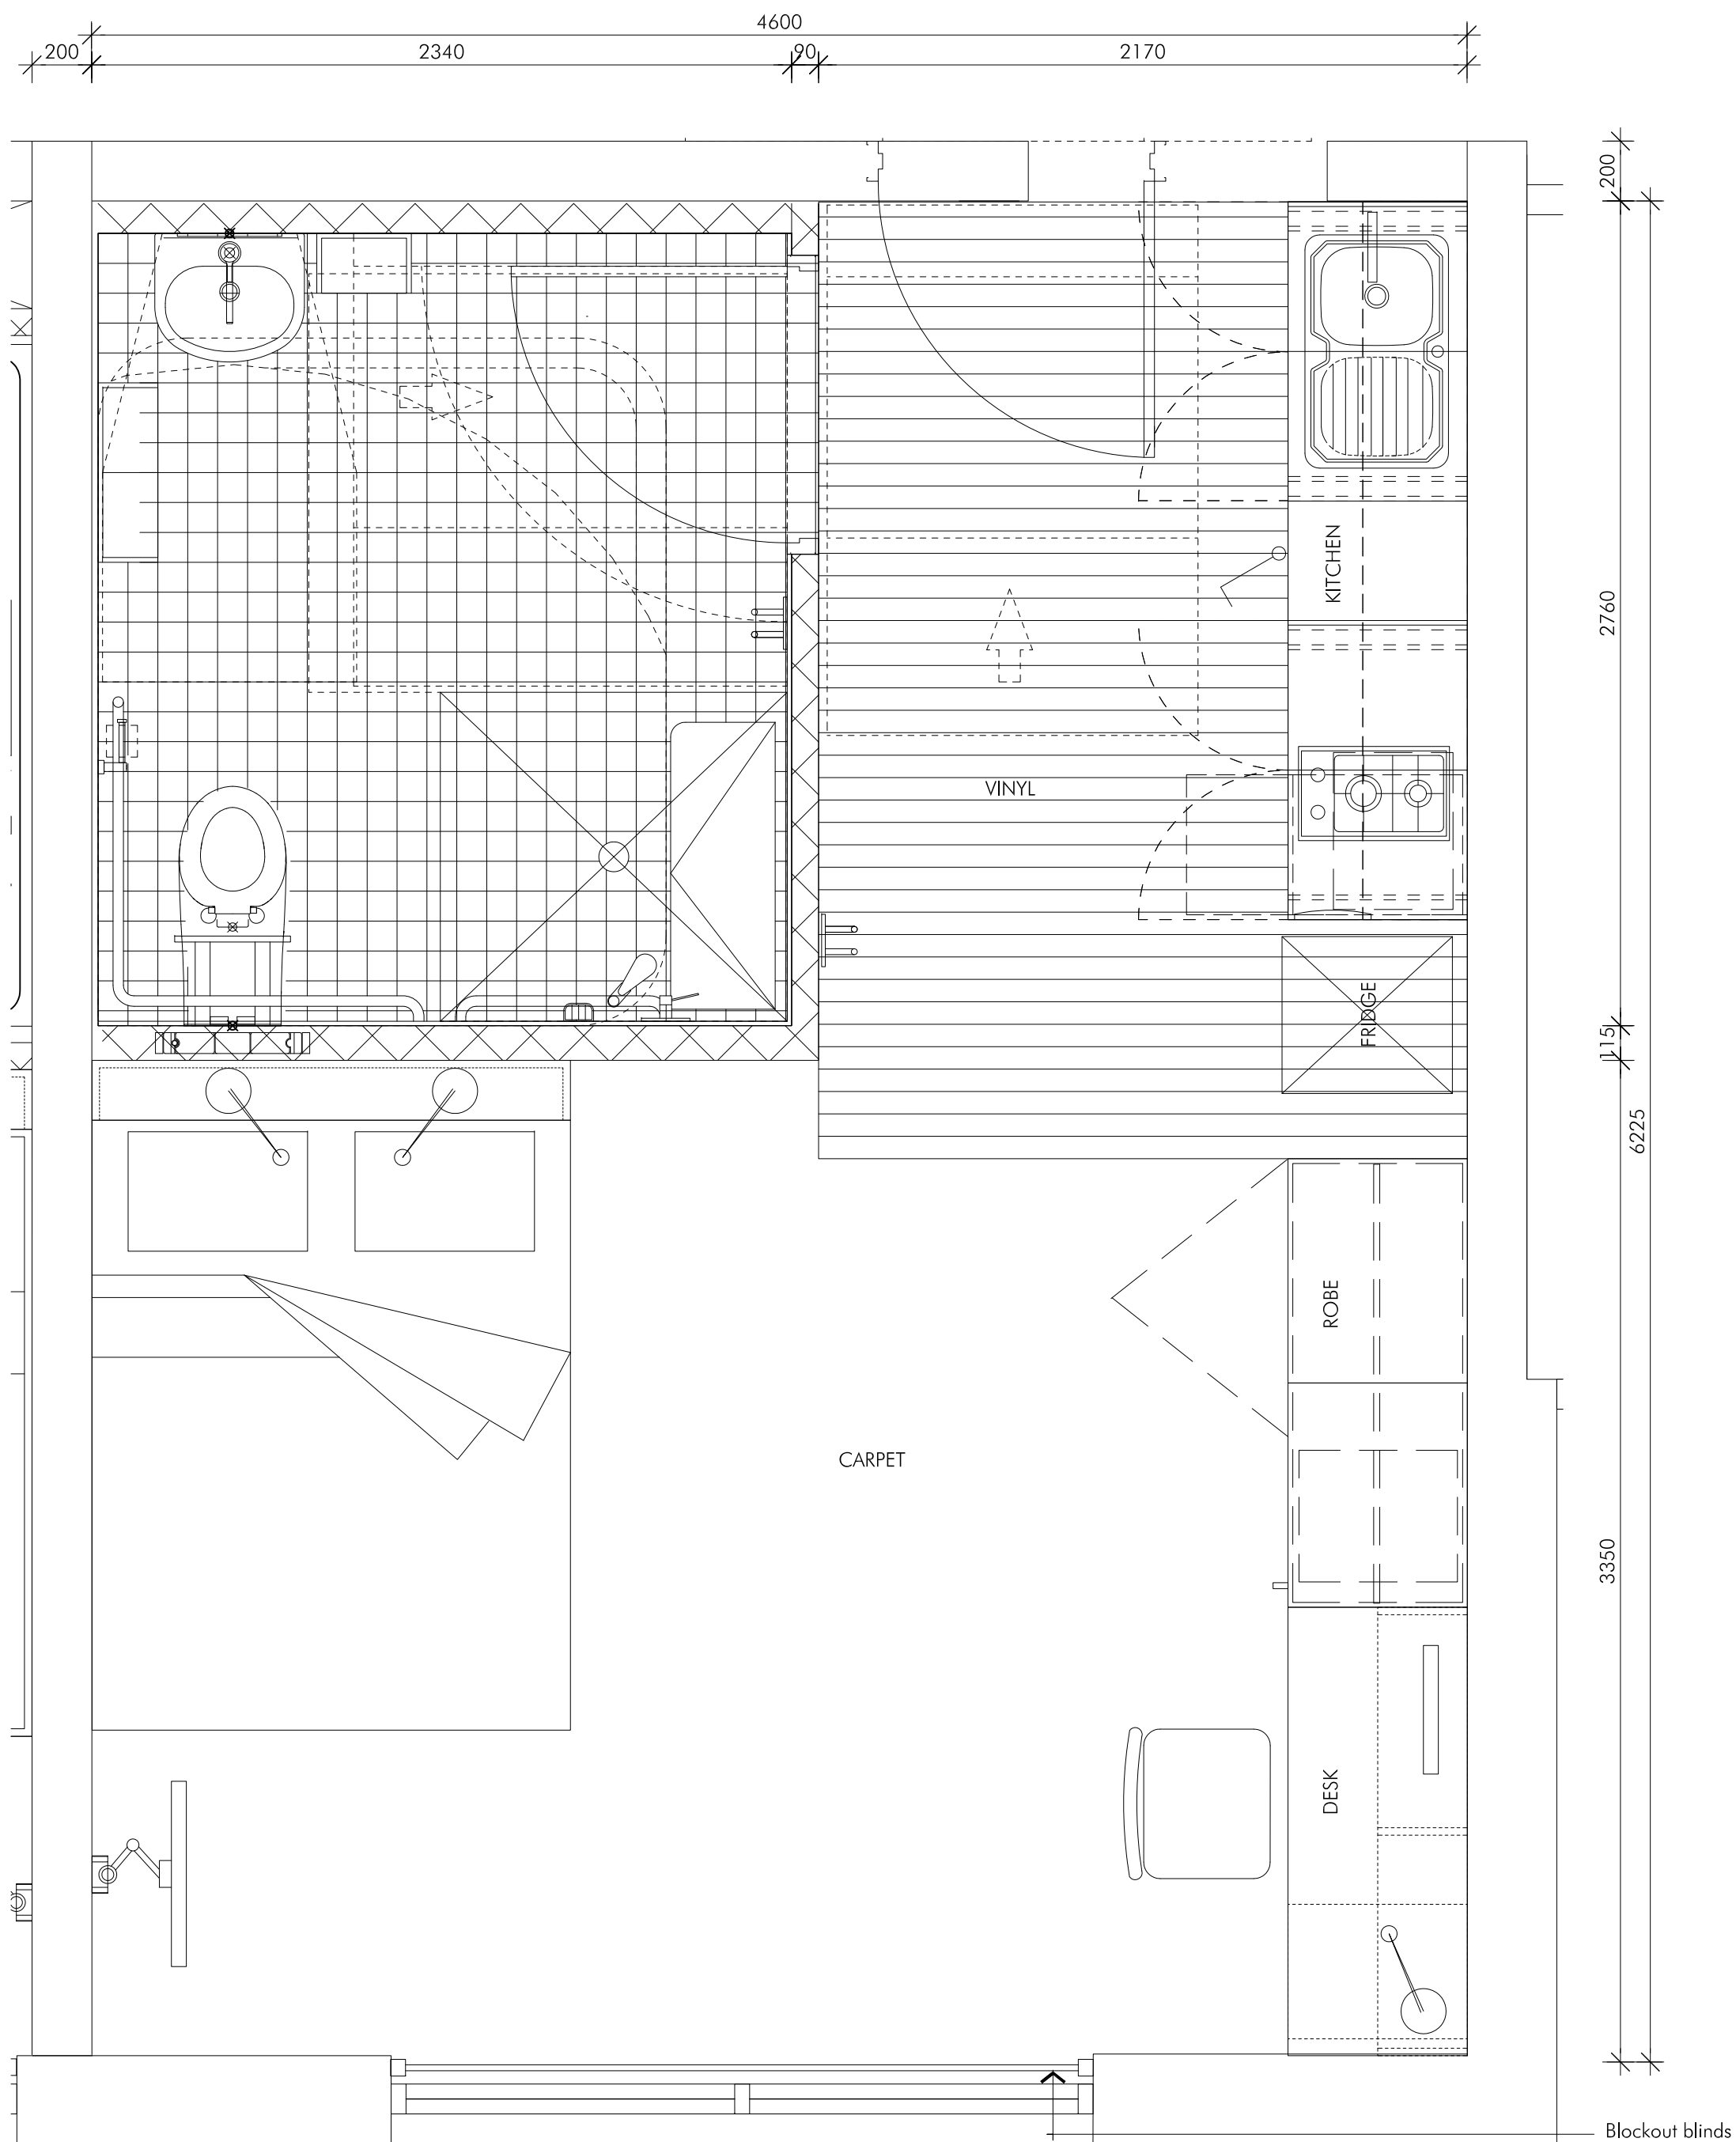

2 ACCESSIBLE STUDIO-TYPE 2
SCALE 1:20 @ A1

