

NSW GOVERNMENT  
 Issued under the Environmental Planning and Assessment Act 1979  
 Approved Application No. 03-0046  
 granted on the 12 March 2012  
 Signed: MB  
 Sheet No. 1 of 6

no	description	date
1	NSWM Title Boundary Line corrected and noted	10/1/2009
2	ISSUE TO DEPARTMENT OF PLANNING	24/4/10
3	New Cycleway and Footpath added	13/6/10
4	RLA changed to APD only	13/6/10
5	Proposed Building Removal, Existing Building Retained	21/6/11

**MP080046 APPROVED STAMPED PLAN**


**CORBEN ARCHITECTS**  
 14/0 Yoo Street Neutral Bay NSW 2059  
 T: 02 9504 1944 F: 02 9504 1955

Client: Ardent Leisure Pty Ltd  
 Project: d'Albora Marina Refurbishment

Address: The Spit, Mosman  
 Title: Master Plan

Scale: 1:500  
 Drawing No: DA01  
 Date: R



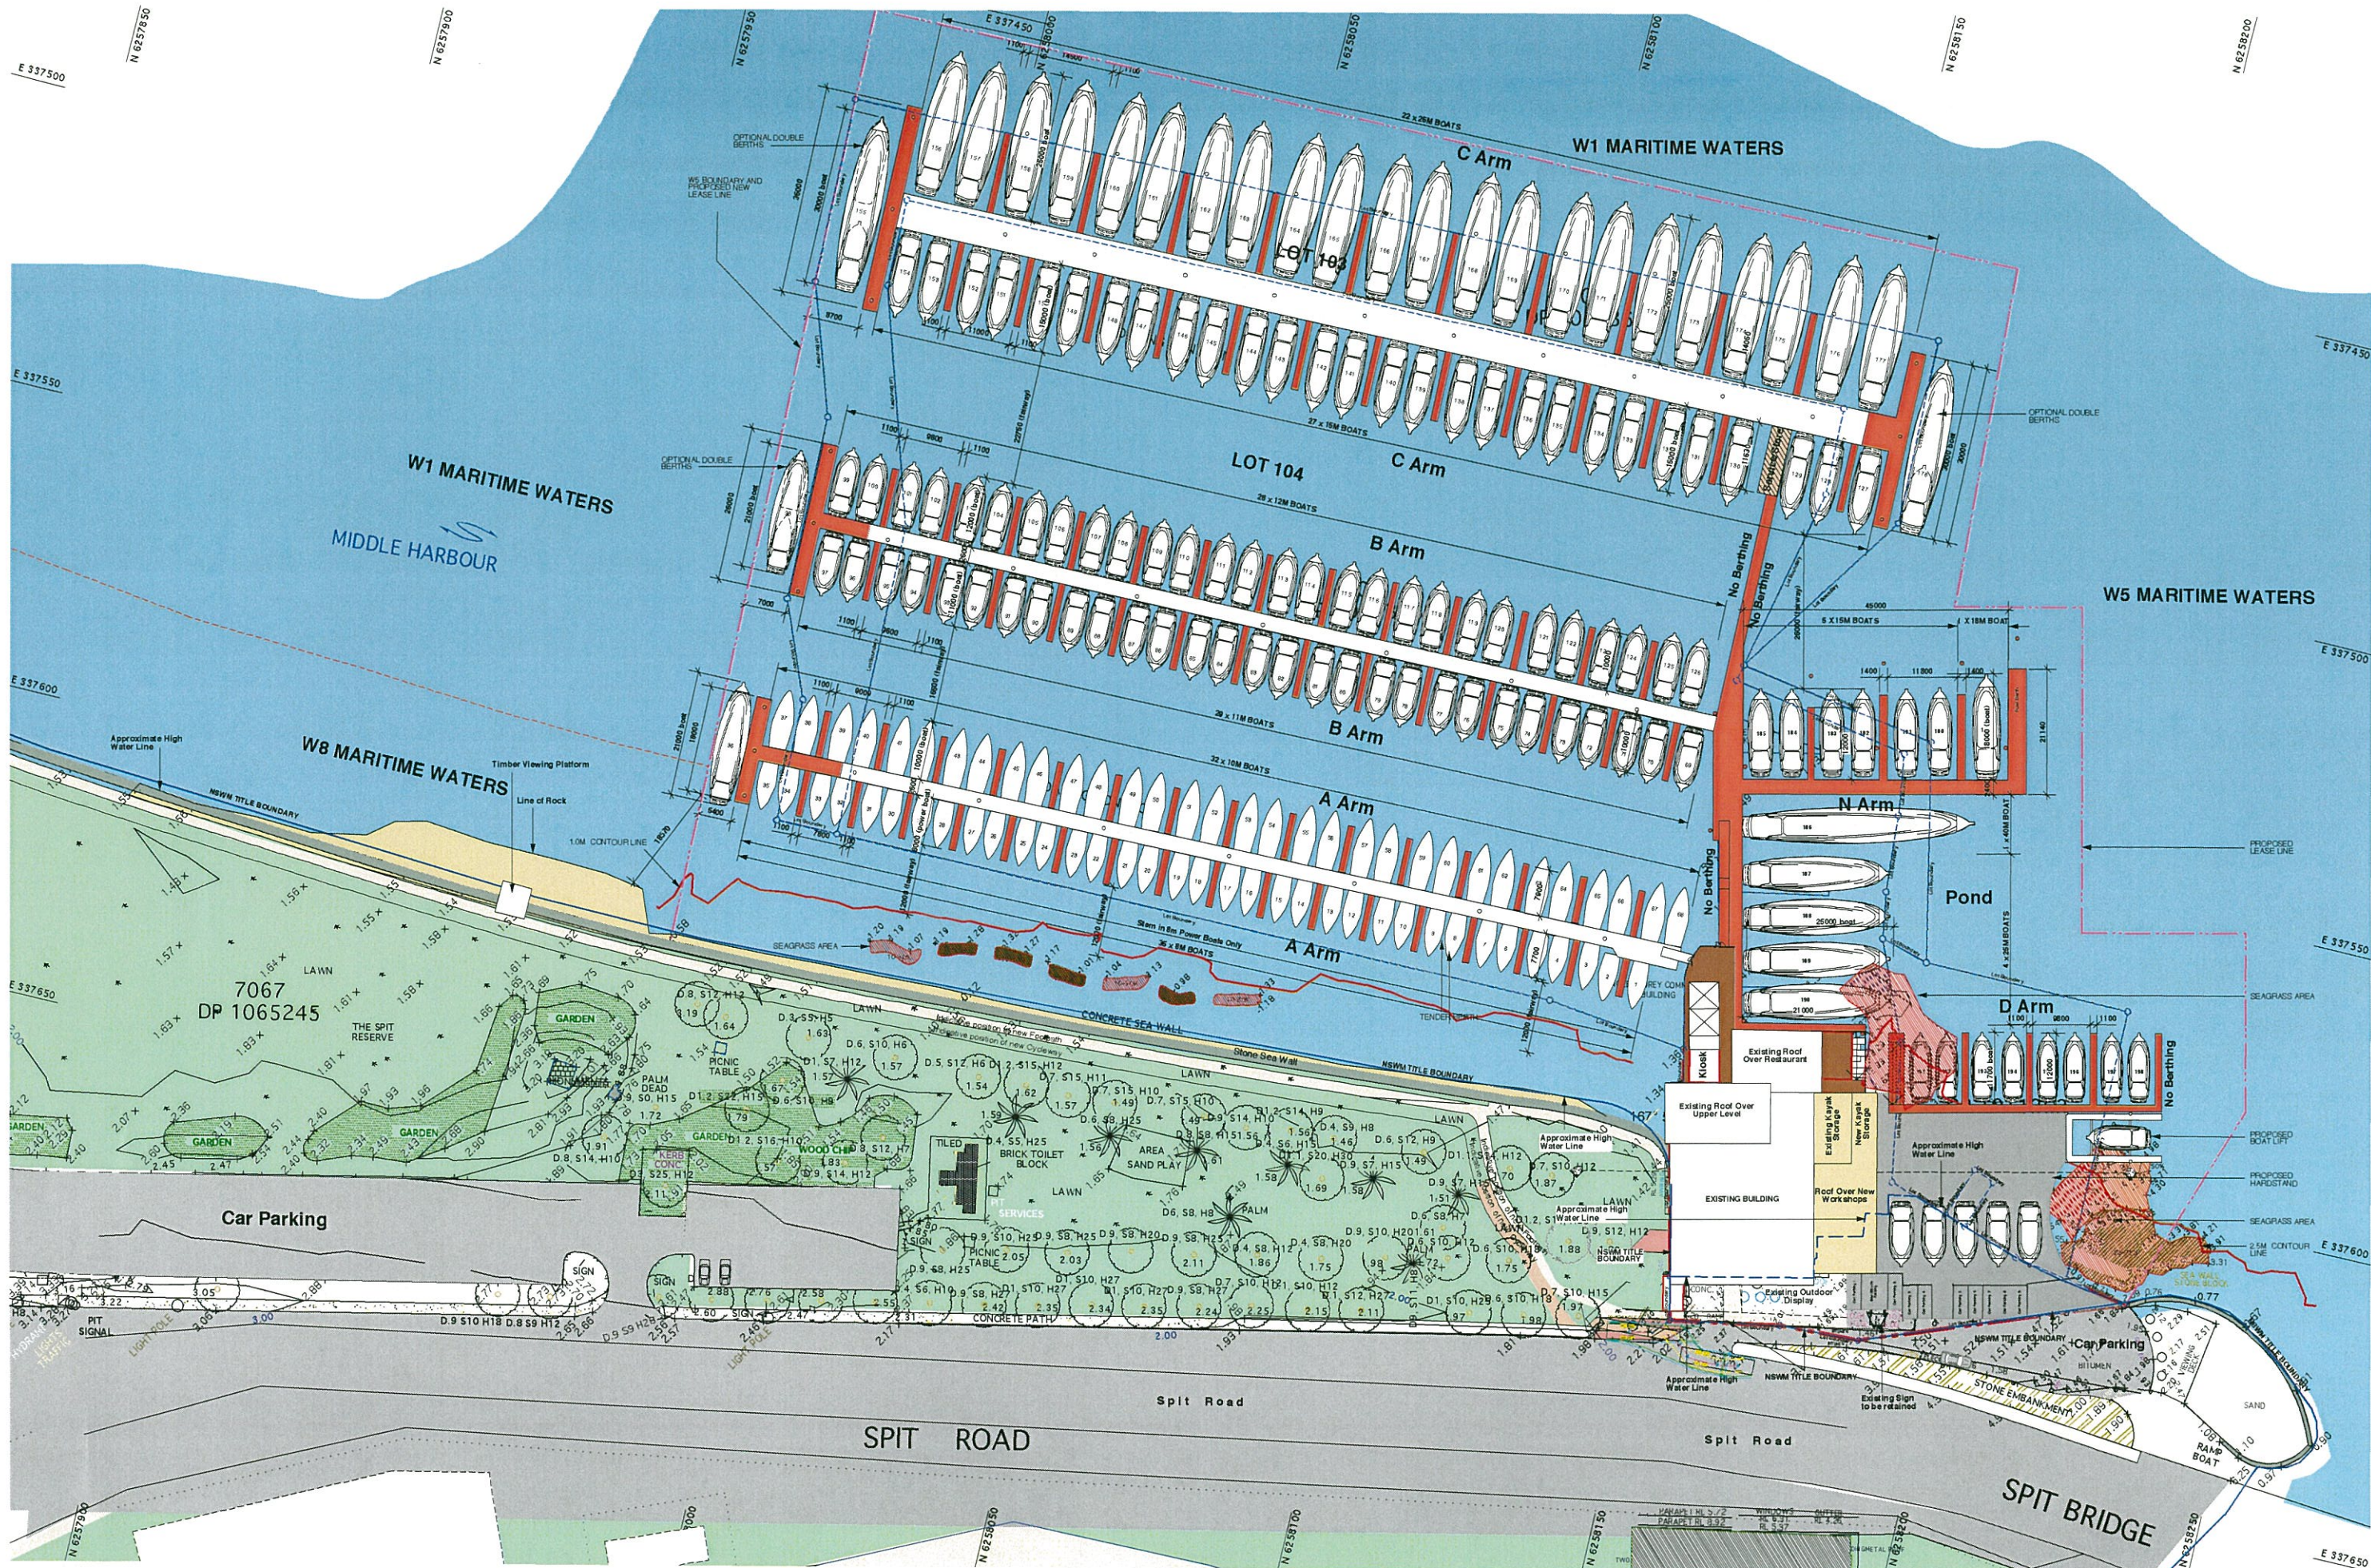

**NOTES**

1. All dimensions are to be taken to the face of the structure unless otherwise stated.
2. All dimensions are to be taken to the face of the structure unless otherwise stated.
3. All dimensions are to be taken to the face of the structure unless otherwise stated.
4. All dimensions are to be taken to the face of the structure unless otherwise stated.
5. All dimensions are to be taken to the face of the structure unless otherwise stated.
6. All dimensions are to be taken to the face of the structure unless otherwise stated.
7. All dimensions are to be taken to the face of the structure unless otherwise stated.
8. All dimensions are to be taken to the face of the structure unless otherwise stated.
9. All dimensions are to be taken to the face of the structure unless otherwise stated.
10. All dimensions are to be taken to the face of the structure unless otherwise stated.

**REVISIONS**

no	amendment	date
1	Berthing structure added. T. Head on south end of Arm B removed. Berth 122 associated with Arm B changed to 10m power boat. All small and viewing platforms updated. <td>30/4/14</td>	30/4/14
2	N Arms revised. D Arm deleted. Boat numbers assigned. Proposed hardstand removed. U Arm has revised. Berthing schedule updated. <td>19/5/14</td>	19/5/14
3	Revisions as per W/Lender email and mark up. <td>5/1/15</td>	5/1/15
4	Issue to Client <td>1/1/15</td>	1/1/15
5	Revisions to N Arm and D Arm <td>2/4/15</td>	2/4/15

MPO80046 MODIFIED PLAN DA01/W

**CORBEN ARCHITECTS**

1440 Yoo Street Neutral Bay NSW 1580  
 T 02 9904 1944 F 02 9904 1955  
 www.corben.com.au mail@corben.com.au

client: Ardent Leisure Pty Ltd

project: d'Albora Marina Refurbishment

address: The Spit, Mosman

use: Master Plan

job no: DMS

drawn: CC

checked: mink

scale: 1:500

sheet: A1

drawing no: DA01

work: W