


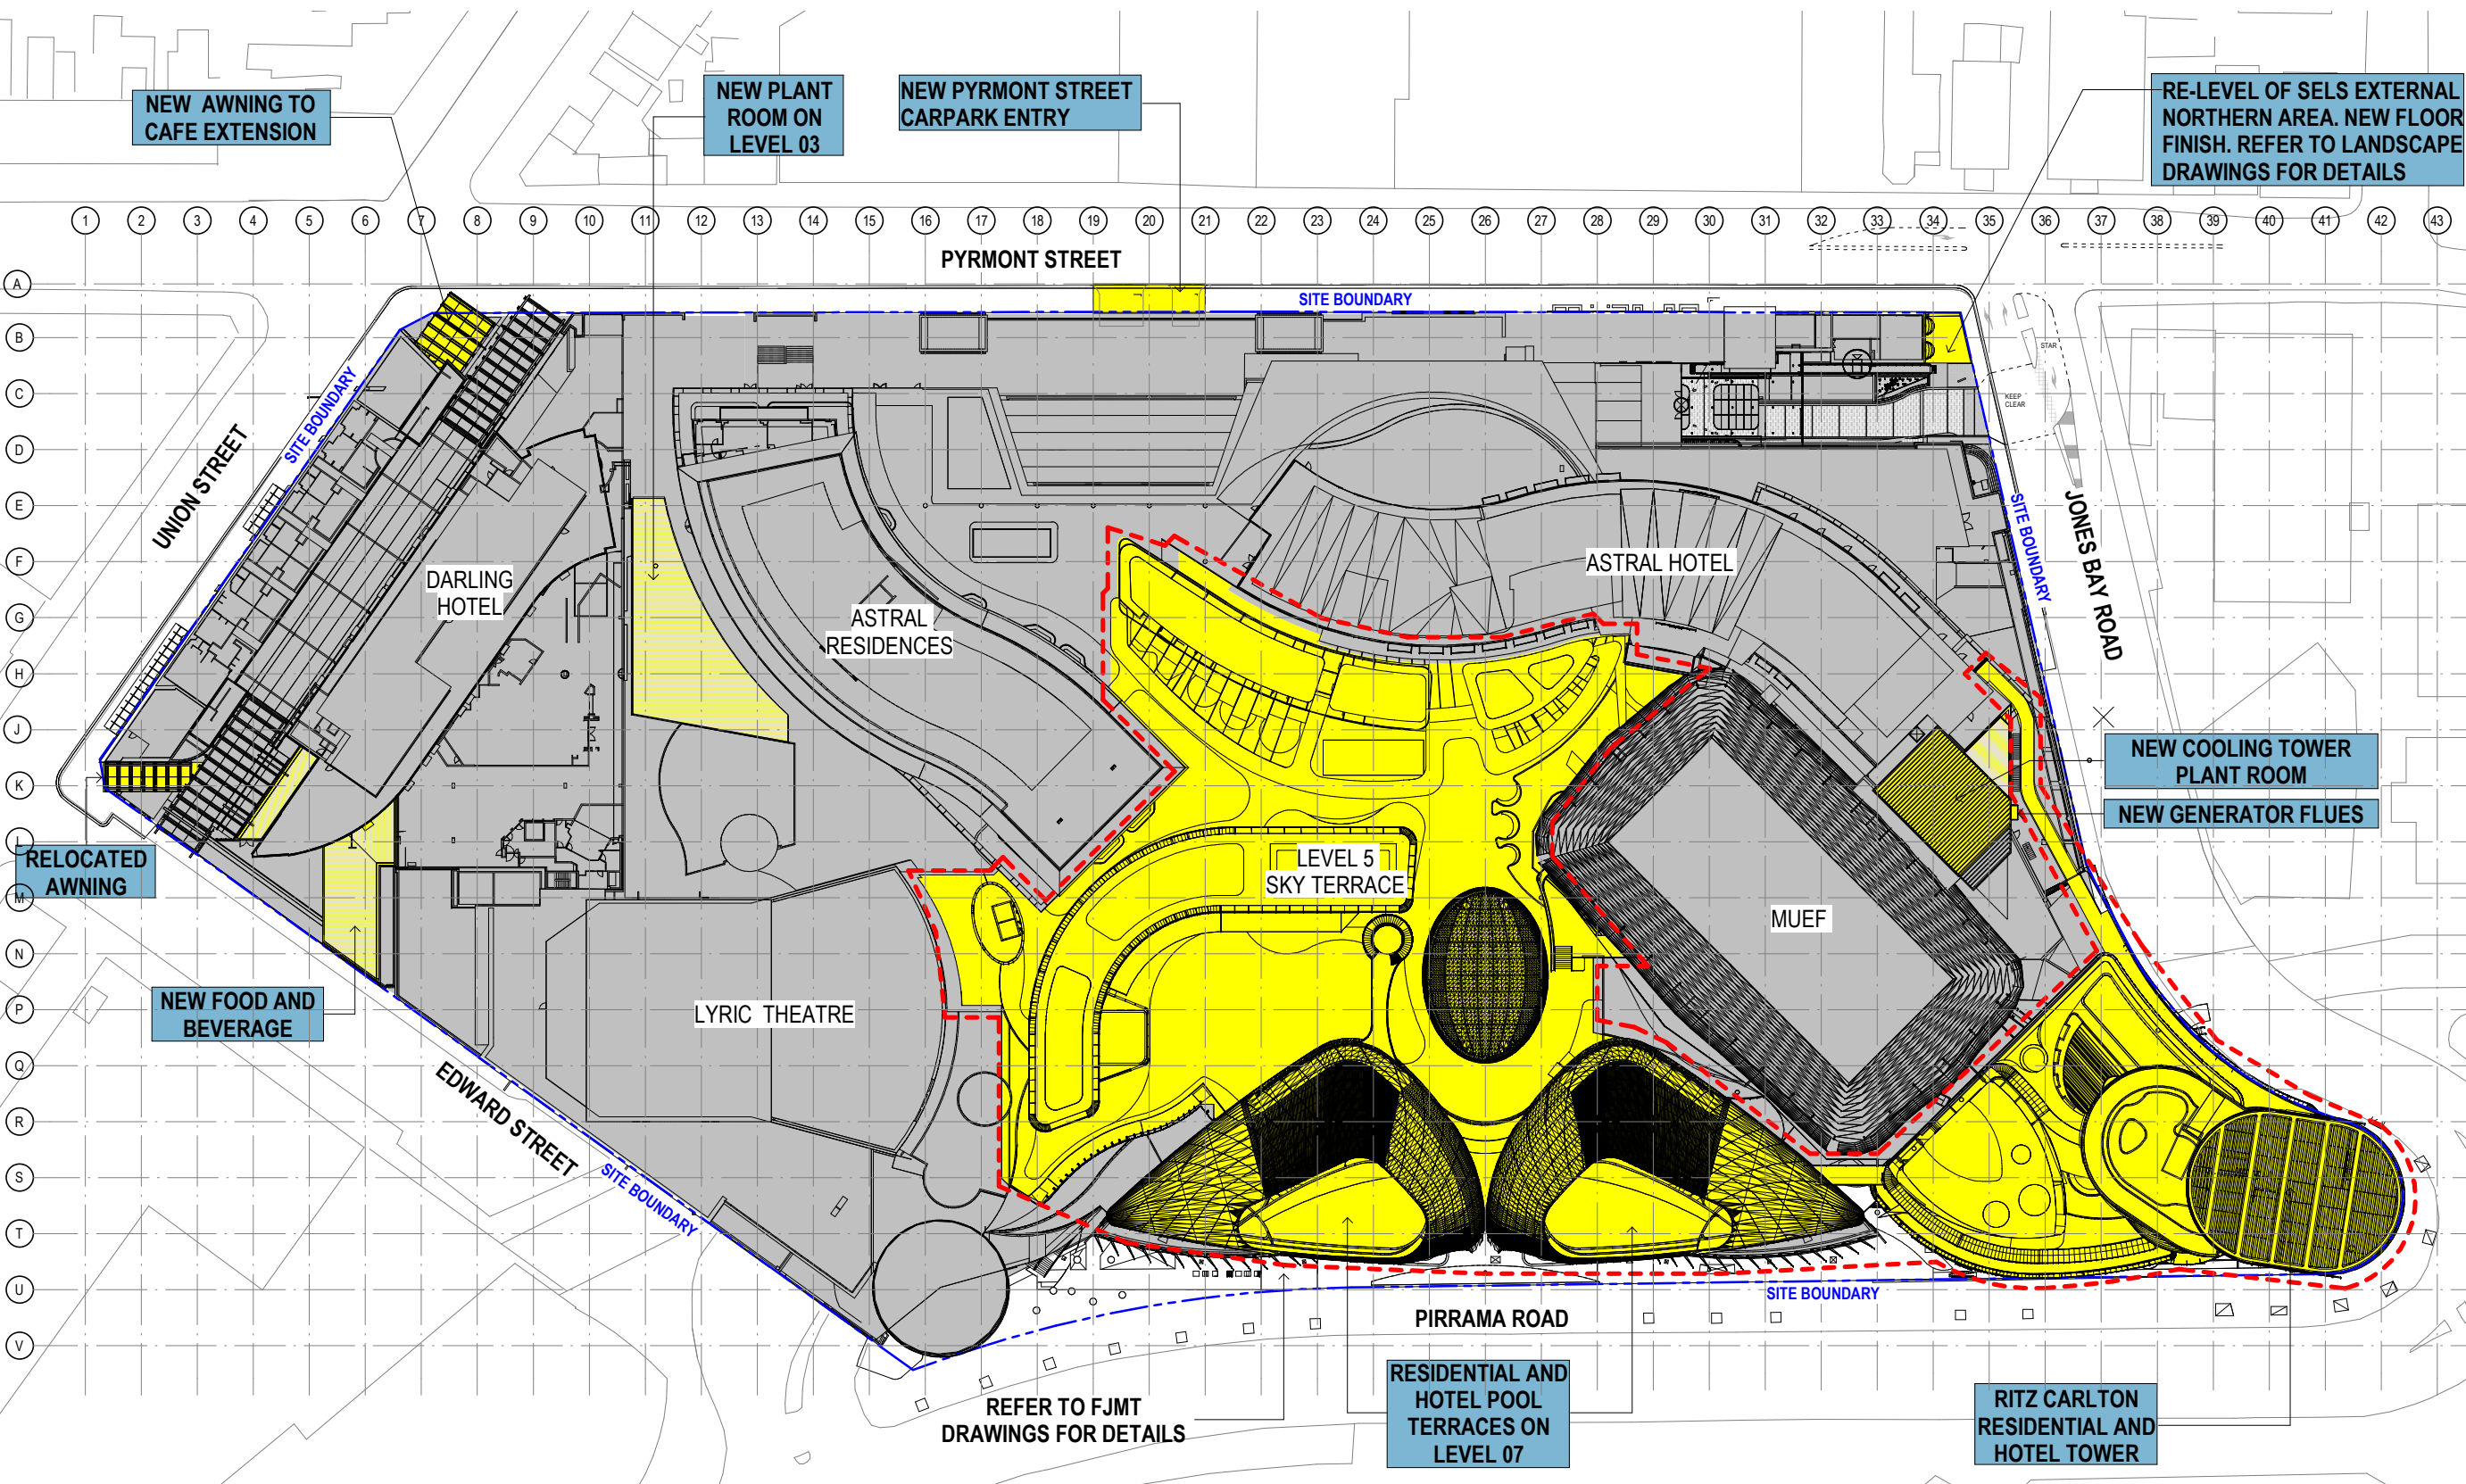


1 SITE PLAN  
1:500

Notes  
The information contained in this document is copyright and may not be used or reproduced for any other project or purpose.  
Verify all dimensions and levels on site and report any discrepancies to dwp for direction prior to the commencement of work.  
Drawings are to be read in conjunction with all other contract documents.  
Use figured dimensions only. Do not scale from drawings. dwp cannot guarantee the accuracy of content and format for copies of drawings issued electronically.  
The completion of the Issue Details Checked and Authorised section is confirmation of the status of the drawing. The drawing shall not be used for construction unless endorsed 'For Construction' and authorised for issue.  
© dwp Australia Pty Ltd  
Registered Business Name dwp Australia ABN 37 169 328 018  
David Rose Nominated Architect NSW APRG 4862

- Consultants
- Planner, Heritage & Social  
URBIS
- Structural & Civil Engineer  
TAYLOR THOMSON WHITTING
- Structural, Mechanical & Fire  
Protection Engineer  
WSP PARSONS  
BRINCKERHOFF
- Electrical, Communications &  
Hydraulic Engineer  
UMBOW LAI
- BCA Consultant  
McKenzie Group

**GENERAL LEVELS NOTE:**  
RLs SHOWN ON  
ARCHITECTURAL DRAWINGS  
ARE 100m ABOVE AHD  
(AUSTRALIAN HEIGHT DATUM).

- LEGEND**
- PROPOSED WORKS
  - EXISTING
  - FJMT SCOPE OF WORKS

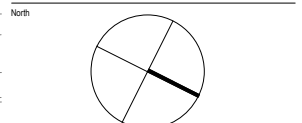

**DA - RESPONSE TO SUBMISSION**  
NOT TO BE USED DURING CONSTRUCTION

|   |                                |            |
|---|--------------------------------|------------|
| E | REVISED CAR PARK ENTRY DETAILS | 31.01.2019 |
| D | RESPONSE TO SUBMISSIONS        | 02.11.2018 |
| C | MOD13 SUBMISSION               | 11.06.2017 |
| B | DRAFT ISSUE                    | 21.06.2017 |
| A | MARK UPS                       | 31.05.2017 |

Architect  
dwp  
www.dwp.com

Project  
THE STAR - MODIFICATION 13

Location  
80 PYRMONT STREET  
PYRMONT NSW 2009

Client  
THE STAR ENTERTAINMENT GROUP  
**THE STAR**  
ENTERTAINMENT GROUP  
周大福企業有限公司  
Chow Tai Fook Enterprises Limited  
遠東發展有限公司  
Far East Consortium International Limited

Drawing  
**SITE WORKS PLAN**

Scale  
1:500 @A1

Date Printed  
1/31/2019 1:09:22 PM

Project Number  
AUSYD160165

Drawing Number  
MOD13-AS0001

Issue  
E

