



By accepting and using this document the recipient agrees that SJB Architects (NSW) Pty. Ltd. ACN 081 094 724 T/A SJB Architects, retain all common law, statutory law and other rights including copyright and intellectual property rights. The recipient agrees not to use this document for any purpose other than its intended use, to waive all claims against SJB Architects resulting from unauthorised changes, or to reuse the document on other projects without the prior written consent of SJB Architects. Under no circumstances shall transfer of this document be deemed a sale. SJB Architects makes no warranties of fitness for any purpose.

The Builder/Contractor shall verify job dimensions prior to any work commencing. Figured dimensions shall take precedence over scaled work.

S75W - FOR APPROVAL		
Rev.	Date	Revision
A	12/11/2010	DA Test of Adequacy
A-1	22/02/2011	Phased Project
A-2	15/04/2012	S75W - March 2012

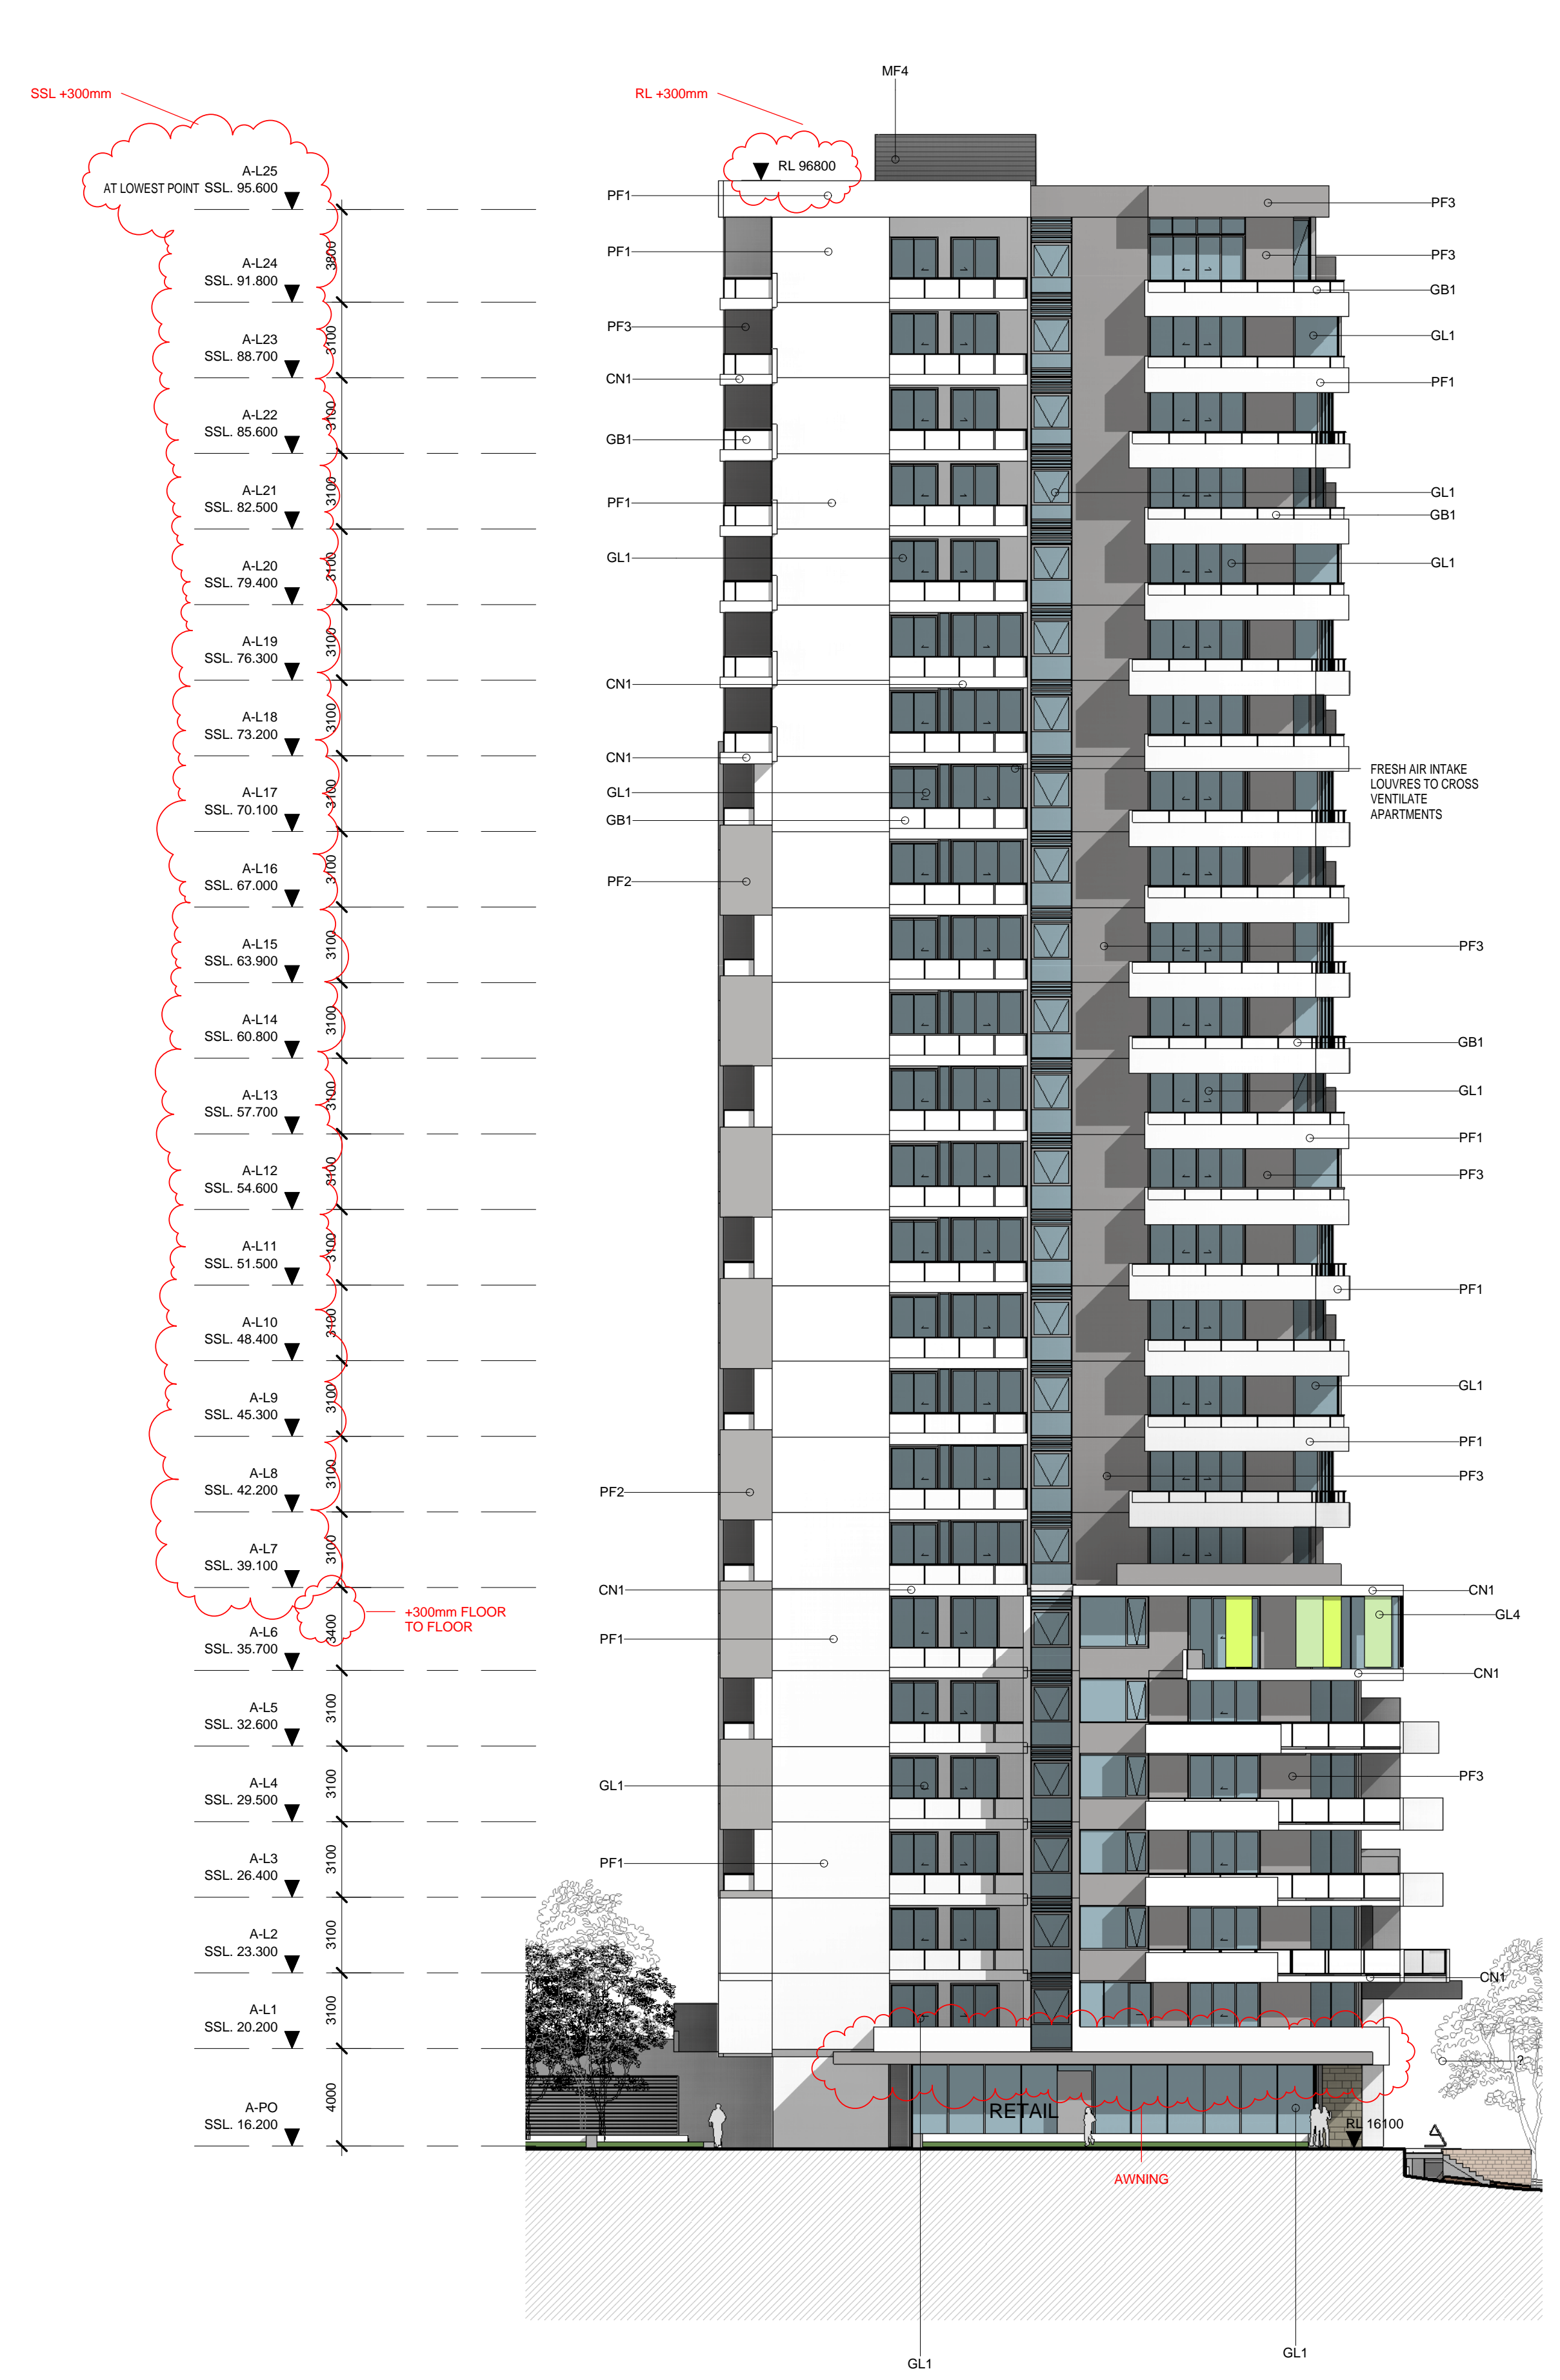

1 ELEVATION
BLDG A - SOUTH
1 : 200

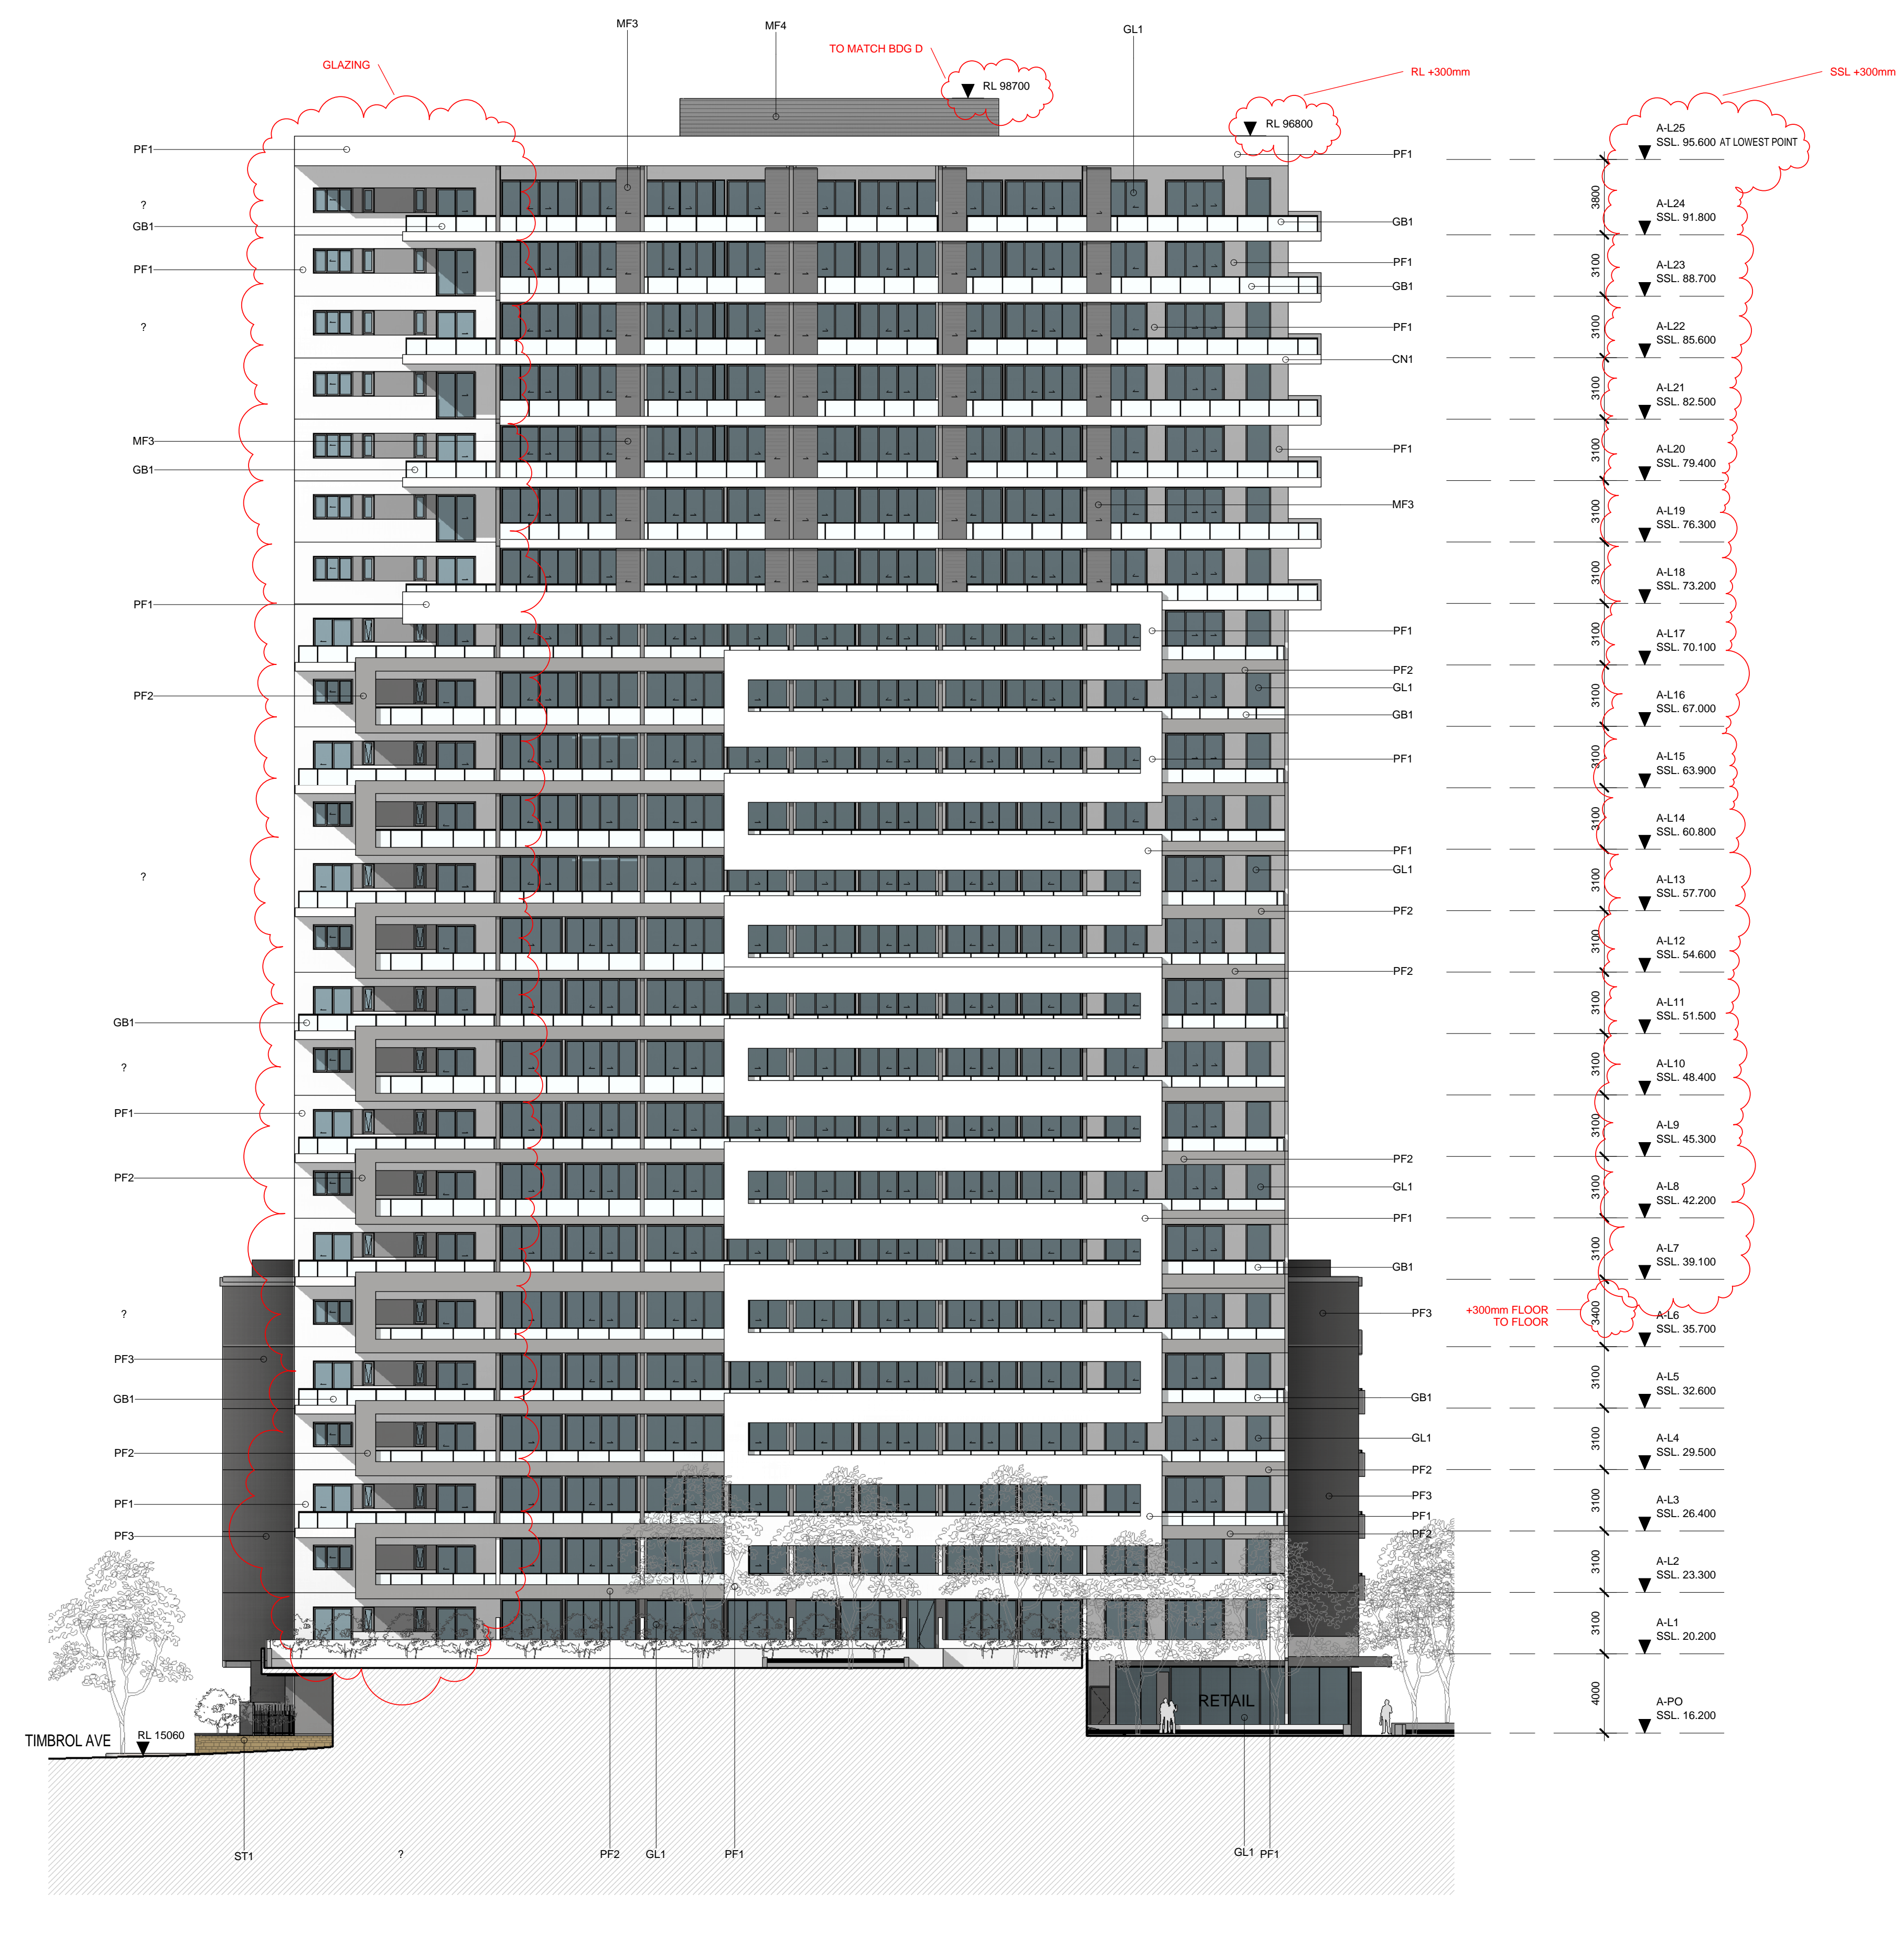


2 ELEVATION
BLDG A - WEST
1 : 200

EXTERNAL FINISHES

- CONCRETE**
 - CN1 Concrete natural finish
 - CR1 Concrete render finish
 - RF1 Roof Finish - Gravel
- MASONRY**
 - PF1 Texture applied finish - White
 - PF2 Texture applied finish - Light Warm Grey
 - PF3 Texture applied finish - Dark Grey
 - ST1 Stone cladding - Stacked grey colour
 - ST2 Stone cladding - Sandstone Finish
- GLAZING**
 - GL1 Clear Glass Windows
 - GL2 Laminated Clear Glass Windows
 - GL3 Obscure Glazing Balustrade
 - GL4 Feature Coloured Glass
 - GB1 Clear glass balustrade with metal handrail
 - WG Wintergarden
- METALWORKS**
 - MB1 Metal balustrade - Steel Galvanised
 - MF1 Metal Finish - Wood + Door Frames
 - MF2 Metal Finish - Shading blades
 - MF3 Metal Finish - Louvre screen
 - MS1 Metal Finish - Plant Screening
 - MS2 Metal Finish - Screen to apartment entries
- TIMBER**
 - TC1 External cladding - Timber Boards
 - TB1 Timber Floor Boards - Natural Stain

NOTE: AS BUILT LEVELS MAY VARY +/- 30mm FROM NOTIMATED SSL's

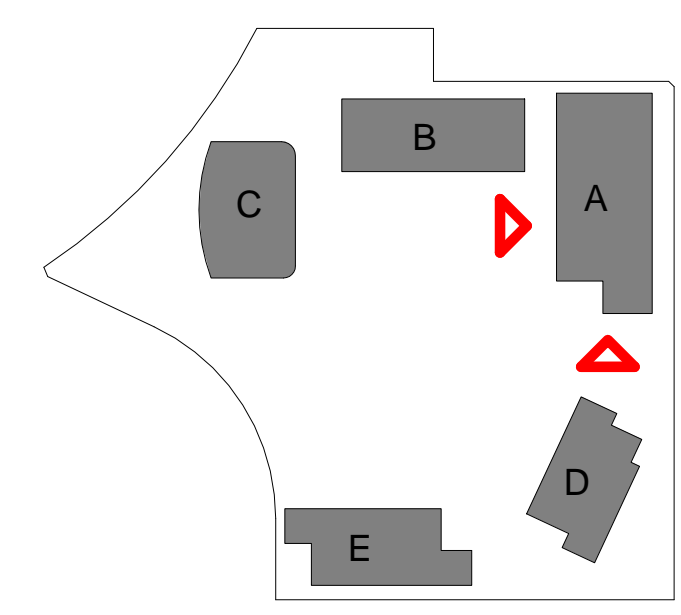

Client
Project
**STAGE 2A + 3A
WALKER ST.
RHODES**
for
Billbergia Developments

Drawing Name
**Elevations - BLDG A
East & West**

Date
18.04.2012

Scale
1 : 200

Sheet Size
@ B1

Reg No.
MM/NH

Chk.
JP

Job No.
4410

Drawing No.
A-0504

Revision
A-2

SJB Architects
Level 2, 490 Crown St
Surry Hills NSW
2010 Australia
T 61 2 9380 9911
F 61 2 9380 9922
www.sjb.com.au

Nominated Architects
Adam Haddock 7188
John Pradel 7004



2004/02/22 10:46 AM