

In accepting and submitting this document the client agrees that SJB Architects (Pty) Ltd, ACN 081 084 724 TIA SJB Architects, retain all common law, statutory and other rights including copyright and intellectual property rights. The client agrees not to use this document for any purpose other than as intended, to ensure all claims against SJB Architects including from unauthorised changes, or to reuse the document on other projects without the prior written consent of SJB Architects. Under no circumstances shall transfer of this document be deemed a sale. SJB Architects makes no warranty of fitness for any purpose.

The client/contractor shall verify all dimensions prior to any work commencing. Figure dimensions shall take precedence over scaled work.


S75W - FOR APPROVAL

Rev.	Date	Revision
A	10/10/2010	DA Test of Adequacy
A-1	22/10/2011	Prepared Project
A-2	16/04/2012	S75W MOD1 - March 2012
A-5	16/10/2012	S75W MOD2 - October 2012

EXTERNAL FINISHES

CONCRETE	
CN1	Concrete natural finish
CN2	Concrete render finish
RF1	Buff finish - Gravel
WETSPRAY	
PF1	Tan wet spray finish - White
PF2	Tan wet spray finish - Light Warm Grey
PF3	Tan wet spray finish - Dark Grey
S11	Stone cladding - Stacked grey colour
S12	Stone cladding - Sandstone finish
GLAZING	
GL1	Clear Glass Windows
GL2	Low-E Glass Windows
GL3	Low-E Glass Balconies
GL4	Low-E Glass Doors
GL5	One glass balustrade with metal handrail
WG	Wingtip
METALWORKS	
MB1	Welded steel - Steel Column
MF1	Welded steel - Window - Steel frame
MF2	Welded steel - Chasing blades
MF3	Welded steel - Louvre screen
MF4	Welded steel - Plant Screening
MF5	Welded steel - Screen to apartment entry
TIMBER	
TC1	Timber cladding - Timber Board
TS1	Timber Floor Board - Natural Oak

NOTE: AS BUILT LEVELS MAY VARY +/- 30mm FROM NOTED SSL'S

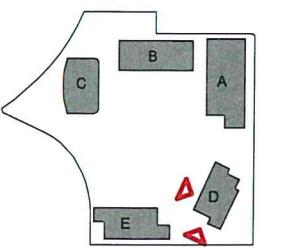

STAGE 2A + 3A
WALKER ST.
RHODES
for
Billbergia Developments

Elevations - BLDG D
South & West

Date	Scale	Sheet Size
22.10.2012	1 : 200	@ B1
Reg No	Drawn	Chk
	MM/NH	JP
Job No	Drawing No	Revision
4410	A-0509	A-5

SJB Architects
Level 2, 450 Crown St
Sunny Hills NSW
2010 Australia
T 61 2 9380 9911
F 61 2 9380 9922
www.sjb.com.au

Nominated Architects
Adam Hadow 7198
John Peadar 7024



NSW GOVERNMENT
Planning

Issued under the Environmental Planning and Assessment Act 1979

Approved Section 75W Modification Application

No. MOD2 granted on the 29.01.13

in respect to MP 10-0105


Signed: [Signature]

Sheet No. 17 of 19

1 ELEVATION
BLDG D - SOUTH



2 ELEVATION
BLDG D - WEST

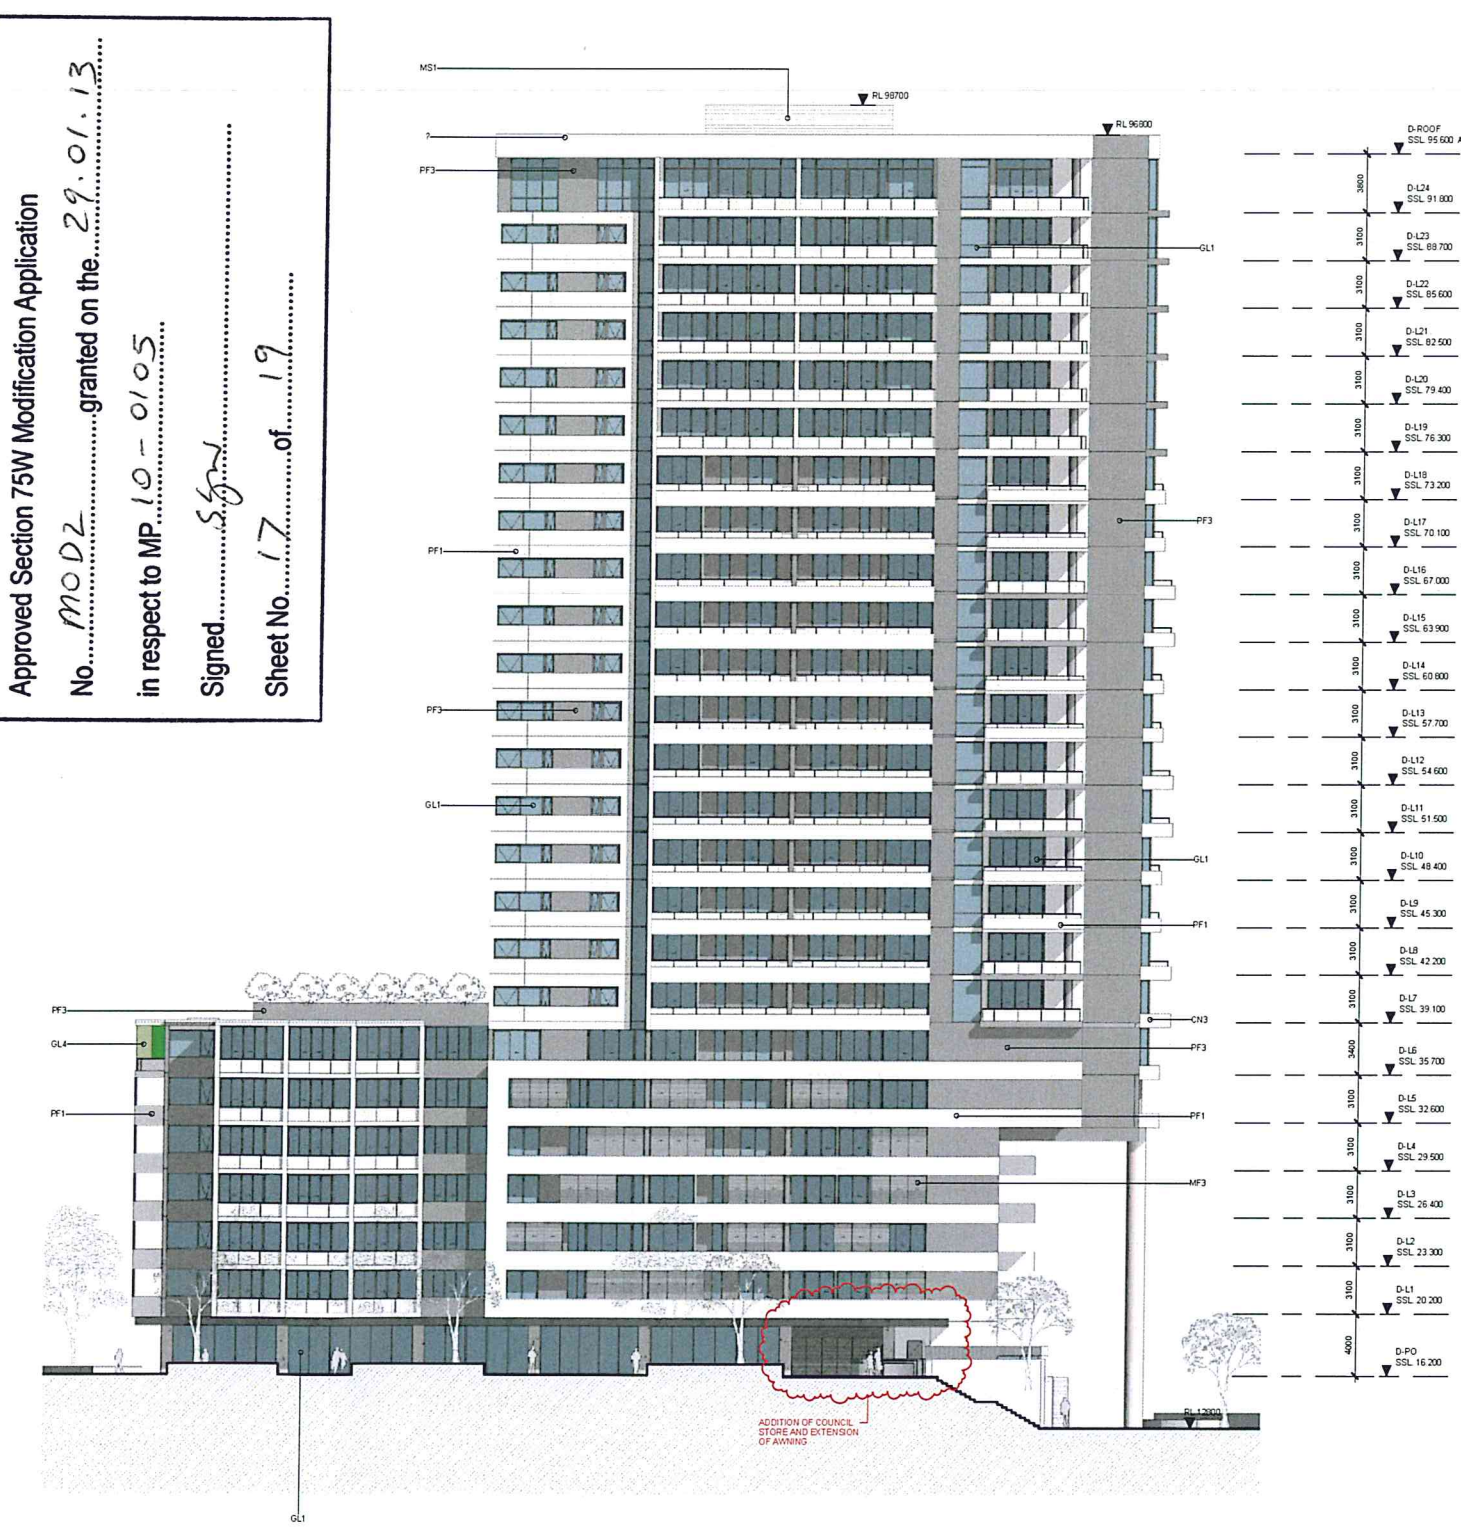

In accepting and using this document the recipient agrees that SJB Architects Pty Ltd, ACN 081 094 724 (SJB Architects), retain all common law, statutory and other rights including copyright and intellectual property rights. The recipient agrees not to use this document for any purpose other than that intended, to make any claims against SJB Architects resulting from unauthorised change, or to reuse the document on other projects without the prior written consent of SJB Architects. Under no circumstances shall transfer of this document be deemed a sale. SJB Architects makes no warranties of fitness for any purpose.

The Recipient/Contractor shall verify job dimensions prior to any work commencing. Figure dimensions shall take precedence over scaled work.

S75W - FOR APPROVAL		
Rev.	Date	Revision
A	12/11/2010	DA Test of Adequacy
A-1	22/02/2011	Preferred Project
A-2	16/04/2012	S75W MOD1 - March 2012
A-3	16/07/2012	Adaptable Parking
A-4	24/08/2012	Adaptable Parking - 3bed to 1bed
A-5	16/10/2012	S75W MOD2 - October 2012

**NSW GOVERNMENT**
Planning

Issued under the *Environmental Planning and Assessment Act 1979*


Approved Section 75W Modification Application

No. MOD2 granted on the 29.01.13


in respect to MP 10-0105

Signed Sgn

Sheet No. 18 of 19

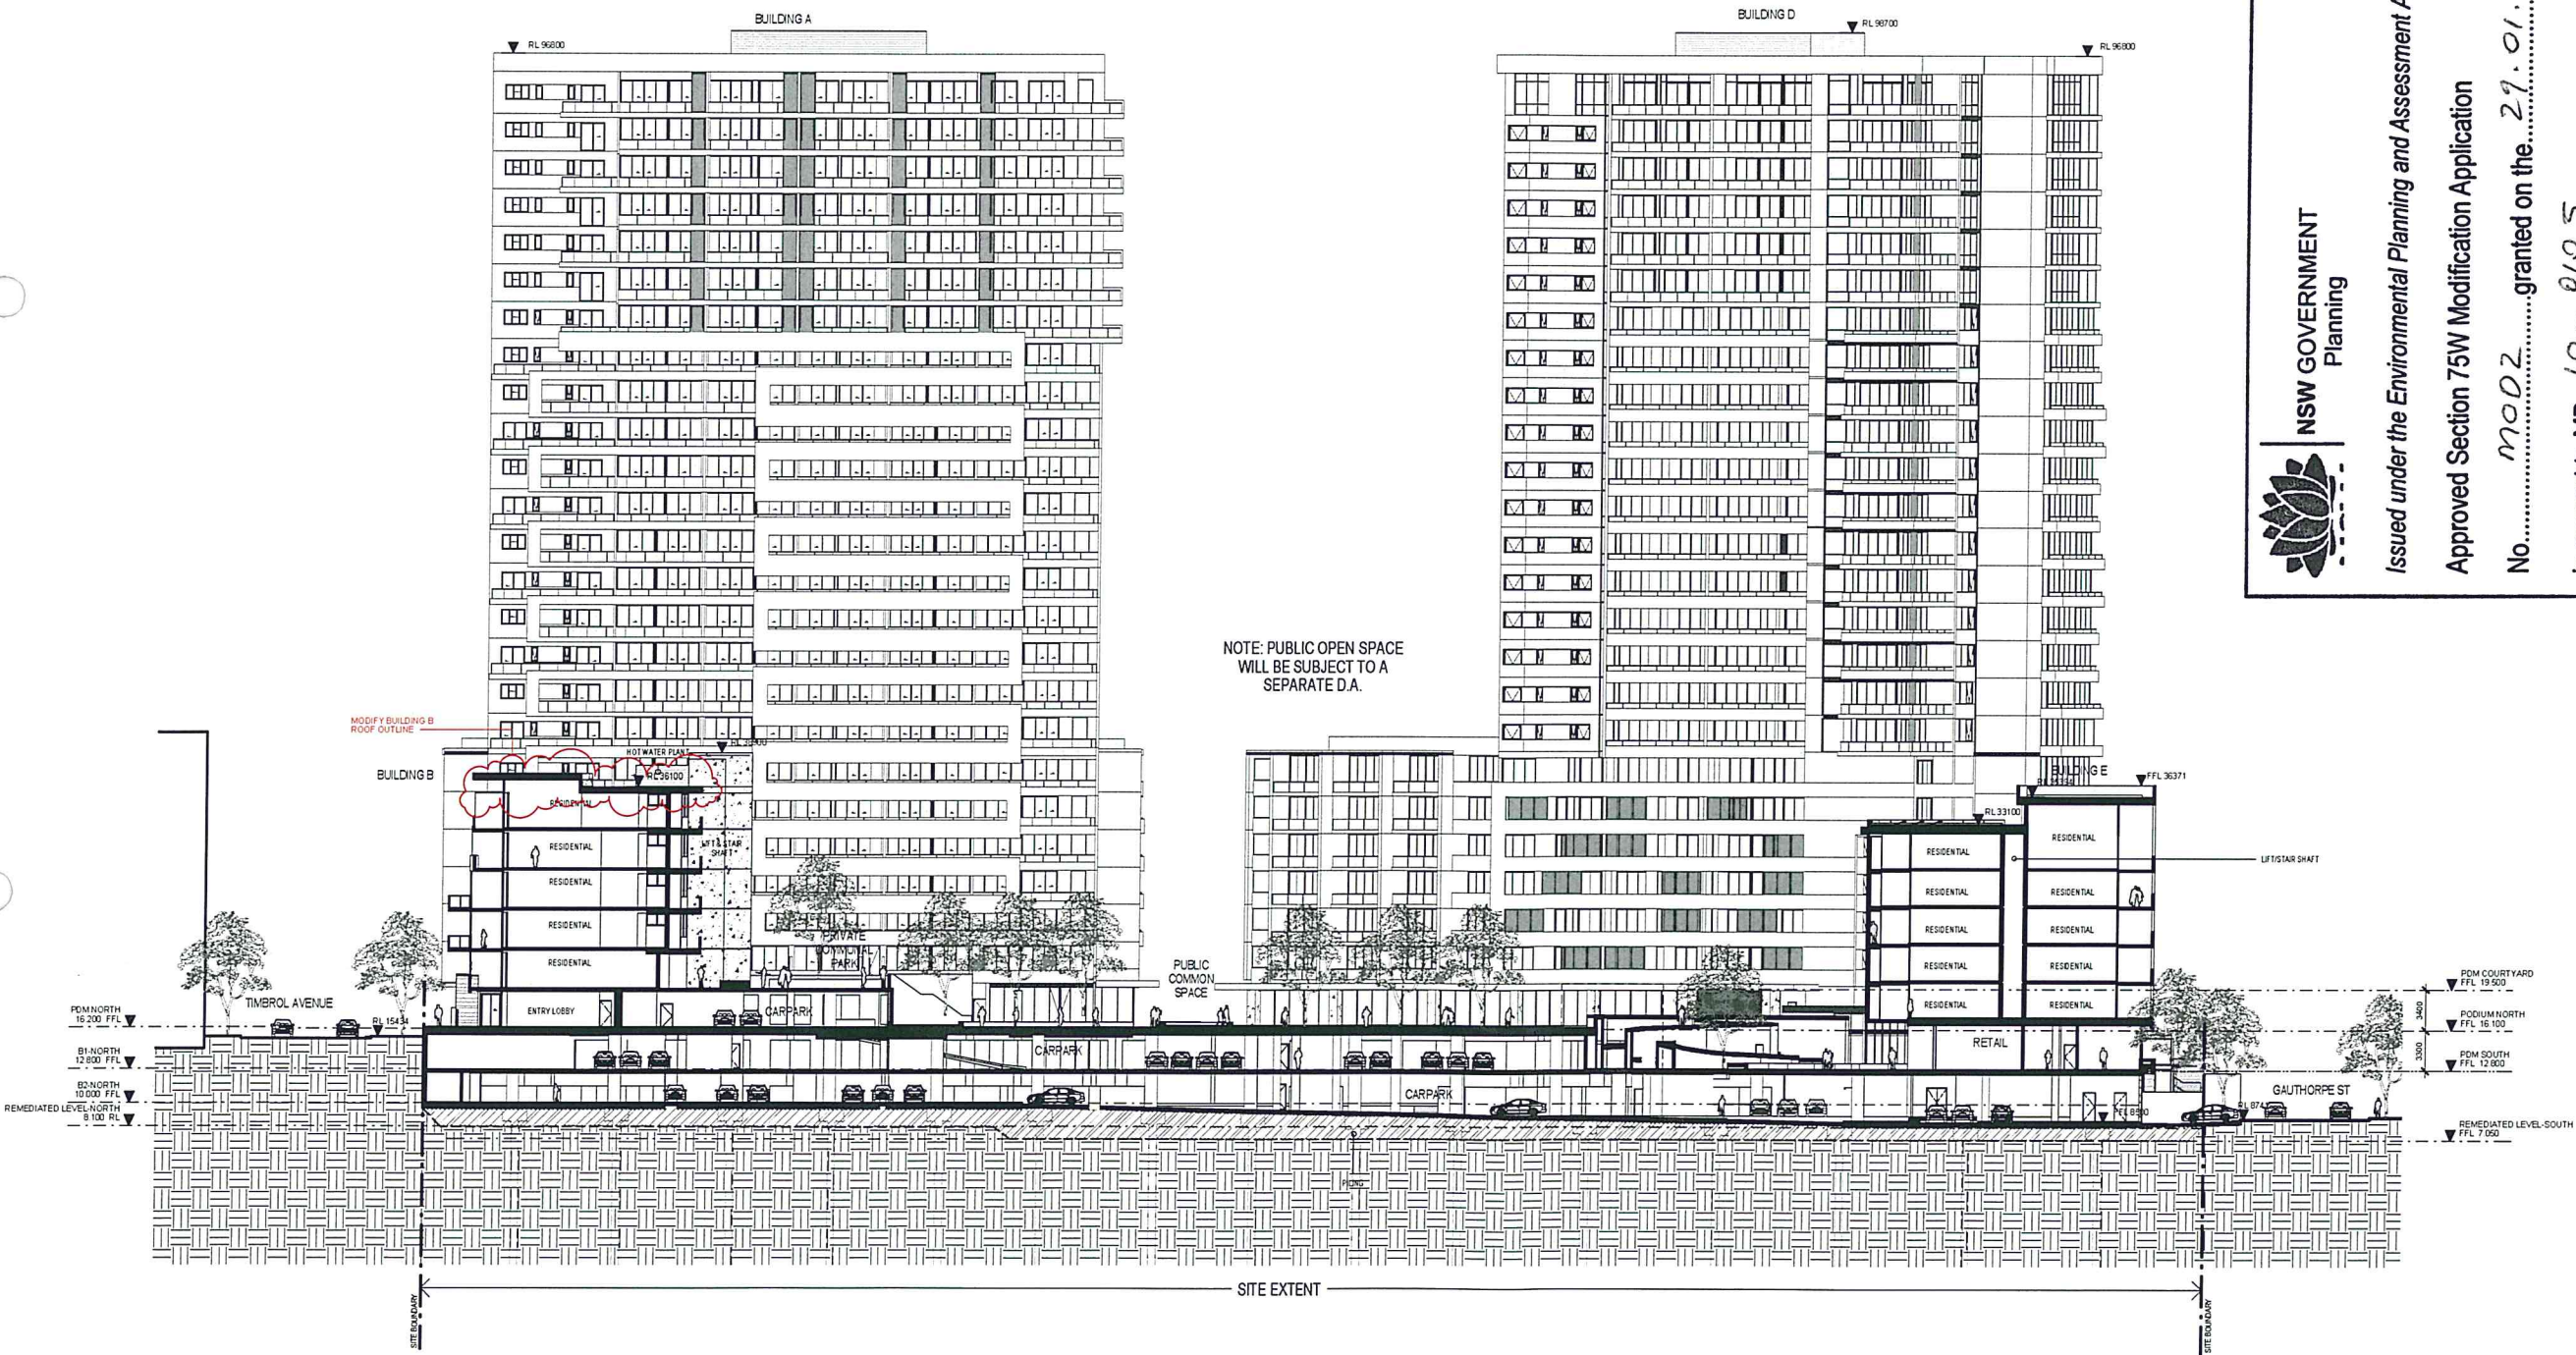

1 SECTION
A-5001 North-South Site Section 1:250

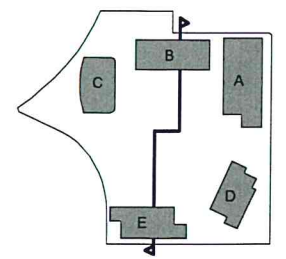

Client

Project

STAGE 2A + 3A
WALKER ST.
RHODES
for
Billbergia Developments

Drawing Name

North-South Site
Section

Date	Scale	Sheet Size
22.10.2012	1 : 250	@ B1
Reg No.	Drawn	Chk
	JT	JP
Job No.	Drawing No.	Revision
4410	A-0601	A-5

SJB Architects
Level 2, 450 Crown St
Sydney NSW
2010 Australia
T 61 2 9390 9911
F 61 2 9390 9922
www.sjb.com.au

Nominated Architects
Adam Haddow 7108
John Peadar 7004




In accepting and using this document the recipient agrees that SJB Architects (NSW) Pty Ltd ACN 081 084 724 TIA SJB Architects, retain all copyright, design and other rights including copyright and intellectual property rights. The recipient agrees not to use this document for any purpose other than as intended and to make all claims against SJB Architects resulting from unauthorized changes, of to reuse the document on other projects without the prior written consent of SJB Architects. Under no circumstances shall transfer of this document be deemed a sale. SJB Architects makes no warranties of fitness for any purpose.

The Recipient/Contractor shall verify job dimensions prior to any work commencing. Figure dimensions shall take precedence over scale work.

S75W - FOR APPROVAL

Rev.	Date	Revision
A	12/11/2010	DA Test of Adequacy
A-1	22/02/2011	Preferred Project
A-2	16/04/2012	S75W MOD 1 - March 2012
A-3	16/07/2012	Adaptable Parking
A-4	24/08/2012	Adaptable Parking - 3bed to 1bed
A-5	16/10/2012	S75W MOD2 - October 2012

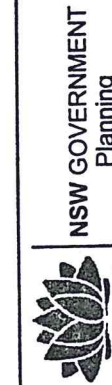

Issued under the Environmental Planning and Assessment Act 1979



Approved Section 75W Modification Application

No. MOD2 granted on the 29.01.13

in respect to MP 10-0105

Signed SJB

Sheet No. 19 of 19

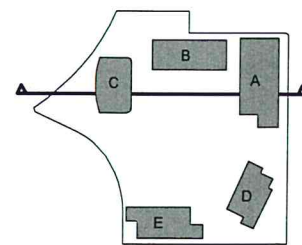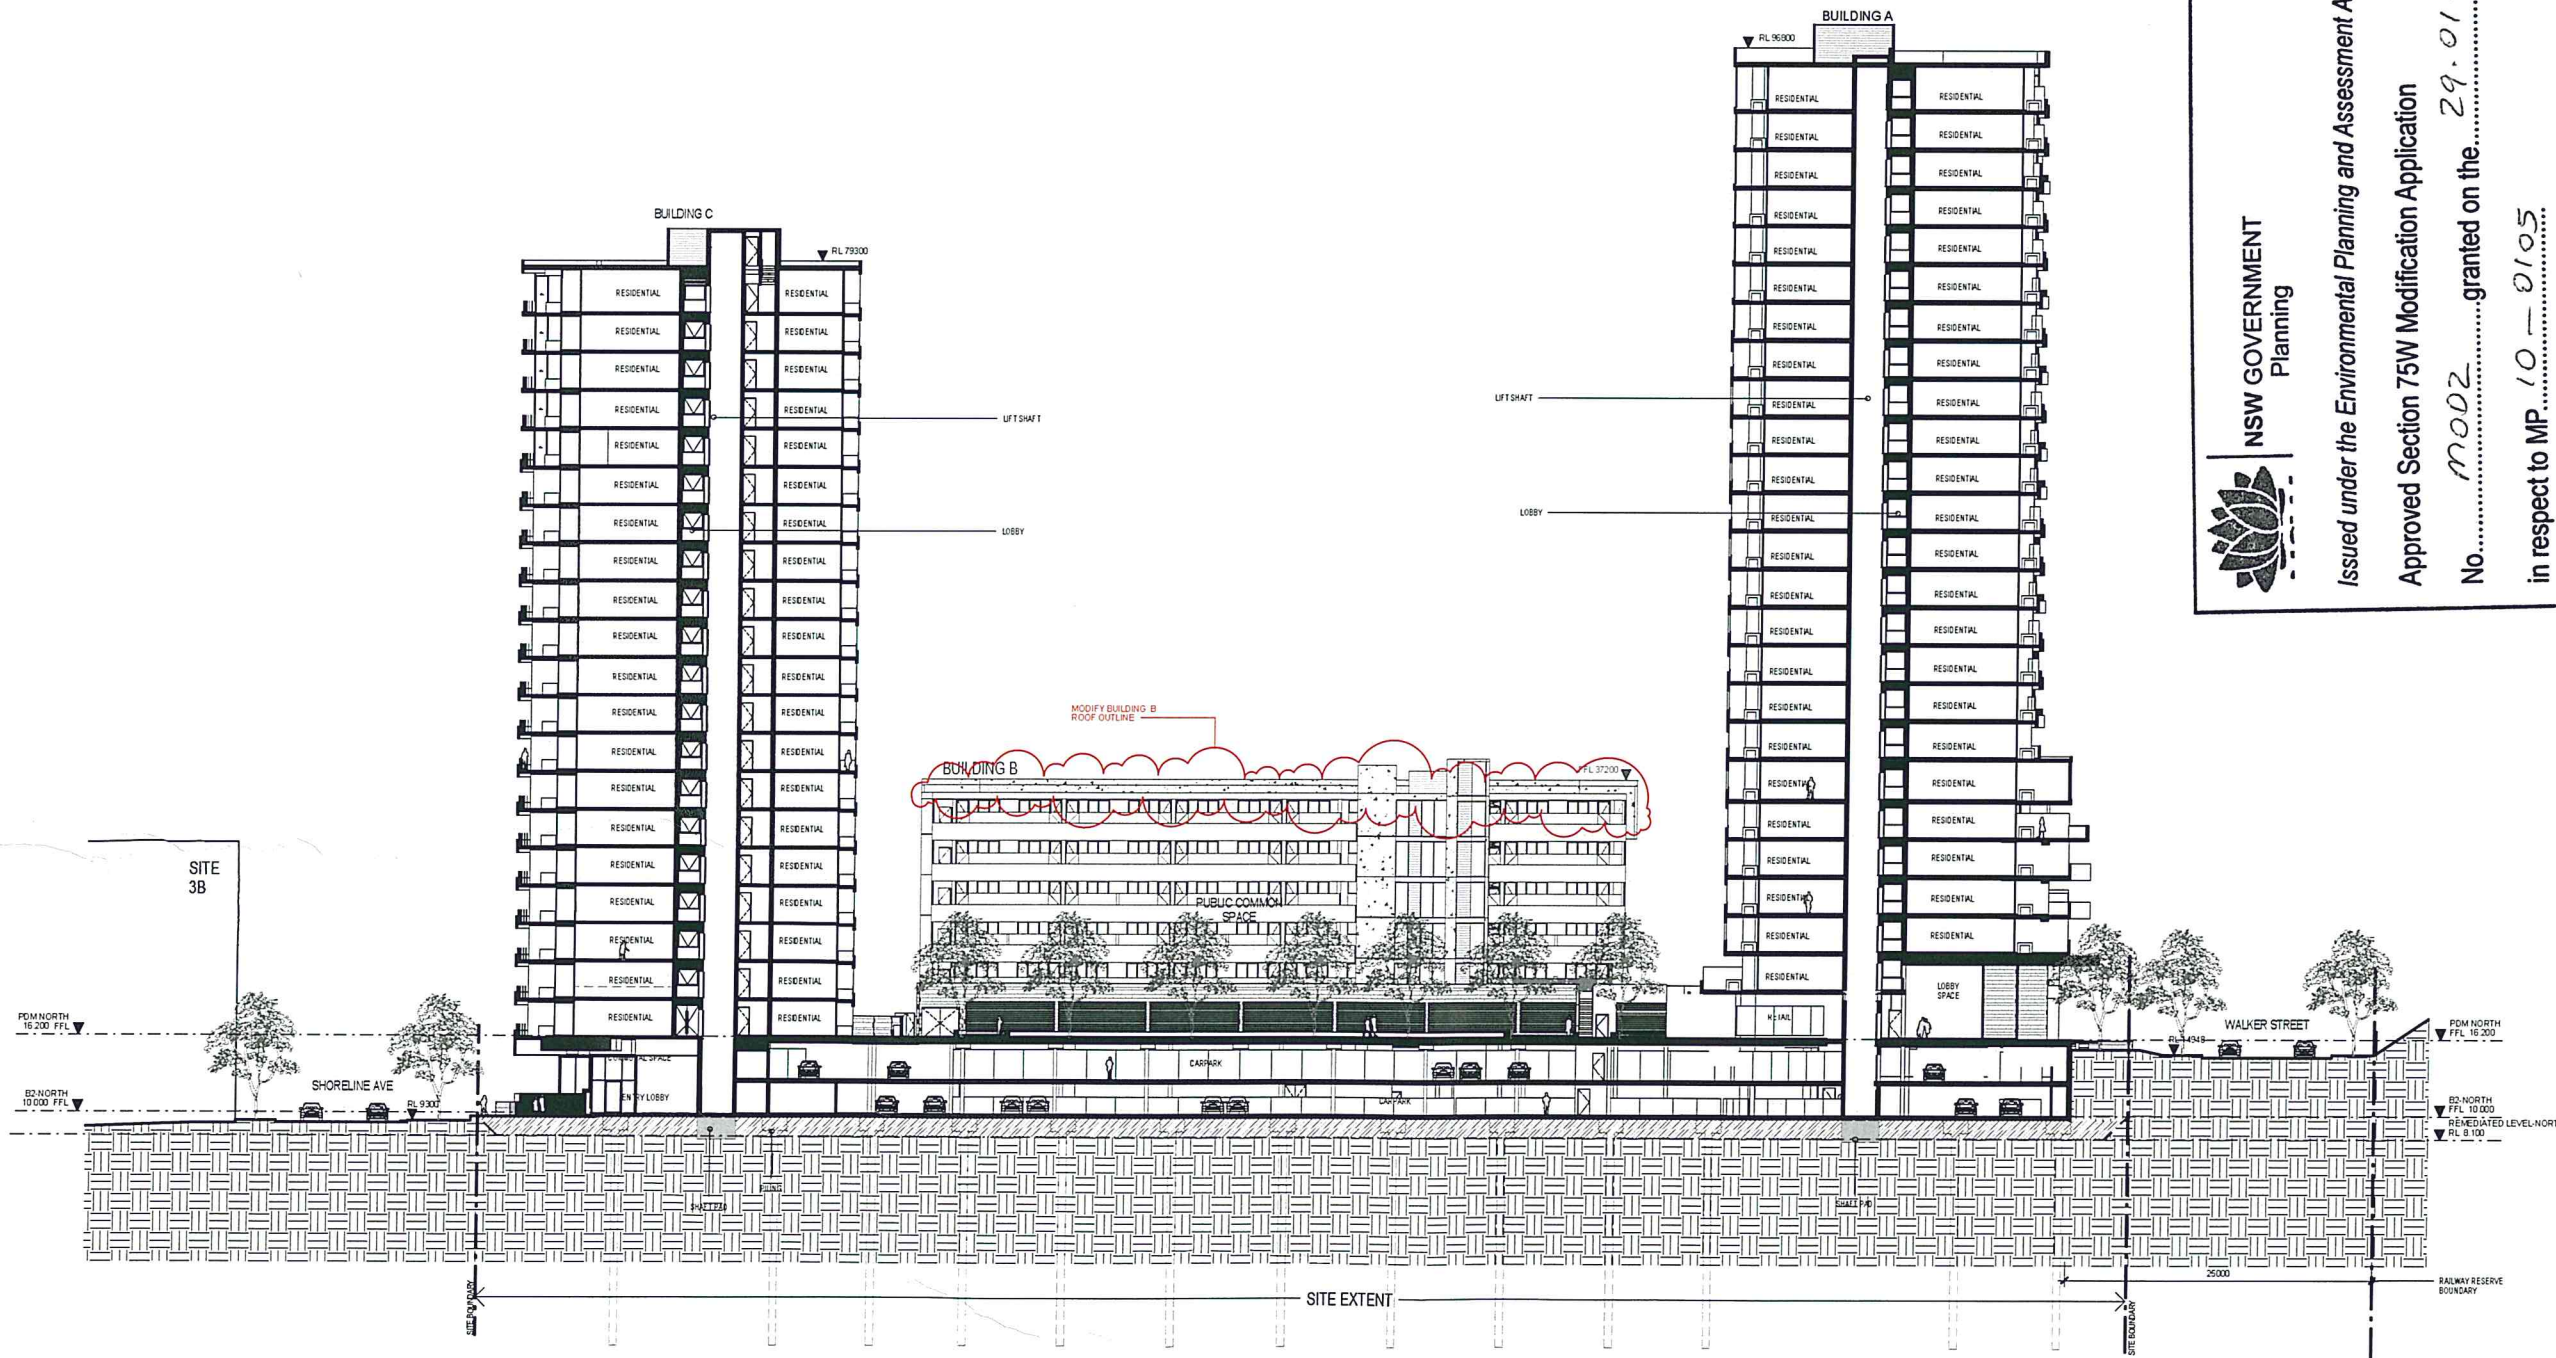

Project
STAGE 2A + 3A
WALKER ST.
RHODES
for
Billbergia Developments

Drawing Name
East-West Site
Section

Date	Scale	Sheet Size
22.10.2012	1 : 250	@ B1
Reg No.	Drawn	Chk.
	JT	JP
Job No.	Drawing No.	Revision
4410	A-0602	A-5

SJB Architects
Level 2, 400 Crown St
Sunny Hills NSW
2010 Australia
T 61 2 9390 9911
F 61 2 9390 9922
www.sjb.com.au

Nominated Architects
Adam Haddow 7188
John Peadar 7204



1 SECTION
A-5001 East-West Site Section 1:250