


EXTERNAL FINISHES	
CONCRETE	
CN1	Concrete natural finish
CR1	Concrete render finish
RF1	Roof Finish - Grand
MASONRY	
PF1	Texture applied finish - White
PF2	Texture applied finish - Light Warm Grey
PF3	Texture applied finish - Dark Grey
ST1	Stone cladding - Stacked grey colour
ST2	Stone cladding - Sandstone Finish
GLAZING	
GL1	Clear Glass Windows
GL2	Lowiron Clear Glass Windows
GL3	Obscure Glazing Balustrade
GL4	Feature Coloured Glass
GB1	Clear glass balustrade with Metal handrail
WG	Wintergarden
METALWORKS	
MB1	Metal Balustrade - Steel Galvanised
MF1	Metal Finish - Window + Door Frames
MF2	Metal Finish - Shading blades
MF3	Metal Finish - Louvre screen
MS1	Metal Finish - Plant Screening
MS2	Metal Finish - Screen to apartment entries
MS3	Aluminum Panel
TIMBER	
TC1	External cladding - Timber Boards
TB1	Timber Floor Boards - Natural Stain

NOTE: AS BUILT LEVELS MAY VARY +/- 30mm FROM NOTIMINATED SSL's

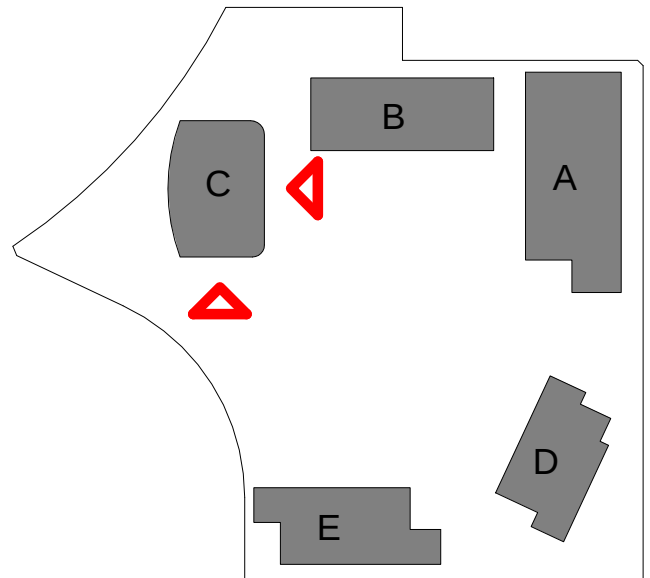


Project
**STAGE 2A + 3A
WALKER ST.
RHODES**
for
Billbergia Developments

Drawing Name
**Elevations - BLDG C
East & West**

Date	Scale	Sheet Size
28/06/2013	1 : 200	@ B1
Reg No.	Drawn	Chk.
	ML	JP
Job No.	Drawing No.	Revision

4410 A-0507 MOD 3

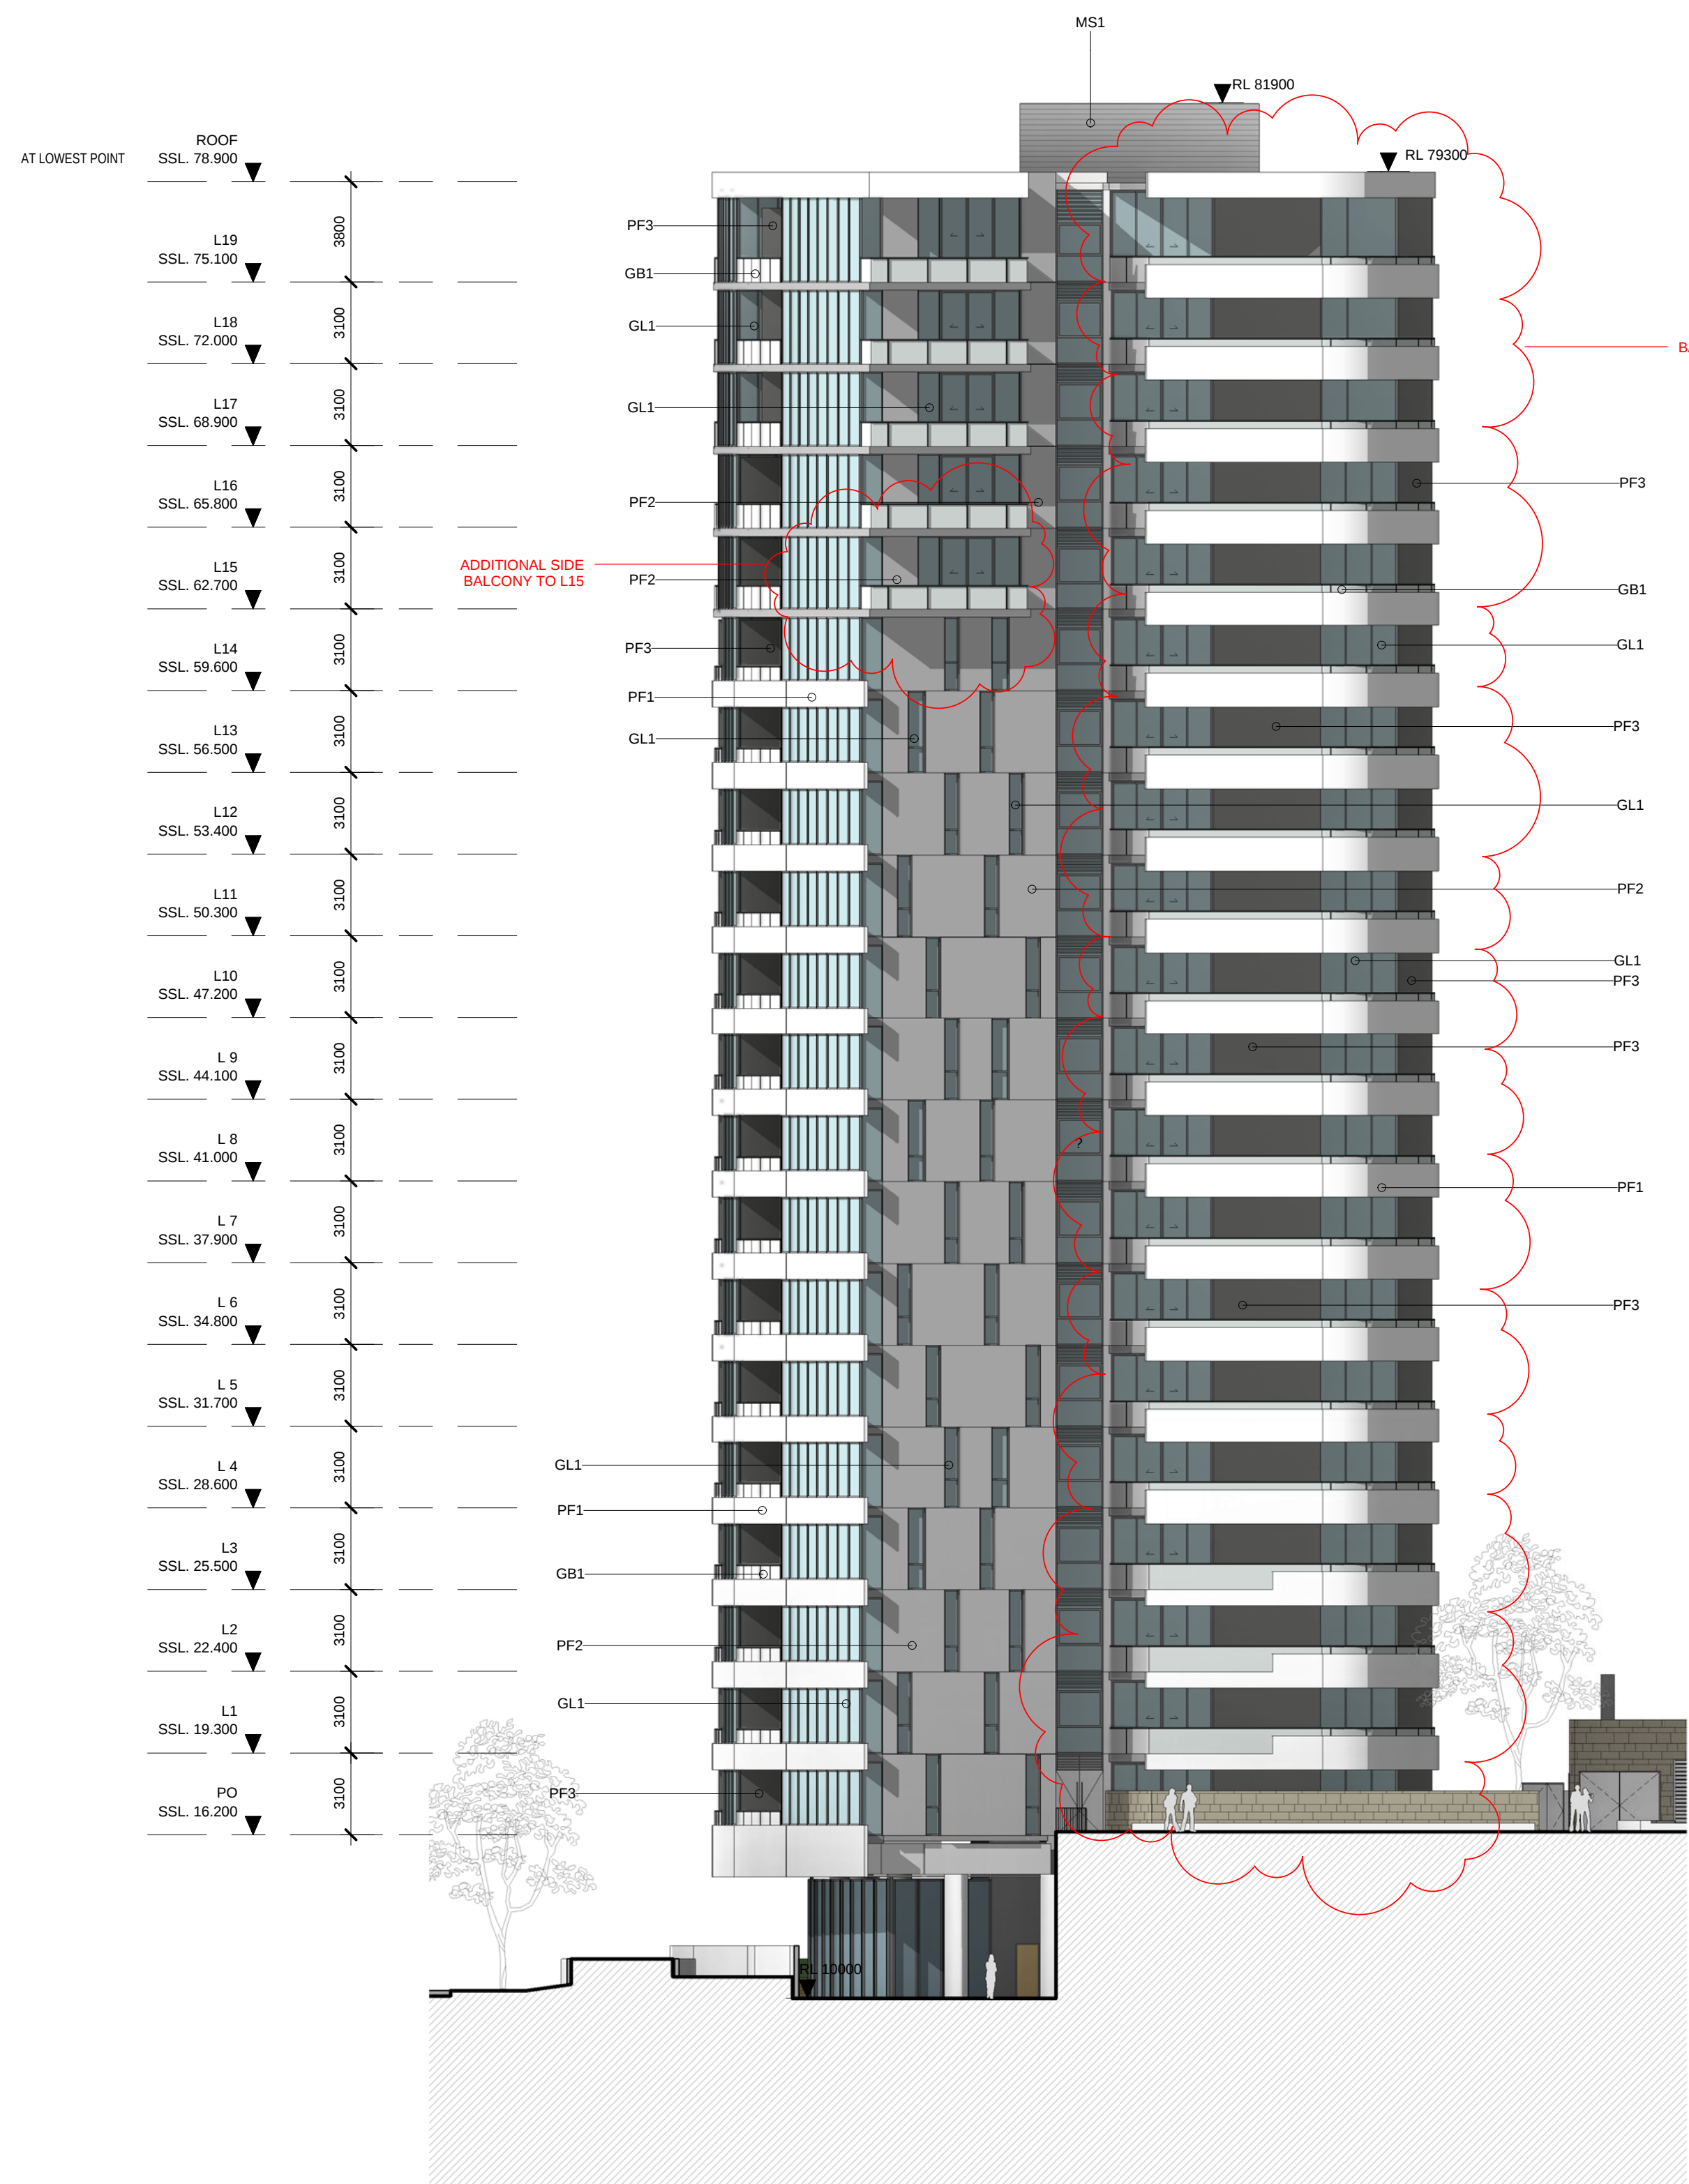

2 ELEVATION
BLDG C - SOUTH
1:200



1 ELEVATION
BLDG C - EAST
1:200