

In accepting and utilising this document the recipient agrees that SJB Architects (NSW) Pty. Ltd. ACN 081 094 724 T/A SJB Architects, retain all common law, statutory law and other rights including copyright and intellectual property rights. The recipient agrees not to use this document for any purpose other than its intended use, to waive all claims against SJB Architects resulting from unauthorised changes, or to reuse the document on other projects without the prior written consent of SJB Architects. Under no circumstances shall transfer of this document be deemed a sale. SJB Architects makes no warranties of fitness for any purpose.




The Builder/Contractor shall verify job dimensions prior to any work commencing. Figured dimensions shall take precedence over scaled work.

FOR APPROVAL		
Rev.	Date	Revision
A	12/11/2010	DA Test of Adequacy
A-1	22/02/2011	Preferred Project
A-2	15/04/2012	S75W MOD 1 - March 2012
A-3	16/07/2012	Adaptable Parking
A-4	24/08/2012	Adaptable Parking - 3bed to 1bed
A-5	16/10/2012	S75W MOD 2 - October 2012
MOD 3	21/06/2013	S75W MOD 3 - June 2013
MOD 4	10/03/2014	S75W MOD 4 - March 2014
MOD 5	16/05/2014	S75W MOD 5 - May 2014

**EXTERNAL FINISHES**

CONCRETE	
CN1	Concrete natural finish
CR1	Concrete render finish
RF1	Roof Finish - Gravel
MASONRY	
PF1	Texture applied finish - White
PF2	Texture applied finish - Light Warm Grey
PF3	Texture applied finish - Dark Grey
ST1	Stone cladding - Stacked grey colour
ST2	Stone cladding - Sandstone Finish
GLAZING	
GL1	Clear Glass Windows
GL2	Louvered Clear Glass Windows
GL3	Obscure Glazing Balustrade
GL4	Feature Coloured Glass
GB1	Clear glass balustrade with metal handrail Wintergarden
METALWORKS	
MB1	Metal balustrade - Steel Galvanneal
MF1	Metal Finish - Window + Door Frames
MF2	Metal Finish - Shading blades
MF3	Metal Finish - Louvre screen
MS1	Metal Finish - Plant Screening
MS2	Metal Finish - Screen to apartment entries
MS3	Aluminium Panel
TIMBER	
TC1	External cladding - Timber Boards
TB1	Timber Floor Boards - Natural Stain

NOTE: AS BUILT LEVELS MAY VARY +/- 30mm FROM NOTIMATED SSLs

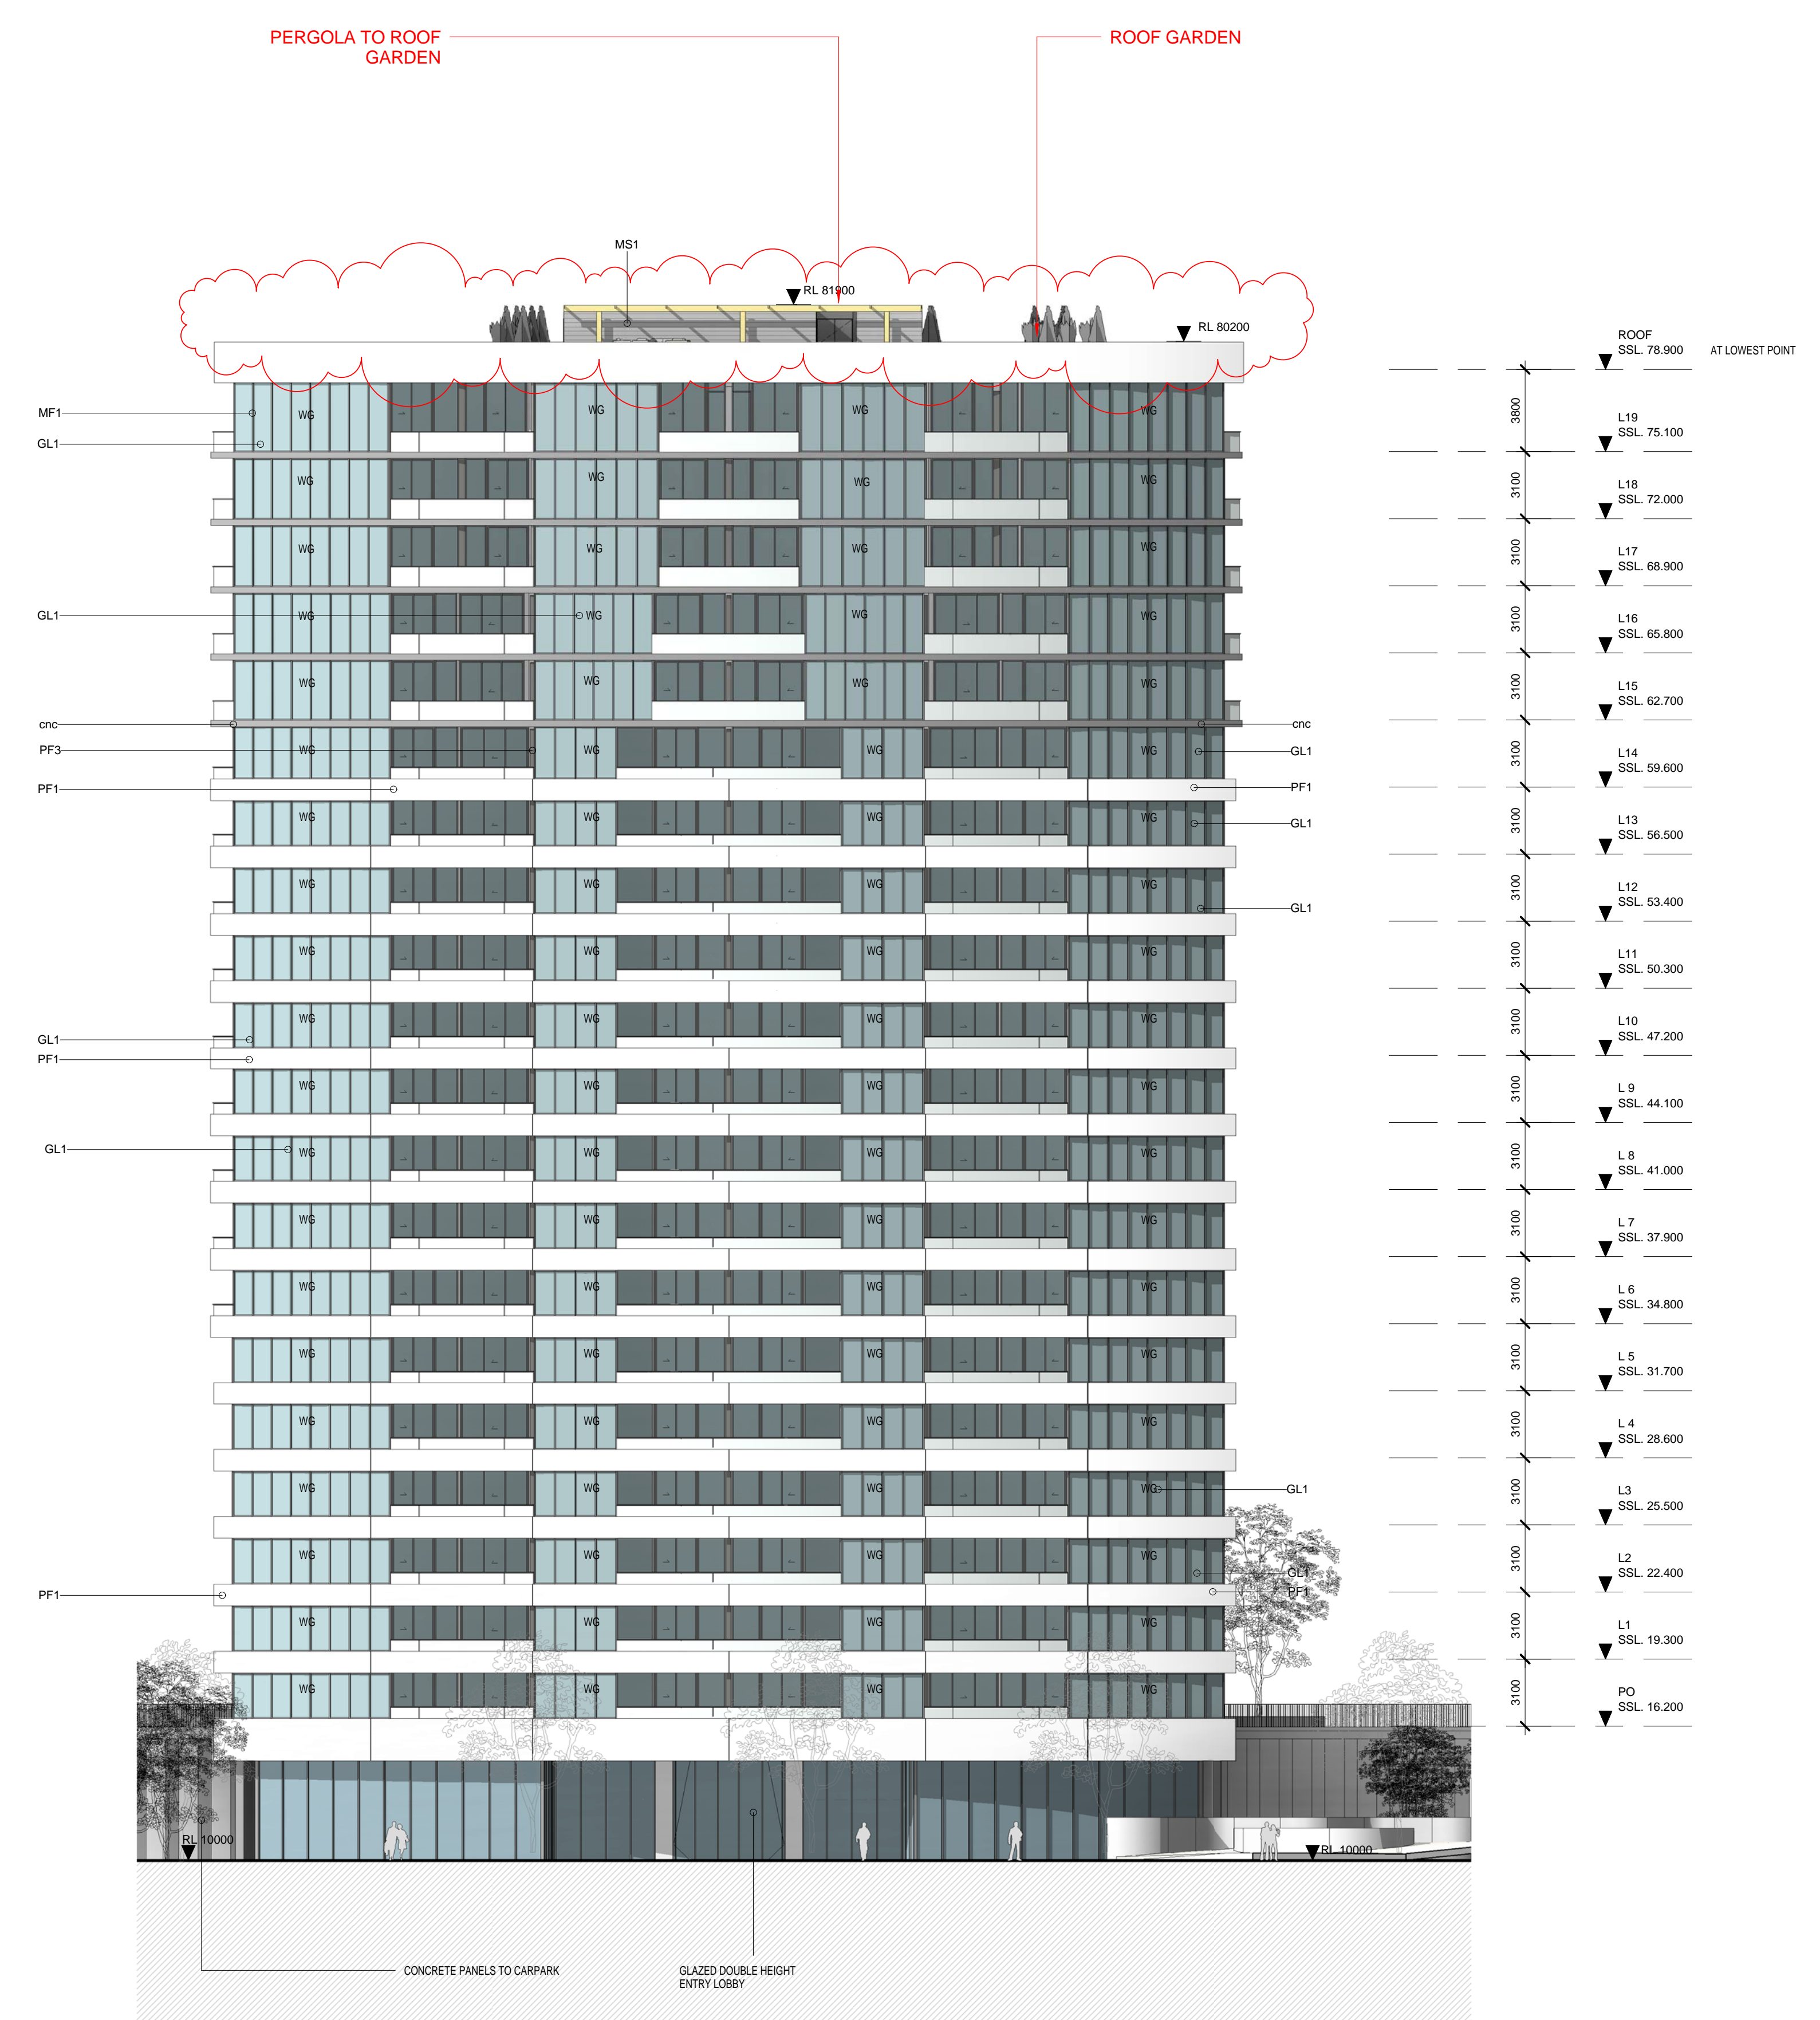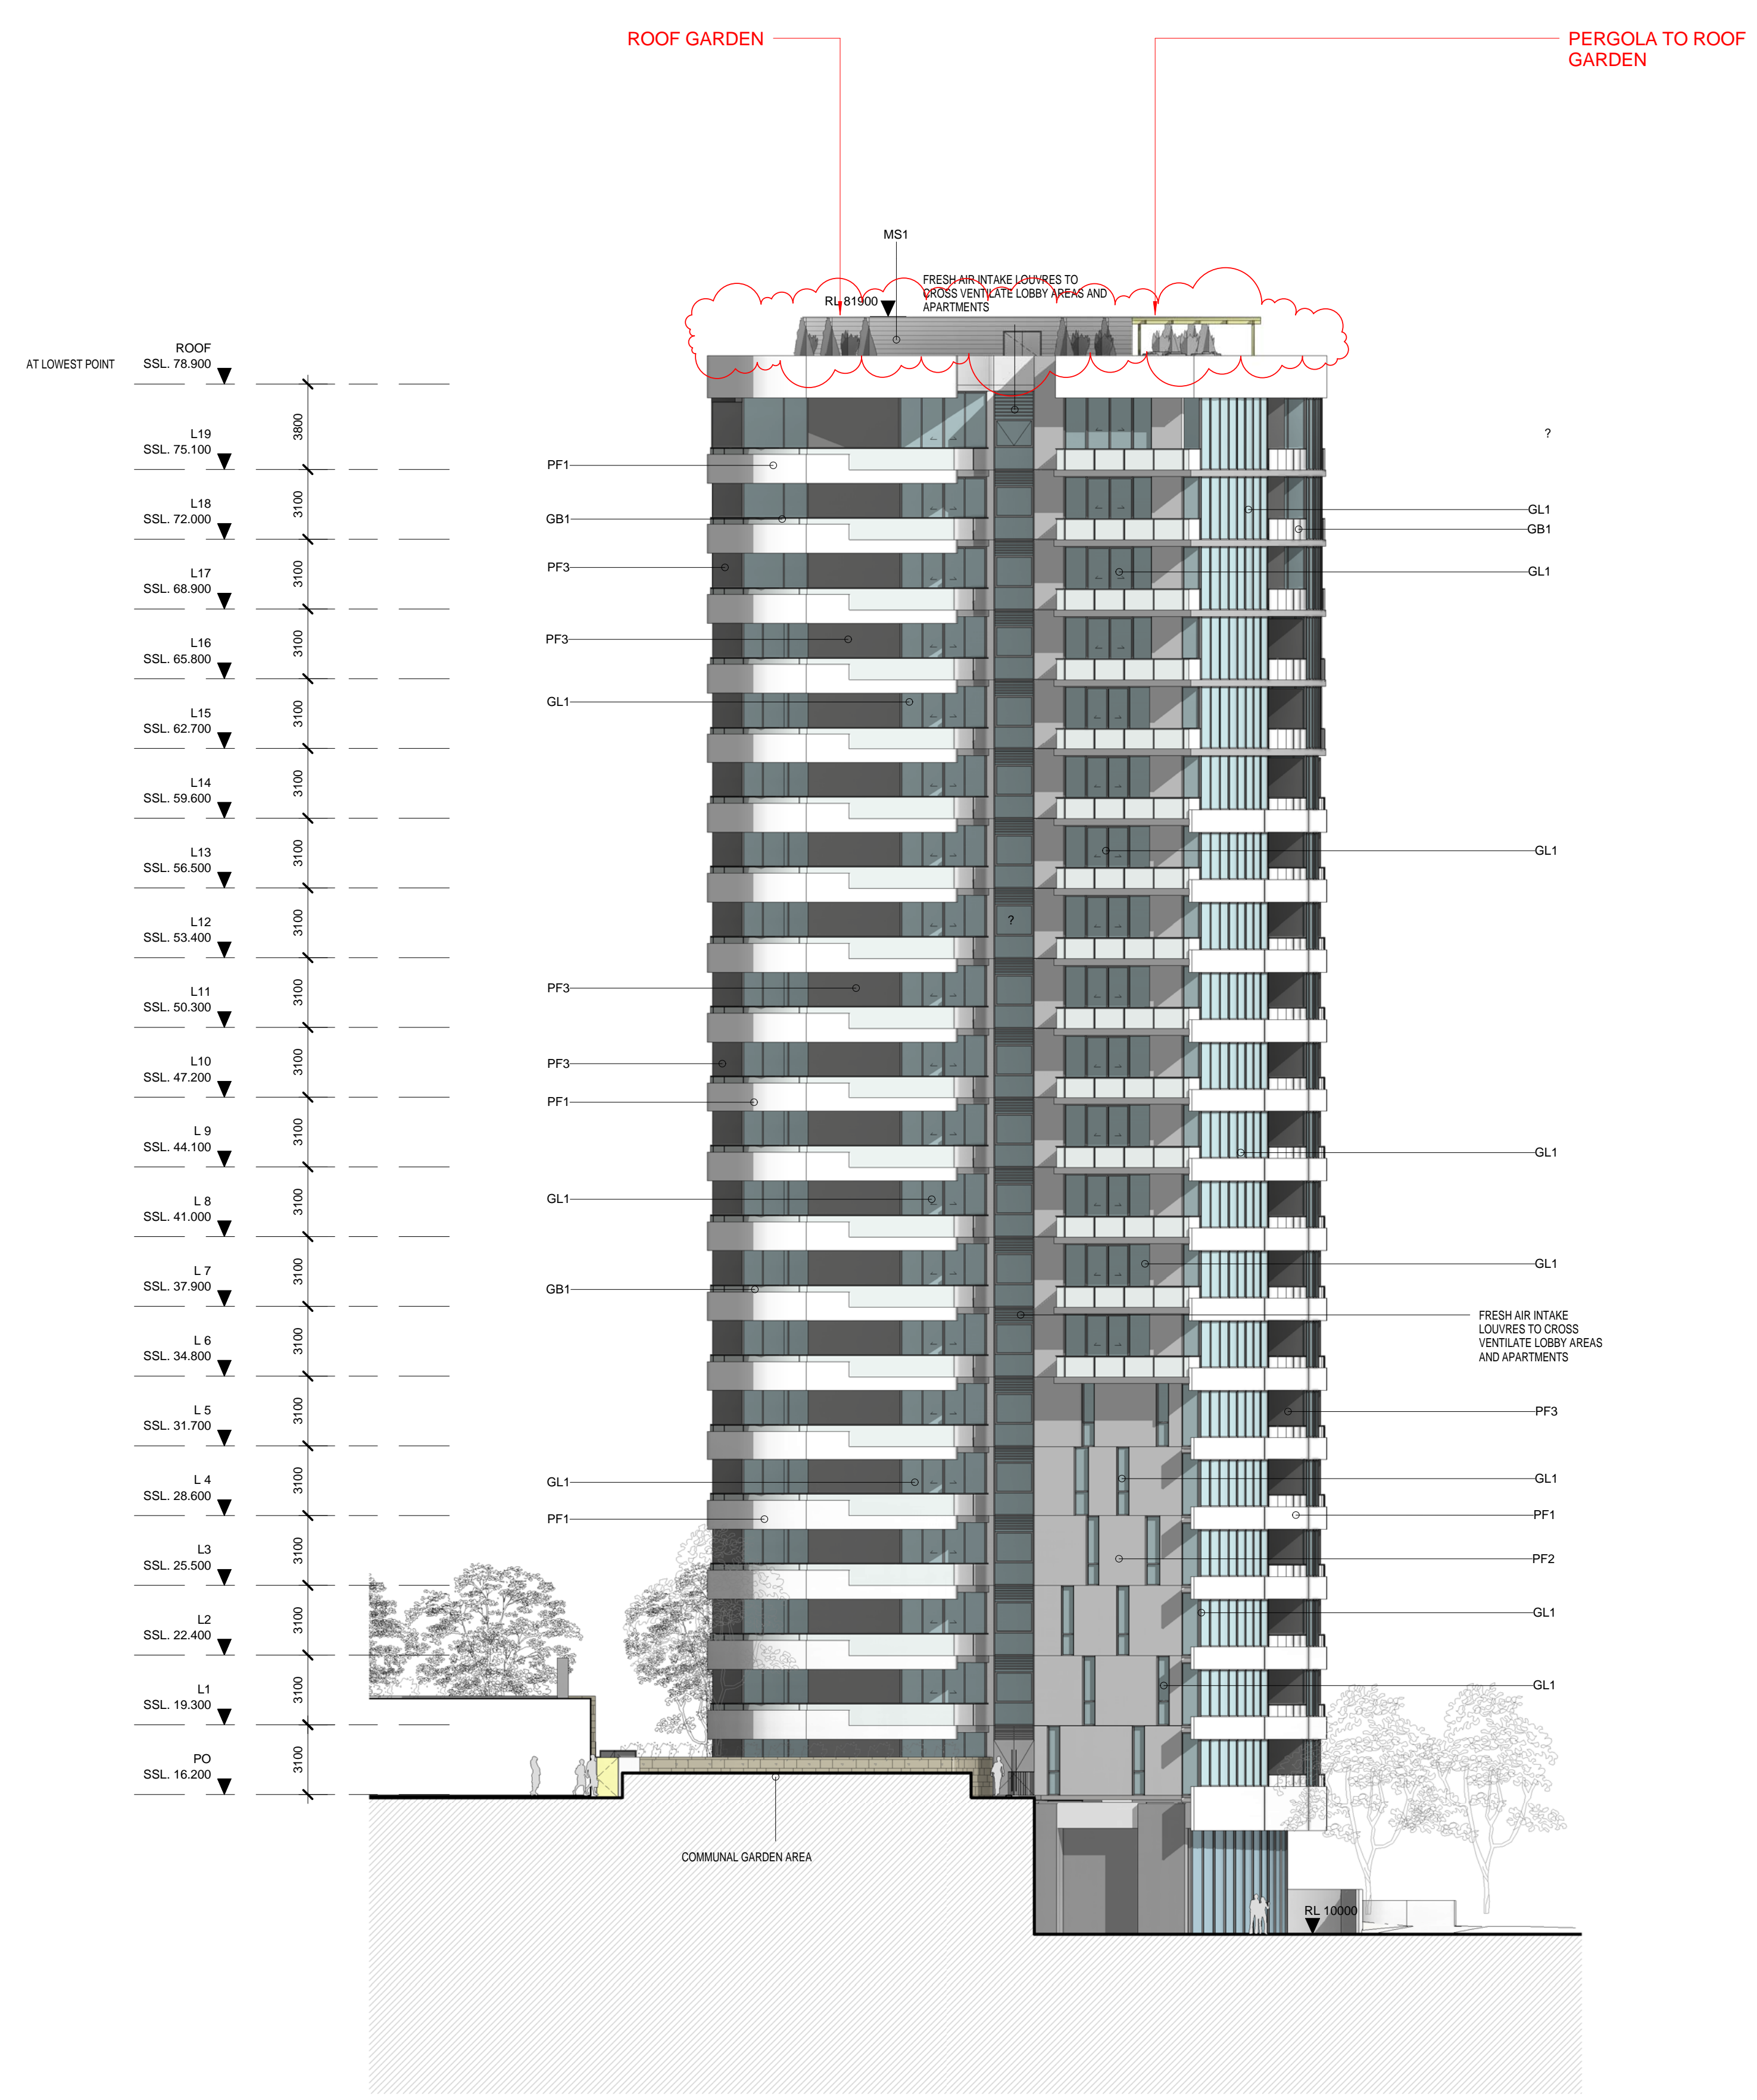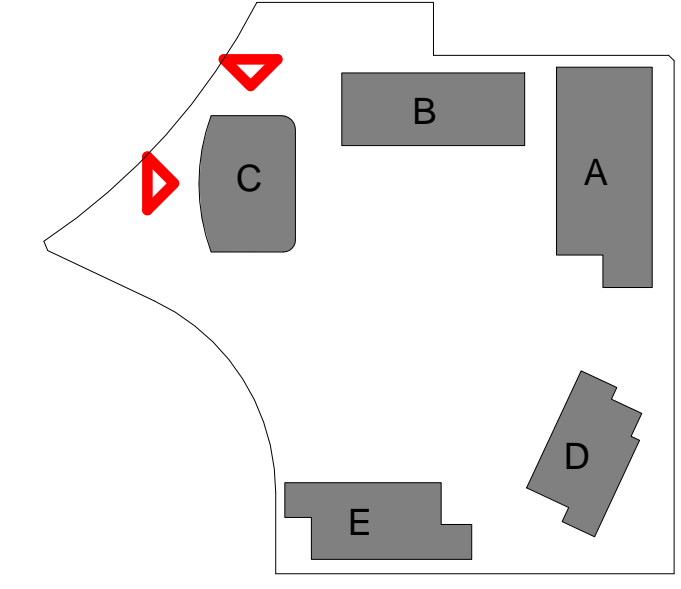

**1 ELEVATION**  
BLDG C - NORTH  
1 : 200

**3 ELEVATION**  
BLDG C - WEST  
1 : 200



Client  
Project  
**STAGE 2A + 3A**  
**WALKER ST.**  
**RHODES**  
for  
Billbergia Developments

Drawing Name  
**Elevations - BLDG C**  
**North & South**

Date  
**16/05/2014**

Scale  
**1 : 200**

Sheet Size  
**@ B1**

Reg No.  
**ML**

Drawn  
**JP**

Job No.  
**4410**

Drawing No.  
**A-0506**

Revision  
**MOD 5**

SJB Architects  
Level 2, 490 Crown St  
Surry Hills NSW  
2010 Australia  
T 61 2 9380 9911  
F 61 2 9380 9922  
www.sjb.com.au  
Nominated Architects  
Adam Haddock 7188  
John Pradel 7004

