



Shelmerdines
Consulting Engineers

**ELECTRICAL AND COMMUNICATIONS
INFRASTRUCTURE REPORT**

for

**RIVERWOOD NORTH
RESIDENTIAL RENEWAL PROJECT**

Prepared by:

SHELMERDINES

Consulting Engineers

ABN 40 003 331 879

55 Hume Street

Crows Nest NSW 2065

Telephone: 02 9436 3021

Facsimile: 02 9439 8709

Email: mail@shelmerdines.com.au

17 December 2010
Job No. 5659E

ELECTRICAL SUPPLY

The electrical infrastructure will require to be upgraded and relocated to meet the maximum demand of the development.

The electrical maximum demand for the development is 3,350kVA which is broken up as follows:-

<u>Phase</u>	<u>No. Units</u>	<u>Stage</u>	<u>Max Demand</u>
Phase 01	68 Units	Stage 01	345kVA
Phase 01	55 Units	Stage 01	280kVA
Phase 01	27 Units	Stage 02	140kVA
Phase 02	177 Units	Stage 01	895kVA
Phase 02	159 Units	Stage 02 and 03	805kVA
Phase 02	175 Units	Stage 04	885kVA
TOTAL			3,350kVA

Initial advice from the Supply Authority, Energy Australia, suggests that the existing substations located within the development will need to be decommissioned and upgraded. The existing Riverwood zone substation and high voltage network is near full capacity.

The existing high voltage network will need to be upgraded to meet the expected electrical load for the development. All new infrastructure for the development is proposed to be underground. It is proposed that the development be served from four padmount substations located within the development adjacent to the buildings.

The above will require confirmation with Energy Australia from our formal application for the new supply.

STREET LIGHTING

New street lighting will be provided and installed to Energy Australia street lighting network standards. All cabling to the proposed street lighting fixtures will be installed underground in dedicated service trenches. The new street lighting fixtures will be chosen to suit the architectural detail of the development.

COMMUNICATION SERVICES

Telephone and Internet

The existing communications cable infrastructure in the existing road system within the development area is providing both telephone and internet services to the existing residential buildings. These services will need to be decommissioned and removed.

It is proposed that multiple underground communications conduits and pit systems be installed throughout the development. The multiple conduit and pit system will allow for the future installation of both copper communications cables and optical fibre communications cables from the available Network Carriers and Service Providers.

Optical Fibre Cable Network

There is an existing optical fibre cable infrastructure near the proposed development. The underground optical fibre cable infrastructure runs along the south side of Washington Avenue from Union Street – Roosevelt Street – Washington Avenue – Belmore Road.


Connection to the fibre optic network will be via the new underground communications conduit and pit system.

Pay TV

Pay TV is available via two methods, satellite dish or co-axial cable.

These two methods will be investigated during design with the relevant Service Providers.

For cable connection, the multiple conduit and pit system would be extended to each building.

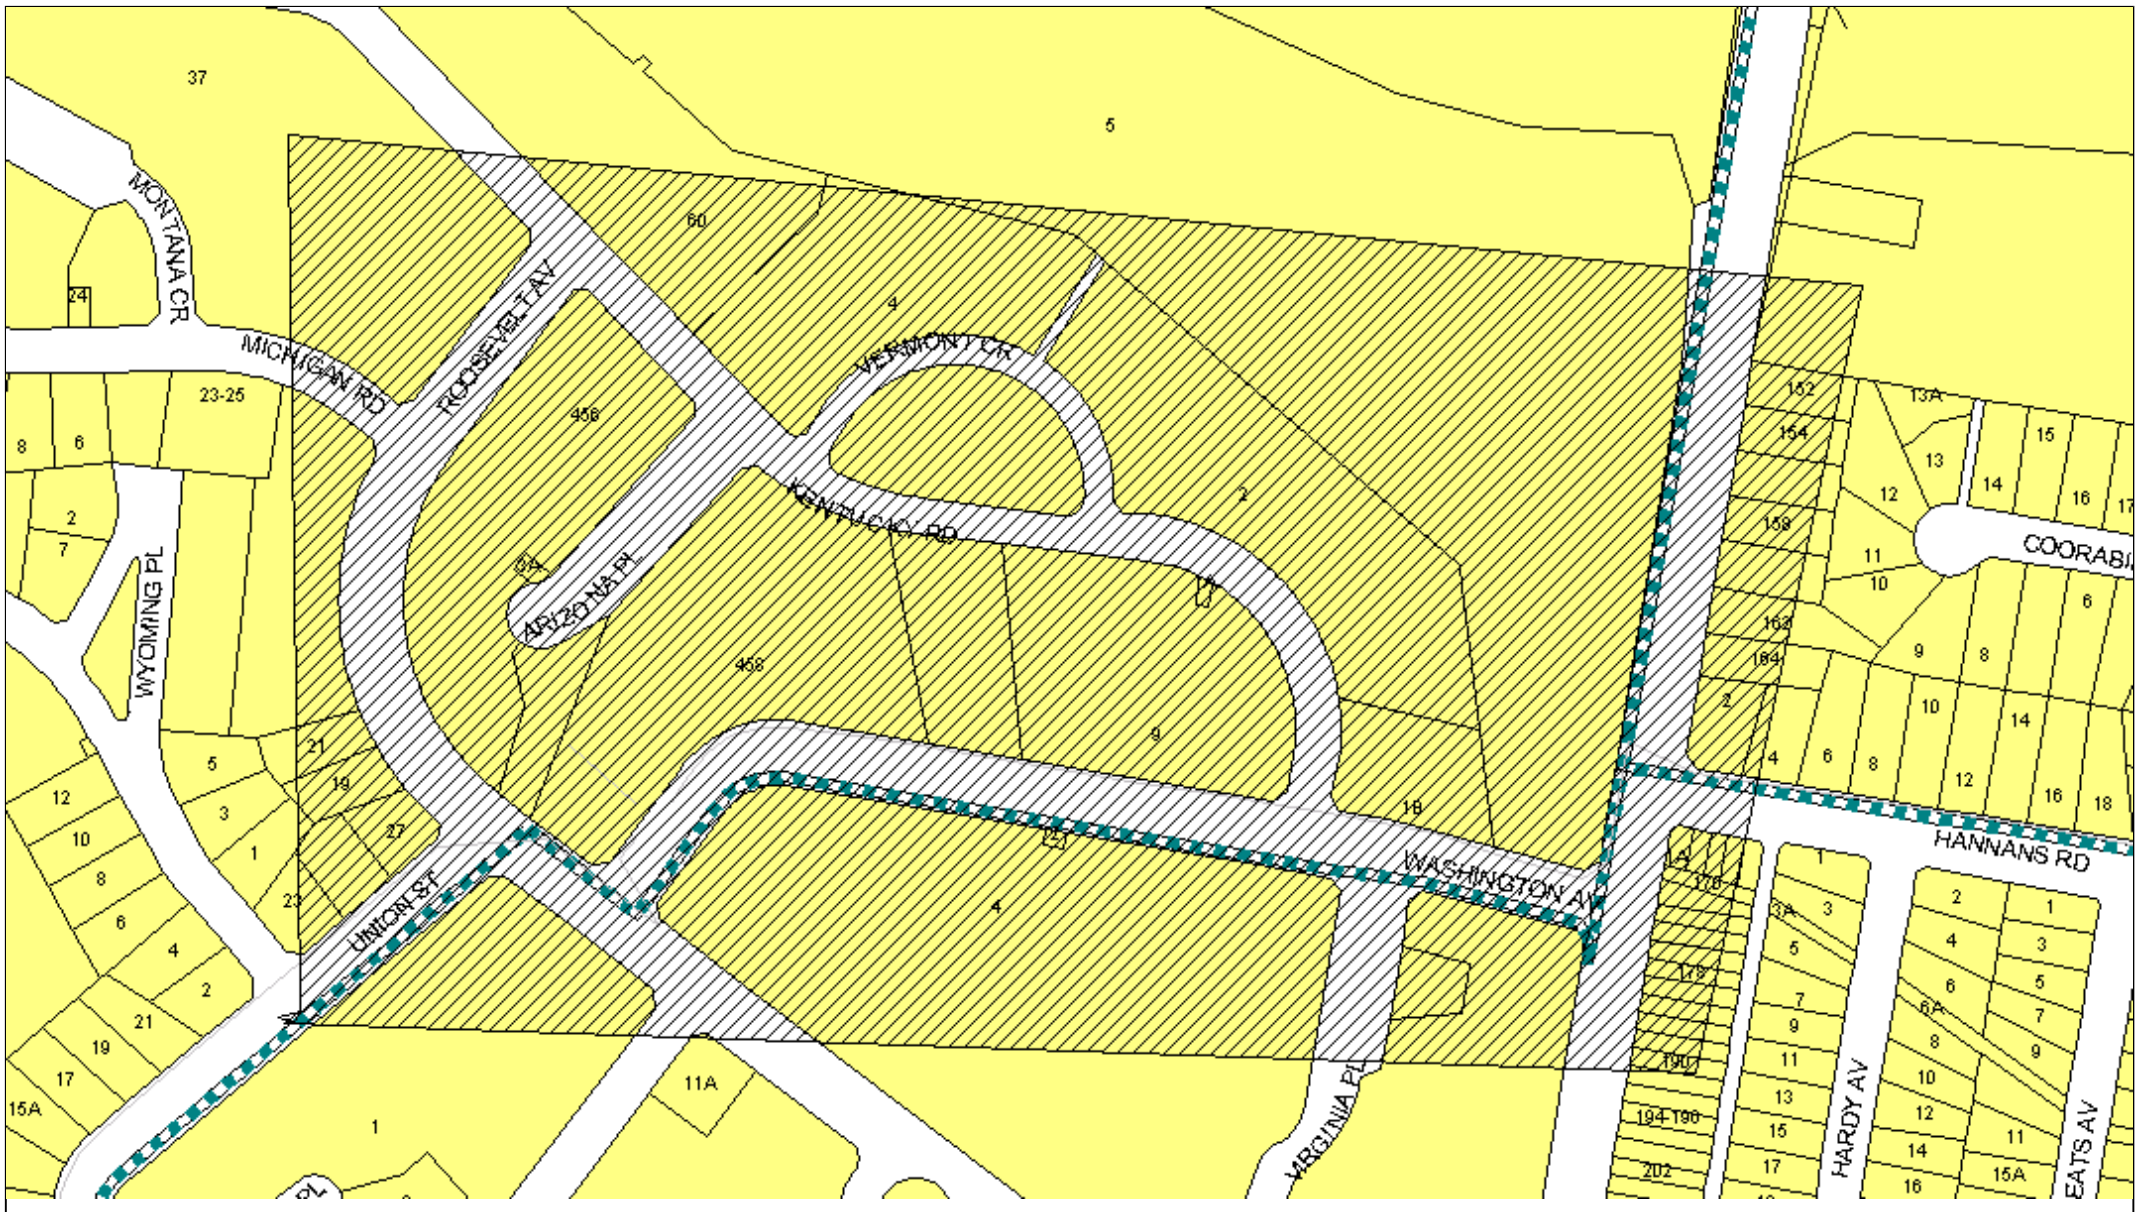

Uecomm
Cable Uecomm Underground OVERVIEW MAP
 Scale: 1 : 2500 Printed On: 29/10/2010

Sequence Number: 19873774
 Location: Washington Av



Job Location

- Line
- ⊙ Point
- Area

Underground Asset


- Uecomm

This document is confidential and may also be privileged, and neight confidentiality nor privileged is waived lost or destroyed by virtue of it being transmitted to an incorrect addressee. Unauthorised use of the contents is therefore strictly prohibited. Any information contained in this document that has been extracted from our records is believed to be accurate, but no responsibility is assumed for any error or omission.




DRAWING NOT TO SCALE


- LEGEND**
- - ELECTRICITY POLE
 - - FIBRE OPTIC CABLE
 - - - - CABLE CONDUIT (TRENCHING)
 - - - - CABLE CONDUIT (BORE TUNNELLING)
 - - UE P2 PIT
 - - UE P5 PIT
 - - UE P6 PIT
 - - UE P8 PIT
 - - UE P9 PIT
 - ▨ - BUILDING LINE
 - BOK - BACK OF KERB
 - CL - CENTRELINE OF CONDUIT
 - TP - TURNING POINT OF CONDUIT
 - - - - FENCE LINE, FL
 - ▤ - TELSTRA MANHOLE
 - ⊙ - TELSTRA PIT
 - - OPTICAL FIBRE JOINT
 - ⊙ - JOINT LOOP (m) - POLE / UNDERGROUND
 - ⊙ - CABLE HEAD POLE
 - 0.6m - CABLE DEPTH

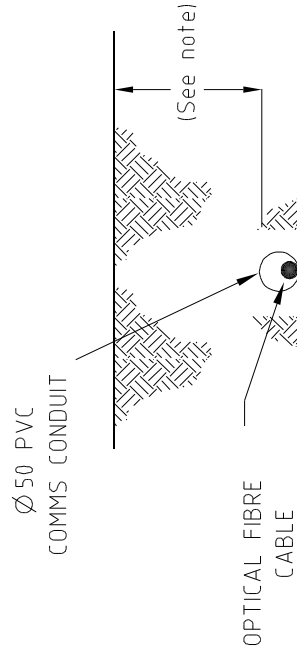


SECTION A-A
BORE

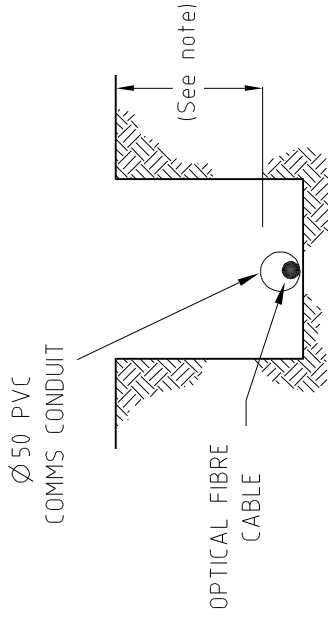

SECTION B-B
TRENCH

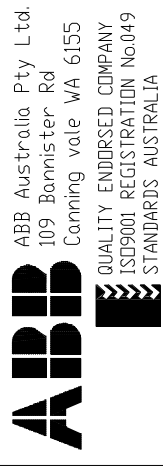

- Note:**
- Conduit depths quoted are approximate only and may change due to unforeseen circumstances.
 - In all instances it is recommended that the position of conduits & cables should be proved on site by hand, prior to commencement of works.
 - Loop in all pits unless otherwise stated.

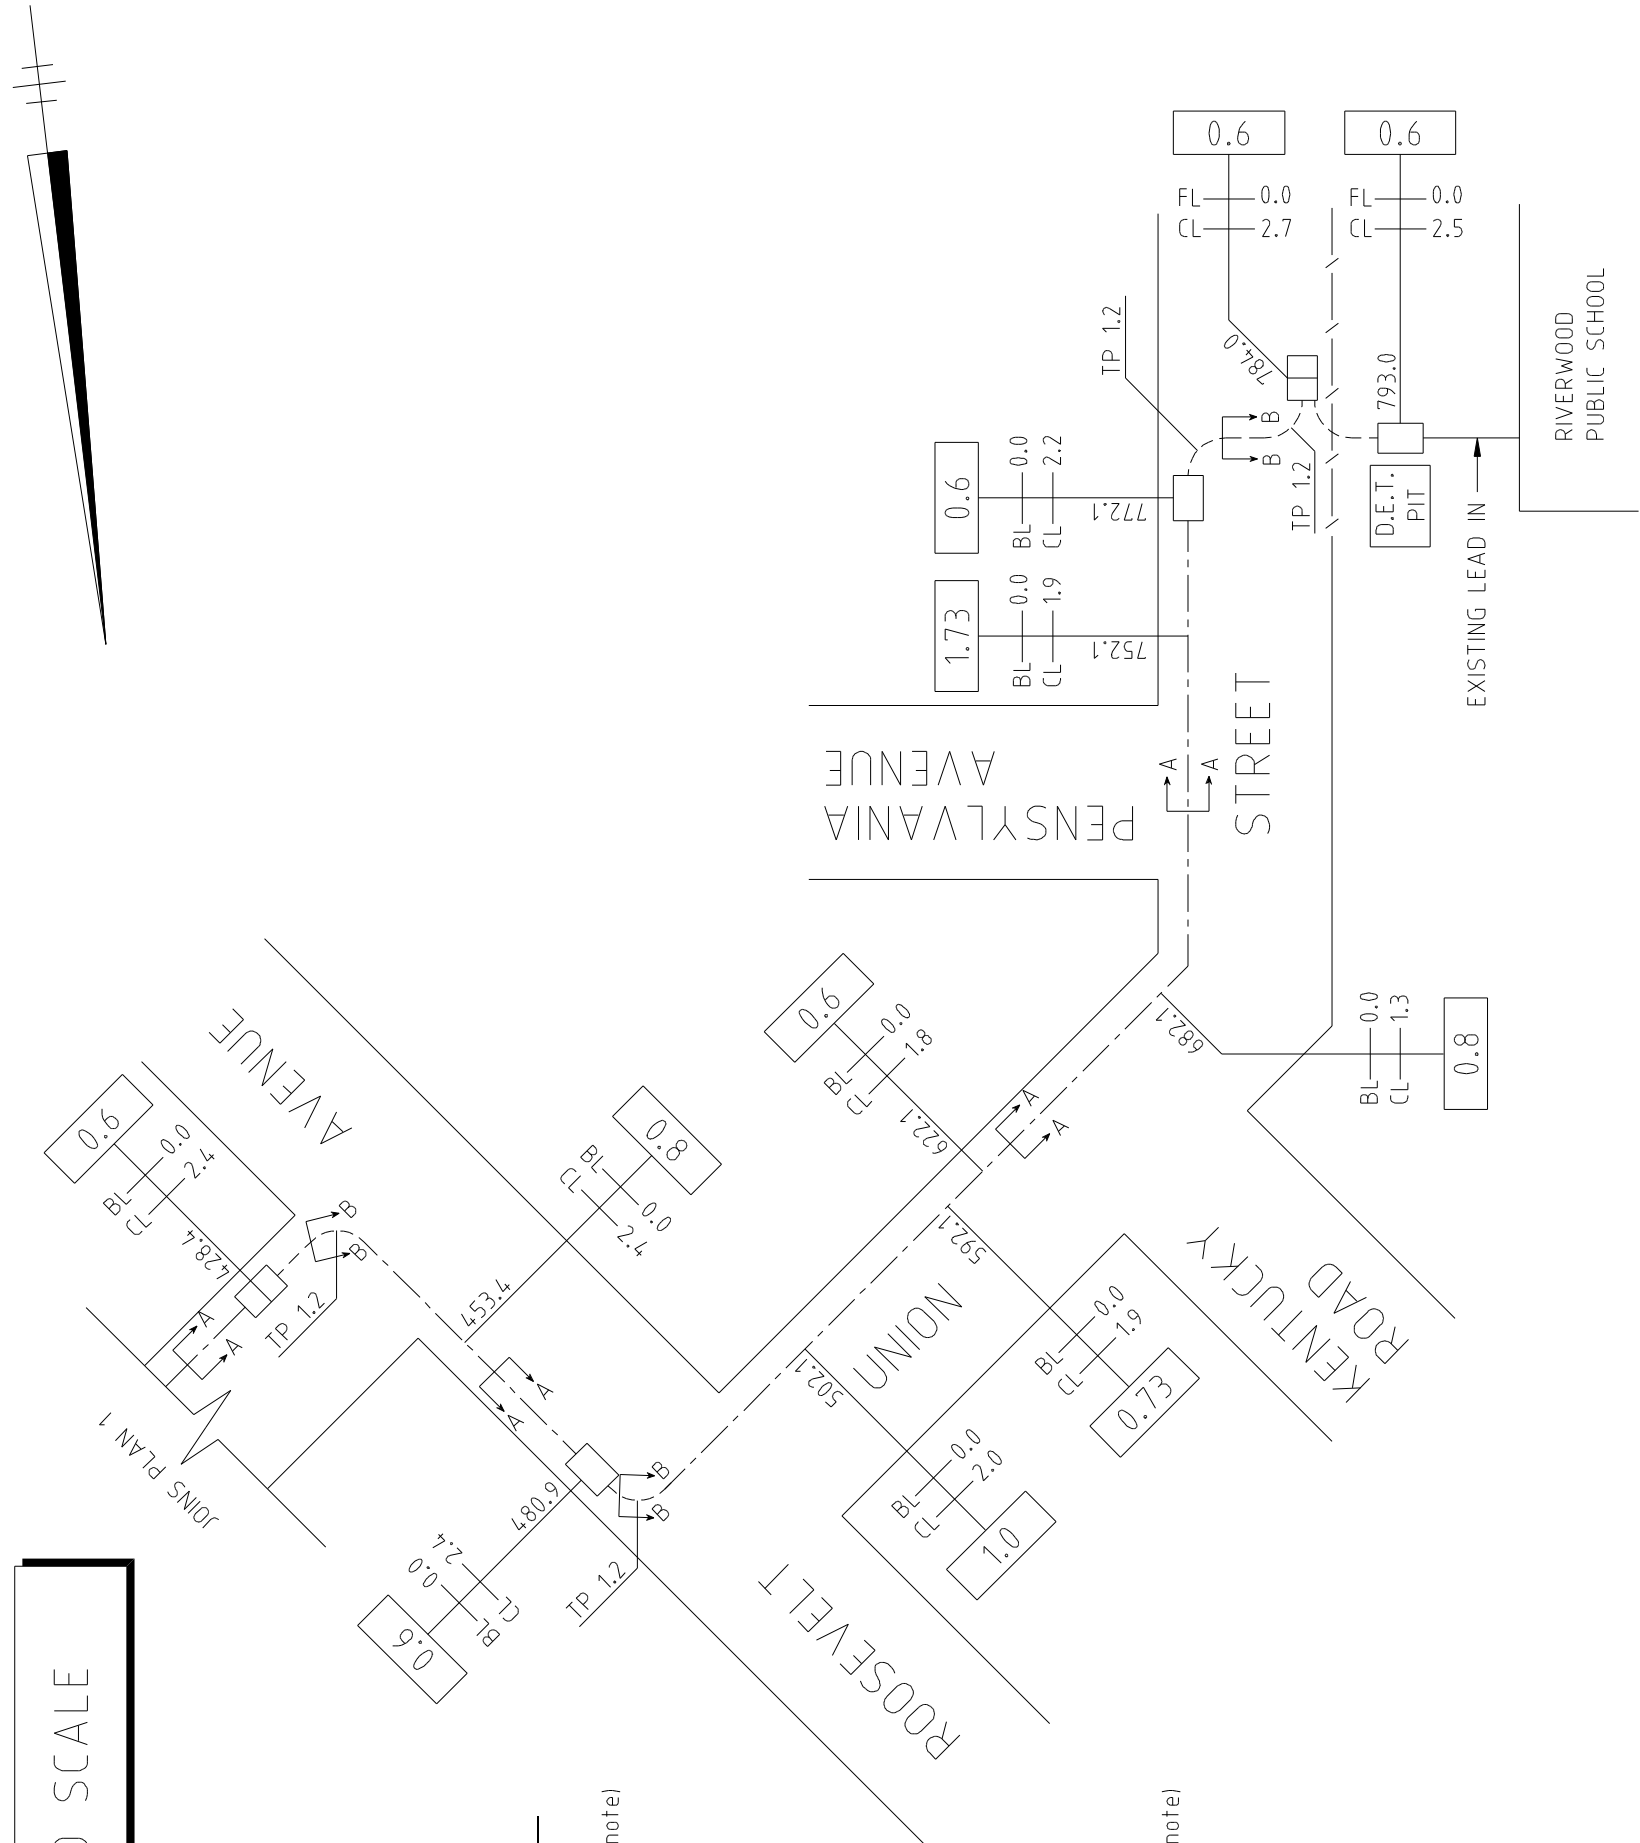

DATE	REV.	REVISION DESCRIPTION	CHECKED	APP'D.
14.08.03	0	AS BUILT	MW	DC
08.01.04	1	P5 at school modified to P6	MS	DC

CONTACT OFFICER	TREVOR SMITH PH: (02) 8226 3244
PROJECT NUMBER	UEC-DE&TS-382
PLAN No.	-
UBD REF	272-E13




Uecommm
 MEL/SYD/QLD

DRAWN JMK	14.08.03
DESIGN CHECKED	MW
APPROVED	14.08.03
DC	14.08.03


DRG No. OFN5-SYD-2460-2
 EXTERNAL ROUTE (2 OF 2)
 RIVERWOOD PUBLIC SCHOOL(3743)
 UNION STREET
 RIVERWOOD 2210

DRAWING NOT TO SCALE

- LEGEND**
- - ELECTRICITY POLE
 - - FIBRE OPTIC CABLE
 - - - CABLE CONDUIT (TRENCHING)
 - - - CABLE CONDUIT (BORE TUNNELLING)
 - - UE P2 PIT
 - - UE P5 PIT
 - - UE P6 PIT
 - - UE P8 PIT
 - - UE P9 PIT
 - ▨ - BUILDING LINE
 - BL - BACK OF KERB
 - CL - CENTRELINE OF CONDUIT
 - TP - TURNING POINT OF CONDUIT
 - - - FENCE LINE, FL
 - ▴ - TELSTRA MANHOLE
 - ⊙ - TELSTRA PIT
 - - OPTICAL FIBRE JOINT
 - ⊙ - JOINT LOOP (m) - POLE / UNDERGROUND
 - ⊙ - CABLE HEAD POLE
 - 0.6m - CABLE DEPTH

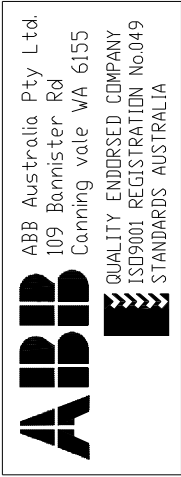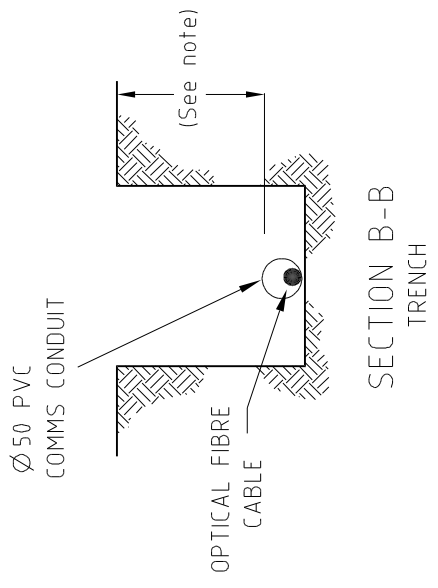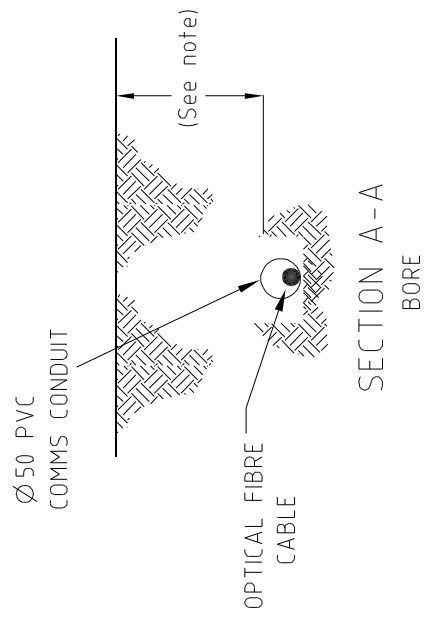

- Note:**
- Conduit depths quoted are approximate only and may change due to unforeseen circumstances.
 - In all instances it is recommended that the position of conduits & cables should be proved on site by hand, prior to commencement of works.
 - Loop in all pits unless otherwise stated.




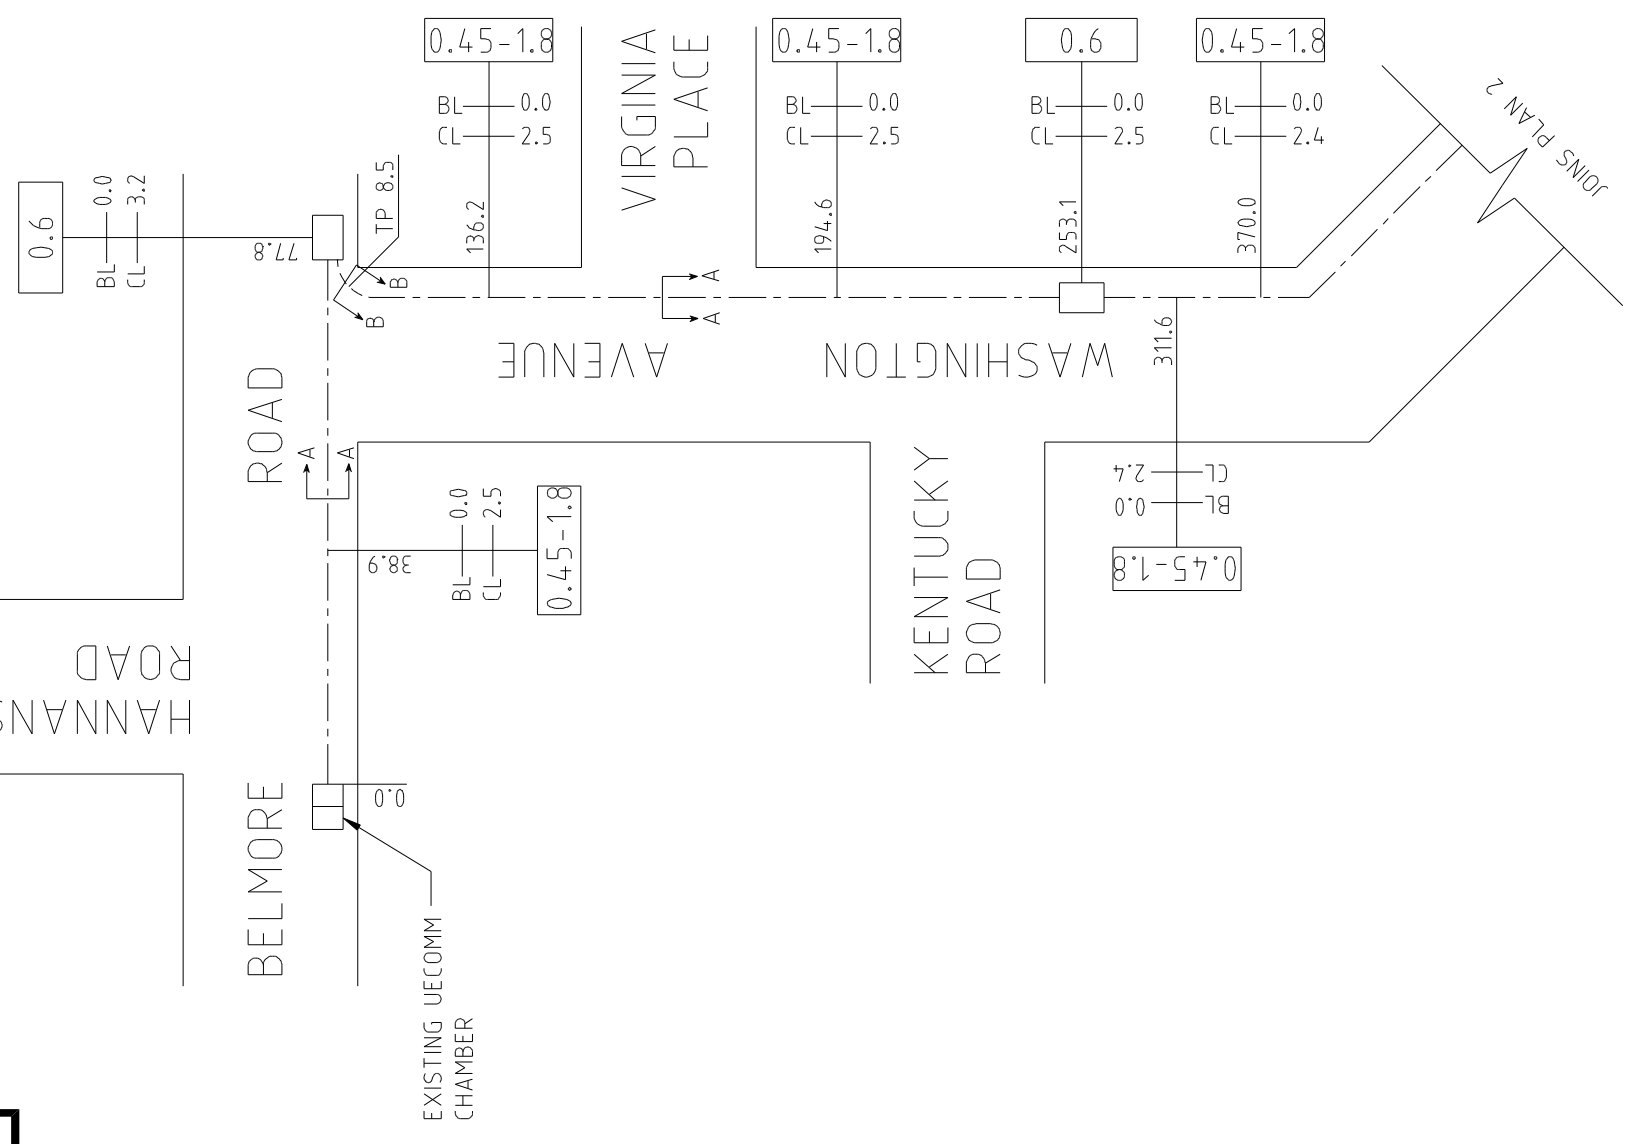


REVISION	DATE	REV.	REVISION DESCRIPTION	CHECKED	APP'D.
14.08.03	0	AS BUILT		MW	DC

CONTACT OFFICER	TREVOR SMITH PH: (02) 8226 3244
PROJECT NUMBER	UEC-DE&TS-382
PLAN No.	-
UBD REF	272-E13

	DRAWN JMK 14.08.03
	DESIGN CHECKED M.W. 14.08.03
APPROVED	
UECOMM MEL/SYD/QLD	


DRG No. OFN5-SYD-2460-1
EXTERNAL ROUTE (1 OF 2)
RIVERWOOD PUBLIC SCHOOL (3743)
UNION STREET
RIVERWOD 2210

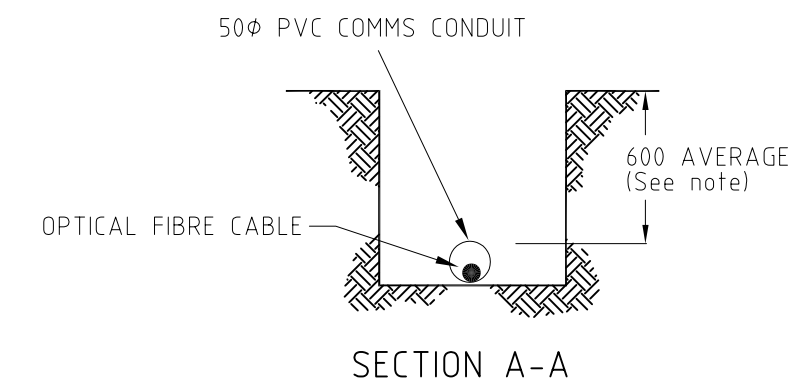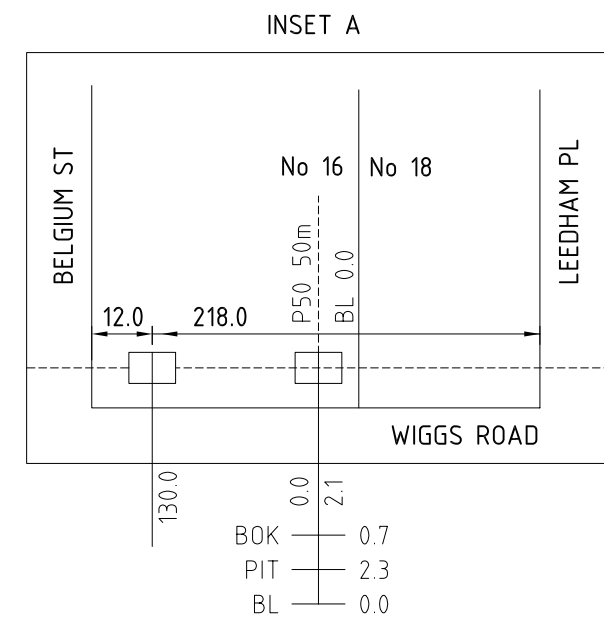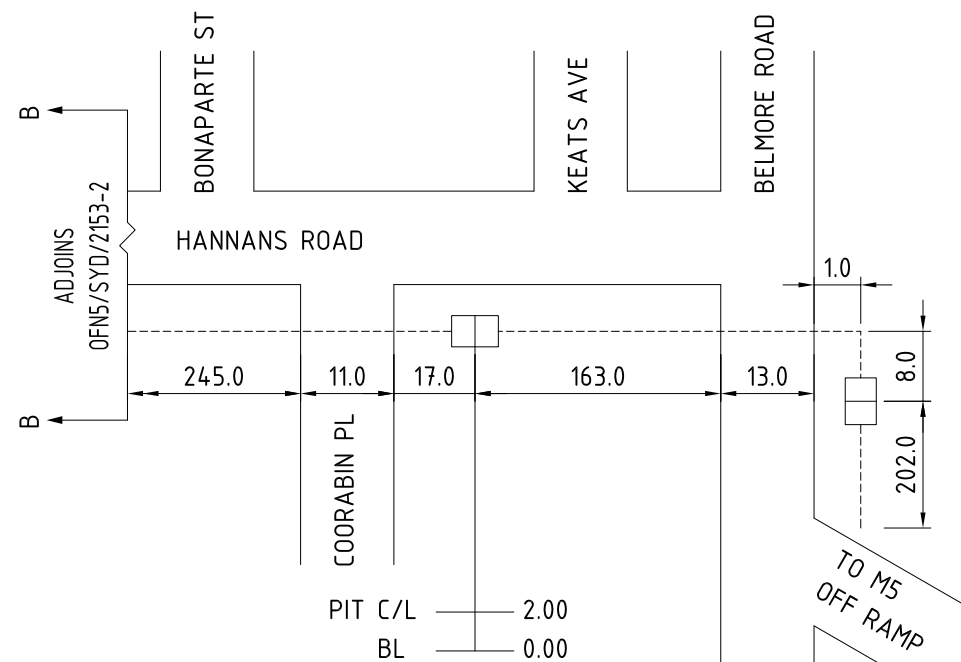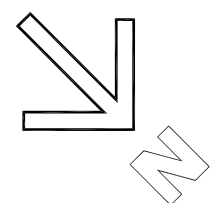

Note:
Conduit depths quoted are approximate only and may change due to unforeseen circumstances.
Excavate by hand until conduit depth is determined.

LEGEND

- - ELECTRICITY POLE
- - FIBRE OPTIC CABLE
- - UE P5 PIT
- ▤ - UE P6 PIT
- BL - BUILDING LINE
- PIT C/L - PIT CENTER LINE FROM BL
- BOK - BACK OF KERB
- CO - COVER
- - FENCE LINE
- ▴ - TELSTRA MANHOLE
- ⊙ - TELSTRA PIT
- TT - TELSTRA 6 PIT

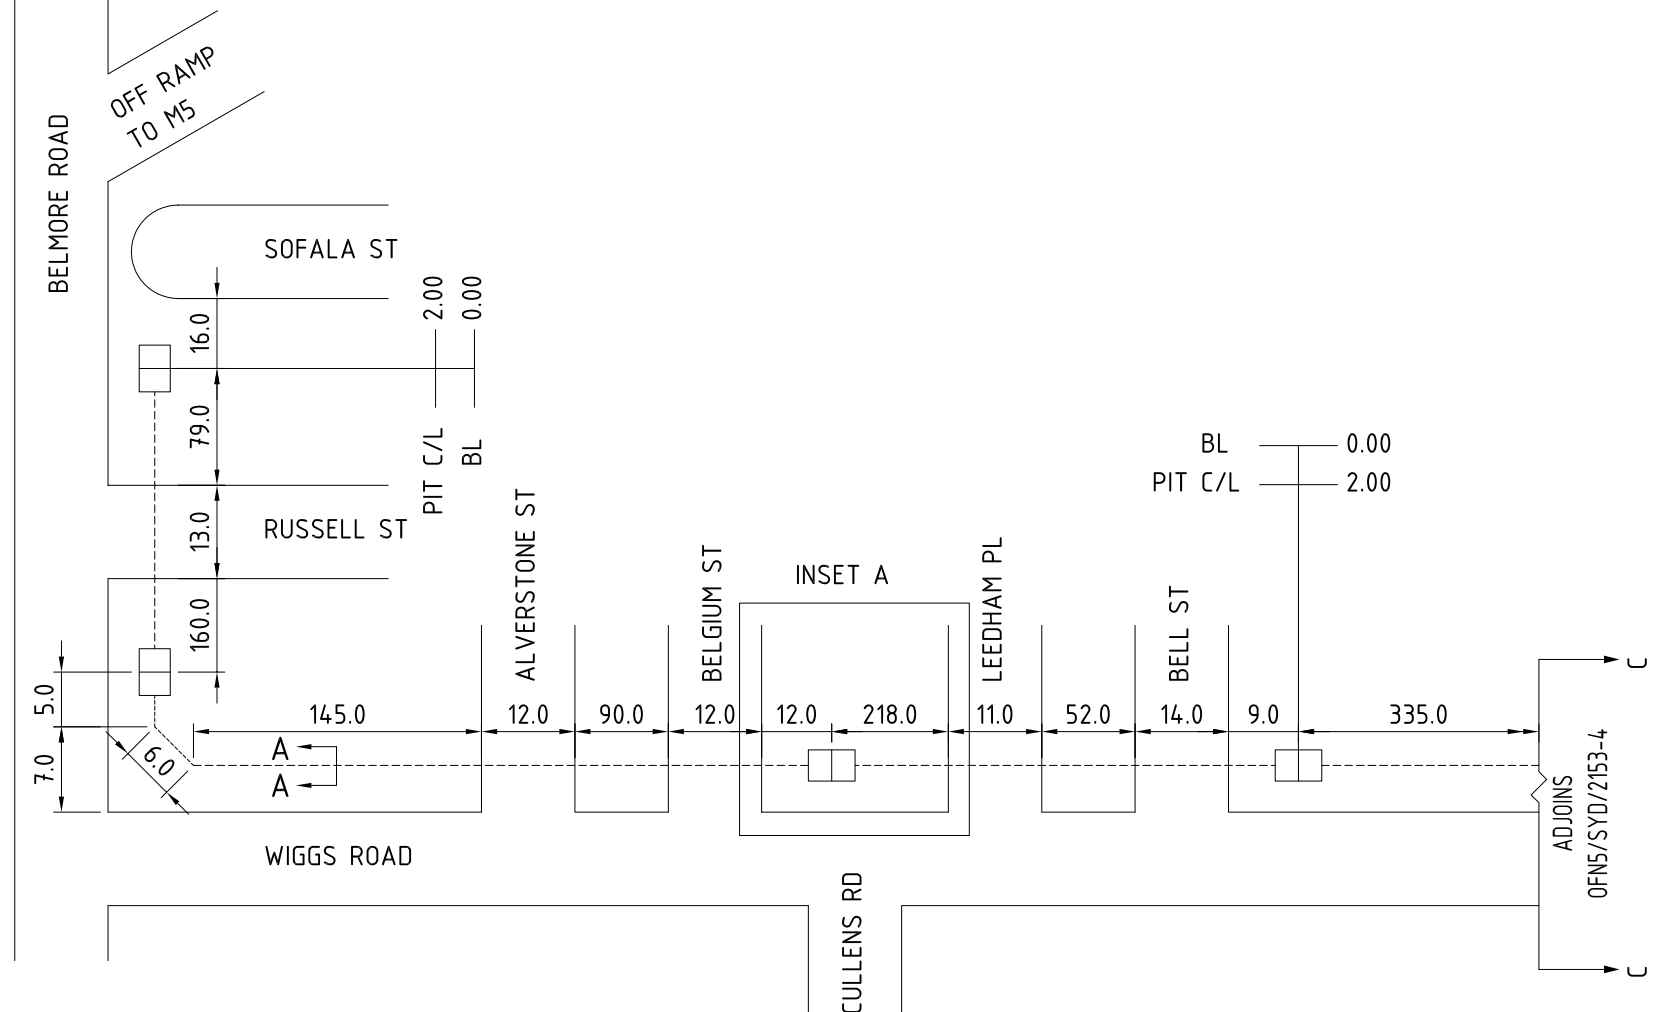

NOTE: - ALL DIMENSIONS ARE SHOWN IN METRES UNLESS NOTED OTHERWISE.

REV	DESCRIPTION	DATE	CHECKED	APPROVED
B	NEW PIT & PIPE (YKPPS-101)	10.07.08	SG	
A	RENUMBERED. WAS BCE-00-0074	26.02.01		

BCE
Brice Civil Engineering Pty Ltd
A.B.N. 13 087 182 581
P.O. Box 378 Cherrybrook NSW 2126 Ph:(02) 8850 7550 Fax: (02) 8850 7551

Uecomm
MAKING THE CONNECTION
ACN 079 083 195

APPROVED
R.Browne
26.02.01
UBD REF:
272-J13,H13,H12,H11,
H10,G10,F10,E9

PROJECT:
HANNANS ROAD -
WIGGS ROAD
RIVERWOOD NSW 2210
CONDUIT: 50mm
DEPTH: 0.5 - 0.7m

**"AS-BUILT"
PLANS**

METHOD: DIRECTIONAL BORE AND EXCAVATION		
SCALE: NOT TO SCALE	DRAWN SSQ P/L	SIZE A3
DOCUMENT No: OFN5/SYD/2153-3	DATE: 10.02.01	REVISION: B