
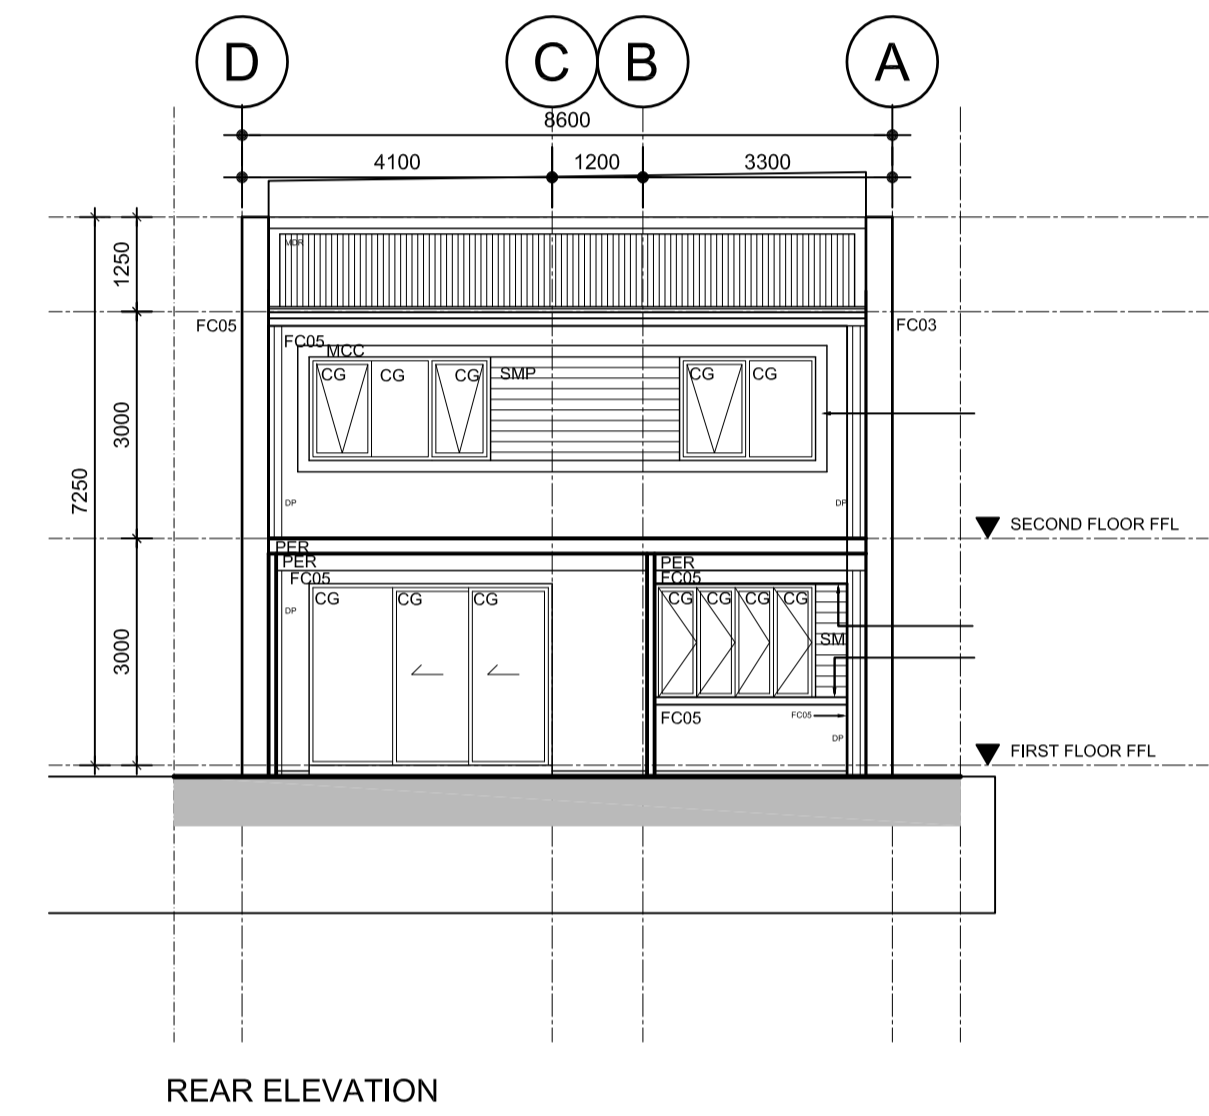
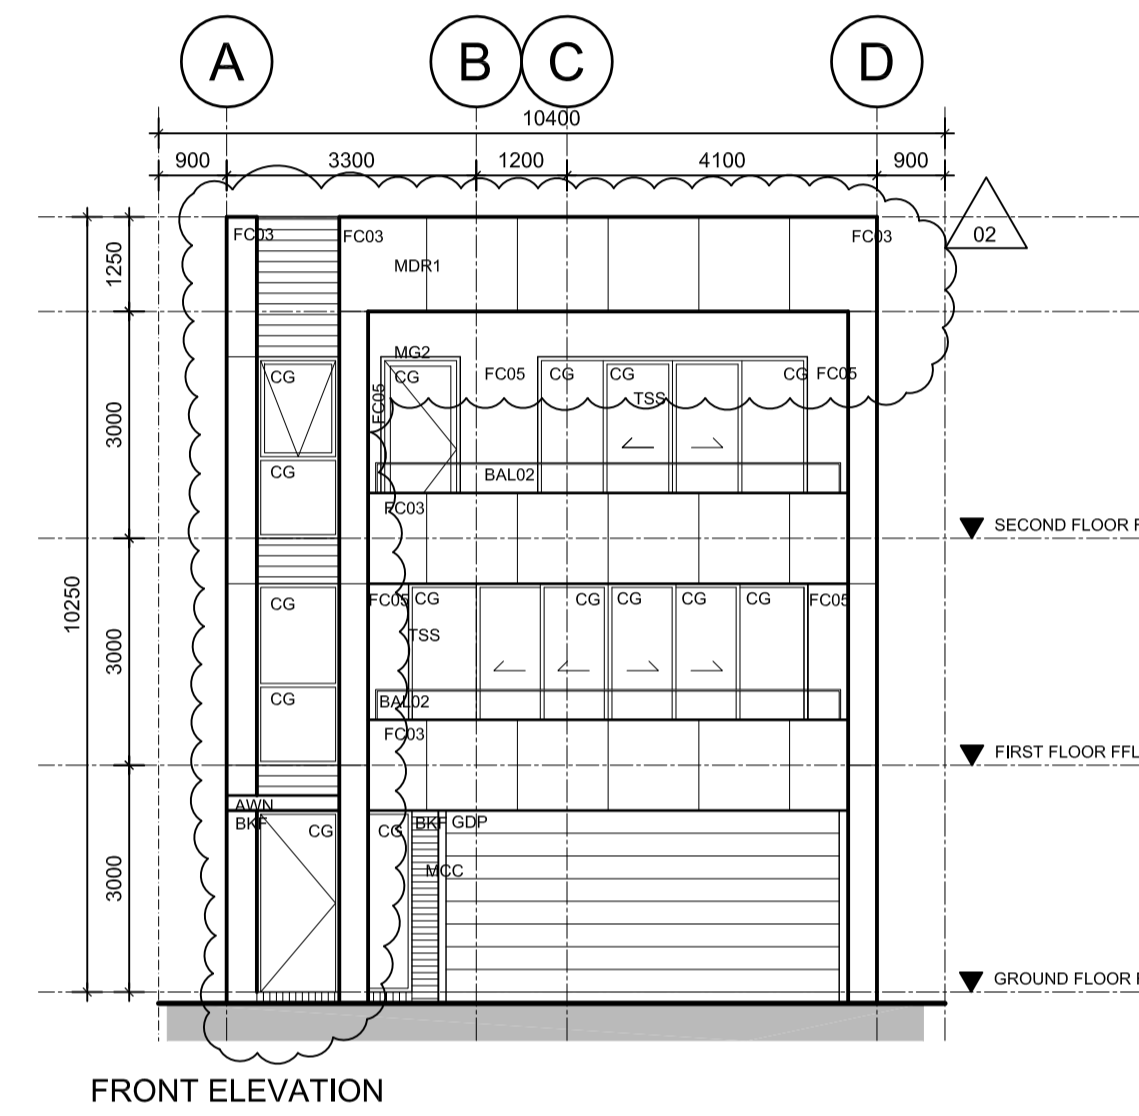


# ABBREVIATIONS LEGEND:


<b>WALLS</b> AGS :ALUMINIUM GLAZED SKYLIGHT BKF :BRICKWORK - FACE BKR :BRICKWORK - RENDER AND PAINT FINISH CBP :CONCRETE BLOCK WORK - PAINT FINISH CG :ALUMINIUM FRAMED CLEAR GLAZING CWT1 :CERAMIC WALL TILES MCC :METAL INFILL PANEL MFB :METAL FIXED BLADE MFSH :METAL SCREEN - FIXED HORIZONTAL MFSV :METAL SCREEN - FIXED VERTICAL MOSH :METAL SCREEN - OPERABLE HORIZONTAL RW1 :DARK GREY RW2 :LIGHT GREY RW3 :WHITE SSH :BRISE SOLEIL AWNING TFS :TIMBER SCREEN - FIXED	BAL01 :BALUSTRADE - TYPE 1 STEEL PLATE BALUSTER BAL02 :BALUSTRADE - TYPE 2 GLAZED BAL03 :BALUSTRADE - TYPE 3 WIRE PBD :PLASTERBOARD LINING, PAINT FINISH FC01 :FIBRE CEMENT CLADDING: VERTICAL - SCYON-AXON FC02V :FIBRE CEMENT CLADDING: WIDE RECESS - VERTICAL - SCYON-STRIA FC02H :FIBRE CEMENT CLADDING: WIDE RECESS - HORIZONTAL - SCYON-STRIA FC03 :FIBRE CEMENT CLADDING: EXPRESSED JOINT - SCYON-MATRIX FC04 :FIBRE CEMENT CLADDING: WEATHERBOARD - SCYON-LINEA FC05 :FIBRE CEMENT CLADDING: RENDERED FC06 :FIBRE CEMENT CLADDING: RENDERED	<b>GENERAL</b> EF :EXHAUST FAN RWO :RAINWATER OUTLET USR :UNDERSIDE ROOF ACU :AIRCONDITIONING CONDENSOR UNIT CL :CLOTHES LINE EDB :ELECTRICAL DISTRIBUTION BOARD GRS :GAS REGULATOR SET GM :GAS METER GTD :GRATED DRAIN HWU :HOT WATER UNIT LB :LETTER BOX RWT :RAINWATER TANK OF :OVERFLOW SS :STAINLESS STEEL SSL :STRUCTURAL SLAB LEVEL WM :WATER METER WPM :WATERPROOF MEMBRANE PER :PERGOLA	MIR :MIRROR DP :DOWNPIPE - COLORBOND EJ :EXPANSION JOINT GDP :GARAGE DOOR - TILT UP UNIT PFC :PARALLEL FLANGED CHANNEL PAINTED  <b>CEILINGS</b> SPB :PLASTERBOARD SFC :FIBRE CEMENT SOFFIT SMP :EXTERNAL TIMBER CLADDING	<b>FLOORS</b> CFS :CONCRETE FINISHED-AS-LAID: STEEL FLOAT CFT1 :CERAMIC FLOOR TILES CPT1 :CARPET TMD1 :TIMBER DECKING - TYPE 1 SKT :TIMBER SKIRTING 100mm HIGH  <b>ROOFS</b> AWN :TIMBER FRAMED AWNING MG1 :METAL GUTTER - TYPE 1 HALF ROUND MG2 :METAL GUTTER - TYPE 2 CUSTOM PROFILE MG3 :METAL GUTTER - TYPE 1 QUAD LOW FRONT MDR1 :METAL DECK ROOF - TYPE 1
--	---	--	---	---

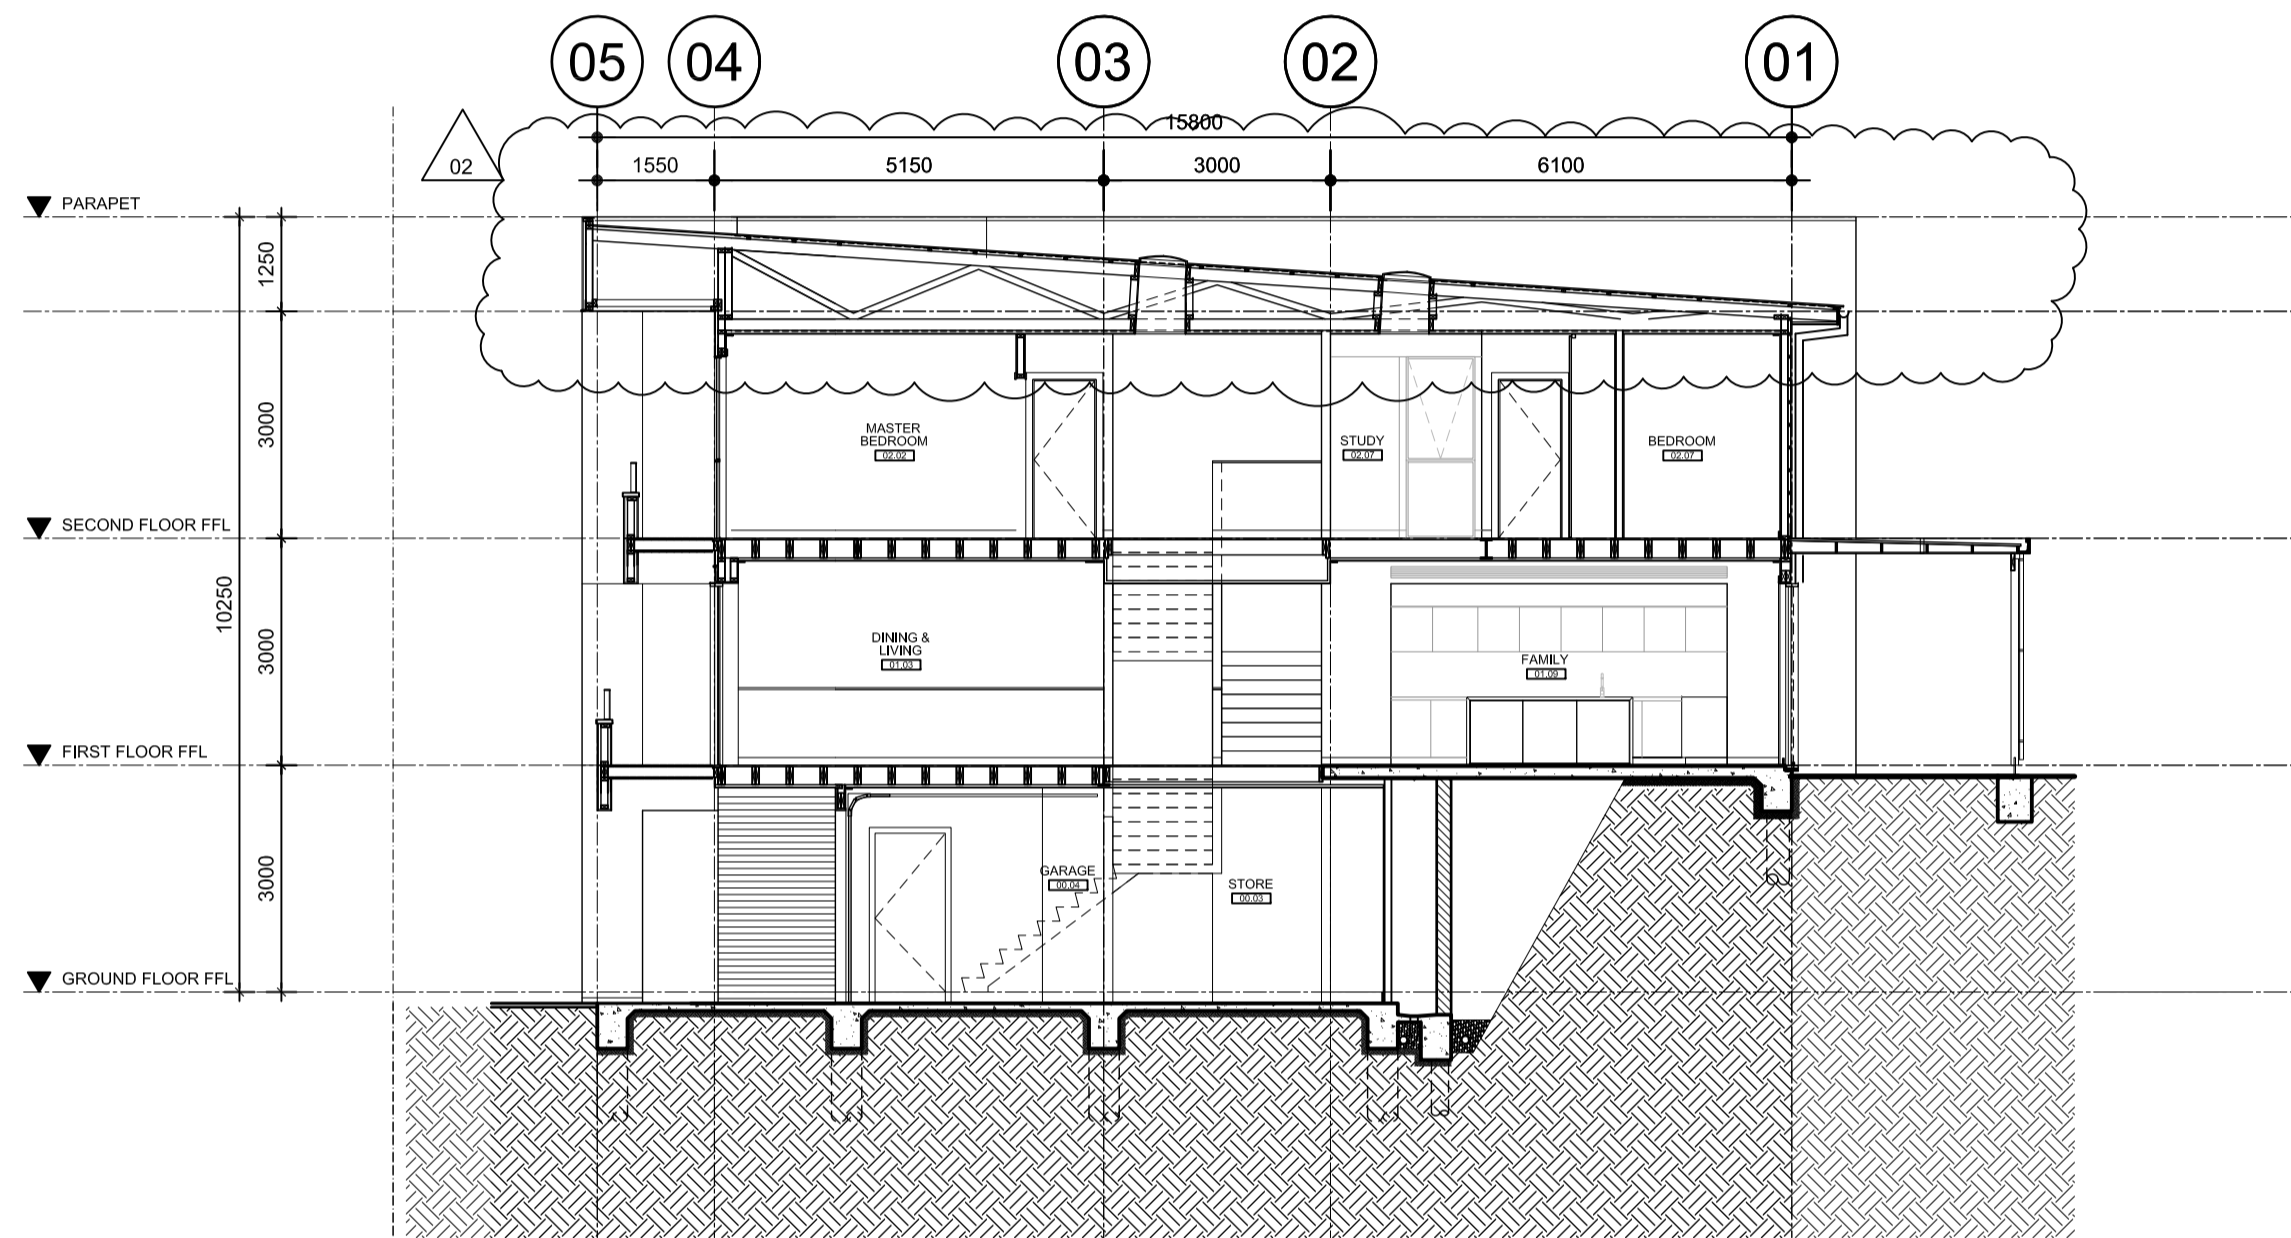


FRONT ELEVATION

REAR ELEVATION

## SECTION

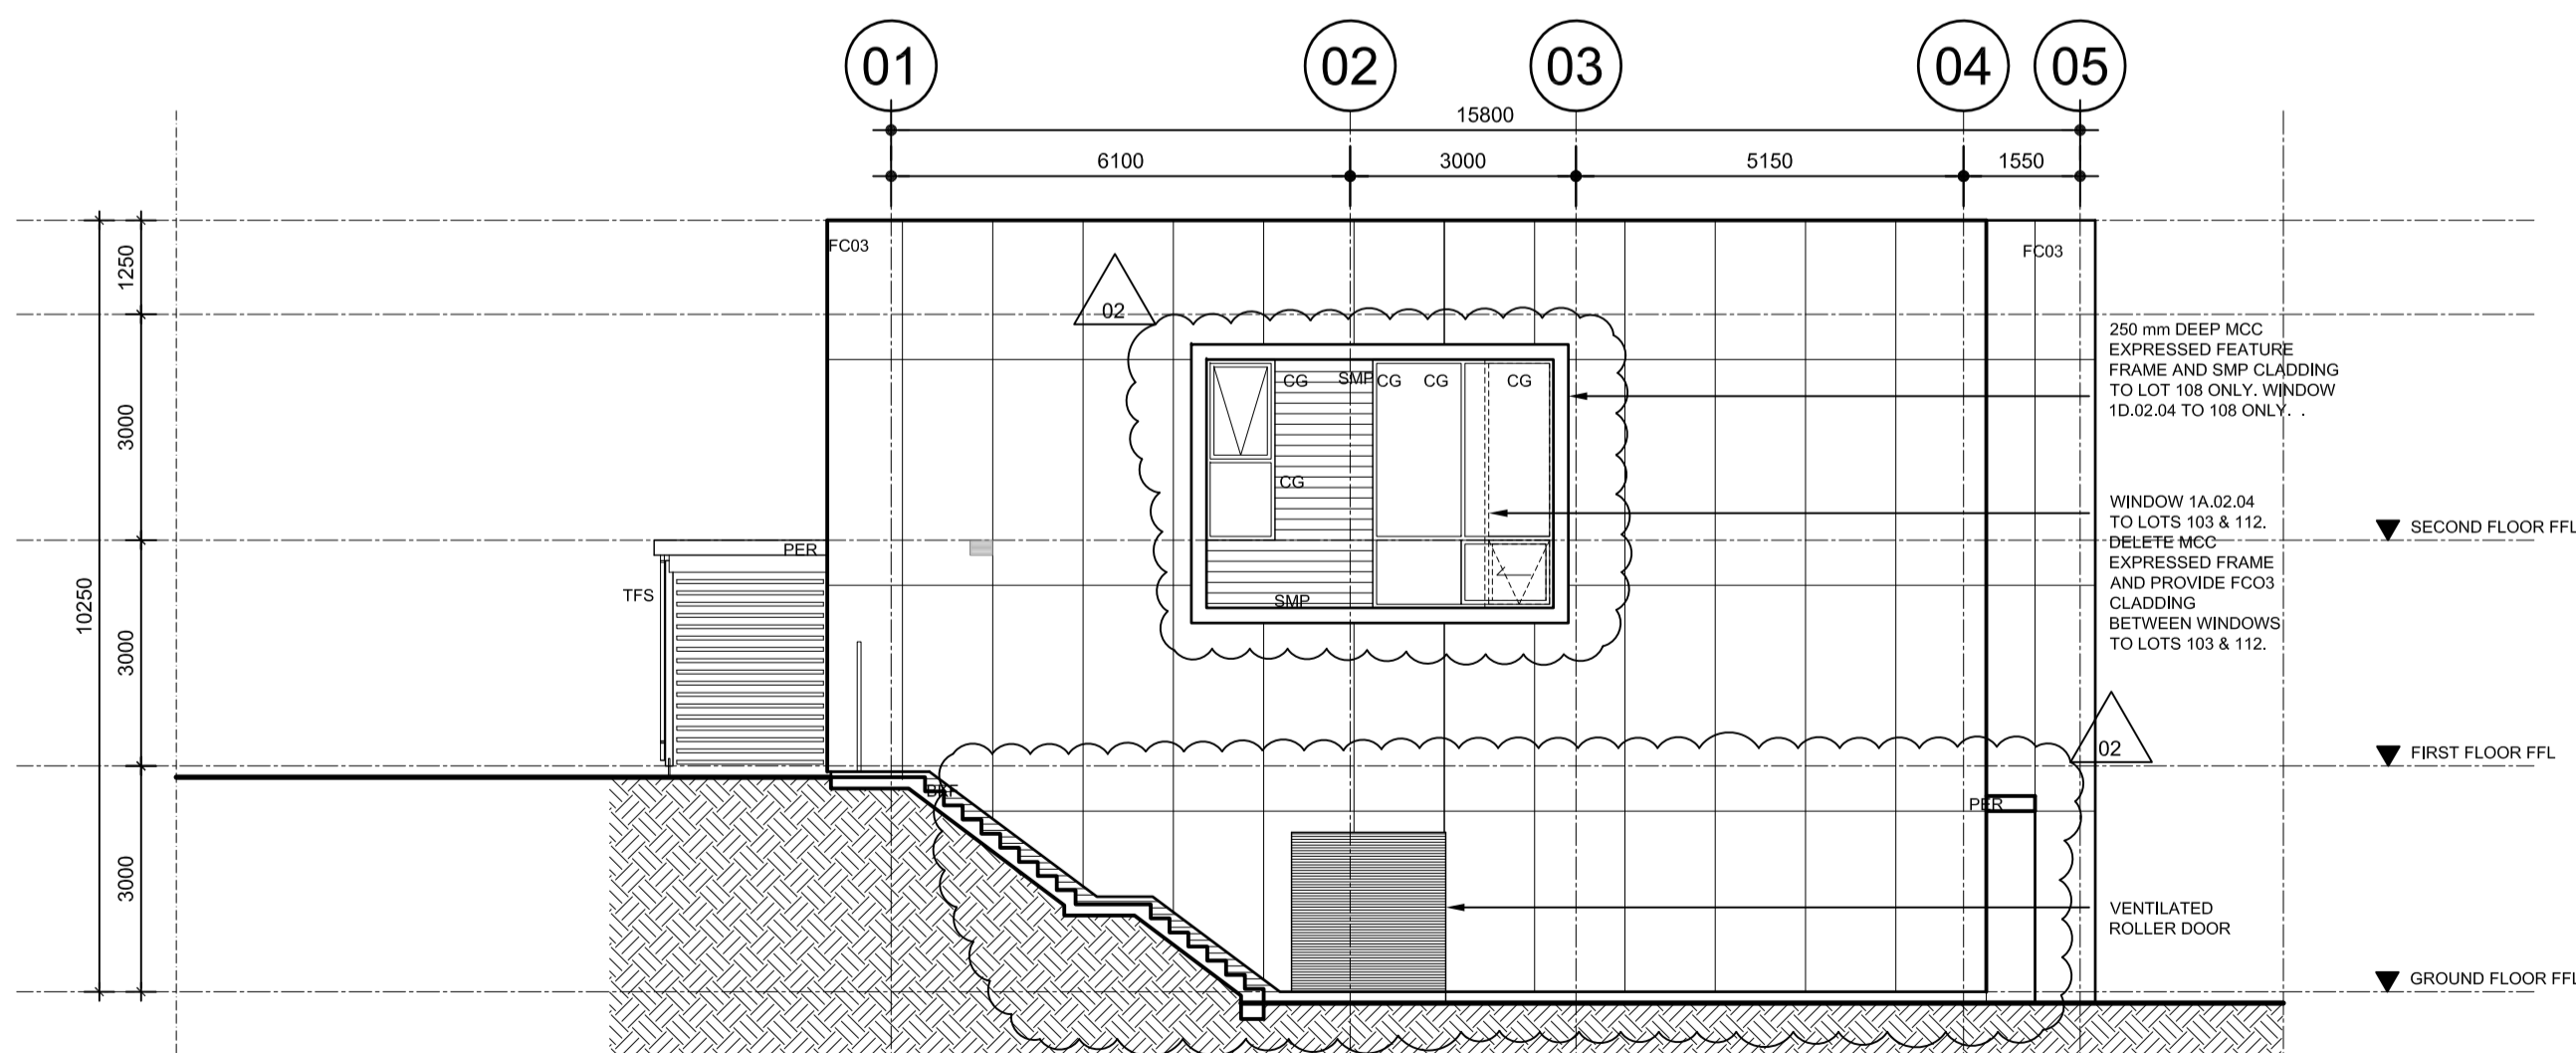

SIDE ELEVATION

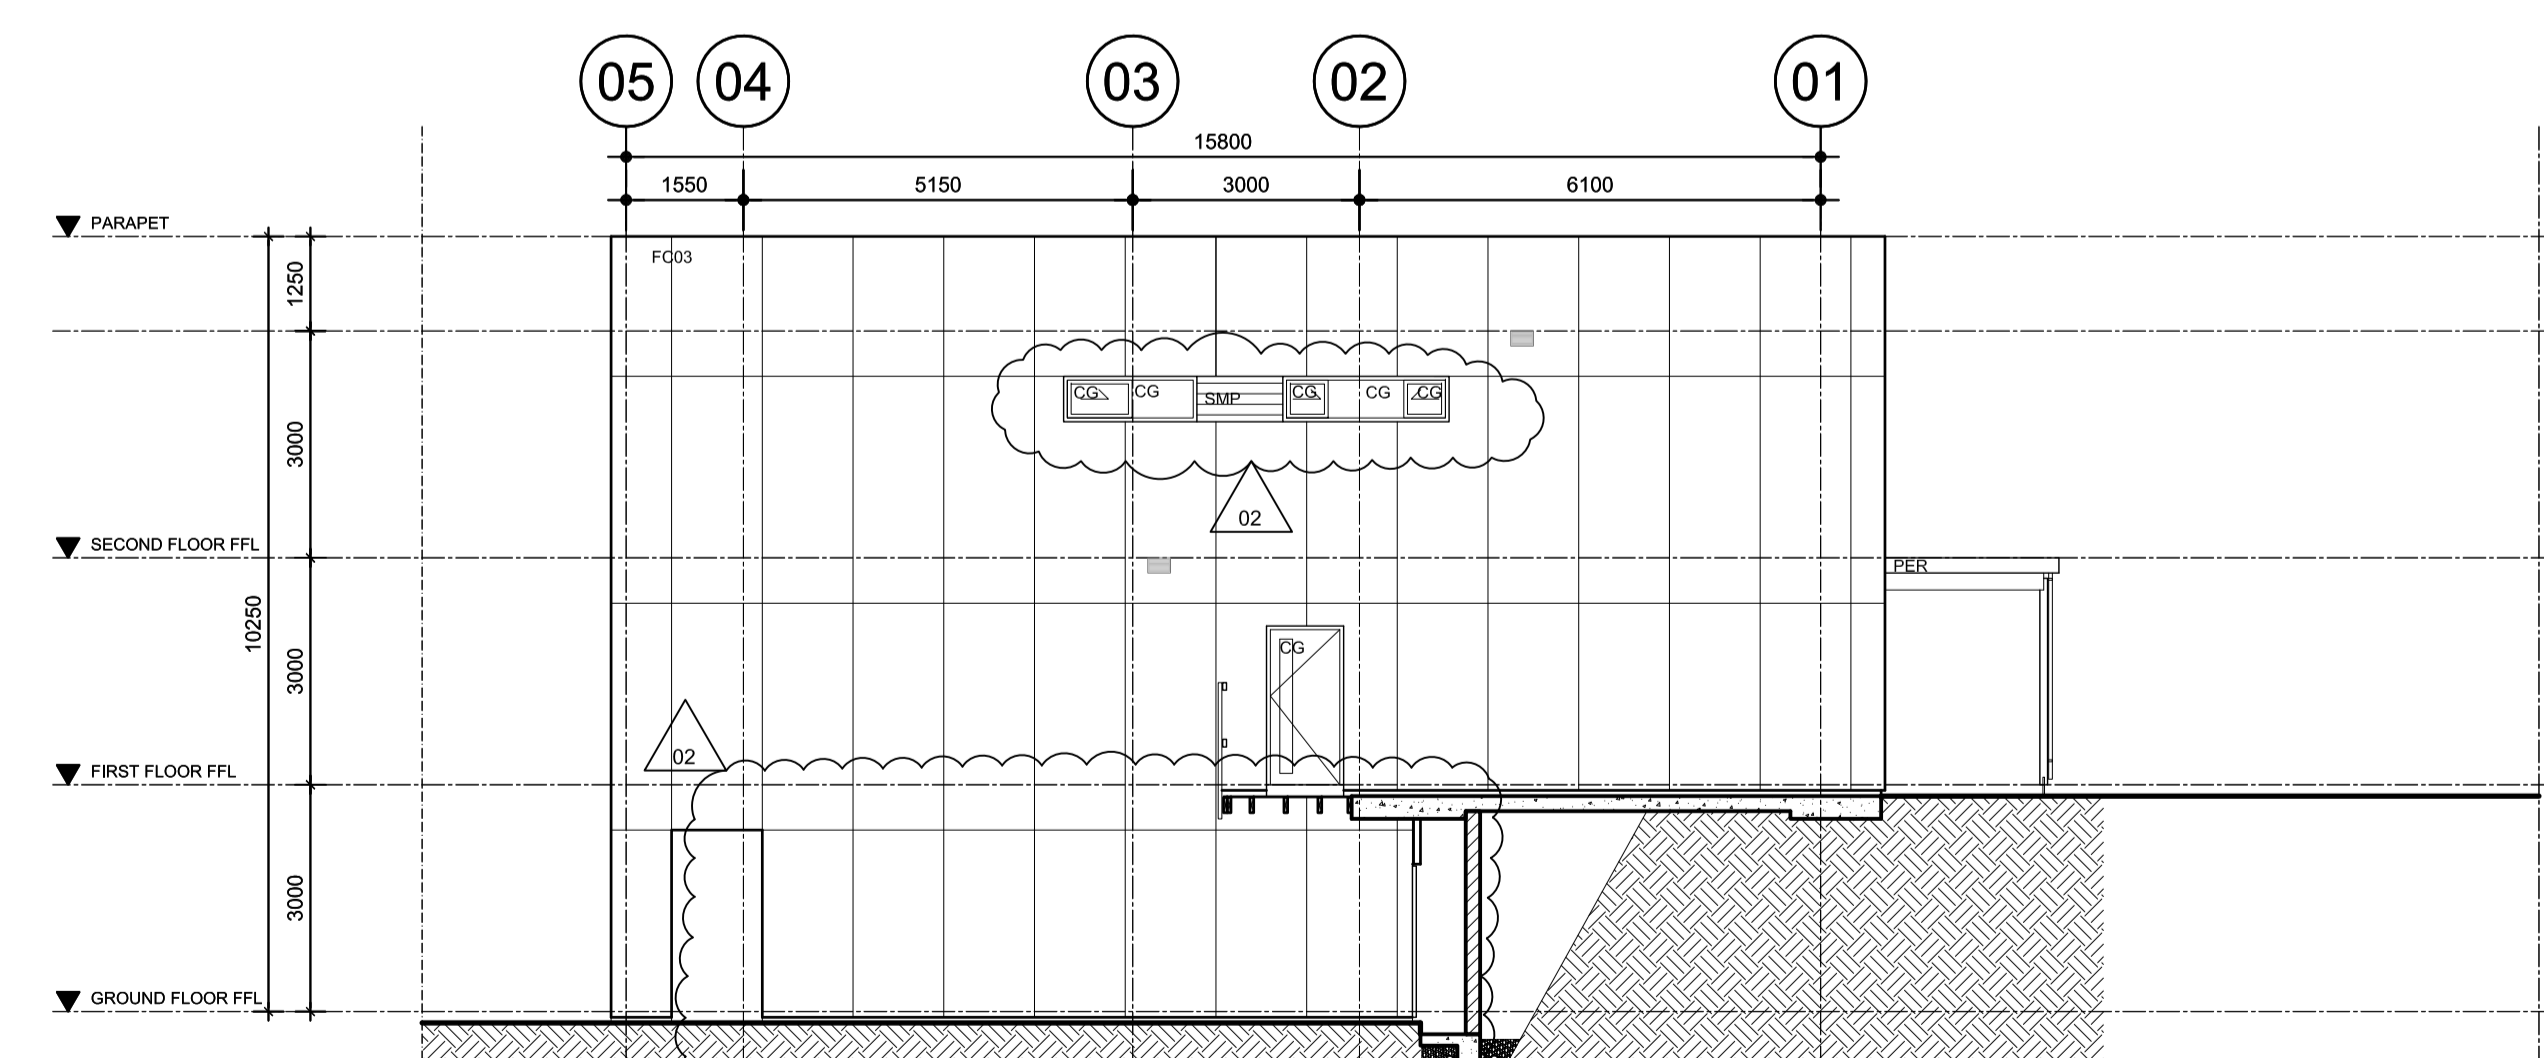

SIDE ELEVATION

Rev	Description	By	Date	Rev	Description	By	Date
01	PREFERRED PROJECT	RB	12-12-11				
02	SECTION 75 W	RB	11-02-13				

Consultants	Project Manager	FRASERS PROPERTY	Heritage Consultant
BCA Consultant	Project Manager	FRASERS PROPERTY	Heritage Consultant
Planning Consultant	JBA PLANNING		Acoustic
Structural	M&G CONSULTING		Environmental
Civil	MEINHARDT ENGINEERING		Traffic Consultant
Building Services			Access Consultant
Landscape	ENVIRONMENTAL PARTNERSHIP		MORRIS GODING
			WT PARTNERSHIP
			Land Surveyor

**Cox Richardson**  
 Level 2, 204 Clarence Street, Sydney 2000 Australia  
 Tel : 612 9267 9599 Fax : 612 9264 5844  
 Email : sydney@cox.com.au



## FRASERS PUTNEY

Drawing Title <b>HOUSING TYPE 1D - DETACHED</b>			
Drawing Number <b>A-PA-FP-H1D2</b>	Revision <b>02</b>	Date <b>2013-02-11</b>	North
Issued for <b>SECTION 75 W</b>	Scale <b>1:100@A1</b>	Drawn <b>RB</b>	
0 0.5 1 1.5 2 2.5 5m			