



- NOTES
- DO NOT SCALE DRAWINGS. WRITTEN DIMENSIONS GOVERN.
 - ALL DIMENSIONS ARE IN MILLIMETRES UNLESS NOTED OTHERWISE.
 - ALL DIMENSIONS SHALL BE VERIFIED ON SITE BEFORE PROCEEDING WITH THE WORK. HASSELL SHALL BE NOTIFIED IN WRITING OF ANY DISCREPANCIES.
 - THIS DRAWING MUST BE READ IN CONJUNCTION WITH ALL RELEVANT CONTRACTS, SPECIFICATIONS AND DRAWINGS.

© COPYRIGHT OF THIS DRAWING IS VESTED IN HASSELL. LTD.
2010 HASSELL. LTD.

THIS DRAWING IS AN UNCONTROLLED COPY, UNLESS NOTED OTHERWISE.

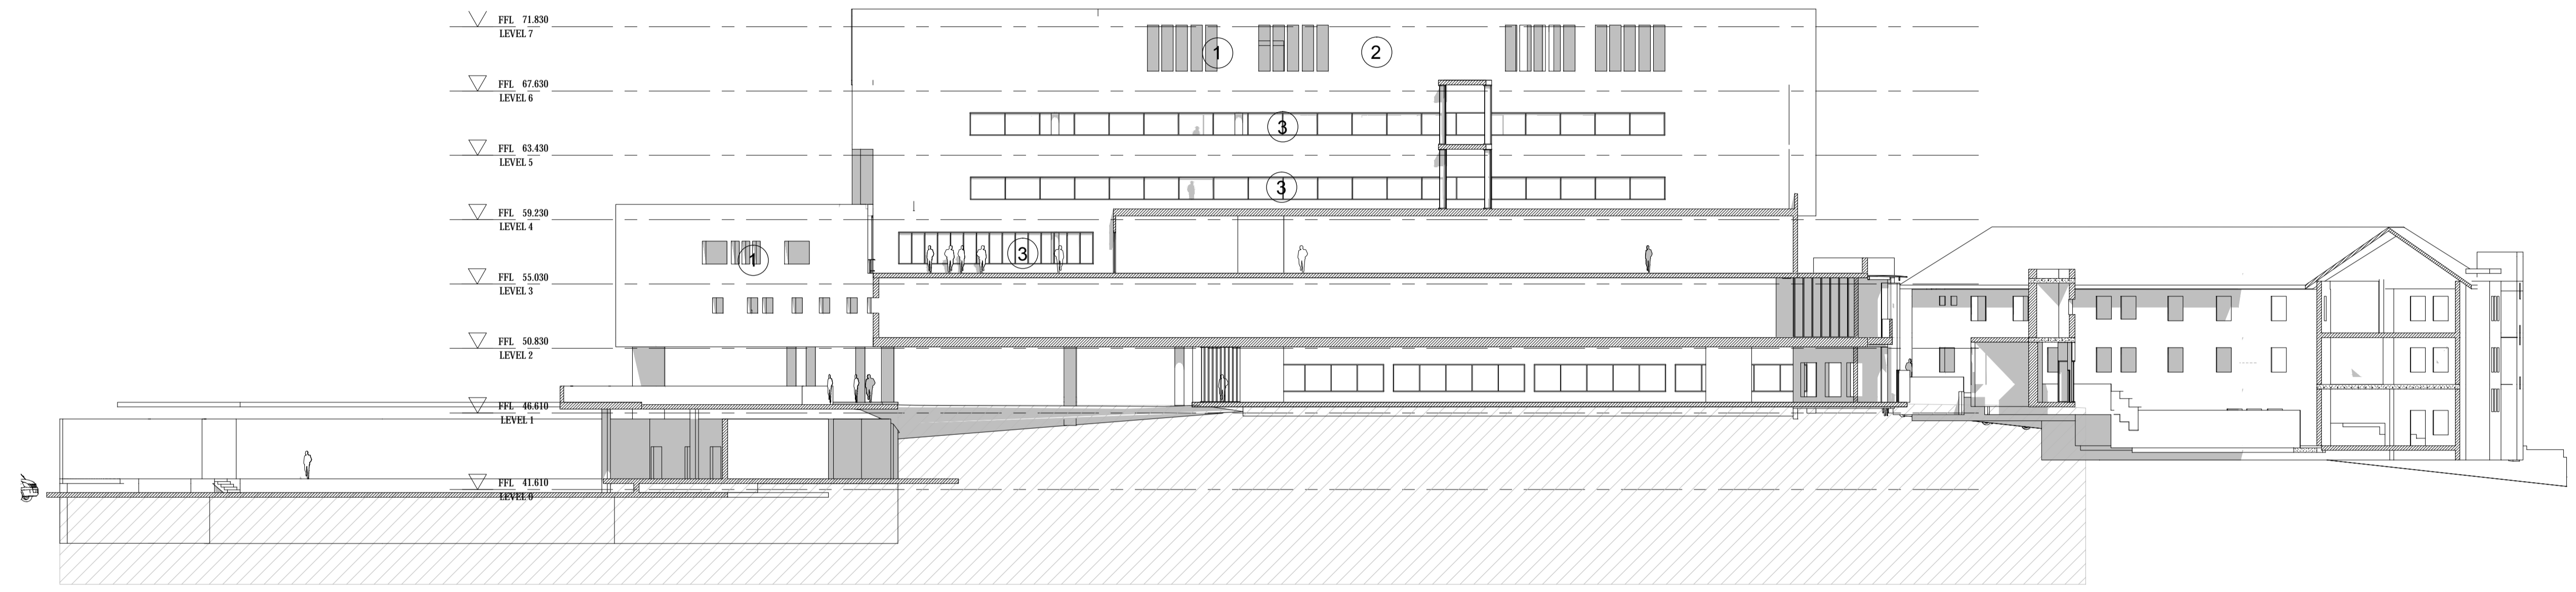

3 ELEVATION 3 - SOUTH ELEVATION
1:250 @ A1 Size

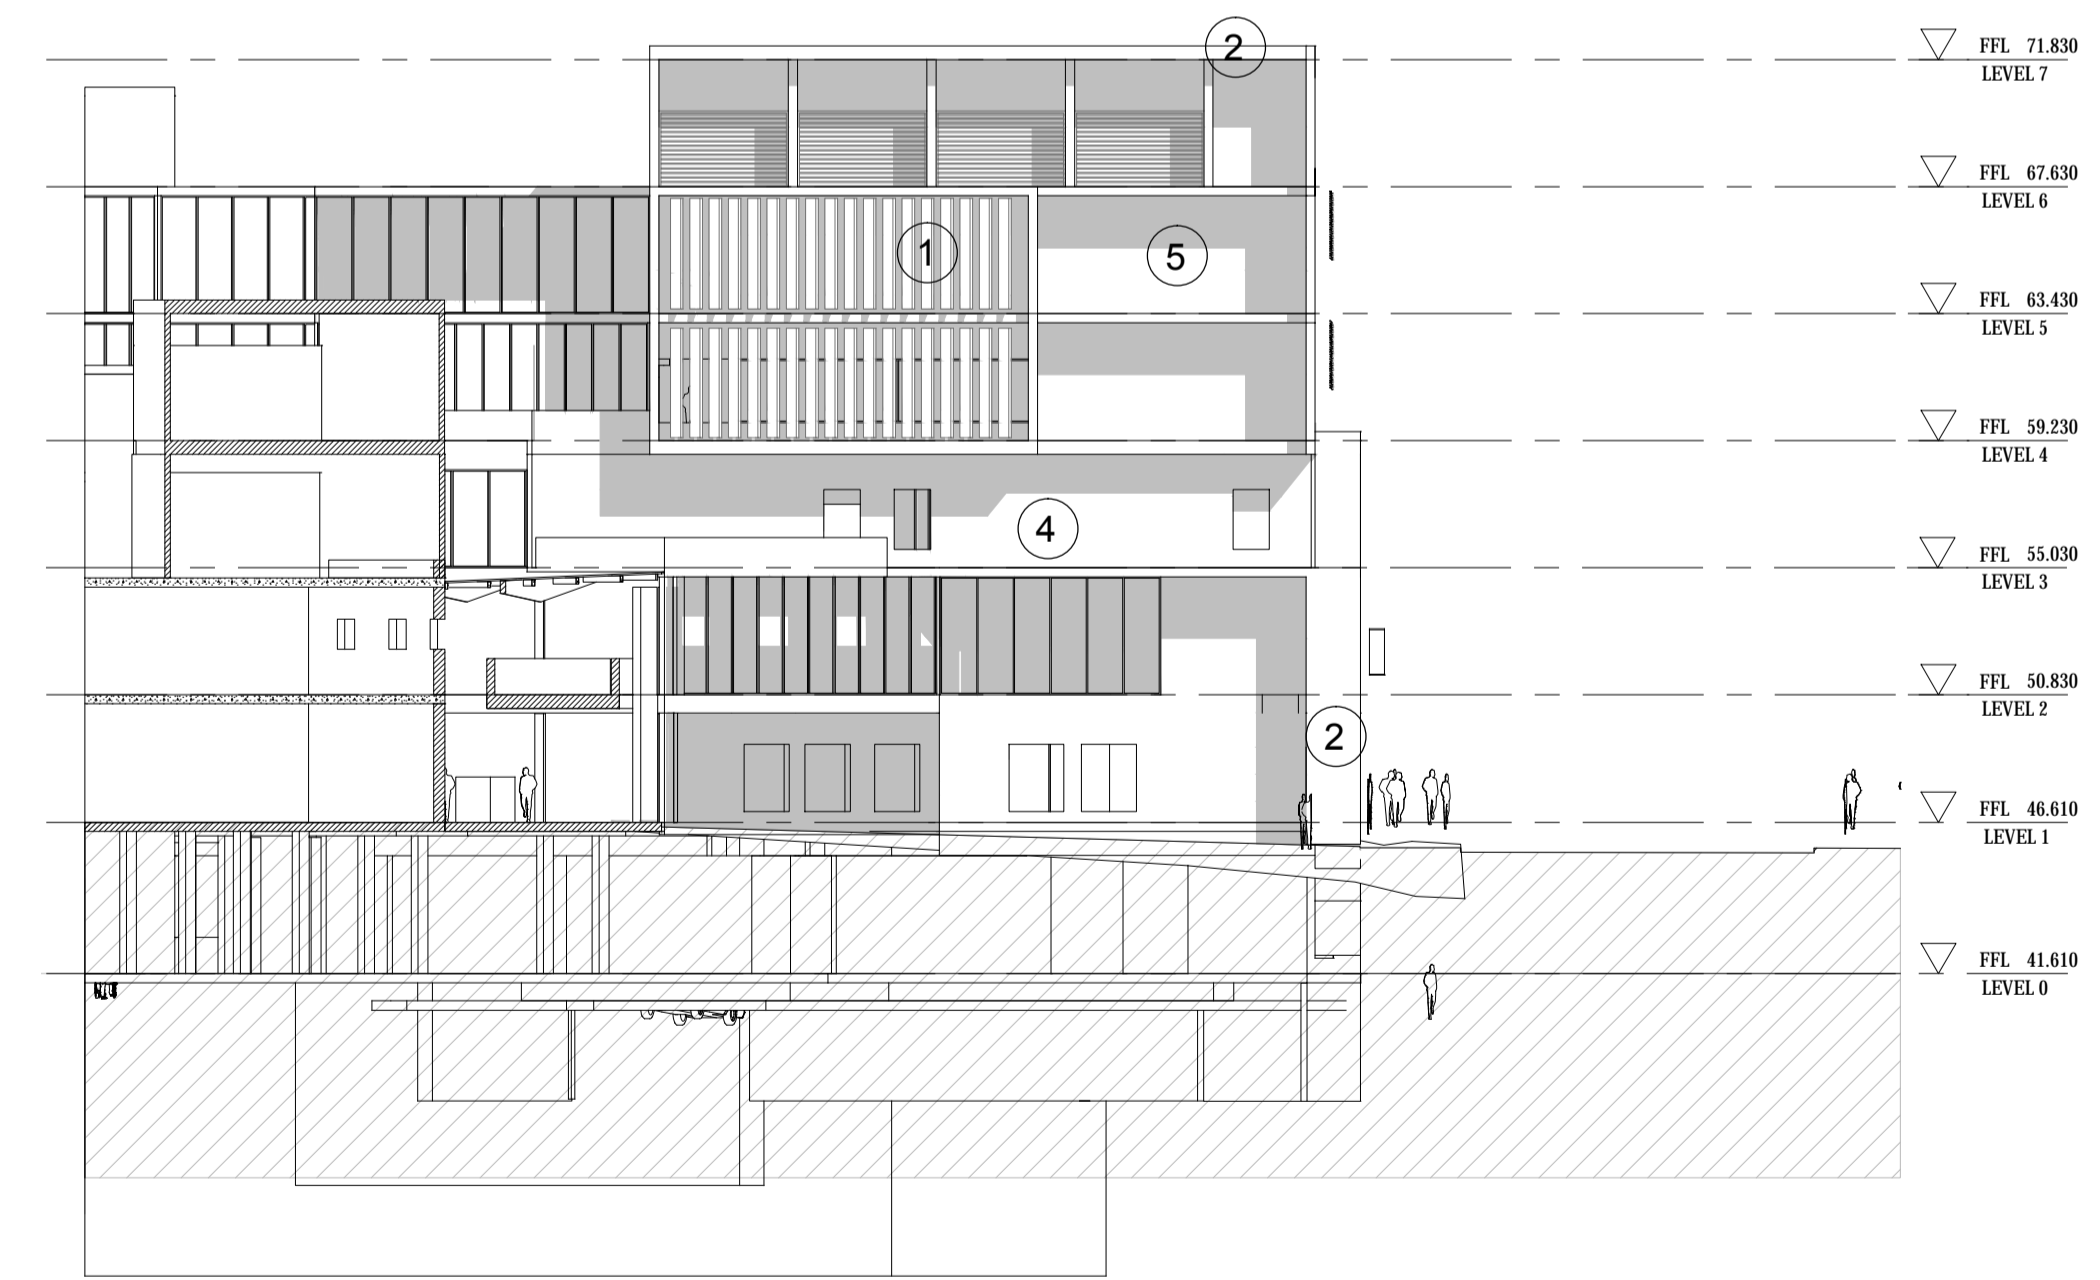

4 ELEVATION 4 - EAST ELEVATION
1:250 @ A1 Size

CODE	LEGEND
1	Aluminium Louvres
2	Composite Panel
3	Aluminium Frame Window
4	Tiles type 1
5	Tiles type 2
6	Tiles type 3
7	Tiles type 4
8	Concrete Panels

REV	DESCRIPTION	DATE
B	DA SUBMISSION	02.09.11
A	DA DRAFT	26.08.11

CONSULTANT
HASSELL LIMITED ACN 007 711 435
88 CUMBERLAND STREET
SYDNEY NSW 2000 AUSTRALIA
SYDNEY@HASSELL.COM.AU
T 61 2 9273 2300 F 61 2 9273 2345


HASSELL
PROJECT
ILLAWARRA ELECTIVE SURGERY
WOLLONGONG HOSPITAL
WOLLONGONG, NSW

DRAWING TITLE
ELEVATION SHEET 2


STATUS				
DEVELOPMENT APPROVAL				
SCALE @ A1	DRAWN	CO-ORD	REVIEWED	APPROVED
1:250	--	LvE	CC	
PROJECT NUMBER	DRAWING NUMBER	REV		
AX003042	IESS - DA 201	B		

EXISTING
BLOCK A LEVELS

- ▽ FFL 81.380
EXISTING LEVEL 10
- ▽ FFL 77.570
EXISTING LEVEL 9
- ▽ FFL 73.760
EXISTING LEVEL 8
- ▽ FFL 69.950
EXISTING LEVEL 7
- ▽ FFL 66.140
EXISTING LEVEL 6
- ▽ FFL 62.330
EXISTING LEVEL 5
- ▽ FFL 58.520
EXISTING LEVEL 4
- ▽ FFL 54.670
EXISTING LEVEL 3
- ▽ FFL 50.830
EXISTING LEVEL 2
- ▽ FFL 46.610
EXISTING LEVEL 1
- ▽ FFL 41.610
EXISTING LEVEL 0

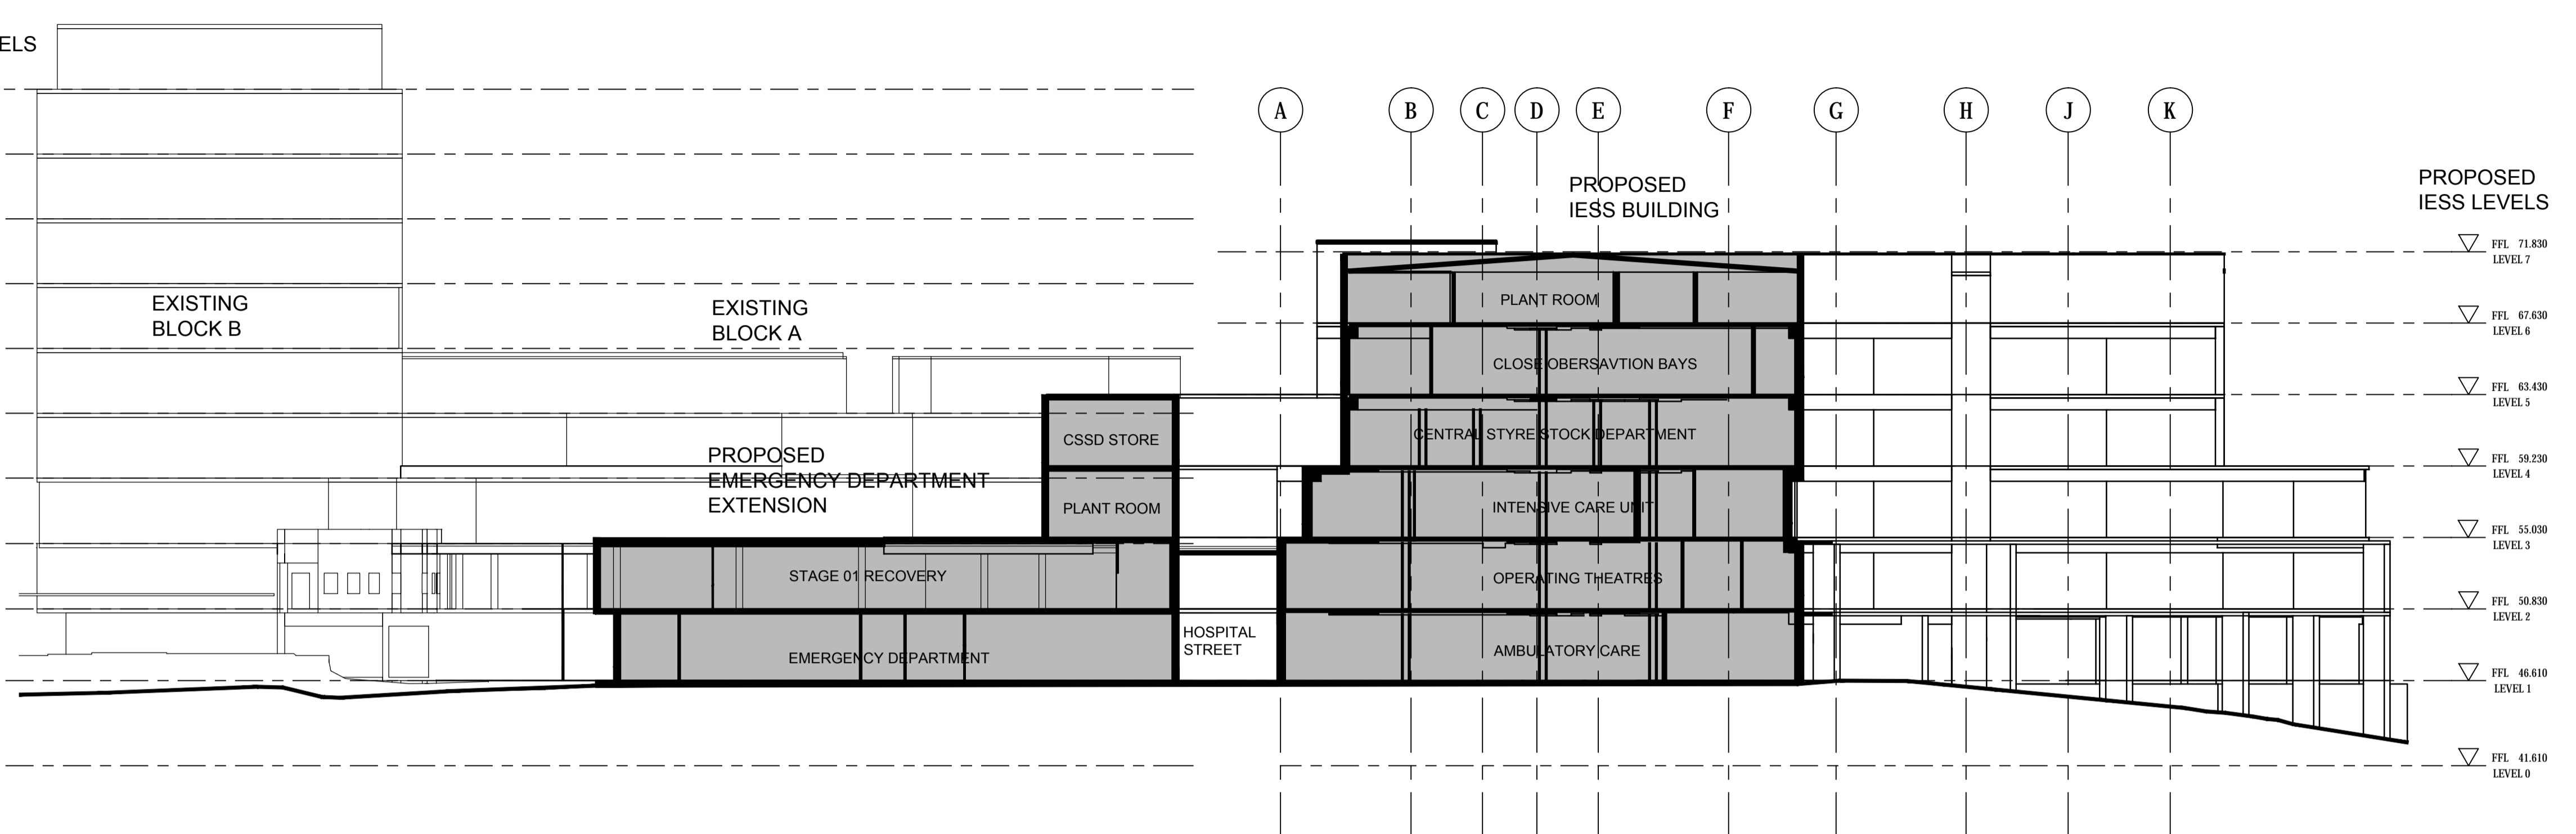

PROPOSED WORKS

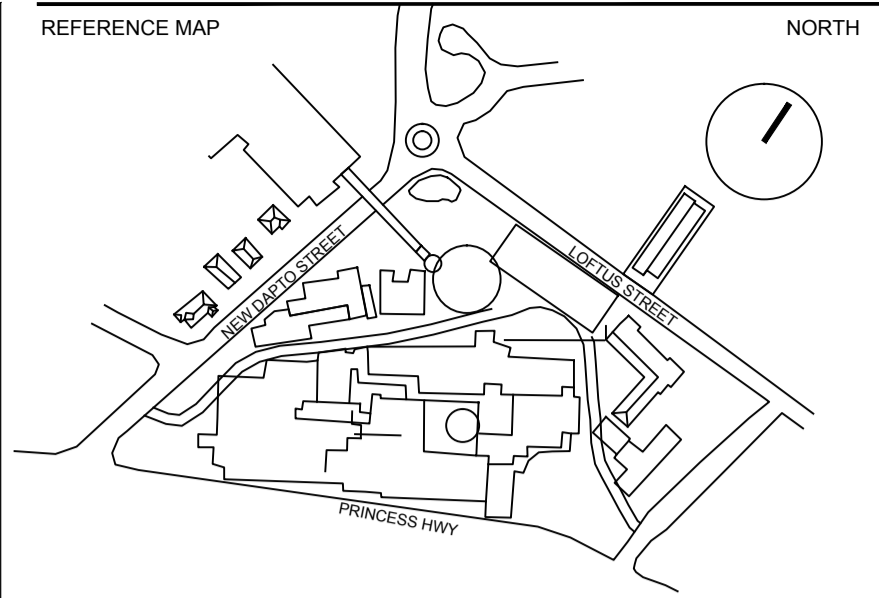


- NOTES
- DO NOT SCALE DRAWINGS. WRITTEN DIMENSIONS GOVERN.
 - ALL DIMENSIONS ARE IN MILLIMETRES UNLESS NOTED OTHERWISE.
 - ALL DIMENSIONS SHALL BE VERIFIED ON SITE BEFORE PROCEEDING WITH THE WORK. HASSELL SHALL BE NOTIFIED IN WRITING OF ANY DISCREPANCIES.
 - THIS DRAWING MUST BE READ IN CONJUNCTION WITH ALL RELEVANT CONTRACTS, SPECIFICATIONS AND DRAWINGS.

© COPYRIGHT OF THIS DRAWING IS VESTED IN HASSELL. LTD.
2010 HASSELL. LTD.

THIS DRAWING IS AN UNCONTROLLED COPY, UNLESS NOTED OTHERWISE.

SECTION A-A

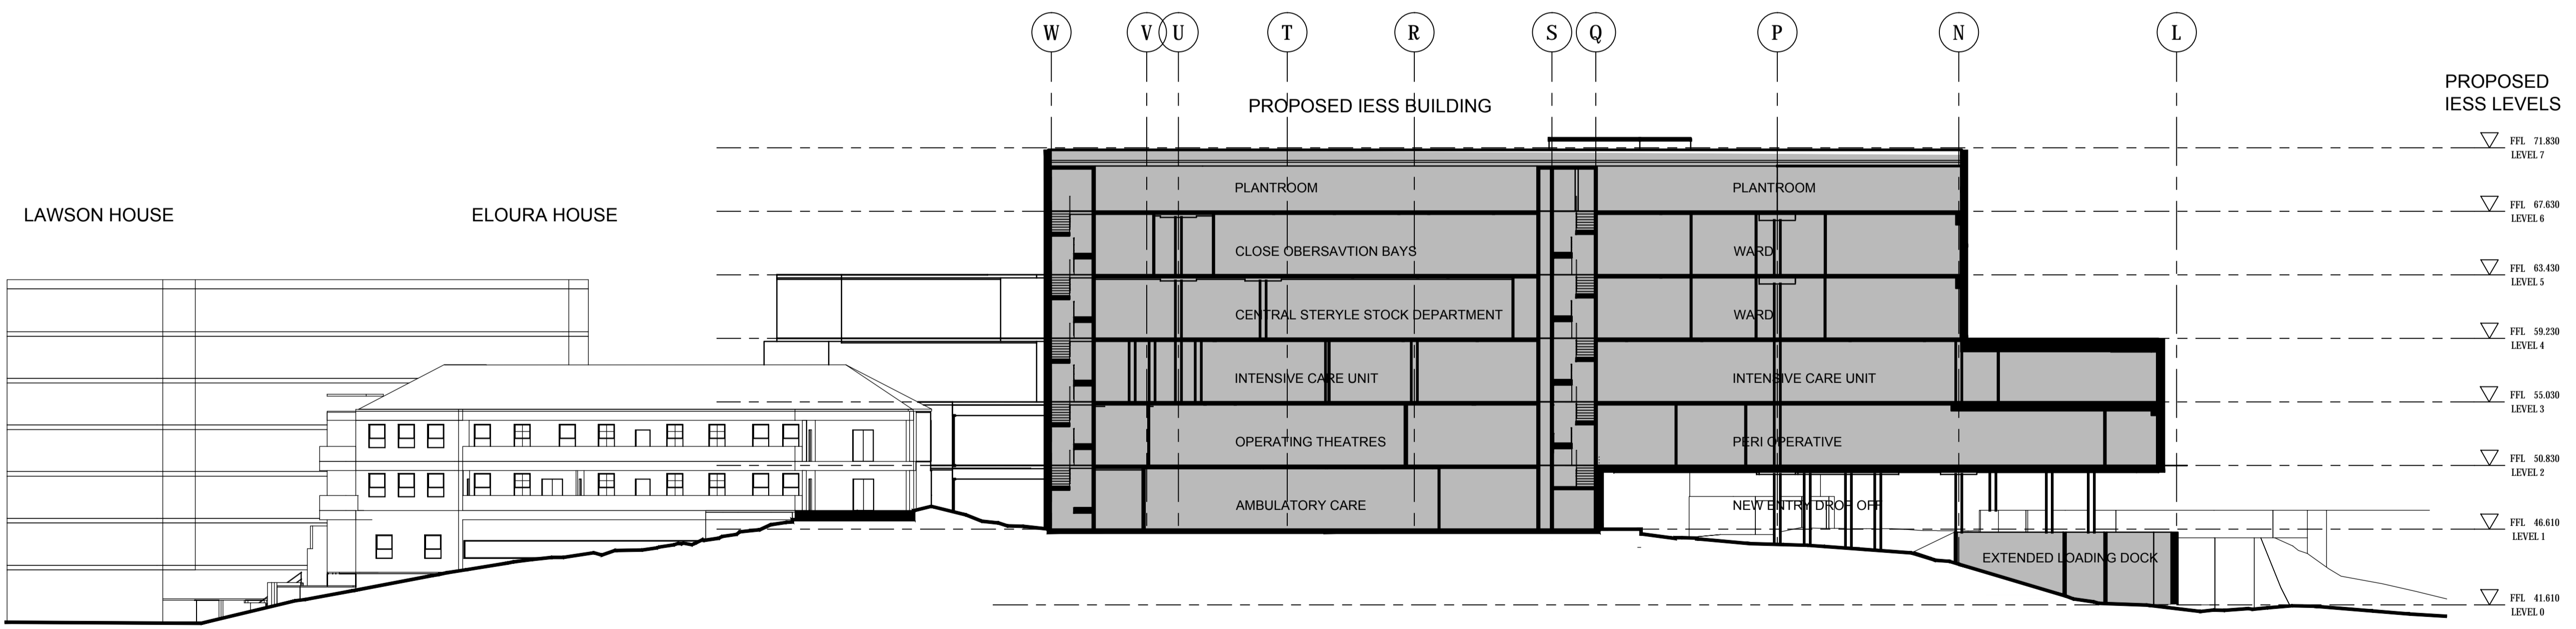

PROPOSED
IESS LEVELS

- ▽ FFL 71.830
LEVEL 7
- ▽ FFL 67.630
LEVEL 6
- ▽ FFL 63.430
LEVEL 5
- ▽ FFL 59.230
LEVEL 4
- ▽ FFL 55.030
LEVEL 3
- ▽ FFL 50.830
LEVEL 2
- ▽ FFL 46.610
LEVEL 1
- ▽ FFL 41.610
LEVEL 0

SECTION B-B

B	DA SUBMISSION	02.09.11
A	DA DRAFT	26.08.11
REV	DESCRIPTION	DATE

CONSULTANT
HASSELL LIMITED ACN 007 711 435
88 CUMBERLAND STREET
SYDNEY NSW 2000 AUSTRALIA
SYDNEY@HASSELL.COM.AU
T 61 2 9273 2300 F 61 2 9273 2345

HASSELL

PROJECT
ILLAWARRA ELECTIVE SURGERY
WOLLONGONG HOSPITAL
WOLLONGONG, NSW

DRAWING TITLE
SECTION - SHEET 1

STATUS

DEVELOPMENT APPROVAL

SCALE @ A1	DRAWN	CO-ORD	REVIEWED	APPROVED
1:250	--	LvE	CC	
PROJECT NUMBER	DRAWING NUMBER	REV		
AX003042	IESS - DA 220	B		

EXISTING
BLOCK A LEVELS

- ▽ FFL 81.380
EXISTING LEVEL 10
- ▽ FFL 77.570
EXISTING LEVEL 9
- ▽ FFL 73.760
EXISTING LEVEL 8
- ▽ FFL 69.950
EXISTING LEVEL 7
- ▽ FFL 66.140
EXISTING LEVEL 6
- ▽ FFL 62.330
EXISTING LEVEL 5
- ▽ FFL 58.520
EXISTING LEVEL 4
- ▽ FFL 54.670
EXISTING LEVEL 3
- ▽ FFL 50.830
EXISTING LEVEL 2

EXISTING
BLOCK B

EXISTING
BLOCK A

HOSPITAL
STREET

PROPOSED IESS BUILDING

PLANT ROOM

WARD

WARD

INTENSIVE CARE UNIT

OPERATING THEATRES


AMBULATORY CARE

PROPOSED WORKS

PROPOSED
IESS LEVELS

- ▽ FFL 71.830
- ▽ 67.630
LEVEL 6
- ▽ 63.430
LEVEL 5
- ▽ FFL LEVEL 4
- ▽ 55.030
LEVEL 3
- ▽ 50.830
LEVEL 2
- ▽ FFL 46.610
LEVEL 1
- ▽ FFL 41.610
LEVEL 0

SECTION C-C

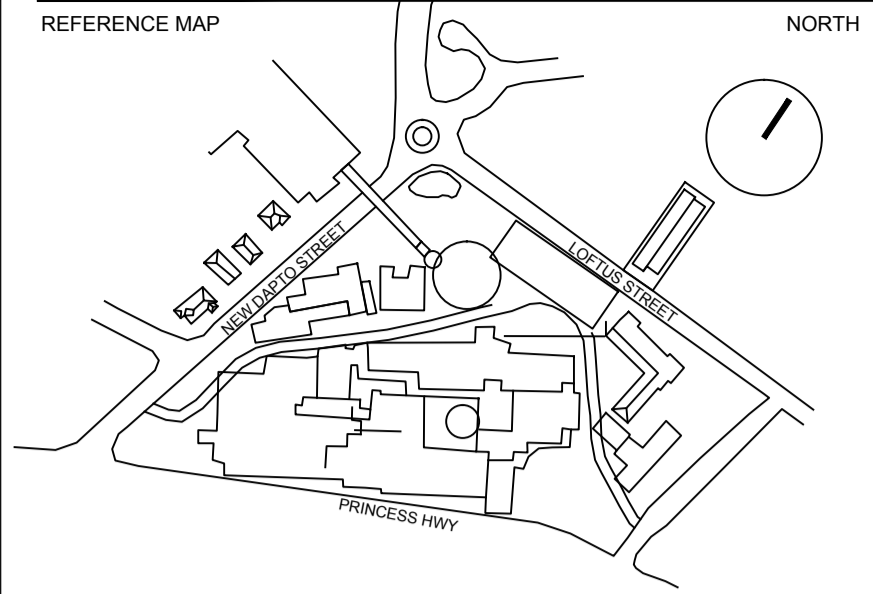

- NOTES
- DO NOT SCALE DRAWINGS. WRITTEN DIMENSIONS GOVERN.
 - ALL DIMENSIONS ARE IN MILLIMETRES UNLESS NOTED OTHERWISE.
 - ALL DIMENSIONS SHALL BE VERIFIED ON SITE BEFORE PROCEEDING WITH THE WORK. HASSELL SHALL BE NOTIFIED IN WRITING OF ANY DISCREPANCIES.
 - THIS DRAWING MUST BE READ IN CONJUNCTION WITH ALL RELEVANT CONTRACTS, SPECIFICATIONS AND DRAWINGS.

© COPYRIGHT OF THIS DRAWING IS VESTED IN HASSELL. LTD.
2010 HASSELL. LTD.

THIS DRAWING IS AN UNCONTROLLED COPY, UNLESS NOTED OTHERWISE.

B	DA SUBMISSION	02.09.11
A	DA DRAFT	26.08.11
REV	DESCRIPTION	DATE

CONSULTANT
HASSELL LIMITED ACN 007 711 435
88 CUMBERLAND STREET
SYDNEY NSW 2000 AUSTRALIA
SYDNEY@HASSELL.COM.AU
T 61 2 9273 2300 F 61 2 9273 2345


HASSELL

PROJECT
ILLAWARRA ELECTIVE SURGERY
WOLLONGONG HOSPITAL
WOLLONGONG, NSW


DRAWING TITLE
SECTION - SHEET 2

STATUS
DEVELOPMENT APPROVAL


SCALE @ A1	DRAWN	CO-ORD	REVIEWED	APPROVED
1:250	--	LvE	CC	
PROJECT NUMBER	DRAWING NUMBER	REV		
AX003042	IESS - DA 221	B		

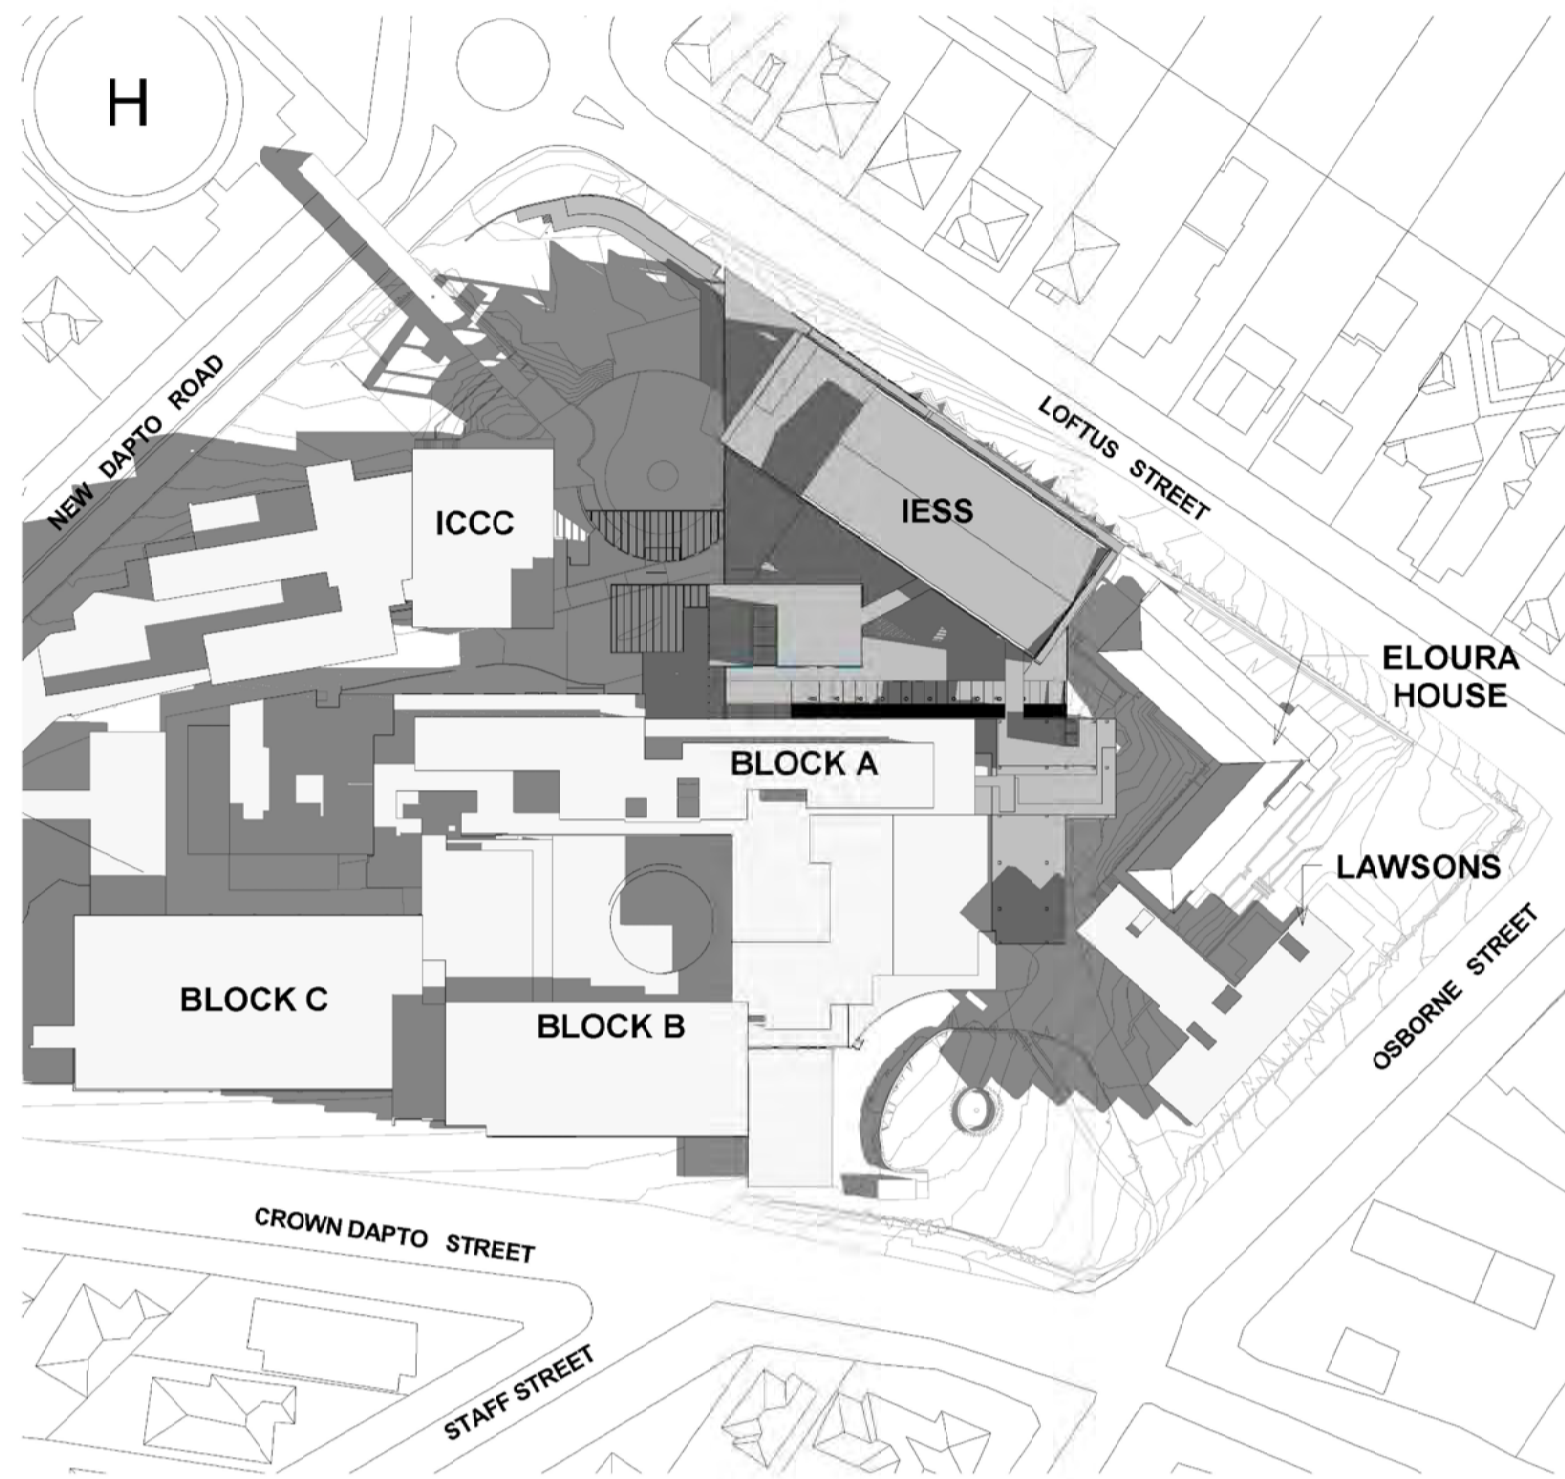


1 SUN SHADOW DIAGRAMS -MARCH 9AM

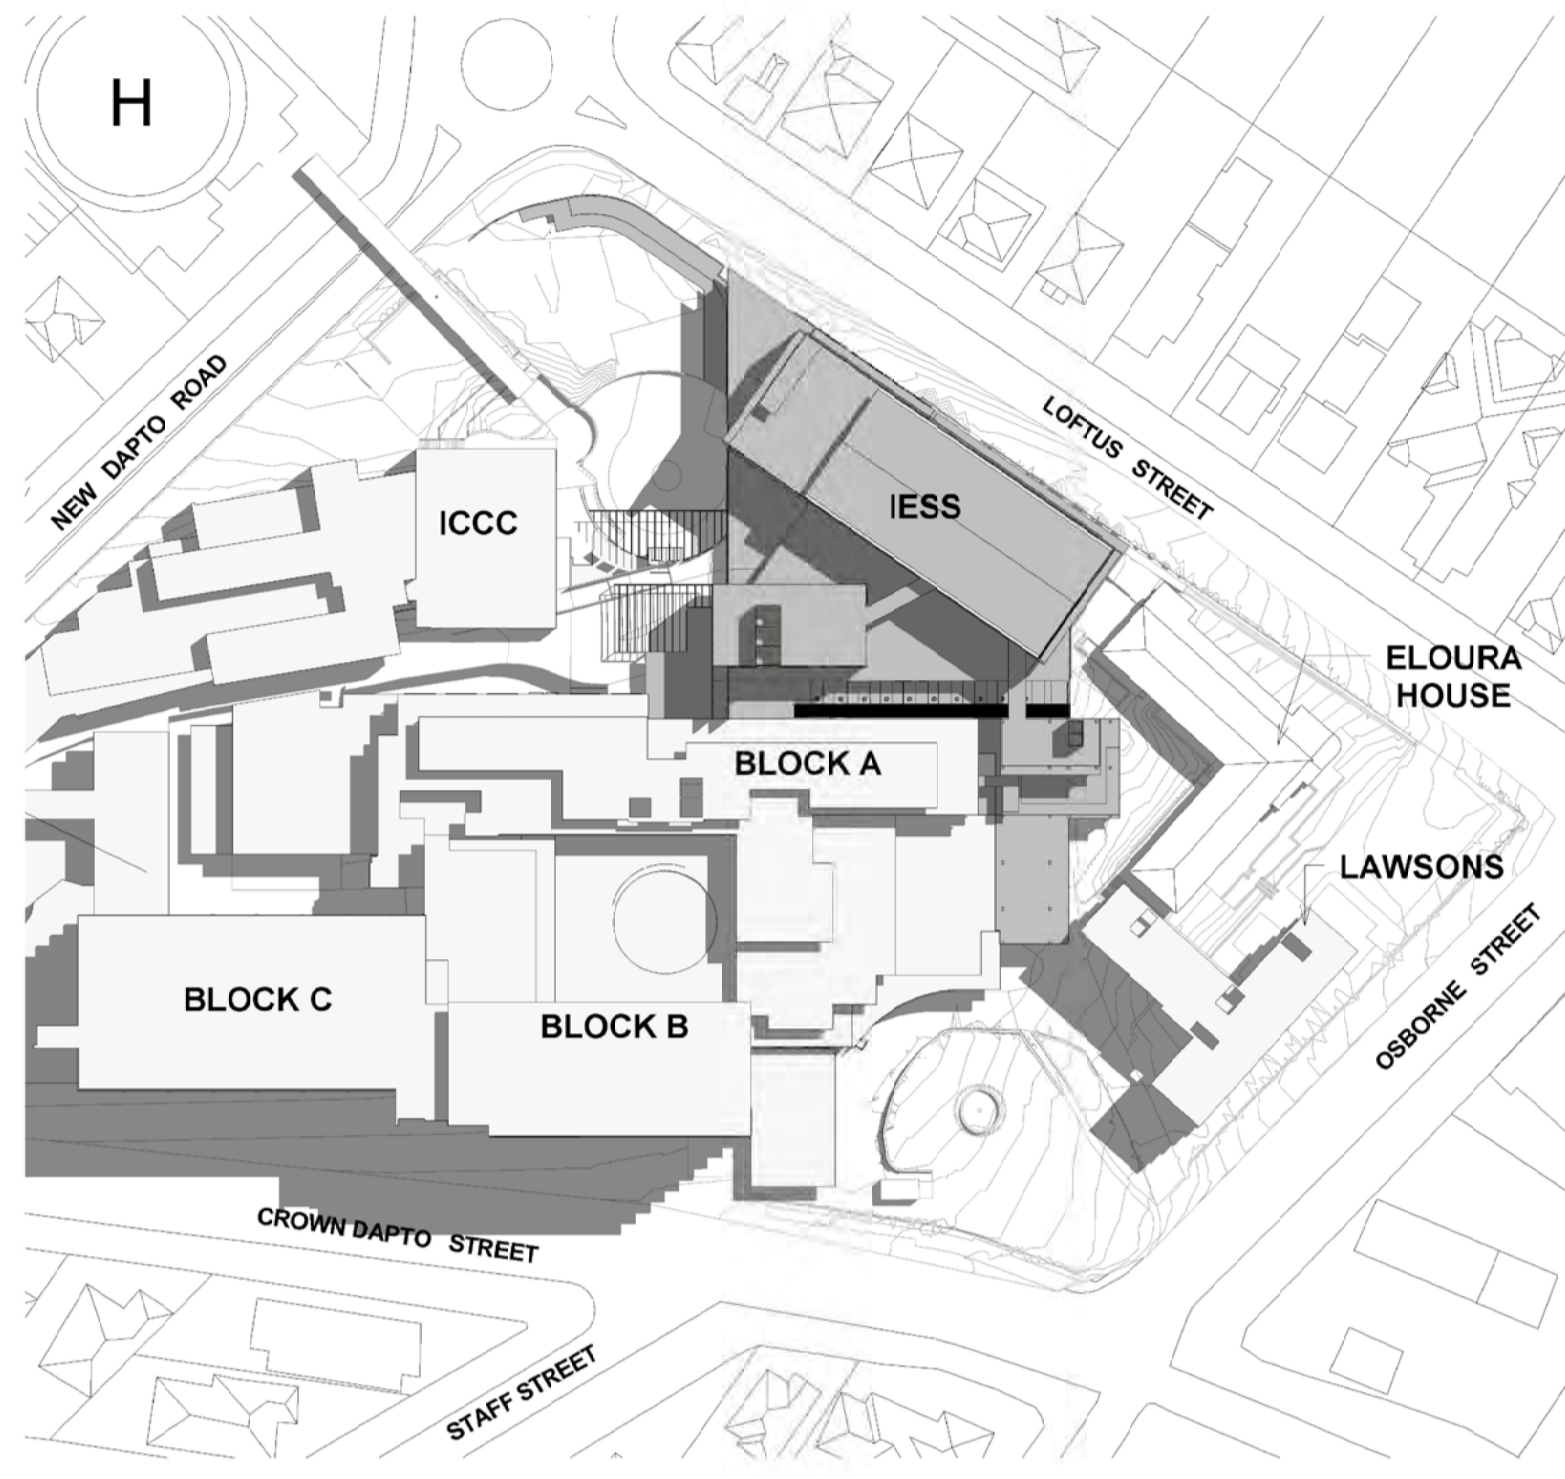


2 SUN SHADOW DIAGRAMS -MARCH 12PM

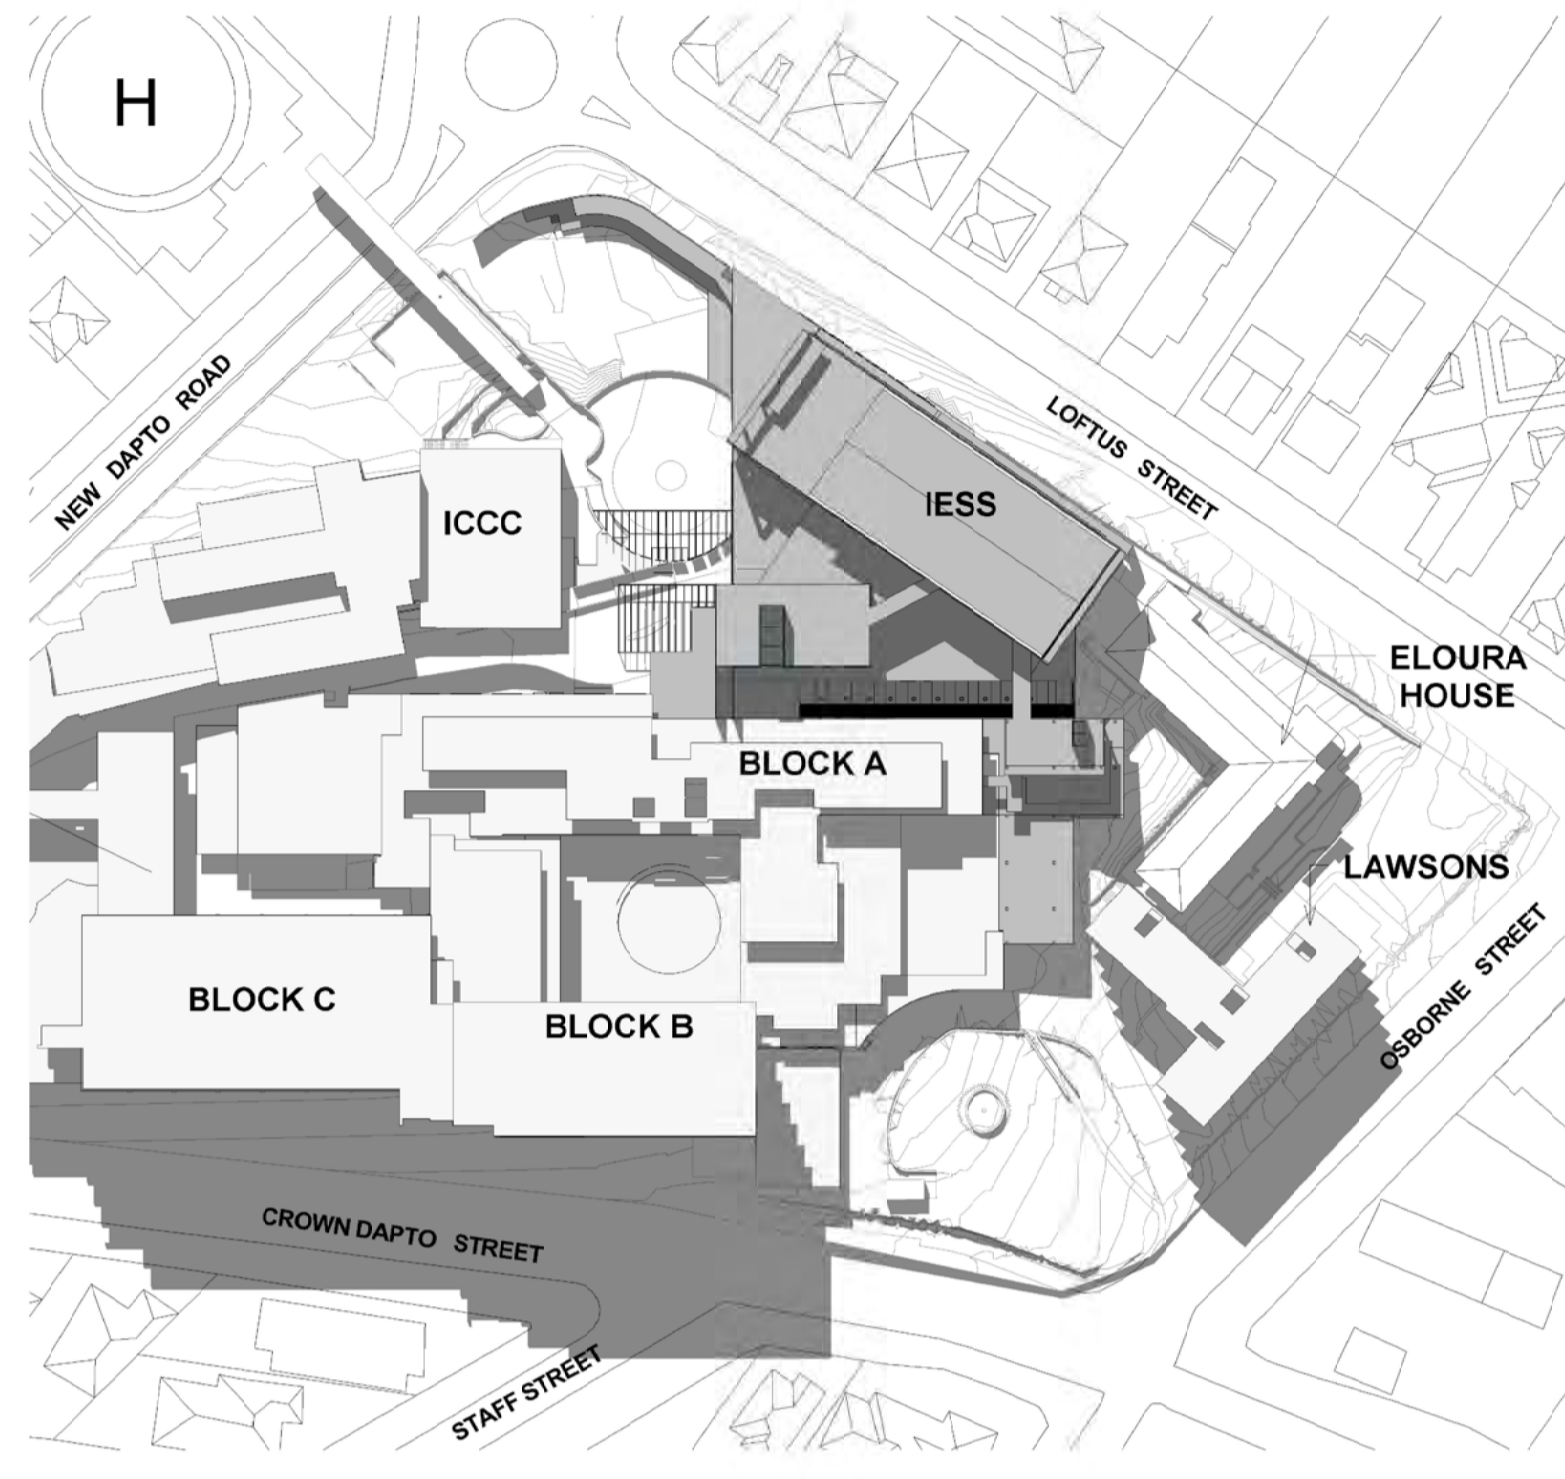


3 SUN SHADOW DIAGRAMS -MARCH 3PM

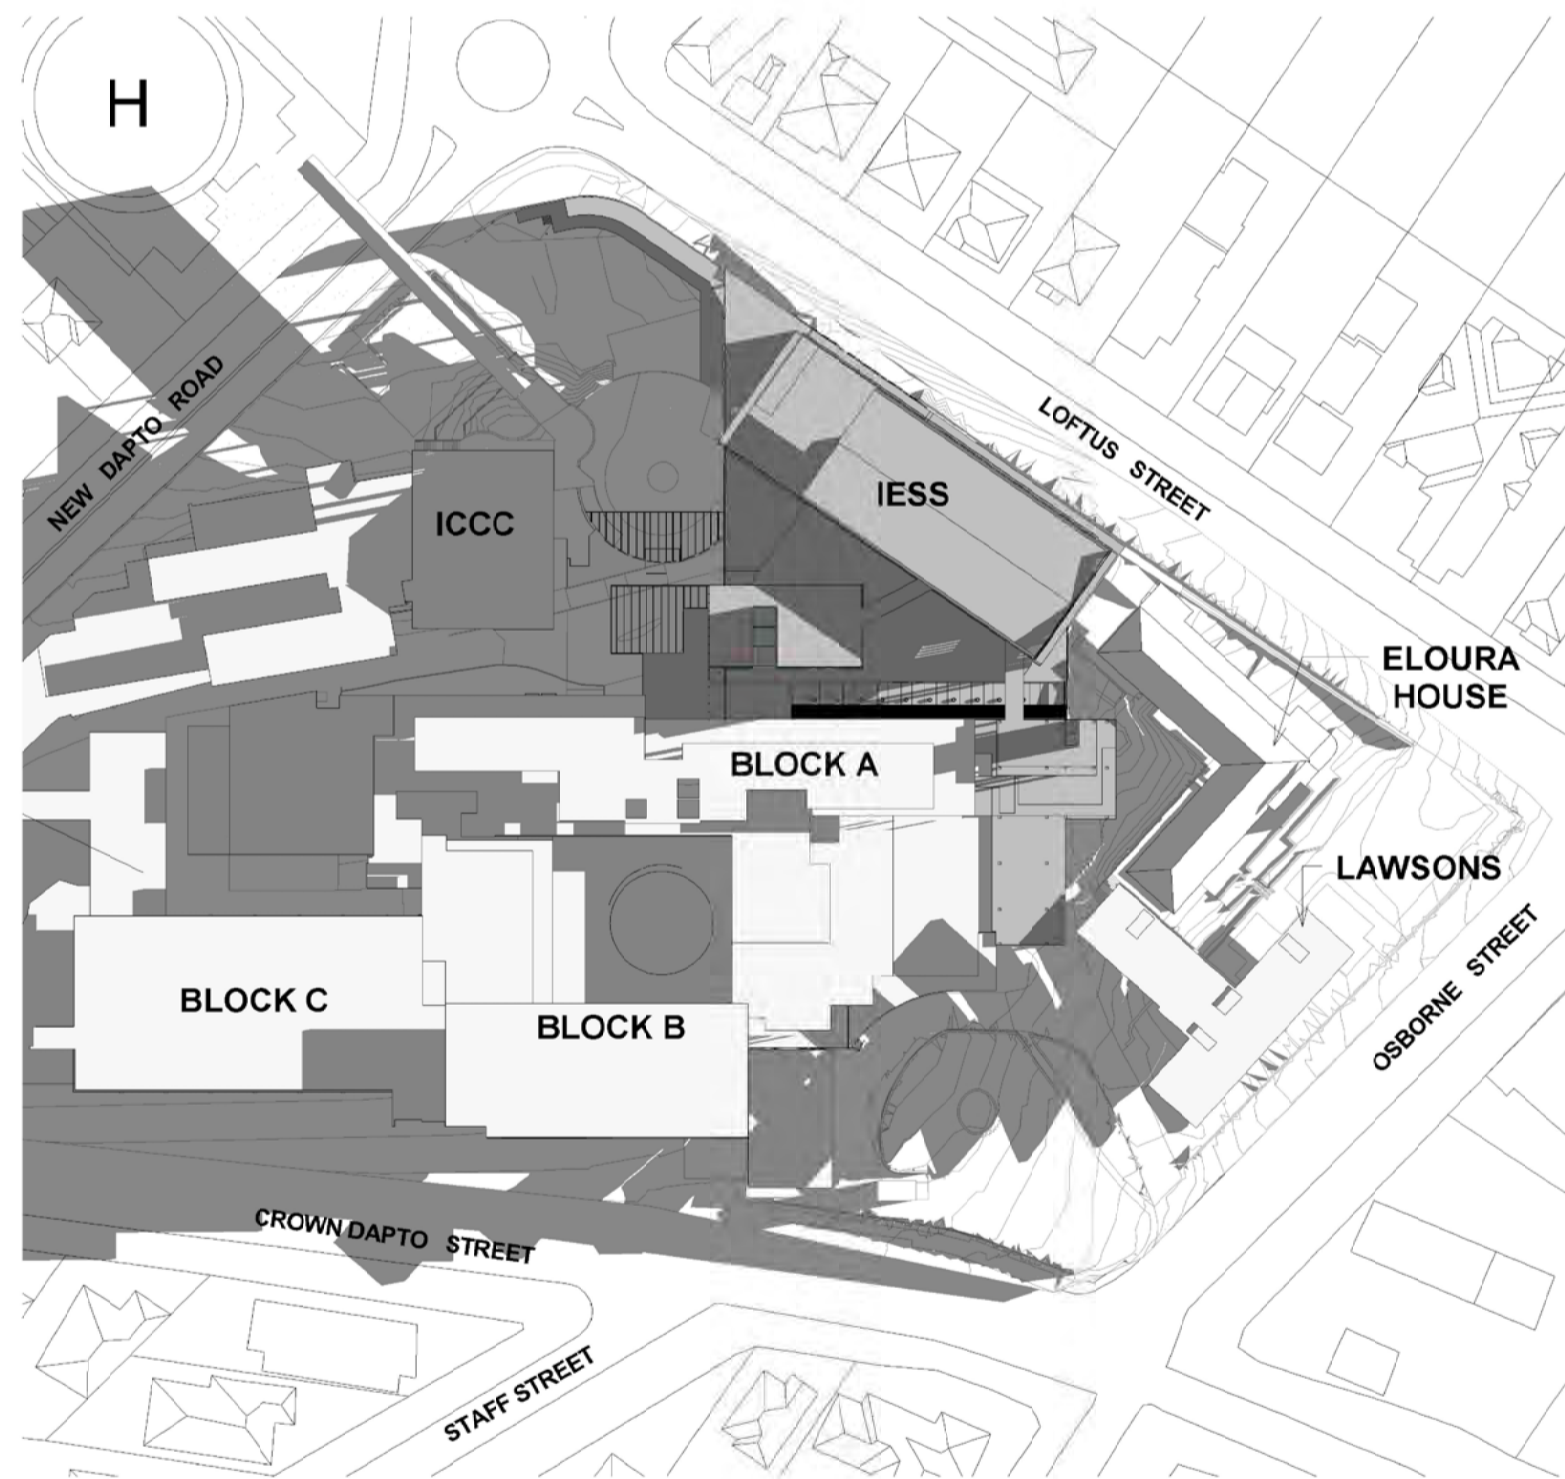


4 SUN SHADOW DIAGRAMS -JUNE 9AM

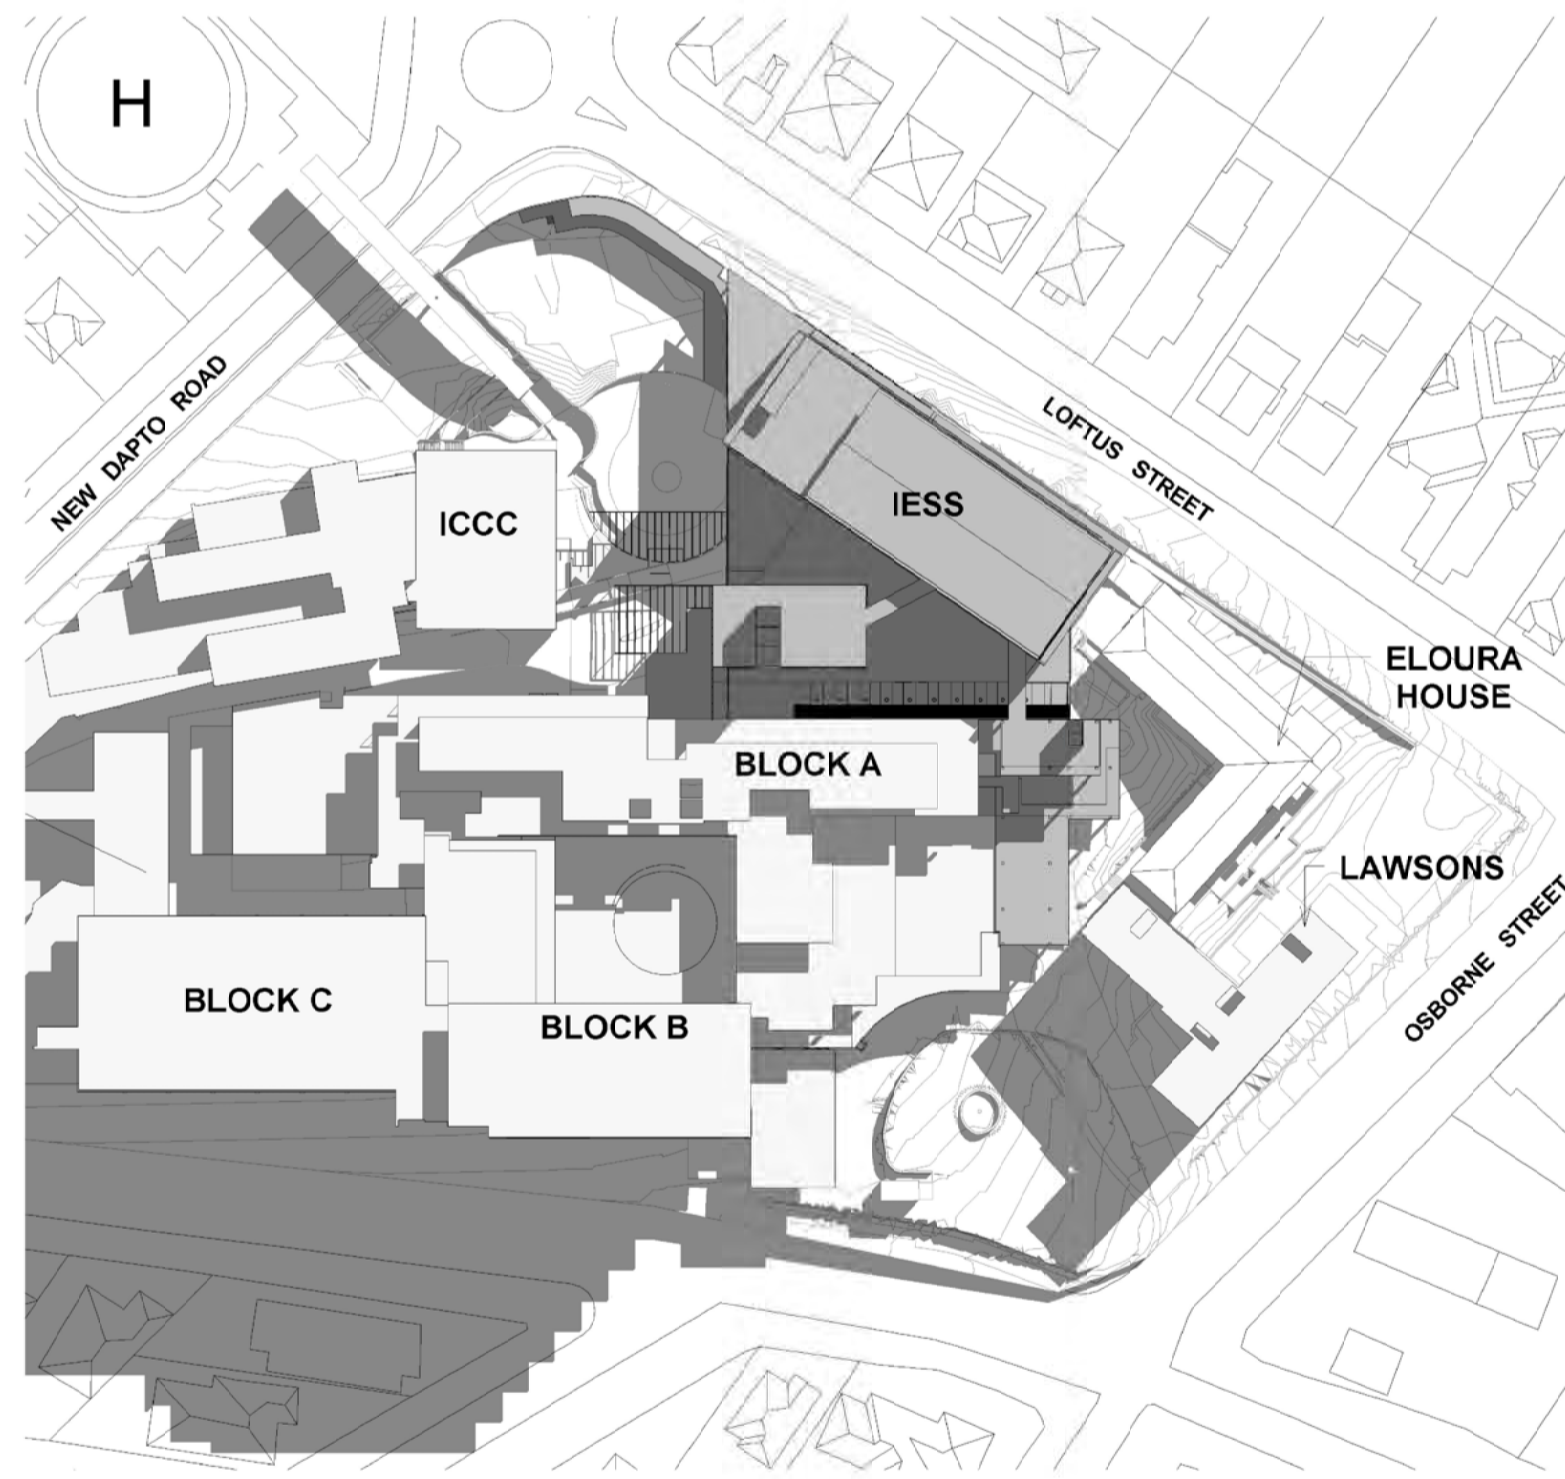

5 SUN SHADOW DIAGRAMS -JUNE 12PM

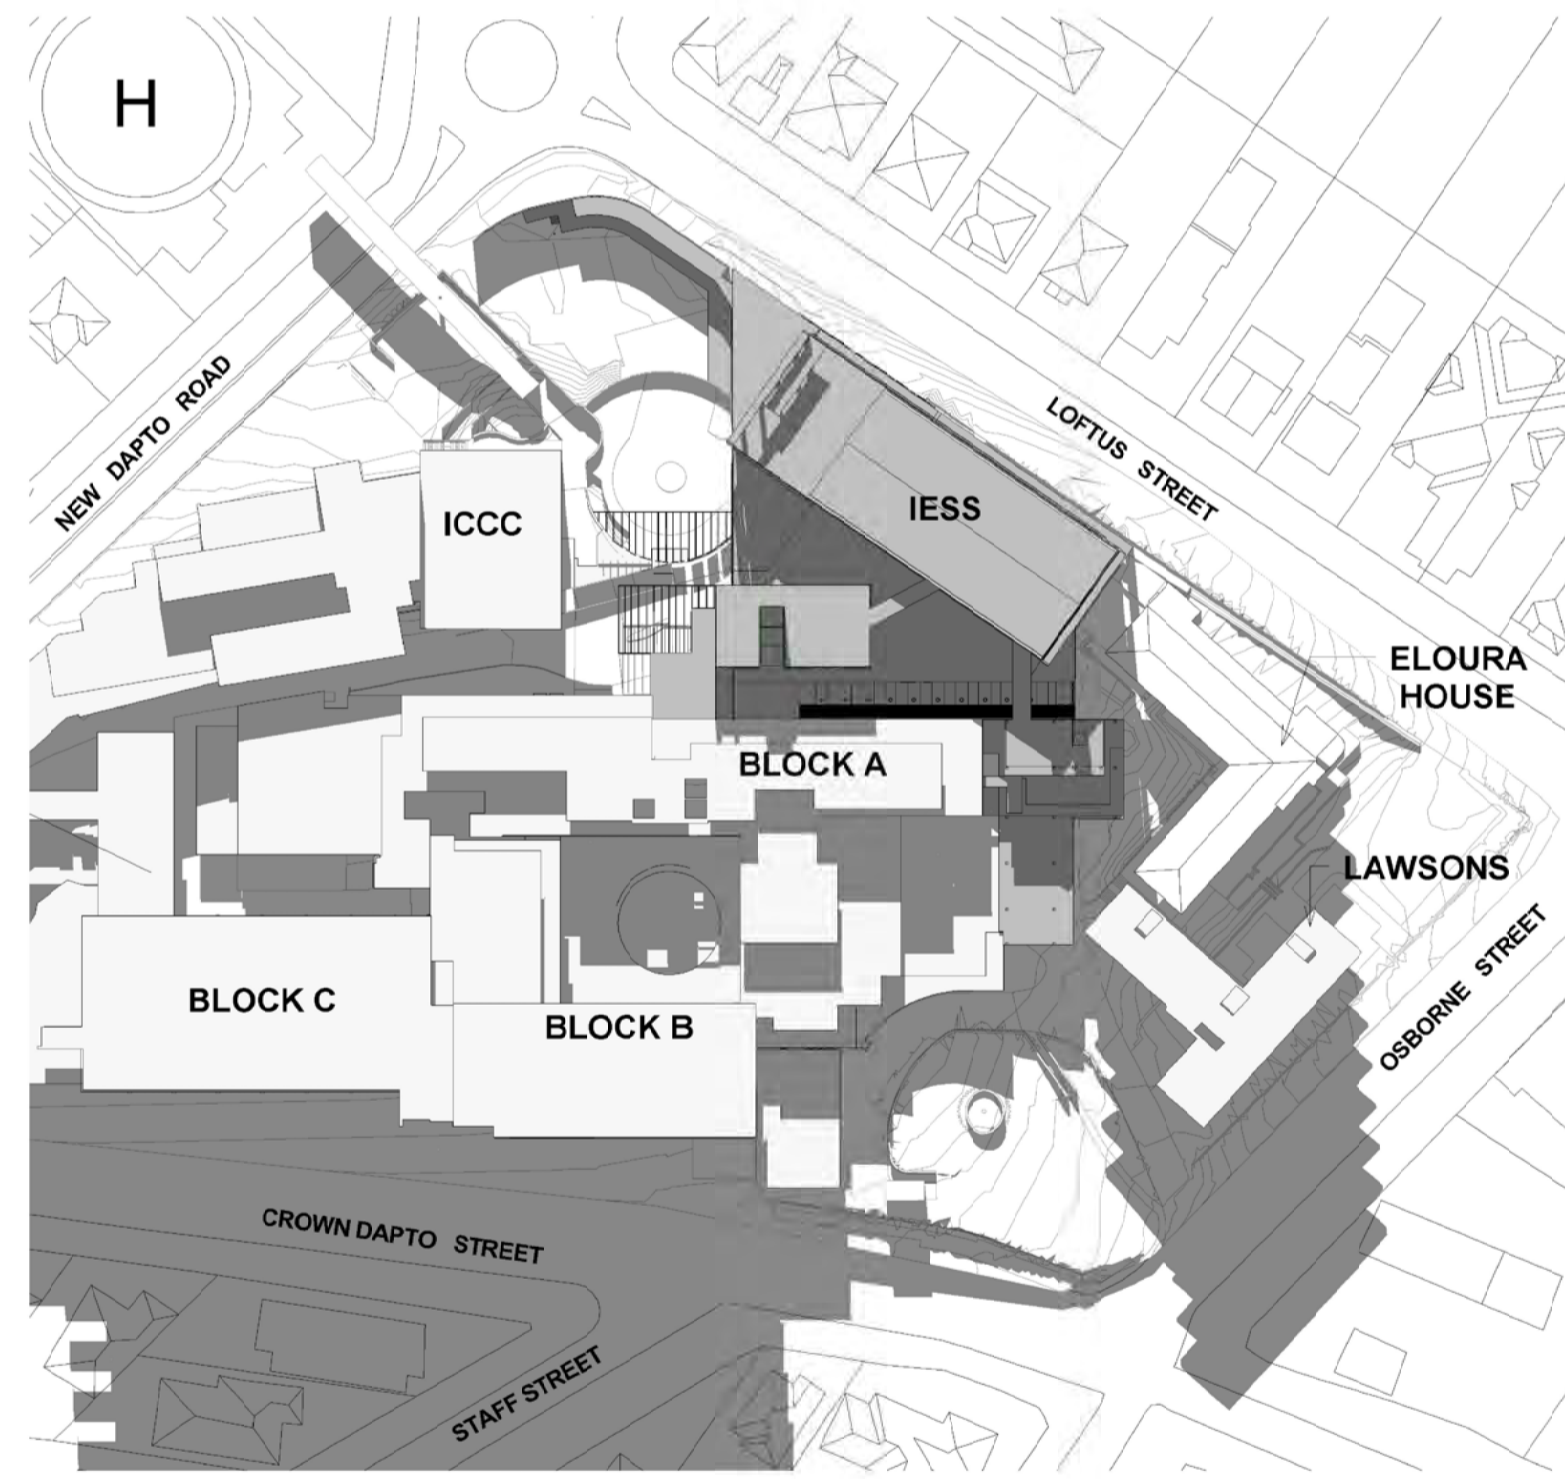

6 SUN SHADOW DIAGRAMS -JUNE 3PM

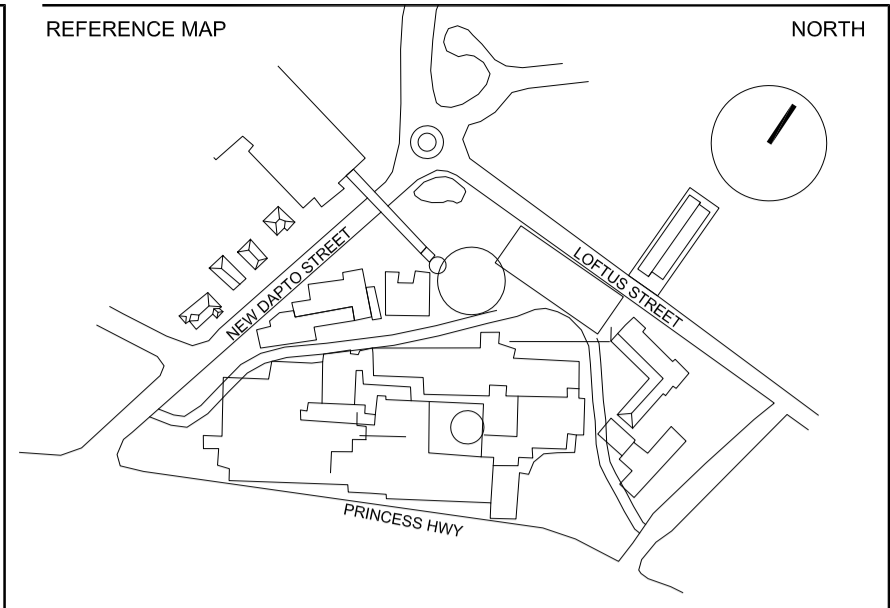

- NOTES
1. DO NOT SCALE DRAWINGS. WRITTEN DIMENSIONS GOVERN.
 2. ALL DIMENSIONS ARE IN MILLIMETRES UNLESS NOTED OTHERWISE.
 3. ALL DIMENSIONS SHALL BE VERIFIED ON SITE BEFORE PROCEEDING WITH THE WORK. HASSELL SHALL BE NOTIFIED IN WRITING OF ANY DISCREPANCIES.
 4. THIS DRAWING MUST BE READ IN CONJUNCTION WITH ALL RELEVANT CONTRACTS, SPECIFICATIONS AND DRAWINGS.

© COPYRIGHT OF THIS DRAWING IS VESTED IN HASSELL LTD.
2010 HASSELL LTD.

THIS DRAWING IS AN UNCONTROLLED COPY, UNLESS NOTED OTHERWISE.

C	DA SUBMISSION - UPDATE	13.09.11
B	DA SUBMISSION	02.09.11
A	DA DRAFT	26.08.11

REV	DESCRIPTION	DATE
-----	-------------	------

CONSULTANT
HASSELL LIMITED ACN 007 711 435
88 CUMBERLAND STREET
SYDNEY NSW 2000 AUSTRALIA
SYDNEY@HASSELL.COM.AU
T 61 2 9273 2300 F 61 2 9273 2345

HASSELL


PROJECT
ILLAWARRA ELECTIVE SURGERY
WOLLONGONG HOSPITAL
WOLLONGONG, NSW

DRAWING TITLE
SHADOW DIAGRAMS MARCH-JUNE


STATUS
DEVELOPMENT APPROVAL

SCALE @ A1	DRAWN	CO-ORD	REVIEWED	APPROVED
NTS	--	LvE	CC	


PROJECT NUMBER	DRAWING NUMBER	REV
AX003042	IESS - DA 350	C

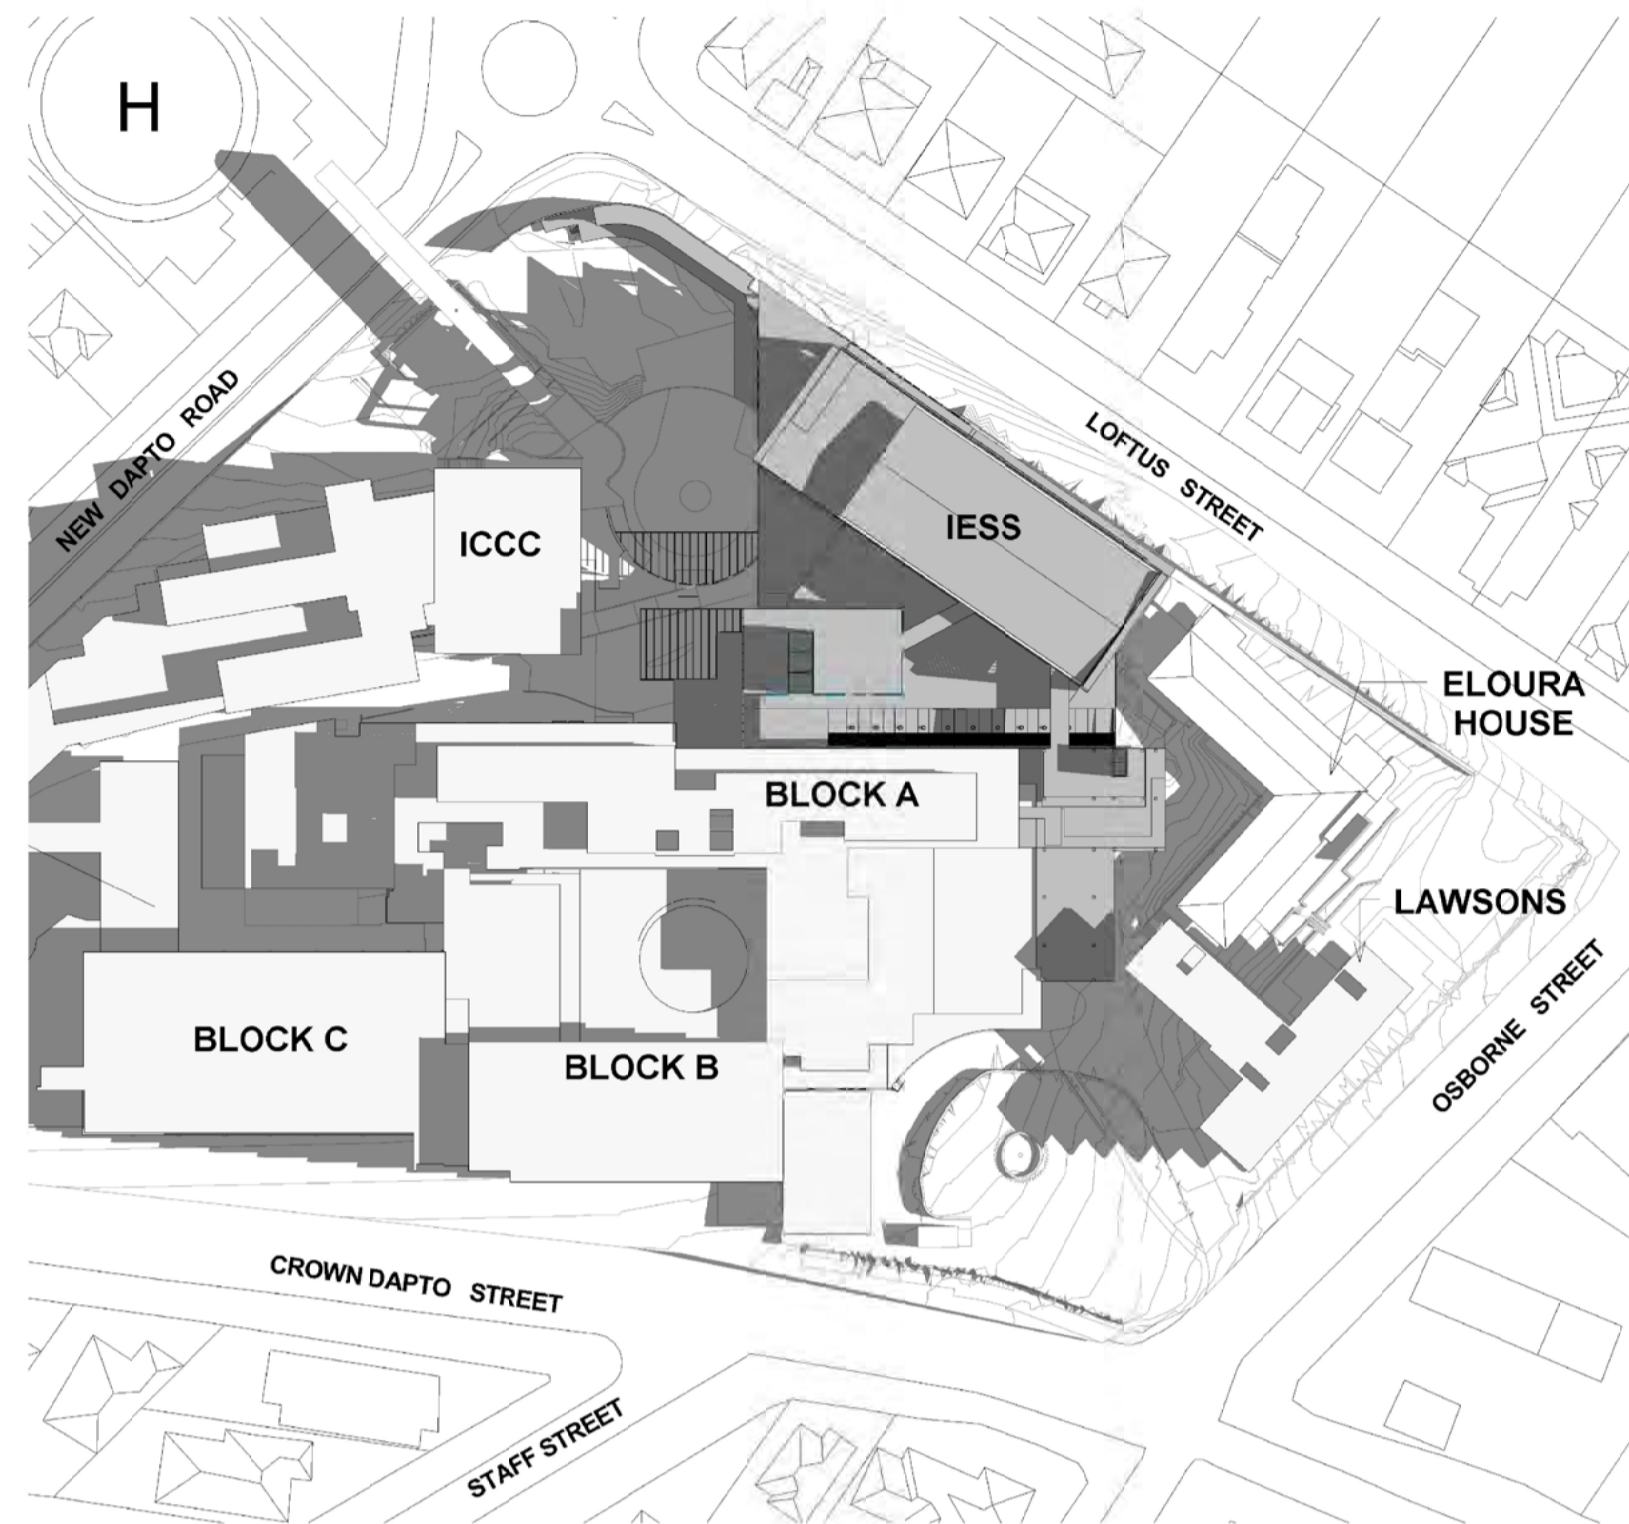


1 SUN SHADOW DIAGRAMS -SEPT 9AM

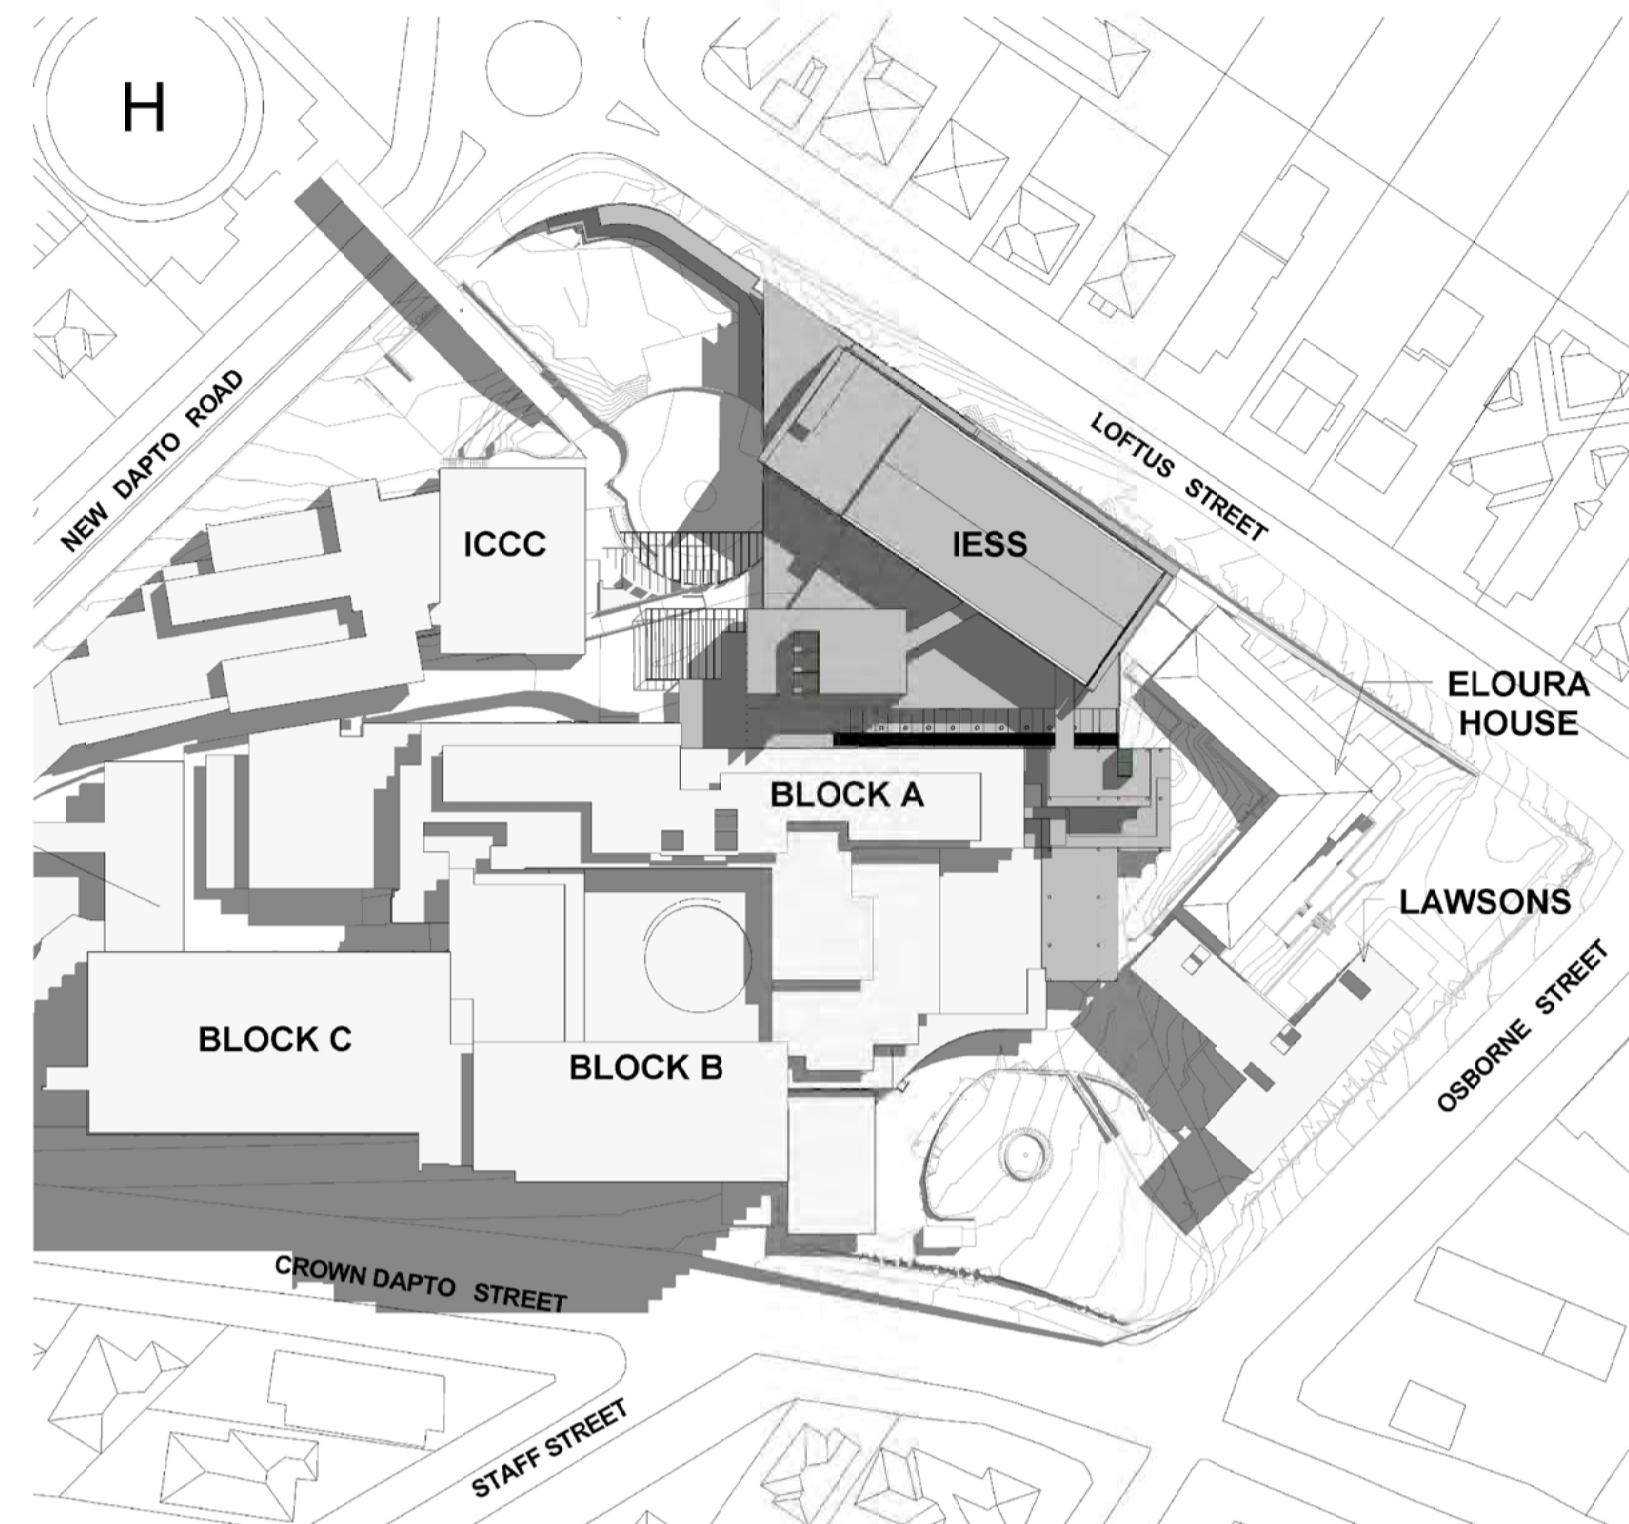


2 SUN SHADOW DIAGRAMS -SEPT 12PM

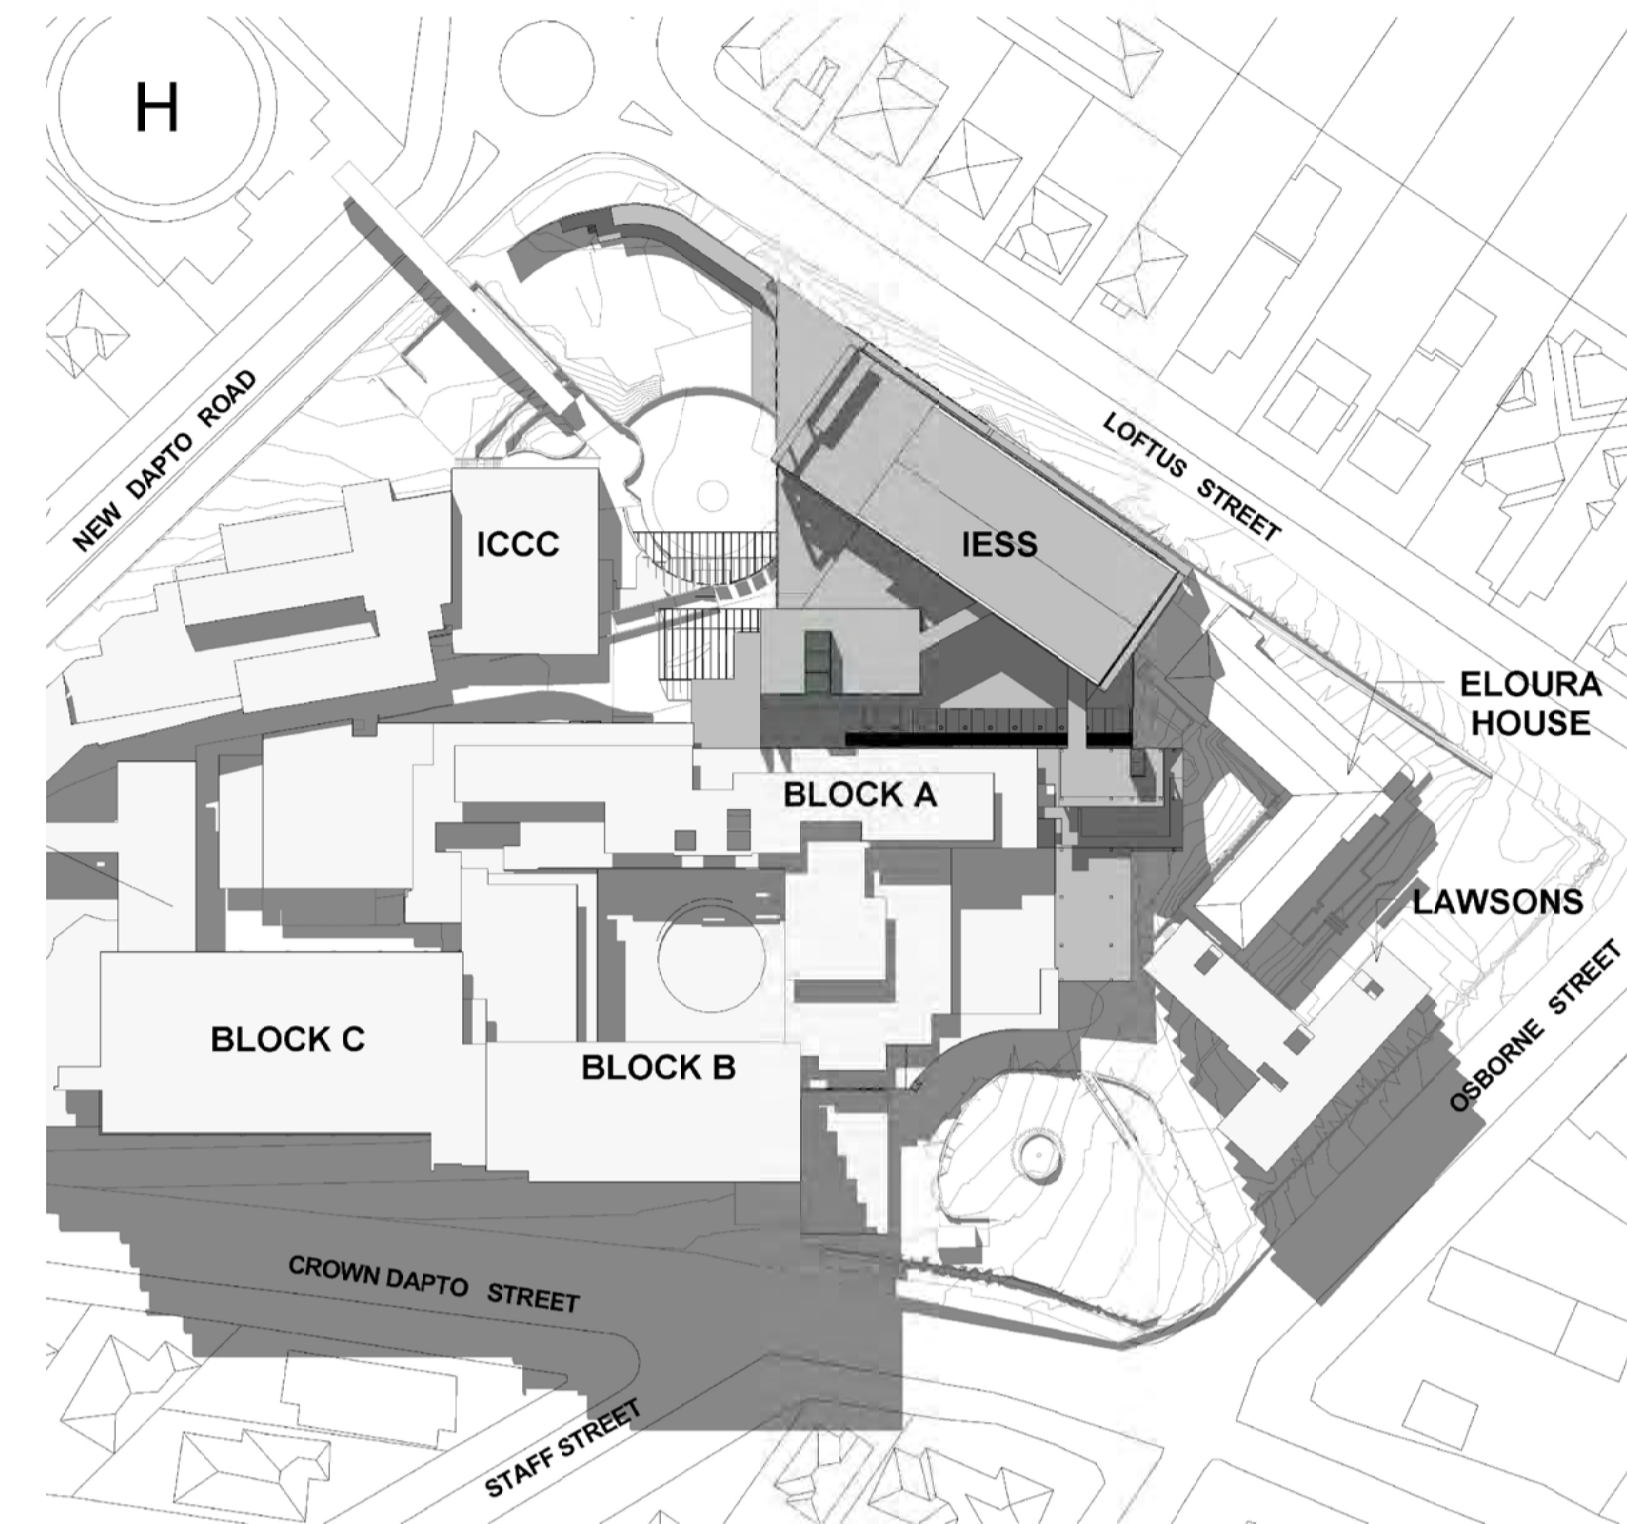


3 SUN SHADOW DIAGRAMS -SEPT 3PM

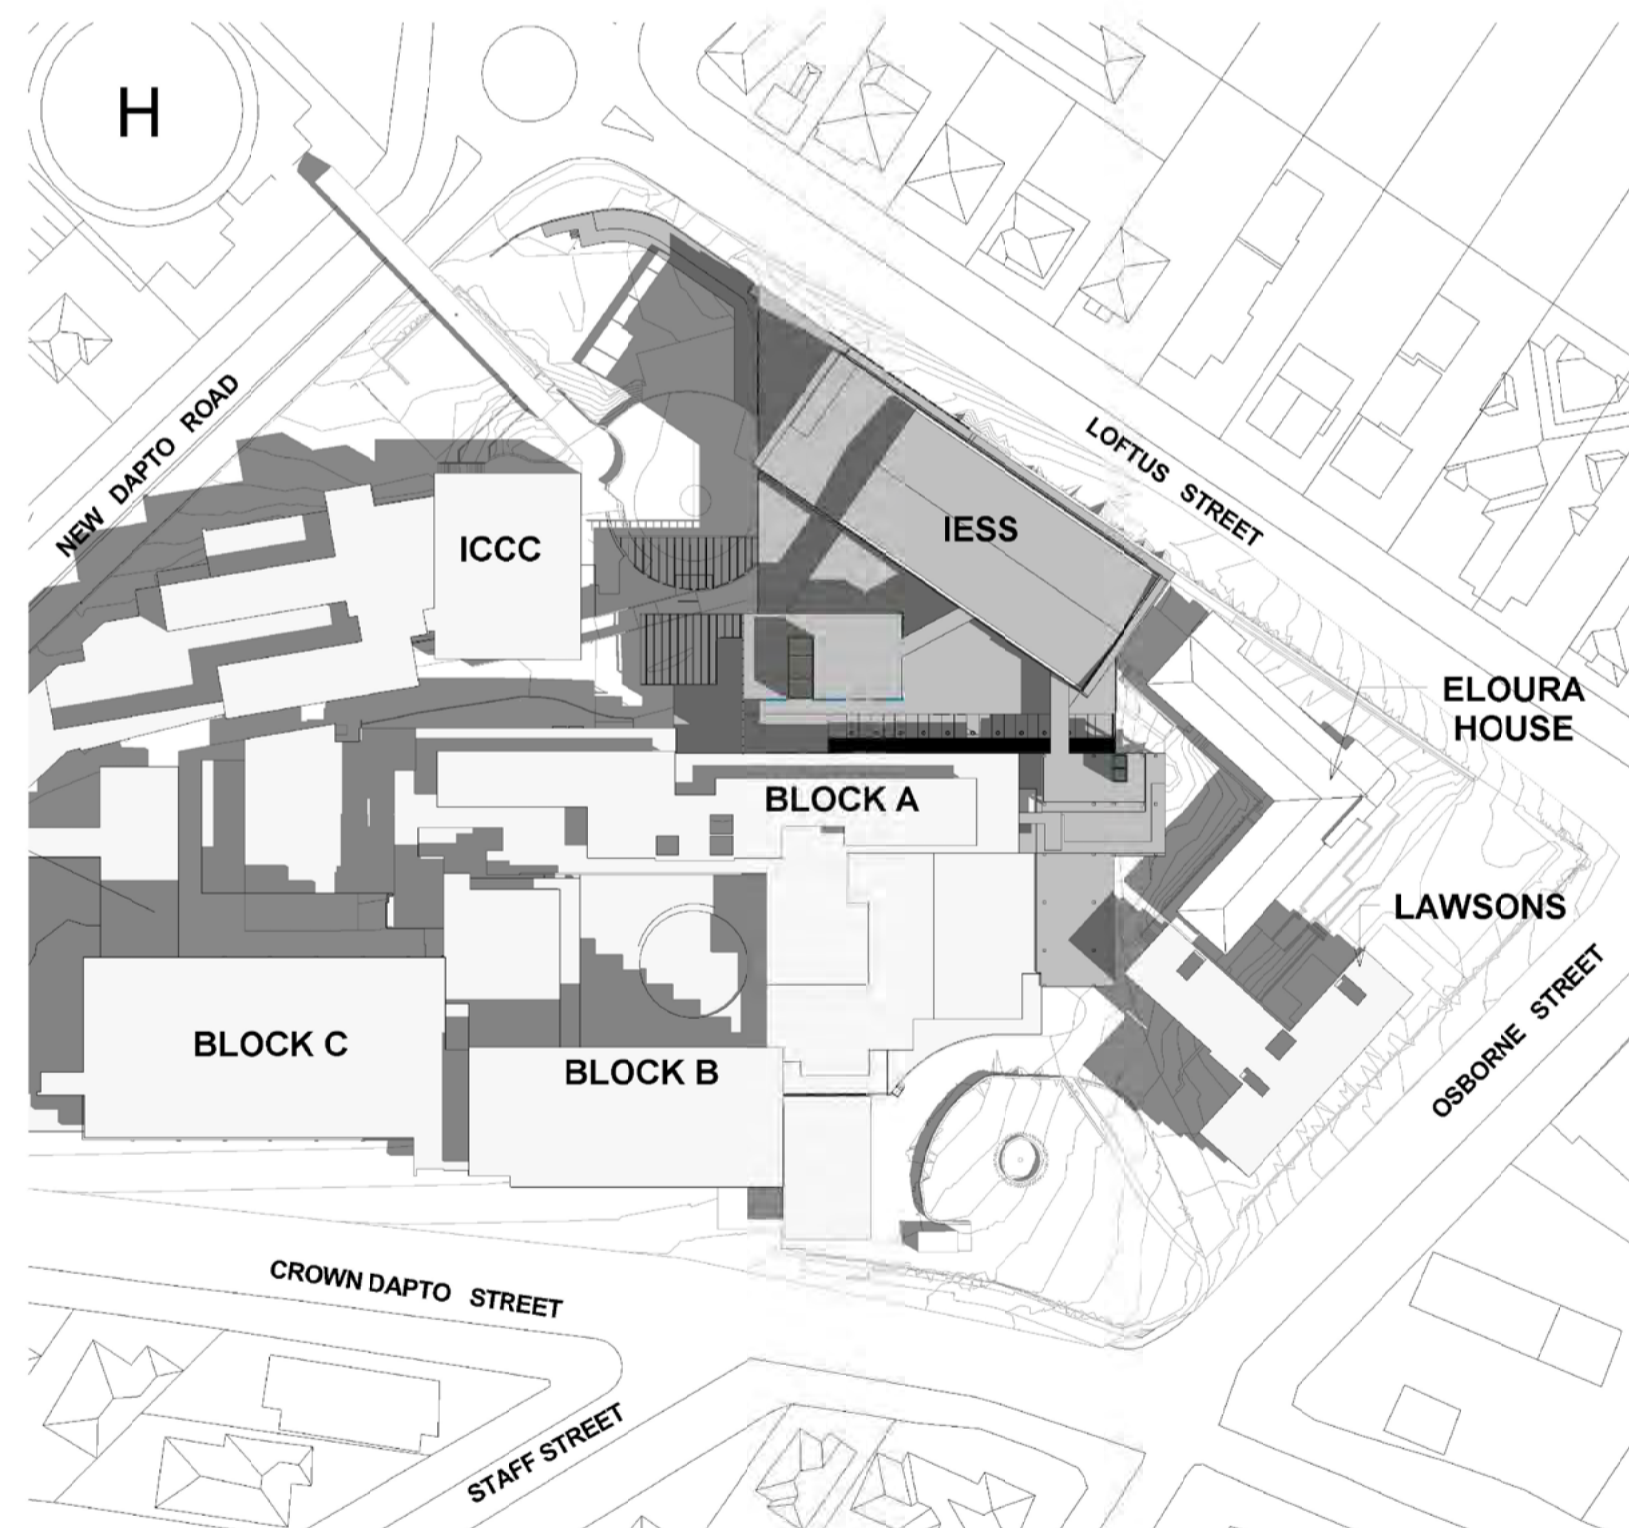


4 SUN SHADOW DIAGRAMS - DEC 9AM

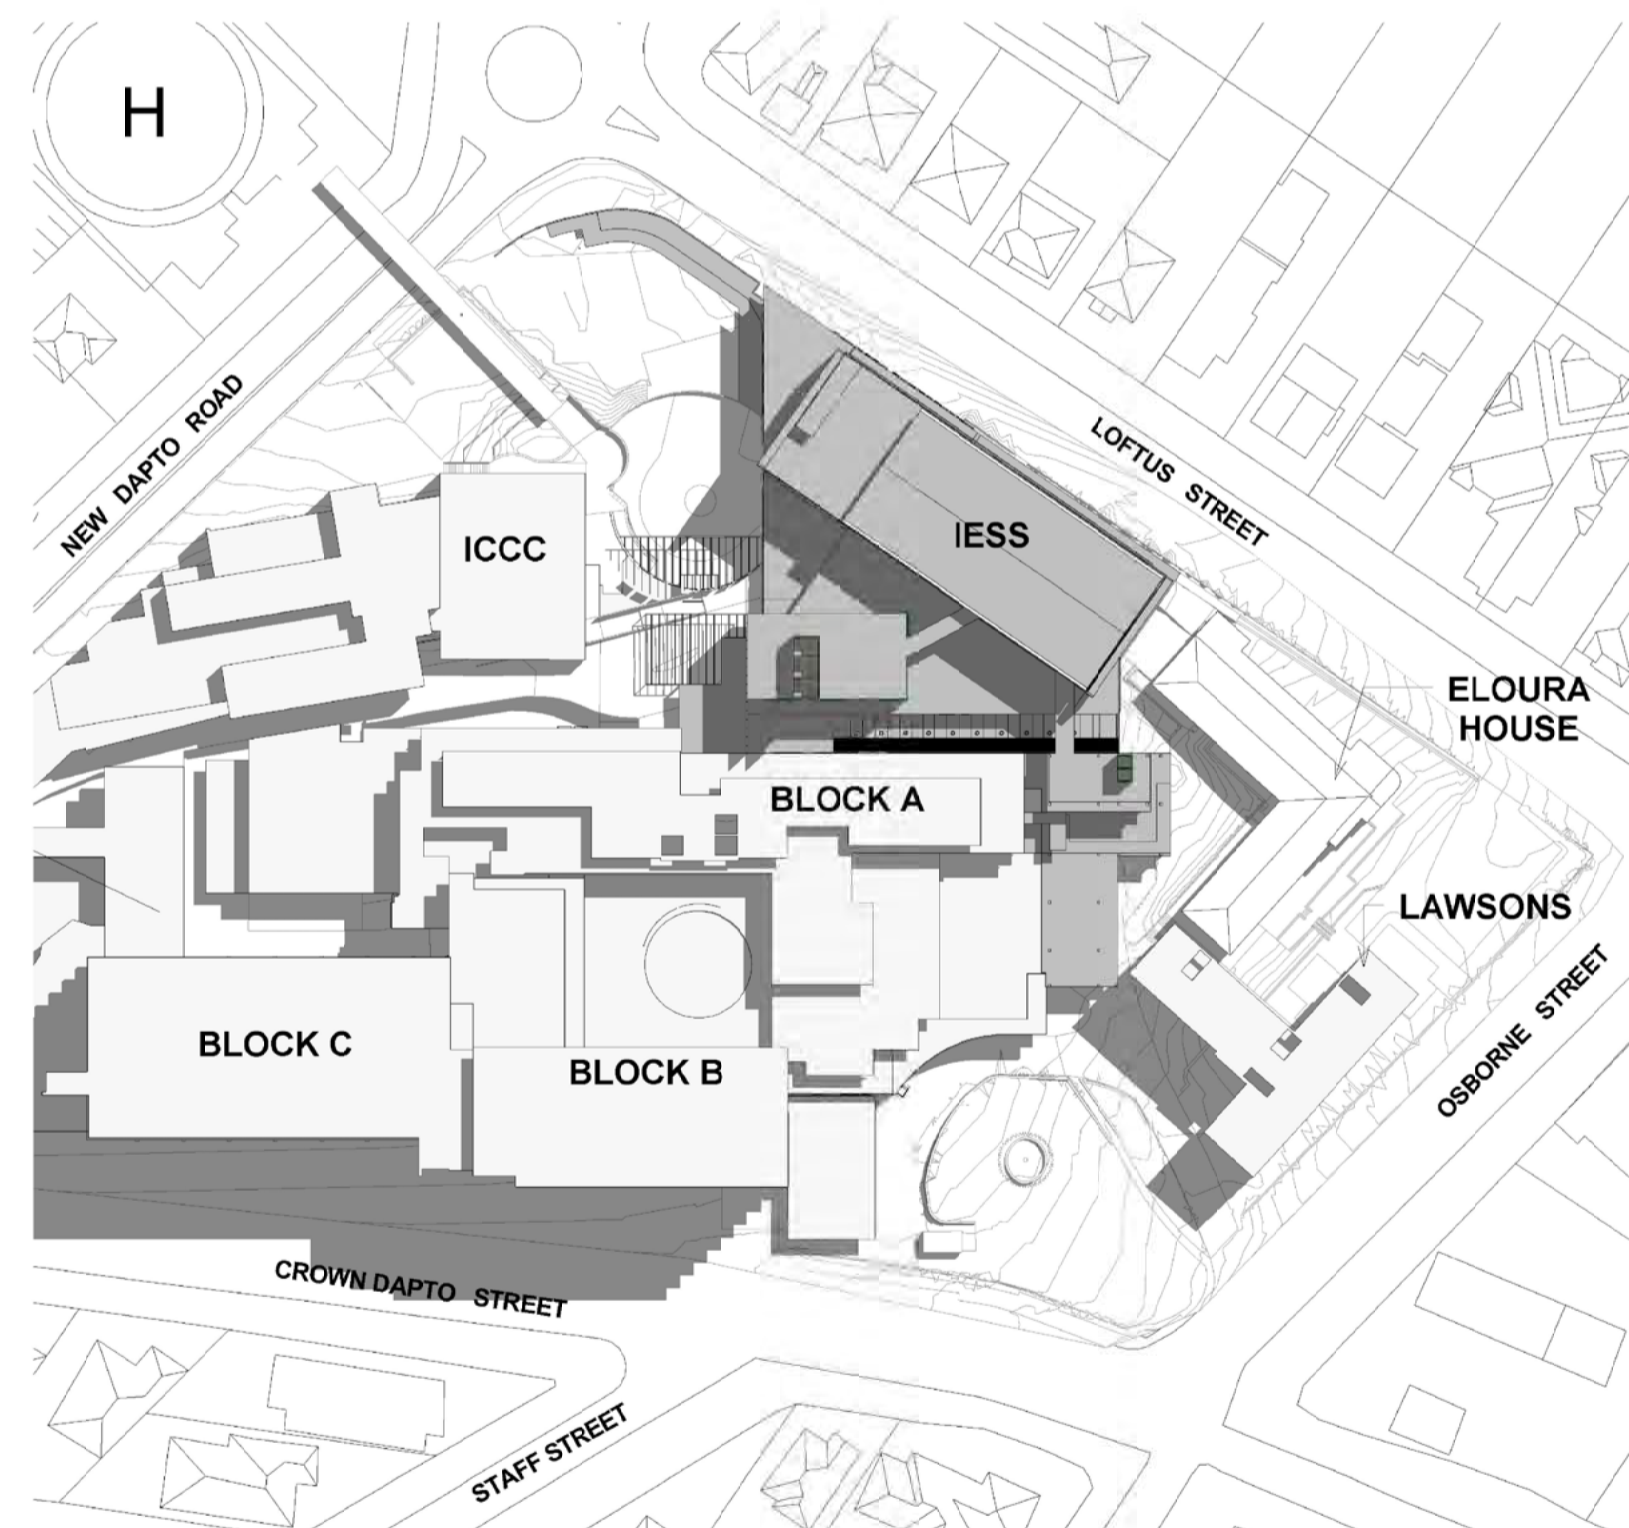

5 SUN SHADOW DIAGRAMS - DEC 12PM

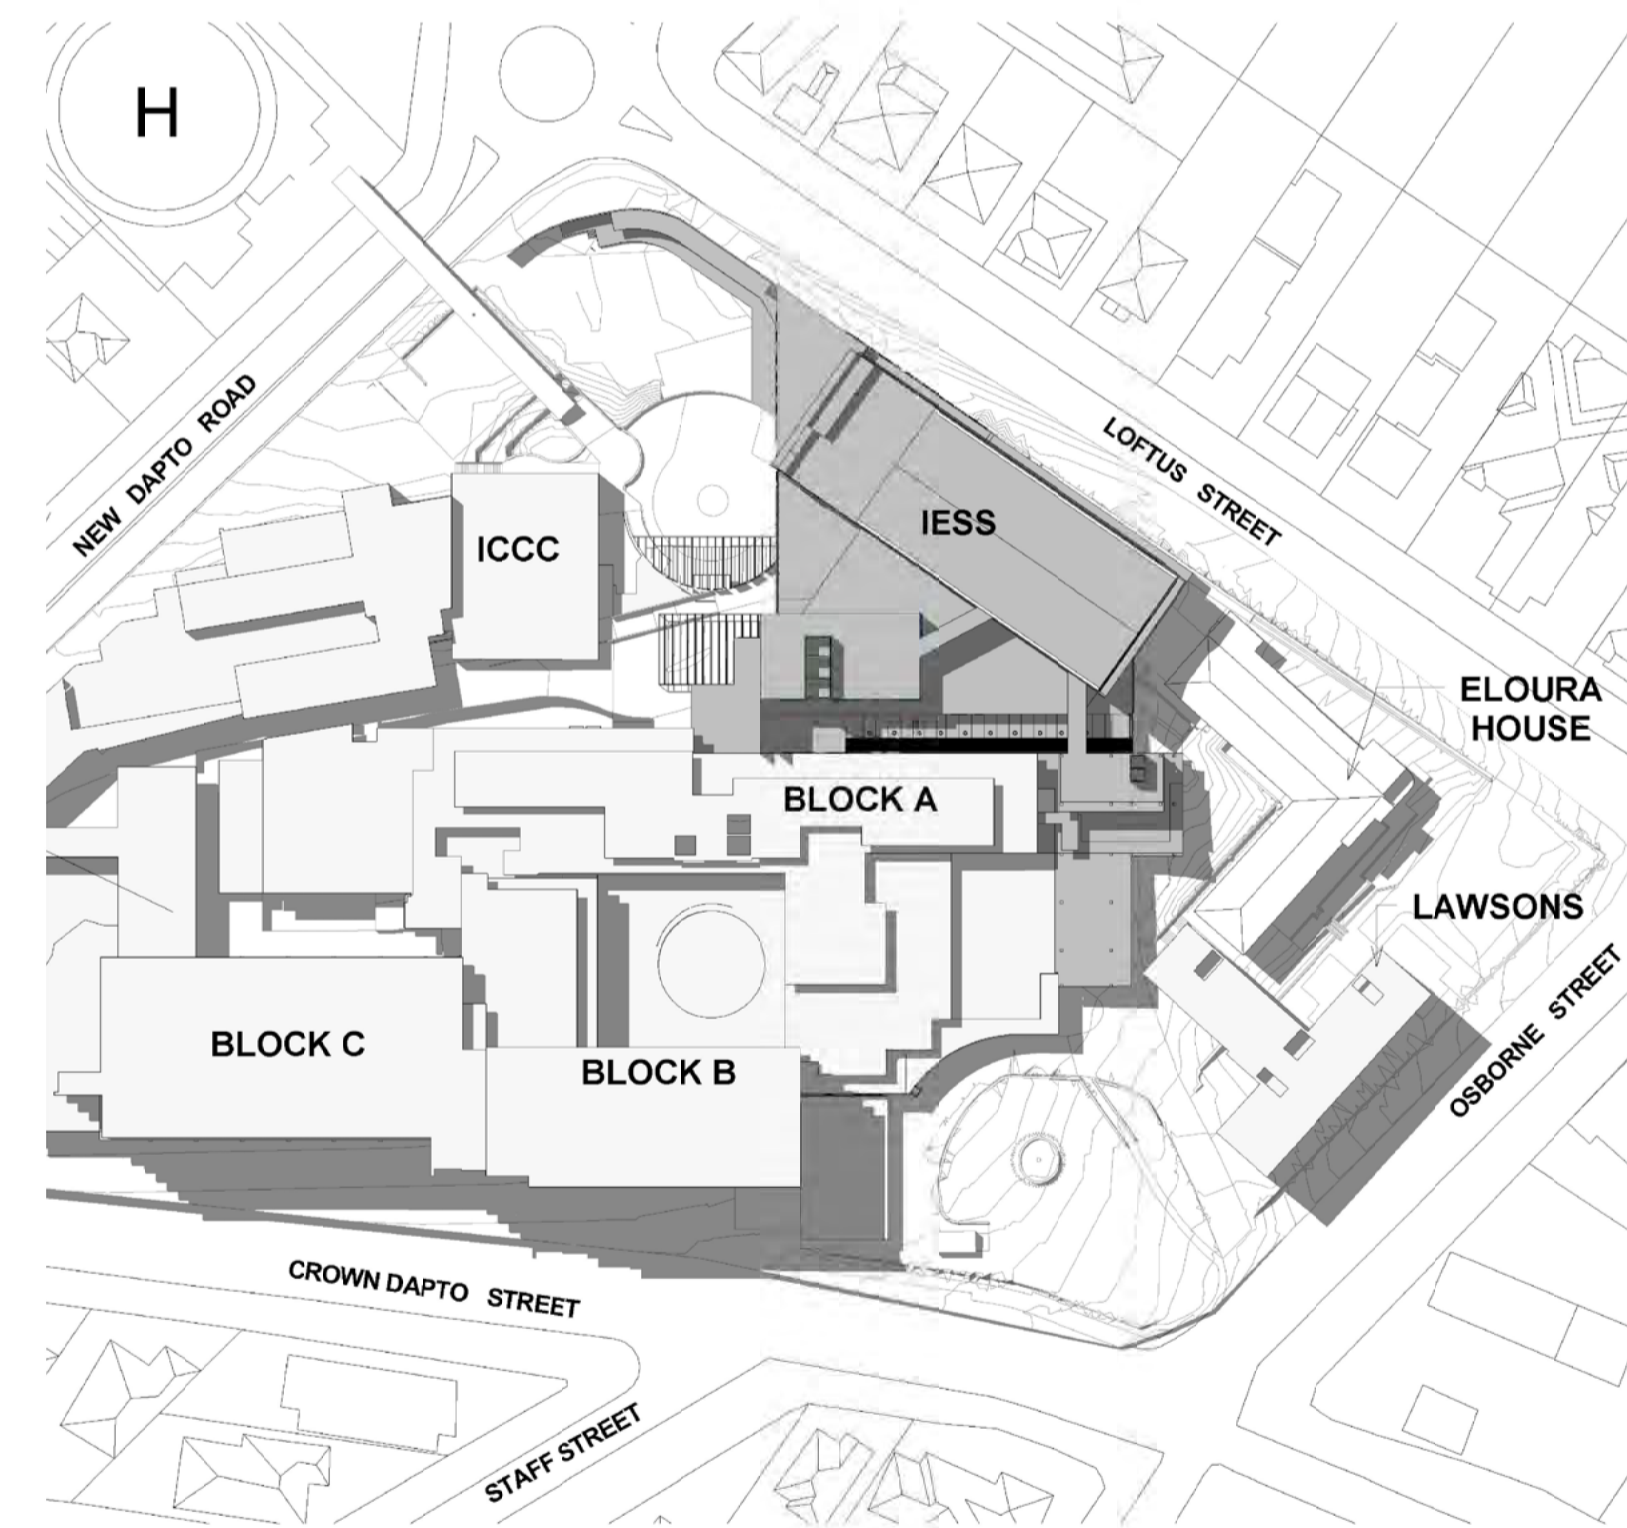

6 SUN SHADOW DIAGRAMS - DEC 3PM

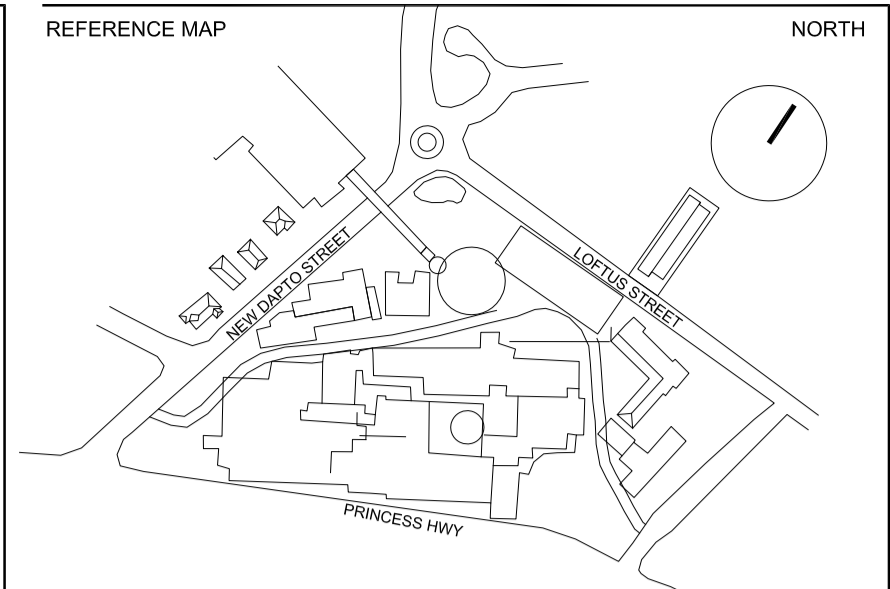

- NOTES
1. DO NOT SCALE DRAWINGS. WRITTEN DIMENSIONS GOVERN.
 2. ALL DIMENSIONS ARE IN MILLIMETRES UNLESS NOTED OTHERWISE.
 3. ALL DIMENSIONS SHALL BE VERIFIED ON SITE BEFORE PROCEEDING WITH THE WORK. HASSELL SHALL BE NOTIFIED IN WRITING OF ANY DISCREPANCIES.
 4. THIS DRAWING MUST BE READ IN CONJUNCTION WITH ALL RELEVANT CONTRACTS, SPECIFICATIONS AND DRAWINGS.

© COPYRIGHT OF THIS DRAWING IS VESTED IN HASSELL LTD.
2010 HASSELL LTD.

THIS DRAWING IS AN UNCONTROLLED COPY, UNLESS NOTED OTHERWISE.

C	DA SUBMISSION - UPDATE	13.09.11
B	DA SUBMISSION	02.09.11
A	DA DRAFT	26.08.11

REV	DESCRIPTION	DATE
-----	-------------	------

CONSULTANT
HASSELL LIMITED ACN 007 711 435
88 CUMBERLAND STREET
SYDNEY NSW 2000 AUSTRALIA
SYDNEY@HASSELL.COM.AU
T 61 2 9273 2300 F 61 2 9273 2345

HASSELL



PROJECT
ILLAWARRA ELECTIVE SURGERY
WOLLONGONG HOSPITAL
WOLLONGONG, NSW

DRAWING TITLE
SHADOW DIAGRAMS SEPT-DEC

STATUS
DEVELOPMENT APPROVAL

SCALE @ A1	DRAWN	CO-ORD	REVIEWED	APPROVED
NTS	--	LvE	CC	

PROJECT NUMBER	DRAWING NUMBER	REV
AX003042	IESS - DA 351	C

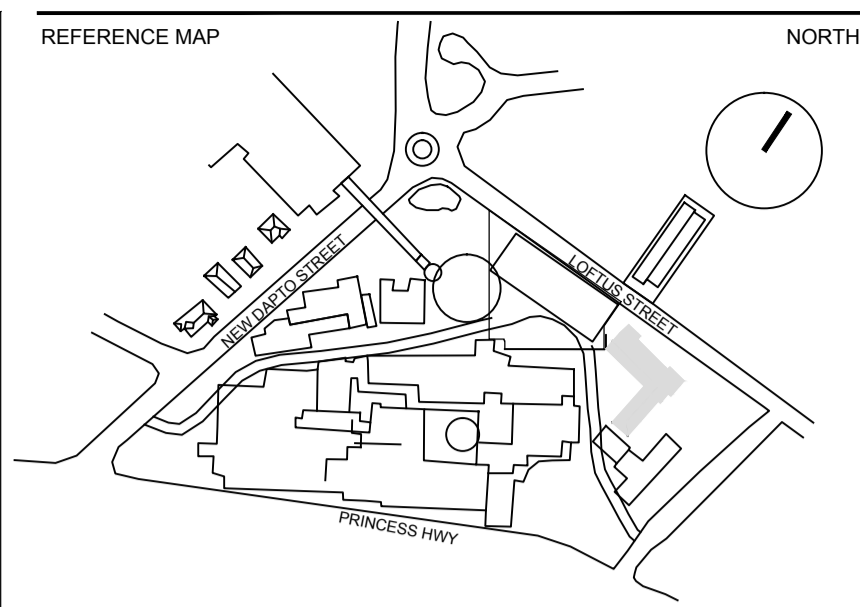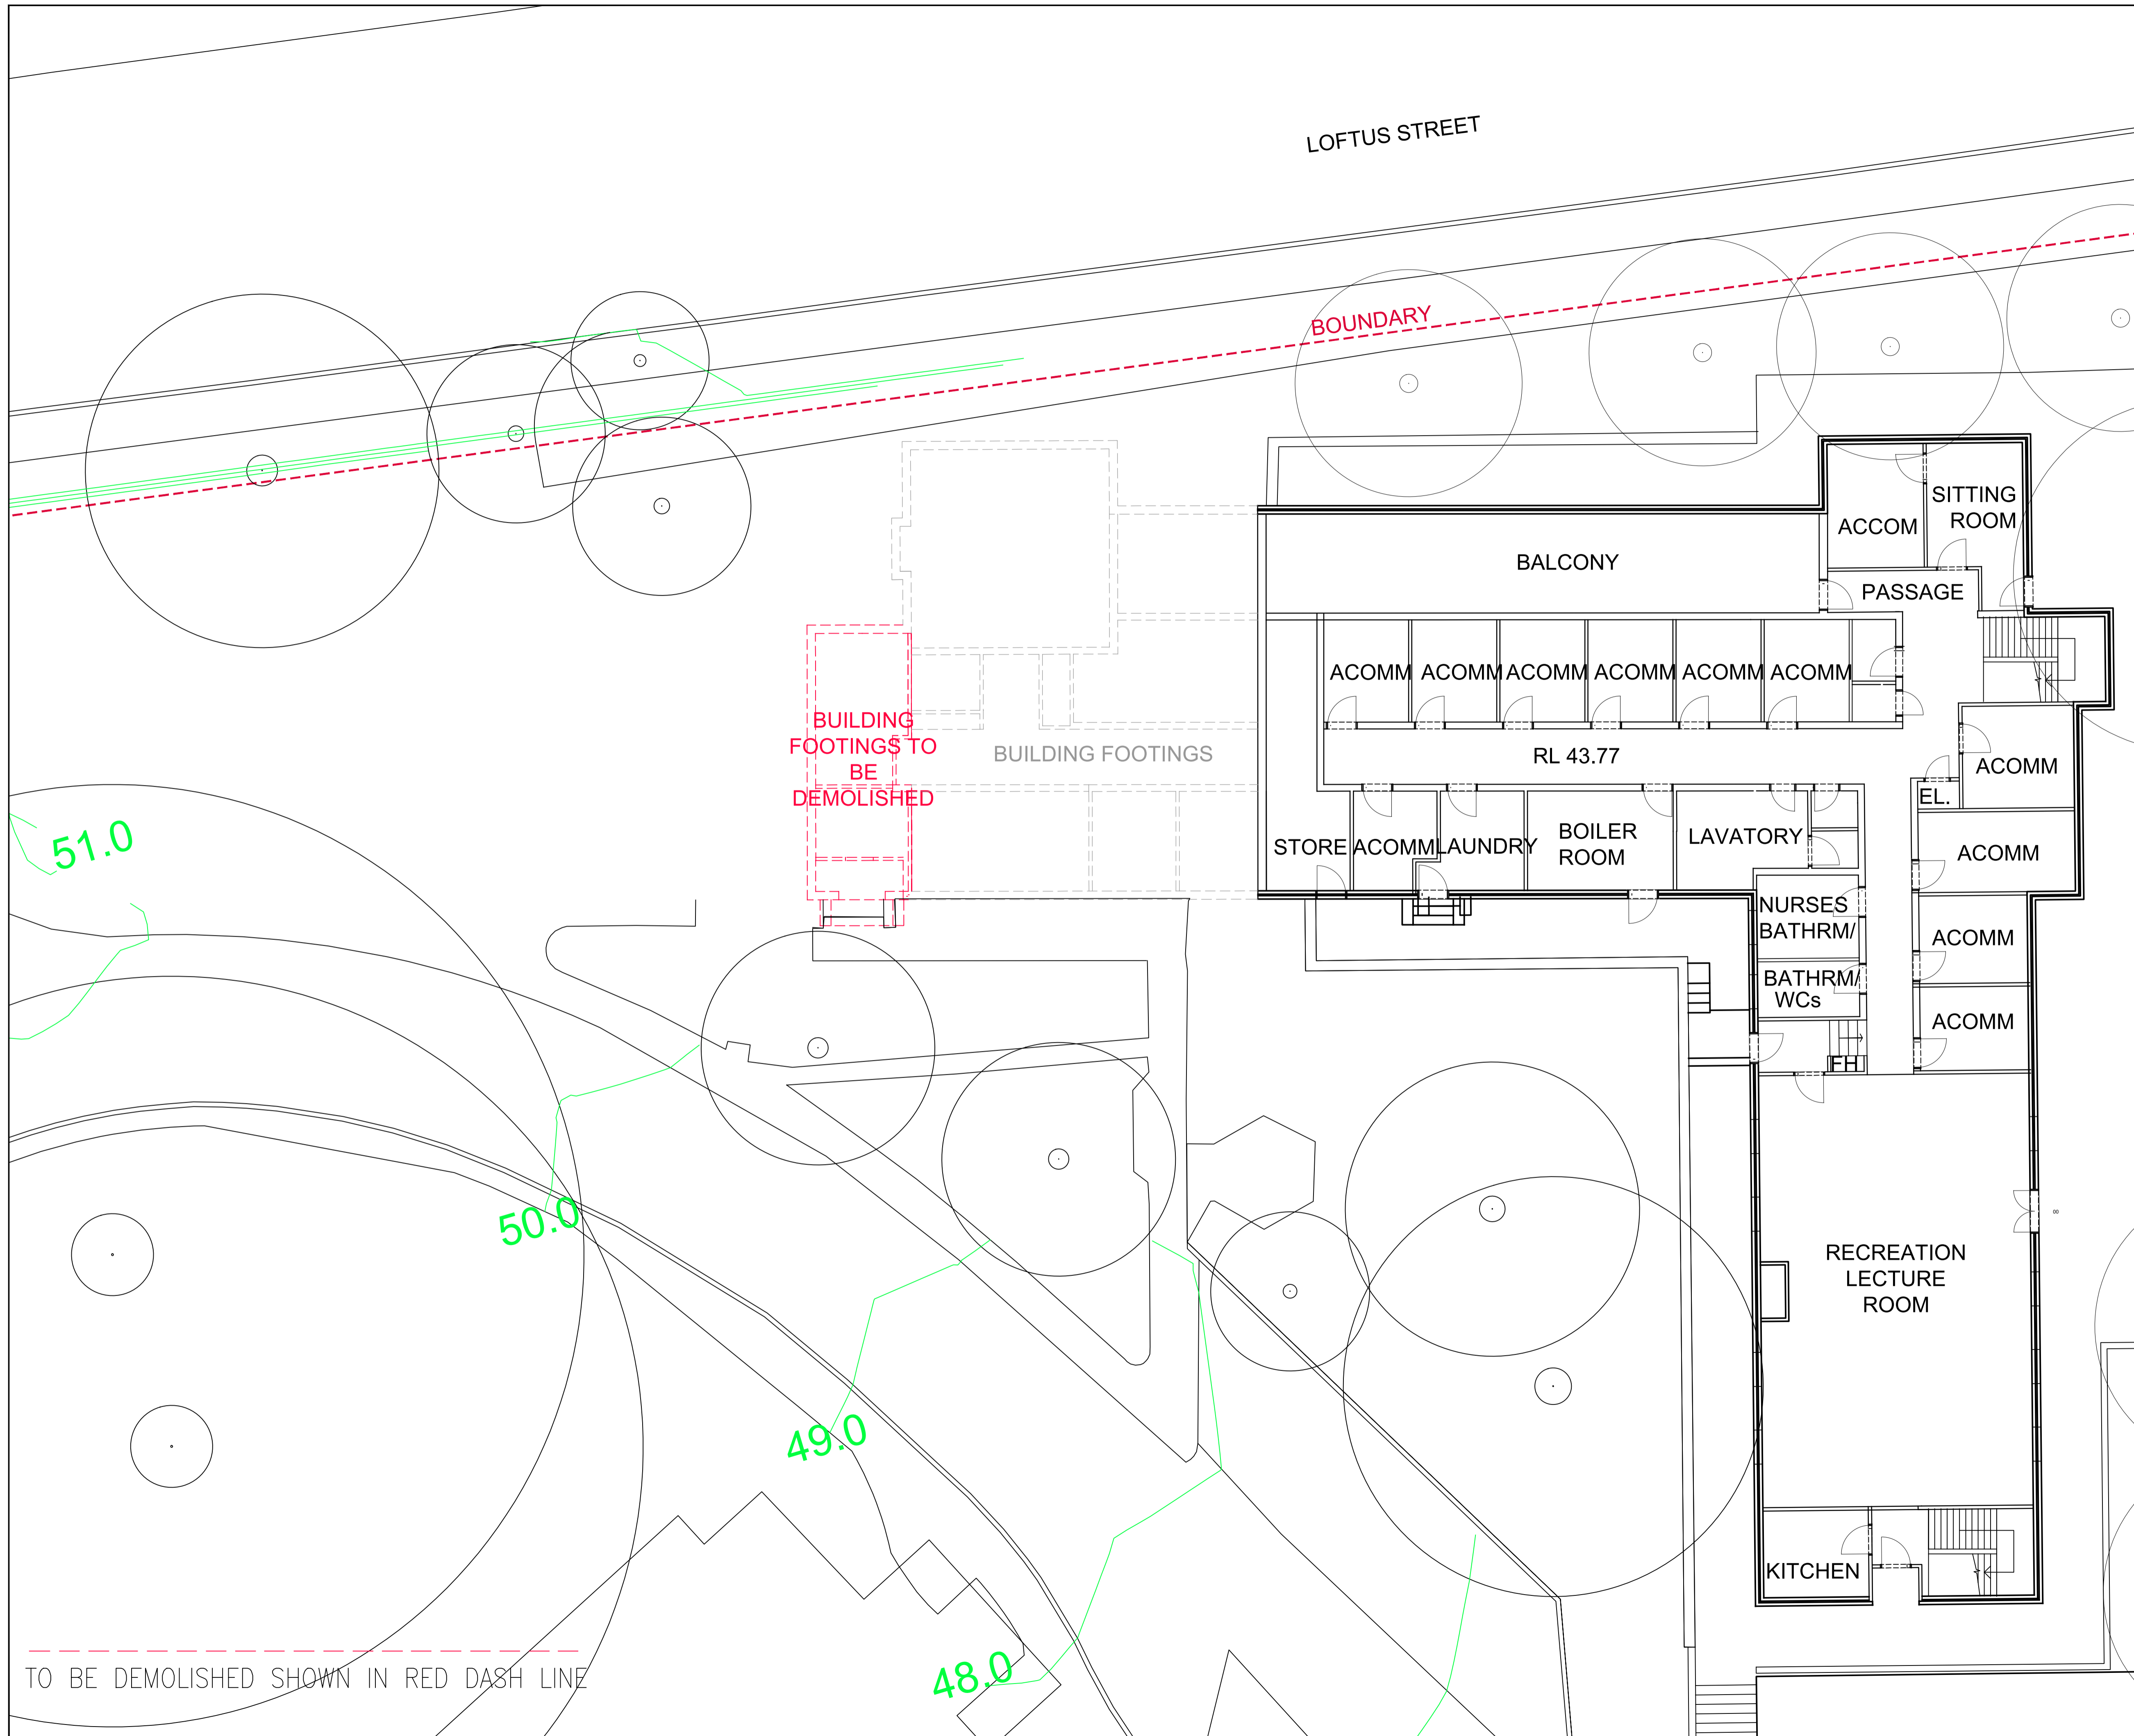

- NOTES
- DO NOT SCALE DRAWINGS. WRITTEN DIMENSIONS GOVERN.
 - ALL DIMENSIONS ARE IN MILLIMETRES UNLESS NOTED OTHERWISE.
 - ALL DIMENSIONS SHALL BE VERIFIED ON SITE BEFORE PROCEEDING WITH THE WORK. HASSELL SHALL BE NOTIFIED IN WRITING OF ANY DISCREPANCIES.
 - THIS DRAWING MUST BE READ IN CONJUNCTION WITH ALL RELEVANT CONTRACTS, SPECIFICATIONS AND DRAWINGS.

© COPYRIGHT OF THIS DRAWING IS VESTED IN HASSELL. LTD.
2010 HASSELL. LTD.

THIS DRAWING IS AN UNCONTROLLED COPY, UNLESS NOTED OTHERWISE.

B	DA SUBMISSION	02.09.11
A	ISSUE FOR INFORMATION	31.08.11
REV	DESCRIPTION	DATE

CONSULTANT
 HASSELL LIMITED ACN 007 711 435
 88 CUMBERLAND STREET
 SYDNEY NSW 2000 AUSTRALIA
 SYDNEY@HASSELL.COM.AU
 T 61 2 9273 2300 F 61 2 9273 2345

HASSELL



PROJECT
 ILLAWARRA ELECTIVE SURGERY
 WOLLONGONG HOSPITAL
 WOLLONGONG, NSW

DRAWING TITLE
 ELOURA DEMOLITION PLAN LV 0

STATUS
 DEVELOPMENT APPROVAL

SCALE @ A1	DRAWN	CO-ORD	REVIEWED	APPROVED
1:100 mm_XREF	LvE	CC		
PROJECT NUMBER	DRAWING NUMBER	REV		
AX003042	EH - DA 300	B		

TO BE DEMOLISHED SHOWN IN RED DASH LINE

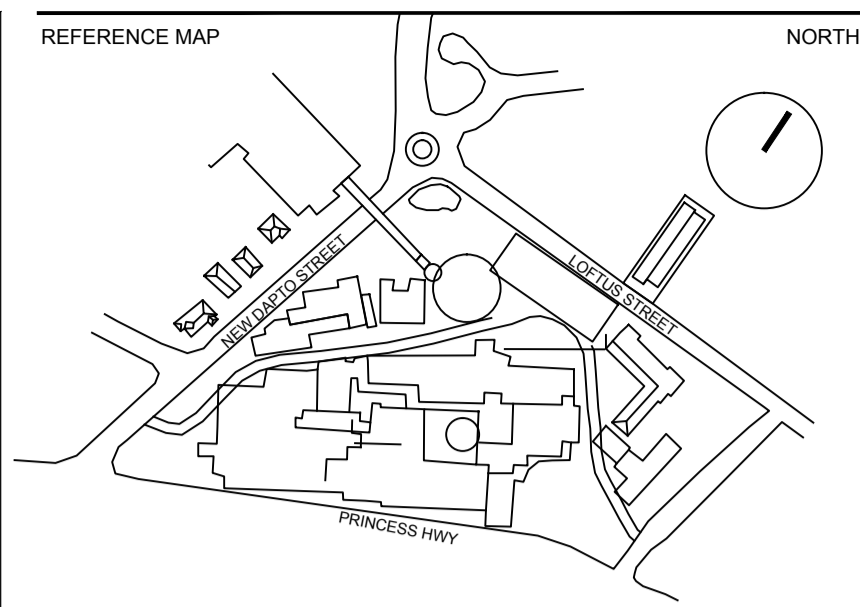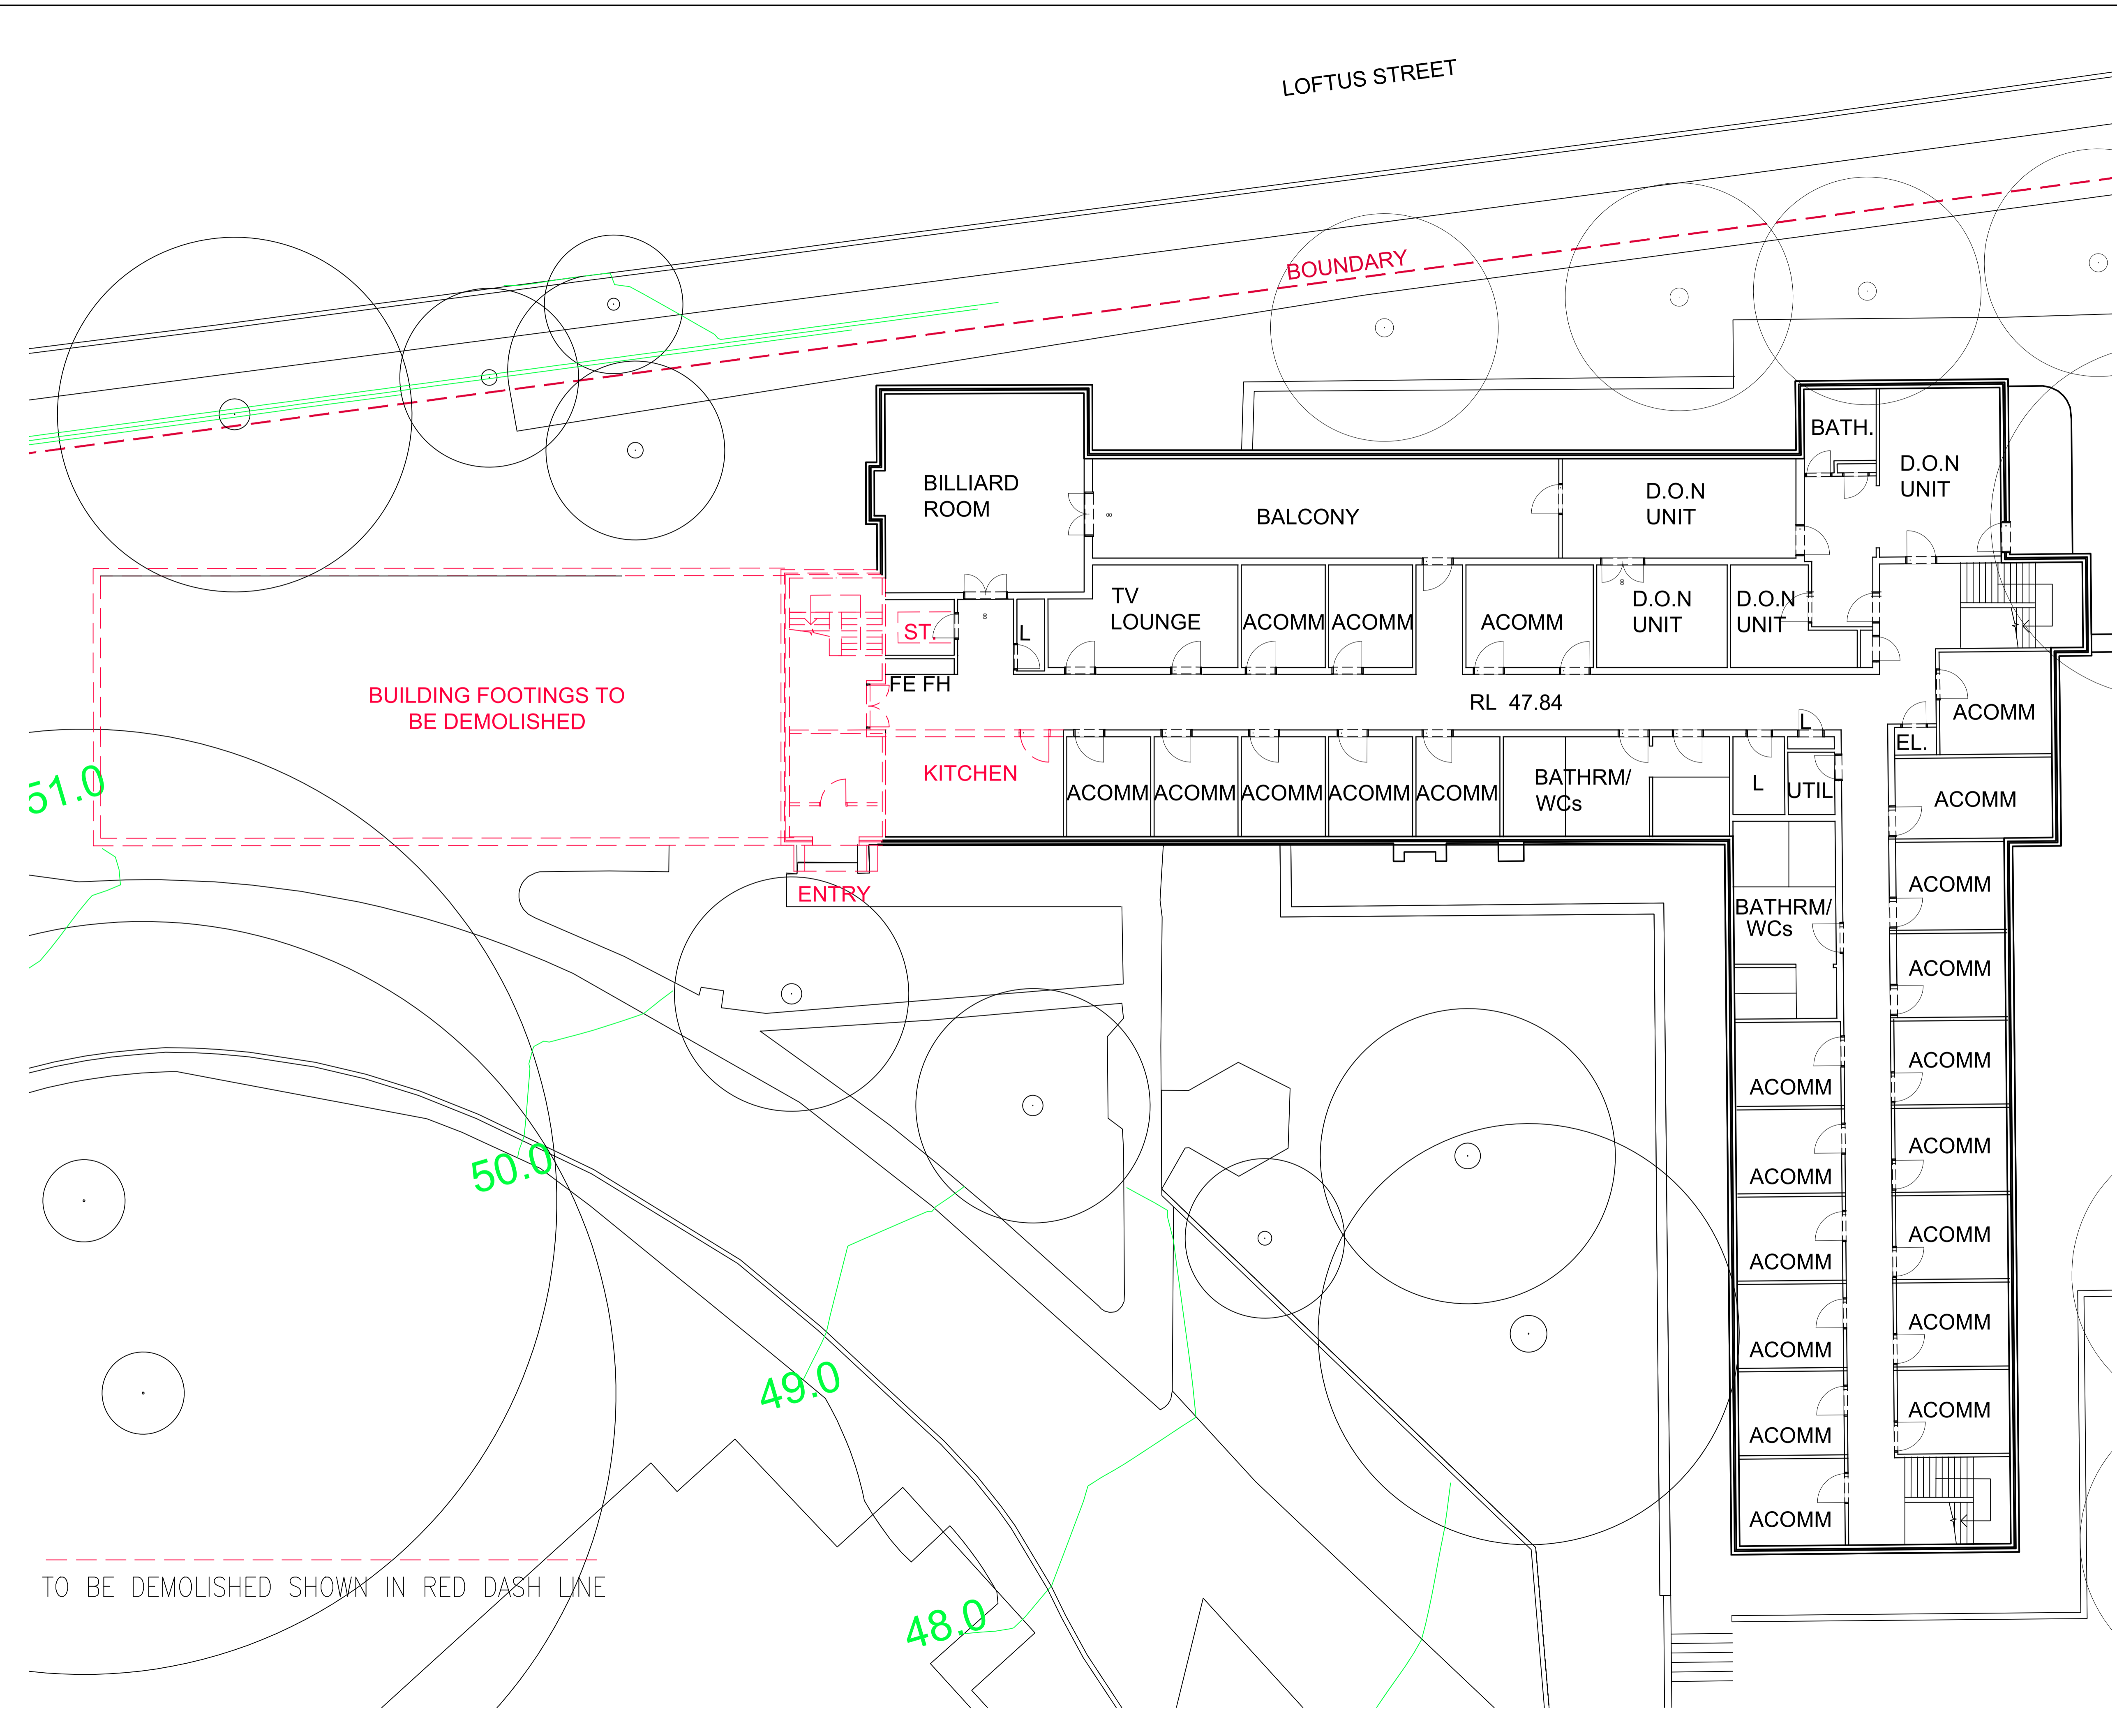



- NOTES
- DO NOT SCALE DRAWINGS. WRITTEN DIMENSIONS GOVERN.
 - ALL DIMENSIONS ARE IN MILLIMETRES UNLESS NOTED OTHERWISE.
 - ALL DIMENSIONS SHALL BE VERIFIED ON SITE BEFORE PROCEEDING WITH THE WORK. HASSELL SHALL BE NOTIFIED IN WRITING OF ANY DISCREPANCIES.
 - THIS DRAWING MUST BE READ IN CONJUNCTION WITH ALL RELEVANT CONTRACTS, SPECIFICATIONS AND DRAWINGS.

© COPYRIGHT OF THIS DRAWING IS VESTED IN HASSELL. LTD.
2010 HASSELL. LTD.

THIS DRAWING IS AN UNCONTROLLED COPY, UNLESS NOTED OTHERWISE.

A		ISSUE FOR INFORMATION	30.08.11
REV	DESCRIPTION	DATE	
CONSULTANT			
HASSELL LIMITED ACN 007 711 435 88 CUMBERLAND STREET SYDNEY NSW 2000 AUSTRALIA SYDNEY@HASSELL.COM.AU T 61 2 9273 2300 F 61 2 9273 2345			
HASSELL			
PROJECT			
ILLAWARRA ELECTIVE SURGERY WOLLONGONG HOSPITAL WOLLONGONG, NSW			
DRAWING TITLE			
ELOURA DEMOLITION PLAN LV 1			
STATUS			
DEVELOPMENT APPROVAL			
SCALE @ A1	DRAWN	CO-ORD	REVIEWED
1:100mm_XREF	LvE	CC	CC
PROJECT NUMBER	DRAWING NUMBER	REV	
AX003042	EH - DA 301	B	

TO BE DEMOLISHED SHOWN IN RED DASH LINE

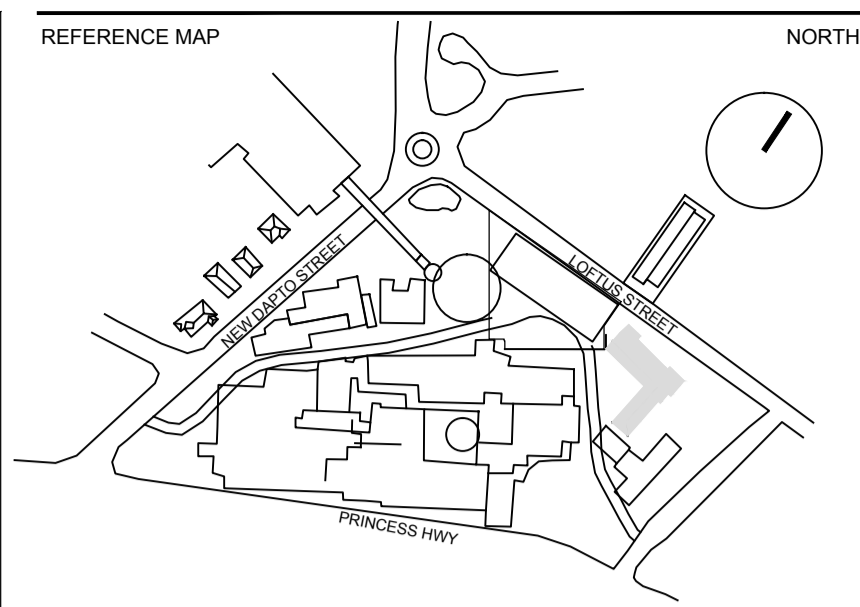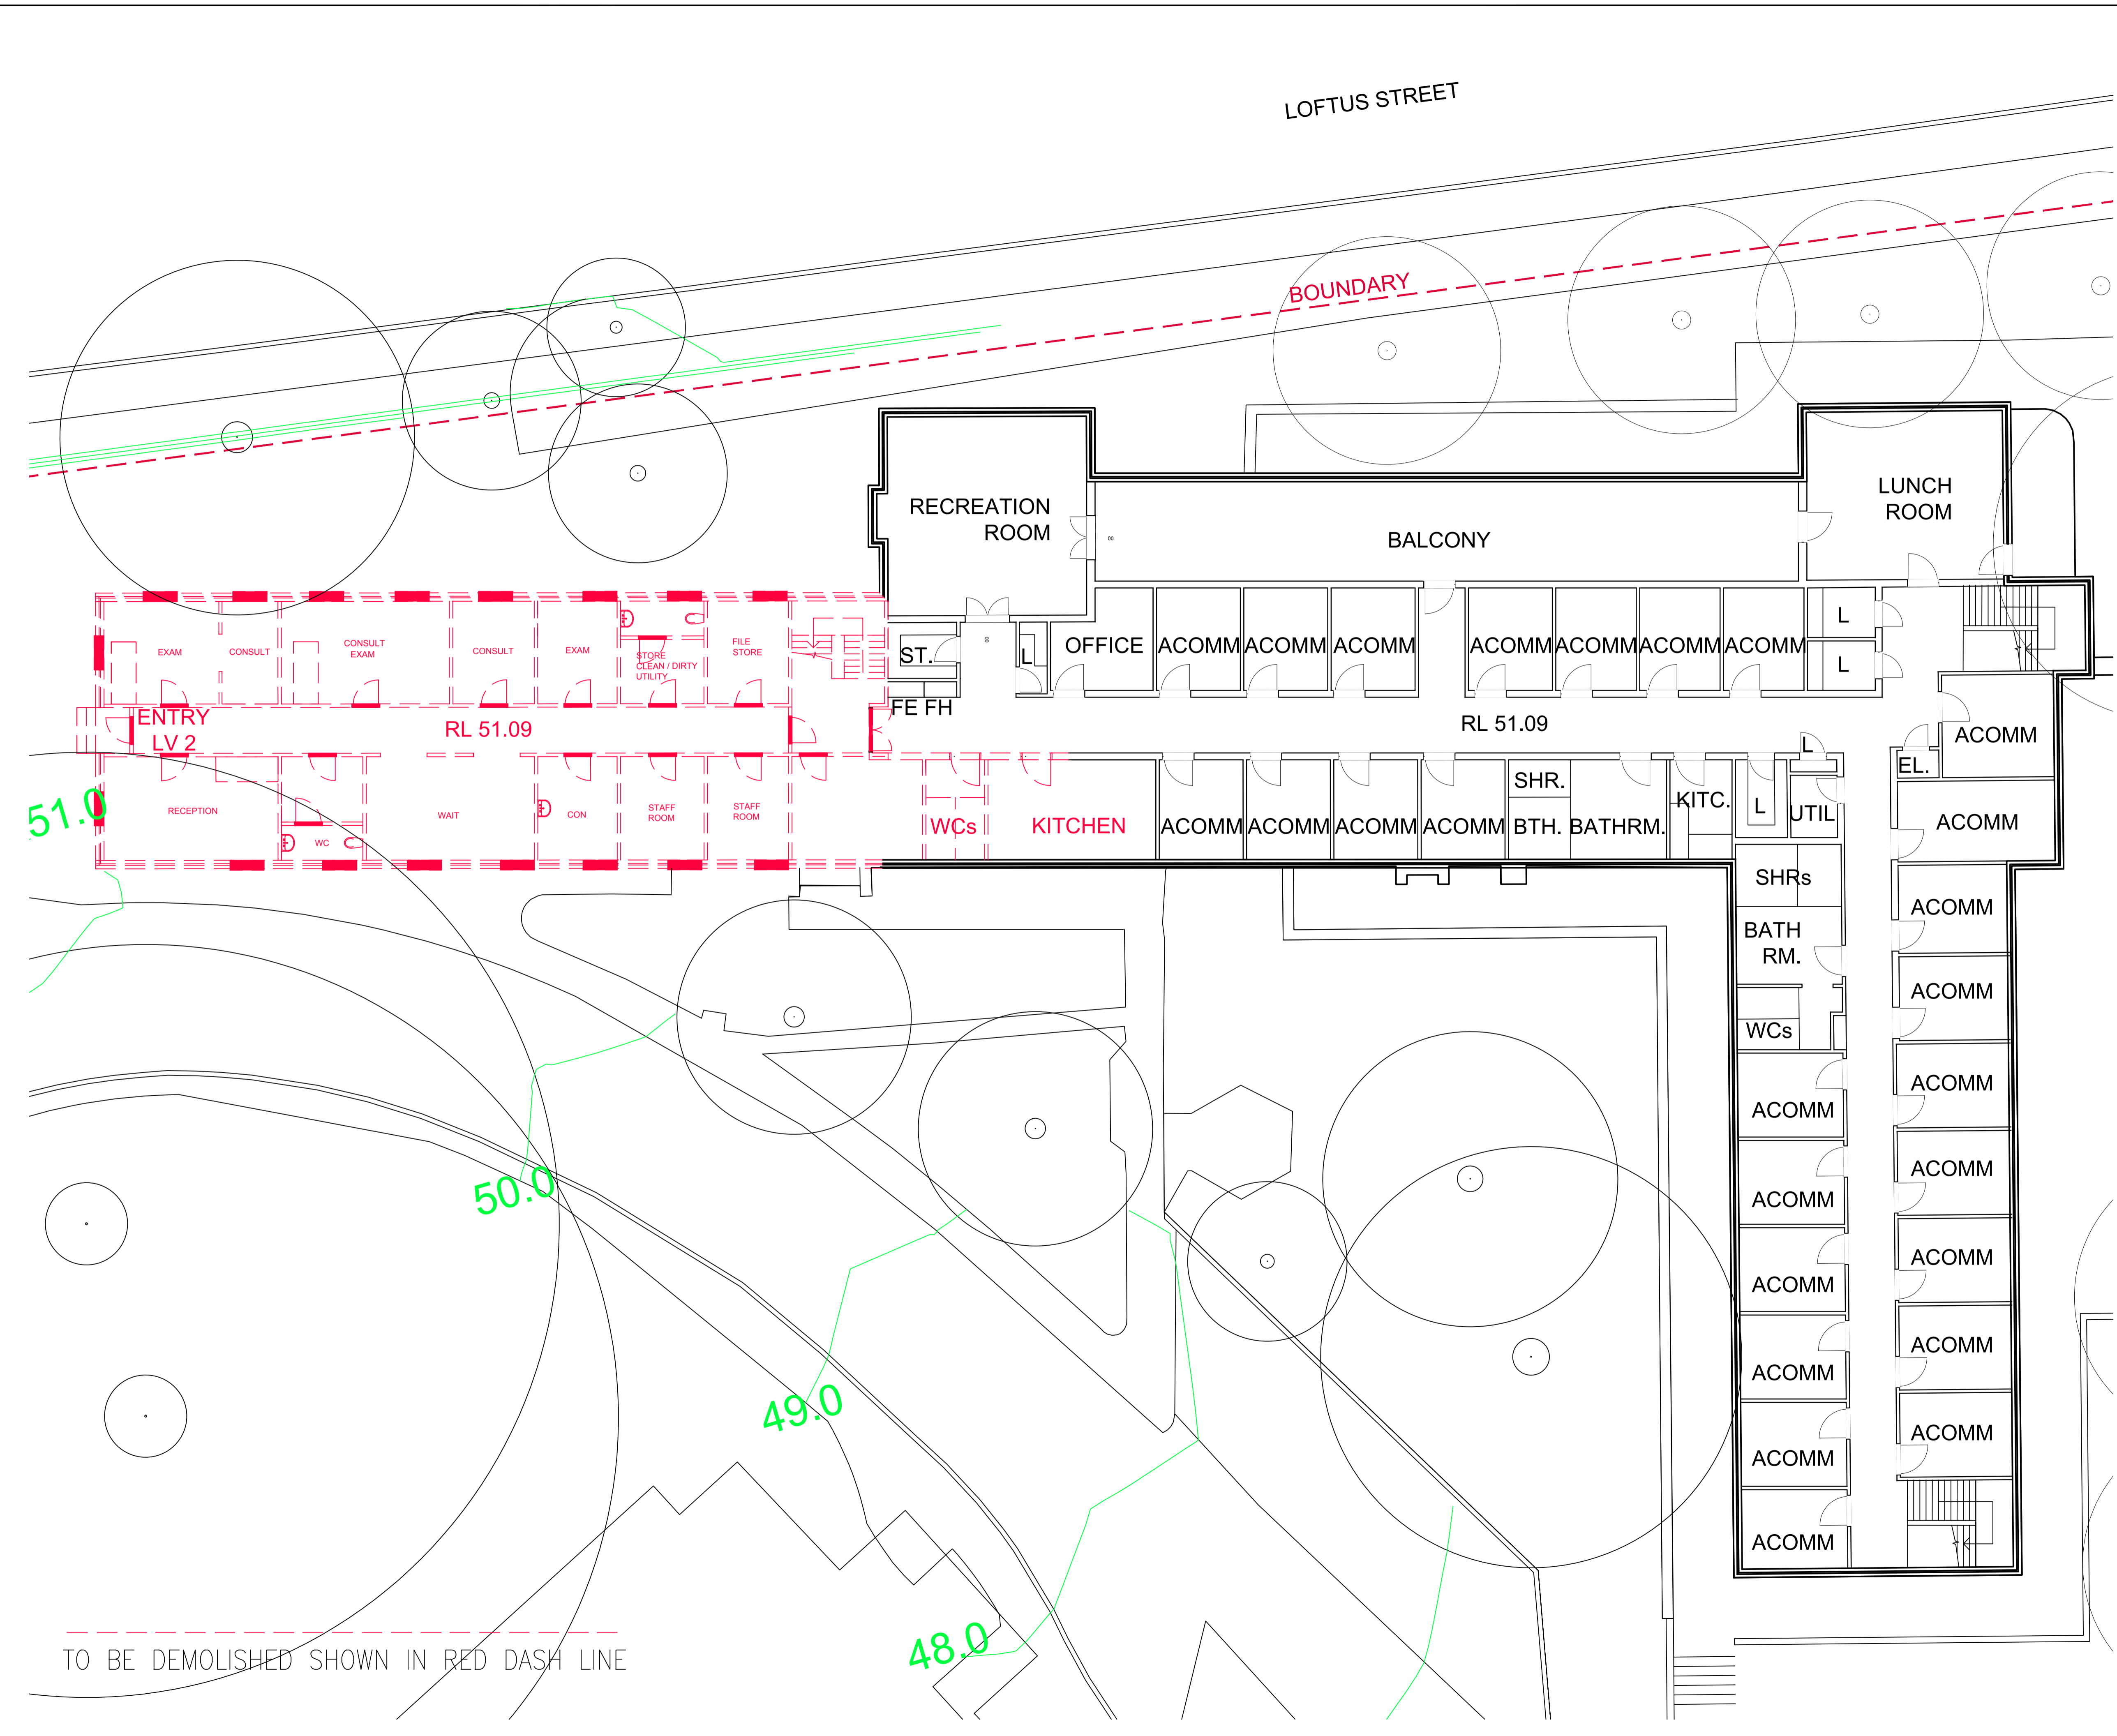

- NOTES
- DO NOT SCALE DRAWINGS. WRITTEN DIMENSIONS GOVERN.
 - ALL DIMENSIONS ARE IN MILLIMETRES UNLESS NOTED OTHERWISE.
 - ALL DIMENSIONS SHALL BE VERIFIED ON SITE BEFORE PROCEEDING WITH THE WORK. HASSELL SHALL BE NOTIFIED IN WRITING OF ANY DISCREPANCIES.
 - THIS DRAWING MUST BE READ IN CONJUNCTION WITH ALL RELEVANT CONTRACTS, SPECIFICATIONS AND DRAWINGS.

© COPYRIGHT OF THIS DRAWING IS VESTED IN HASSELL. LTD.
2010 HASSELL. LTD.

THIS DRAWING IS AN UNCONTROLLED COPY, UNLESS NOTED OTHERWISE.

REV	DESCRIPTION	DATE
B	DA SUBMISSION	02.09.11
A	ISSUE FOR INFORMATION	30.08.11

REV	DESCRIPTION	DATE
B	DA SUBMISSION	02.09.11
A	ISSUE FOR INFORMATION	30.08.11

CONSULTANT
 HASSELL LIMITED ACN 007 711 435
 88 CUMBERLAND STREET
 SYDNEY NSW 2000 AUSTRALIA
 SYDNEY@HASSELL.COM.AU
 T 61 2 9273 2300 F 61 2 9273 2345

HASSELL

PROJECT
 ILLAWARRA ELECTIVE SURGERY
 WOLLONGONG HOSPITAL
 WOLLONGONG, NSW

DRAWING TITLE
 ELOURA DEMOLITION PLAN LV 2


STATUS
 DEVELOPMENT APPROVAL

SCALE @ A1	DRAWN	CO-ORD	REVIEWED	APPROVED
1:100 mm	XREF	LvE	CC	
PROJECT NUMBER	DRAWING NUMBER	REV		
AX003042	EH - DA 302	B		

TO BE DEMOLISHED SHOWN IN RED DASH LINE



TO BE DEMOLISHED SHOWN IN RED DASH LINE

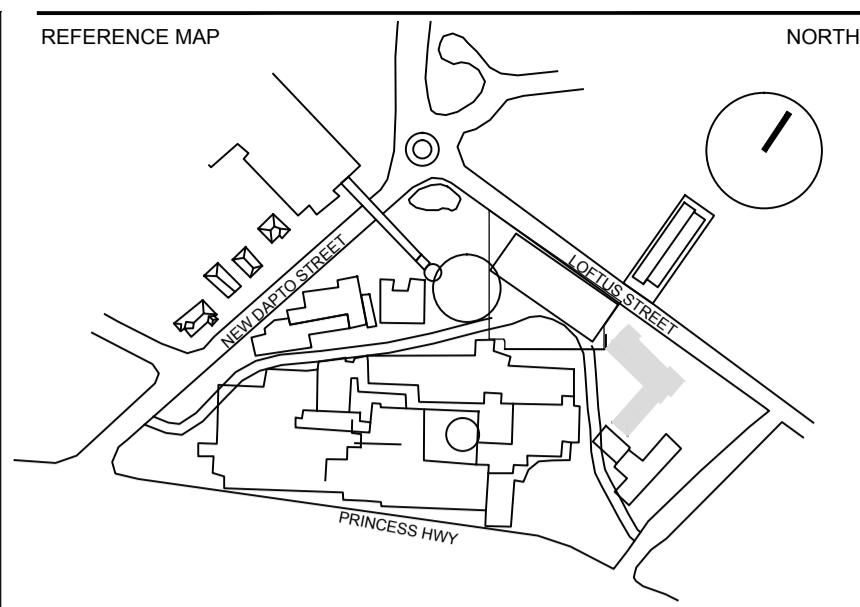

- NOTES
1. DO NOT SCALE DRAWINGS. WRITTEN DIMENSIONS GOVERN.
 2. ALL DIMENSIONS ARE IN MILLIMETRES UNLESS NOTED OTHERWISE.
 3. ALL DIMENSIONS SHALL BE VERIFIED ON SITE BEFORE PROCEEDING WITH THE WORK. HASSELL SHALL BE NOTIFIED IN WRITING OF ANY DISCREPANCIES.
 4. THIS DRAWING MUST BE READ IN CONJUNCTION WITH ALL RELEVANT CONTRACTS, SPECIFICATIONS AND DRAWINGS.

© COPYRIGHT OF THIS DRAWING IS VESTED IN HASSELL. LTD.
2010 HASSELL. LTD.

THIS DRAWING IS AN UNCONTROLLED COPY, UNLESS NOTED OTHERWISE.

B	DA SUBMISSION	02.09.11
A	ISSUE FOR INFORMATION	30.08.11
REV	DESCRIPTION	DATE

CONSULTANT
 HASSELL LIMITED ACN 007 711 435
 88 CUMBERLAND STREET
 SYDNEY NSW 2000 AUSTRALIA
 SYDNEY@HASSELL.COM.AU
 T 61 2 9273 2300 F 61 2 9273 2345

HASSELL


PROJECT
 ILLAWARRA ELECTIVE SURGERY
 WOLLONGONG HOSPITAL
 WOLLONGONG, NSW

DRAWING TITLE
 ELOURA DEMOLITION PLAN LV 3

STATUS

DEVELOPMENT APPROVAL


SCALE @ A1	DRAWN	CO-ORD	REVIEWED	APPROVED
1:100 mm_XREF	LvE	CC		
PROJECT NUMBER	DRAWING NUMBER	REV		
AX003042	EH - DA 303	B		

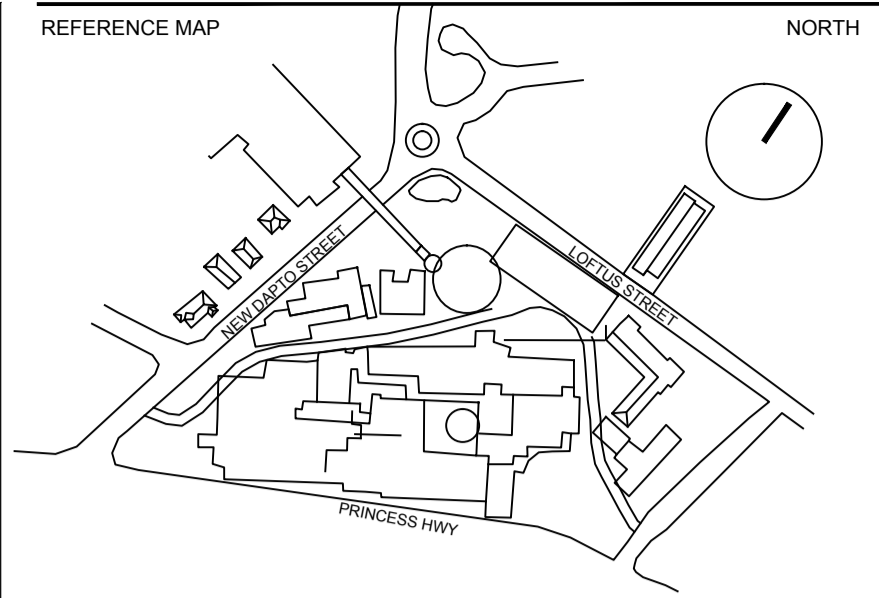

- NOTES
1. DO NOT SCALE DRAWINGS. WRITTEN DIMENSIONS GOVERN.
 2. ALL DIMENSIONS ARE IN MILLIMETRES UNLESS NOTED OTHERWISE.
 3. ALL DIMENSIONS SHALL BE VERIFIED ON SITE BEFORE PROCEEDING WITH THE WORK. HASSELL SHALL BE NOTIFIED IN WRITING OF ANY DISCREPANCIES.
 4. THIS DRAWING MUST BE READ IN CONJUNCTION WITH ALL RELEVANT CONTRACTS, SPECIFICATIONS AND DRAWINGS.

© COPYRIGHT OF THIS DRAWING IS VESTED IN HASSELL. LTD.
2010 HASSELL. LTD.

THIS DRAWING IS AN UNCONTROLLED COPY, UNLESS NOTED OTHERWISE.

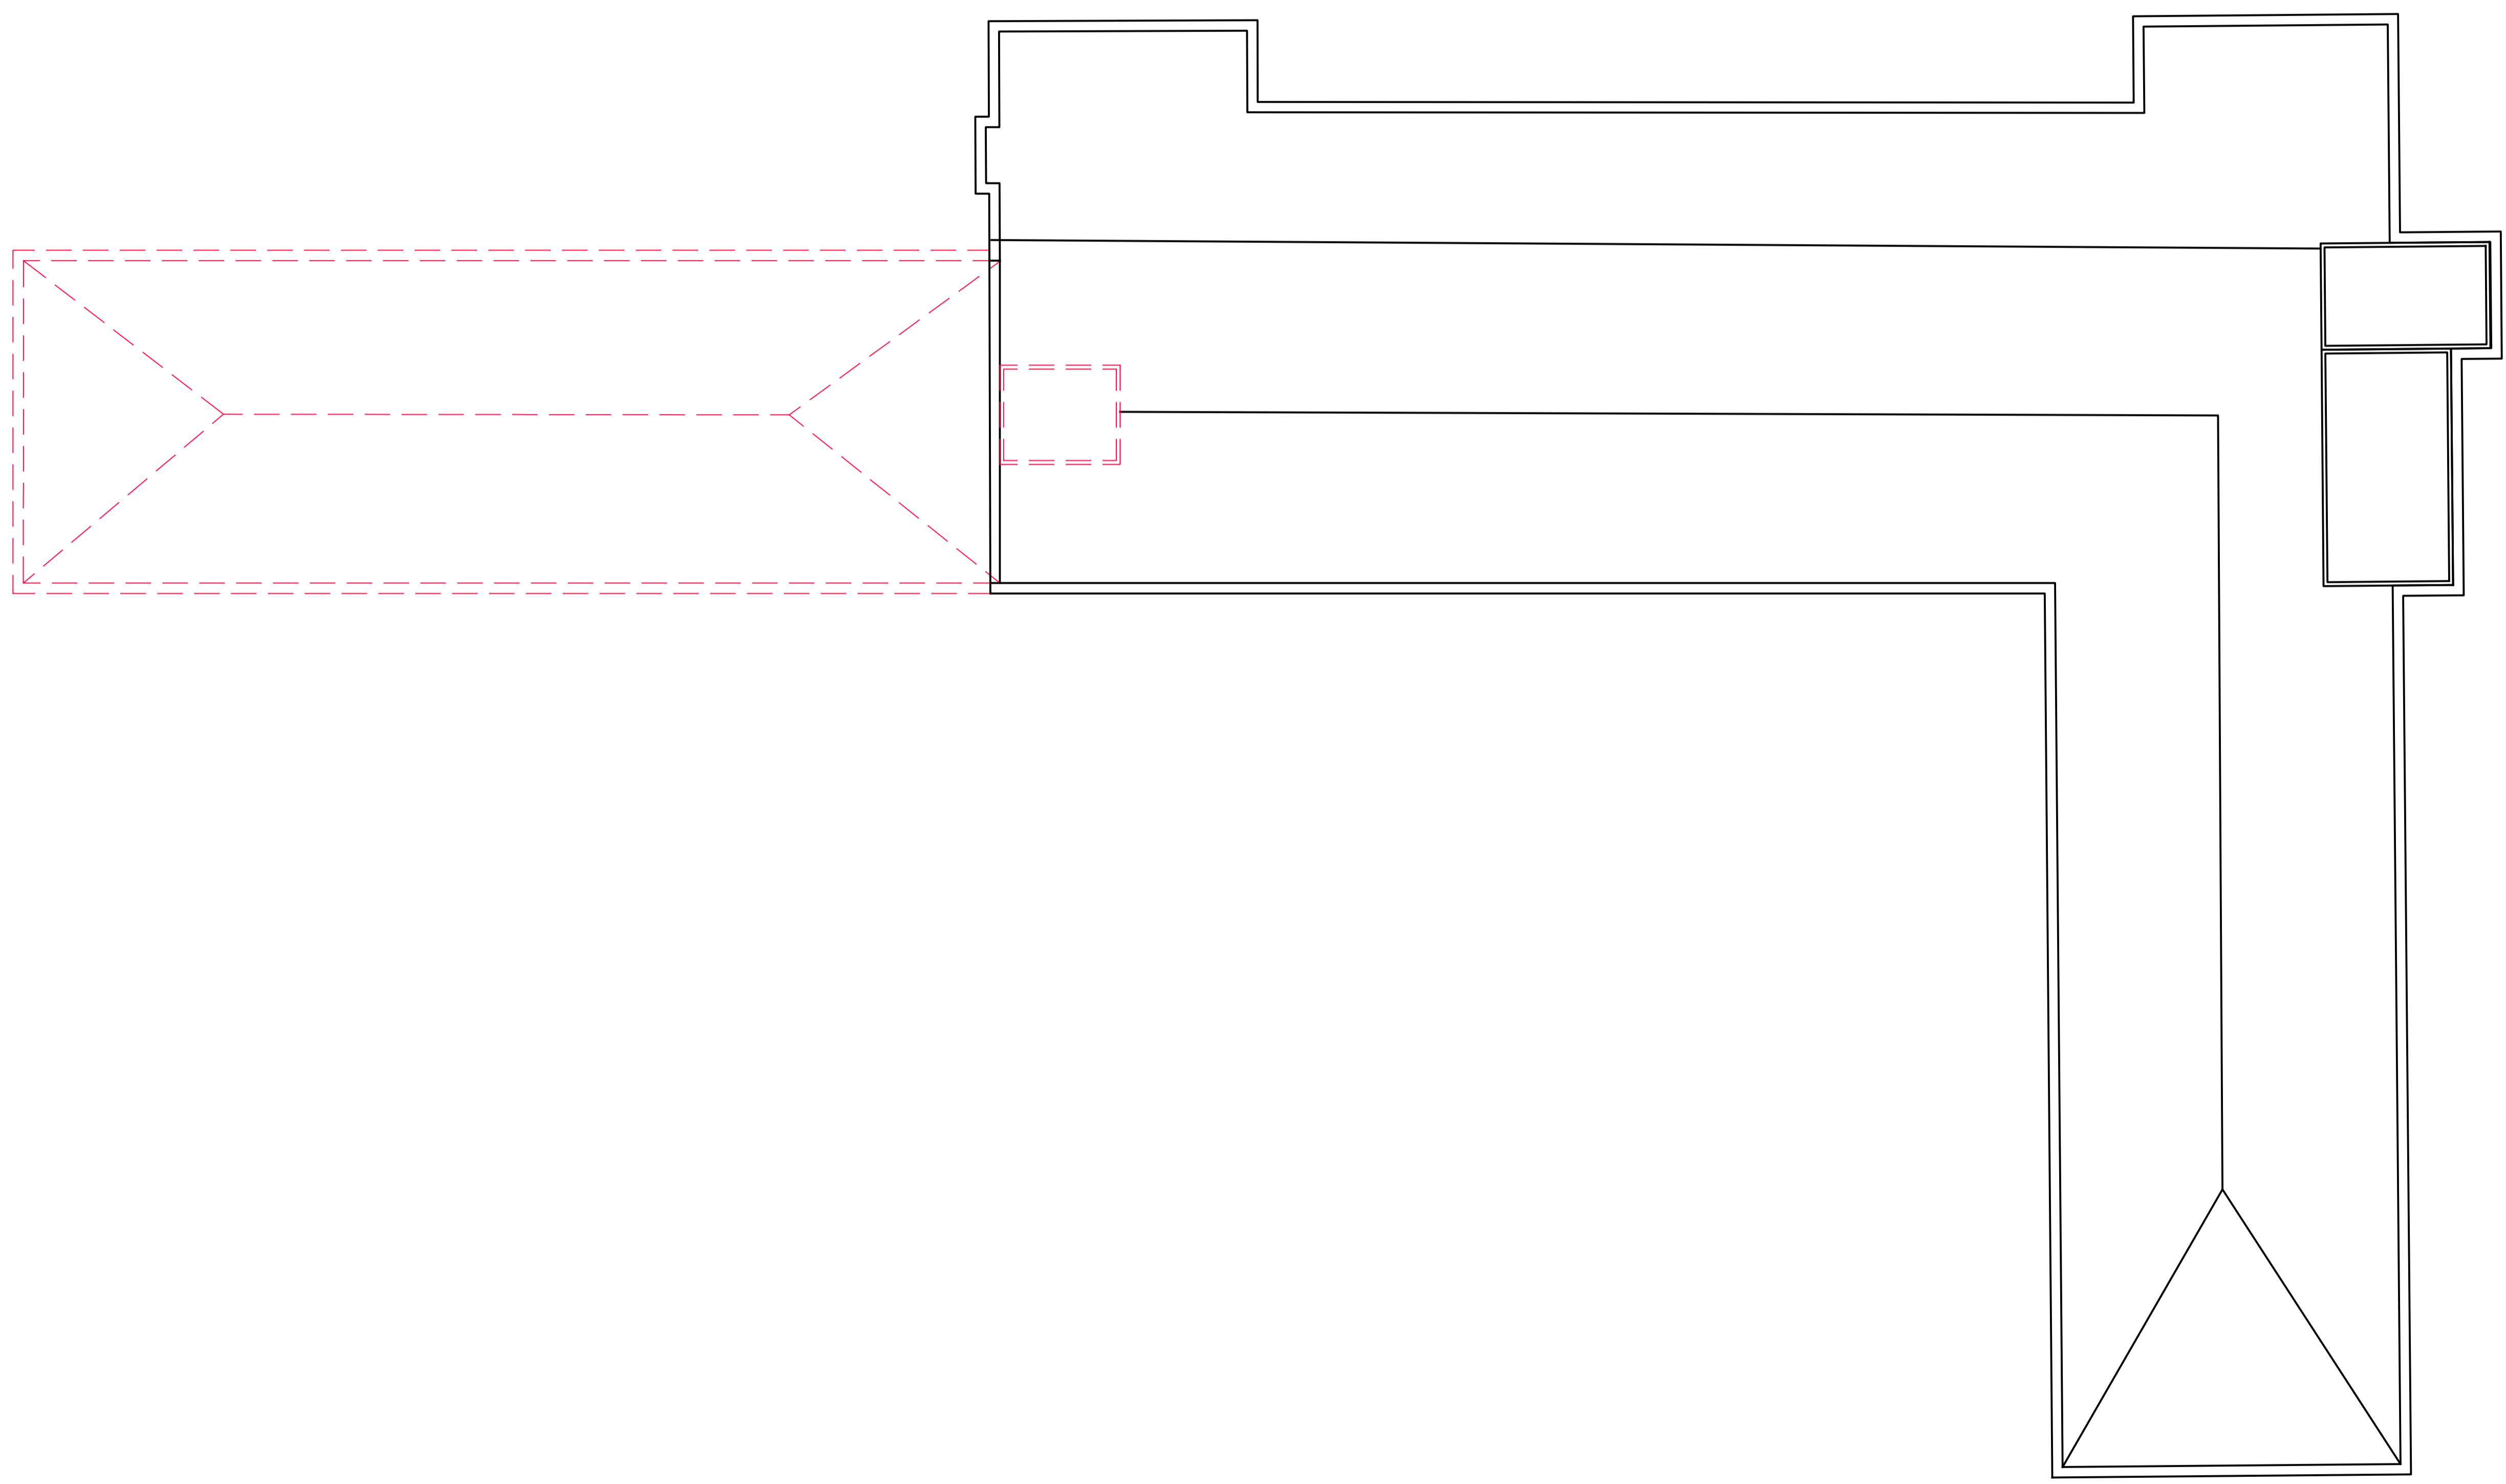

TO BE DEMOLISHED SHOWN IN RED DASH LINE

B	DA SUBMISSION	02.09.11
A	ISSUE FOR INFORMATION	30.08.11
REV	DESCRIPTION	DATE

CONSULTANT
HASSELL LIMITED ACN 007 711 435
88 CUMBERLAND STREET
SYDNEY NSW 2000 AUSTRALIA
SYDNEY@HASSELL.COM.AU
T 61 2 9273 2300 F 61 2 9273 2345

HASSELL

PROJECT
ILLAWARRA ELECTIVE SURGERY
WOLLONGONG HOSPITAL
WOLLONGONG, NSW

DRAWING TITLE
ELOURA DEMOLITION ROOF

STATUS
DEVELOPMENT APPROVAL

SCALE @ A1	DRAWN	CO-ORD	REVIEWED	APPROVED
1:100	--	LvE	CC	
PROJECT NUMBER	DRAWING NUMBER	REV		
AX003042	EH - DA 304	B		

PROPOSED WORKS IN BLUE

LOFTUS STREET

BOUNDARY

1500

IESS PROPOSED WORKS

IESS PROPOSED HOSPITAL STREET

IESS PROPOSED WORKS

BUILDING FOOTINGS

BALCONY

ACOMM ACOMM ACOMM ACOMM ACOMM ACOMM

RL 43.77

STORE ACOMM LAUNDRY BOILER ROOM LAVATORY

NURSES BATHRM/

BATHRM/ WCs

RECREATION LECTURE ROOM

KITCHEN

ACCOM

SITTING ROOM


PASSAGE

ACOMM

ACOMM

ACOMM

ACOMM

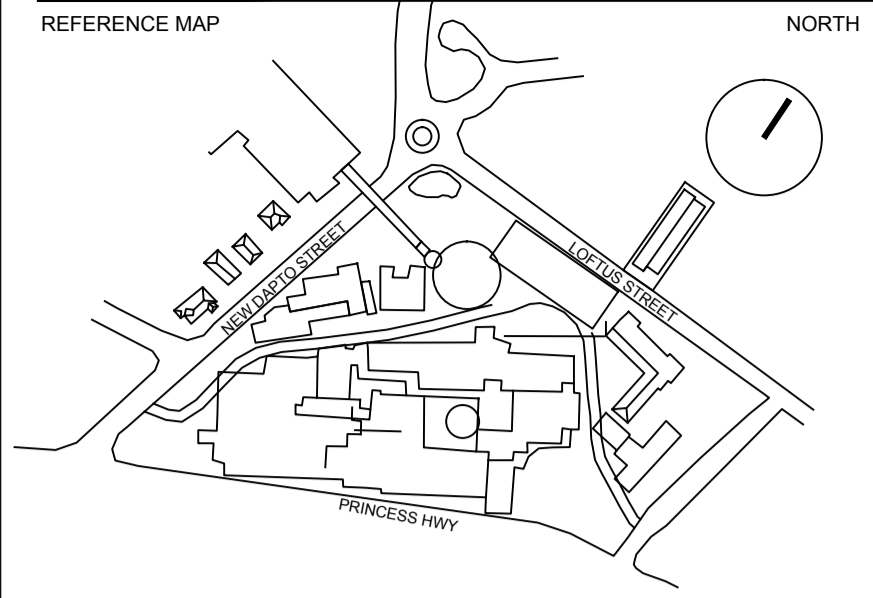

- NOTES
- DO NOT SCALE DRAWINGS. WRITTEN DIMENSIONS GOVERN.
 - ALL DIMENSIONS ARE IN MILLIMETRES UNLESS NOTED OTHERWISE.
 - ALL DIMENSIONS SHALL BE VERIFIED ON SITE BEFORE PROCEEDING WITH THE WORK. HASSELL SHALL BE NOTIFIED IN WRITING OF ANY DISCREPANCIES.
 - THIS DRAWING MUST BE READ IN CONJUNCTION WITH ALL RELEVANT CONTRACTS, SPECIFICATIONS AND DRAWINGS.

© COPYRIGHT OF THIS DRAWING IS VESTED IN HASSELL. LTD. 2010 HASSELL. LTD.

THIS DRAWING IS AN UNCONTROLLED COPY. UNLESS NOTED OTHERWISE.

REV	DESCRIPTION	DATE
B	ISSUE FOR INFORMATION	02.09.11
A		30.08.11

CONSULTANT
 HASSELL LIMITED ACN 007 711 435
 88 CUMBERLAND STREET
 SYDNEY NSW 2000 AUSTRALIA
 SYDNEY@HASSELL.COM.AU
 T 61 2 9273 2300 F 61 2 9273 2345



HASSELL
 PROJECT
 ILLAWARRA ELECTIVE SURGERY
 WOLLONGONG HOSPITAL
 WOLLONGONG, NSW

DRAWING TITLE
 ELOURA LEVEL 0 PROPOSED

STATUS
 DEVELOPMENT APPROVAL

SCALE @ A1	DRAWN	CO-ORD	REVIEWED	APPROVED
1:100 mm_XREF	LvE	CC		
PROJECT NUMBER	DRAWING NUMBER	REV		
AX003042	EH - DA 310	B		

PROPOSED WORKS IN BLUE

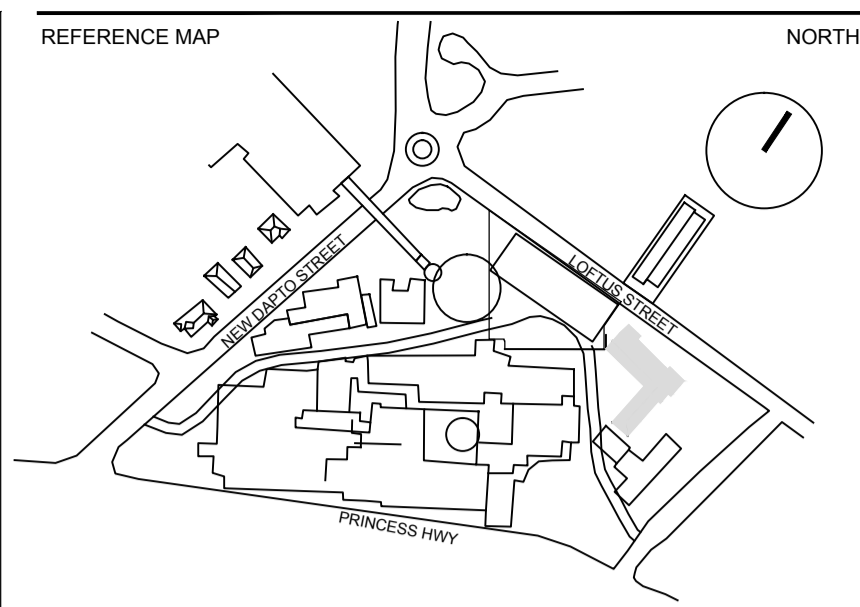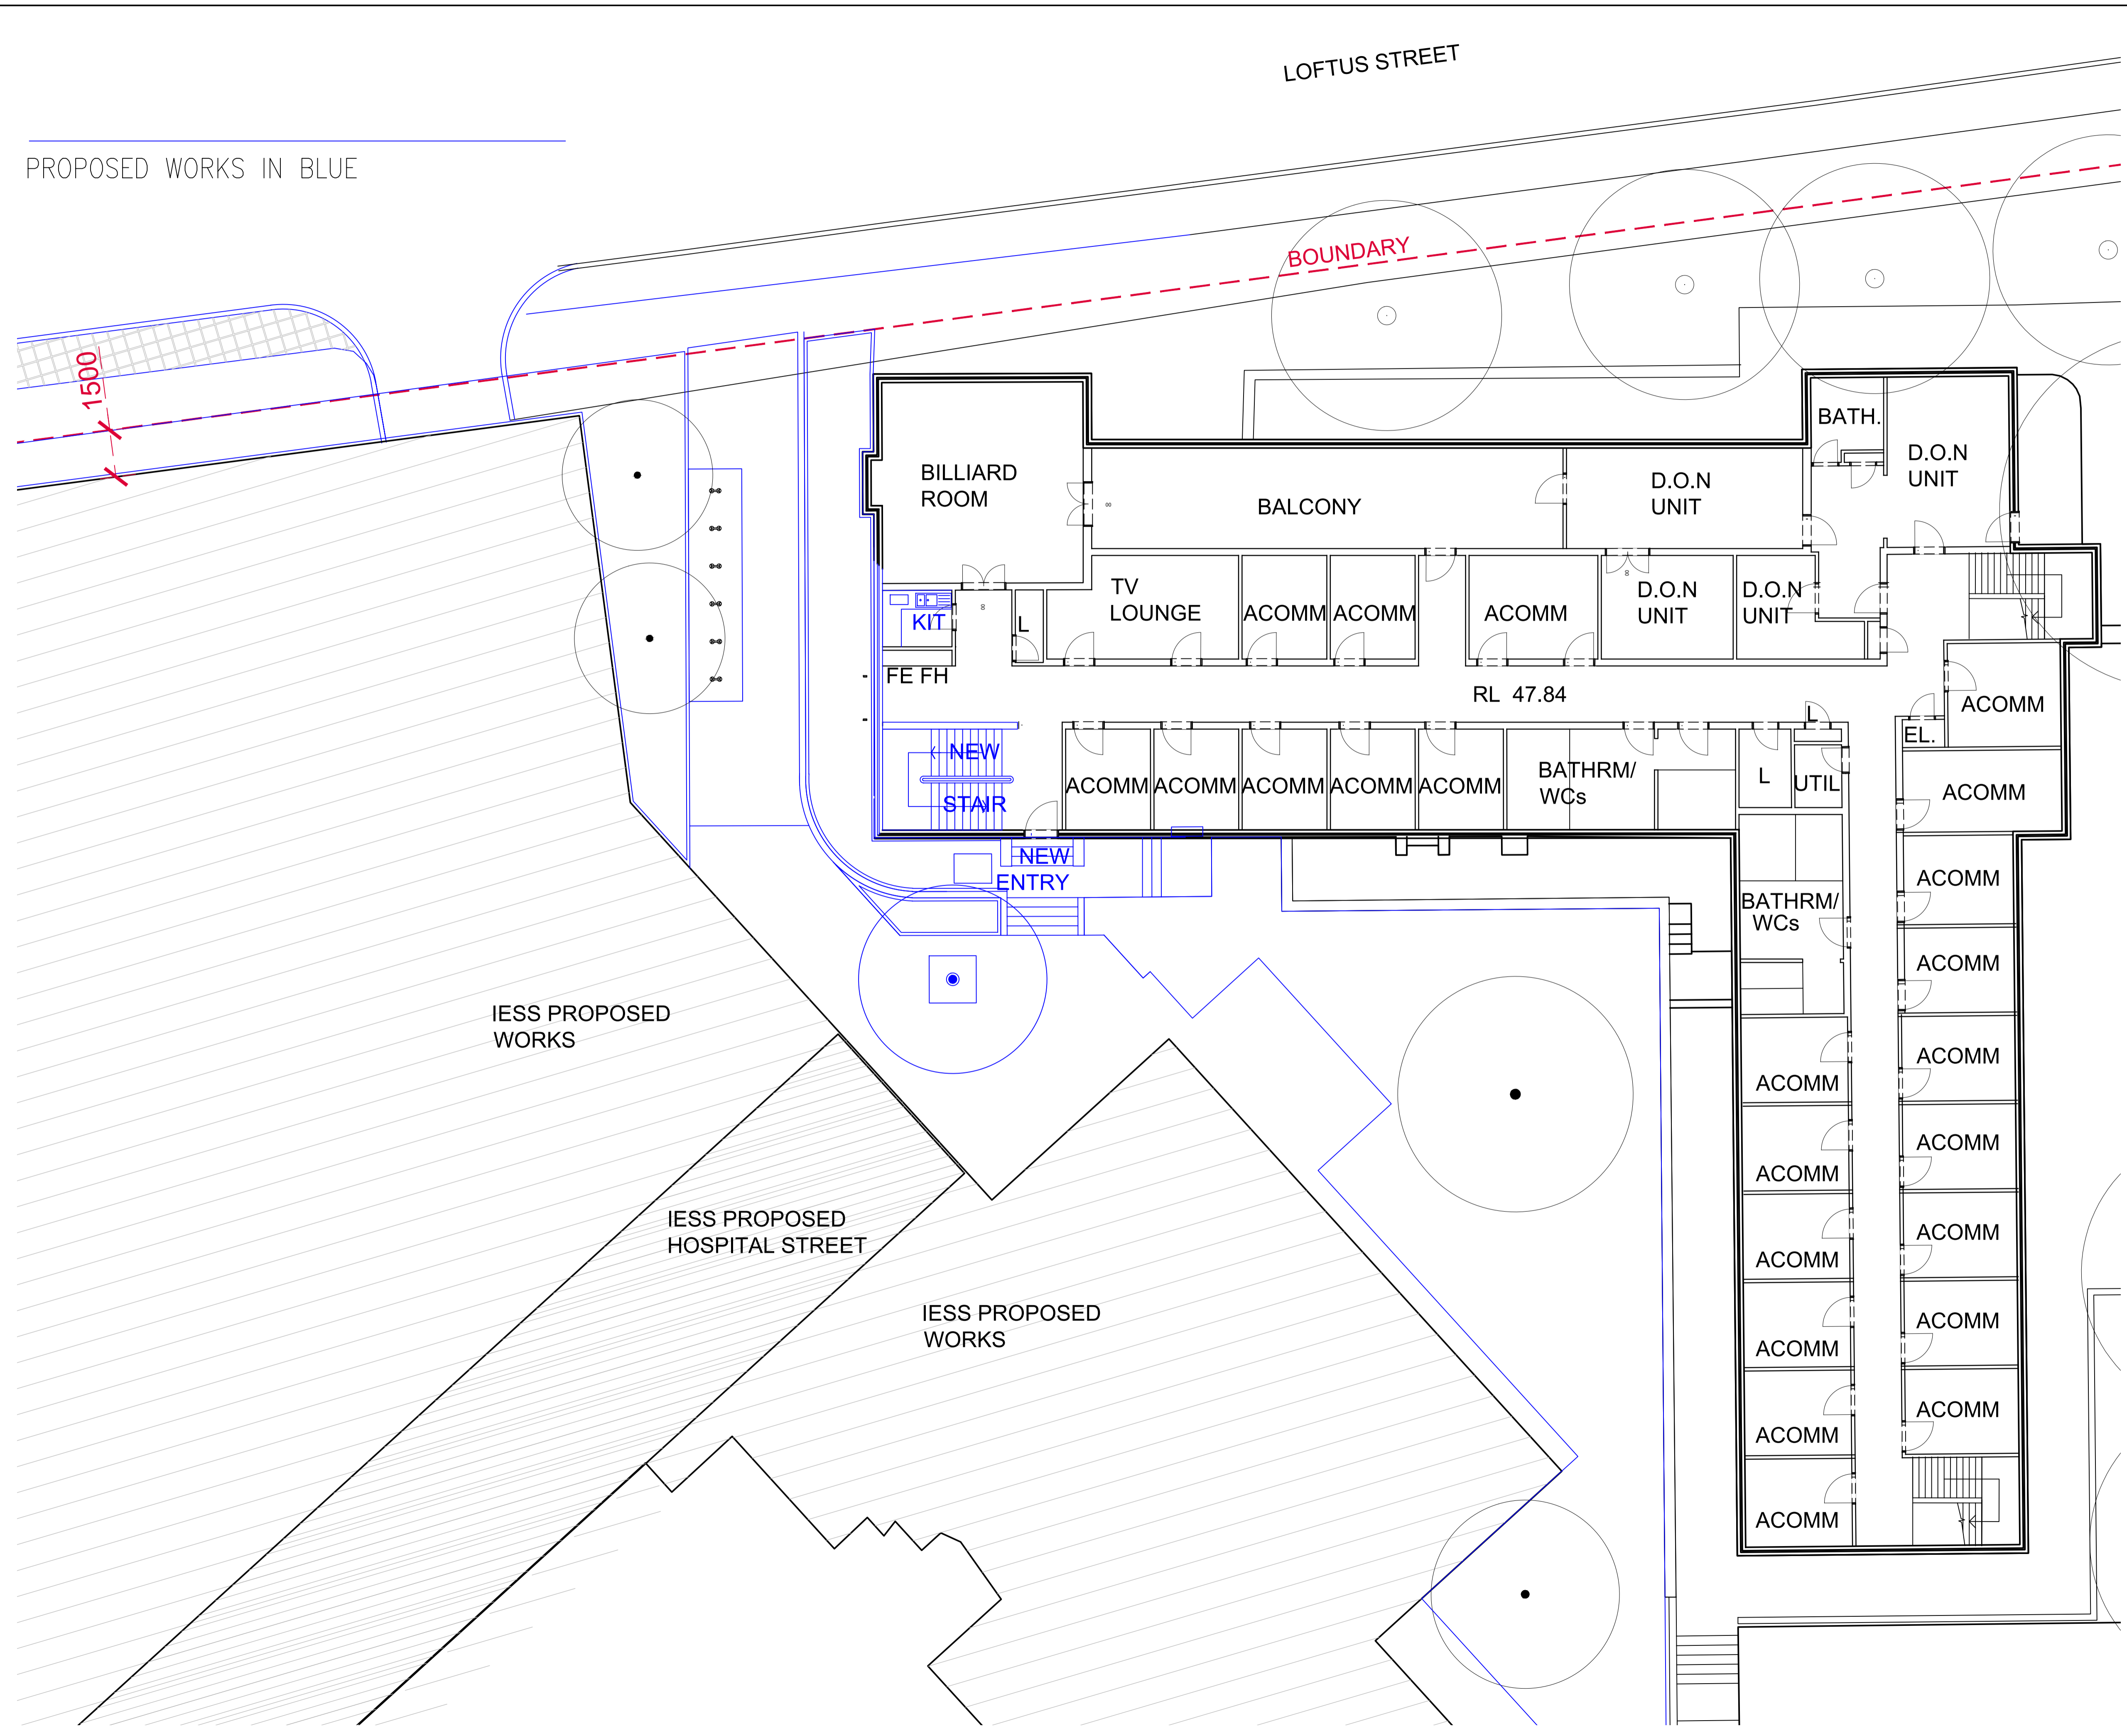

- NOTES
- DO NOT SCALE DRAWINGS. WRITTEN DIMENSIONS GOVERN.
 - ALL DIMENSIONS ARE IN MILLIMETRES UNLESS NOTED OTHERWISE.
 - ALL DIMENSIONS SHALL BE VERIFIED ON SITE BEFORE PROCEEDING WITH THE WORK. HASSELL SHALL BE NOTIFIED IN WRITING OF ANY DISCREPANCIES.
 - THIS DRAWING MUST BE READ IN CONJUNCTION WITH ALL RELEVANT CONTRACTS, SPECIFICATIONS AND DRAWINGS.

© COPYRIGHT OF THIS DRAWING IS VESTED IN HASSELL. LTD.
2010 HASSELL. LTD.

THIS DRAWING IS AN UNCONTROLLED COPY, UNLESS NOTED OTHERWISE.

A		ISSUE FOR INFORMATION	30.08.11
REV	DESCRIPTION		DATE
B			02.09.11

CONSULTANT
 HASSELL LIMITED ACN 007 711 435
 88 CUMBERLAND STREET
 SYDNEY NSW 2000 AUSTRALIA
 SYDNEY@HASSELL.COM.AU
 T 61 2 9273 2300 F 61 2 9273 2345



HASSELL
 PROJECT
 ILLAWARRA ELECTIVE SURGERY
 WOLLONGONG HOSPITAL
 WOLLONGONG, NSW

DRAWING TITLE
ELOURA LEVEL 1 PROPOSED

STATUS
DEVELOPMENT APPROVAL

SCALE @ A1	DRAWN	CO-ORD	REVIEWED	APPROVED
1:100mm_XREF	LvE	CC		
PROJECT NUMBER	DRAWING NUMBER	REV		
AX003042	EH - DA 311	B		

PROPOSED WORKS IN BLUE

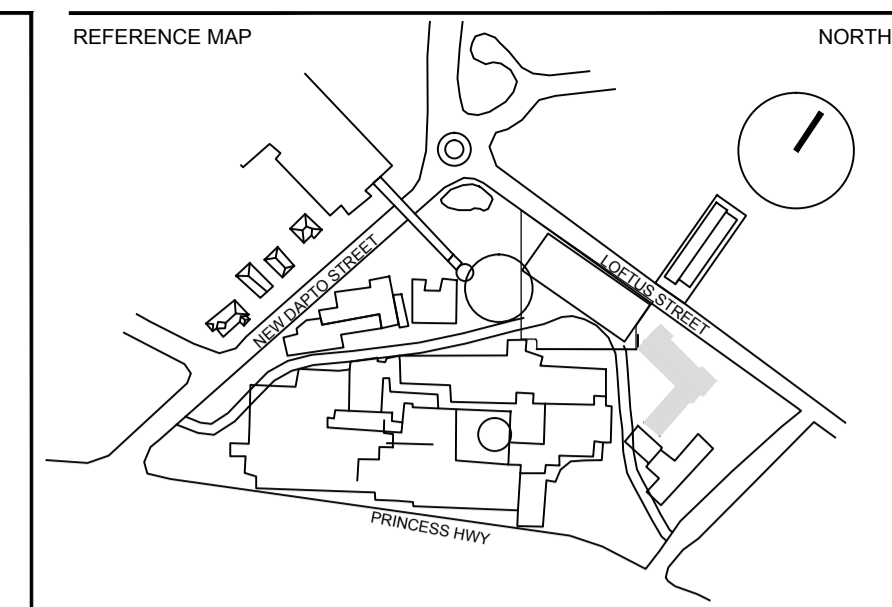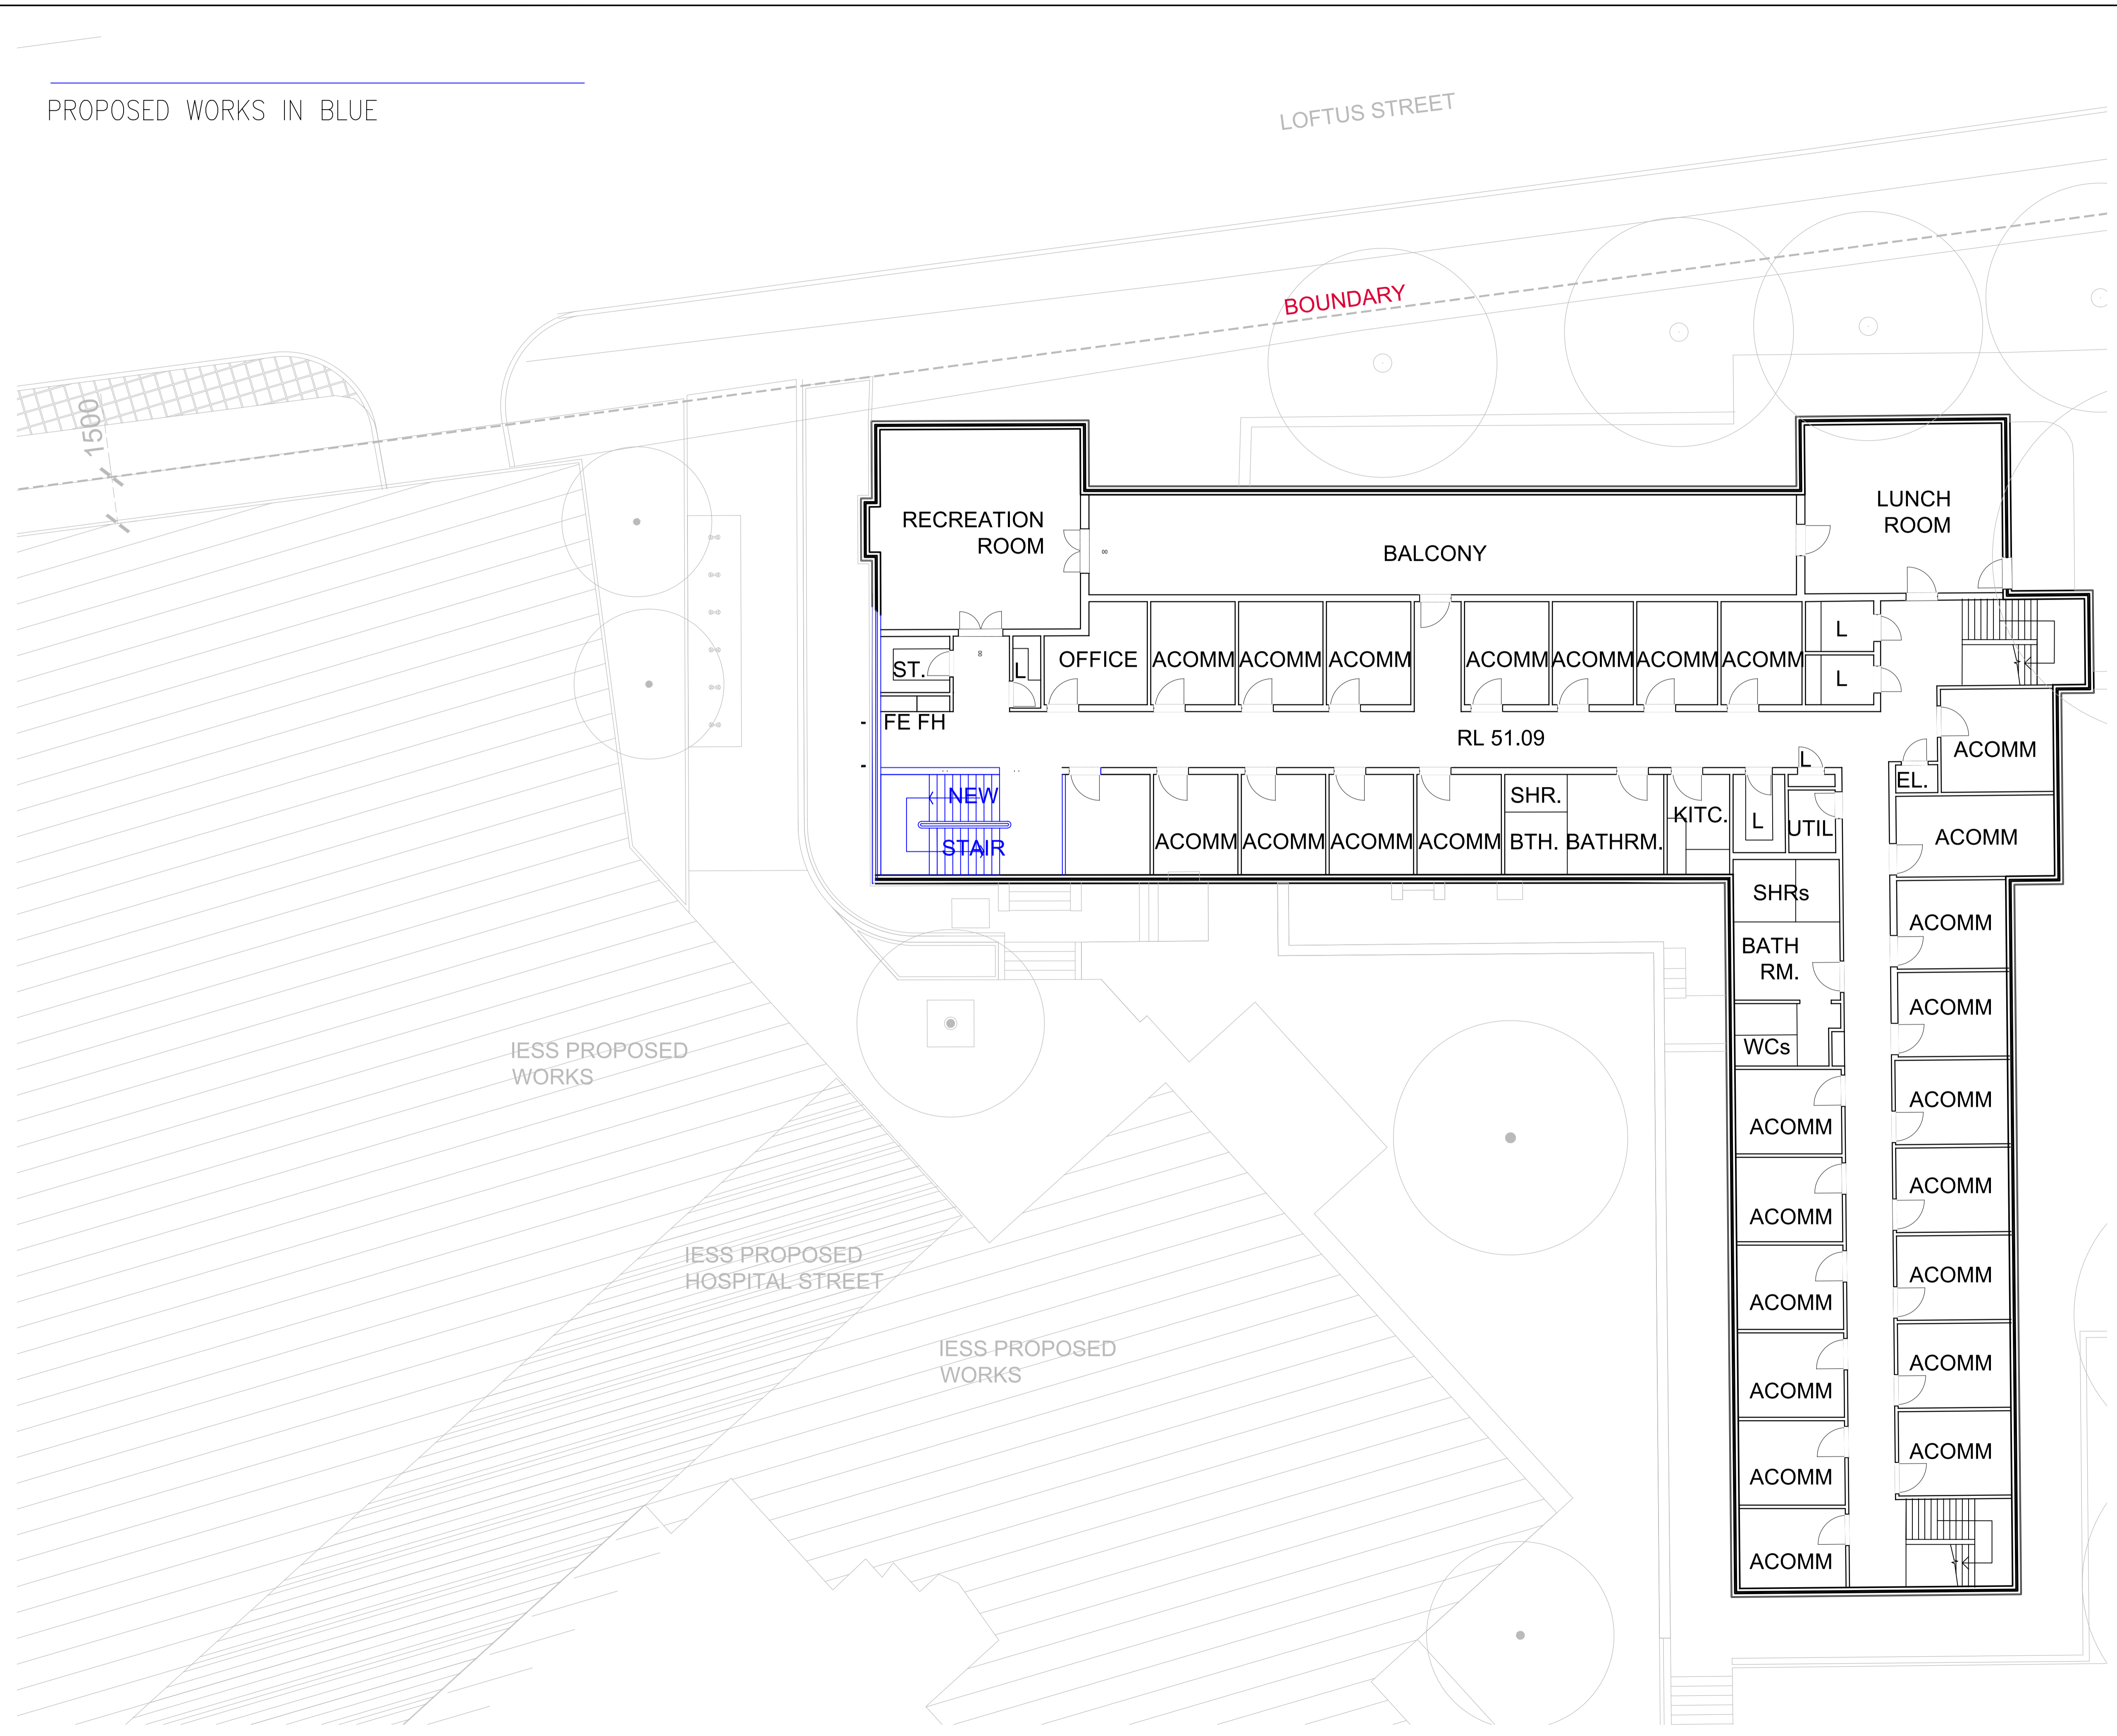

- NOTES
1. DO NOT SCALE DRAWINGS. WRITTEN DIMENSIONS GOVERN.
 2. ALL DIMENSIONS ARE IN MILLIMETRES UNLESS NOTED OTHERWISE.
 3. ALL DIMENSIONS SHALL BE VERIFIED ON SITE BEFORE PROCEEDING WITH THE WORK. HASSELL SHALL BE NOTIFIED IN WRITING OF ANY DISCREPANCIES.
 4. THIS DRAWING MUST BE READ IN CONJUNCTION WITH ALL RELEVANT CONTRACTS, SPECIFICATIONS AND DRAWINGS.

© COPYRIGHT OF THIS DRAWING IS VESTED IN HASSELL. LTD.
2010 HASSELL. LTD.

THIS DRAWING IS AN UNCONTROLLED COPY. UNLESS NOTED OTHERWISE.

REV	DESCRIPTION	DATE
B	DA SUBMISSION	02.09.11
A	ISSUE FOR INFORMATION	30.08.11

REV	DESCRIPTION	DATE
B	DA SUBMISSION	02.09.11
A	ISSUE FOR INFORMATION	30.08.11

CONSULTANT
 HASSELL LIMITED ACN 007 711 435
 88 CUMBERLAND STREET
 SYDNEY NSW 2000 AUSTRALIA
 SYDNEY@HASSELL.COM.AU
 T 61 2 9273 2300 F 61 2 9273 2345

HASSELL



PROJECT
 ILLAWARRA ELECTIVE SURGERY
 WOLLONGONG HOSPITAL
 WOLLONGONG, NSW

DRAWING TITLE
 ELOURA LEVEL 2 PROPOSED

STATUS
 DEVELOPMENT APPROVAL

SCALE @ A1	DRAWN	CO-ORD	REVIEWED	APPROVED
1:100 mm_XREF	LvE	CC		
PROJECT NUMBER	DRAWING NUMBER	REV		
AX003042	EH - DA 312	B		

PROPOSED WORKS IN BLUE

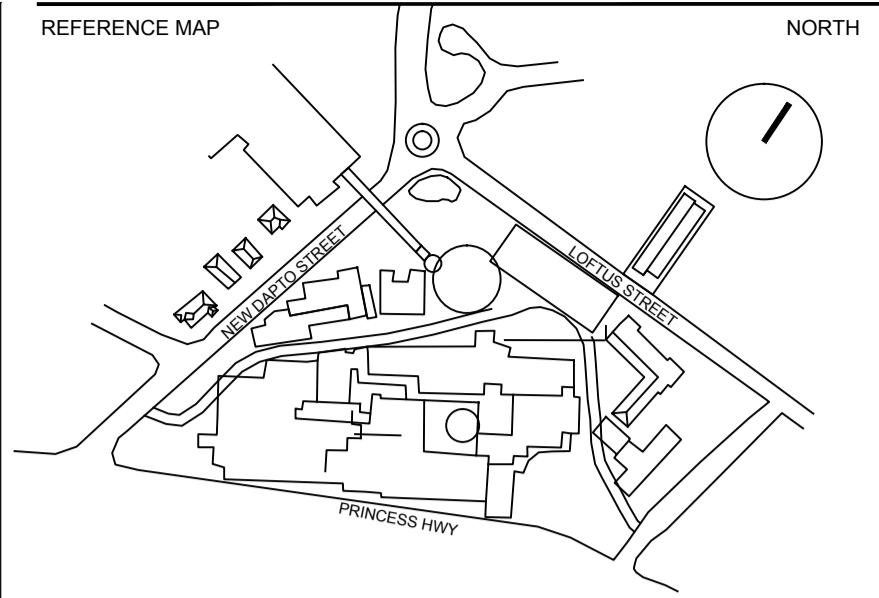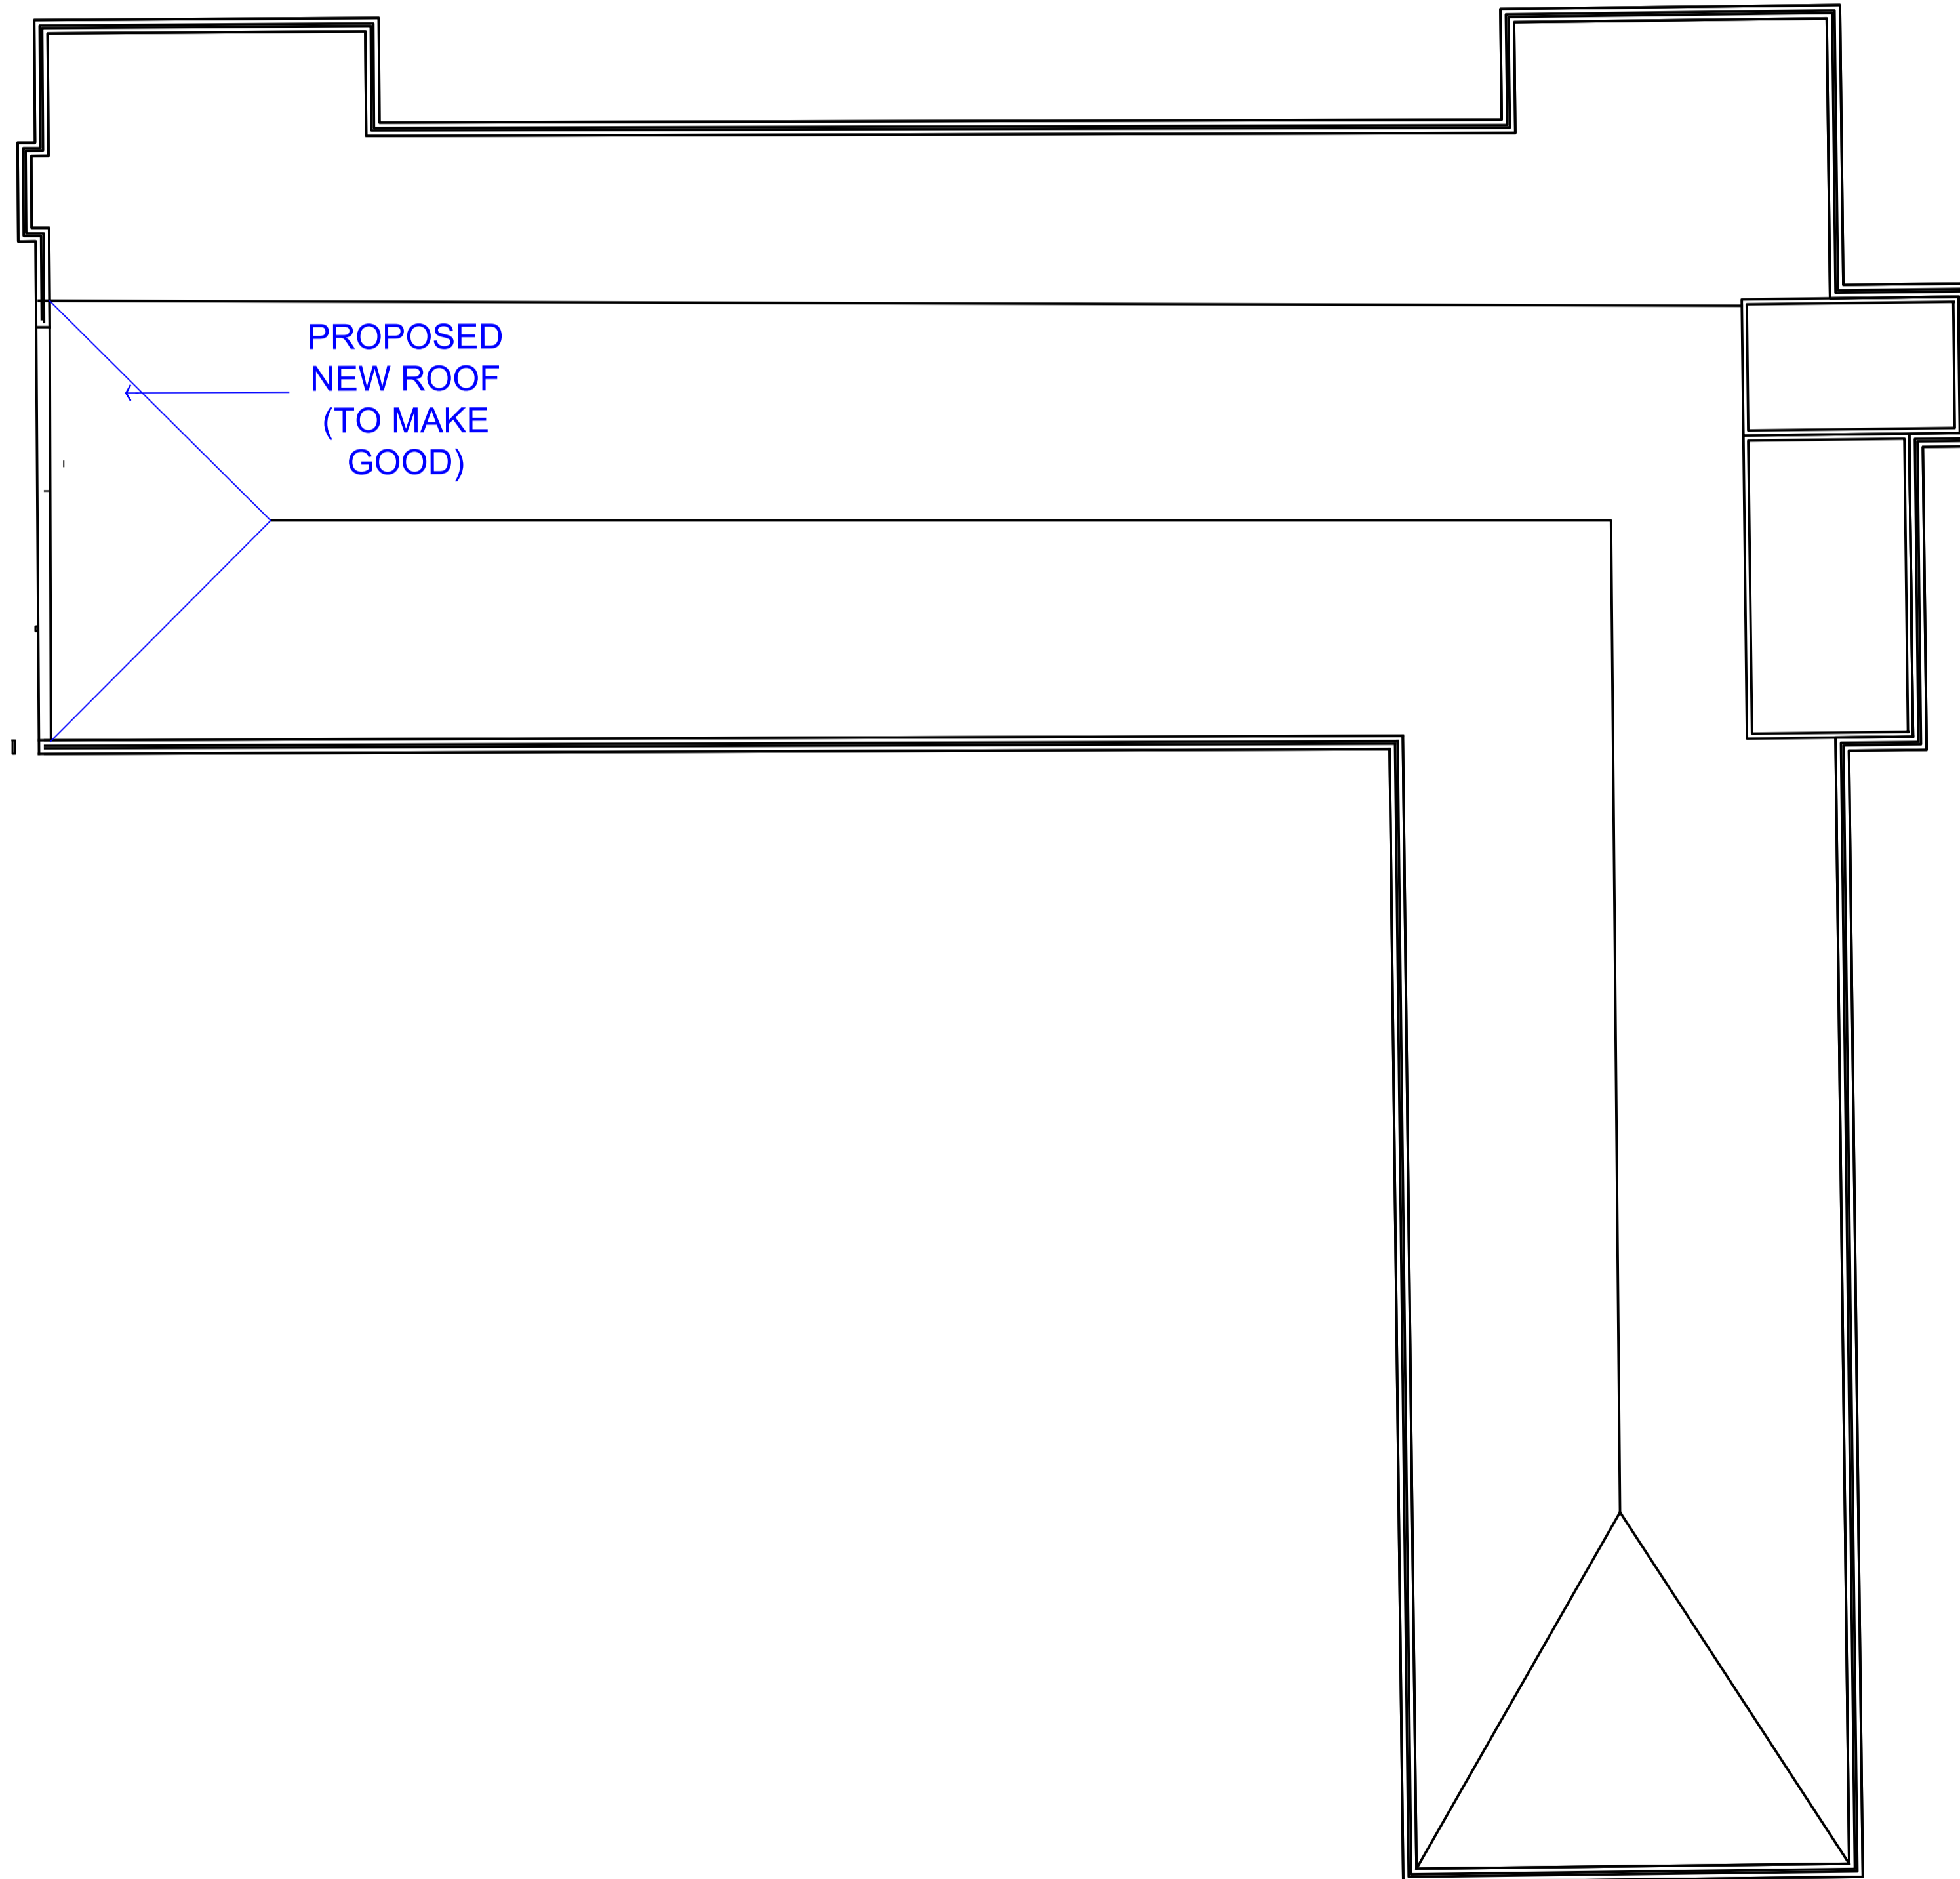

- NOTES
1. DO NOT SCALE DRAWINGS. WRITTEN DIMENSIONS GOVERN.
 2. ALL DIMENSIONS ARE IN MILLIMETRES UNLESS NOTED OTHERWISE.
 3. ALL DIMENSIONS SHALL BE VERIFIED ON SITE BEFORE PROCEEDING WITH THE WORK. HASSELL SHALL BE NOTIFIED IN WRITING OF ANY DISCREPANCIES.
 4. THIS DRAWING MUST BE READ IN CONJUNCTION WITH ALL RELEVANT CONTRACTS, SPECIFICATIONS AND DRAWINGS.

© COPYRIGHT OF THIS DRAWING IS VESTED IN HASSELL. LTD.
2010 HASSELL. LTD.

THIS DRAWING IS AN UNCONTROLLED COPY, UNLESS NOTED OTHERWISE.

B	DA SUBMISSION	02.09.11
A	ISSUE FOR INFORMATION	30.08.11
REV	DESCRIPTION	DATE

CONSULTANT
 HASSELL LIMITED ACN 007 711 435
 88 CUMBERLAND STREET
 SYDNEY NSW 2000 AUSTRALIA
 SYDNEY@HASSELL.COM.AU
 T 61 2 9273 2300 F 61 2 9273 2345

HASSELL

PROJECT
 ILLAWARRA ELECTIVE SURGERY
 WOLLONGONG HOSPITAL
 WOLLONGONG, NSW


DRAWING TITLE
 ELOURA LEVEL 3 PROPOSED

STATUS
 DEVELOPMENT APPROVAL


SCALE @ A1	DRAWN	CO-ORD	REVIEWED	APPROVED
1:100	--	LvE	CC	
PROJECT NUMBER	DRAWING NUMBER		REV	
AX003042	EH - DA 313		B	

PROPOSED WORKS IN BLUE

TO BE DEMOLISHED SHOWN IN RED DASH LINE

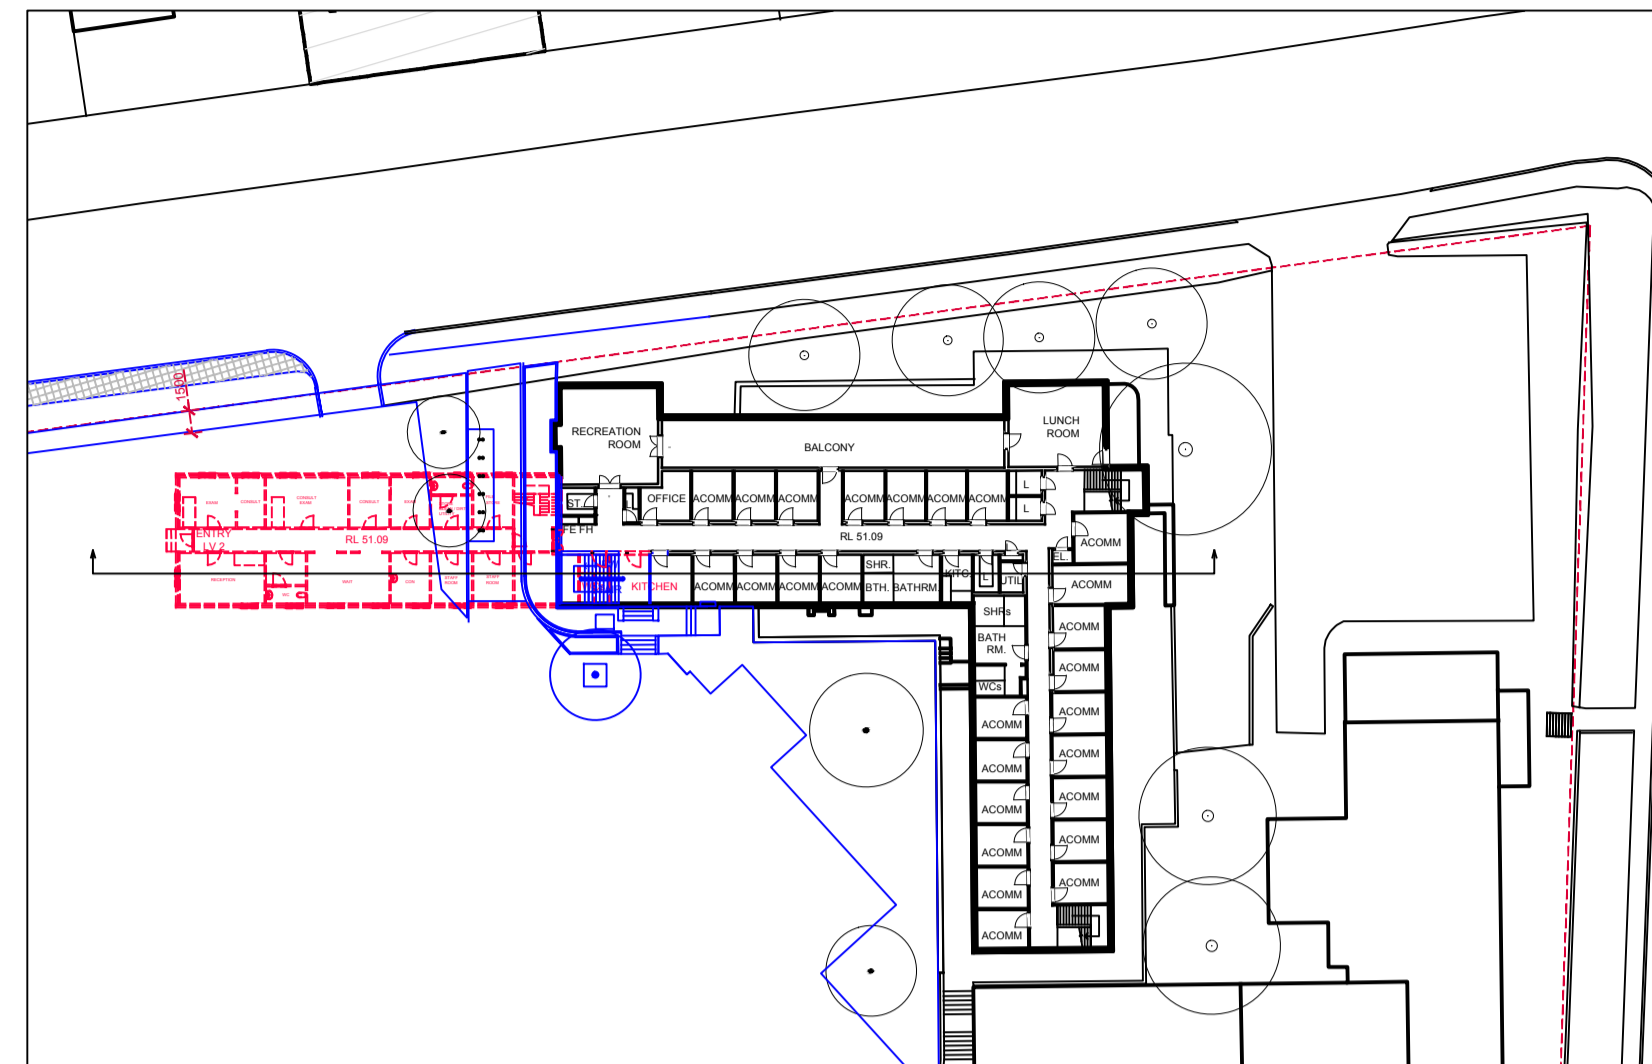


KEY PLAN
1:500

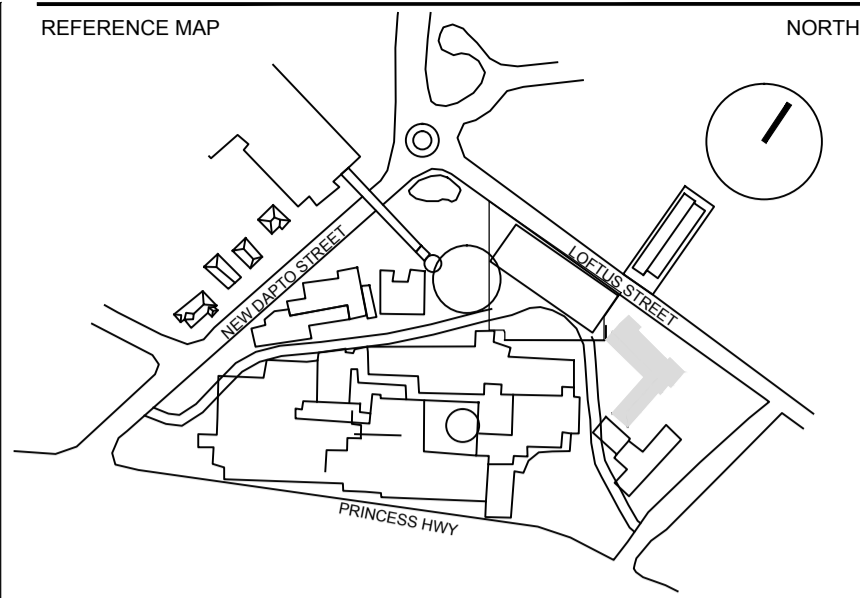


- NOTES
- DO NOT SCALE DRAWINGS. WRITTEN DIMENSIONS GOVERN.
 - ALL DIMENSIONS ARE IN MILLIMETRES UNLESS NOTED OTHERWISE.
 - ALL DIMENSIONS SHALL BE VERIFIED ON SITE BEFORE PROCEEDING WITH THE WORK. HASSELL SHALL BE NOTIFIED IN WRITING OF ANY DISCREPANCIES.
 - THIS DRAWING MUST BE READ IN CONJUNCTION WITH ALL RELEVANT CONTRACTS, SPECIFICATIONS AND DRAWINGS.

© COPYRIGHT OF THIS DRAWING IS VESTED IN HASSELL. LTD.
2010 HASSELL. LTD.


THIS DRAWING IS AN UNCONTROLLED COPY, UNLESS NOTED OTHERWISE.

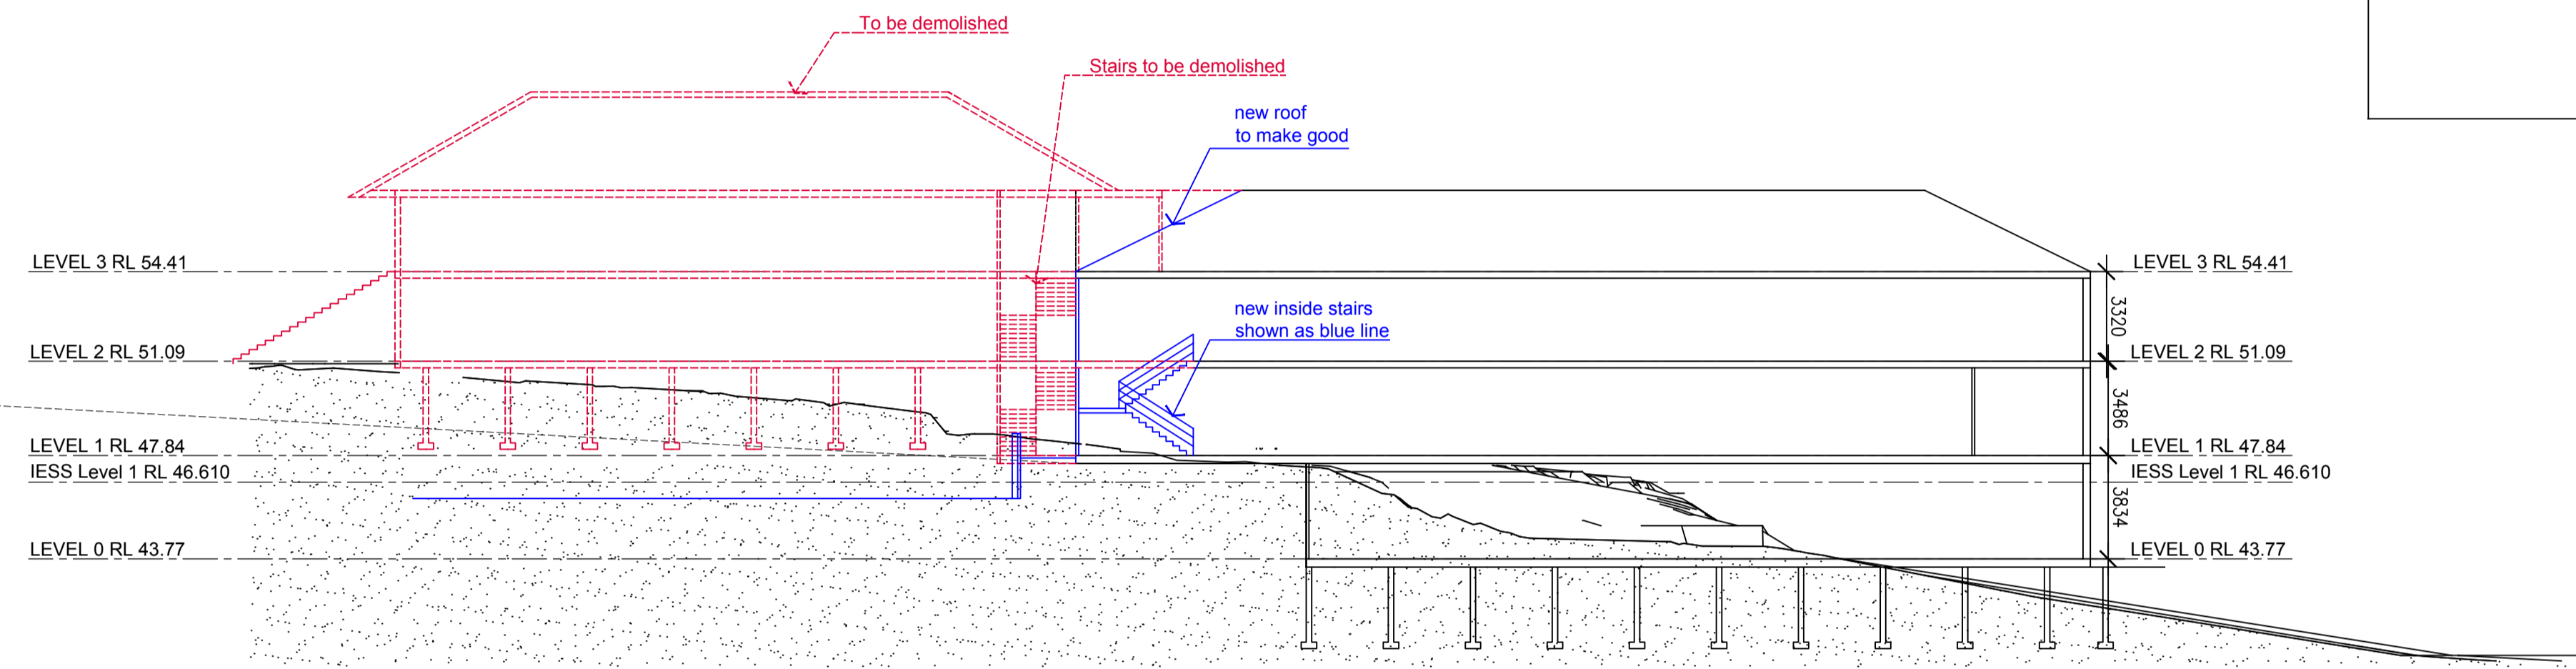

Section (demolished and new)

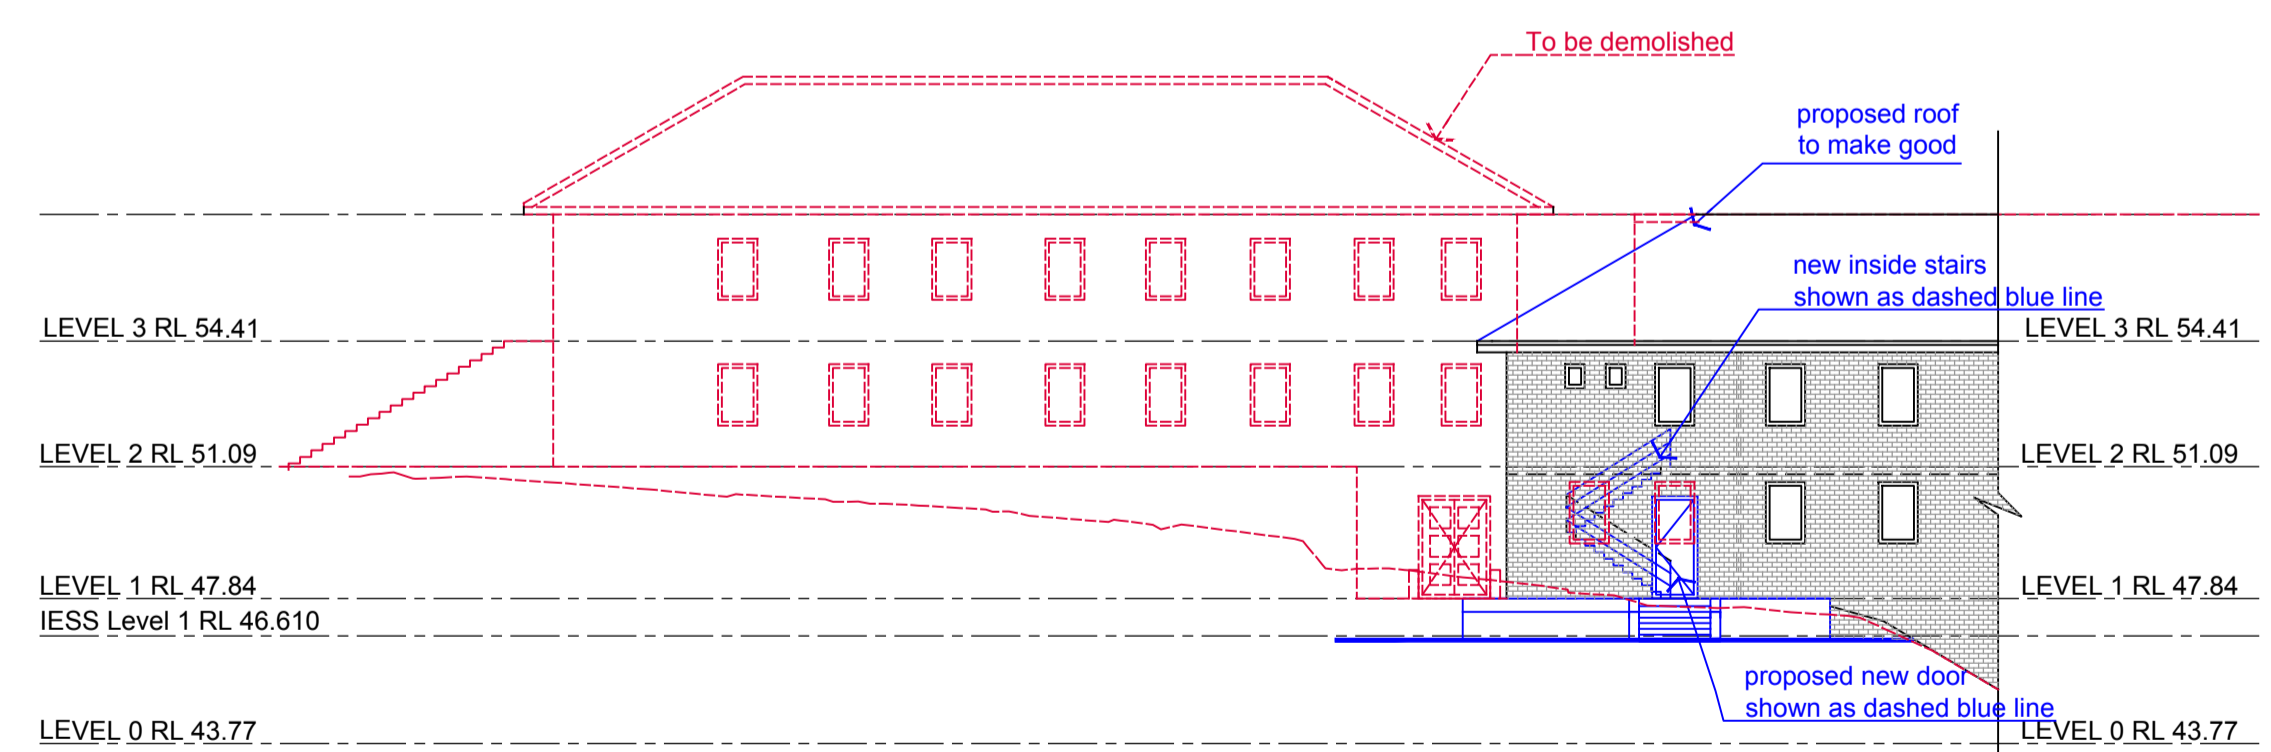

Proposed south elevation

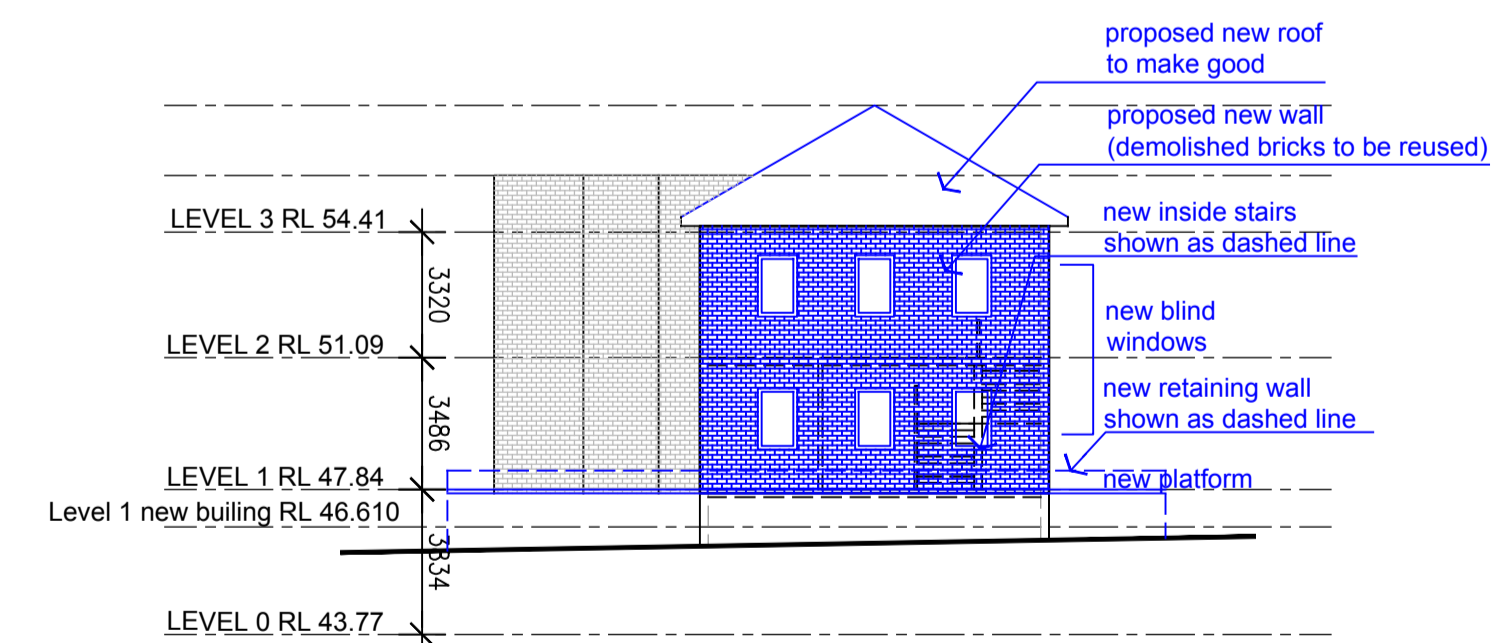

Proposed west elevation

B	DA SUBMISSION	02.09.11
A	ISSUE FOR INFORMATION	30.08.11
REV	DESCRIPTION	DATE


CONSULTANT
HASSELL LIMITED ACN 007 711 435
88 CUMBERLAND STREET
SYDNEY NSW 2000 AUSTRALIA
SYDNEY@HASSELL.COM.AU
T 61 2 9273 2300 F 61 2 9273 2345

HASSELL
PROJECT
ILLAWARRA ELECTIVE SURGERY
WOLLONGONG HOSPITAL
WOLLONGONG, NSW

DRAWING TITLE
ELOURA SECTION AND ELEVATIONS

STATUS
DEVELOPMENT APPROVAL

SCALE @ A1	DRAWN	CO-ORD	REVIEWED	APPROVED
1:2000000_XREF	LvE	CC		
PROJECT NUMBER	DRAWING NUMBER	REV		
AX003042	EH - DA 320	B		

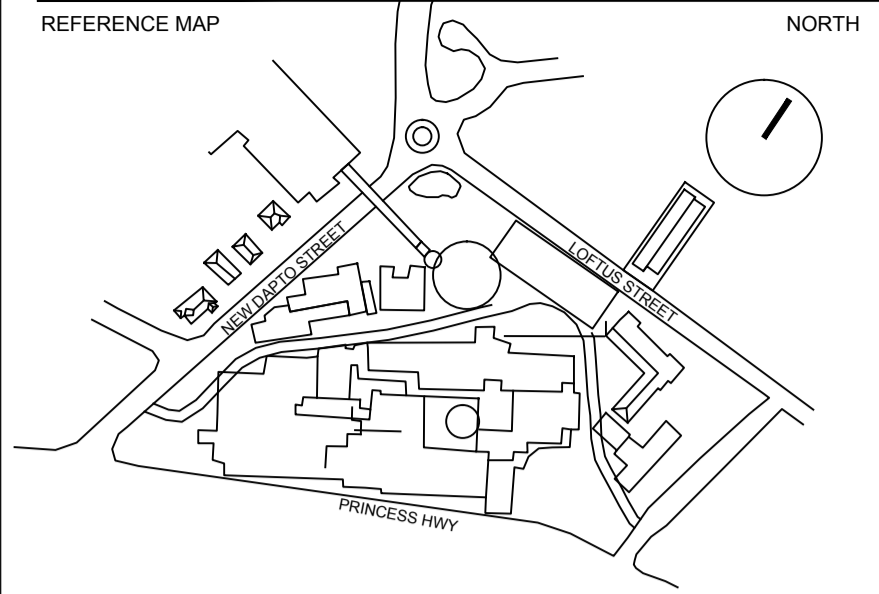

- NOTES
1. DO NOT SCALE DRAWINGS. WRITTEN DIMENSIONS GOVERN.
 2. ALL DIMENSIONS ARE IN MILLIMETRES UNLESS NOTED OTHERWISE.
 3. ALL DIMENSIONS SHALL BE VERIFIED ON SITE BEFORE PROCEEDING WITH THE WORK. HASSELL SHALL BE NOTIFIED IN WRITING OF ANY DISCREPANCIES.
 4. THIS DRAWING MUST BE READ IN CONJUNCTION WITH ALL RELEVANT CONTRACTS, SPECIFICATIONS AND DRAWINGS.

© COPYRIGHT OF THIS DRAWING IS VESTED IN HASSELL. LTD.
2010 HASSELL. LTD.

THIS DRAWING IS AN UNCONTROLLED COPY, UNLESS NOTED OTHERWISE.

CONSULTANT				
HASSELL LIMITED ACN 007 711 435 88 CUMBERLAND STREET SYDNEY NSW 2000 AUSTRALIA SYDNEY@HASSELL.COM.AU T 61 2 9273 2300 F 61 2 9273 2345				
HASSELL				
PROJECT				
ILLAWARRA ELECTIVE SURGERY WOLLONGONG HOSPITAL WOLLONGONG, NSW				
DRAWING TITLE				
ELOURA GENERAL PERSPECTIVE				
STATUS				
DEVELOPMENT APPROVAL				
SCALE @ A1	DRAWN	CO-ORD	REVIEWED	APPROVED
0.012309	--	LvE	CC	
PROJECT NUMBER		DRAWING NUMBER		REV
AX003042		EH - DA 330		B

B	DA SUBMISSION	02.09.11
A	ISSUE FOR INFORMATION	30.08.11
REV	DESCRIPTION	DATE

B	DA SUBMISSION	02.09.11
A	ISSUE FOR INFORMATION	30.08.11
REV	DESCRIPTION	DATE

