



COMPARISON LEGEND

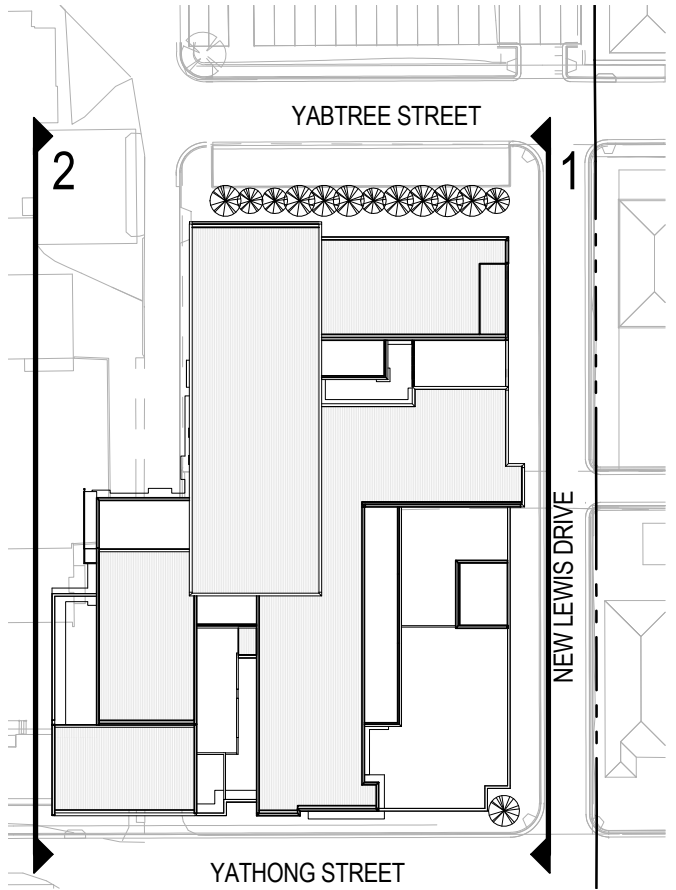

SOLID BLACK LINE CURRENT SCHEME

DASHED RED LINE PREVIOUS SCHEME

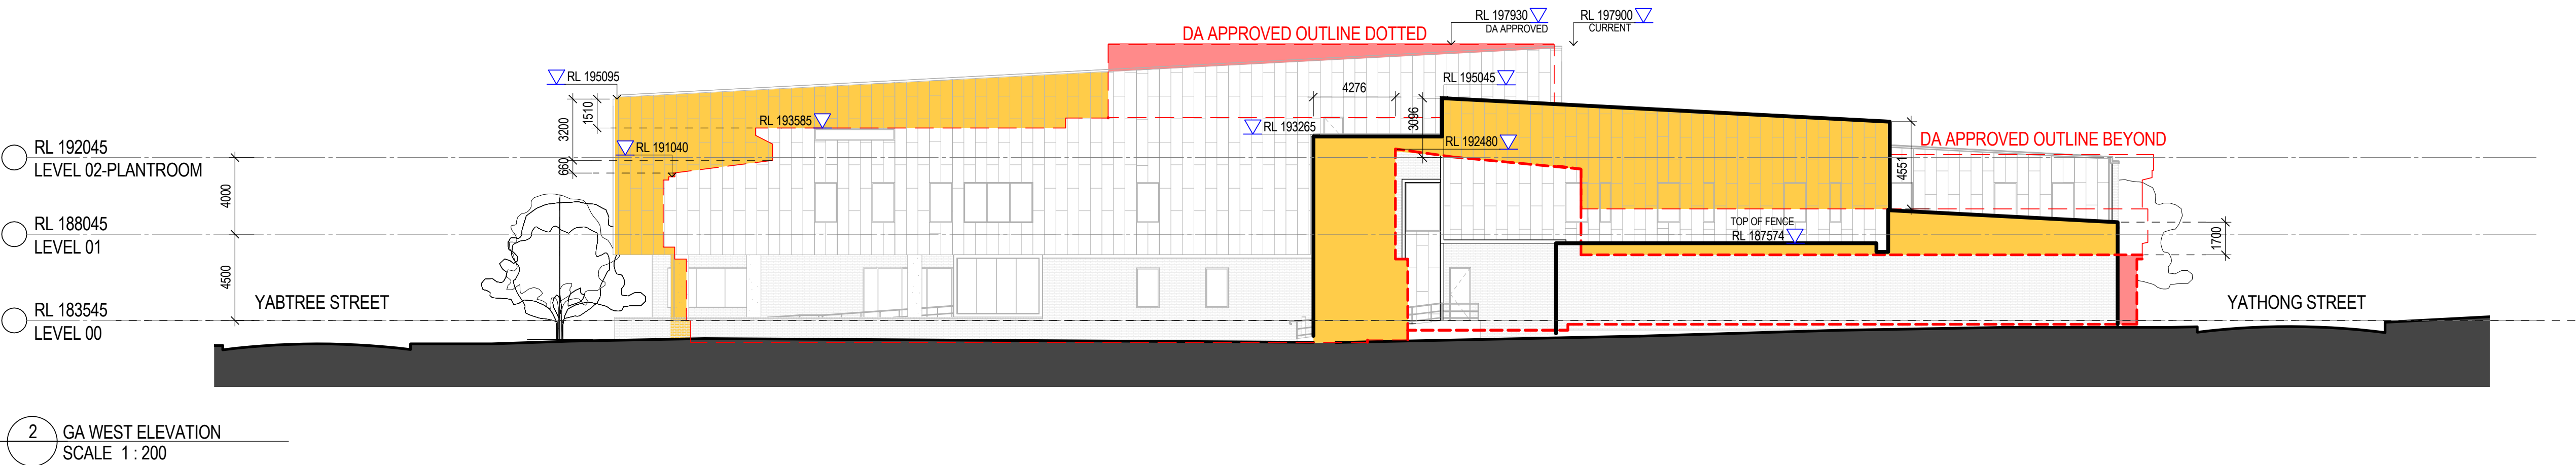

2	SECTION 75 W SUBMISSION	14.08.12	CH
1	SECTION 75 W SUBMISSION	08.08.12	CH
Rev	Description	Date	App'd



Project
WAGGA WAGGA HEALTH SERVICE -
PHASE 1 MENTAL HEALTH

EDWARD STREET
WAGGA WAGGA, NSW, 2650 AUSTRALIA



Drawing title
GA EAST AND WEST ELEVATION
COMPARISON

Checked MK Approved CH Scale As indicated @ A1 sheet size

50mm on original

Project number 120059 Drawing number AR.MH.DA.3021 Revision 2

Status
FOR INFORMATION