

SECURITY TURNSTILE ACCESS
GUARDHOUSE 19sqm
SECURITY TURNSTILE ACCESS

SKYLINE CRESCENT

PROPERTY RETAINING WALL TO CIVIL ENG. DETAILS
PROPOSED SUBSTATION LOCATION
EXISTING EASEMENT SHOWN IN GREEN DASH




INDUSTRIAL DEVELOPMENT
LOT 4, BRINGELLY ROAD, LEPPINGTON, SYDNEY




THESE DESIGNS, PLANS & SPECIFICATIONS AND THE COPYRIGHT THEREIN ARE THE PROPERTY OF THE ARCHITECTS AND MUST NOT BE USED, REPRODUCED OR COPIED WHOLLY OR IN PART WITHOUT THE WRITTEN PERMISSION OF THE ARCHITECTS.
FIGURED DIMENSIONS TO BE USED IN PREFERENCE TO SCALING.
ALL DIMENSIONS TO BE CHECKED ON SITE.
THIS DOCUMENT NOT TO BE USED FOR CONSTRUCTION UNLESS ISSUED & ISSUED FOR CONSTRUCTION.

TITLE		DATE		SCALE		PROJECT NO.		DWG NO.		REVISION	
SITE PLAN		03/02/2021		1 : 500 @ A1		20245		DA101		F	

F		03/02/2021		CLIENT	
MEZZANINE, COOLROOM, FREEZER, PUMP ROOM ADDED		16/11/2020			
E UPDATED AREAS		13/11/2020			
D ISSUED FOR INFORMATION		11/11/2020			
C ISSUED FOR DA		26/08/2020			
B ISSUED FOR DA		14/08/2020			
A ISSUED FOR DA					
# DESCRIPTION		DATE			

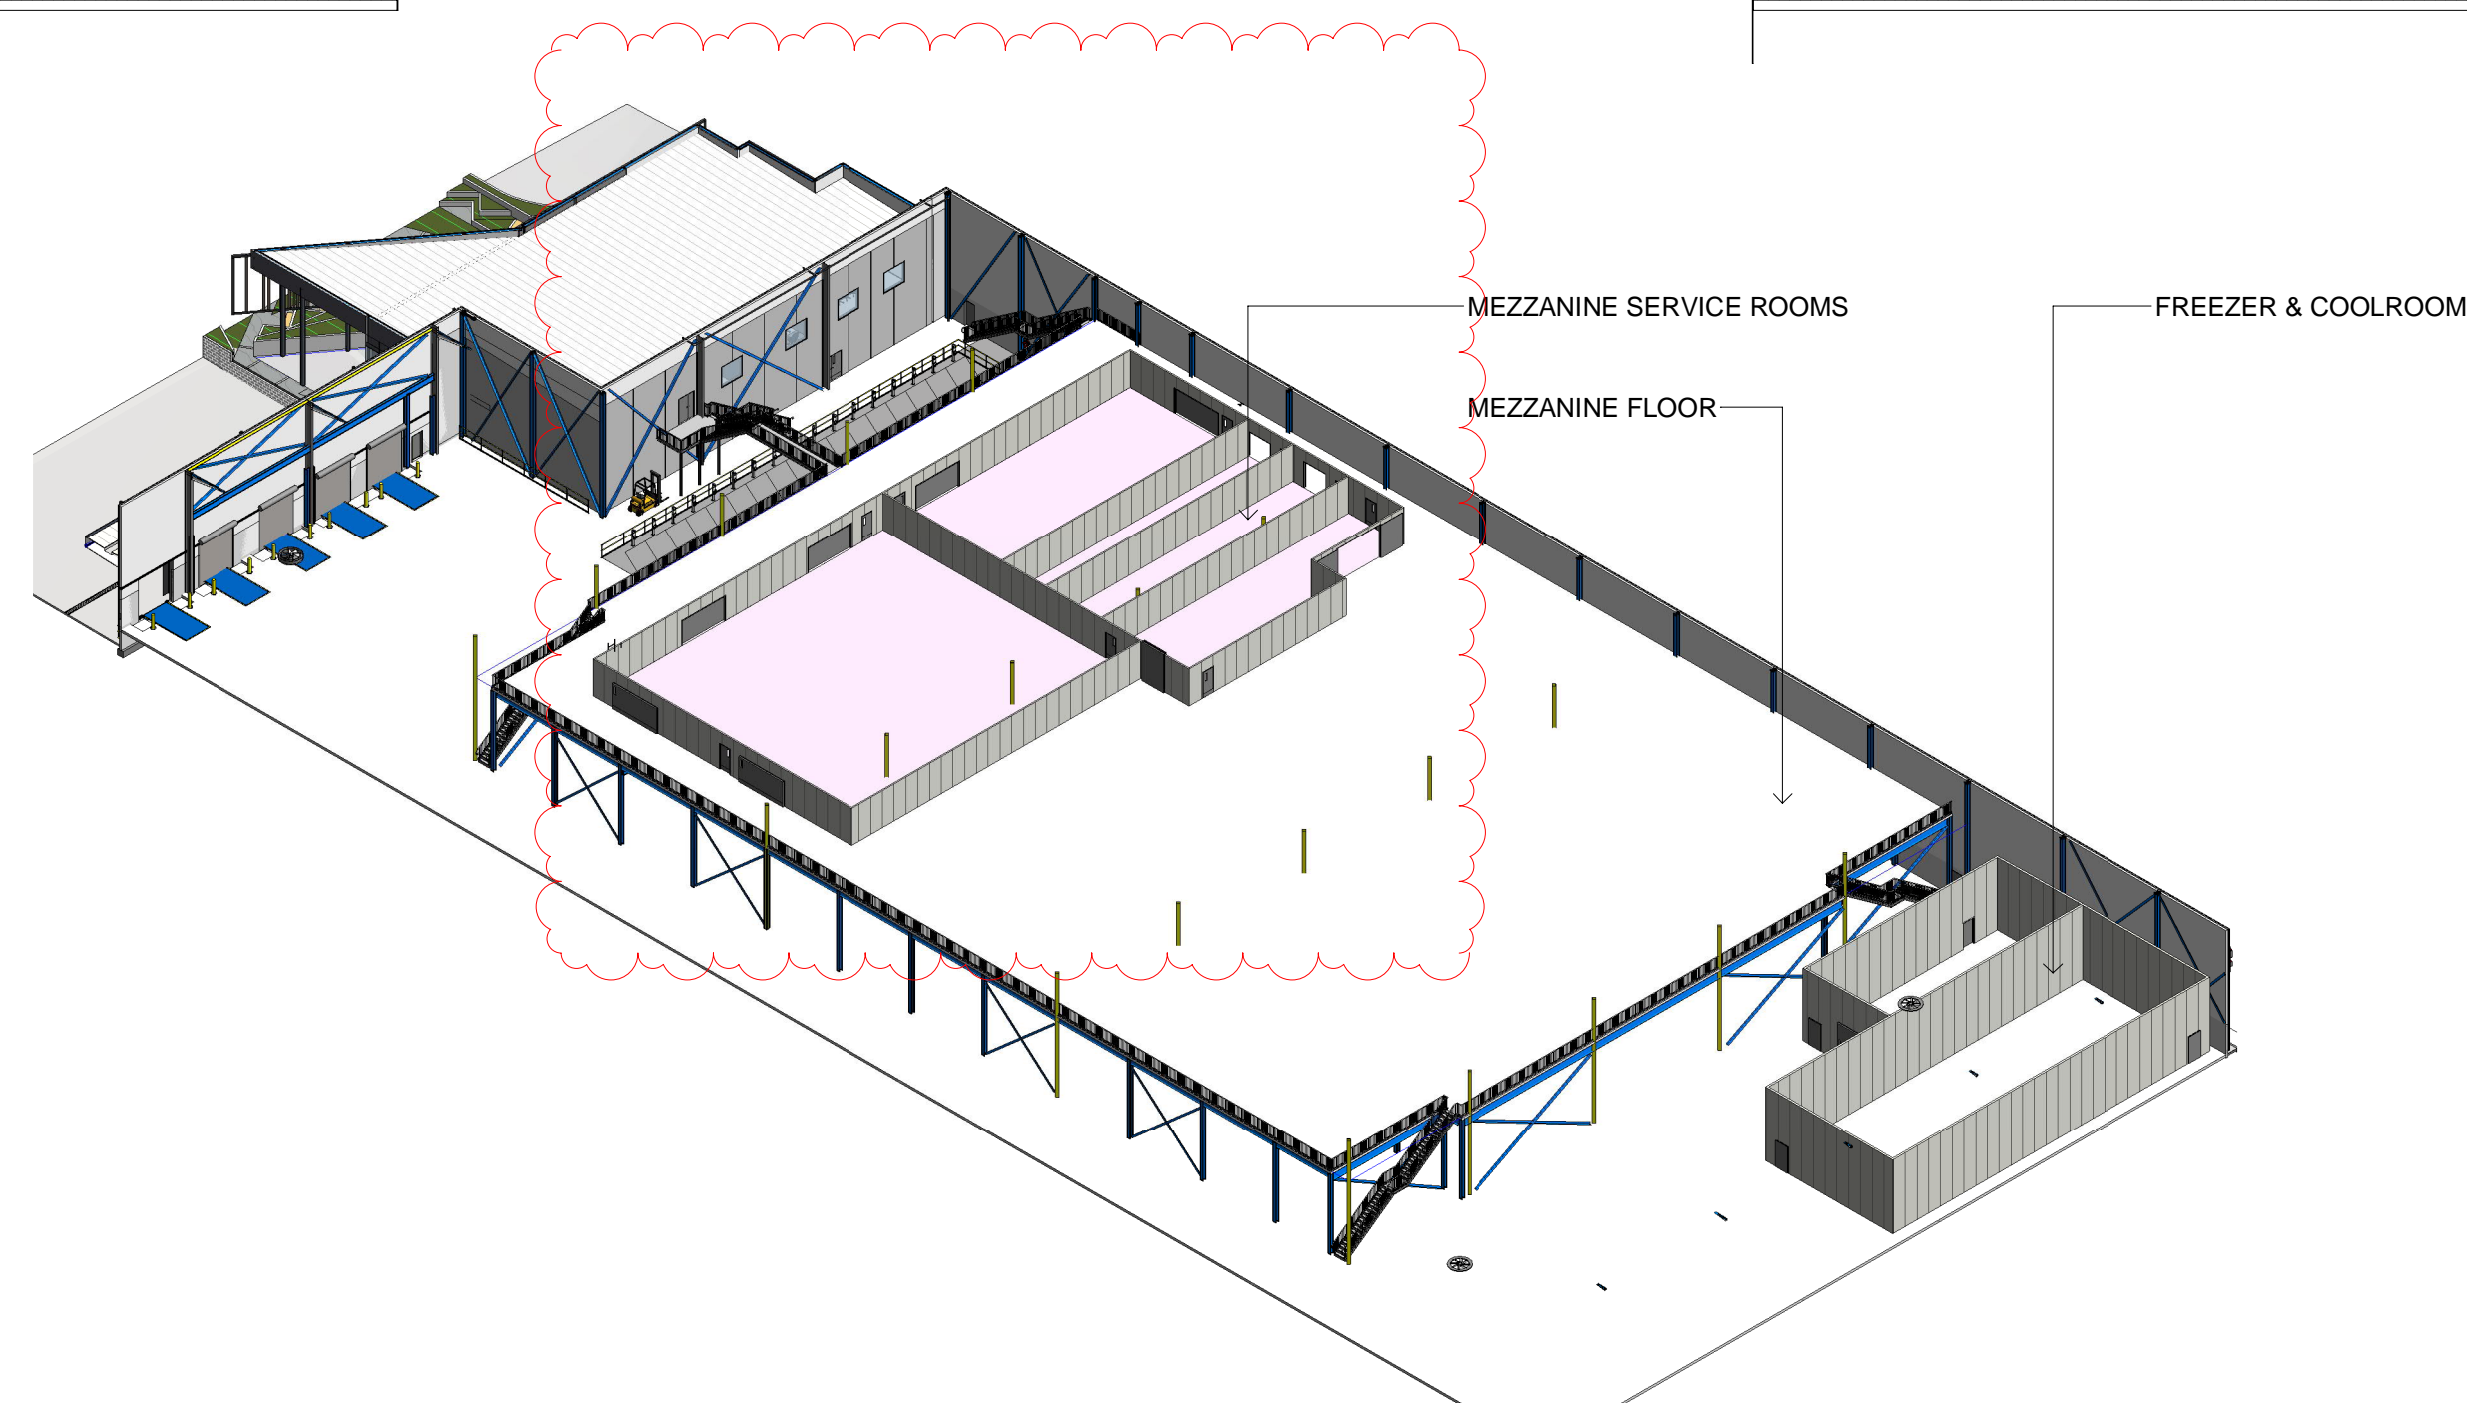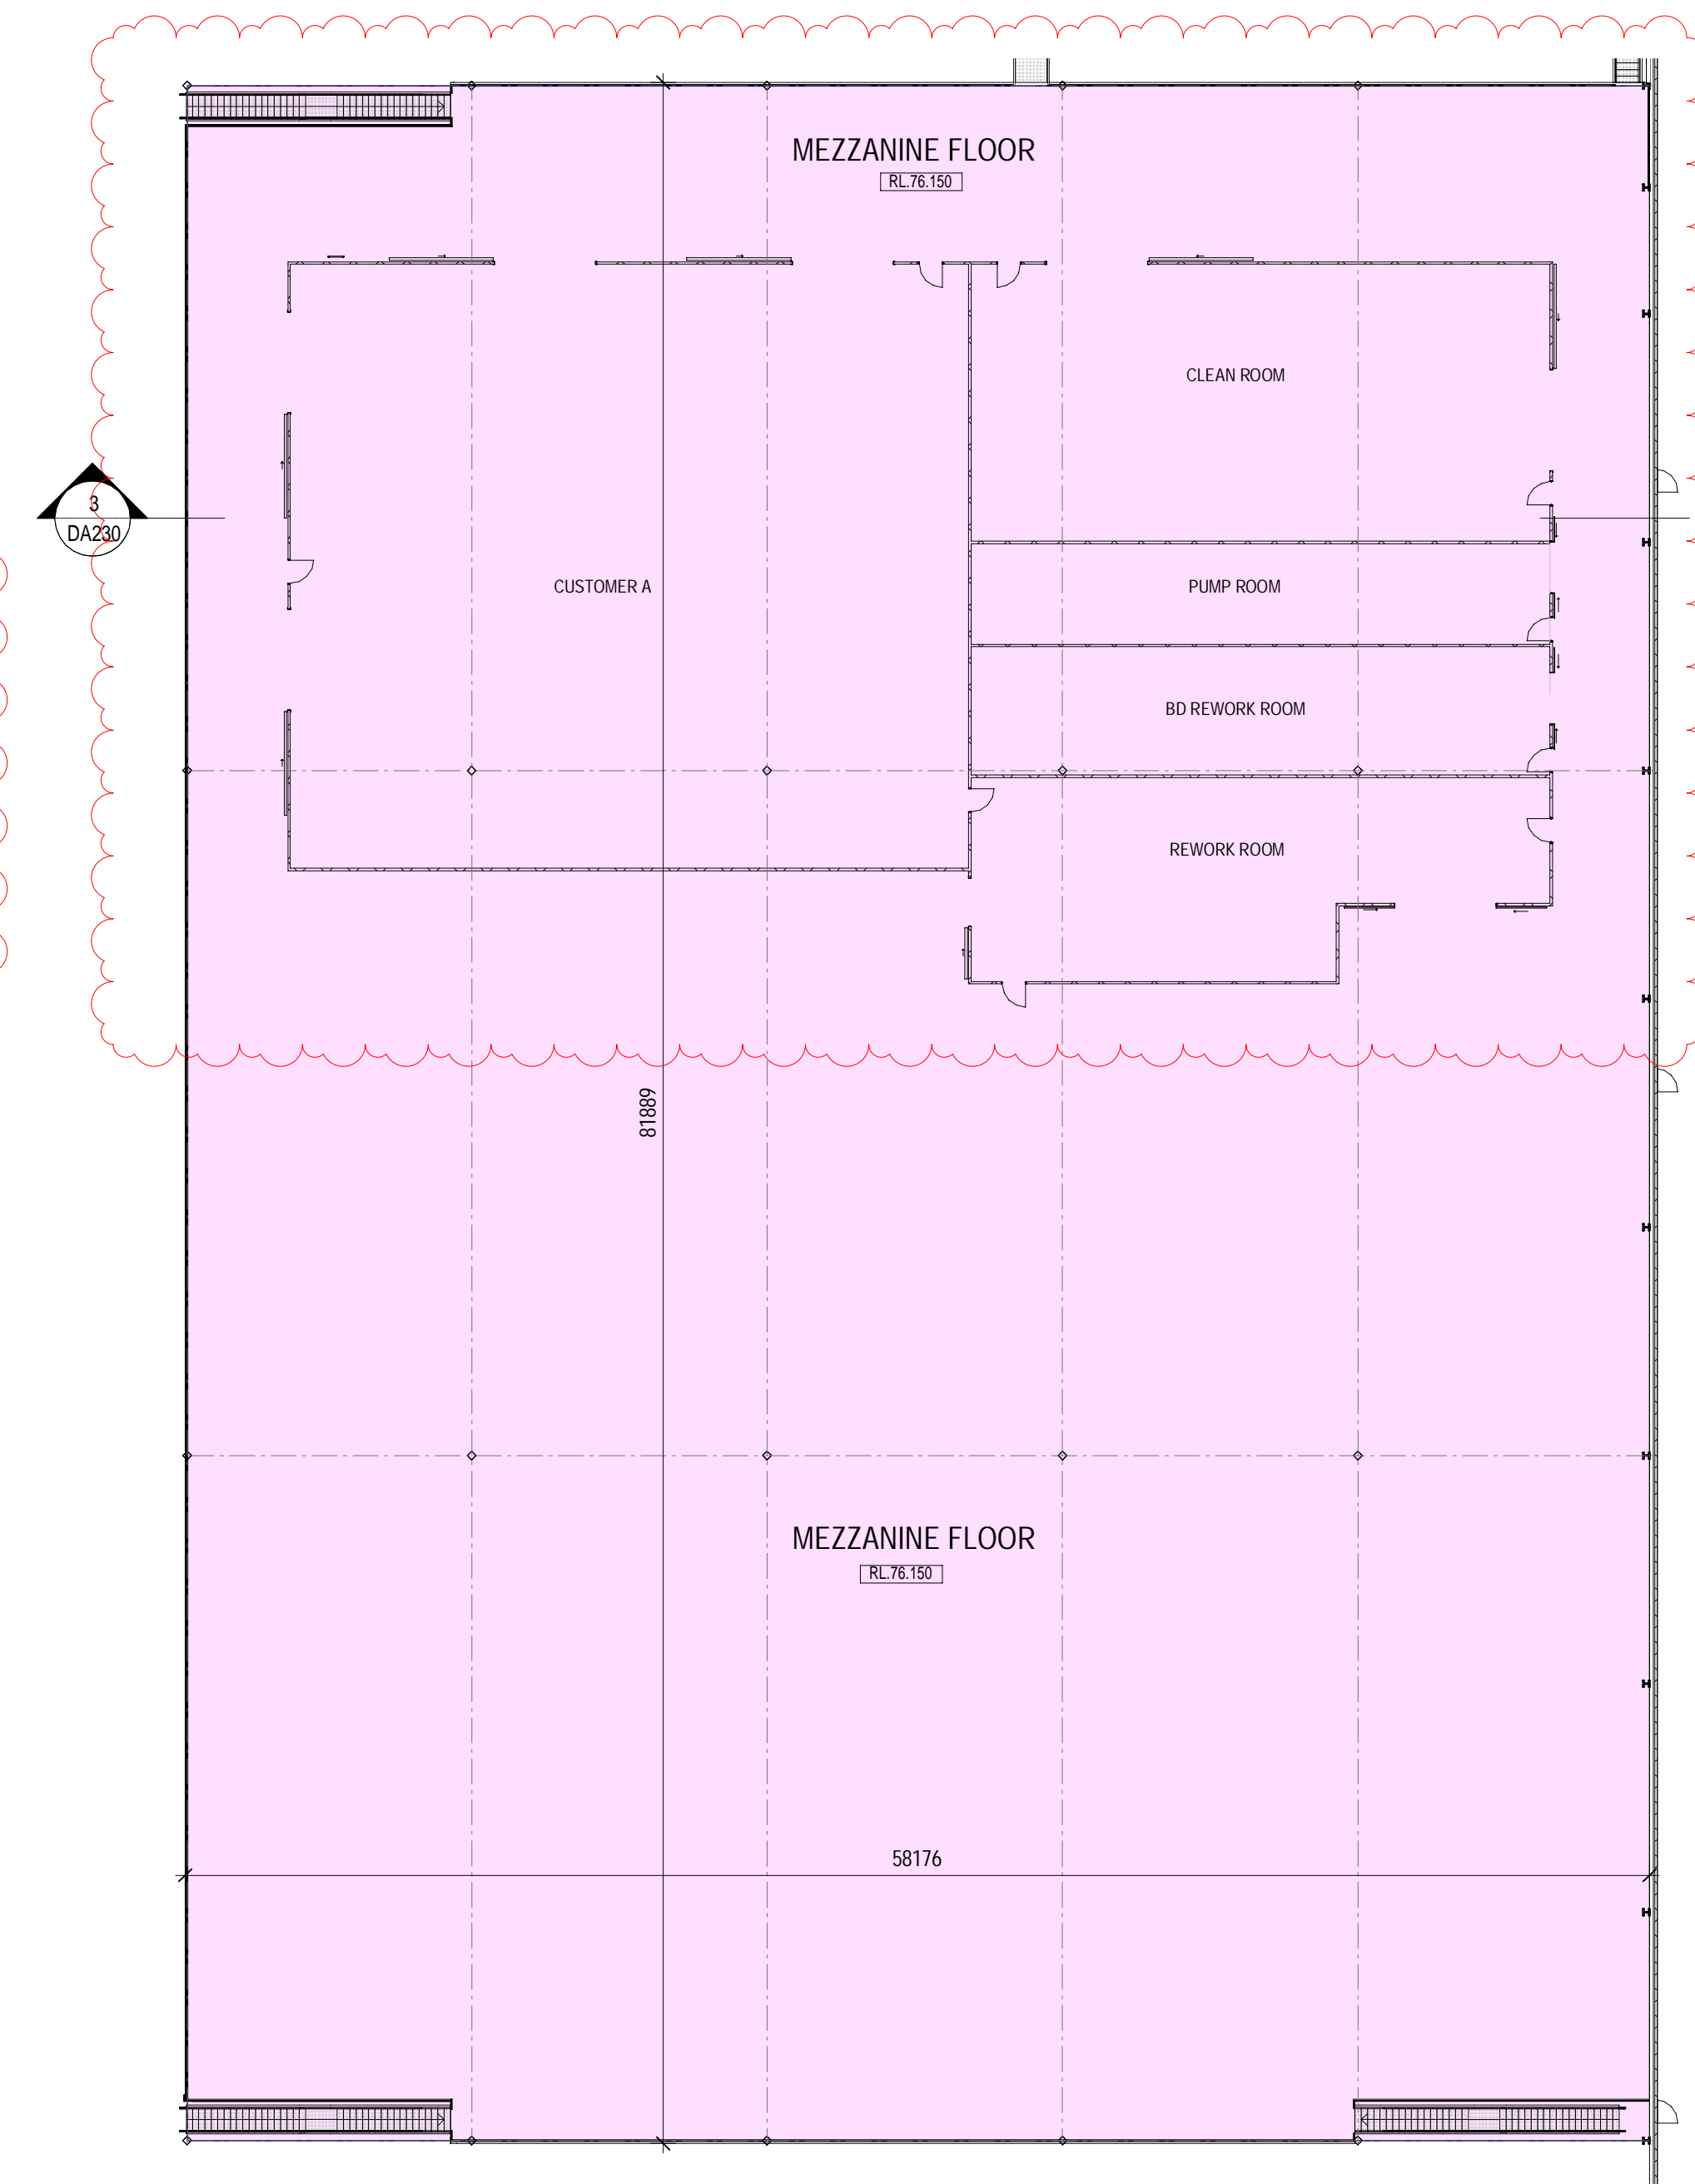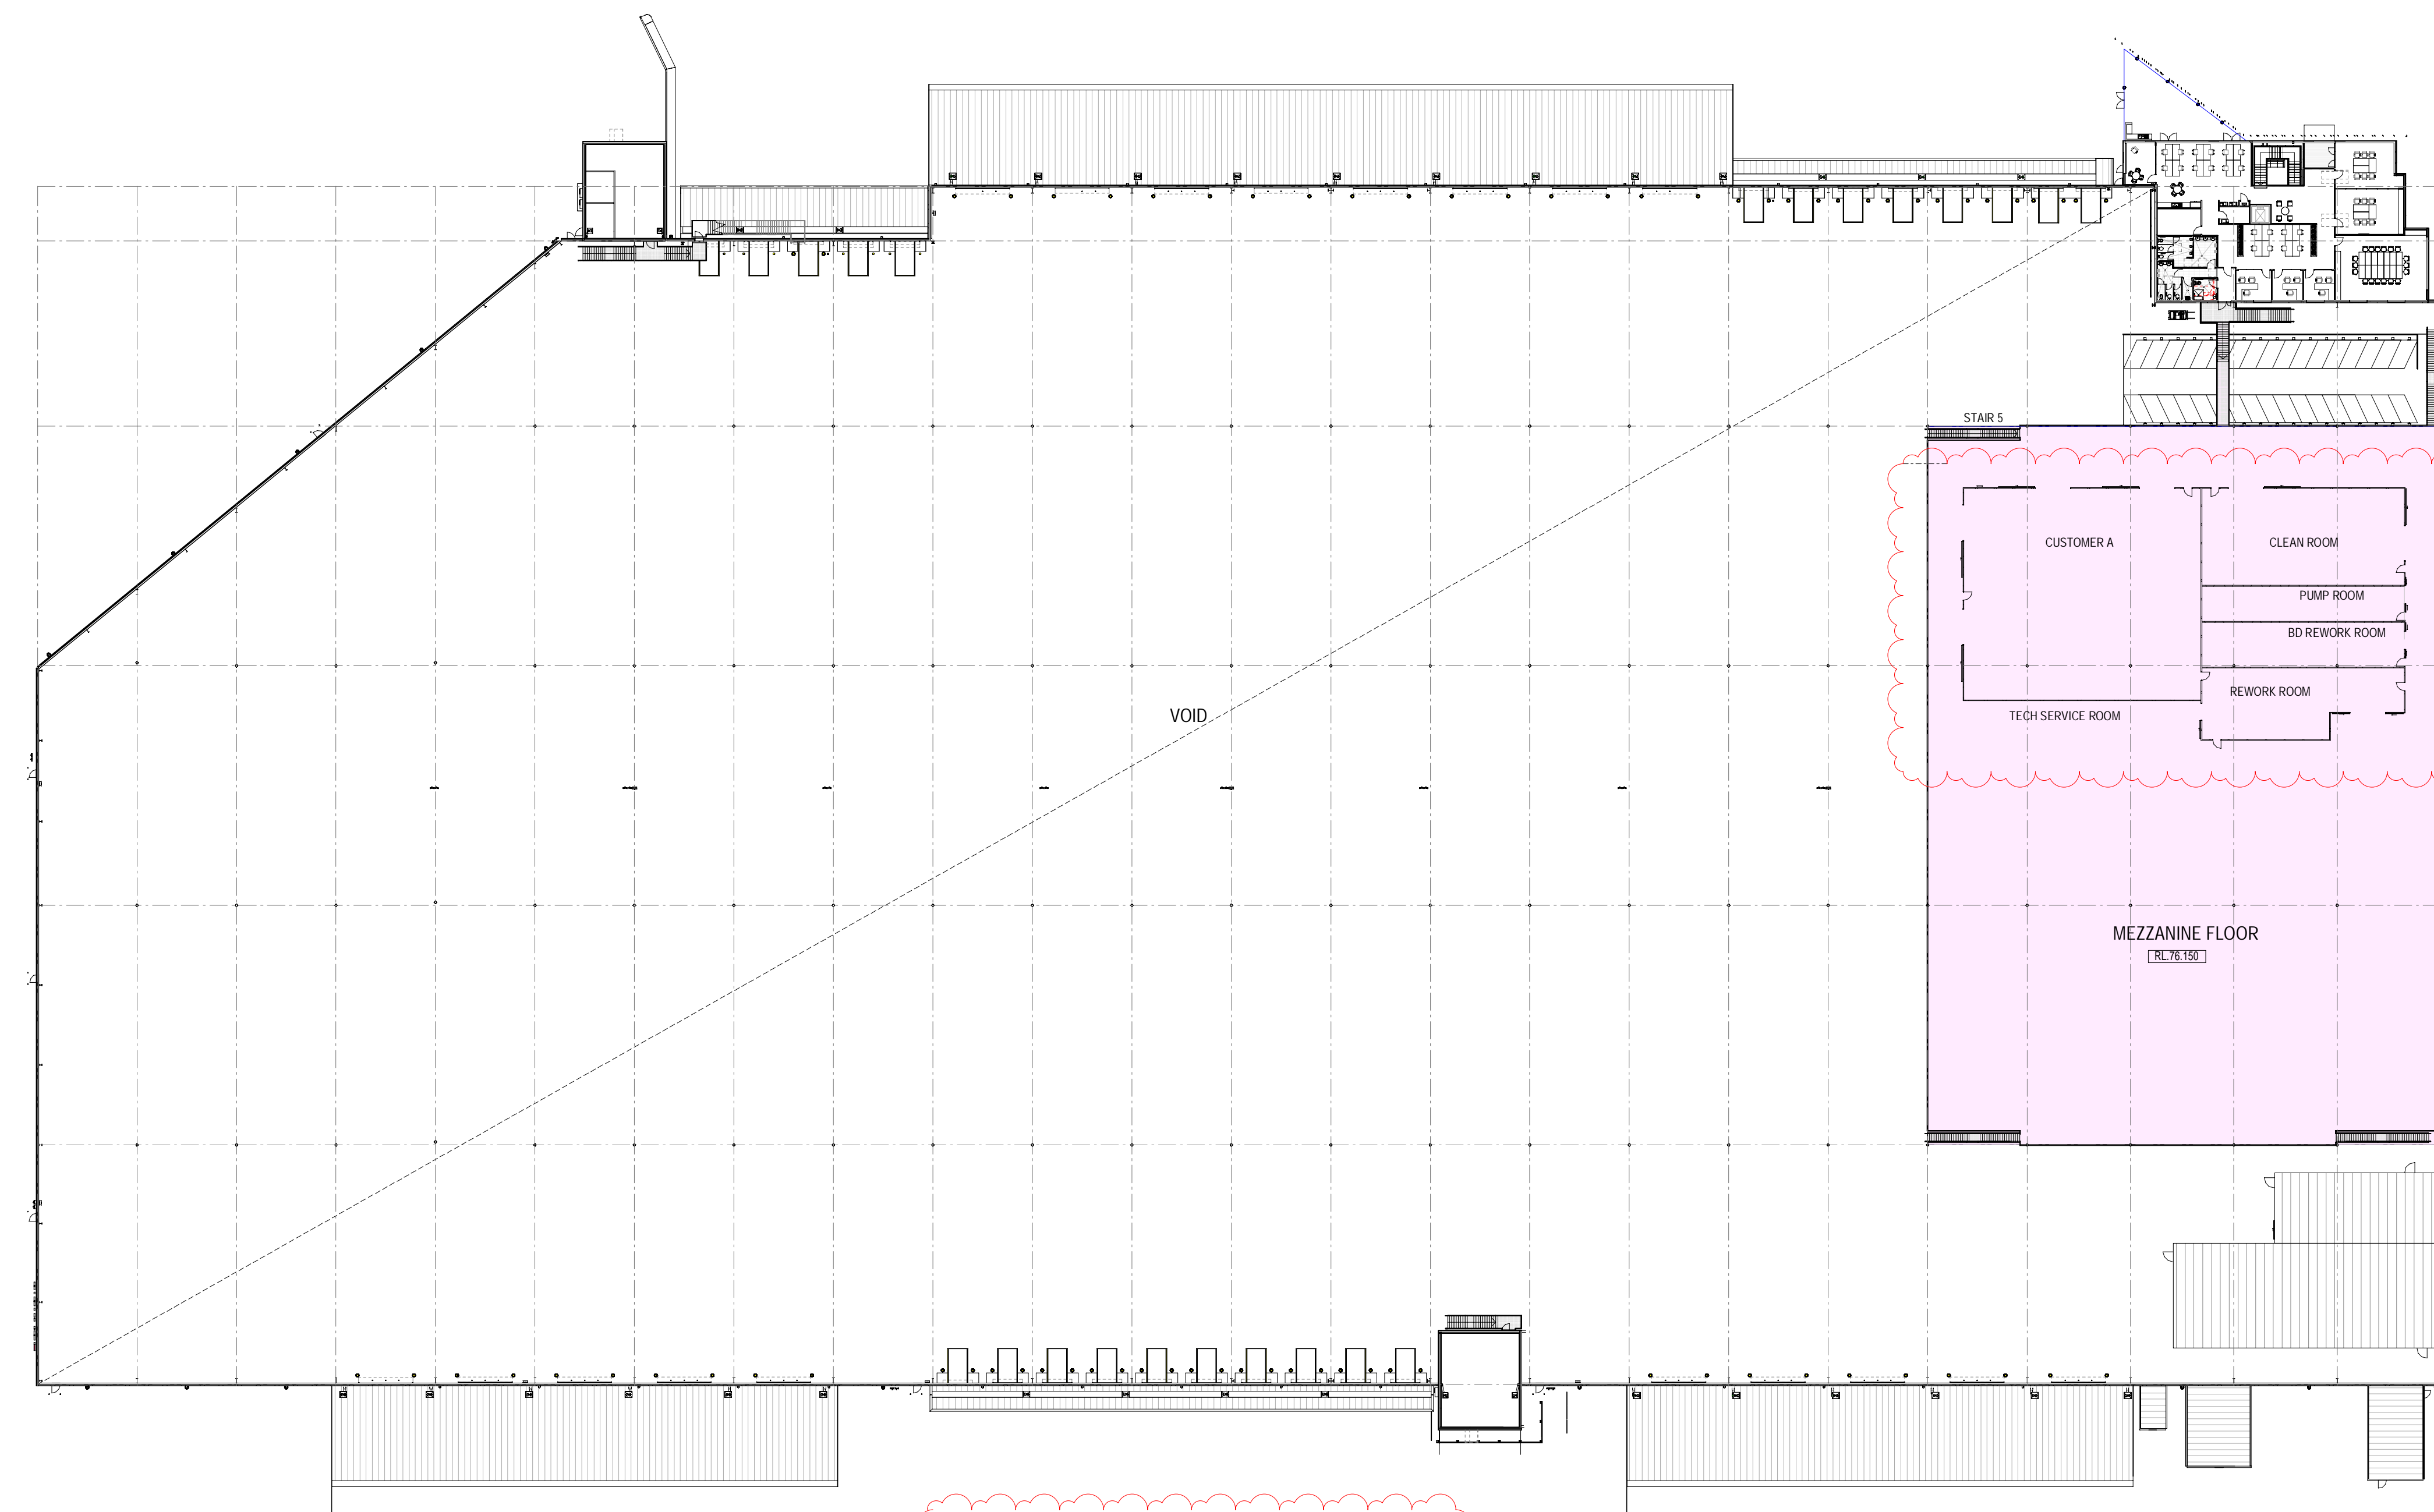

2 MEZZANINE FLOOR PLAN 1:250

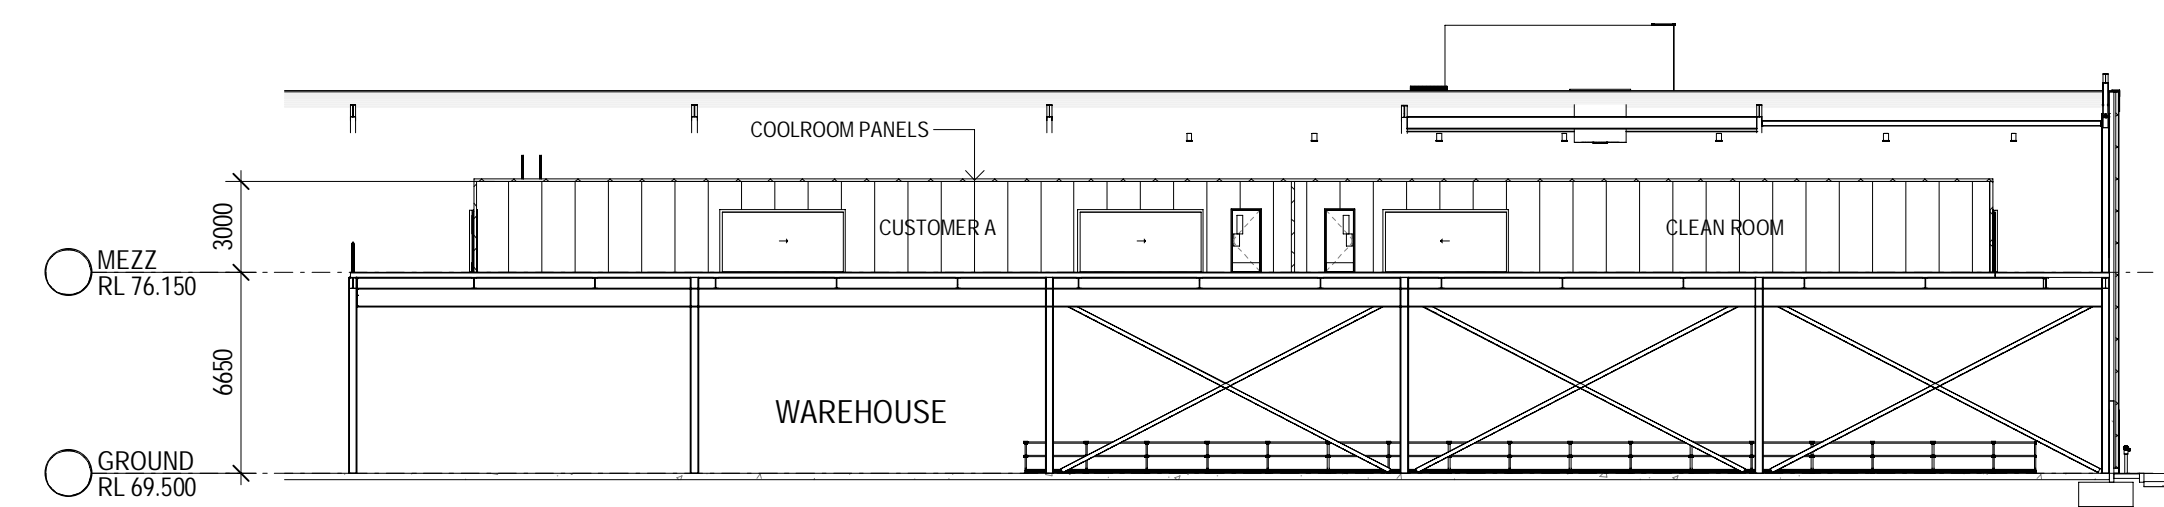


3 MEZZ SECTION 1:250

1 MEZZANINE. 1:500

4 AXONOMETRIC - MEZZANINE.

INDUSTRIAL DEVELOPMENT

LOT 4, BRINGELLY ROAD, LEPPINGTON, SYDNEY

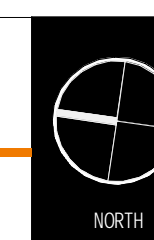

THESE DESIGN PLANS & SPECIFICATIONS AND THE COPYRIGHT THEREIN ARE THE PROPERTY OF THE ARCHITECTS AND MUST NOT BE USED, REPRODUCED OR COPIED WHOLLY OR IN PART WITHOUT THE WRITTEN PERMISSION OF THIS OFFICE.

FOR ANY DIMENSIONS TO BE USED IN PREFERENCE TO SCALING ALL DIMENSIONS TO BE CHECKED ON SITE.

THIS DOCUMENT NOT TO BE USED FOR CONSTRUCTION UNLESS SIGNED & ISSUED FOR CONSTRUCTION.

TITLE				
MEZZ FLOOR PLAN & SECTION				
DATE	SCALE	PROJECT NO.	DWG NO.	REVISION
23/02/2021	As indicated @ A1	20245	DA230	B