

Check all dimensions and site conditions prior to commencement of any work, the purchase or ordering of any materials, fittings, plant, services or equipment and the preparation of shop drawings and or the fabrication of any components.

Do not scale drawings - refer to figured dimensions only. Any discrepancies shall immediately be referred to the architect for clarification.

All drawings may not be reproduced or distributed without prior permission from the architect.



Proposed blind system at south side to run down on an angle to accommodate bench seating.

Existing planter to be extended. Plant selection to Landscape Arch's specs.

Glass blades to be similar to existing glass blades. Top of glass blades to match height of northern restaurant @ RL 5.250 FT low iron lam glass compliant to AS1288

View 01



New proposed glass blade location. Floor mounted, concealed within planter bed to Struct Eng's details.

View 01




New proposed glass blade location. Floor mounted, concealed within planter bed to Struct Eng's details.

View 02

FOR APPROVAL
WESTERN RESTAURANT

METEOROLOGICAL DATA

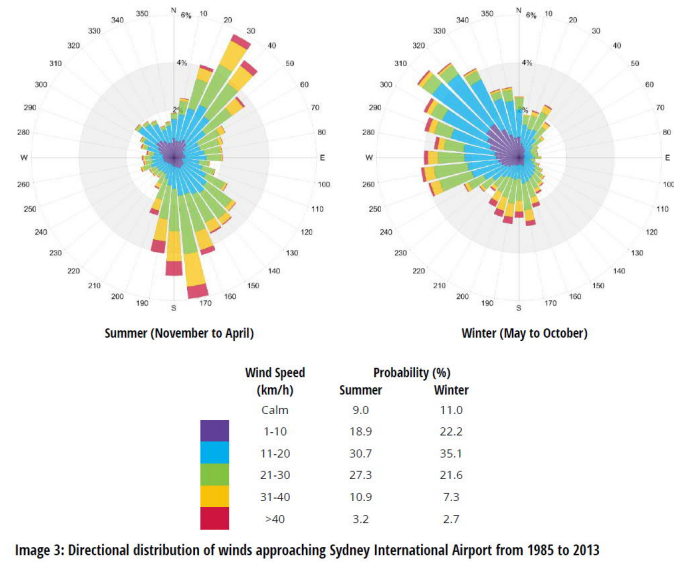

3C	08.06.2021	CROWN MARKUP	CROWN	CROWN
3B	21.05.2021	CROWN MARKUP	CROWN	CROWN
3A	11.05.2021	CROWN MARKUP	CROWN	CROWN
3	11.05.21	ISSUED FOR INFORMATION	BS	BS
2A	15.04.2021	CROWN MARKUP	CROWN	CROWN
2	09.04.21	ISSUED FOR INFORMATION	BS	BS
1	19.03.21	ISSUED FOR INFORMATION	BS	BS
Revision	Date	Description	Initial	Checked

Client
Crown Resorts Limited
8 Whiteman Street
South Bank VIC 3006
T +61 (0) 3 9292 8888
F +61 (0) 3 9292 8808
www.crownresorts.com.au

Principal Architect
WilkinsonEyre

London 33 Bowling Green Lane
EC1R 0BJ United Kingdom
T +44 (0) 20 7608 7900 F +44 (0) 20 7608 7901
www.wilkinsonseyre.com

Executive Architect
BATESSMART


Sydney 43 Brisbane Street
Surry Hills NSW 2010 Australia
T +61 2 8354 5100 F +61 2 8354 5199
www.batesmart.com.au

Melbourne 1 Nicholson Street
Melbourne VIC 3000 Australia
T +61 3 8664 6200 F +61 3 8664 6300

Bates Smart Architects Pty Ltd ABN 68 094 740 986

Crown Sydney Hotel Resort

Glass Blades - Western Restaurant Terrace
Proposed

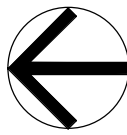

Status	NOT FOR CONSTRUCTION				
Scale	1 : 100	@ A1			
Drawn	Author	Checked	Checker		
Project No.	s11659				
Plot Date	10/05/2021 5:32:41 PM				
Model File					
Drawing no.	Discipline/ Doc.	Series	Sector/Level Object	Sheet	Revision
CRS_AD_SK0028					3C