


Check all dimensions and site conditions prior to commencement of any work, the purchase or ordering of any materials, fittings, plant, services or equipment and the preparation of shop drawings and or the fabrication of any components.

Do not scale drawings - refer to figured dimensions only. Any discrepancies shall immediately be referred to the architect for clarification.

All drawings may not be reproduced or distributed without prior permission from the architect.

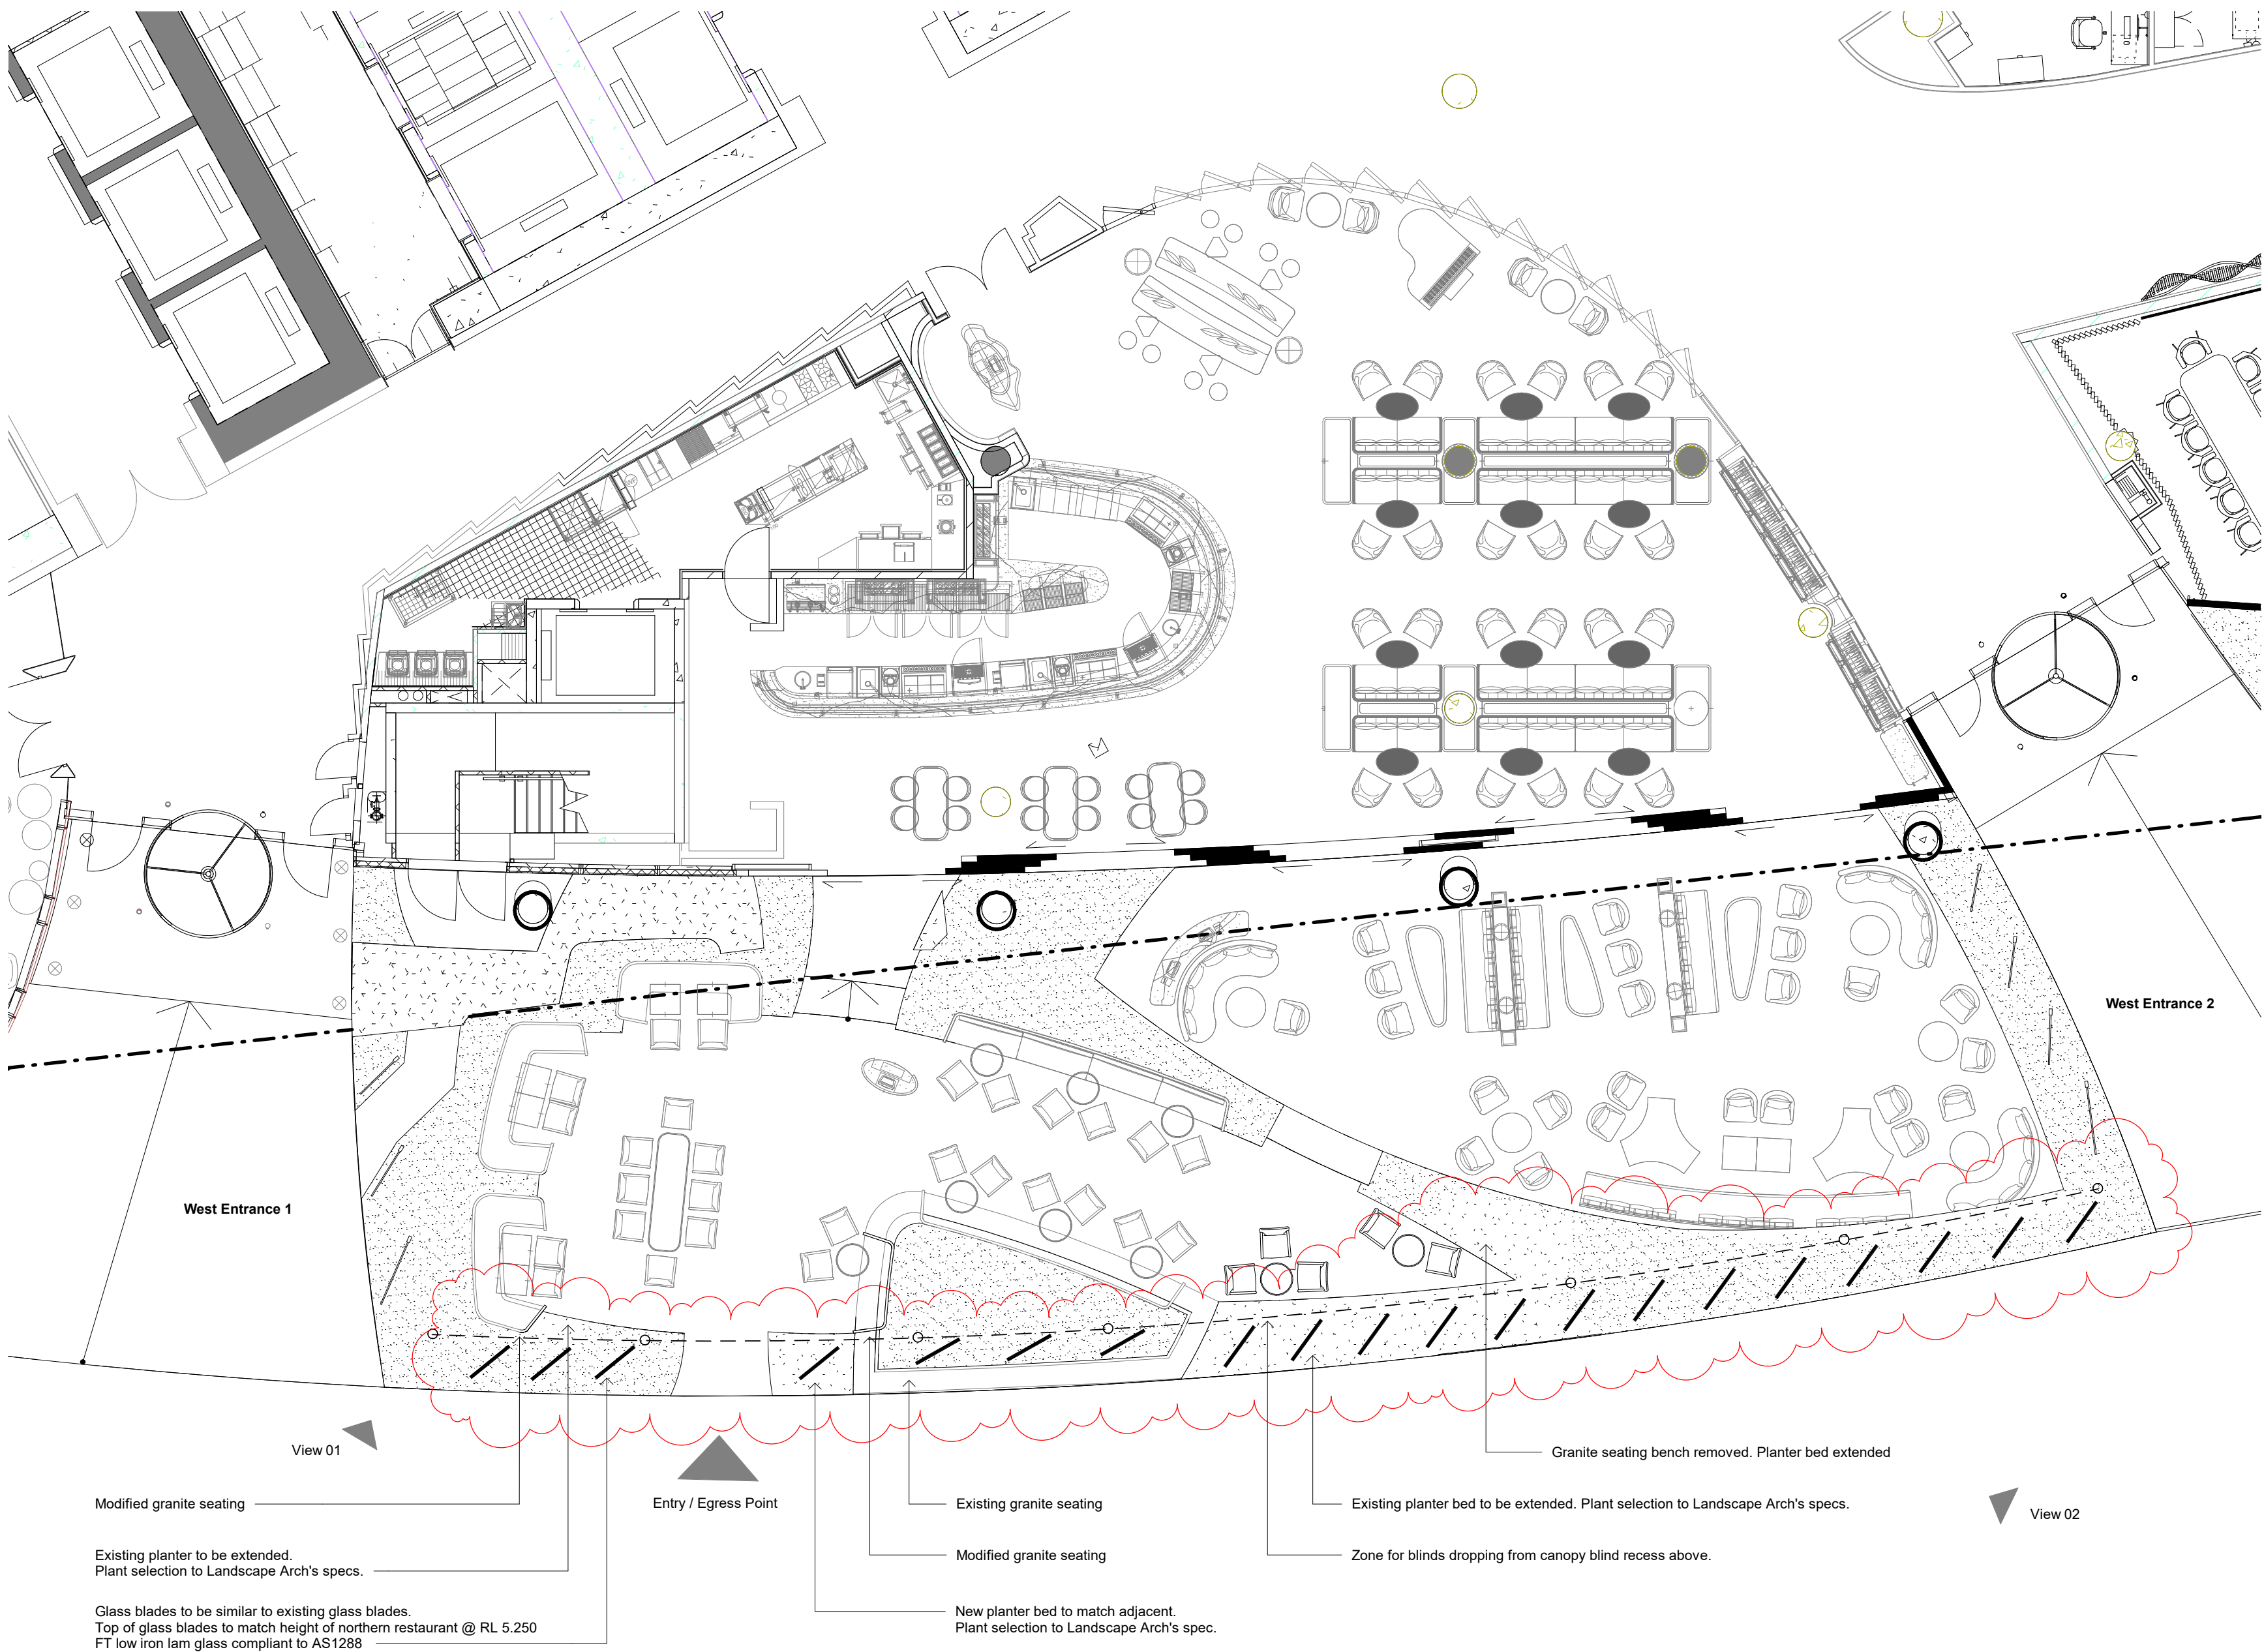


View 04



View 05

FOR APPROVAL
PROPOSED LAYOUT
LOBBY BAR TERRACE

METEOROLOGICAL DATA

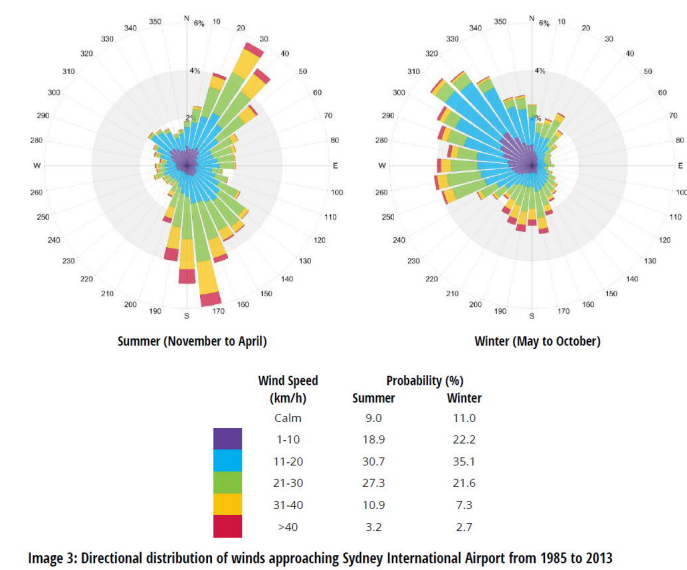

2C	08.06.2021	CROWN MARKUP	CROWN CROWN
2B	21.05.2021	CROWN MARKUP	CROWN CROWN
2A	15.04.2021	CROWN MARKUP	CROWN CROWN
2	09.04.21	ISSUED FOR INFORMATION	BS BS
1	19.03.21	ISSUED FOR INFORMATION	BS BS
Revision	Date	Description	Initial Checked

Client
Crown Resorts Limited
8 Whiteman Street
South Bank VIC 3006
T +61 (0) 3 9292 8888
F +61 (0) 3 9292 8808
www.crownresorts.com.au

Principal Architect
WilkinsonEyre

London 33 Bowling Green Lane
EC1R 0BJ United Kingdom
T +44 (0) 20 7608 7900 F +44 (0) 20 7608 7901
www.wilkinsonseyre.com

Executive Architect
BATESSMART

Sydney 43 Brisbane Street
Surry Hills NSW 2010 Australia
T +61 2 8354 5100 F +61 2 8354 5199
www.batesmart.com.au

Melbourne 1 Nicholson Street
Melbourne VIC 3000 Australia
T +61 3 8664 6200 F +61 3 8664 6300
www.batesmart.com.au

Bates Smart Architects Pty Ltd ABN 68 094 740 986

Crown Sydney Hotel Resort

Glass Blades - Lobby Bar Terrace
Proposed

Status	NOT FOR CONSTRUCTION				
Scale	1 : 100		@ A1		
Drawn	Author	Checked		Checker	
Project No.	s11659				
Plot Date	9/04/2021 10:31:55 AM				
Model File					
Drawing no.	Discipline/ Doc.	Series	Sector/Level Object	Sheet	Revision
CRS AD SK0030					2C