

- GENERAL NOTES
1. THIS DRAWING IS COPYRIGHT AND IS THE PROPERTY OF TURF DESIGN STUDIO AND MUST NOT BE USED WITHOUT PERMISSION.
 2. THIS DRAWING IS AN UNCONTROLLED COPY UNLESS STAMPED WITH STATUS.
 3. THE CONTRACTOR MUST VERIFY ALL DIMENSIONS AND LEVELS ON SITE AS THIS IS NOT A SHOP DRAWING.
 4. THE CONTRACTOR MUST REFER ANY DISCREPANCIES TO THE SUPERINTENDENTS REPRESENTATIVE BEFORE PROCEEDING WITH THE WORK.
 5. THE CONTRACTOR MUST NOT SCALE FROM THESE DRAWINGS. USE NOMINATED DIMENSIONS AND LEVELS.
 6. THIS DRAWING MUST BE READ IN CONJUNCTION WITH THE TOTAL CONTRACT PACKAGE INCLUDING DRAWINGS AND SPECIFICATIONS OF ALL CONSULTANTS.
 7. IF THE CONTRACTOR INTENDS TO UNDERTAKE ANY EXCAVATION WORK, IT IS THE CONTRACTORS RESPONSIBILITY TO CONTACT 1100 - DIAL BEFORE YOU DIG OR WWW.1100.COM.AU
- SURVEY INFORMATION
8. TURF DESIGN STUDIO DO NOT WARRANT THE ACCURACY OF SURVEY INFORMATION.

9	16.02.2021	SSD2	AR	MC
8	18.10.2019	SSD2	AR	MC
7	23.09.2019	SSD2	AR	MH
6	28.08.2019	FOR INFORMATION	AR	MC
5	16.08.2019	FOR INFORMATION	AR	MC
4	09.08.2019	FOR INFORMATION	AR	MC
3	02.08.2019	FOR INFORMATION	AR	MC
2	08.07.2019	FOR INFORMATION	HH	MC
1	19.06.2019	70% SCHEMATIC DESIGN	AR	MC

Rev	Date	Description	Drawn	Checked
-----	------	-------------	-------	---------



Turf Design Studio: P.O. Box 419 Cronulla NSW 2230, 95 Kingsway, Cronulla 2230
Phone (+61 2) 9527 3380, Fax (+61 2) 9527 2307
Email: sydney@turfdesign.com



Project
TWEED VALLEY HOSPITAL DEVELOPMENT

Drawing Title
Site-wide Landscape Plan


Drawing Status
SSD2

Scale: As indicated @A1 Plot Date

Project No. Drawing No. Revision

1719 LS-DWG -10-001 9


LEGEND

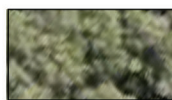

Retained forest - restored and enhanced in accordance with Biodiversity Management Plan




Vegetated buffer.

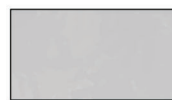

Roadway




Proposed Trees

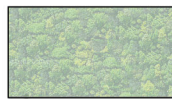

Bioretention planting.



Proposed planting

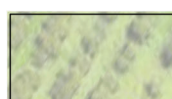


Existing Orchard



Retaining wall



Hydromulched/drill seeded lawn (various species refer Plant Schedules)

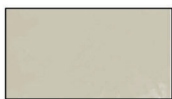

Proposed paving


NOT FOR CONSTRUCTION

GENERAL NOTES

1. THIS DRAWING IS COPYRIGHT AND IS THE PROPERTY OF TURF DESIGN STUDIO AND
2. MUST NOT BE USED WITHOUT PERMISSION.
3. THIS DRAWING IS AN UNCONTROLLED COPY UNLESS STAMPED WITH STATUS
4. NOT A SHOP DRAWING.
5. THE CONTRACTOR MUST REFER ANY DISCREPANCIES TO THE SUPERINTENDENTS REPRESENTATIVE BEFORE PROCEEDING WITH THE WORK.
6. THE CONTRACTOR MUST NOT SCALE FROM THESE DRAWINGS. USE NOMINATED DIMENSIONS AND LEVELS.
7. THIS DRAWING MUST BE READ IN CONJUNCTION WITH THE TOTAL CONTRACT PACKAGE INCLUDING DRAWINGS AND SPECIFICATIONS OF ALL CONSULTANTS.
8. IF THE CONTRACTOR INTENDS TO UNDERTAKE ANY EXCAVATION WORK, IT IS THE CONTRACTORS RESPONSIBILITY TO CONTACT 1100 - DIAL BEFORE YOU DIG OR WWW.1100.COM.AU

SURVEY INFORMATION

8. TURF DESIGN STUDIO DO NOT WARRANT THE ACCURACY OF SURVEY INFORMATION.

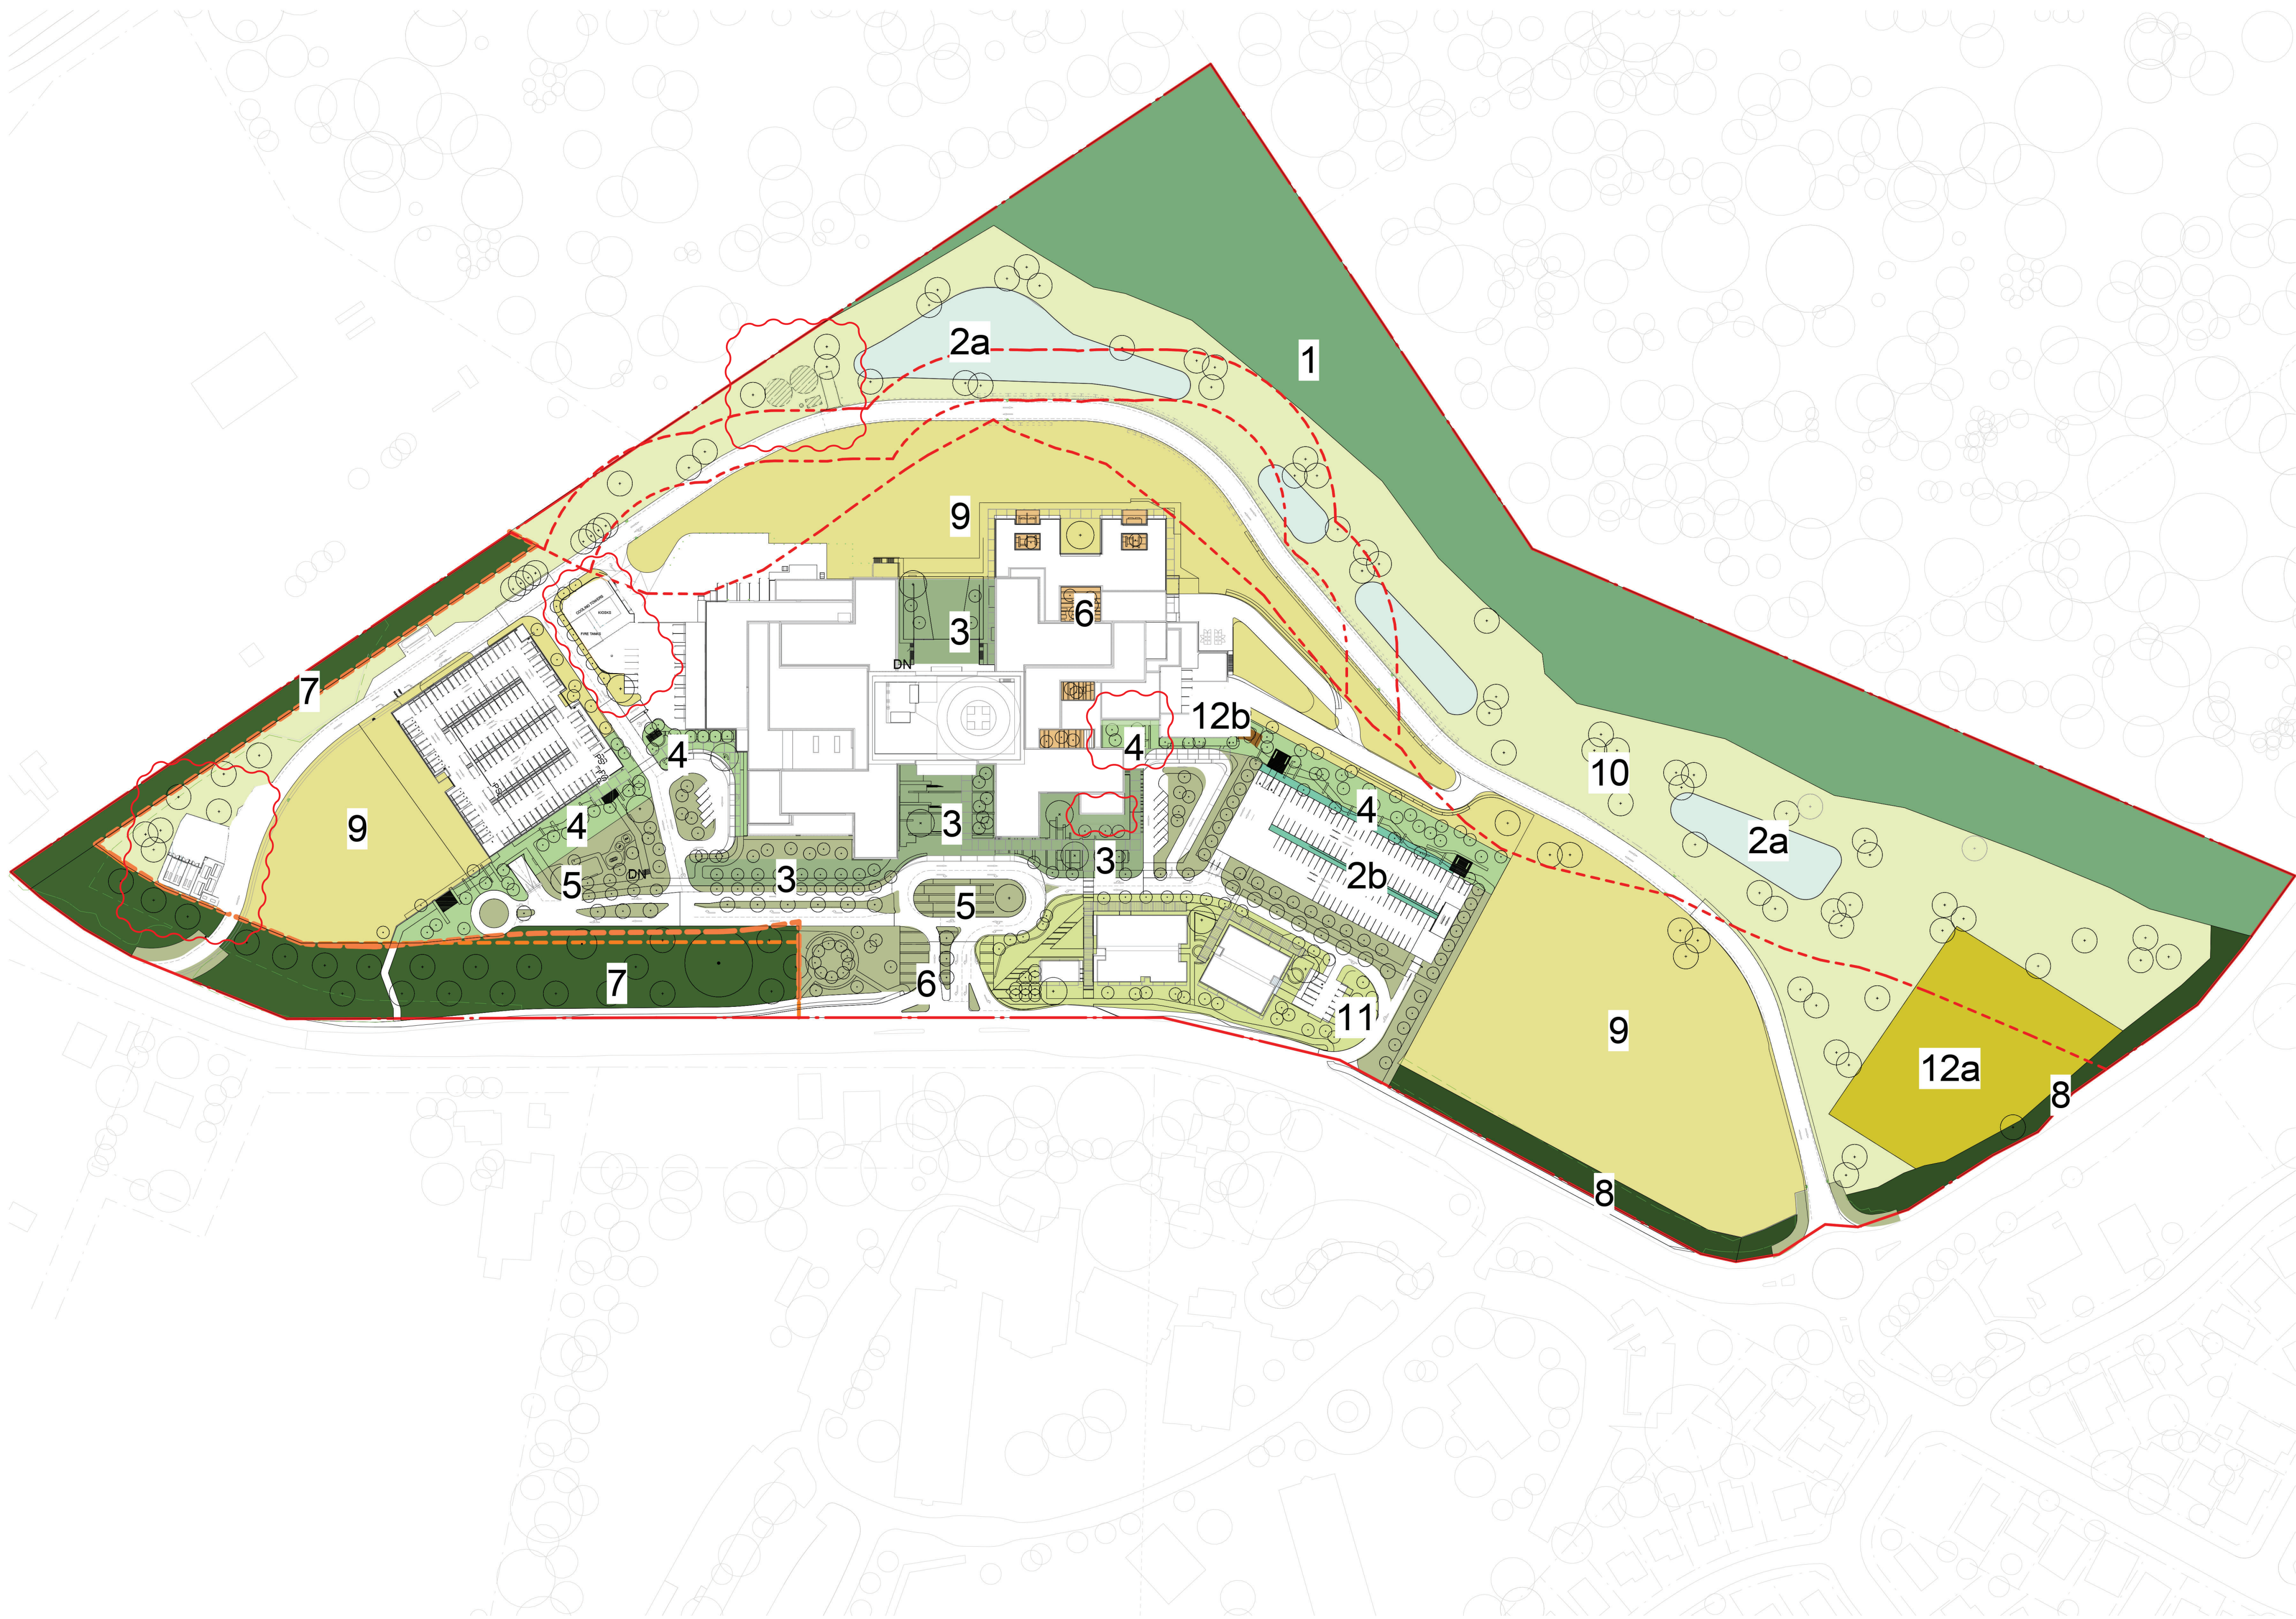

LEGEND

1. Retained forest - Restored and enhanced in accordance with Biodiversity Management Plan	4. Green Spine **	8. Embellished Buffer - Embellished in accordance with Biodiversity Management Plan **	12a. Existing Orchard
2a. Bioretention planting **	5. Feature Entries/Hospital landscape fringe **	9. Hydromulched/drill seeded lawn (Exotic grass-mowing maintenance eg. couch, buffalo)	12b. Therapy garden Opportunity **
2b. Rain Gardens **	6. Landscaped courtyards within hospital envelope **	10. Lawn with clusters of native planting	** From a biodiversity/habitat connectivity perspective the bio-detention basins, vegetation buffers and garden bed planting contribute to stepping-stone habitat connectivity and 'moist corridors' across the site.
3. Hospital landscape - including edible plants where appropriate **	7. Vegetated buffer **	11. Health Hub / Support Building **	

12	16.02.2021	SSD2	AR	MC
11	16.03.2020	RTS	AR	MC
10	20.02.2020	RTS	AR	MC
9	18.10.2019	SSD2	AR	MC
8	23.09.2019	SSD2	AR	MH
7	28.08.2019	FOR INFORMATION	AR	MC
6	16.08.2019	FOR INFORMATION	AR	MC
5	09.08.2019	FOR INFORMATION	AR	MC
4	02.08.2019	FOR INFORMATION	AR	MC
3	09.07.2019	FOR INFORMATION	HH	MC
2	08.07.2019	FOR INFORMATION	HH	MC
1	19.06.2019	70% SCHEMATIC DESIGN	AR	MC

Rev Date Description Drawn Checked

turf

Turf Design Studio: P.O Box 419 Cronulla NSW 2230, 95 Kingsway, Cronulla 2230
Phone (+61 2) 9527 3380, Fax (+61 2) 9527 2307
Email: sydney@turfdesign.com

Client

NSW GOVERNMENT | **Health** Infrastructure | **Health** Northern NSW Local Health District

Project

TWEED VALLEY HOSPITAL DEVELOPMENT

Drawing Title

Zonal Plan

Drawing Status

SSD2

Scale:	As indicated @A1	Plot Date	
Project No.	1719	Drawing No.	LS-DWG -10-003
		Revision	12

NOT FOR CONSTRUCTION



- GENERAL NOTES
1. THIS DRAWING IS COPYRIGHT AND IS THE PROPERTY OF TURF DESIGN STUDIO AND
 2. MUST NOT BE USED WITHOUT PERMISSION.
 - THIS DRAWING IS AN UNCONTROLLED COPY UNLESS STAMPED WITH STATUS
 - THE CONTRACTOR MUST VERIFY ALL DIMENSIONS AND LEVELS ON SITE AS THIS IS
 4. NOT A SHOP DRAWING.
 - THE CONTRACTOR MUST REFER ANY DISCREPANCIES TO THE SUPERINTENDENTS
 5. REPRESENTATIVE BEFORE PROCEEDING WITH THE WORK.
 - THE CONTRACTOR MUST NOT SCALE FROM THESE DRAWINGS. USE NOMINATED
 6. DIMENSIONS AND LEVELS.
 - THIS DRAWING MUST BE READ IN CONJUNCTION WITH THE TOTAL CONTRACT
 7. PACKAGE INCLUDING DRAWINGS AND SPECIFICATIONS OF ALL CONSULTANTS.
 - IF THE CONTRACTOR INTENDS TO UNDERTAKE ANY EXCAVATION WORK, IT IS THE
 - CONTRACTORS RESPONSIBILITY TO CONTACT 1100 - DIAL BEFORE YOU DIG OR
 - WWW.1100.COM.AU
- SURVEY INFORMATION
8. TURF DESIGN STUDIO DO NOT WARRANT THE ACCURACY OF SURVEY INFORMATION.

1 Eastern Entry & Green Spine Detail Plan
1 : 250@A1

LEGEND

-  Seating with Backrest (50% of the total length)
-  Lighting (TBC)
-  Pause Points



2 East Green Spine Section
1 : 100@A1

9	16.02.2021 SSD2	AR	MC
8	18.10.2019 SSD2	AR	MC
7	23.09.2019 SSD2	AR	MH
6	28.08.2019 FOR INFORMATION	AR	MC
5	16.08.2019 FOR INFORMATION	AR	MC
4	09.08.2019 FOR INFORMATION	AR	MC
3	02.08.2019 FOR INFORMATION	AR	MC
2	08.07.2019 FOR INFORMATION	HH	MC
1	19.06.2019 70% SCHEMATIC DESIGN	AR	MC

Rev	Date	Description	Drawn	Checked
-----	------	-------------	-------	---------



Turf Design Studio: P O Box 419 Cronulla NSW 2230, 95 Kingsway, Cronulla 2230
Phone: (+61 2) 9527 3380, Fax: (+61 2) 9527 2307
Email: sydney@turfdesign.com



Project
TWEED VALLEY HOSPITAL DEVELOPMENT

Drawing Title
Landscape Plans & Sections - Eastern Entry & Green Spine

Drawing Status
SSD2

Scale:	As indicated @A1	Plot Date	
Project No.	Drawing No.	Revision	
1719	LS-DWG -20-004	9	

NOT FOR CONSTRUCTION

C:\Users\User\Documents\TVH_LANDSCAPE_L18_Abdullah R.rvt

GENERAL NOTES


1. THIS DRAWING IS COPYRIGHT AND IS THE PROPERTY OF TURF DESIGN STUDIO AND MUST NOT BE USED WITHOUT PERMISSION.
2. THIS DRAWING IS AN UNCONTROLLED COPY UNLESS STAMPED WITH STATUS AND THE CONTRACTOR MUST VERIFY ALL DIMENSIONS AND LEVELS ON SITE AS THIS IS NOT A SHOP DRAWING.
3. THE CONTRACTOR MUST REFER ANY DISCREPANCIES TO THE SUPERINTENDENTS REPRESENTATIVE BEFORE PROCEEDING WITH THE WORK.
4. THE CONTRACTOR MUST NOT SCALE FROM THESE DRAWINGS. USE NOMINATED DIMENSIONS AND LEVELS.
5. THIS DRAWING MUST BE READ IN CONJUNCTION WITH THE TOTAL CONTRACT PACKAGE INCLUDING DRAWINGS AND SPECIFICATIONS OF ALL CONSULTANTS.
6. IF THE CONTRACTOR INTENDS TO UNDERTAKE ANY EXCAVATION WORK, IT IS THE CONTRACTORS RESPONSIBILITY TO CONTACT 1100 - DIAL BEFORE YOU DIG OR WWW.1100.COM.AU

SURVEY INFORMATION

8. TURF DESIGN STUDIO DO NOT WARRANT THE ACCURACY OF SURVEY INFORMATION.




1 10m Agricultural buffer - West of loop road entry
1 : 500@A1

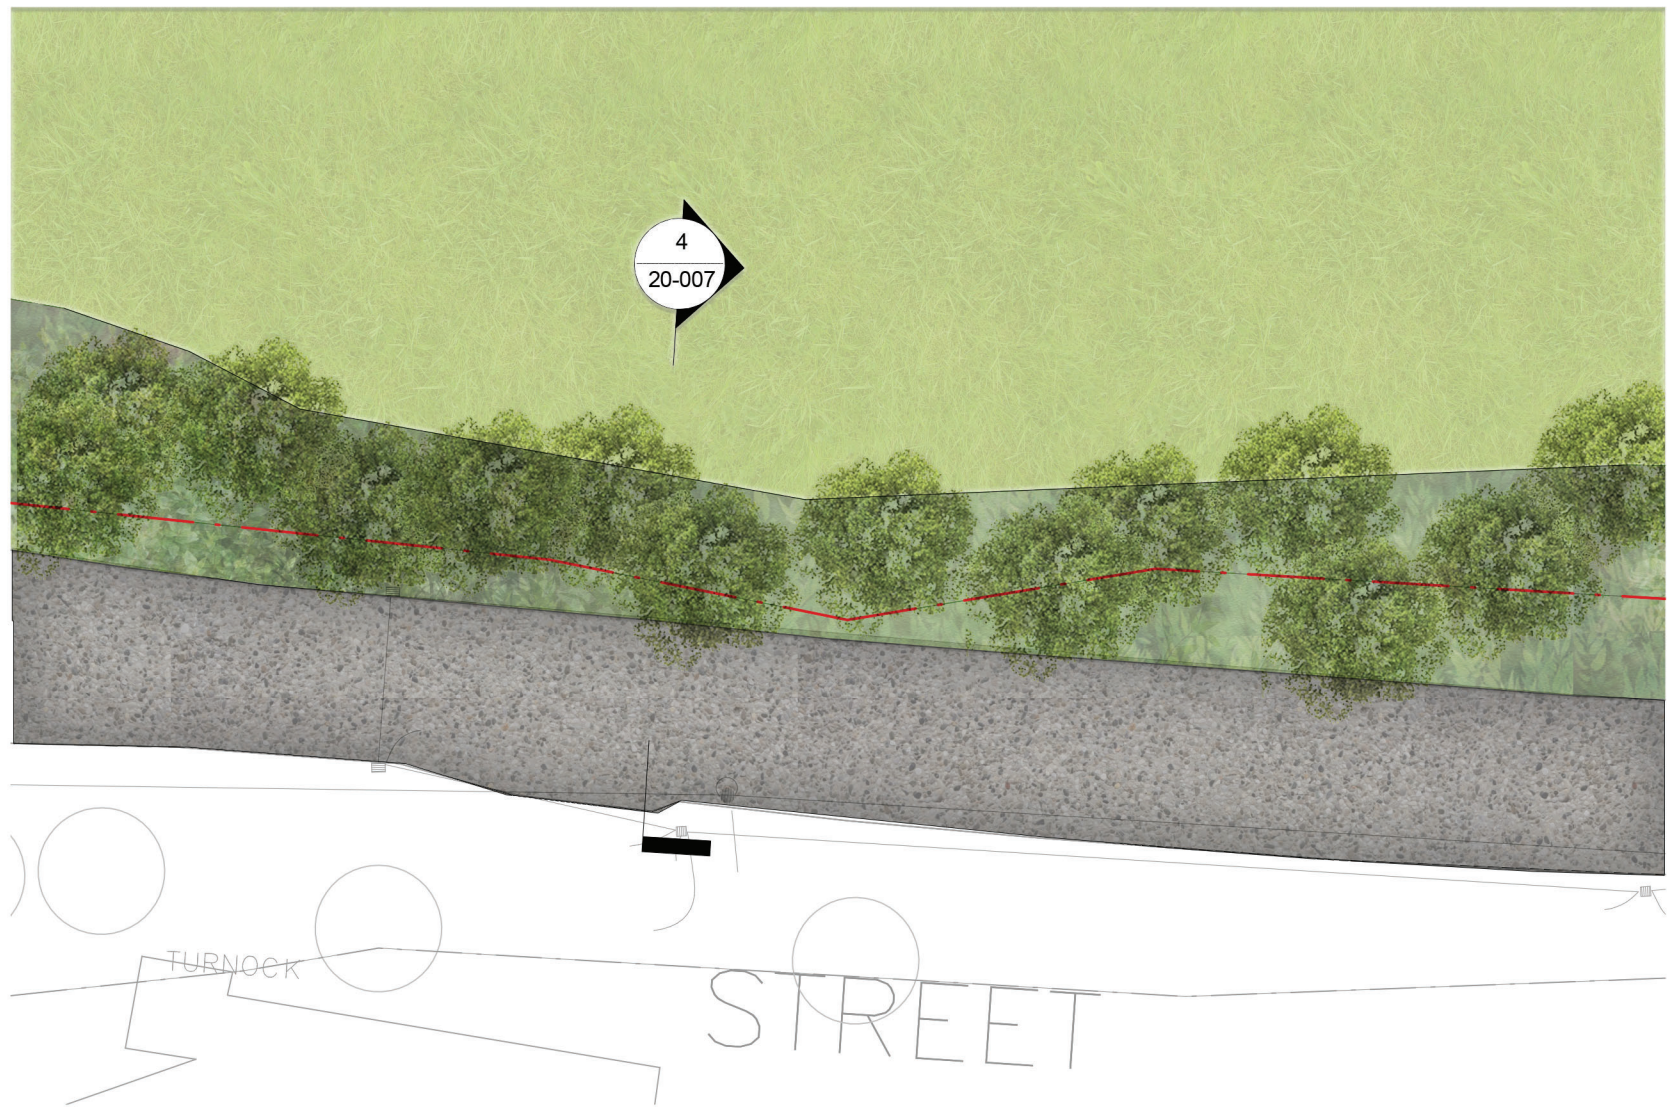

3 10m Embellished buffer - East of the hospital
1 : 500@A1



2 30m Agricultural buffer - West of loop road entry
1 : 200@A1

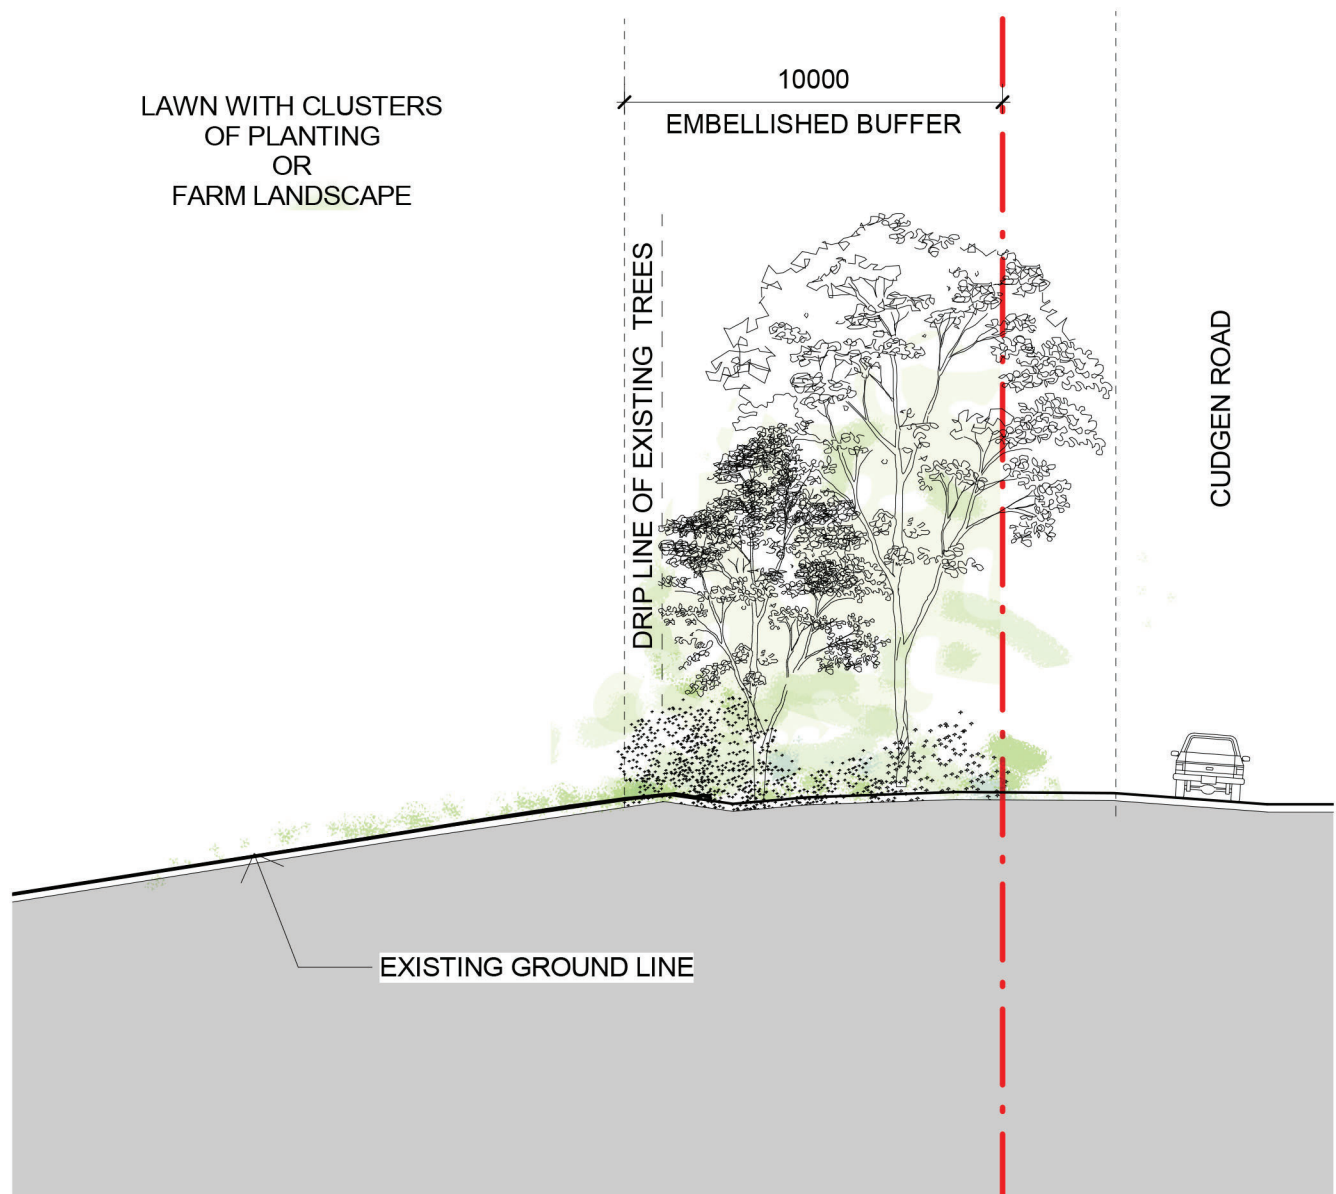

4 10m Embellished buffer - East of the hospital
1 : 200@A1

6	16.02.2021	SSD2	AR	MC
5	18.10.2019	SSD2	AR	MC
4	23.09.2019	SSD2	AR	MH
3	28.08.2019	FOR INFORMATION	AR	MC
2	16.08.2019	FOR INFORMATION	AR	MC
1	09.08.2019	FOR INFORMATION	AR	MC

Rev	Date	Description	Drawn	Checked
-----	------	-------------	-------	---------



Turf Design Studio: P.O. Box 419 Cronulla NSW 2230, 95 Kingsway, Cronulla 2230
Phone (+61 2) 9527 3380, Fax (+61 2) 9527 2307
Email: sydney@turfdesign.com



Project
TWEED VALLEY HOSPITAL DEVELOPMENT

Drawing Title
Landscape Plans & Sections - East and west Buffer

Drawing Status



SSD2

Scale	As indicated @A1	Plot Date
-------	------------------	-----------

Project No.	Drawing No.	Revision
-------------	-------------	----------

1719 LS-DWG -20-007 6

NOT FOR CONSTRUCTION

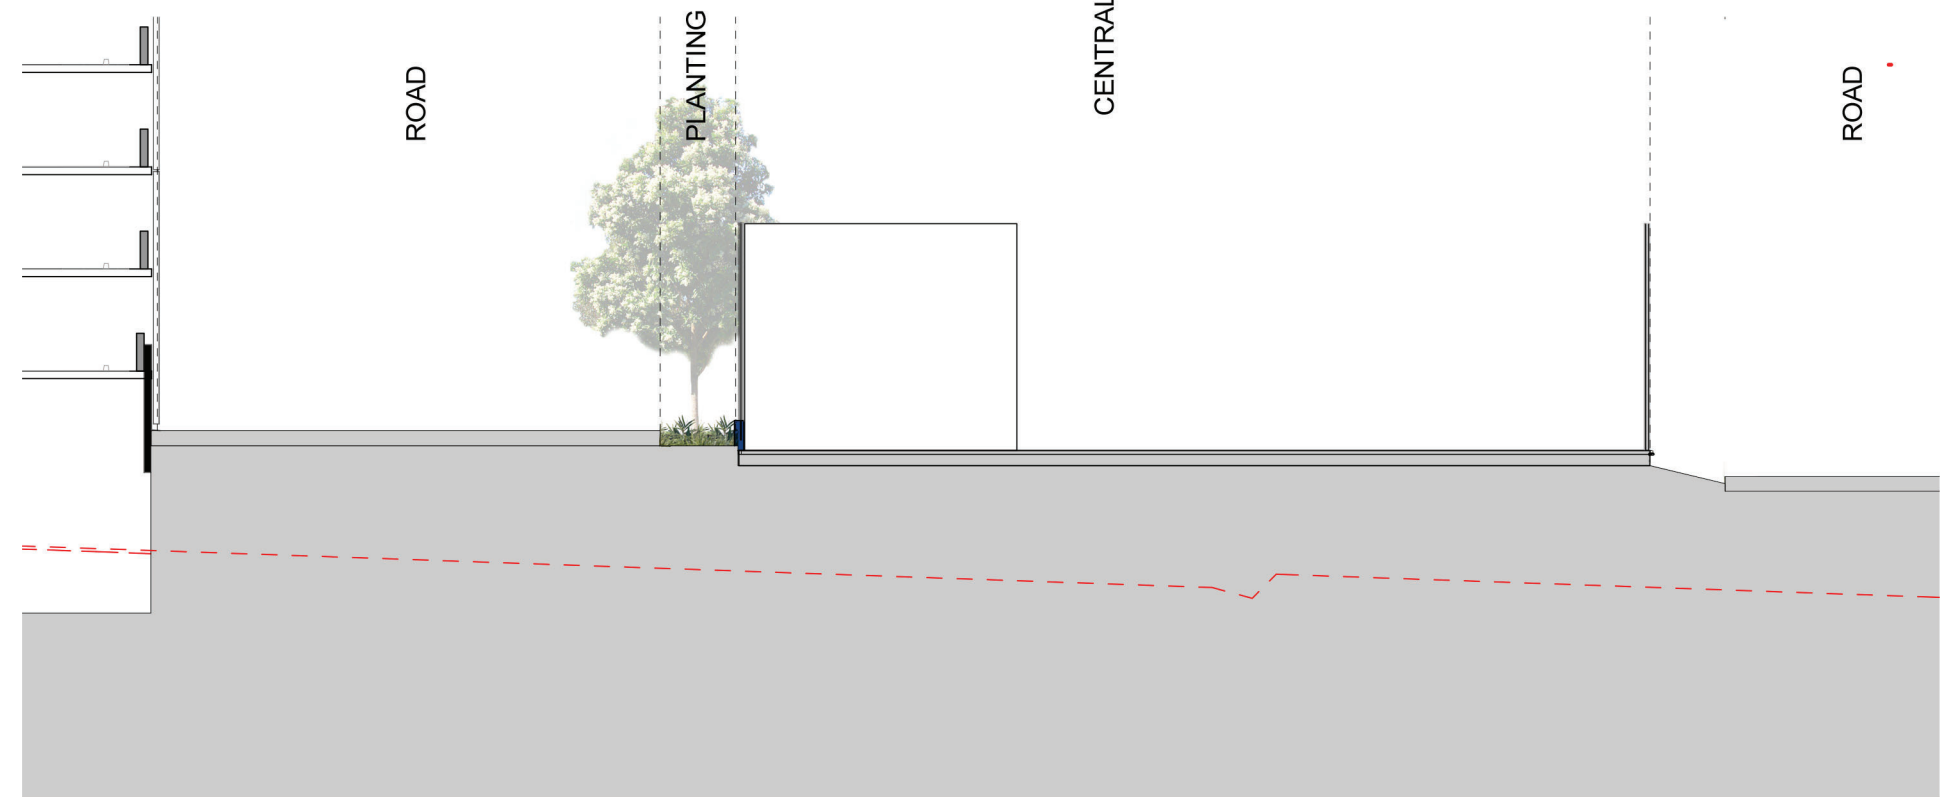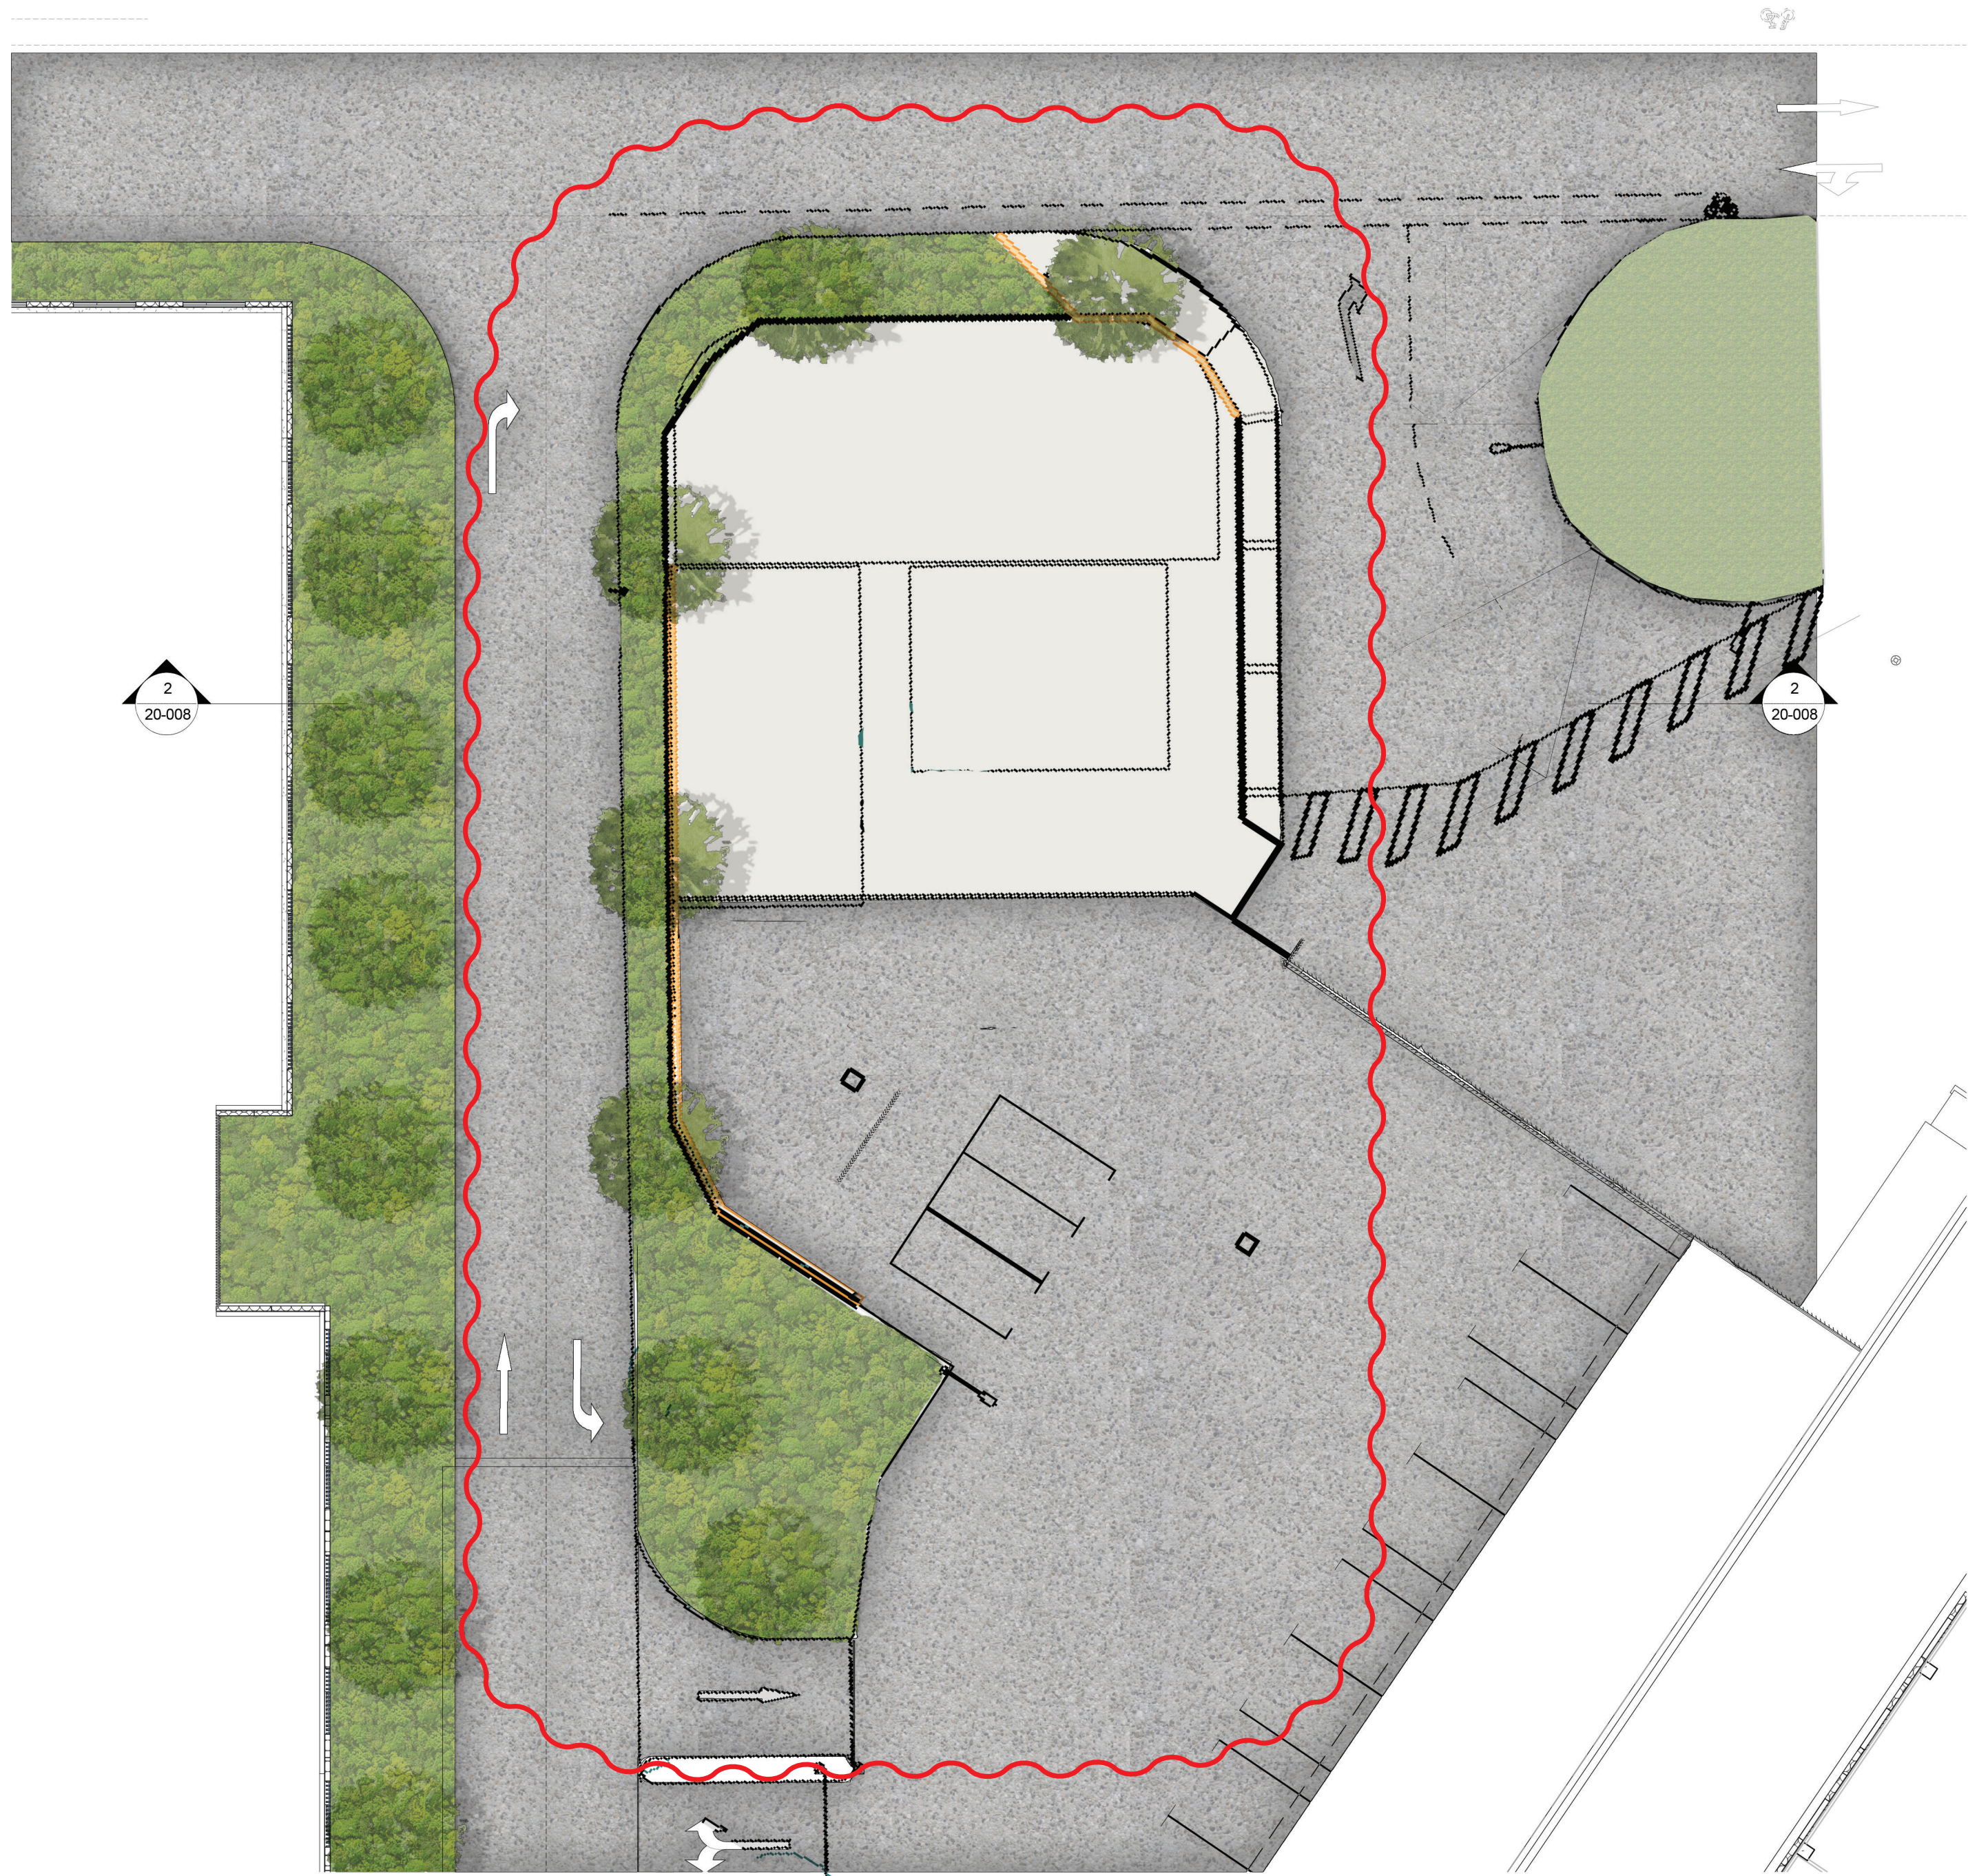

2 Central Energy Plant
1 : 200@A1

0 2 4 6 8 10
SCALE - 1:200 @ A1, 1:400 @ A3

- GENERAL NOTES
1. THIS DRAWING IS COPYRIGHT AND IS THE PROPERTY OF TURF DESIGN STUDIO AND MUST NOT BE USED WITHOUT PERMISSION.
 2. THIS DRAWING IS AN UNCONTROLLED COPY UNLESS STAMPED WITH STATUS.
 3. THE CONTRACTOR MUST VERIFY ALL DIMENSIONS AND LEVELS ON SITE AS THIS IS NOT A SHOP DRAWING.
 4. THE CONTRACTOR MUST REFER ANY DISCREPANCIES TO THE SUPERINTENDENTS REPRESENTATIVE BEFORE PROCEEDING WITH THE WORK.
 5. THE CONTRACTOR MUST NOT SCALE FROM THESE DRAWINGS. USE NOMINATED DIMENSIONS AND LEVELS.
 6. THIS DRAWING MUST BE READ IN CONJUNCTION WITH THE TOTAL CONTRACT PACKAGE INCLUDING DRAWINGS AND SPECIFICATIONS OF ALL CONSULTANTS.
 7. IF THE CONTRACTOR INTENDS TO UNDERTAKE ANY EXCAVATION WORK, IT IS THE CONTRACTORS RESPONSIBILITY TO CONTACT 1100 - DIAL BEFORE YOU DIG OR WWW.1100.COM.AU

- SURVEY INFORMATION
8. TURF DESIGN STUDIO DO NOT WARRANT THE ACCURACY OF SURVEY INFORMATION.

9	16.02.2021	SSD2	AR	MC
8	18.10.2019	SSD2	AR	MC
7	23.09.2019	SSD2	AR	MH
6	28.08.2019	FOR INFORMATION	AR	MC
5	16.08.2019	FOR INFORMATION	AR	MC
4	09.08.2019	FOR INFORMATION	AR	MC
3	02.08.2019	FOR INFORMATION	AR	MC
2	08.07.2019	FOR INFORMATION	HH	MC
1	19.06.2019	70% SCHEMATIC DESIGN	AR	MC

Rev	Date	Description	Drawn	Checked
-----	------	-------------	-------	---------



Turf Design Studio: P.O. Box 419 Cronulla NSW 2230, 95 Kingsway, Cronulla 2230
Phone (+61 2) 9527 3380, Fax (+61 2) 9527 2307
Email: sydney@turfdesign.com



Project
**TWEED VALLEY HOSPITAL
DEVELOPMENT**

Drawing Title
**Landscape Plans & Sections -
Central Energy Plant**

Drawing Status

SSD2

Scale	1 : 200 @A1	Plot Date
-------	-------------	-----------

Project No.	Drawing No.	Revision
-------------	-------------	----------

1719 LS-DWG -20-008 9

NOT FOR CONSTRUCTION

1 Central Energy Plant
1 : 200@A1

8. LANDSCAPE MASTERPLAN



KOALA FOOD
TREES MARKUP

16.02.2021

- Orange circle: Tallowwood (Eucalyptus microcorys)*
- Blue circle: Small-fruited grey gum (Eucalyptus propinqua)
- * or Swamp Mahogany (Eucalyptus robusta) in Zone 10

LEGEND

1. Retained forest - Restored and enhanced in accordance with Biodiversity Management Plan	4. Green Spine **	8. Embellished Buffer - Embellished in accordance with Biodiversity Management Plan **	12a. Existing Orchard
2a. Bioretention planting **	5. Feature Entries/Hospital landscape fringe **	9. Hydromulched/drill seeded lawn (Exotic grass-mowing maintenance eg. couch, buffalo)	12b. Therapy garden Opportunity **
2b. Rain Gardens **	6. Landscaped courtyards within hospital envelope **	10. Lawn with clusters of native planting	** From a biodiversity/habitat connectivity perspective the bio-detention basins, vegetation buffers and garden bed planting contribute to stepping-stone habitat connectivity and 'moist corridors' across the site.
3. Hospital landscape - including edible plants where appropriate **	7. Vegetated buffer **	11. Health Hub / Support Building **	

Fig 8.1 Landscape Zonal Plan