


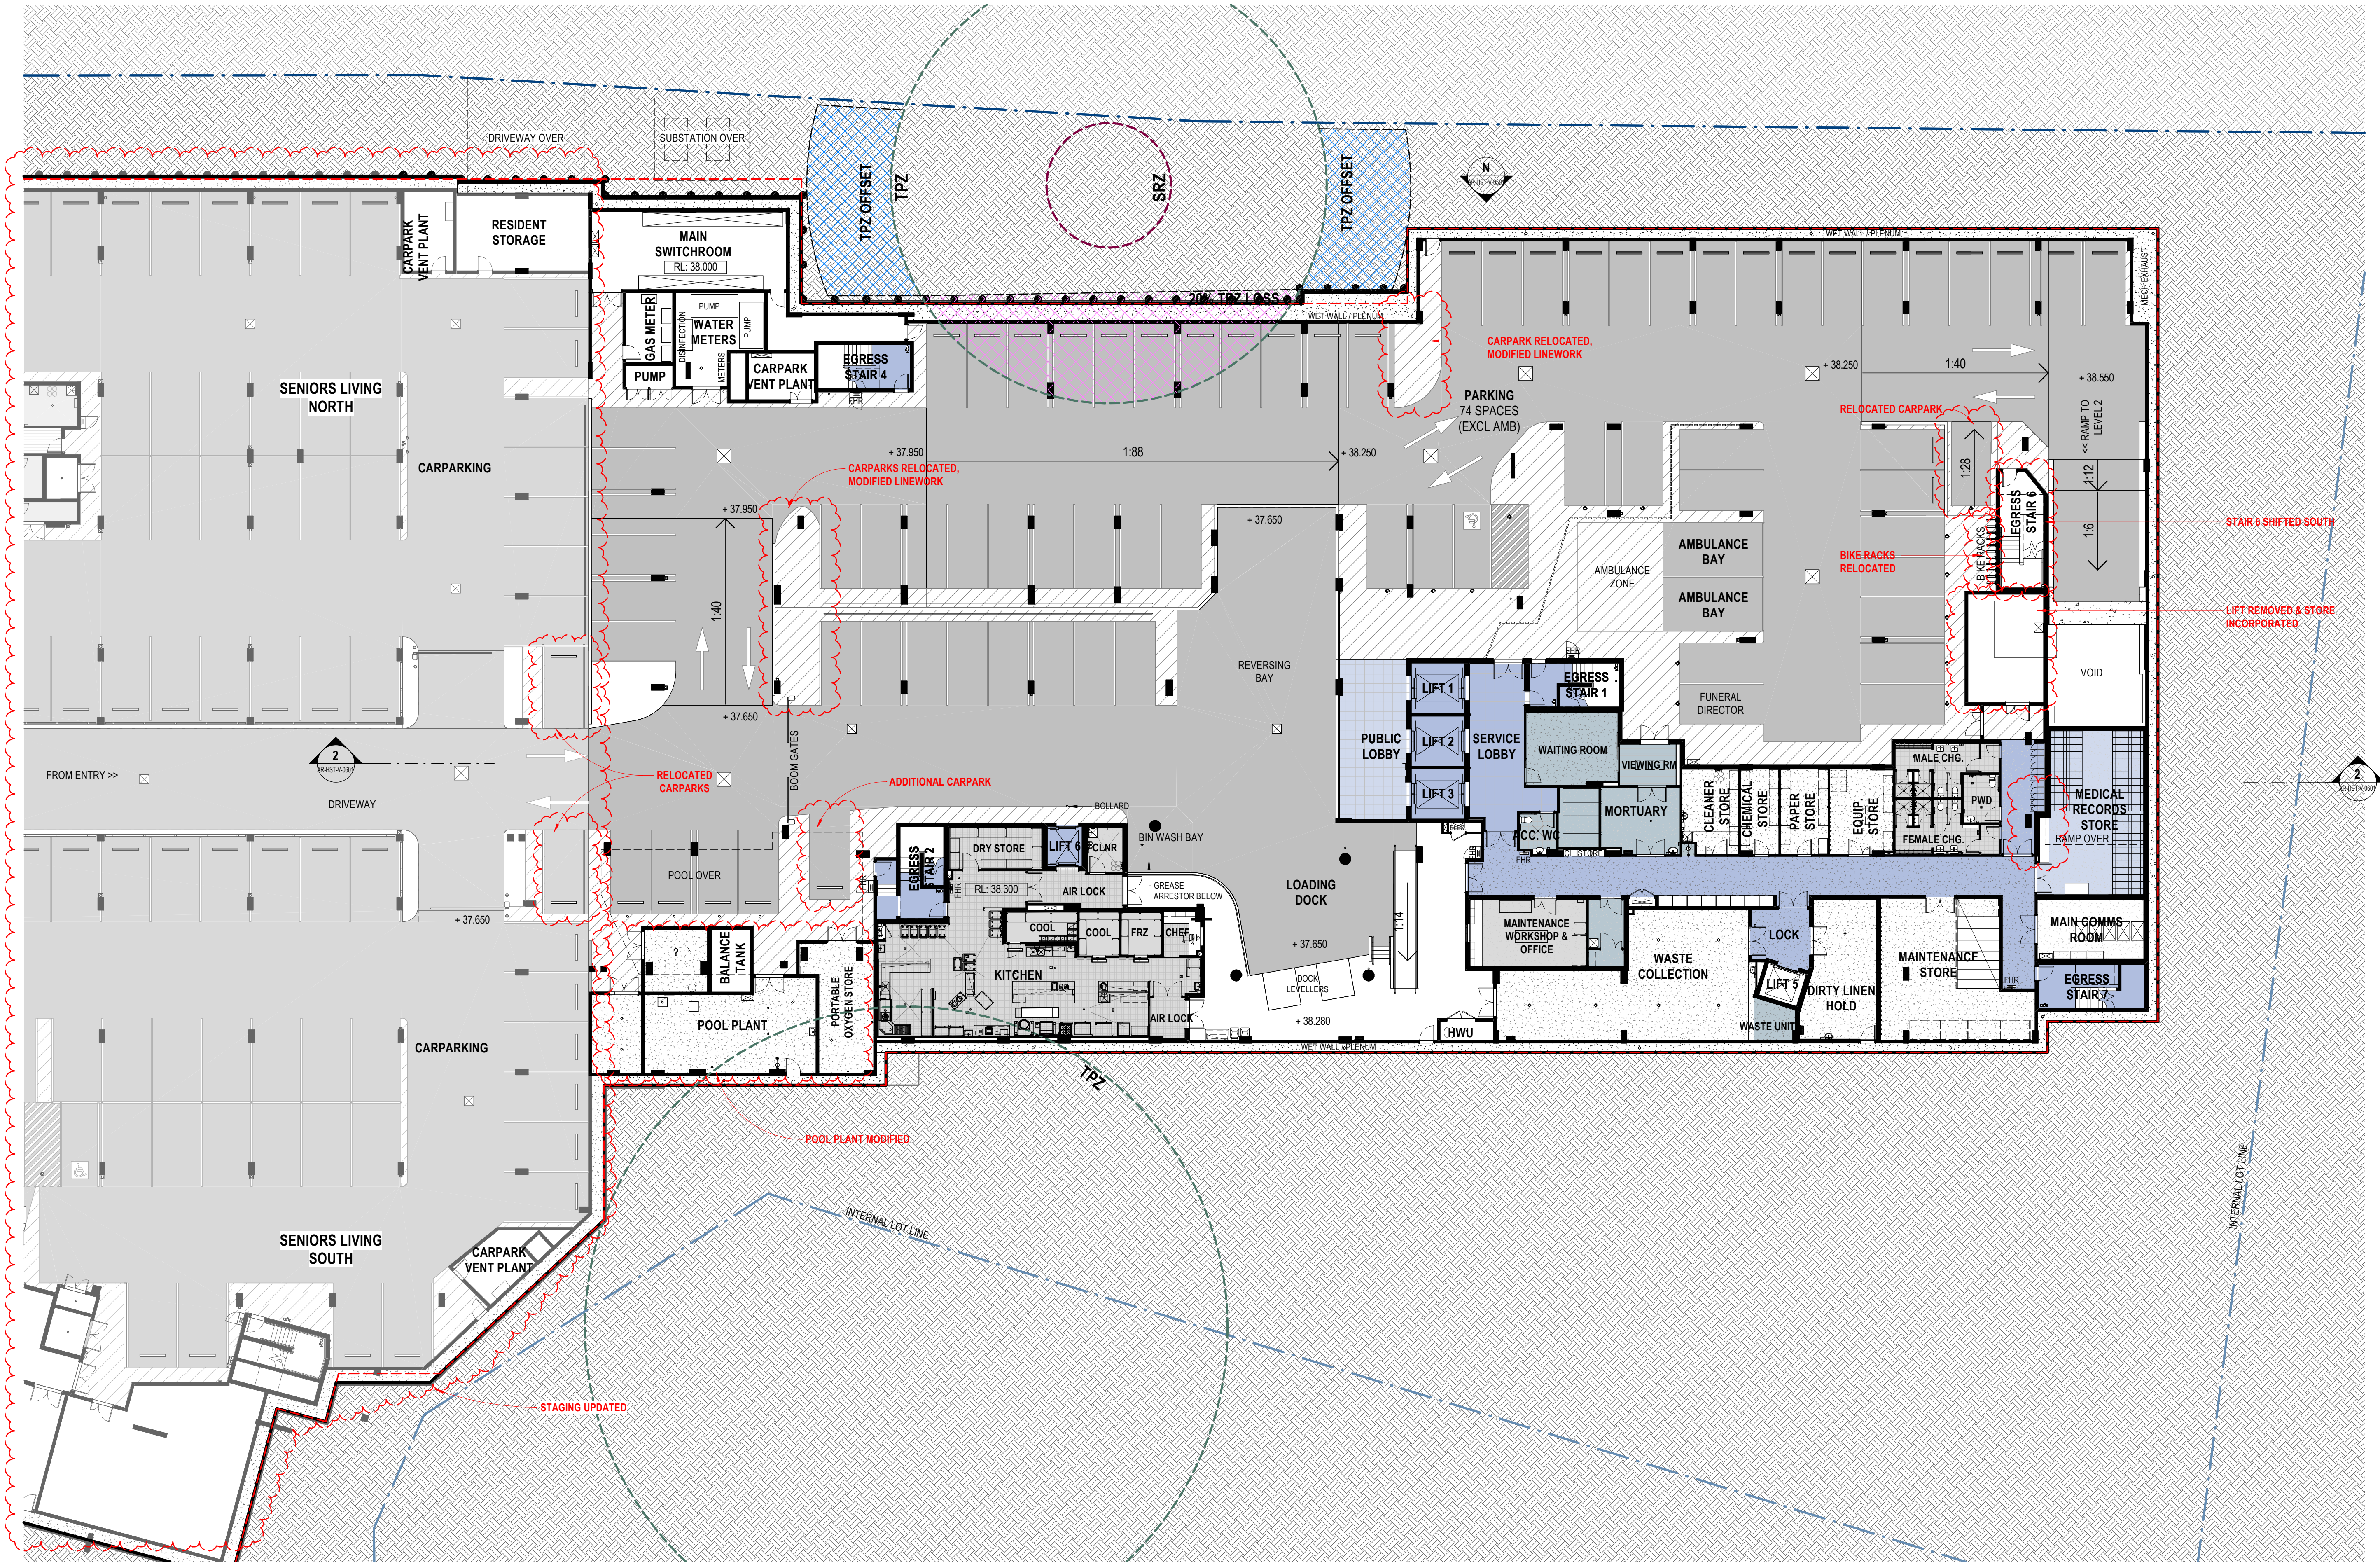

0m 4m 8m 12m 16m 20m


1: 200 @ A1 THIS DRAWING IS IN COLOUR. IF YOU DO NOT HAVE A COLOURED VERSION YOU DO NOT HAVE ALL THE REQUIRED INFORMATION. THIS NOTE IS IN RED.

© COPYRIGHT THESE DRAWINGS AND DESIGNS AND THE COPYRIGHT THEREOF ARE THE PROPERTY OF BICKERTON MASTERS ARCHITECTURE PTY LTD (ACN 109 225 149) T/A BICKERTON MASTERS AND BM HEDE PTY LTD (ACN 630 149 998) T/A HEDE ARCHITECTS AND MUST NOT BE USED, RETAINED OR COPIED WITHOUT THE WRITTEN PERMISSION OF THE AFOREMENTIONED LEGAL ENTITIES. BICKERTON MASTERS AND HEDE ARCHITECTS ACCEPT NO RESPONSIBILITY FOR THE USABILITY, COMPLETENESS OR ACCURACY OF DATA TRANSFERRED ELECTRONICALLY. RECIPIENTS SHOULD WHEN NECESSARY REQUEST A HARD COPY VERSION FOR VERIFICATION. USE FIGURED DIMENSIONS IN PREFERENCE TO SCALE. ALL DIMENSIONS TO BE VERIFIED ON SITE.

NSW NOMINATED ARCHITECT: ANDREW MASTERS NSW ARB No. 9037

Autodesk Docs://Greenwich Hospital Redevelopment/AR-HST-V-GREENWICH.rvt

P29	30/09/2025	ISSUED FOR PLANNING MODIFICATIONS	CM
P28	07.04.2025	ISSUE FOR PLANNING MODIFICATION	ZB
P27	27.06.2023	RESPONSE TO SUBMISSIONS	NAH
P26	21.12.2022	RESPONSE TO SUBMISSIONS	AMac
REV	DATE	DETAILS	INITIALS

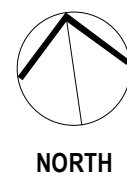

LEGEND - PLAN	
SYMBOL	DESCRIPTION
	Room Name
	Room Number
	Detail Number of Section / Elevation
	Sheet Number of Section / Elevation

SYMBOL	DESCRIPTION
	Property Boundary
	Movement Joint. Refer to Structural Drawings

SYDNEY
(02) 9261 8333
SUITE 103
110 PACIFIC HIGHWAY
NORTH SYDNEY 2060, NSW
www.bickertonmasters.com.au




CLIENT:
HammondCare
Champion Life
PROJECT: 01605
GREENWICH HOSPITAL
REDEVELOPMENT
RIVER RD, GREENWICH

REVISION: DRAWING No:
P29 DD-HST-0100
DATE: 08/22/22
DRAWING TITLE:
H&C - OVERALL PLAN - L1
DRAWN: NAH CHECKED: SCALE: 1: 200 @ A1

APPROVAL ISSUE
NOT FOR CONSTRUCTION

NSW NOMINATED ARCHITECT: ANDREW MASTERS (9037)

30/09/2025 12:11:25 PM

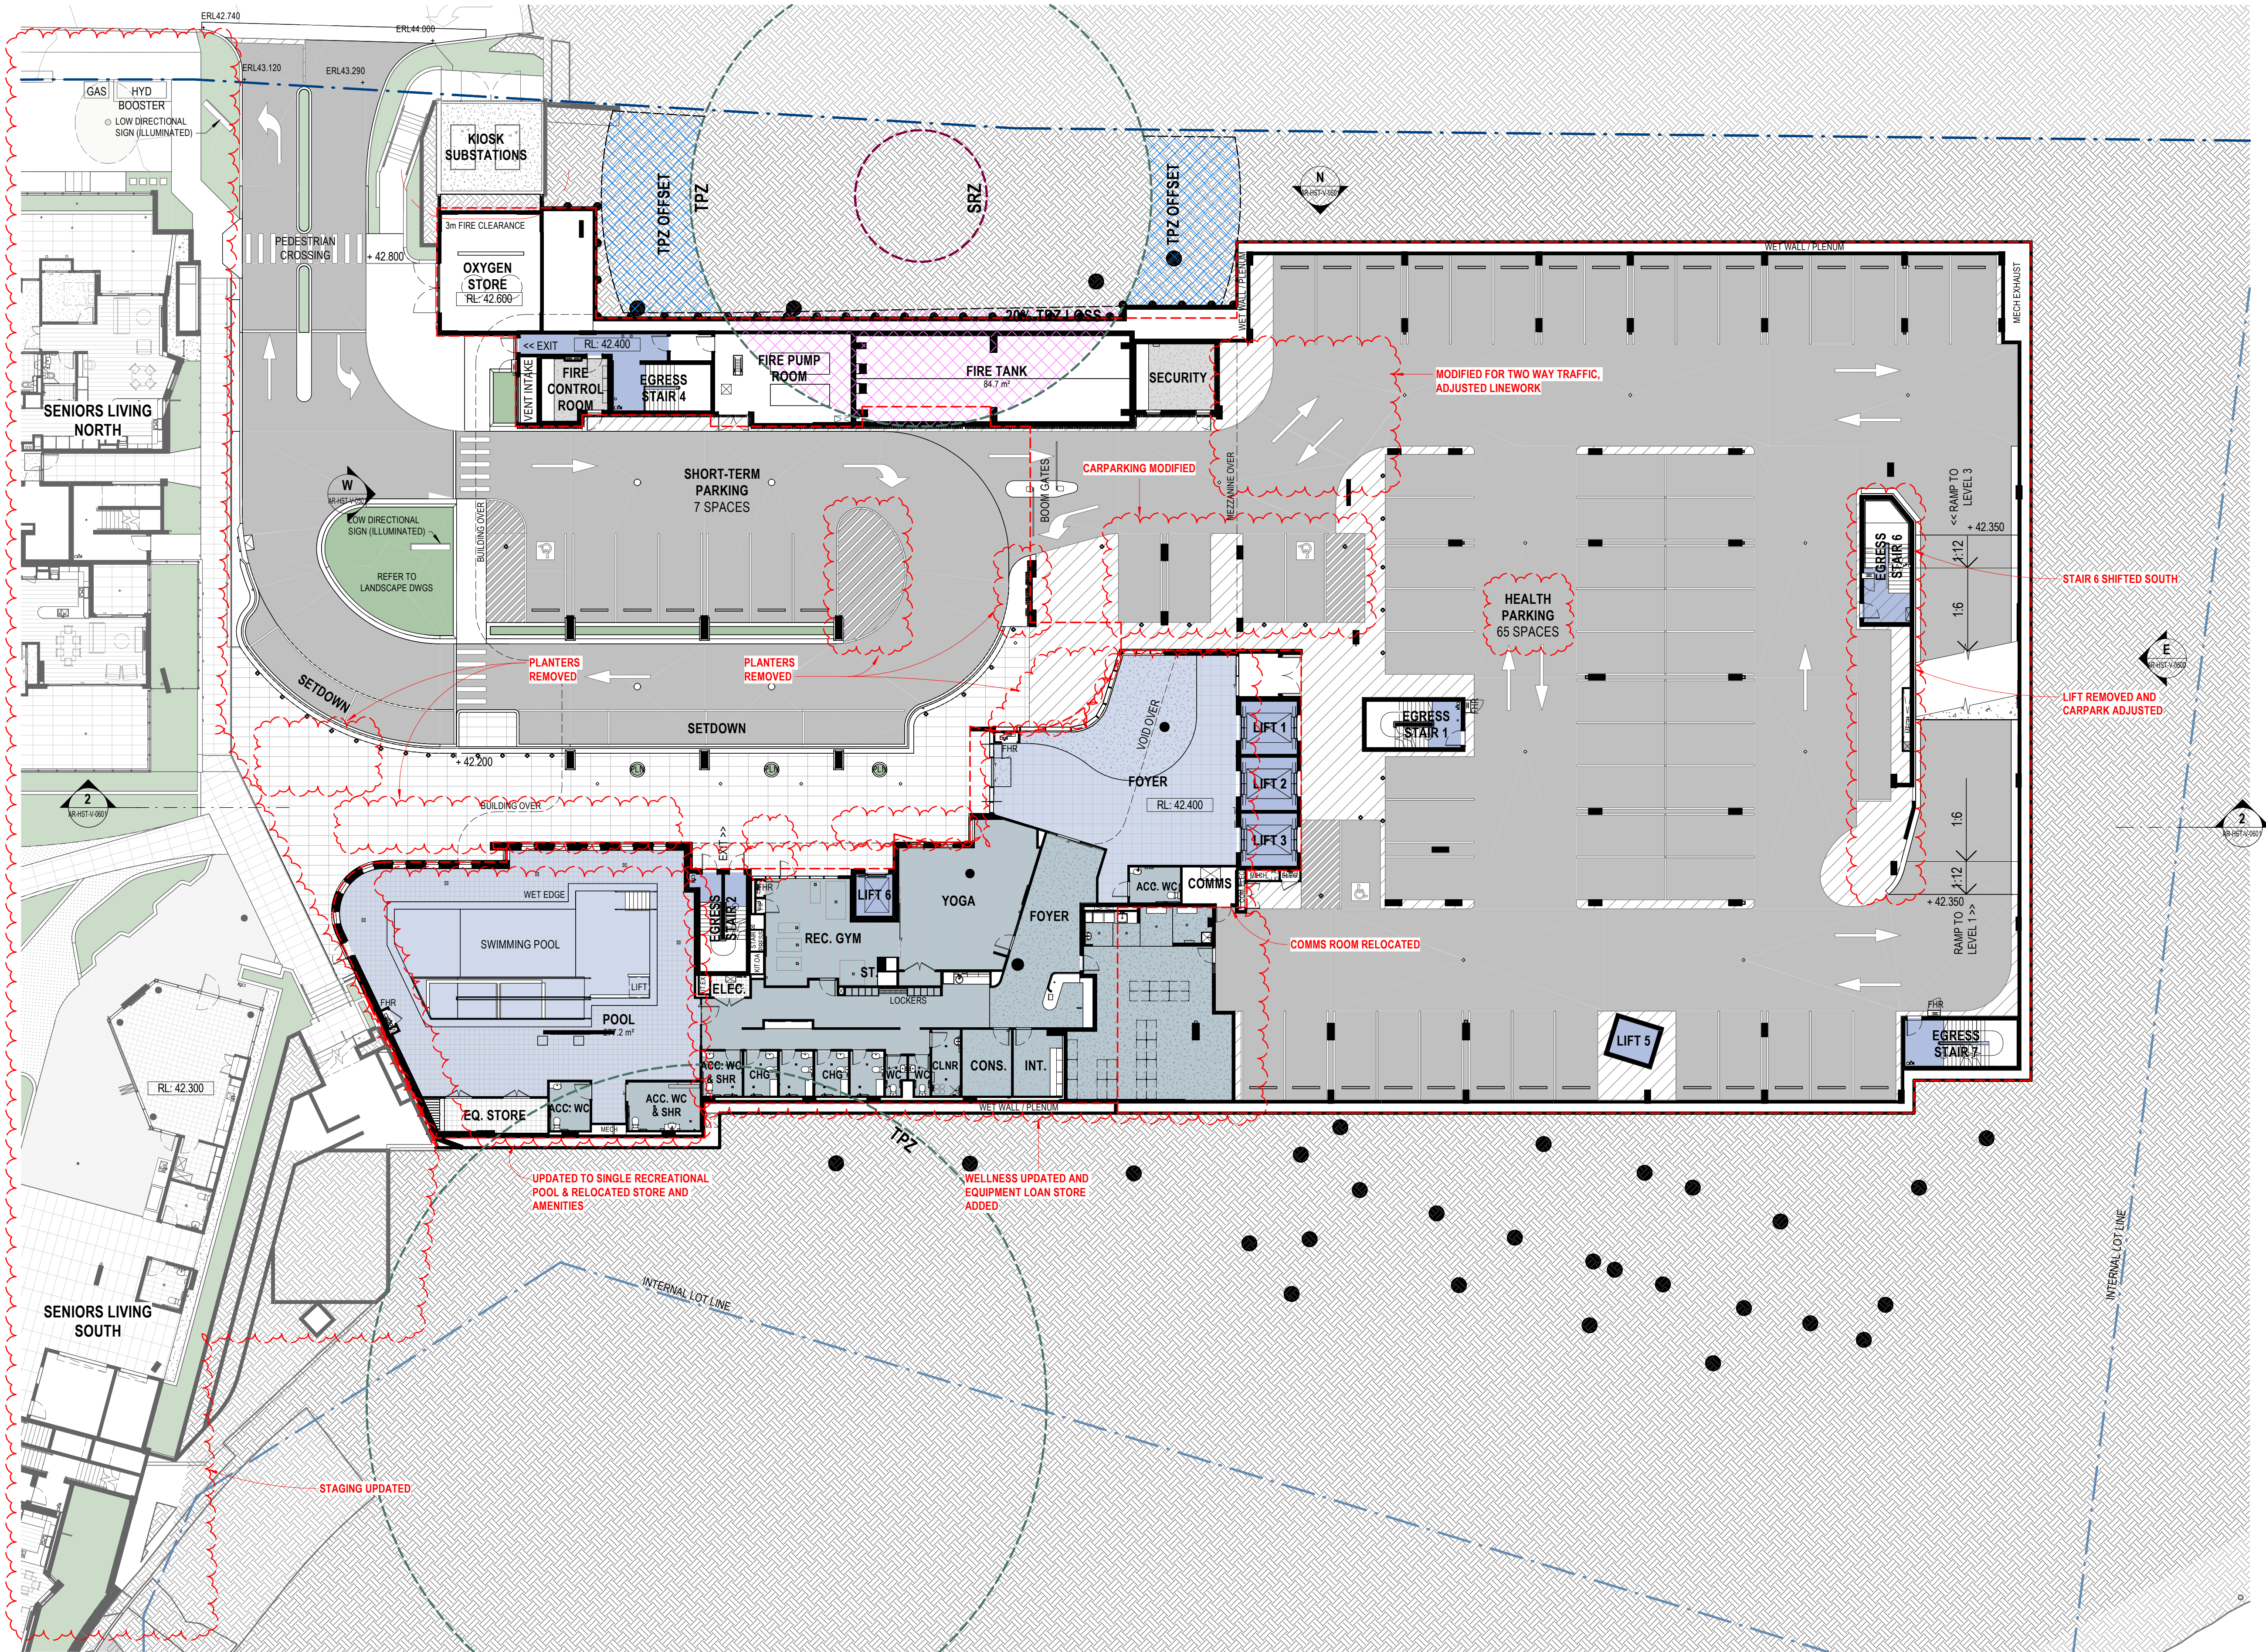

0m 4m 8m 12m 16m 20m


1 : 200 @ A1 THIS DRAWING IS IN COLOUR. IF YOU DO NOT HAVE A COLOURED VERSION YOU DO NOT HAVE ALL THE REQUIRED INFORMATION. THIS NOTE IS IN RED.

© COPYRIGHT THESE DRAWINGS AND DESIGNS AND THE COPYRIGHT THEREOF ARE THE PROPERTY OF BICKERTON MASTERS ARCHITECTURE PTY LTD (ACN 109 225 149) T/A BICKERTON MASTERS AND BM HEDE PTY LTD (ACN 630 149 998) T/A HEDE ARCHITECTS AND MUST NOT BE USED, RETAINED OR COPIED WITHOUT THE WRITTEN PERMISSION OF THE AFOREMENTIONED LEGAL ENTITIES. BICKERTON MASTERS AND HEDE ARCHITECTS ACCEPT NO RESPONSIBILITY FOR THE USABILITY, COMPLETENESS OR ACCURACY OF DATA TRANSFERRED ELECTRONICALLY. RECIPIENTS SHOULD WHEN NECESSARY REQUEST A HARD COPY VERSION FOR VERIFICATION. USE FIGURED DIMENSIONS IN PREFERENCE TO SCALE. ALL DIMENSIONS TO BE VERIFIED ON SITE.

NSW NOMINATED ARCHITECT: ANDREW MASTERS NSW ARB No. 9037

Autodesk Docs://Greenwich Hospital Redevelopment/AR-HST-V-GREENWICH.rvt

P28	30/09/2025	ISSUED FOR PLANNING MODIFICATIONS	CM
P27	07.04.2025	ISSUE FOR PLANNING MODIFICATION	ZB
P26	27.06.2023	RESPONSE TO SUBMISSIONS	NAH
P25	21.12.2022	RESPONSE TO SUBMISSIONS	AMac
REV	DATE	DETAILS	INITIALS

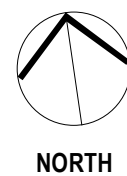

LEGEND - PLAN

SYMBOL	DESCRIPTION	SYMBOL	DESCRIPTION
	Room Name		Property Boundary
	Room Number		Movement Joint. Refer to Structural Drawings
	Detail Number of Section / Elevation		
	Sheet Number of Section / Elevation		

SYDNEY
(02) 9261 8333
SUITE 103
110 PACIFIC HIGHWAY
NORTH SYDNEY 2060, NSW
www.bickertonmasters.com.au



CLIENT:
HammondCare
Champion Life
PROJECT: 01605
GREENWICH HOSPITAL
REDEVELOPMENT
RIVER RD, GREENWICH

REVISION: DRAWING No:
P28 DD-HST-0101
DATE: 08/04/22
DRAWING TITLE:
H&C - OVERALL PLAN - L2
DRAWN: NAH CHECKED: SCALE: 1 : 200 @A1

APPROVAL ISSUE
NOT FOR CONSTRUCTION

NSW NOMINATED ARCHITECT: ANDREW MASTERS (9037)

30/09/2025 12:11:30 PM




1 : 200 @ A1 THIS DRAWING IS IN COLOUR. IF YOU DO NOT HAVE A COLOURED VERSION YOU DO NOT HAVE ALL THE REQUIRED INFORMATION. THIS NOTE IS IN RED.

© COPYRIGHT THESE DRAWINGS AND DESIGNS AND THE COPYRIGHT THEREOF ARE THE PROPERTY OF BICKERTON MASTERS ARCHITECTURE PTY LTD (ACN 109 225 149) T/A BICKERTON MASTERS AND BM HEDE PTY LTD (ACN 630 149 998) T/A HEDE ARCHITECTS AND MUST NOT BE USED, RETAINED OR COPIED WITHOUT THE WRITTEN PERMISSION OF THE AFOREMENTIONED LEGAL ENTITIES. BICKERTON MASTERS AND HEDE ARCHITECTS ACCEPT NO RESPONSIBILITY FOR THE USABILITY, COMPLETENESS OR ACCURACY OF DATA TRANSFERRED ELECTRONICALLY. RECIPIENTS SHOULD WHEN NECESSARY REQUEST A HARD COPY VERSION FOR VERIFICATION. USE FIGURED DIMENSIONS IN PREFERENCE TO SCALE. ALL DIMENSIONS TO BE VERIFIED ON SITE.

NSW NOMINATED ARCHITECT: ANDREW MASTERS NSW ARB No. 9037
Autodesk Docs://Greenwich Hospital Redevelopment/AR-HST-V-GREENWICH.rvt

P28	30/09/2025	ISSUED FOR PLANNING MODIFICATIONS	CM
P27	07.04.2025	ISSUE FOR PLANNING MODIFICATION	ZB
P26	27.06.2023	RESPONSE TO SUBMISSIONS	NAH
P25	21.12.2022	RESPONSE TO SUBMISSIONS	AMac
REV	DATE	DETAILS	INITIALS

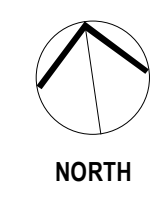

LEGEND - PLAN			
SYMBOL	DESCRIPTION	SYMBOL	DESCRIPTION
ROOM NAME	Room Name	Property Boundary	Property Boundary
000	Room Number	Movement Joint. Refer to Structural Drawings	Movement Joint. Refer to Structural Drawings
000	Detail Number of Section / Elevation		
000	Sheet Number of Section / Elevation		

SYDNEY
(02) 9261 8333
SUITE 103
110 PACIFIC HIGHWAY
NORTH SYDNEY 2060, NSW
www.bickertonmasters.com.au



CLIENT:
HammondCare
Champion Life
PROJECT: 01605
GREENWICH HOSPITAL
REDEVELOPMENT
RIVER RD, GREENWICH

REVISION: DRAWING No:
P28 DD-HST-0103
DATE: 08/04/22
DRAWING TITLE:
H&C - OVERALL PLAN - L4
DRAWN: NAH CHECKED: SCALE: 1 : 200 @A1
NSW NOMINATED ARCHITECT: ANDREW MASTERS (9037) 30/09/2025 12:11:42 PM



APPROVAL ISSUE
NOT FOR CONSTRUCTION

0m 4m 8m 12m 16m 20m


1 : 200 @ A1 THIS DRAWING IS IN COLOUR. IF YOU DO NOT HAVE A COLOURED VERSION YOU DO NOT HAVE ALL THE REQUIRED INFORMATION. THIS NOTE IS IN RED.

© COPYRIGHT THESE DRAWINGS AND DESIGNS AND THE COPYRIGHT THEREOF ARE THE PROPERTY OF BICKERTON MASTERS ARCHITECTURE PTY LTD (ACN 109 225 149) T/A BICKERTON MASTERS AND BM HEDE PTY LTD (ACN 630 149 998) T/A HEDE ARCHITECTS AND MUST NOT BE USED, RETAINED OR COPIED WITHOUT THE WRITTEN PERMISSION OF THE AFOREMENTIONED LEGAL ENTITIES. BICKERTON MASTERS AND HEDE ARCHITECTS ACCEPT NO RESPONSIBILITY FOR THE USABILITY, COMPLETENESS OR ACCURACY OF DATA TRANSFERRED ELECTRONICALLY. RECIPIENTS SHOULD WHEN NECESSARY REQUEST A HARD COPY VERSION FOR VERIFICATION. USE FIGURED DIMENSIONS IN PREFERENCE TO SCALE. ALL DIMENSIONS TO BE VERIFIED ON SITE.

NSW NOMINATED ARCHITECT: ANDREW MASTERS NSW ARB No. 9037

Autodesk Docs://Greenwich Hospital Redevelopment/AR-HST-V-GREENWICH.rvt

P29	30/09/2025	ISSUED FOR PLANNING MODIFICATIONS	CM
P28	07.04.2025	ISSUE FOR PLANNING MODIFICATION	ZB
P27	27.06.2023	RESPONSE TO SUBMISSIONS	NAH
P26	21.12.2022	RESPONSE TO SUBMISSIONS	AMac
REV	DATE	DETAILS	INITIALS

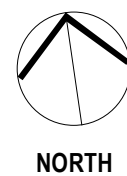

LEGEND - PLAN

SYMBOL	DESCRIPTION	SYMBOL	DESCRIPTION
	Room Name		Property Boundary
	Room Number		Movement Joint. Refer to Structural Drawings
	Detail Number of Section / Elevation		
	Sheet Number of Section / Elevation		

SYDNEY
(02) 9261 8333
SUITE 103
110 PACIFIC HIGHWAY
NORTH SYDNEY 2060, NSW
www.bickertonmasters.com.au



CLIENT:
HammondCare
Champion Life
PROJECT: 01605
GREENWICH HOSPITAL
REDEVELOPMENT
RIVER RD, GREENWICH

REVISION: DRAWING No:
P29 DD-HST-0104
DATE: 08/04/22
DRAWING TITLE:
H&C - OVERALL PLAN - L5

DRAWN: NAH CHECKED: SCALE: 1 : 200 @A1

NSW NOMINATED ARCHITECT: ANDREW MASTERS (9037)

30/09/2025 12:11:49 PM



0m 4m 8m 12m 16m 20m


1 : 200 @ A1 THIS DRAWING IS IN COLOUR. IF YOU DO NOT HAVE A COLOURED VERSION YOU DO NOT HAVE ALL THE REQUIRED INFORMATION. THIS NOTE IS IN RED.

© COPYRIGHT THESE DRAWINGS AND DESIGNS AND THE COPYRIGHT THEREOF ARE THE PROPERTY OF BICKERTON MASTERS ARCHITECTURE PTY LTD (ACN 109 225 149) T/A BICKERTON MASTERS AND BM HEDE PTY LTD (ACN 630 149 998) T/A HEDE ARCHITECTS AND MUST NOT BE USED, RETAINED OR COPIED WITHOUT THE WRITTEN PERMISSION OF THE AFOREMENTIONED LEGAL ENTITIES. BICKERTON MASTERS AND HEDE ARCHITECTS ACCEPT NO RESPONSIBILITY FOR THE USABILITY, COMPLETENESS OR ACCURACY OF DATA TRANSFERRED ELECTRONICALLY. RECIPIENTS SHOULD WHEN NECESSARY REQUEST A HARD COPY VERSION FOR VERIFICATION. USE FIGURED DIMENSIONS IN PREFERENCE TO SCALE. ALL DIMENSIONS TO BE VERIFIED ON SITE.

NSW NOMINATED ARCHITECT: ANDREW MASTERS NSW ARB No. 9037

Autodesk Docs://Greenwich Hospital Redevelopment/AR-HST-V-GREENWICH.rvt

P28	30/09/2025	ISSUED FOR PLANNING MODIFICATIONS	CM
P27	07.04.2025	ISSUE FOR PLANNING MODIFICATION	ZB
P26	27.06.2023	RESPONSE TO SUBMISSIONS	NAH
P25	21.12.2022	RESPONSE TO SUBMISSIONS	AMac
REV	DATE	DETAILS	INITIALS

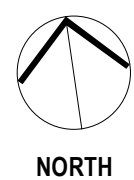

LEGEND - PLAN

SYMBOL	DESCRIPTION	SYMBOL	DESCRIPTION
ROOM NAME	Room Name	Property Boundary	Property Boundary
000	Room Number	Movement Joint, Refer to Structural Drawings	Movement Joint, Refer to Structural Drawings
000	Detail Number of Section / Elevation		
000	Sheet Number of Section / Elevation		

SYDNEY
(02) 9261 8333
SUITE 103
110 PACIFIC HIGHWAY
NORTH SYDNEY 2060, NSW
www.bickertonmasters.com.au



CLIENT:
HammondCare
Champion Life
PROJECT: 01605
GREENWICH HOSPITAL
REDEVELOPMENT
RIVER RD, GREENWICH

REVISION: DRAWING No:
P28 DD-HST-0105
DATE: 08/04/22
DRAWING TITLE:
H&C - OVERALL PLAN - L6
DRAWN: NAH CHECKED: SCALE: 1 : 200 @ A1

APPROVAL ISSUE
NOT FOR CONSTRUCTION

NSW NOMINATED ARCHITECT: ANDREW MASTERS (9037)

30/09/2025 12:11:55 PM




0m 4m 8m 12m 16m 20m

1 : 200 @ A1 THIS DRAWING IS IN COLOUR. IF YOU DO NOT HAVE A COLOURED VERSION YOU DO NOT HAVE ALL THE REQUIRED INFORMATION. THIS NOTE IS IN RED.

© COPYRIGHT THESE DRAWINGS AND DESIGNS AND THE COPYRIGHT THEREOF ARE THE PROPERTY OF BICKERTON MASTERS ARCHITECTURE PTY LTD (ACN 109 225 149) T/A BICKERTON MASTERS AND BM HEDE PTY LTD (ACN 630 149 998) T/A HEDE ARCHITECTS AND MUST NOT BE USED, RETAINED OR COPIED WITHOUT THE WRITTEN PERMISSION OF THE AFOREMENTIONED LEGAL ENTITIES. BICKERTON MASTERS AND HEDE ARCHITECTS ACCEPT NO RESPONSIBILITY FOR THE USABILITY, COMPLETENESS OR ACCURACY OF DATA TRANSFERRED ELECTRONICALLY. RECIPIENTS SHOULD WHEN NECESSARY REQUEST A HARD COPY VERSION FOR VERIFICATION. USE FIGURED DIMENSIONS IN PREFERENCE TO SCALE. ALL DIMENSIONS TO BE VERIFIED ON SITE.

NSW NOMINATED ARCHITECT: ANDREW MASTERS NSW ARB No. 9037 Autodesk Docs://Greenwich Hospital Redevelopment/AR-HST-V-GREENWICH.rvt

P27	30/09/2025	ISSUED FOR PLANNING MODIFICATIONS	CM
P26	07.04.2025	MODIFICATION	ZB
P25	27.06.2023	RESPONSE TO SUBMISSIONS	NAH
P24	21.12.2022	RESPONSE TO SUBMISSIONS	AMac
REV	DATE	DETAILS	INITIALS

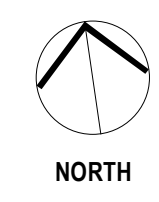

LEGEND - PLAN			
SYMBOL	DESCRIPTION	SYMBOL	DESCRIPTION
	ROOM NAME		Room Number
	Detail Number of Section / Elevation		Sheet Number of Section / Elevation

SYDNEY
(02) 9261 8333
SUITE 103
110 PACIFIC HIGHWAY
NORTH SYDNEY 2060, NSW
www.bickertonmasters.com.au



CLIENT:
HammondCare
Champion Life
PROJECT: 01605
GREENWICH HOSPITAL
REDEVELOPMENT
RIVER RD, GREENWICH

APPROVAL ISSUE
NOT FOR CONSTRUCTION

REVISION: DRAWING No:
P27 DD-HST-0106
DATE: 08/04/22
DRAWING TITLE:
H&C - OVERALL PLAN - L7

DRAWN: NAH CHECKED: SCALE: 1 : 200 @A1

NSW NOMINATED ARCHITECT: ANDREW MASTERS (9037) 30/09/2025 12:11:59 PM