


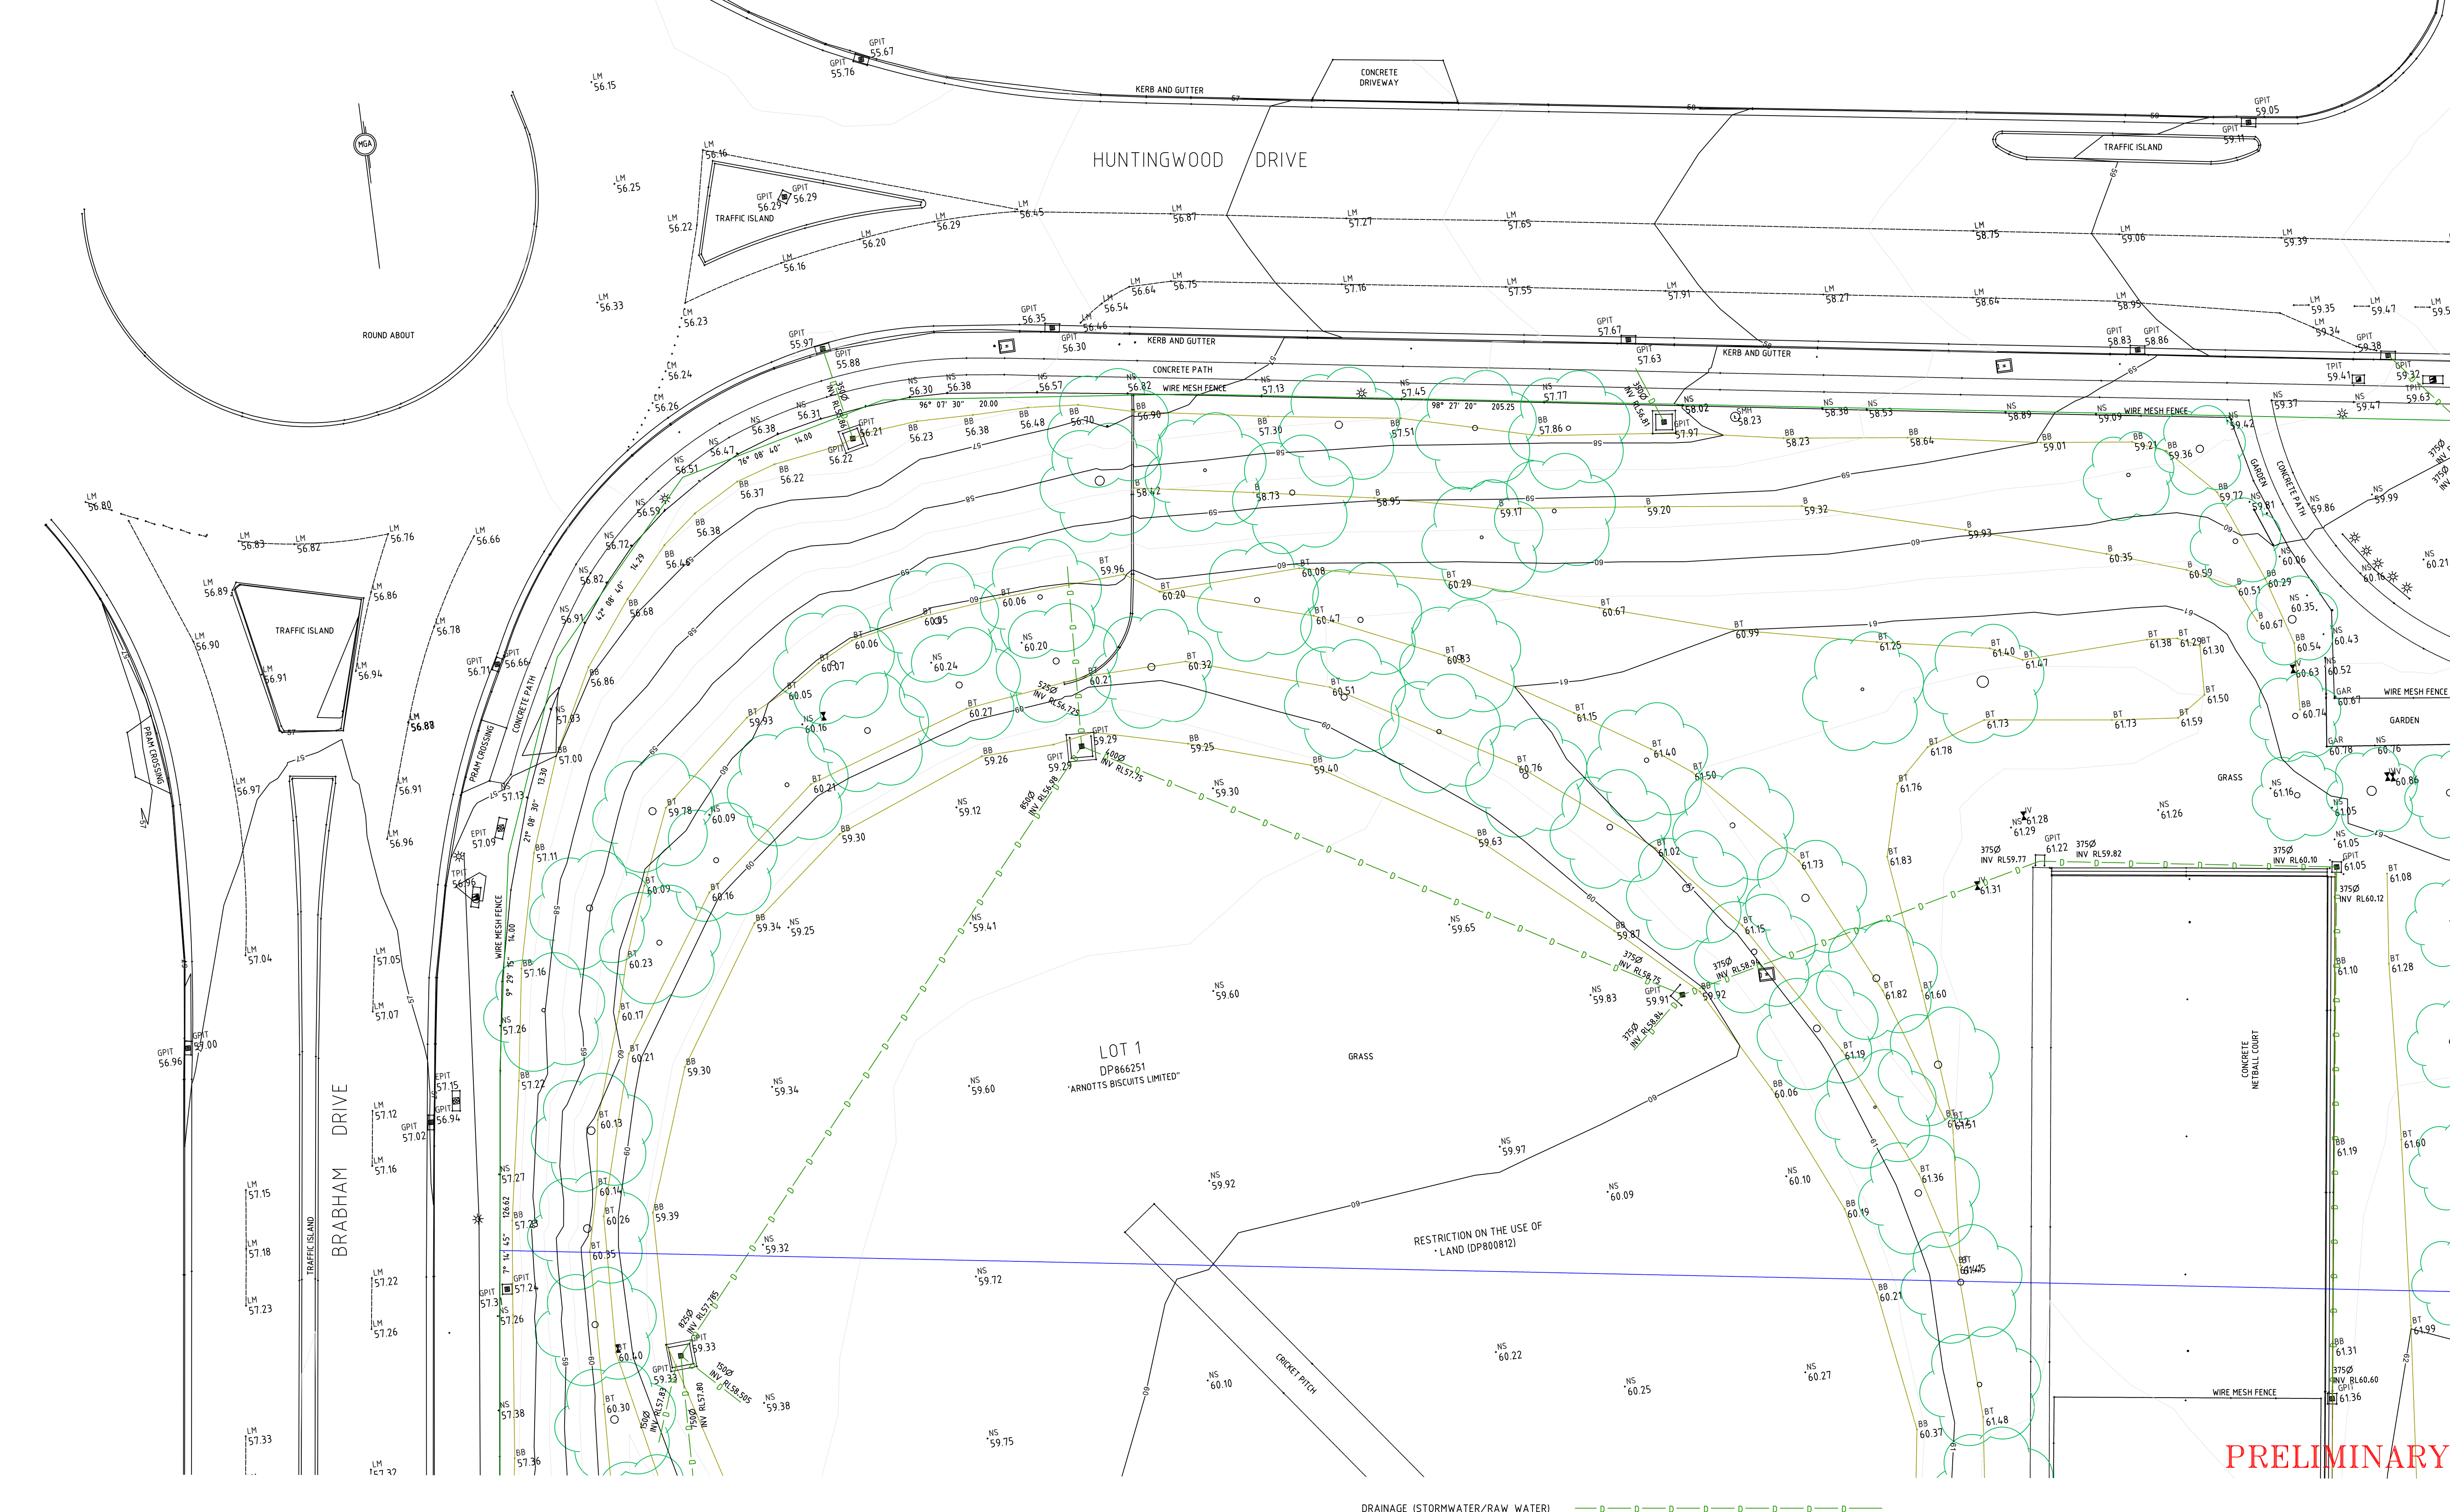

NOTES:

1. THIS DETAIL SURVEY IS NOT A "SURVEY" AS DEFINED BY THE SURVEYING AND SPATIAL INFORMATION ACT 2002. IF ANY CONSTRUCTION IS PLANNED IT WOULD BE ADVISABLE TO CARRY OUT FURTHER SURVEY WORK TO DETERMINE THE BOUNDARY DIMENSIONS AVAILABLE.
2. DIMENSIONS AND AREAS SHOWN ON THIS PLAN HAVE BEEN COMPILED FROM DEPOSITED PLANS REGISTERED AT THE DEPARTMENT OF LAND AND PROPERTY INFORMATION AND ARE SUBJECT TO FINAL SURVEY.
3. THE MGA NORTH POINT SHOWN ON THIS PLAN HAS BEEN ADOPTED FROM DEPOSITED PLANS REGISTERED AT THE DEPARTMENT OF LAND AND PROPERTY INFORMATION. IF ACCURATE TRUE NORTH IS REQUIRED ADDITIONAL SURVEY WILL NEED TO BE UNDERTAKEN.
4. THE RELATIONSHIP OF IMPROVEMENTS TO BOUNDARIES ARE DIAGRAMMATIC ONLY, WHERE DISTANCES TO BOUNDARIES ARE CRITICAL THEY SHOULD BE CONFIRMED ON SITE PRIOR TO CONSTRUCTION BY FURTHER SURVEY.

5. THE SPREAD OF TREES SHOWN HEREON ARE DIAGRAMMATIC ONLY AND MAY NOT BE SYMMETRICAL. THE DIAMETER, HEIGHT AND SPREAD OF THE CANOPY OF THE TREES ARE BY ESTIMATION ONLY.
6. THE EXISTENCE AND POSITION OF UNDERGROUND SERVICES HAS NOT BEEN INVESTIGATED BY ICD ASIA PACIFIC PTY LTD. NUMEROUS SERVICES INCLUDING OPTIC FIBRE CABLE MAY EXIST IN THE AREA AND NOT ALL SERVICES HAVE BEEN SHOWN IN OUR PLAN. UNDERGROUND SERVICES LOCATIONS SHOWN HEREON HAVE BEEN OBTAINED FROM AS BUILT DRAWING SUPPLIED BY DIAL BEFORE YOU DIG. IT IS PASSED ON WITH THE UNDERSTANDING THAT NO EXCAVATION OR WORKS WILL BE COMMENCED WITHOUT A CURRENT SERVICES SEARCH OF ALL SERVICES BEING OBTAINED FROM "Dial Before You Dig" SERVICE (DBYD) (Phone 100 Fax 1300 652 077) OR FROM ANY INDIVIDUAL SERVICE PROVIDER. NOTE THAT NOT ALL SERVICES PROVIDERS ARE MEMBERS OF DBYD.
7. IF POSITION AND DEPTH OF A SERVICE IS CRITICAL TO DESIGN OR CONSTRUCTION THE SERVICE MUST BE EXPOSED BY "POT HOLING" CARRIED OUT BY A PERSON ACCREDITED BY THE RELEVANT SERVICE PROVIDER.

8. THESE WARNINGS ARE FOR THE PROTECTION OF ALL PARTIES INVOLVED IN THE DEVELOPMENT BY MINIMISING THE CHANCES THAT EXISTING SERVICES ARE DAMAGED.
9. AUSTRALIAN HEIGHT DATUM WAS ESTABLISHED FROM SSM42986 R.L. 64.30 DATED 22ND SEPTEMBER 2020 SUPPLIED BY SCIMS.
10. A SCALE FACTOR OF 1000 HAS BEEN USED FOR COORDINATE CALCULATIONS.
10. THESE NOTES FORM AN INTEGRAL PART OF THIS PLAN.

B	14/10/2020	detail added	BA						
A	8/10/2020	ORIGINAL ISSUE	BA	PH					
REV	DATE	DESCRIPTION	DRAWN	CHECKED	ENGINEER	RELEASED			




ICD Asia Pacific Pty Ltd
L2, 21 Solent Circuit,
Norwest Business Park,
Baulkham Hills, NSW 2153
Phone No: (02) 8882-2700
Fax No: (02) 8882-2799
www.icdasiapacific.com.au

CLIENT: FDC CONSTRUCTIONS
TITLE: DETAIL SURVEY
65 HUNTINGWOOD DRIVE
HUNTINGWOOD
LOT 1 DP866251

ICD JOB No. 10848
ICD Drg. No. 10848_DET_1_B
DATE SURVEY: 8/10/2020
SCALE: 1:200
A1
REV: B

SHEET 2 OF 8

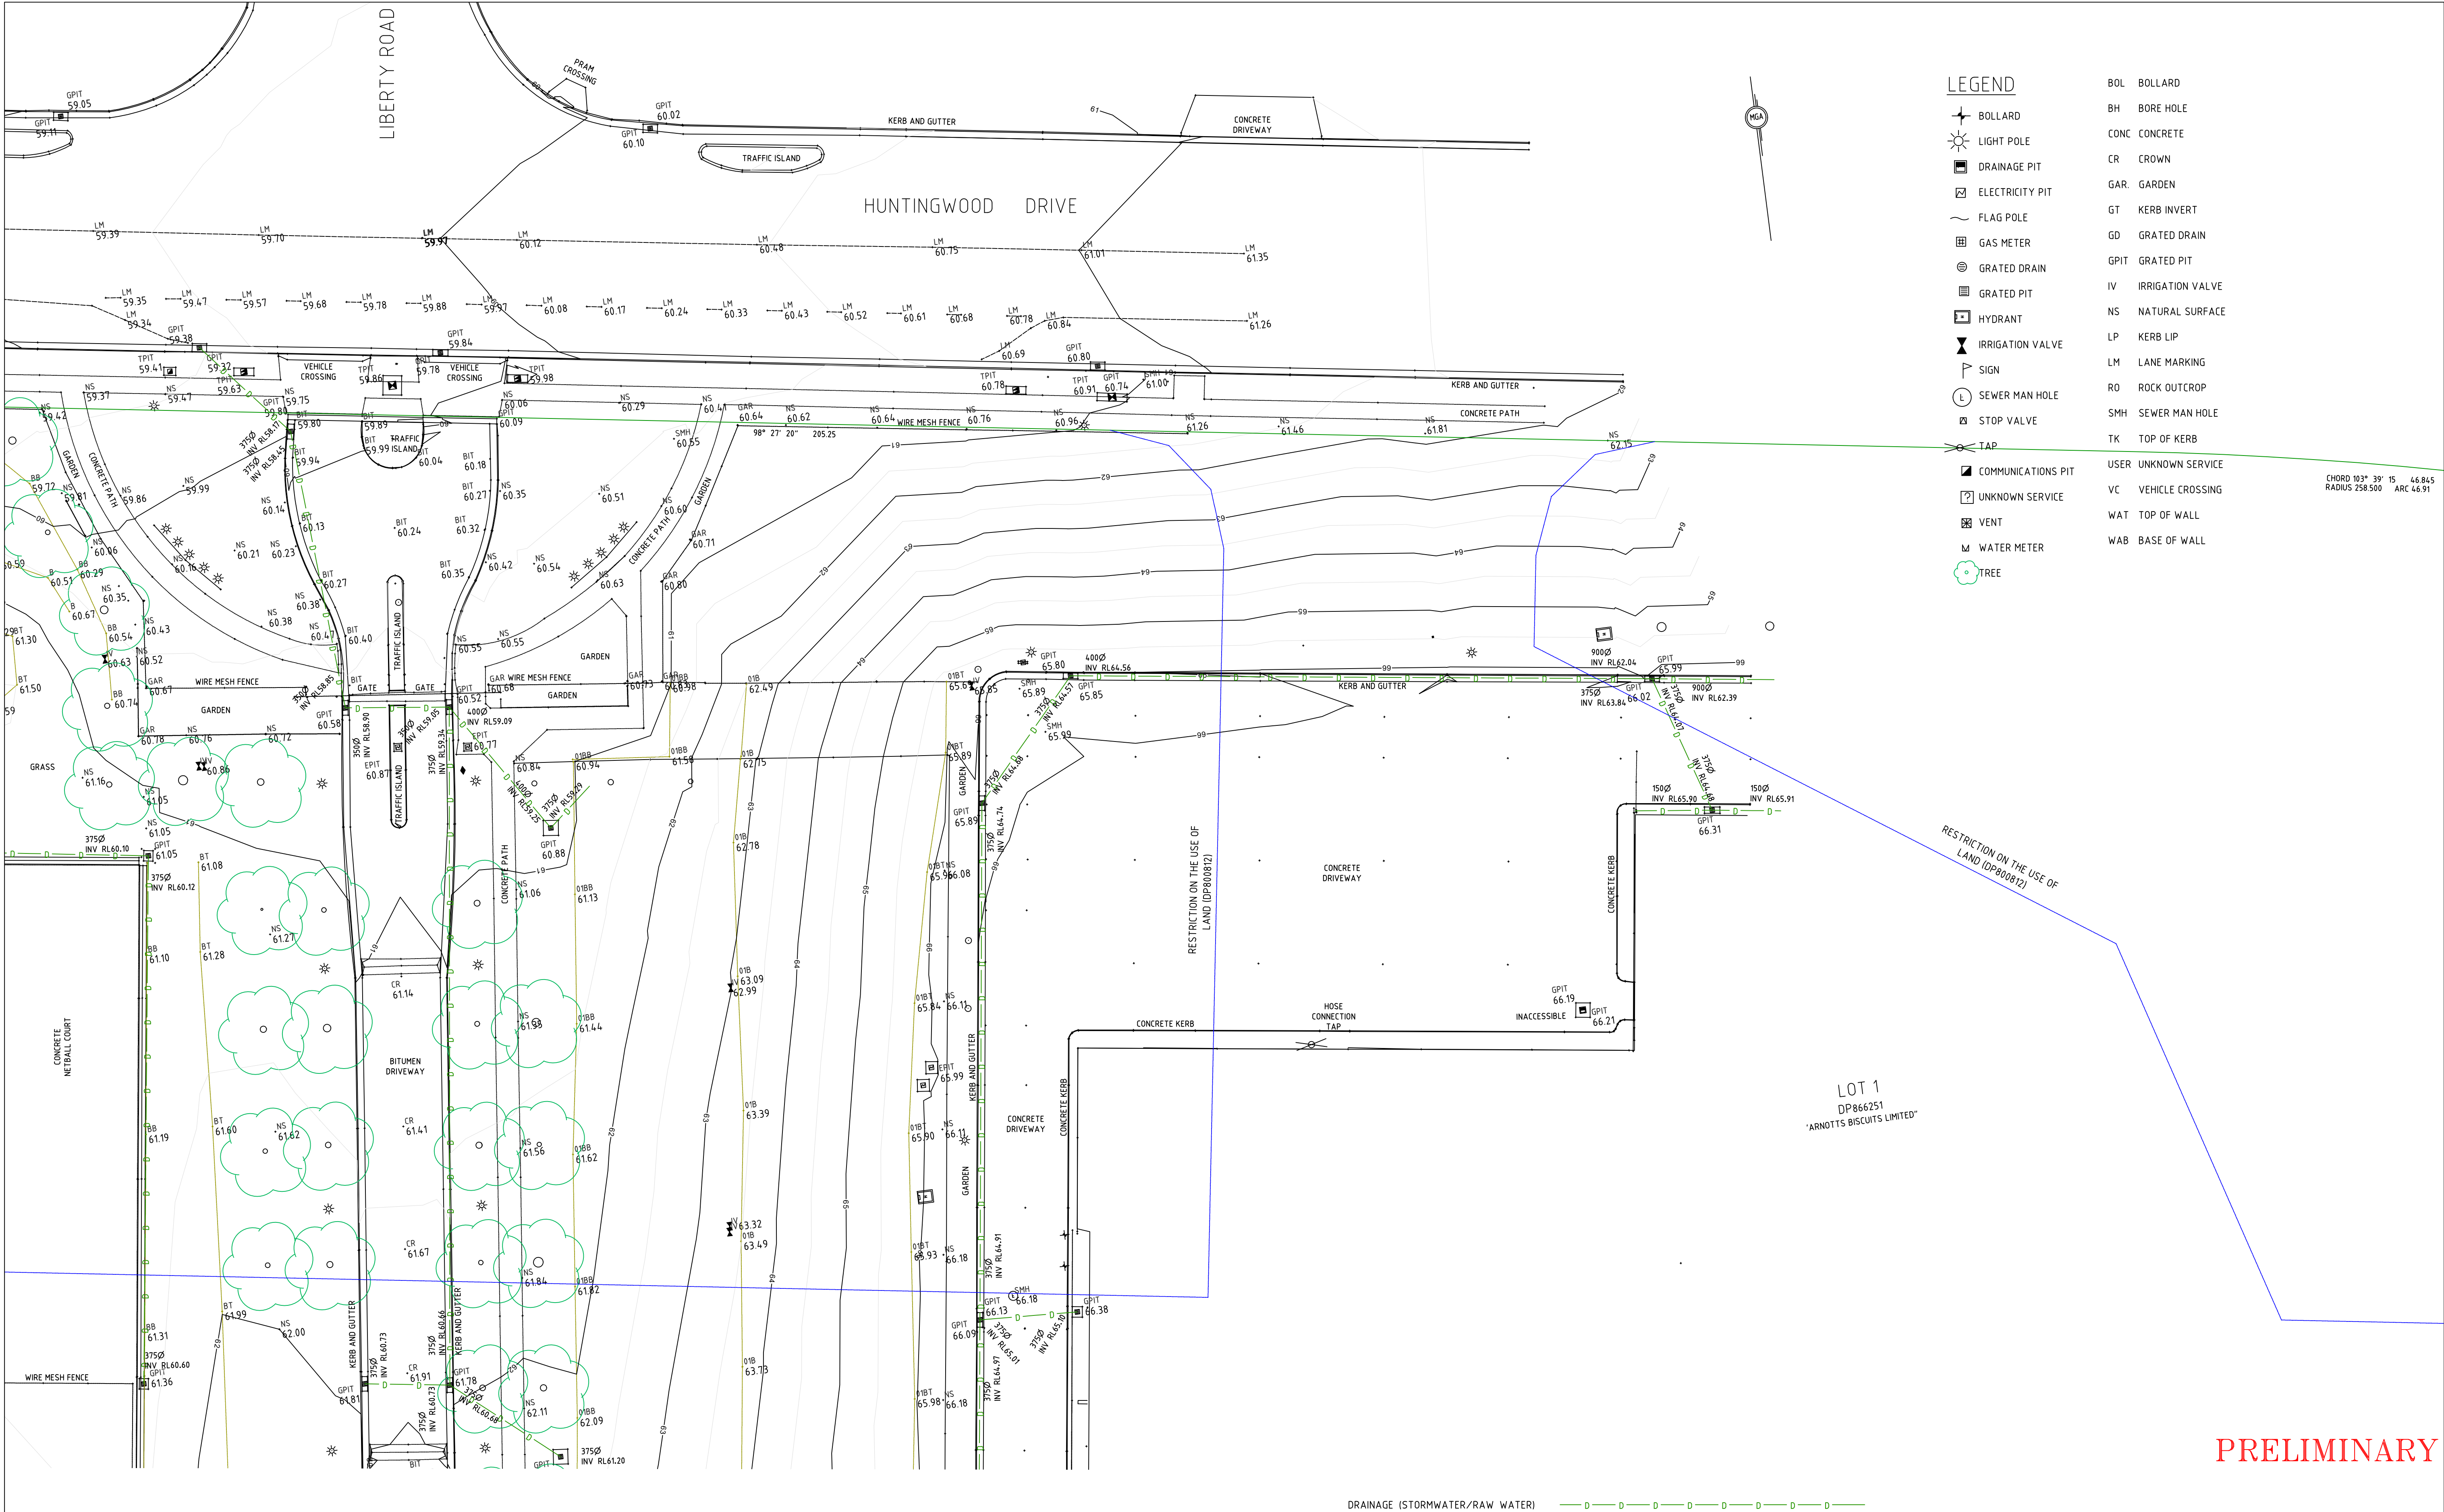

LEGEND

- BOLLARD
- LIGHT POLE
- DRAINAGE PIT
- ELECTRICITY PIT
- FLAG POLE
- GAS METER
- GRATED DRAIN
- GRATED PIT
- HYDRANT
- IRRIGATION VALVE
- SIGN
- SEWER MAN HOLE
- STOP VALVE
- TAP
- COMMUNICATIONS PIT
- UNKNOWN SERVICE
- VENT
- WATER METER
- TREE

BOL

BOLLARD

BH

BORE HOLE

CONC

CONCRETE

CR

CROWN

GAR.

GARDEN

GT

KERB INVERT

GD

GRATED DRAIN

GPIT

GRATED PIT

IV

IRRIGATION VALVE

NS

NATURAL SURFACE

LP

KERB LIP

LM

LANE MARKING

RO

ROCK OUTCROP

SMH

SEWER MAN HOLE

TK

TOP OF KERB

USER

UNKNOWN SERVICE

VC

VEHICLE CROSSING

WAT

TOP OF WALL

WAB

BASE OF WALL

CHORD 103° 39' 15" 46.845
RADIUS 258.500 ARC 46.91

LOT 1
DP866251
"ARNOTT'S BISCUITS LIMITED"

PRELIMINARY

NOTES:

1. THIS DETAIL SURVEY IS NOT A "SURVEY" AS DEFINED BY THE SURVEYING AND SPATIAL INFORMATION ACT 2002. IF ANY CONSTRUCTION IS PLANNED IT WOULD BE ADVISABLE TO CARRY OUT FURTHER SURVEY WORK TO DETERMINE THE BOUNDARY DIMENSIONS AVAILABLE.

2. DIMENSIONS AND AREAS SHOWN ON THIS PLAN HAVE BEEN COMPILED FROM DEPOSITED PLANS REGISTERED AT THE DEPARTMENT OF LAND AND PROPERTY INFORMATION AND ARE SUBJECT TO FINAL SURVEY.

3. THE MGA NORTH POINT SHOWN ON THIS PLAN HAS BEEN ADOPTED FROM DEPOSITED PLANS REGISTERED AT THE DEPARTMENT OF LAND AND PROPERTY INFORMATION IF ACCURATE TRUE NORTH IS REQUIRED ADDITIONAL SURVEY WILL NEED TO BE UNDERTAKEN.

4. THE RELATIONSHIP OF IMPROVEMENTS TO BOUNDARIES ARE DIAGRAMMATIC ONLY, WHERE DISTANCES TO BOUNDARIES ARE CRITICAL THEY SHOULD BE CONFIRMED ON SITE PRIOR TO CONSTRUCTION BY FURTHER SURVEY.
5. THE SPREAD OF TREES SHOWN HEREON ARE DIAGRAMMATIC ONLY AND MAY NOT BE SYMMETRICAL. THE DIAMETER, HEIGHT AND SPREAD OF THE CANOPY OF THE TREES ARE BY ESTIMATION ONLY.

6. THE EXISTENCE AND POSITION OF UNDERGROUND SERVICES HAS NOT BEEN INVESTIGATED BY ICD ASIA PACIFIC PTY LTD. NUMEROUS SERVICES INCLUDING OPTIC FIBRE CABLE MAY EXIST IN THE AREA AND NOT ALL SERVICES HAVE BEEN SHOWN IN OUR PLAN. UNDERGROUND SERVICES LOCATIONS SHOWN HEREON HAVE BEEN OBTAINED FROM AS BUILT DRAWING SUPPLIED BY DETAIL BEFORE YOU DIG. IT IS PASSED ON WITH THE UNDERSTANDING THAT NO EXCAVATION OR WORKS WILL BE COMMENCED WITHOUT A CURRENT SERVICES SEARCH OF ALL SERVICES BEING OBTAINED FROM "Dig Before You Dig" SERVICE (DBYD) (Phone 100 Fax 1300 652 077) OR FROM ANY INDIVIDUAL SERVICE PROVIDER. NOTE THAT NOT ALL SERVICES PROVIDERS ARE MEMBERS OF DBYD.

7. IF POSITION AND DEPTH OF A SERVICE IS CRITICAL TO DESIGN OR CONSTRUCTION THE SERVICE MUST BE EXPOSED BY "POT HOLING" CARRIED OUT BY A PERSON ACCREDITED BY THE RELEVANT SERVICE PROVIDER.

8. THESE WARNINGS ARE FOR THE PROTECTION OF ALL PARTIES INVOLVED IN THE DEVELOPMENT BY MINIMISING THE CHANCES THAT EXISTING SERVICES ARE DAMAGED.

9. AUSTRALIAN HEIGHT DATUM WAS ESTABLISHED FROM SSM42986 R.L. 64.30 DATED 22ND SEPTEMBER 2020 SUPPLIED BY SCIMS.


10. A SCALE FACTOR OF 1000 HAS BEEN USED FOR COORDINATE CALCULATIONS.

10. THESE NOTES FORM AN INTEGRAL PART OF THIS PLAN.


DRAINAGE (STORMWATER/RAW WATER)

B	14/10/2020	Detail added	BA		
A	8/10/2020	ORIGINAL ISSUE	BA	PH	
REV	DATE	DESCRIPTION	DRAWN	CHECKED	ENGINEER
					RELEASED

		ICD Asia Pacific Pty Ltd	
L2, 21 Solent Circuit, Norwest Business Park, Baulkham Hills, NSW 2153		Phone No: (02) 8882-2700 Fax No: (02) 8882-2799 www.icdasiapacific.com.au	
CLIENT: FDC CONSTRUCTIONS		SHEET 3 OF 7	
TITLE: DETAIL SURVEY			
65 HUNTINGWOOD DRIVE			
HUNTINGWOOD			
LOT 1 DP866251			
ICD JOB No.	10848	ICD Drg. No.	10848_DET_1_B
DATE SURVEY:	8/10/2020	SCALE:	1:200
A1		REV:	B

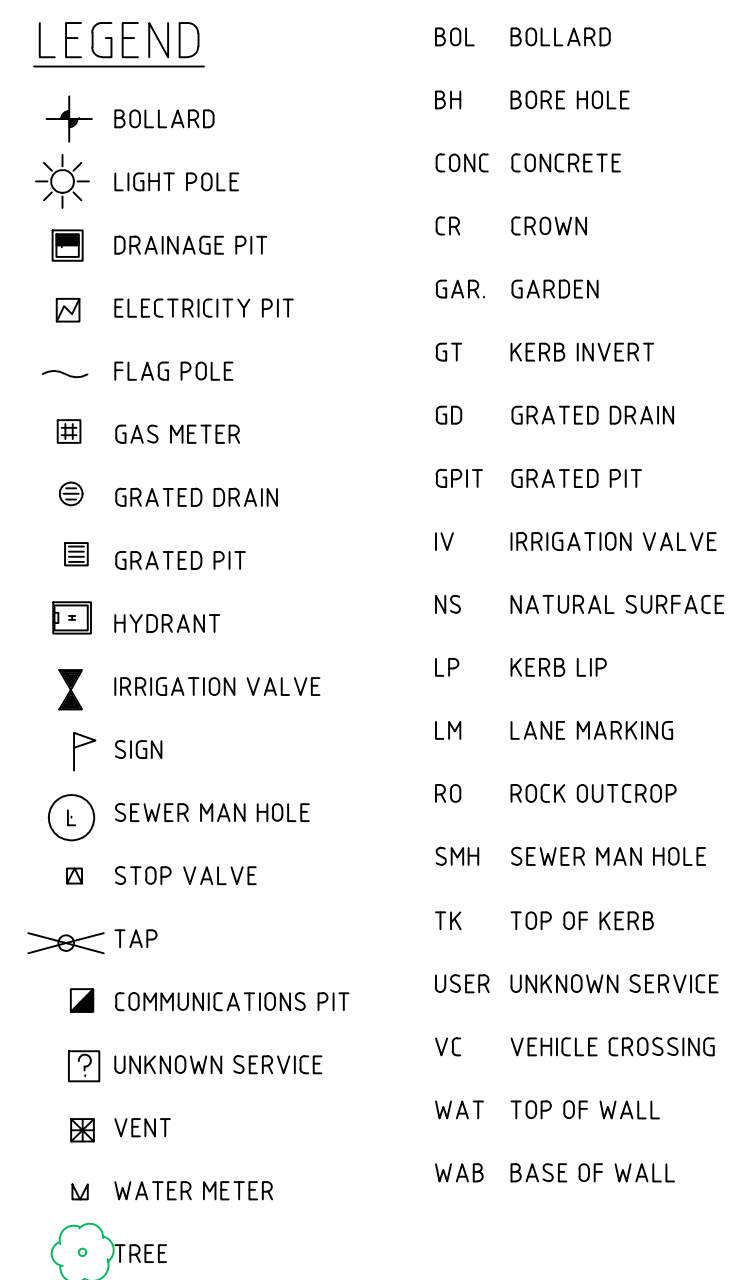

	ICD Asia Pacific Pty Ltd										
	L2, 21 Solent Circuit, Norwest Business Park, Baulkham Hills, NSW 2153		Phone No: (02) 8882-2700 Fax No: (02) 8882-2799 www.icdasiapacific.com.au								
	CLIENT: FDC CONSTRUCTIONS										
	SHEET 5 OF 8										
<table border="1" style="width: 100%; border-collapse: collapse;"> <tr> <td style="width: 10%; font-weight: bold;">TITLE:</td> <td> DETAIL SURVEY 65 HUNTINGWOOD DRIVE HUNTINGWOOD LOT 1 DP866251 </td> </tr> </table>				TITLE:	DETAIL SURVEY 65 HUNTINGWOOD DRIVE HUNTINGWOOD LOT 1 DP866251						
TITLE:	DETAIL SURVEY 65 HUNTINGWOOD DRIVE HUNTINGWOOD LOT 1 DP866251										
<table border="1" style="width: 100%; border-collapse: collapse;"> <tr> <td style="width: 30%;">ICD JOB No.</td> <td style="width: 20%;">10848</td> <td style="width: 30%;">ICD Drg. No.</td> <td style="width: 20%;">10848_DET_1_B</td> </tr> </table>				ICD JOB No.	10848	ICD Drg. No.	10848_DET_1_B				
ICD JOB No.	10848	ICD Drg. No.	10848_DET_1_B								
<table border="1" style="width: 100%; border-collapse: collapse;"> <tr> <td style="width: 30%;">DATE SURVEY:</td> <td style="width: 20%;">8/10/2020</td> <td style="width: 30%;">SCALE:</td> <td style="width: 20%;">1:200</td> </tr> <tr> <td colspan="2"></td> <td style="width: 30%;">A1</td> <td style="width: 20%;">REV: B</td> </tr> </table>				DATE SURVEY:	8/10/2020	SCALE:	1:200			A1	REV: B
DATE SURVEY:	8/10/2020	SCALE:	1:200								
		A1	REV: B								

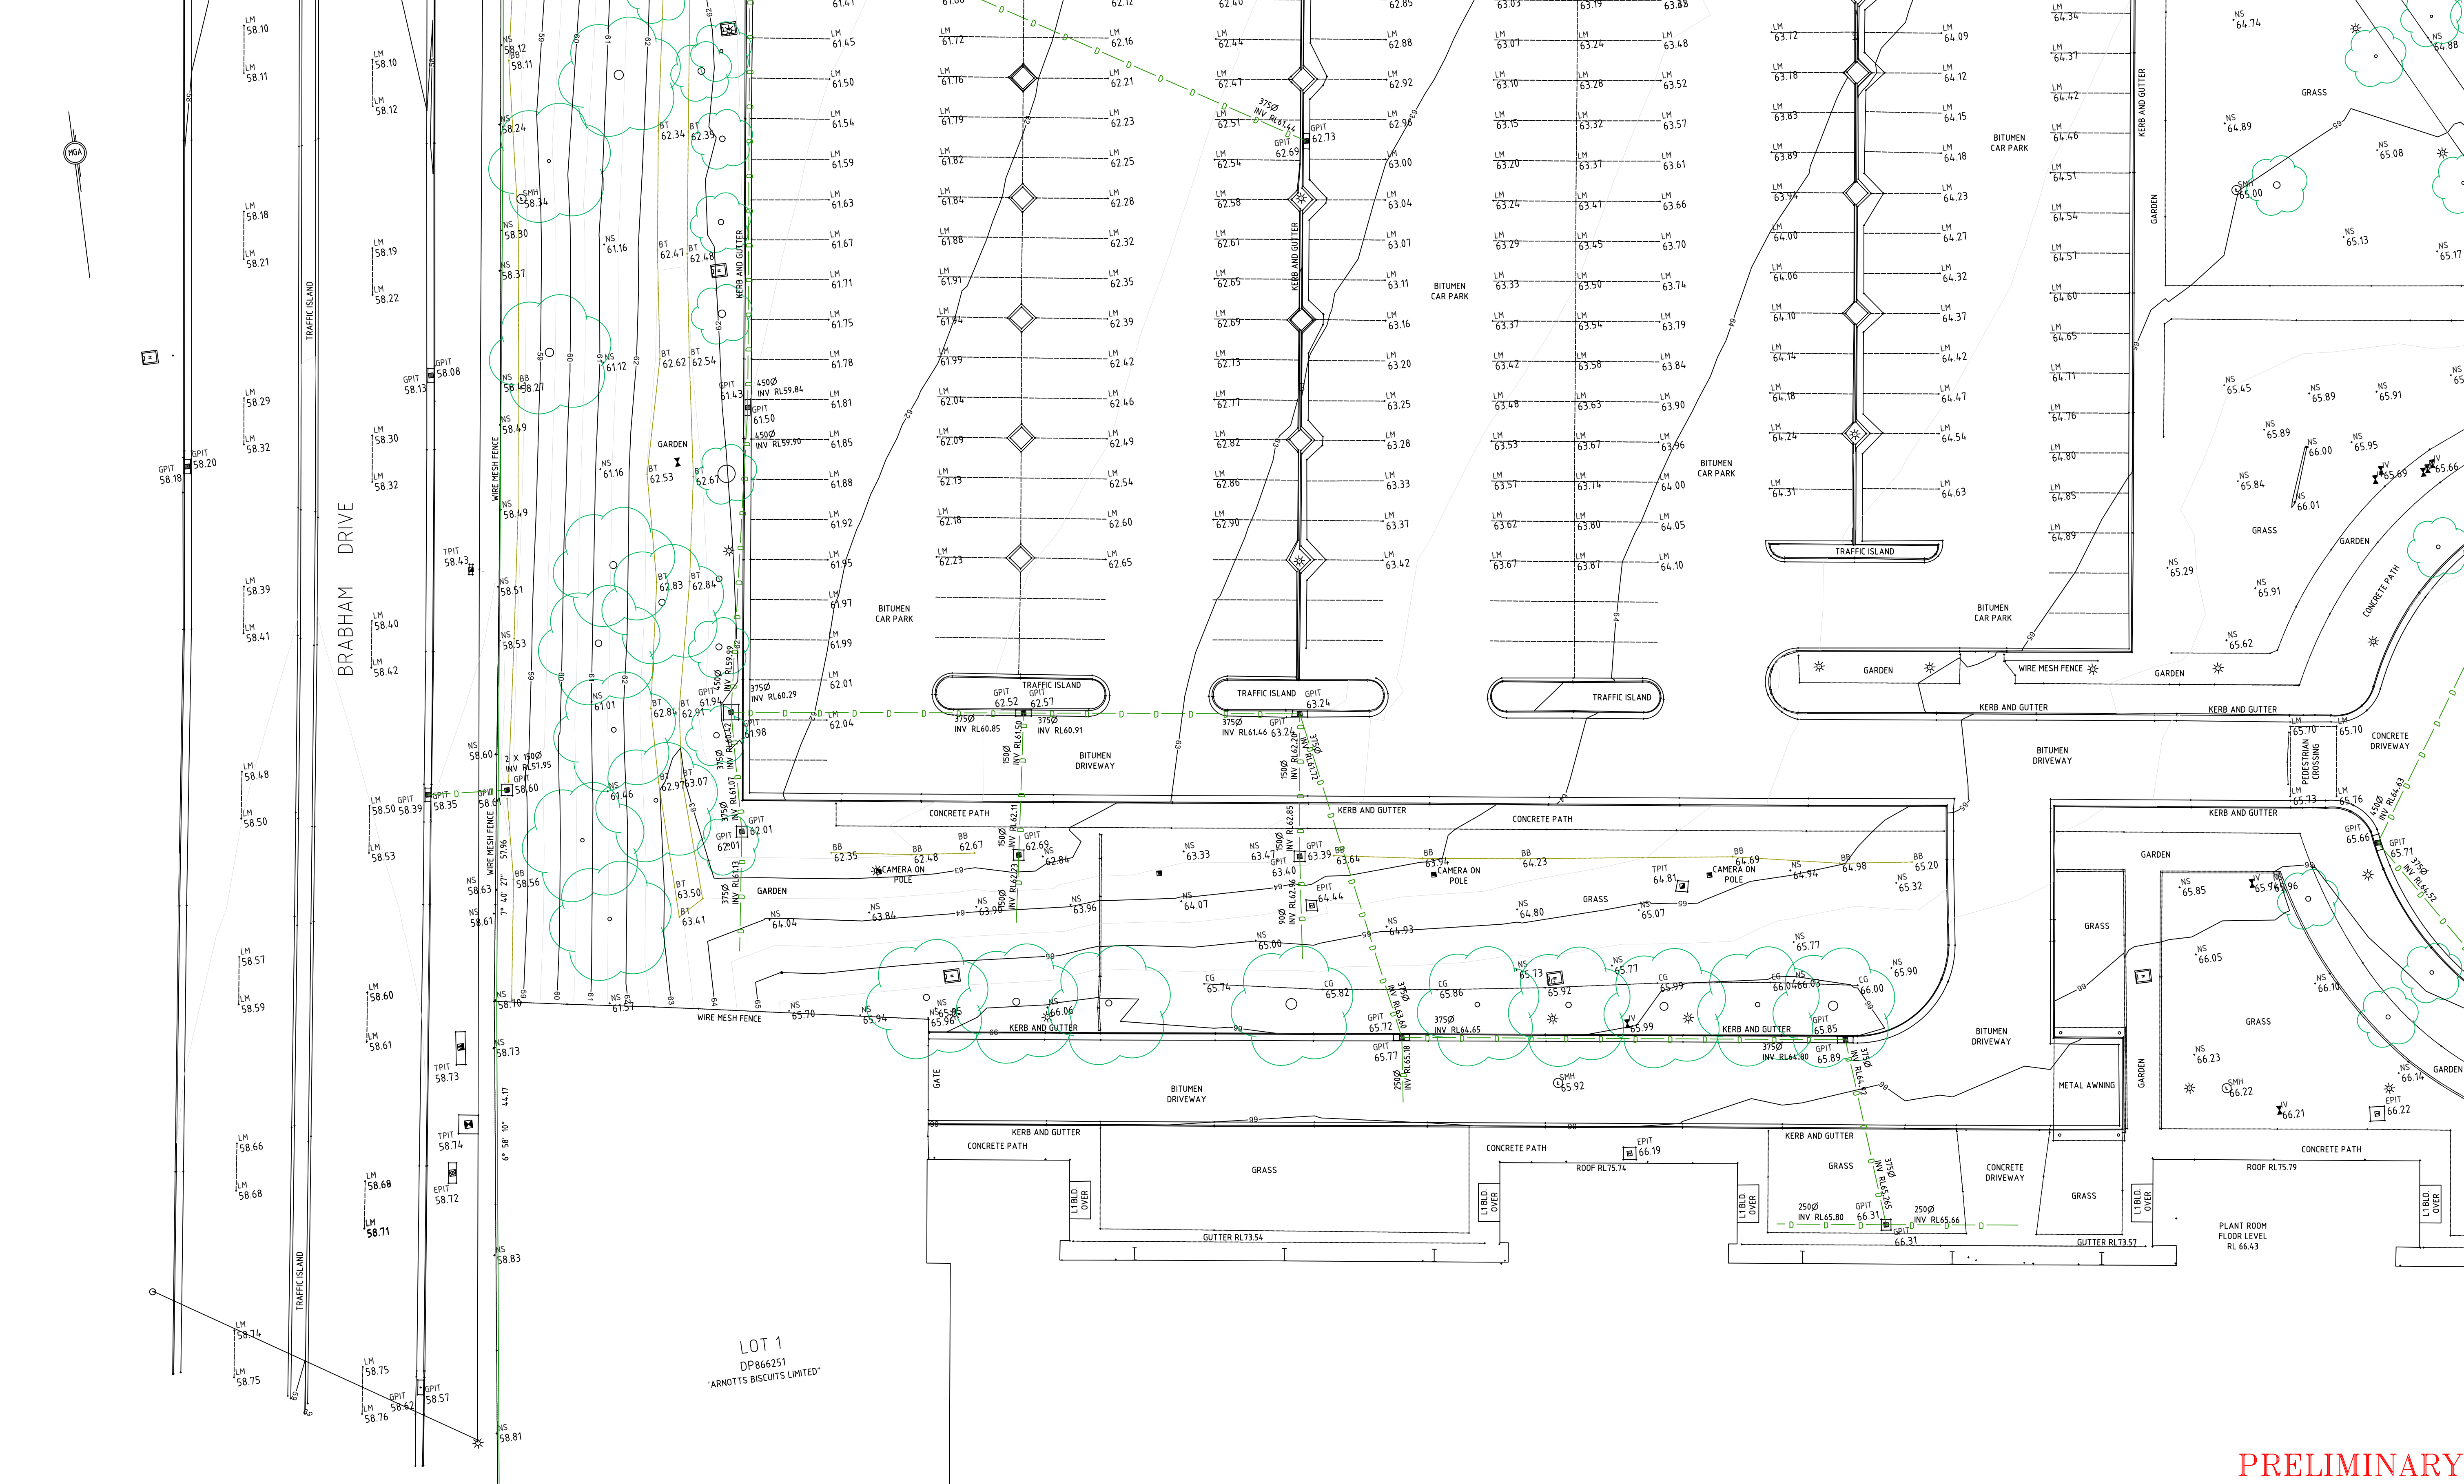

NOTES:

1. THIS DETAIL SURVEY IS NOT A "SURVEY" AS DEFINED BY THE SURVEYING AND SPATIAL INFORMATION ACT 2002. IF ANY CONSTRUCTION IS PLANNED IT WOULD BE ADVISABLE TO CARRY OUT FURTHER SURVEY WORK TO DETERMINE THE BOUNDARY DIMENSIONS AVAILABLE.

2. DIMENSIONS AND AREAS SHOWN ON THIS PLAN HAVE BEEN COMPILED FROM DEPOSITED PLANS REGISTERED AT THE DEPARTMENT OF LAND AND PROPERTY INFORMATION AND ARE SUBJECT TO FINAL SURVEY.

3. THE MGA NORTH POINT SHOWN ON THIS PLAN HAS BEEN ADOPTED FROM DEPOSITED PLANS REGISTERED AT THE DEPARTMENT OF LAND AND PROPERTY INFORMATION. IF ACCURATE TRUE NORTH IS REQUIRED ADDITIONAL SURVEY WILL NEED TO BE UNDERTAKEN.

4. THE RELATIONSHIP OF IMPROVEMENTS TO BOUNDARIES ARE DIAGRAMMATIC ONLY, WHERE DISTANCES TO BOUNDARIES ARE CRITICAL THEY SHOULD BE CONFIRMED ON SITE PRIOR TO CONSTRUCTION BY FURTHER SURVEY.
5. THE SPREAD OF TREES SHOWN HEREON ARE DIAGRAMMATIC ONLY AND MAY NOT BE SYMMETRICAL. THE DIAMETER, HEIGHT AND SPREAD OF THE CANOPY OF THE TREES ARE BY ESTIMATION ONLY.

6. THE EXISTENCE AND POSITION OF UNDERGROUND SERVICES HAS NOT BEEN INVESTIGATED BY ICD ASIA PACIFIC PTY LTD. NUMEROUS SERVICES INCLUDING OPTIC FIBRE CABLE MAY EXIST IN THE AREA AND NOT ALL SERVICES HAVE BEEN SHOWN IN OUR PLAN. UNDERGROUND SERVICES LOCATIONS SHOWN HEREON HAVE BEEN OBTAINED FROM AS BUILT DRAWING SUPPLIED BY DIAL BEFORE YOU DIG. IT IS PASSED ON WITH THE UNDERSTANDING THAT NO EXCAVATION OR WORKS WILL BE COMMENCED WITHOUT A CURRENT SERVICES SEARCH OF ALL SERVICES BEING OBTAINED FROM "Dial Before You Dig" SERVICE (DBYD) (Phone 100 Fax 1300 652 077) OR FROM ANY INDIVIDUAL SERVICE PROVIDER. NOTE THAT NOT ALL SERVICES PROVIDERS ARE MEMBERS OF DBYD.

7. IF POSITION AND DEPTH OF A SERVICE IS CRITICAL TO DESIGN OR CONSTRUCTION THE SERVICE MUST BE EXPOSED BY "POT HOLING" CARRIED OUT BY A PERSON ACCREDITED BY THE RELEVANT SERVICE PROVIDER.

8. THESE WARNINGS ARE FOR THE PROTECTION OF ALL PARTIES INVOLVED IN THE DEVELOPMENT BY MINIMISING THE CHANCES THAT EXISTING SERVICES ARE DAMAGED.

9. AUSTRALIAN HEIGHT DATUM WAS ESTABLISHED FROM SSM42986 R.L. 64.30 DATED 22ND SEPTEMBER 2020 SUPPLIED BY SCIMS.

10. A SCALE FACTOR OF 1000 HAS BEEN USED FOR COORDINATE CALCULATIONS.

10. THESE NOTES FORM AN INTEGRAL PART OF THIS PLAN.

DRAINAGE (STORMWATER/RAW WATER) ————

PRELIMINARY

B	14/10/2020	Additional detail added	BA		
A	8/10/2020	ORIGINAL ISSUE	BA	PH	
REV	DATE	DESCRIPTION	DRAWN	CHECKED	ENGINEER
			RELEASED		



ICD Asia Pacific Pty Ltd

L2, 21 Solent Circuit,
Norwest Business Park,
Baulkham Hills, NSW 2153

Phone No: (02) 8882-2700
Fax No: (02) 8882-2799
www.icdasiapacific.com.au

CLIENT: FDC CONSTRUCTIONS

SHEET 6 OF 8

TITLE: DETAIL SURVEY

65 HUNTINGWOOD DRIVE

HUNTINGWOOD

LOT 1 DP866251

ICD JOB No. 10848

ICD Drg. No. 10848_DET_1_B

DATE SURVEY: 8/10/2020

SCALE: 1:200

A1


REV: B

This drawing is the property of ICD Asia Pacific Pty Ltd and can not be used for any purpose, communicated to any person or reproduced in any form without the express permission in writing from ICD Asia Pacific Pty Ltd



LEGEND

- BOLLARD
- LIGHT POLE
- DRAINAGE PIT
- ELECTRICITY PIT
- FLAG POLE
- GAS METER
- GRATED DRAIN
- GRATED PIT
- HYDRANT
- IRRIGATION VALVE
- SIGN
- SEWER MAN HOLE
- STOP VALVE
- TAP
- COMMUNICATIONS PIT
- UNKNOWN SERVICE
- VENT
- WATER METER
- TREE

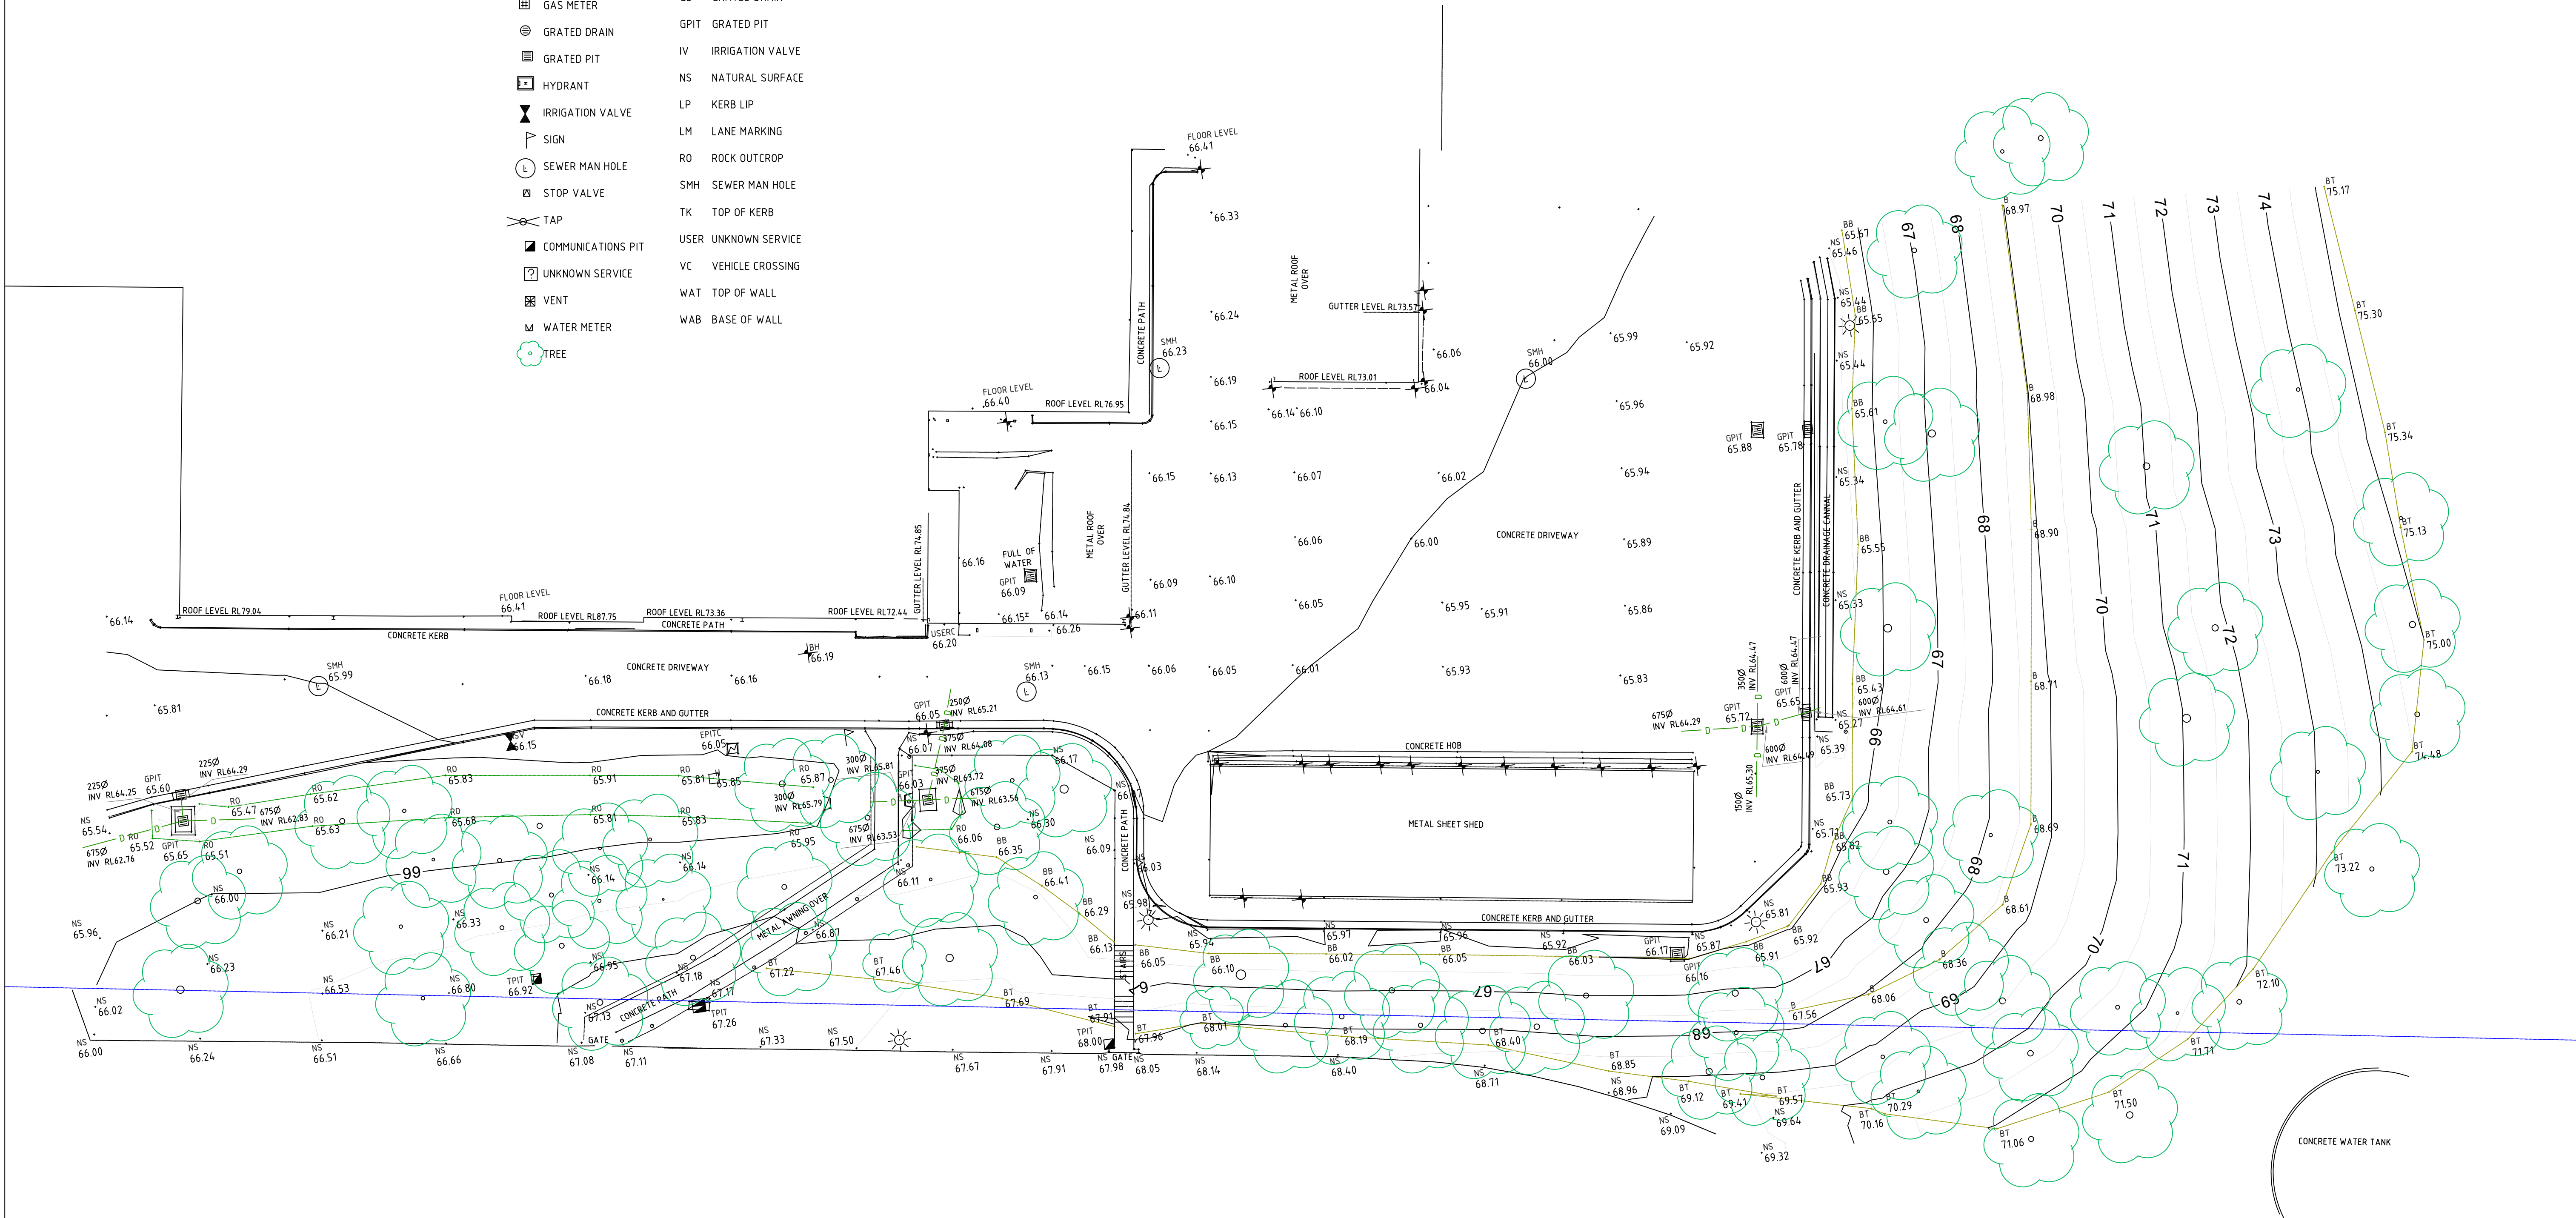BOL BOLLARDBH BORE HOLECONC CONCRETECR CROWNGAR GARDENGT KERB INVERTGD GRATED DRAINGPIT GRATED PITIV IRRIGATION VALVENS NATURAL SURFACELP KERB LIPLM LANE MARKINGRO ROCK OUTCROPSMH SEWER MAN HOLETK TOP OF KERBUSER UNKNOWN SERVICEVC VEHICLE CROSSINGWAT TOP OF WALLWAB BASE OF WALL

PRELIMINARY

NOTES:

1. THIS DETAIL SURVEY IS NOT A "SURVEY" AS DEFINED BY THE SURVEYING AND SPATIAL INFORMATION ACT 2002. IF ANY CONSTRUCTION IS PLANNED IT WOULD BE ADVISABLE TO CARRY OUT FURTHER SURVEY WORK TO DETERMINE THE BOUNDARY DIMENSIONS AVAILABLE.
2. DIMENSIONS AND AREAS SHOWN ON THIS PLAN HAVE BEEN COMPILED FROM DEPOSITED PLANS REGISTERED AT THE DEPARTMENT OF LAND AND PROPERTY INFORMATION AND ARE SUBJECT TO FINAL SURVEY.
3. THE MGA NORTH POINT SHOWN ON THIS PLAN HAS BEEN ADOPTED FROM DEPOSITED PLANS REGISTERED AT THE DEPARTMENT OF LAND AND PROPERTY INFORMATION. IF ACCURATE TRUE NORTH IS REQUIRED ADDITIONAL SURVEY WILL NEED TO BE UNDERTAKEN.
4. THE RELATIONSHIP OF IMPROVEMENTS TO BOUNDARIES ARE DIAGRAMMATIC ONLY, WHERE DISTANCES TO BOUNDARIES ARE CRITICAL THEY SHOULD BE CONFIRMED ON SITE PRIOR TO CONSTRUCTION BY FURTHER SURVEY.
5. THE SPREAD OF TREES SHOWN HEREON ARE DIAGRAMMATIC ONLY AND MAY NOT BE SYMMETRICAL. THE DIAMETER, HEIGHT AND SPREAD OF THE CANOPY OF THE TREES ARE BY ESTIMATION ONLY.
6. THE EXISTENCE AND POSITION OF UNDERGROUND SERVICES HAS NOT BEEN INVESTIGATED BY ICD ASIA PACIFIC PTY LTD. NUMEROUS SERVICES INCLUDING OPTIC FIBRE CABLE MAY EXIST IN THE AREA AND NOT ALL SERVICES HAVE BEEN SHOWN IN OUR PLAN. UNDERGROUND SERVICES LOCATIONS SHOWN HEREON HAVE BEEN OBTAINED FROM AS BUILT DRAWING SUPPLIED BY DIAL BEFORE YOU DIG. IT IS PASSED ON WITH THE UNDERSTANDING THAT NO EXCAVATION OR WORKS WILL BE COMMENCED WITHOUT A CURRENT SERVICES SEARCH OF ALL SERVICES BEING OBTAINED FROM "Dial Before You Dig" SERVICE (DBYD) (Phone 100 Fax 1300 652 077) OR FROM ANY INDIVIDUAL SERVICE PROVIDER. NOTE THAT NOT ALL SERVICES PROVIDERS ARE MEMBERS OF DBYD.
7. IF POSITION AND DEPTH OF A SERVICE IS CRITICAL TO DESIGN OR CONSTRUCTION THE SERVICE MUST BE EXPOSED BY "POT HOLING" CARRIED OUT BY A PERSON ACCREDITED BY THE RELEVANT SERVICE PROVIDER.

8. THESE WARNINGS ARE FOR THE PROTECTION OF ALL PARTIES INVOLVED IN THE DEVELOPMENT BY MINIMISING THE CHANCES THAT EXISTING SERVICES ARE DAMAGED.
9. AUSTRALIAN HEIGHT DATUM WAS ESTABLISHED FROM SSM42986 R.L. 64.30 DATED 22ND SEPTEMBER 2020 SUPPLIED BY SCIMS.
10. A SCALE FACTOR OF 1000 HAS BEEN USED FOR COORDINATE CALCULATIONS.
10. THESE NOTES FORM AN INTEGRAL PART OF THIS PLAN.

DRAINAGE (STORMWATER/RAW WATER)

B	14/10/2020	Additional detail added	BA		
A	8/10/2020	ORIGINAL ISSUE	BA	PH	
REV	DATE	DESCRIPTION	DRAWN	CHECKED	ENGINEER
					RELEASED

ICD Asia Pacific Pty Ltd

L2, 21 Solent Circuit,
Norwest Business Park,
Baulkham Hills, NSW 2153

Phone No: (02) 8882-2700
Fax No: (02) 8882-2799
www.icdasiapacific.com.au

CLIENT: FDC CONSTRUCTIONS

SHEET 8 OF 8

TITLE: DETAIL SURVEY

65 HUNTINGWOOD DRIVE

HUNTINGWOOD

LOT 1 DP866251

ICD JOB No. 10848

ICD Drg. No. 10848_DET_1_B

DATE SURVEY: 8/10/2020

SCALE: 1:200

A1

REV: B