



ABN 48 612 666 172

Sydney | Brisbane | Melbourne

Level 20, 2 Market St
Sydney NSW 2000

PO Box Q453
Queen Victoria Building
NSW 1230

Ph (02) 9437 1000

23 February 2026

TSA

Level 4, 25 Wyatt Street

Newcastle NSW 2300

Attention: E. Lind

Dear Emma,

**RE: National Construction Code (NCC) 2022 Volume One Section J
Part J4 Statement of Compliance**

**JOB NO.: 210296
REVISION NO.: [D]**

SUBJECT PREMISE: UNITING CHARLESTOWN | 27 TIRAL STREET, CHARLESTOWN NSW 2290

This NCC Section J Part J4 statement has been prepared to demonstrate design compliance for the new development of **Uniting Charlestown** located at **27 Tiral Street, Charlestown NSW 2290**.

The proposed development is located in climate **Zone 5** as defined by the NCC 2022 Building Code of Australia – Volume One.

In accordance with A2G1, compliance with the NCC is achieved by complying with the Governing Requirements of the NCC and the Performance Requirements. The Performance Requirements are satisfied by Performance Solution, Deemed-to-Satisfy Solution or a combination of both.

The table below shows the areas assessed, NCC 2022 Building Classification the Performance Requirements, the Method of Compliance, and the DTS Provisions subjected to Performance Solution.

Building Area Description	NCC Classification	Performance Requirements	Method of Compliance
Clubhouse	9b	J1P1	DTS

Compliance with Performance Requirement J1P1 will be achieved subject to this report and compliance with J4D3 (1-5), J3, J5, J6, J7, J8 & J9 being met by the relevant designers / contractors.

The assessment is based on the architectural drawings listed below.

Architectural Drawings Plus Architecture Pty. Ltd.
Project no. 20456
Issued 22/12/2025

Building	Drawing Title	Drawing No	Revision
Building B – Clubhouse	BUILDING B - LEVEL 01 FLOOR PLAN	PLA-AR-B-1001	14
	BUILDING B - ELEVATIONS SHEET 01	PLA-AR-B-2001	13
	BUILDING B - ELEVATIONS SHEET 02	PLA-AR-B-2002	13
	BUILDING B - ELEVATIONS SHEET 03	PLA-AR-B-2003	13
	BUILDING B - ELEVATIONS SHEET 04	PLA-AR-B-2004	13
	BUILDING B - ELEVATIONS SHEET 05	PLA-AR-B-2005	13
	BUILDING B - ELEVATIONS SHEET 06	PLA-AR-B-2006	13
	BUILDING B - SECTIONS SHEET 01	PLA-AR-B-2501	08
	BUILDING B - SECTIONS SHEET 02	PLA-AR-B-2502	08
	BUILDING B - SECTIONS SHEET 03	PLA-AR-B-2503	08
	BUILDING B - SECTIONS SHEET 04	PLA-AR-B-2504	08
	BUILDING B - SECTIONS SHEET 05	PLA-AR-B-2505	08

As per the Deemed-to-Satisfy Provisions of **NCC 2022 Volume One**, design compliance with Part J4 can be met subject to the following specifications:

Part J4 Building Fabric

Required **Total R-value** including allowance for **thermal bridging**.

Elements	Total Construction R-value	Notes
Roofs & Ceilings	R3.7 (Downwards, SA < 0.45)	<ol style="list-style-type: none"> It is a total system performance value and NOT the insulation. The impact of Thermal Bridging must be included in the building envelope total system R-value calculations. As per J4D7 a slab-on-ground that does not have an in-slab heating or cooling system is considered to achieve a Total R-Value of R2.0.
External Walls	R1.4	
Internal Walls	R1.4	
Floors (suspended)	R2.0	
Floors (slab on ground)	R2.0 ^{Note 3}	

Required **Total System U-value** and **SHGC**.

Location/Type	Window Assembly (Glass & Frame)		Description
	U-value	SHGC	
Clubhouse	6.5	0.31	Single Glazed Tinted or the like

Please refer to Attachment A for the facade calculator demonstrating compliance, and Attachment B for the mark-ups of the building fabrics thermal construction requirements.

Additional Section J Compliance Notes

Note project needs to adhere to the following NCC 2022 Section J construction requirements as applicable:

- *J4D3 (1-4) Thermal Construction – general* installation requirements for insulations
- *J4D3 (5)* The required total R-value and total system U-value, including thermal bridging calculation.

JHA recommend the following general construction requirements from Section J of the NCC 2022 be included in the architectural specification and drawings to ensure compliance.

- *Part J5 – Building Sealing*
 - *J5D3 Chimneys and flues*
 - *J5D4 Roof lights*
 - *J5D5 Windows and doors*
 - *J5D6 Exhaust fans*
 - *J5D7 Construction of ceilings, walls and floors*
 - *J5D8 Evaporative coolers*

Full Name of Designer: Felisa Garcia
Qualifications: B LArch
Address of Designer: JHA
Level 20, 2 Market Street
SYDNEY NSW 2000
Business Telephone No: (02) 9437 1000
Name of Employer: JHA

Yours sincerely,



Felisa Garcia

ESD Consultant

Disclaimer

This statement is prepared for the nominated recipient only and relates to the specific scope of work and agreement between JHA and the client (the recipient). It is not to be used or relied upon by any third party for any purpose.

Revision History

REV	DATE	Amendment
B	24/07/2025	For Tender 50% Preliminary Issue
C	05/01/2026	For 85% Tender Issue
D	23/02/2026	DA Mod 2

Attachment A – Facade Calculator

Project Name	Uniting Charlestown Bldg B - Clubhouse
Project No.	210296
NCC Climate Zone	CZ 5
NCC Building Class	Other
Drawing Azimuth	100

NCC 2022 Volume One - Façade Calculator



In accordance with NCC 2022 Volume One J4D6 Walls and Glazing and Specification 37.

© Commonwealth of Australia and the States and Territories 2022, published by the Australian Building Codes Board.

The total System U-value of the proposed building is **1.99**, less than the Max. total System U-value of **2.0**.
 The total Representative Air-conditioning Energy Value (Er) of the proposed building is **31.69**, less than the Max. Er of **32.27**.
 Therefore, based on the Thermal Performance Specifications used in the tables below, the proposed building façades comply with Part J4 via Method 2.

Results

Aspect	J4D6(4)		Method 1		Method 2	
	Min. R-Value	Achieved R-Value	Max. U-Value	Achieved U-Value	Max. U-Value	Achieved U-Value
N	1.0	1.40	2.0	1.05	2.0	1.99
E	1.4	1.40	2.0	0.88		
S	1.0	1.40	2.0	1.84		
W	1.0	1.40	2.0	3.84		

Aspect	Method 1		Method 2			
	Max SA	Achieved SA	Max Er	Achieved Er	Max Er	Achieved Er
N	0.13	0.08	4.27	2.75	32.27	31.69
E	0.13	0.04	0.00	0.00		
S	0.13	0.07	8.31	4.19		
W	0.13	0.16	19.70	24.75		

Areas Summary

Aspect	Total Wall-Glazing Areas Summary				78.0%
	Total W-G Areas [m2]	Total Wall [m2]	Total Glazing [m2]	Wall to Total W-G Ratio	
N	82.2	77.4	4.8	94.2%	78.0%
E	65.9	64.1	1.9	97.2%	
S	69.7	56.2	13.5	80.6%	
W	86.6	39.7	46.8	45.9%	

Aspect	External Wall-Glazing Areas Summary				63.0%
	Total Ext. W-G Areas [m2]	Total External Wall [m2]	Total External Glazing [m2]	Ext Wall to Tot. Ext. W-G Ratio	
N	14.4	9.6	4.8	66.6%	63.0%
E	16.4	14.5	1.9	88.6%	
S	63.9	50.4	13.5	78.8%	
W	86.6	39.7	46.8	45.9%	

Façade Inputs & Walls Thermal Specifications

Aspect	Envelope Areas					Walls Thermal Performance		
	Wall Type Reference	External Envelope Areas [m2]	Internal Envelope Areas [m2]	External excluded Areas [m2]	Internal excluded Areas [m2]	Total W-G Areas [m2]	Total R-Value	Area x (1/R-value)
North	1	14.4	67.8			82.2	1.40	55.3
	2					0.0	1.00	0.0
	3					0.0	1.00	0.0
	4					0.0	1.00	0.0
East	5	16.4	57.8		2.3	65.9	1.40	45.8
	6					0.0	1.00	0.0
	7					0.0	1.00	0.0
	8					0.0	1.00	0.0
South	9	63.9	5.8			69.7	1.40	40.2
	10					0.0	1.00	0.0
	11					0.0	1.00	0.0
	12					0.0	1.00	0.0
West	13	86.6				86.6	1.40	28.4
	14					0.0	1.00	0.0
	15					0.0	1.00	0.0
	16					0.0	1.00	0.0

Glazing Thermal Specifications

Aspect	Glazing Thermal Performance			
	Glazing Type Reference	Total U-Value	Total SHGC	Area x U-Value
North	N1	6.5	0.31	31.2
	N2			0.0
	N3			0.0
	N4			0.0
East	E1	6.5	0.31	12.1
	E2			0.0
	E3			0.0
	E4			0.0
South	S1	6.5	0.31	87.8
	S2			0.0
	S3			0.0
	S4			0.0
West	W1	6.5	0.31	304.5
	W2			0.0
	W3			0.0
	W4			0.0

Glazing Details

Glazing Identification	External / Internal	Level	Glazing Type Reference	Wall Type Reference	Window			Shading				Shading Multiplier [SM]	Area x SM x SHGC
					Height [m]	Width [m]	Area [m²]	P [m]	H [m]	P/H	G/H		
W01	External	Level 01	N1	1	2.70	1.78	4.8	1.05	3.30	0.32	0.18	0.81	1.21
W02	External	Level 01	W1	13	2.70	4.77	12.9	0.15	3.30	0.05	0.18	1.00	3.99
W03	External	Level 01	W1	13	2.70	2.50	6.8	0.15	3.30	0.05	0.18	1.00	2.09
W03_B01.C01.14	External	Level 01	W1	13	2.29	1.20	2.7			-	-	1.00	0.85
W03_B01.C01.11	External	Level 01	E1	5	1.55	1.20	1.9			-	-	1.00	0.58
W03_B01.C01.10	External	Level 01	S1	9	1.55	1.20	1.9			-	-	1.00	0.58
W02_B01.C01.08	External	Level 01	S1	9	1.85	3.60	6.7			-	-	1.00	2.06
W02_B01.C01.07	External	Level 01	S1	9	1.85	2.70	5.0			-	-	1.00	1.55
D05_1	External	Level 01	W1	13	2.70	2.90	7.8	0.57	3.30	0.17	0.18	0.95	2.31
D05_2	External	Level 01	W1	13	2.70	2.90	7.8	0.57	3.30	0.17	0.18	0.95	2.31
D05_3	External	Level 01	W1	13	2.70	3.26	8.8	0.57	3.30	0.17	0.18	0.95	2.59

Attachment B – Building Fabric Requirements Markups

1. DRAWING TO BE READ IN CONJUNCTION WITH PLA-AR-001 LEGEND, RELEVANT SCHEDULES AND PROJECT SPECIFICATION.
2. GRATED OPENINGS TO COMPLY WITH AS 1428.1:2019 Cl 7

- GENERAL NOTES:**
- DRAWINGS COORDINATED WITH THE FOLLOWING CONSULTANTS:
- STRUCTURAL
 - ELECTRICAL
 - MECHANICAL
 - HYDRAULICS
 - FIRE SERVICES
 - FIRE ENGINEER
 - ACoustICS
 - AV/SECURITY
 - ACCESS
 - BCA
 - PCA
 - QS
 - SAFETY IN DESIGN
 - LANDSCAPE
 - SUSTAINABILITY
 - FACADE ENGINEER
 - CIVIL
 - WPM CONSULTANT

NCC 2022 Section J4 DTS requirements
Building Fabric Required total system R-Values

- Roof & Ceiling - R1 3.7 (DOWNWARDS, SOLAR ABSORPTANCE OF THE UPPER SURFACE OF A ROOF MUST NOT BE MORE THAN 0.45)
- Walls - R1 1.4
- Floors (including Slab on Ground) - R1 2.0

Note:


- The R-value is a total system performance value and NOT insulation.
- The above construction are only to be applied to non-glazed portions of the envelope and spandrel panels; glazing must be installed as per the architectural layouts with its thermal performances pursuant to the respective glazing specifications stated in the Section J report.
- For Climate Zone 5, a slab-on-ground floor that does not have an in-slab heating or cooling system is considered to achieve a total R-value of R1.0.

DTS Glazing (Glass + Frame) requirements:
All Windows - U-value: 6.5, SHGC: 0.31 (Single Glazed Tinted or the like)

JHA
MARKUP / SKETCH

DOCUMENT No.: 210296
DOCUMENT TITLE: **Uniting Charlestown Building B - Clubhouse**

DOCUMENT REV: 0
DOCUMENT BY: FG DATE: 23/02/2025

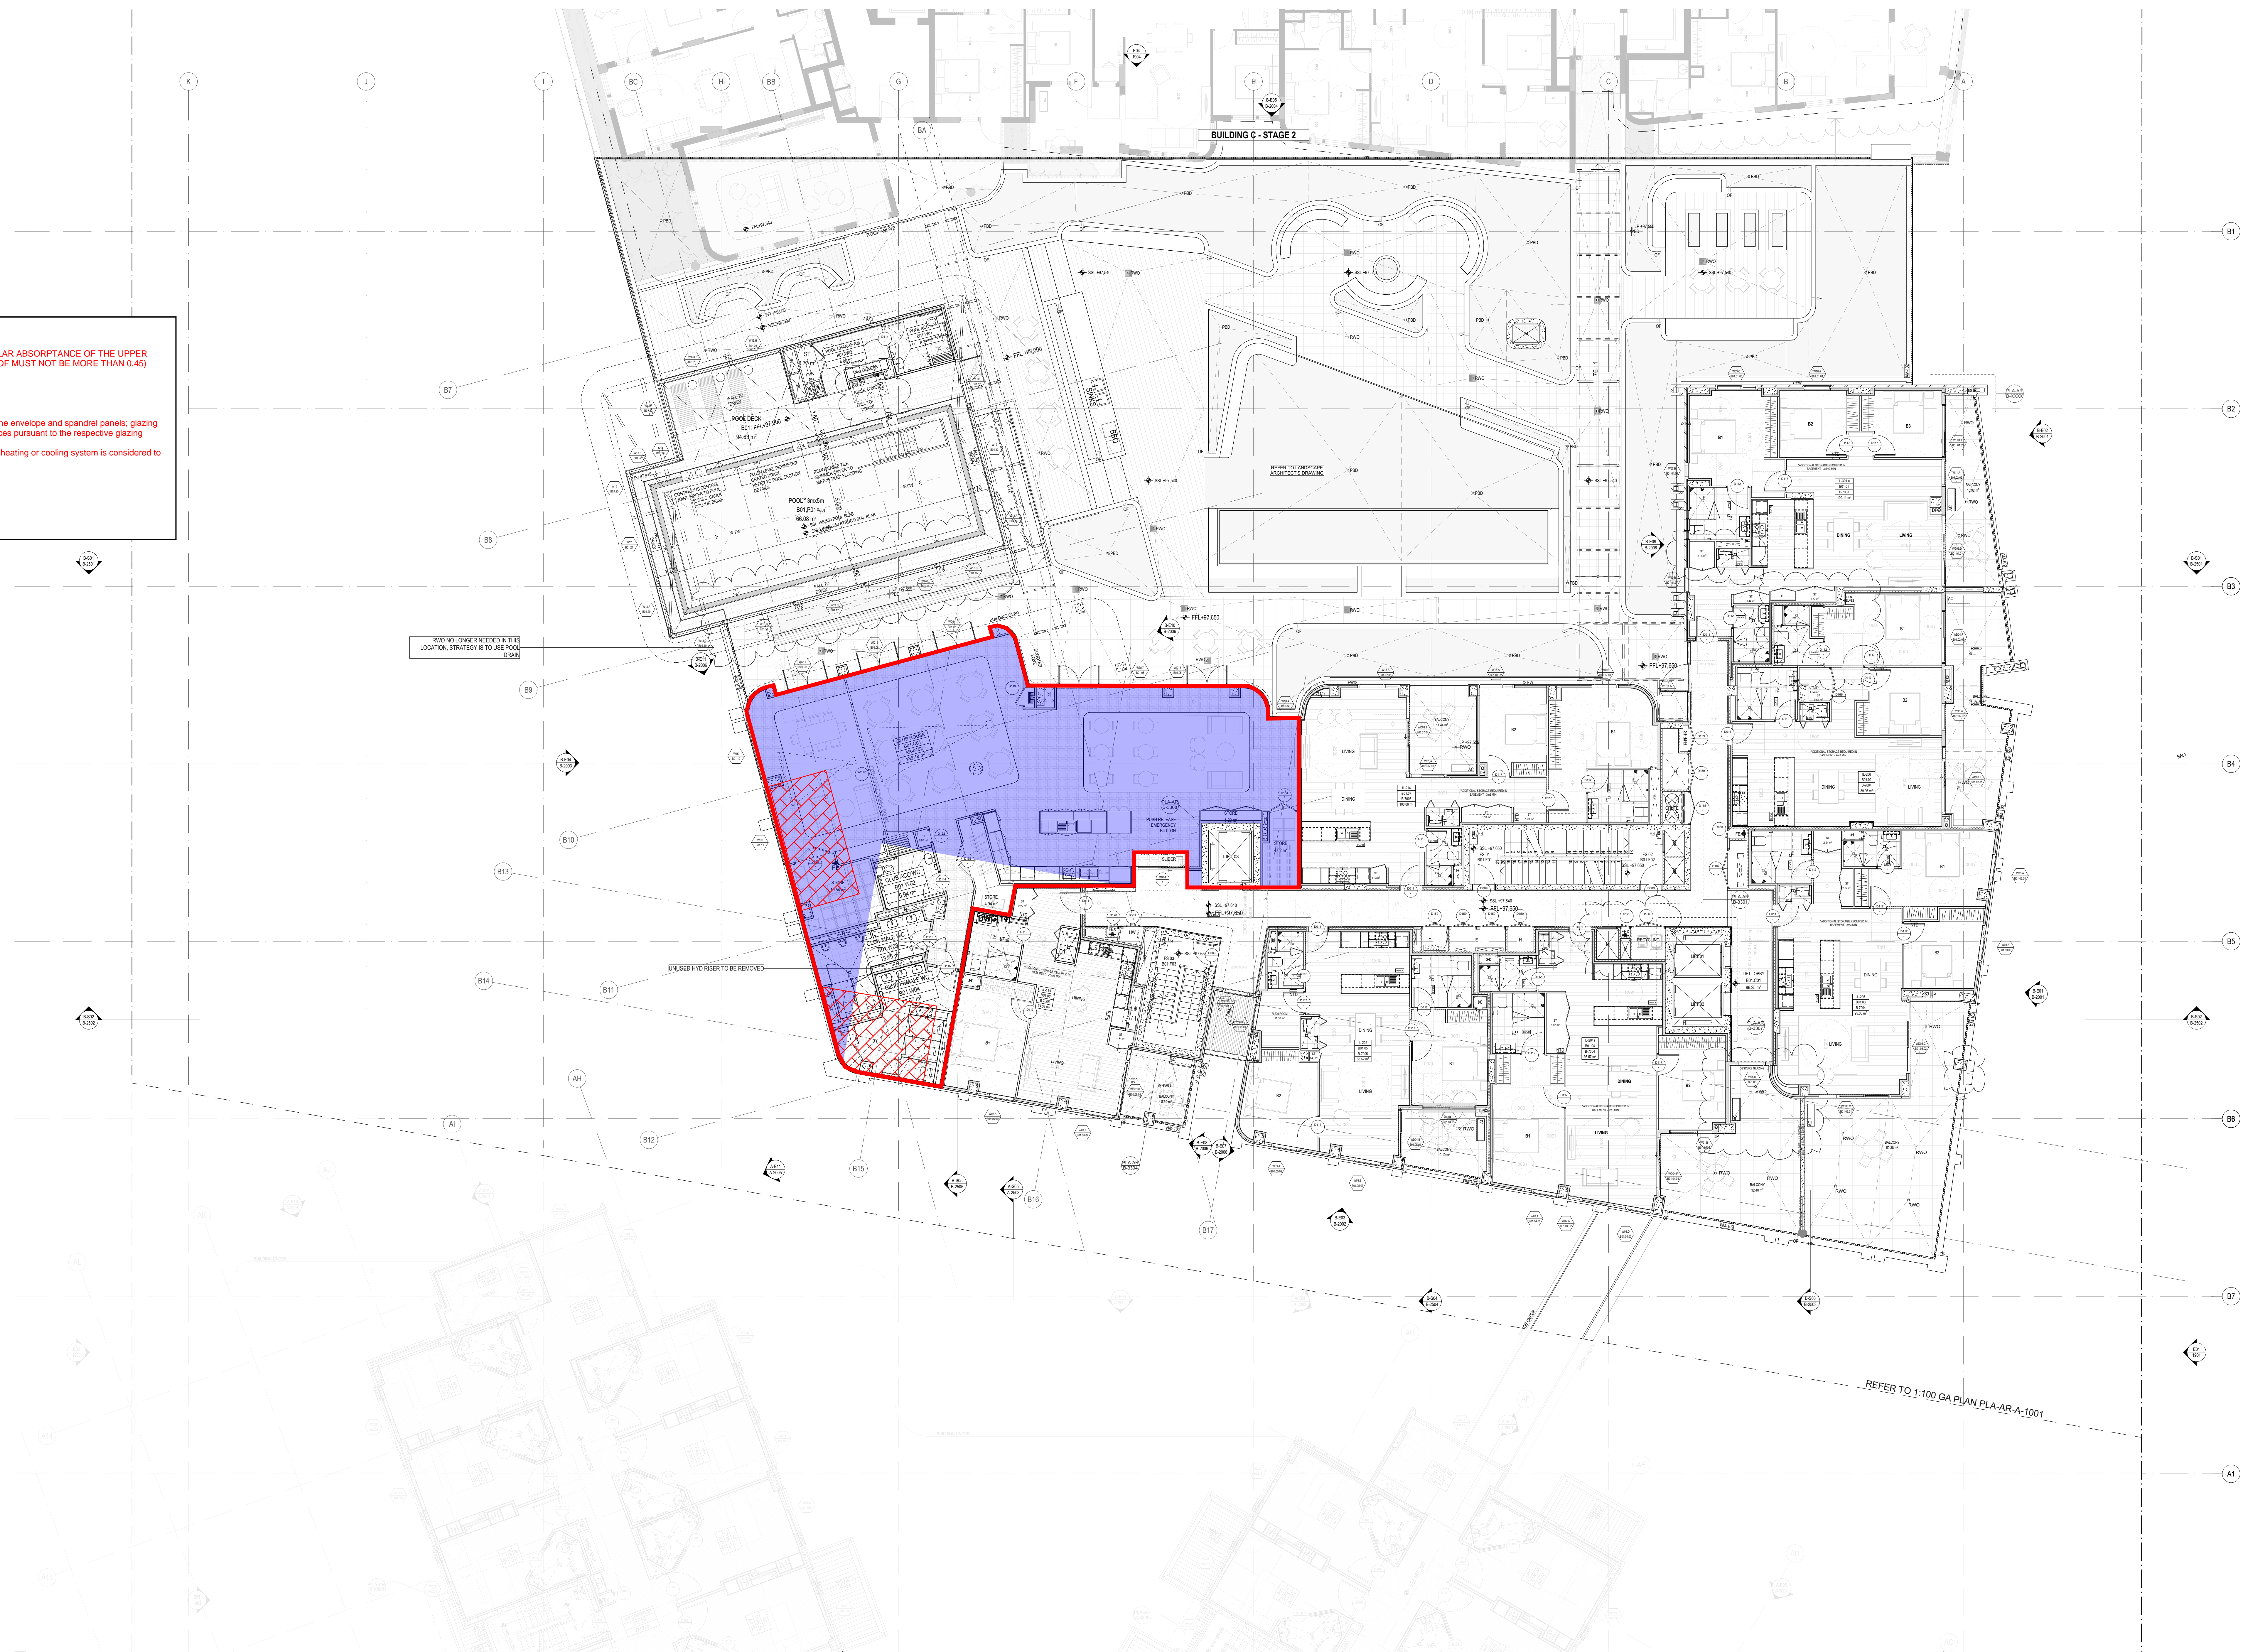

FOR TENDER 85% PRELIMINARY ISSUE

DRAWING TO BE READ IN CONJUNCTION WITH PLA-AR-001 LEGEND, RELEVANT SCHEDULES AND PROJECT SPECIFICATION.

DATE	REVISION	BY	CHK	NO.	DATE	REVISION	BY	CHK	NO.
21/03/2024	ISSUE FOR INFORMATION	MA	MA	01	5/11/2025	FOR TENDER 70% PRELIMINARY ISSUE	DHNK	MA/FT	11
27/03/2024	ISSUE FOR INFORMATION	DHNK	MA/FT	02	1/12/2025	PRELIMINARY ISSUE	DHNK	MA/FT	12
17/04/2024	ISSUE FOR 30% COORDINATION	DHNK	MA/FT	03	4/12/2025	PRELIMINARY ISSUE	DHNK	MA/FT	13
3/05/2024	ISSUE FOR 40% COORDINATION	DHNK	MA/FT	04	19/12/2025	FOR TENDER 85% PRELIMINARY ISSUE	DHNK	MA/FT	14
23/05/2024	ISSUE FOR 50% COORDINATION	DHNK	MA/FT	05					
18/06/2024	FOR COORDINATION	DHNK	MA/FT	06					
11/11/2024	ISSUE FOR COORDINATION	DHNK	MA/FT	07					
23/06/2025	AMENDED 50% FOR VE CHANGES	DHNK	MA/FT	08					
14/07/2025	FOR TENDER 50% PRELIMINARY ISSUE	DHNK	MA/FT	09					
9/09/2025	ISSUE FOR COORDINATION	DHNK	MA/FT	10					

CONSULTANTS	PROJECT MANAGER	PCA	BB-G	T 82 921 7777
<input type="checkbox"/> TBA	<input type="checkbox"/> TBA	<input type="checkbox"/>	<input type="checkbox"/>	
<input type="checkbox"/> CIVIL ENG.	<input type="checkbox"/> WPC	<input type="checkbox"/>	<input type="checkbox"/>	T 82 427 5566
<input type="checkbox"/> STRUCTURAL ENG.	<input type="checkbox"/> NORTHROP	<input type="checkbox"/>	<input type="checkbox"/>	T 82 443 1777
<input type="checkbox"/> SERVICE ENG.	<input type="checkbox"/> NORTHROP	<input type="checkbox"/>	<input type="checkbox"/>	T 82 841 4188
<input type="checkbox"/> LANDSCAPE ARCH.	<input type="checkbox"/> ARCADIA	<input type="checkbox"/>	<input type="checkbox"/>	T 82 871 2900
<input type="checkbox"/> BCA	<input type="checkbox"/> BB-G	<input type="checkbox"/>	<input type="checkbox"/>	T 82 921 7777

Uniting

plus

Level 4, 222 Clarendon Street
Sydney, NSW 1590 Australia
Plus Architecture Pty. Ltd.
ACN 90343831
Nationalised Architect (NSA)
Arch. No. 1000
Rtdo Pty 1136

Melbourne
Brisbane
Christchurch
Sydney
Wellington
Auckland

Telephone +61 2 8227 7000
Email info@plusarchitecture.com.au
www.plusarchitecture.com.au

PROJECT: **27 TIRAL STREET, CHARLESTOWN**

DRAWING TITLE: **BUILDING B - LEVEL 01 FLOOR PLAN**

SCALE: 1:100 @A0

PLOT DATE: 19/12/2025

DRAWN: DHNK

CHECKED: MA/FT

JOB NO.: 20456

DRAWING NO.: PLA-AR-B-1001

REVISION: 14

In accepting and obtaining this document the recipient agrees that Plus Architecture Pty. Ltd. ACN 802030321, its officers, employees, agents, subcontractors, consultants, and other parties, shall not be liable for any loss or damage, including consequential loss or damage, arising from the use of this document for any purpose other than that for which it was prepared, and that the recipient shall indemnify and hold Plus Architecture Pty. Ltd. harmless from and against all claims, damages, costs, and expenses, including reasonable legal costs, in respect of any such loss or damage. The recipient shall also indemnify and hold Plus Architecture Pty. Ltd. harmless from and against all claims, damages, costs, and expenses, including reasonable legal costs, in respect of any such loss or damage. The recipient shall also indemnify and hold Plus Architecture Pty. Ltd. harmless from and against all claims, damages, costs, and expenses, including reasonable legal costs, in respect of any such loss or damage.