



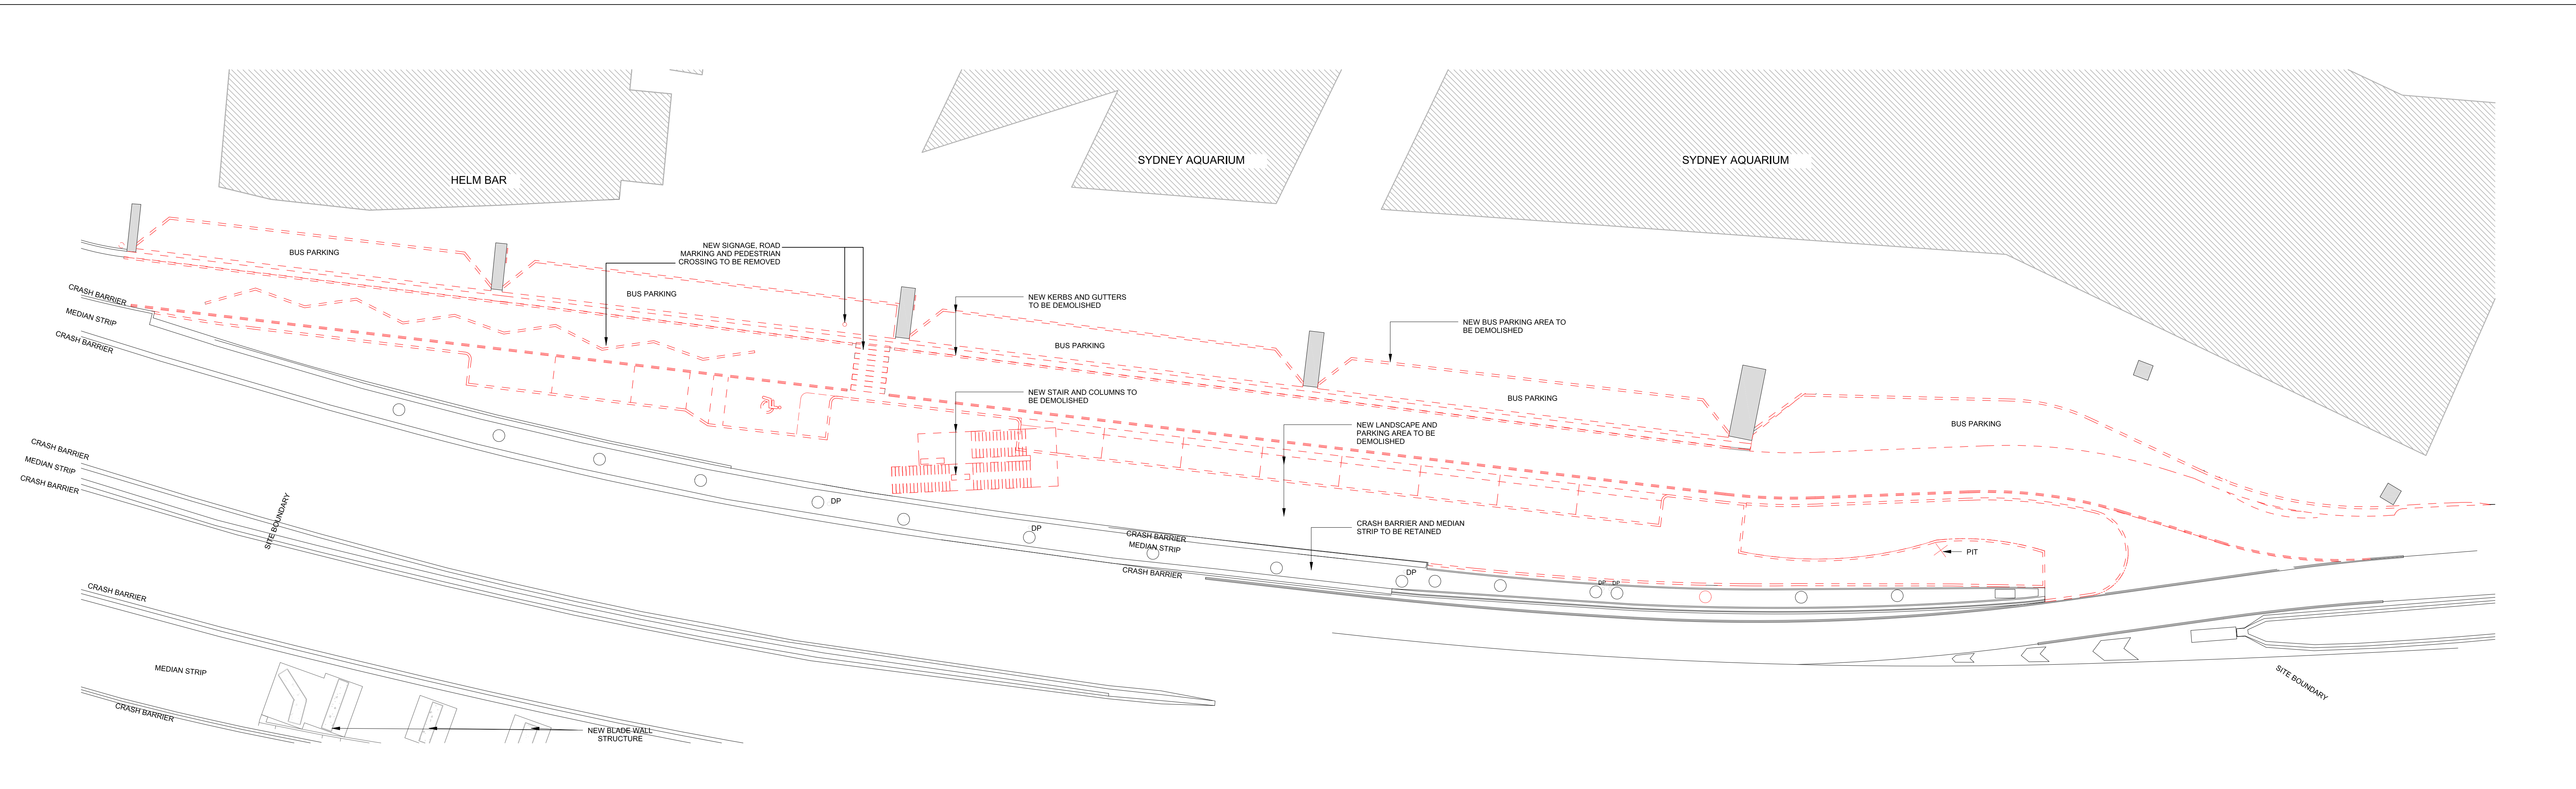

1 PUBLIC DOMAIN - LOWER GROUND LEVEL - WHEAT ROAD DEMOLITION
SCALE 1 : 200
(DEMOLITION SHOWN IN DASHED RED LINE)

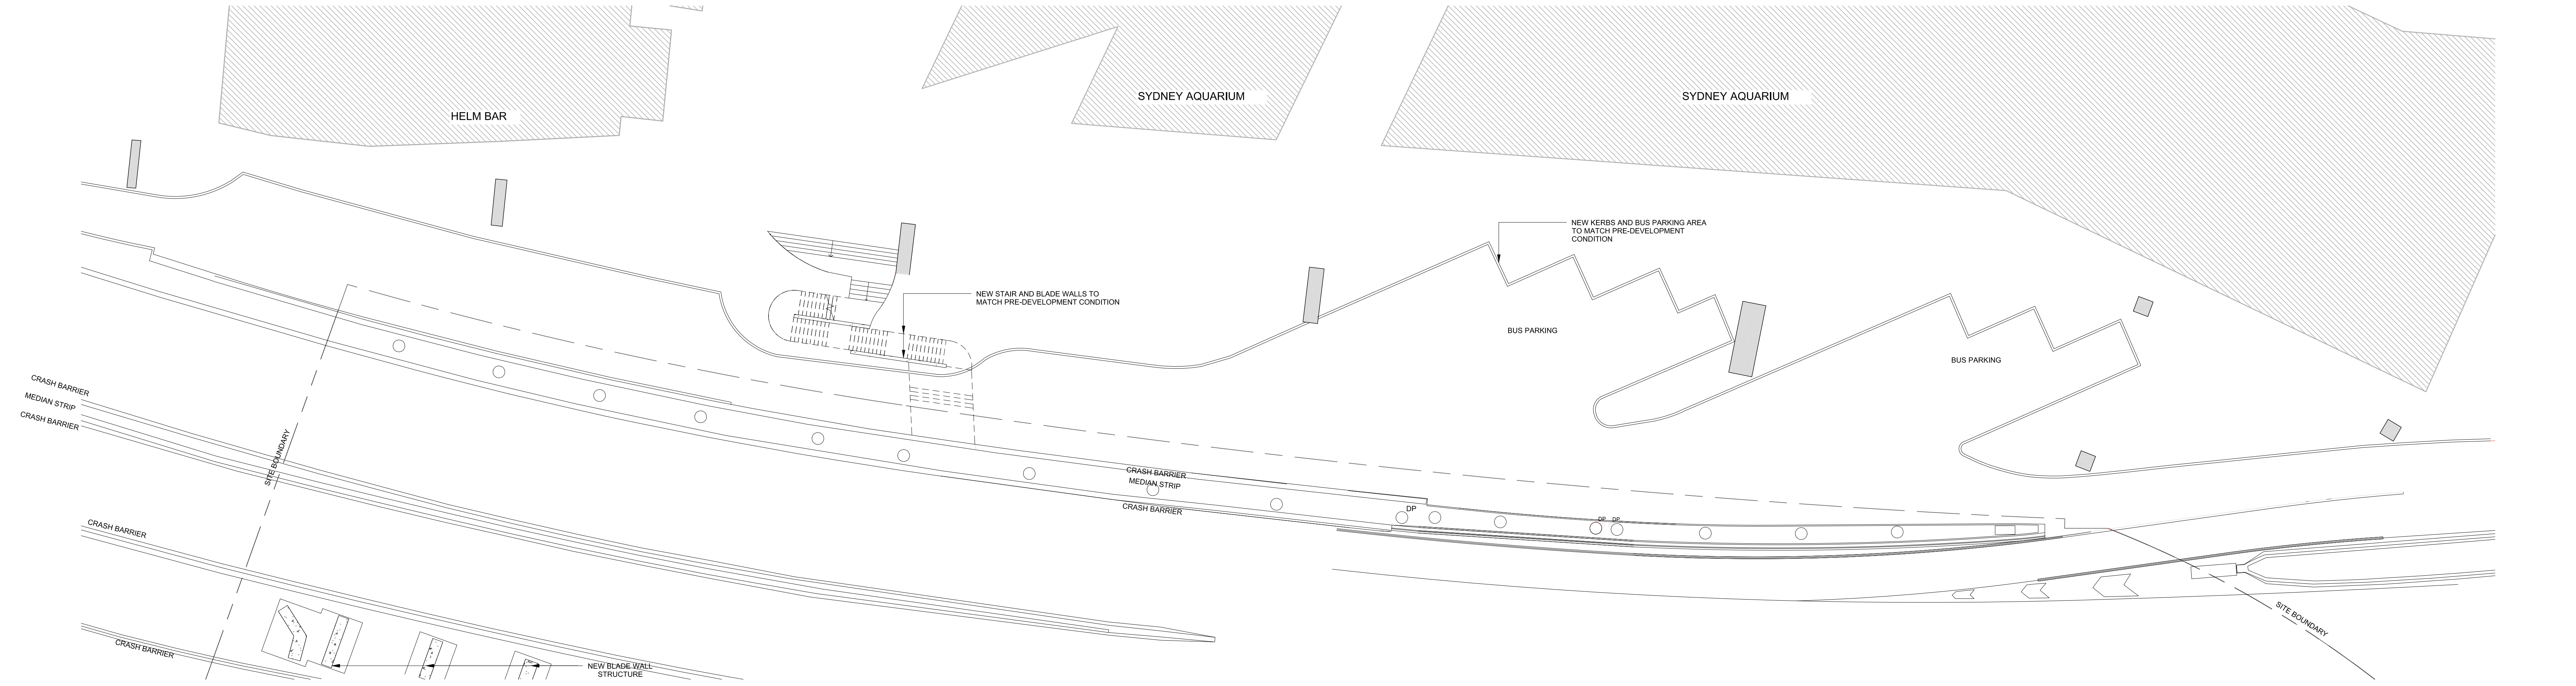

2 PUBLIC DOMAIN - LOWER GROUND LEVEL - WHEAT ROAD PROPOSED
SCALE 1 : 200