

NOTES:

1. CHANGES FROM DA APPROVED BUILDING DESIGN TO S.96 DESIGN SHOWN CLOUDED AND ARE NUMBERED.
READ IN CONJUNCTION WITH LIST OF CHANGES BELOW.
2. OUTLINE OF APPROVED STATE SIGNIFICANT DEVELOPMENT APPLICATION SSD 6339 SHOWN IN RED DASHED LINES.
3. NEW WORKS TO DJSC BUILDING SHOWN IN BLUE COLOUR.
4. DRAWING TO BE REPRODUCED IN COLOUR FOR CLARITY.

B 1 ← CHANGE ID NUMBER (REFER TO LIST OF CHANGES)
ISSUE #

- LIST OF CHANGES SECTIONS:
- 1. STAIR FLIGHT LOCATION CHANGED.
- 2. DECORATIVE BLAZE WALL DELETED
- 3. NEW LOCATION FOR PLANT ROOM TO THE WEST AWAY FROM No.4 MACHPHERSON STREET.
- 4. PLANT ROOM MOVED TO THE WEST AWAY FROM NEIGHBOUR SMOKE EXHAUST SYSTEM OVER THE AUDITORIUM ROOF
- 5. BUILDING FOOTPRINT REDUCED AT LEVEL 6 TOWARDS THE EAST BOUNDARY.
- 6. BUILDING SETBACK TO WEST BOUNDARY REDUCED FOR STRUCTURAL REQUIREMENTS
- 7. ADDITIONAL AREA AT BASEMENT AS A RESULT OF FOOTINGS, COLUMNS AND RETAINING WALLS BUILDING REQUIREMENTS.
- 8. BICYCLE PARKING ALLOCATION.
- 9. LEVEL 1 BOTTOM RAMP ADDED TO ALLOW FOR STRUCTURAL REQUIREMENTS, SERVICE DUCKS AND MINIMUM PARKING CLEARANCES.
- 9. ADDITIONAL AREA AT BASEMENT AS A RESULT OF FOOTINGS, COLUMNS AND RETAINING WALLS BUILDING REQUIREMENTS.
- 10. NEW WINDOWS FOR NATURAL LIGHT AND VENTILATION TO LEVEL 3
- 11. LEVEL 4 TERRACE CANTILEVER TO PROVIDE WEATHER PROTECTION TO OPENINGS ABOVE
- 12. NEW SPECIES OF PLANTING AND EXISTING MAGNOLIA TREE AMENDED. REFER TO LANDSCAPE ARCHITECT DRAWINGS.
- 12. CHANGE TO ROOF HEIGHT
- 13. OSO & RW TANKS SHOWN
- 14. BALANCE TANK FOR SWIMMING POOL SHOWN.
- 15. STAIR DESIGN AND INTERNAL SPACE DISTRIBUTION AMENDED.

2 SECTION B - S.96
1 : 200

101.080 RL
Fly Tower Roof

▽ 99.431 RL
Research Centre Roof

95.455 RL
Level 7

DAME JOAN
SUTHERLAND
CENTRE

▽ 91.900 RL
Level 6

▽ 89.560 RL
Level 5

▽ 85.900 RL
Level 4

▽ 82.280 RL
Level 3

▽ 77.900 RL
Level 2

▽ 72.550 RL
Level 1

ROOF PLANT

SMOKE EXHAUST

LOUNGE

BOARD ROOM

FOYER

BOILER PLANT

MULTI PURPOSE HALL

DIVING BOARDS

12 LANES SWIMMING POOL

2 WAY RAMP

CARPARK

RES. UNIT BEDROOM

RES. UNIT BEDROOM

RES. UNIT BEDROOM

GARAGE

SITE BOUNDARY EAST

No.4
MACPHERSON
STREET

RL 90.910

RL 87.990

RL 84.000

RL 82.000

RL 80.000

RL 0.000

RL -2.000

RL -4.000

RL -6.000

RL -396.000



RL -398.000

RL -400.000

RL -402.000

 
RL -404.000

RL -406.000</

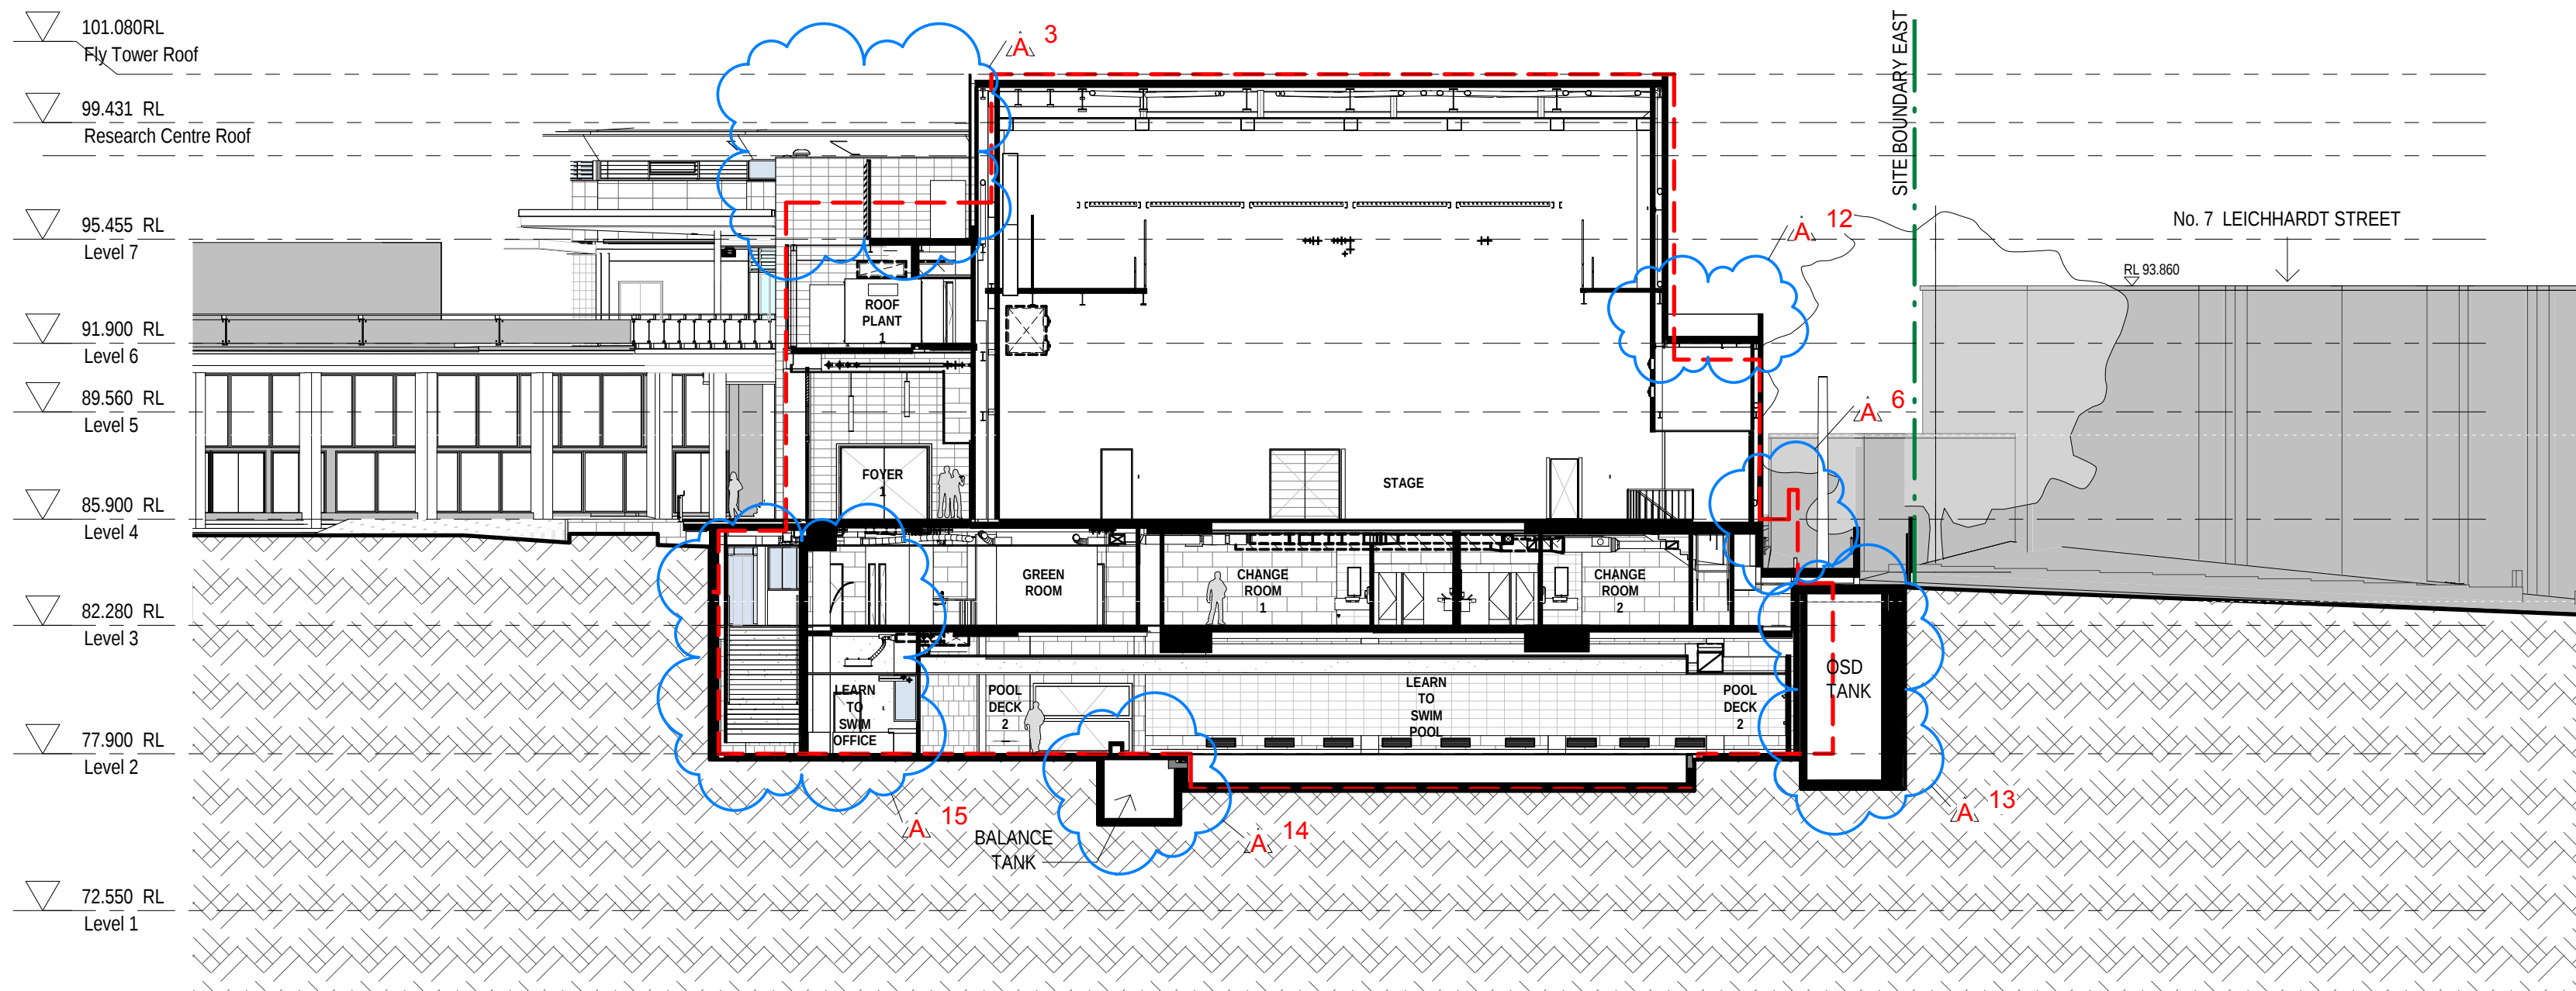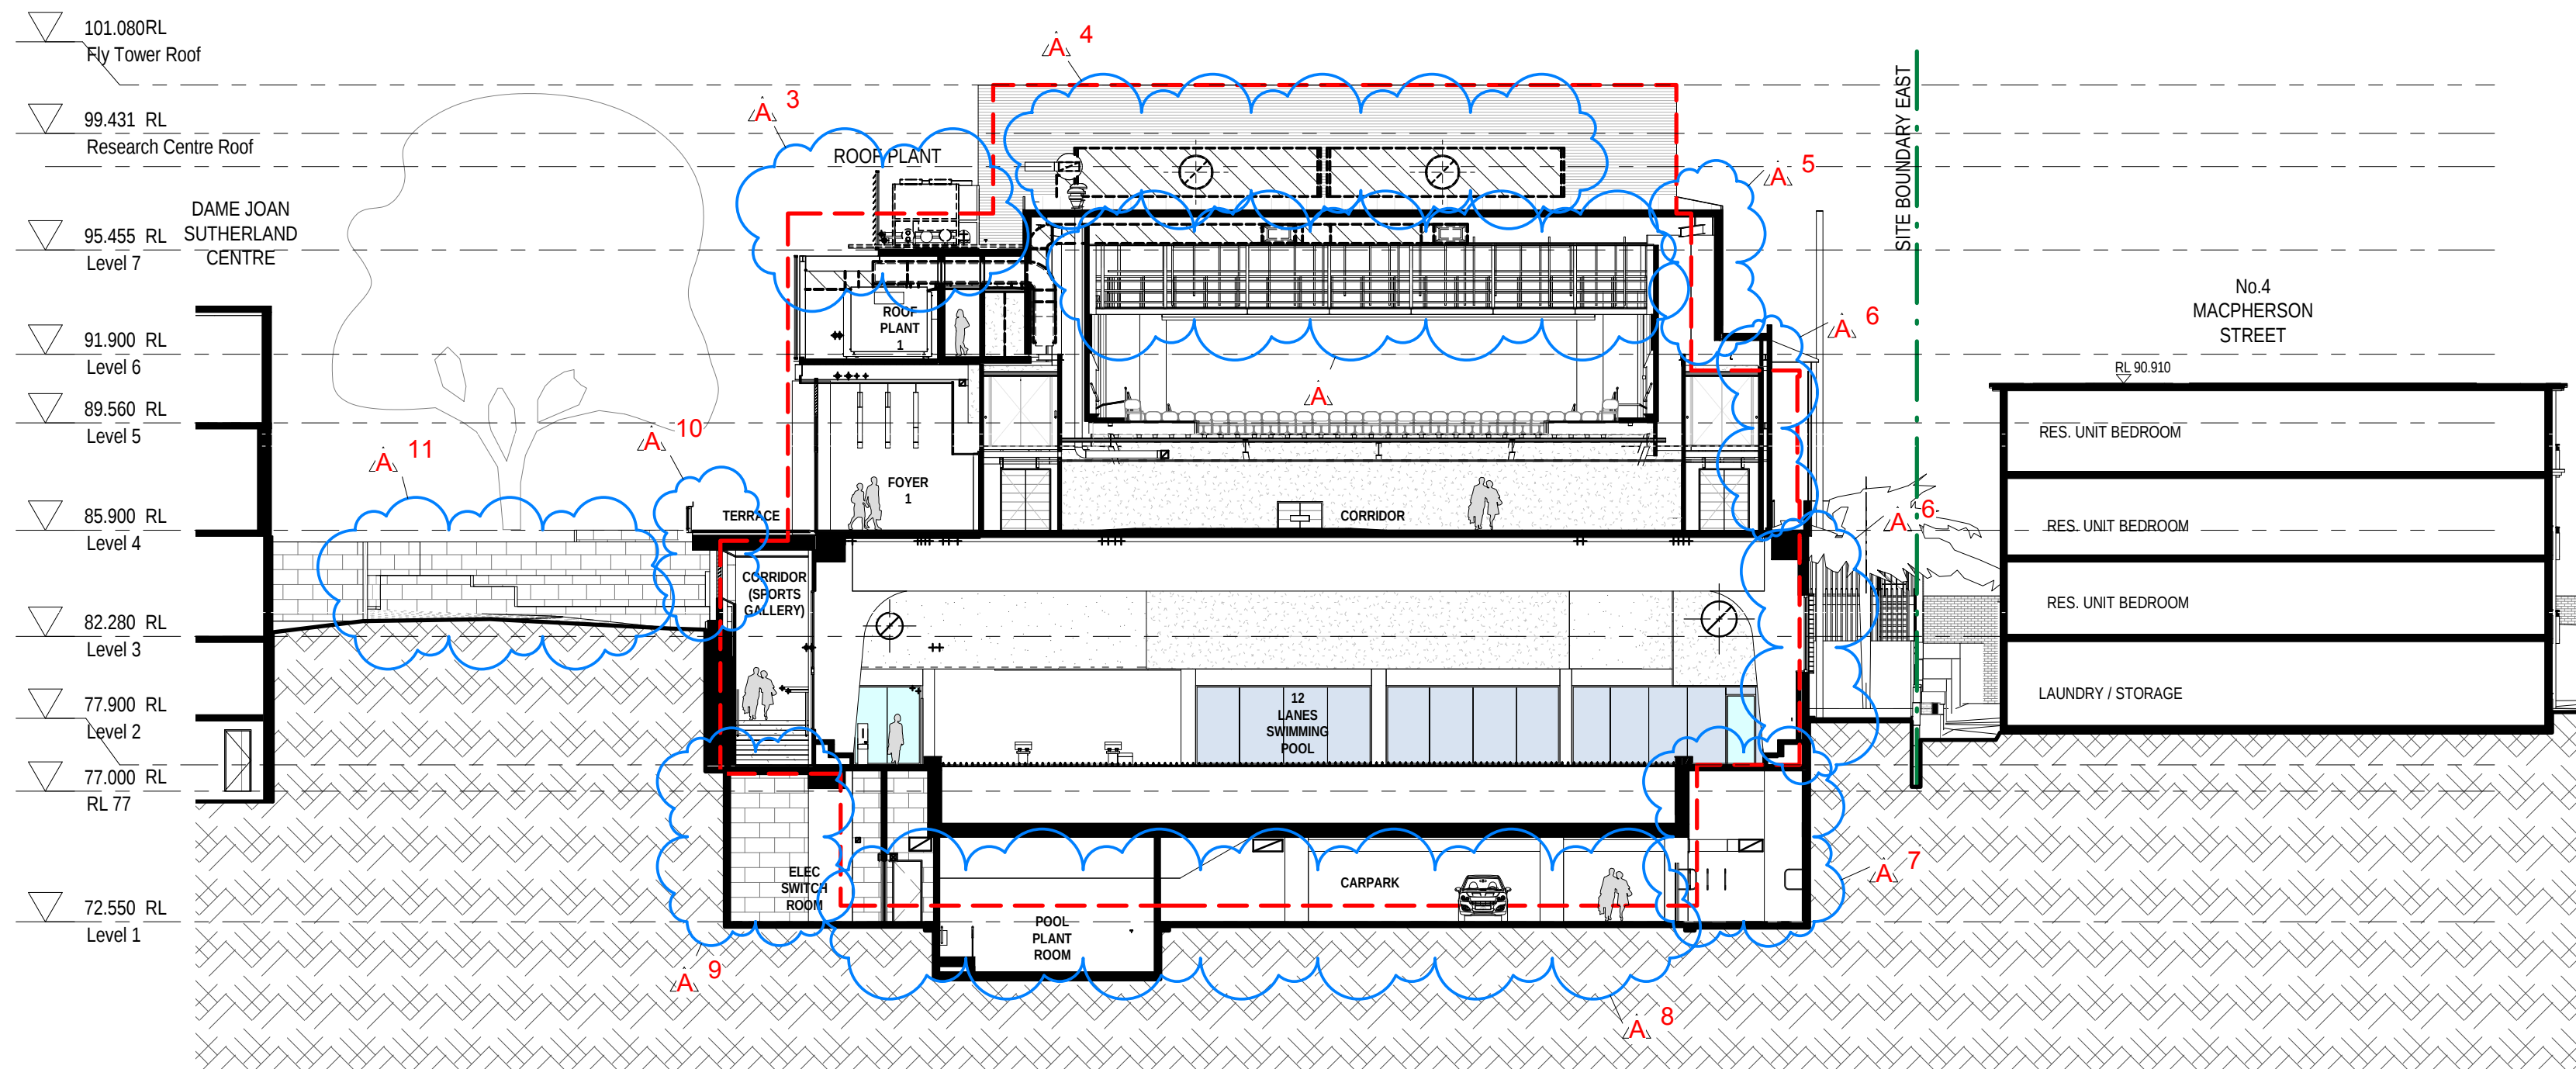

A	S.96 APPLICATION	19.12.17
ISSUE	AMENDMENT DESCRIPTION	DATE

ARCHITECT

 **MAYOH**
ARCHITECTS

DD MAYOH PTY LTD
ABN 16788096806
Peter Mayoh - Registered Architect No.3788
Jo Simmons - Registered Architect No.8227
60 Strathallen Avenue Northbridge NSW 2063
P: +61 2 9358 0488 F: +61 2 9358 6424
info@pdmayoh.com.au
www.mayoharchitects.com.au

CLIENT

ST. CATHERINE'S
SCHOOL

TITLE

SECTION A, B & C

PROJECT

RPAC

26 ALBION STREET WAVERLEY NSW
2024

DRAWING STATUS: 70% ECI STAGE 1

0 m 2 4 6

SCALE: As indicated @ A1 JOB NO: 1212

CHECKED: JS DRAWN: DBV

DRAWINGS No. 96A160

REV A

18/12/2017 10:34:10 PM