



NSW GOVERNMENT
Planning

Issued under the Environmental Planning and Assessment Act 1979


Approved Section 96 (1A) (1) (2) Modification Application

No. MOD 3 granted on the 09 NOV 2017

in respect to MP SSD 7237

Signed: A. Coonan

Sheet No. 1 of 20

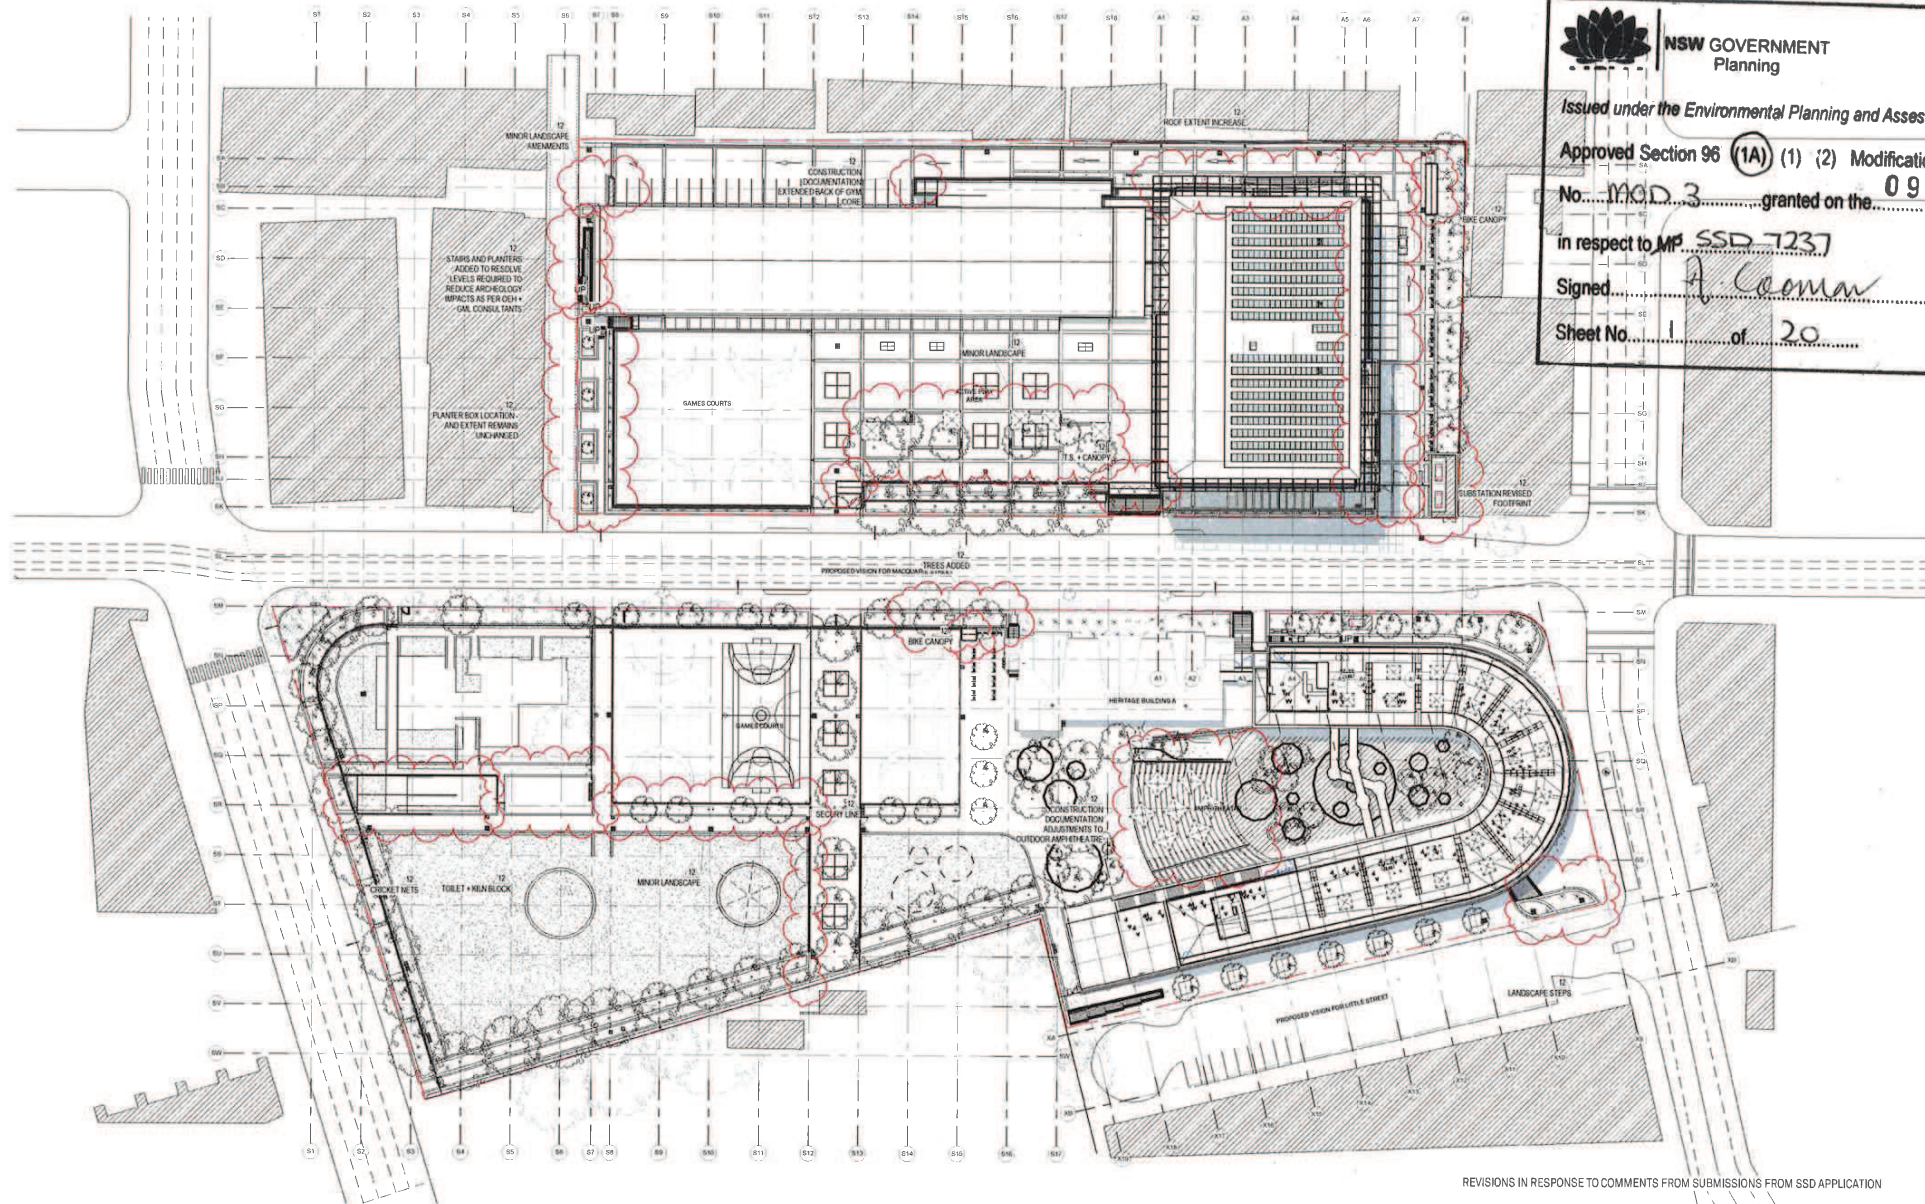

REVISIONS IN RESPONSE TO COMMENTS FROM SUBMISSIONS FROM SSD APPLICATION

ALL DRAWINGS TO BE READ IN CONJUNCTION WITH EFSG DEPARTURE SCHEDULE, FUNCTIONAL DESIGN BRIEF AND EDUCATIONAL FOUNDATIONS REPORTS

1 Context Roof Plan_500

GRIMSHAW

GRIMSHAW Architects
Telephone +61 (0)2 9233 0200
Address Level 3, 24 Hickson Rd
Vaucluse, NSW 2030
Australia

www.grimshaw-architects.com



BVN Architecture
Telephone +61 (0)2 6297 7200
Address Level 11
255 The Street
Sydney NSW 2000
Australia

www.bvn.com.au

INTELLECTUAL PROPERTY

Designated copyright material is to be used in accordance with the terms of the license. All rights in the design are reserved. No part of this document may be reproduced, stored in a retrieval system, or transmitted in any form or by any means, electronic, mechanical, photocopying, recording, or by any information storage or retrieval system, without prior written permission from the copyright owner. The copyright owner is not responsible for any loss or damage arising from the use of this document, or any information stored or retrieved from it.

REV	DATE	FOR
1	22.02.16	D/E
2	04.03.16	D/E
3	11.03.16	D/E
4	15.03.16	ARUP
5	21.03.16	D/E
6	15.04.16	PLANNING DRAFT
7	02.05.16	PLANNING ISSUE
8	14.06.16	Q3
9	25.06.16	PLANNING ISSUE
10	22.11.16	PLANNING ISSUE
11	08.03.17	PLANNING
12	01.08.17	PLANNING AMENDMENT

CLIENT
Department of Education

GRIMSHAW PROJECT NO.
15091

DRAWING KEY



PROJECT
APHS

ADDRESS
(PPS)
175 Macquarie Street

(APHS)
80-100 Macquarie Street
Parramatta NSW 2150
Australia



SCALE 1:1
1: 500


STATUS
PLANNING AMENDMENT

DRAWING
SITE PLANS CONTEXT PLAN
ROOF

DRAWN
GAS

DRAWING NUMBER
A02-1001

REVISION
12

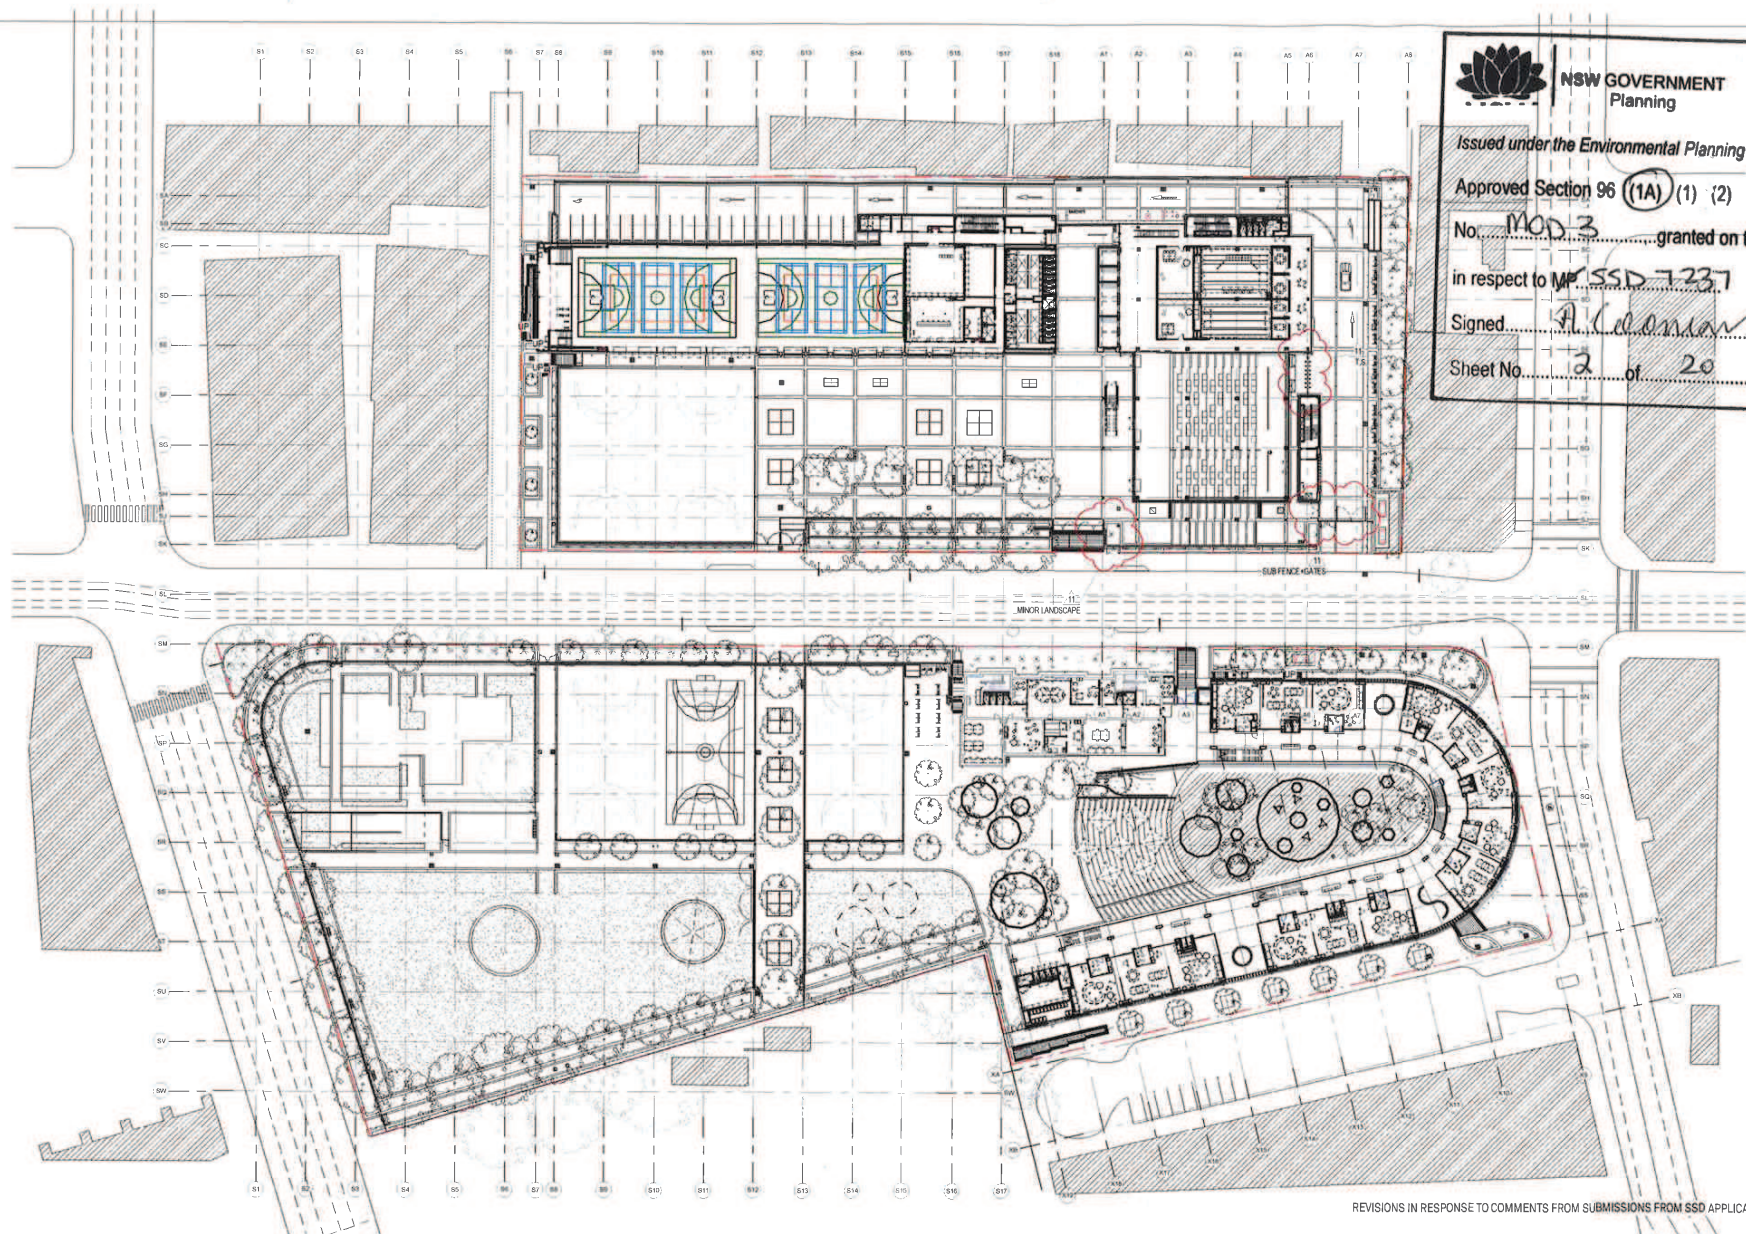

NSW GOVERNMENT
Planning

Issued under the Environmental Planning and Assessment Act 1979

Approved Section 96 (1A) (1) (2) Modification Application

No. MOD 3 granted on the 9 NOV 2017

in respect to MP SSD 7237

Signed A. Coleman

Sheet No. 2 of 20

1 AR-A02-1002_Site Plan Upper Ground_500

REVISIONS IN RESPONSE TO COMMENTS FROM SUBMISSIONS FROM SSD APPLICATION

ALL DRAWINGS TO BE READ IN CONJUNCTION WITH EPSS DEPARTURE SCHEDULE,
FUNCTIONAL DESIGN BRIEF AND EDUCATIONAL FOUNDATIONS REPORTS

GRIMSHAW

GRIMSHAW Architects
Telephone +61 (02) 9253 0200
Address Level 3, 24 Hickson Rd
Vaucluse NSW 2000
Australia

www.grimshaw-architects.com



BVN Architecture
Telephone +61 (02) 8297 7200
Address Level 11
255 The Street
Sydney NSW 2000
Australia

www.bvn.com.au

INTELLECTUAL PROPERTY

©COPYRIGHT GRIMSHAW ARCHITECTS
ALL RIGHTS RESERVED. NO PART OF THIS DOCUMENT
MAY BE REPRODUCED OR TRANSMITTED IN ANY FORM
OR BY ANY MEANS, ELECTRONIC OR MECHANICAL,
INCLUDING PHOTOCOPYING, RECORDING, OR BY
ANY INFORMATION STORAGE AND RETRIEVAL SYSTEM,
WITHOUT PERMISSION IN WRITING FROM GRIMSHAW
ARCHITECTS.

REV	DATE	FOR
1	04/03/16	D/E
2	11/03/16	D/E
3	21/03/16	D/E
4	12/04/16	D/E APPROVAL
5	15/04/16	PLANNING DRAFT
6	02/05/16	PLANNING ISSUE
7	14/06/16	QS
8	25/08/16	PLANNING ISSUE
9	22/11/16	PLANNING ISSUE
10	08/03/17	PLANNING
11	01/08/17	PLANNING AMENDMENT

CLIENT
Department of Education

GRIMSHAW PROJECT NO
15091

DRAWING KEY



PROJECT
APHS

ADDRESS
(PPS)
175 Macquarie Street

(APHS)
80-100 Macquarie Street
Parramatta NSW 2150
Australia



NORTH
SCALE 1:500

STATUS
PLANNING AMENDMENT

DRAWING
SITE PLANS CONTEXT PLAN
UPPER GROUND


DRAWN CHECKED AUTHORIZED
GAS EE / LJ LB

DRAWING NUMBER REVISION
A02-1002 11

MACQUARIE STREET

PS-SK 1034

A05-1101

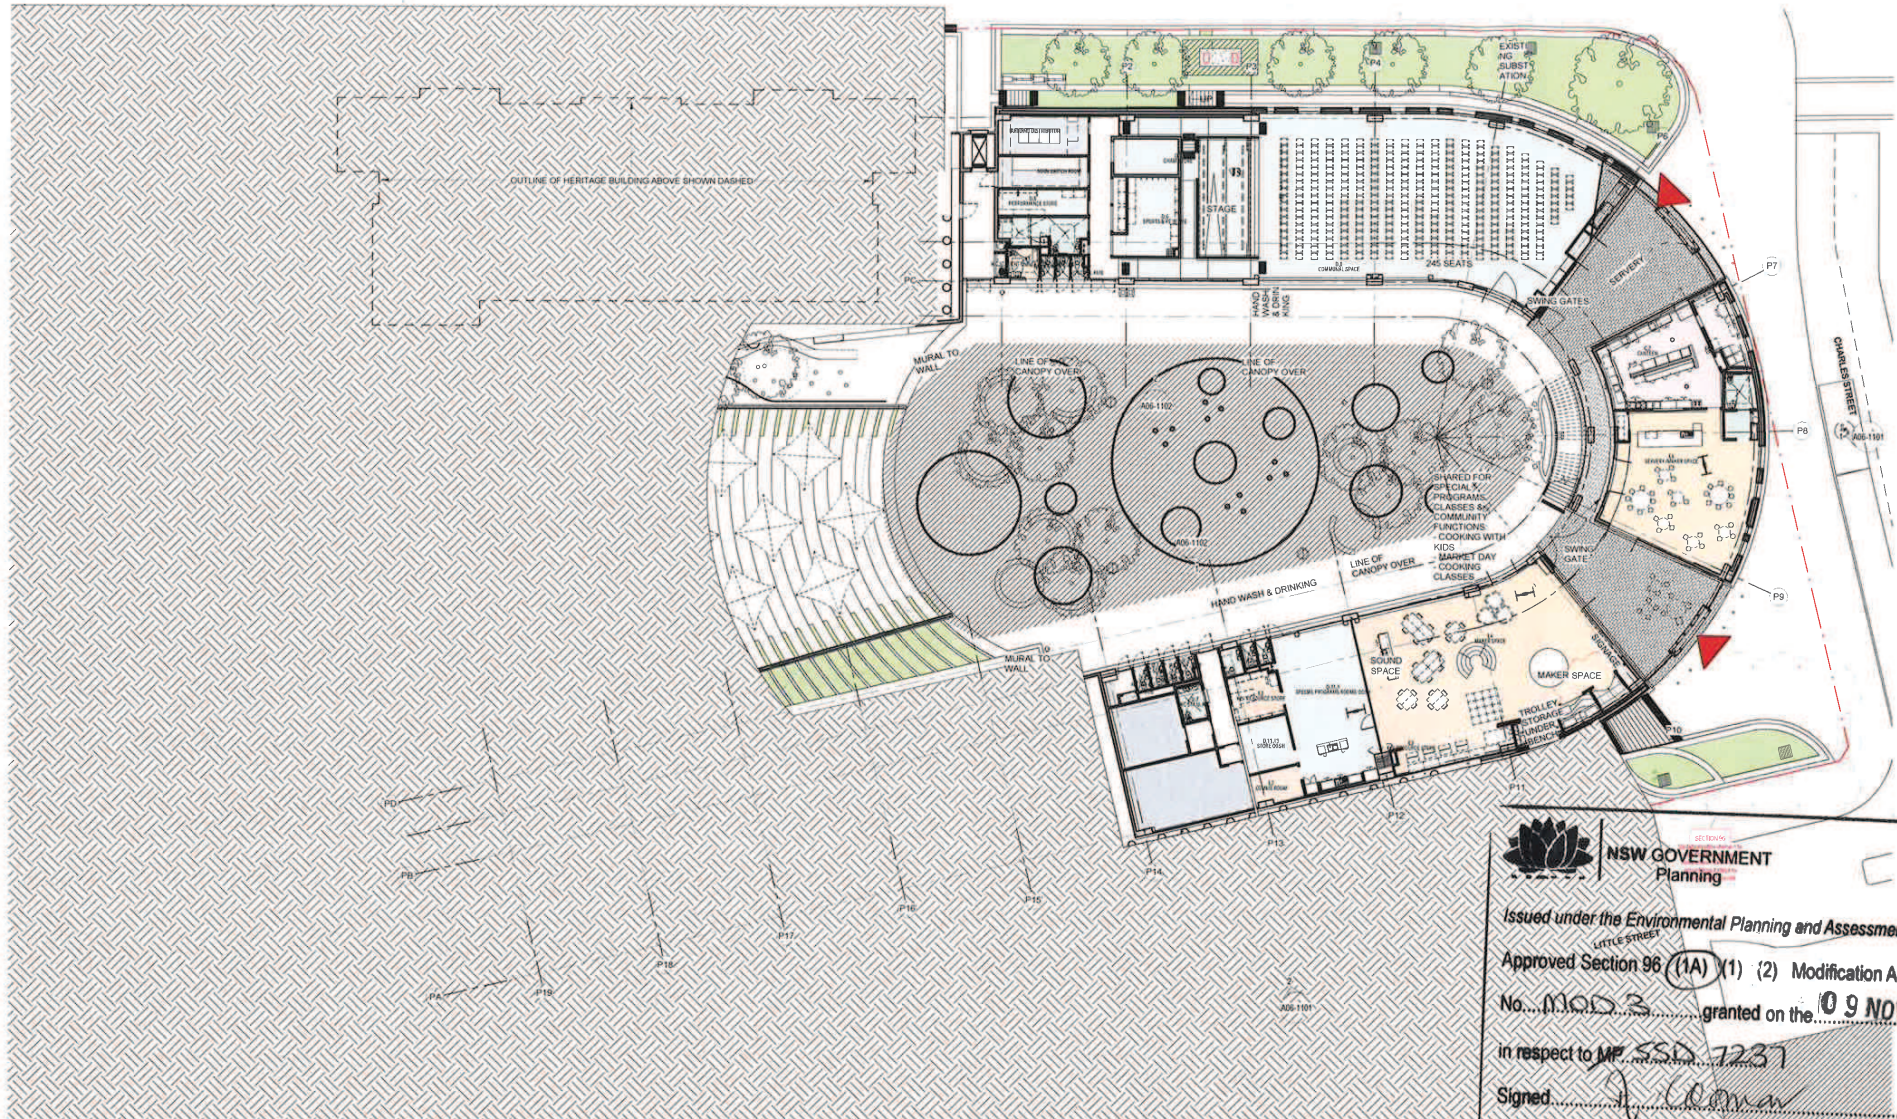

ALL DRAWINGS TO BE READ IN CONJUNCTION WITH EFSG DEPARTURE SCHEDULE, FUNCTIONAL DESIGN BRIEF AND EDUCATIONAL FOUNDATIONS REPORTS



NSW GOVERNMENT
Planning

Issued under the Environmental Planning and Assessment Act 1979

Approved Section 96 (1A) (1) (2) Modification Application

No. MOD 3 granted on the 09 NOV 2017

in respect to MP SSD 7237

Signed: [Signature]

Sheet No. 3 of 3

REVISION RESPONSE TO COMMENTS FROM SUBMISSION FROM SSD APPLICATION

GRIMSHAW

GRIMSHAW Architects
Telephone +61 (0)2 9253 0200
Address Level 3, 24 Hickson Rd
Sydney NSW 2000
Australia
www.grimshaw-architects.com



BVN Architecture
Telephone +61 (0)2 9287 7200
Address Level 11
255 Pitt Street
Sydney NSW 2000
Australia
www.bvn.com.au

INTELLECTUAL PROPERTY

© Copyright Grimshaw Architects
This drawing is the property of Grimshaw Architects. All rights reserved. No part of this drawing may be reproduced or transmitted in any form or by any means electronic or mechanical, including photocopying, recording, or by any information storage and retrieval system, without prior written permission from Grimshaw Architects. This drawing is to be used for the project only and is not to be used for any other purpose. All rights reserved.

REV	DATE	FOR
1	23.02.16	D&E
2	29.02.16	D&E
3	04.03.16	D&E
4	10.03.16	consultants
5	16.03.16	D&E
6	21.03.16	D&E Approval
7	14.04.16	GE
8	14.06.16	ARUP
9	21.06.16	PLANNING ISSUE
10	26.08.16	PLANNING
11	08.03.17	

CLIENT
DEPARTMENT OF
EDUCATION

DRAWING KEY



PROJECT
Parramatta Public School

ADDRESS
(PPS)
175 Macquarie Street

(APHS)
80-100 Macquarie Street
Parramatta NSW 2150
Australia



SCALE
1:200

STATUS
PLANNING AMENDMENT

DRAWING
GENERAL ARRANGEMENT
FLOOR PLANS PPS - GA -
GROUND - CHARLES
STREET

DRAWN KN CHECKED WH AUTHORISED AC

DRAWING NUMBER A03-1101 REVISION 11

PS-SK-1034

NSW GOVERNMENT
Planning


Issued under the Environmental Planning and Assessment Act 1979

Approved Section 96 (1A) (1) (2) Modification Application
No. **MOB 3** granted on the **09 NOV 2017**

in respect to **MP 550 7237**

Signed **A. Coonan**

Sheet No. **4** of **20**

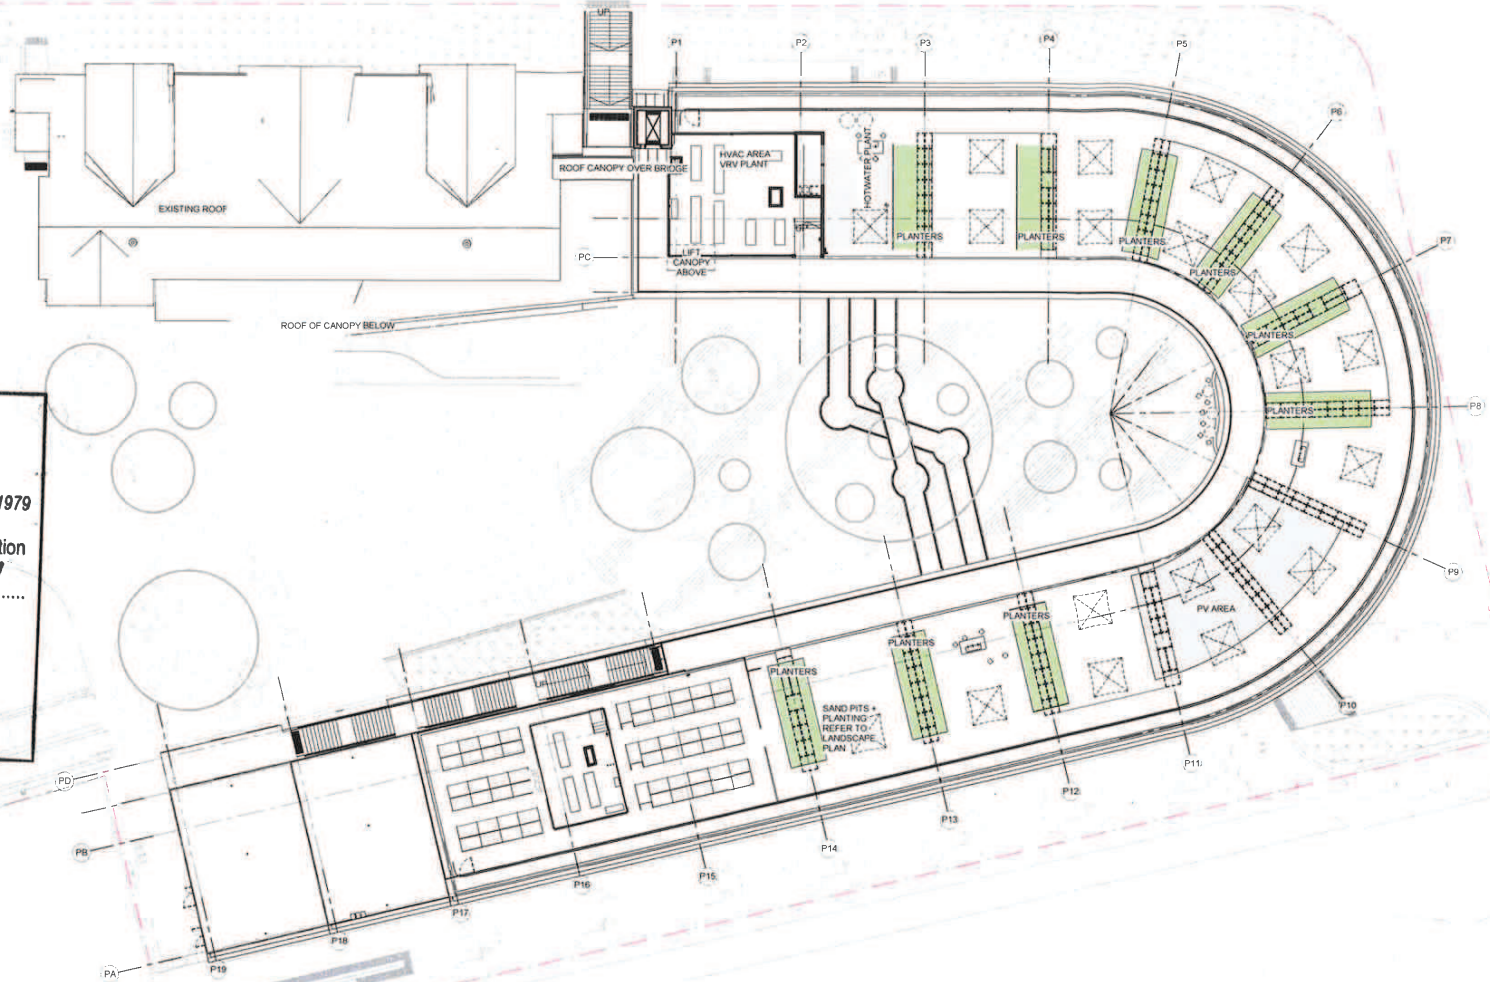

ALL DRAWINGS TO BE READ IN CONJUNCTION WITH EFSG DEPARTURE SCHEDULE,
FUNCTIONAL DESIGN BRIEF AND EDUCATIONAL FOUNDATIONS REPORTS

REVISIONS IN RESPONSE TO COMMENTS FROM SUBMISSION FROM SSD APPLICATION

GRIMSHAW

GRIMSHAW Architects
Telephone +61 (0)2 9253 0200
Address Level 3, 24 Hickson Rd
Vaucliff Bay
Sydney NSW 2000
Australia

www.grimshaw-architects.com

BVW

BVW Architecture
Telephone +61 (0)2 8297 7200
Address Level 11
255 Pitt Street
Sydney NSW 2000
Australia

www.bvw.com.au

INTELLECTUAL PROPERTY

© COPYRIGHT GRIMSHAW ARCHITECTS
ALL RIGHTS RESERVED. NO PART OF THIS DOCUMENT OR ANY CONTENTS HEREIN MAY BE REPRODUCED OR TRANSMITTED IN ANY FORM OR BY ANY MEANS, ELECTRONIC OR MECHANICAL, INCLUDING PHOTOCOPYING, RECORDING, OR BY ANY INFORMATION STORAGE AND RETRIEVAL SYSTEM, WITHOUT THE WRITTEN PERMISSION OF GRIMSHAW ARCHITECTS. THIS DOCUMENT IS THE PROPERTY OF GRIMSHAW ARCHITECTS AND IS TO BE USED ONLY FOR THE PROJECT AND SITE SPECIFICALLY IDENTIFIED HEREIN. IT IS NOT TO BE USED FOR ANY OTHER PROJECT OR SITE WITHOUT THE WRITTEN PERMISSION OF GRIMSHAW ARCHITECTS.

REV	DATE	FOR
1	23.02.16	DoE
2	29.02.16	DoE
3	04.03.16	DoE
4	10.03.16	
5	18.03.16	consultants
6	21.03.16	DoE
7	14.04.16	DoE Approval
8	14.06.16	CS
9	21.06.16	ARUP
10	26.06.16	PLANNING ISSUE
11	09.03.17	PLANNING

CLIENT
DEPARTMENT OF
EDUCATION

DRAWING KEY



PROJECT
Parramatta Public School

ADDRESS
(PPS)
175 Macquarie Street

(APHS)
80-100 Macquarie Street
Parramatta NSW 2150
Australia




SCALE
1:200

STATUS
PLANNING AMENDMENT

DRAWING
GENERAL ARRANGEMENT
FLOOR PLANS PPS - ROOF

DRAWN KN CHECKED WH AUTHORISED AC

DRAWING NUMBER A03-1105 REVISION 11

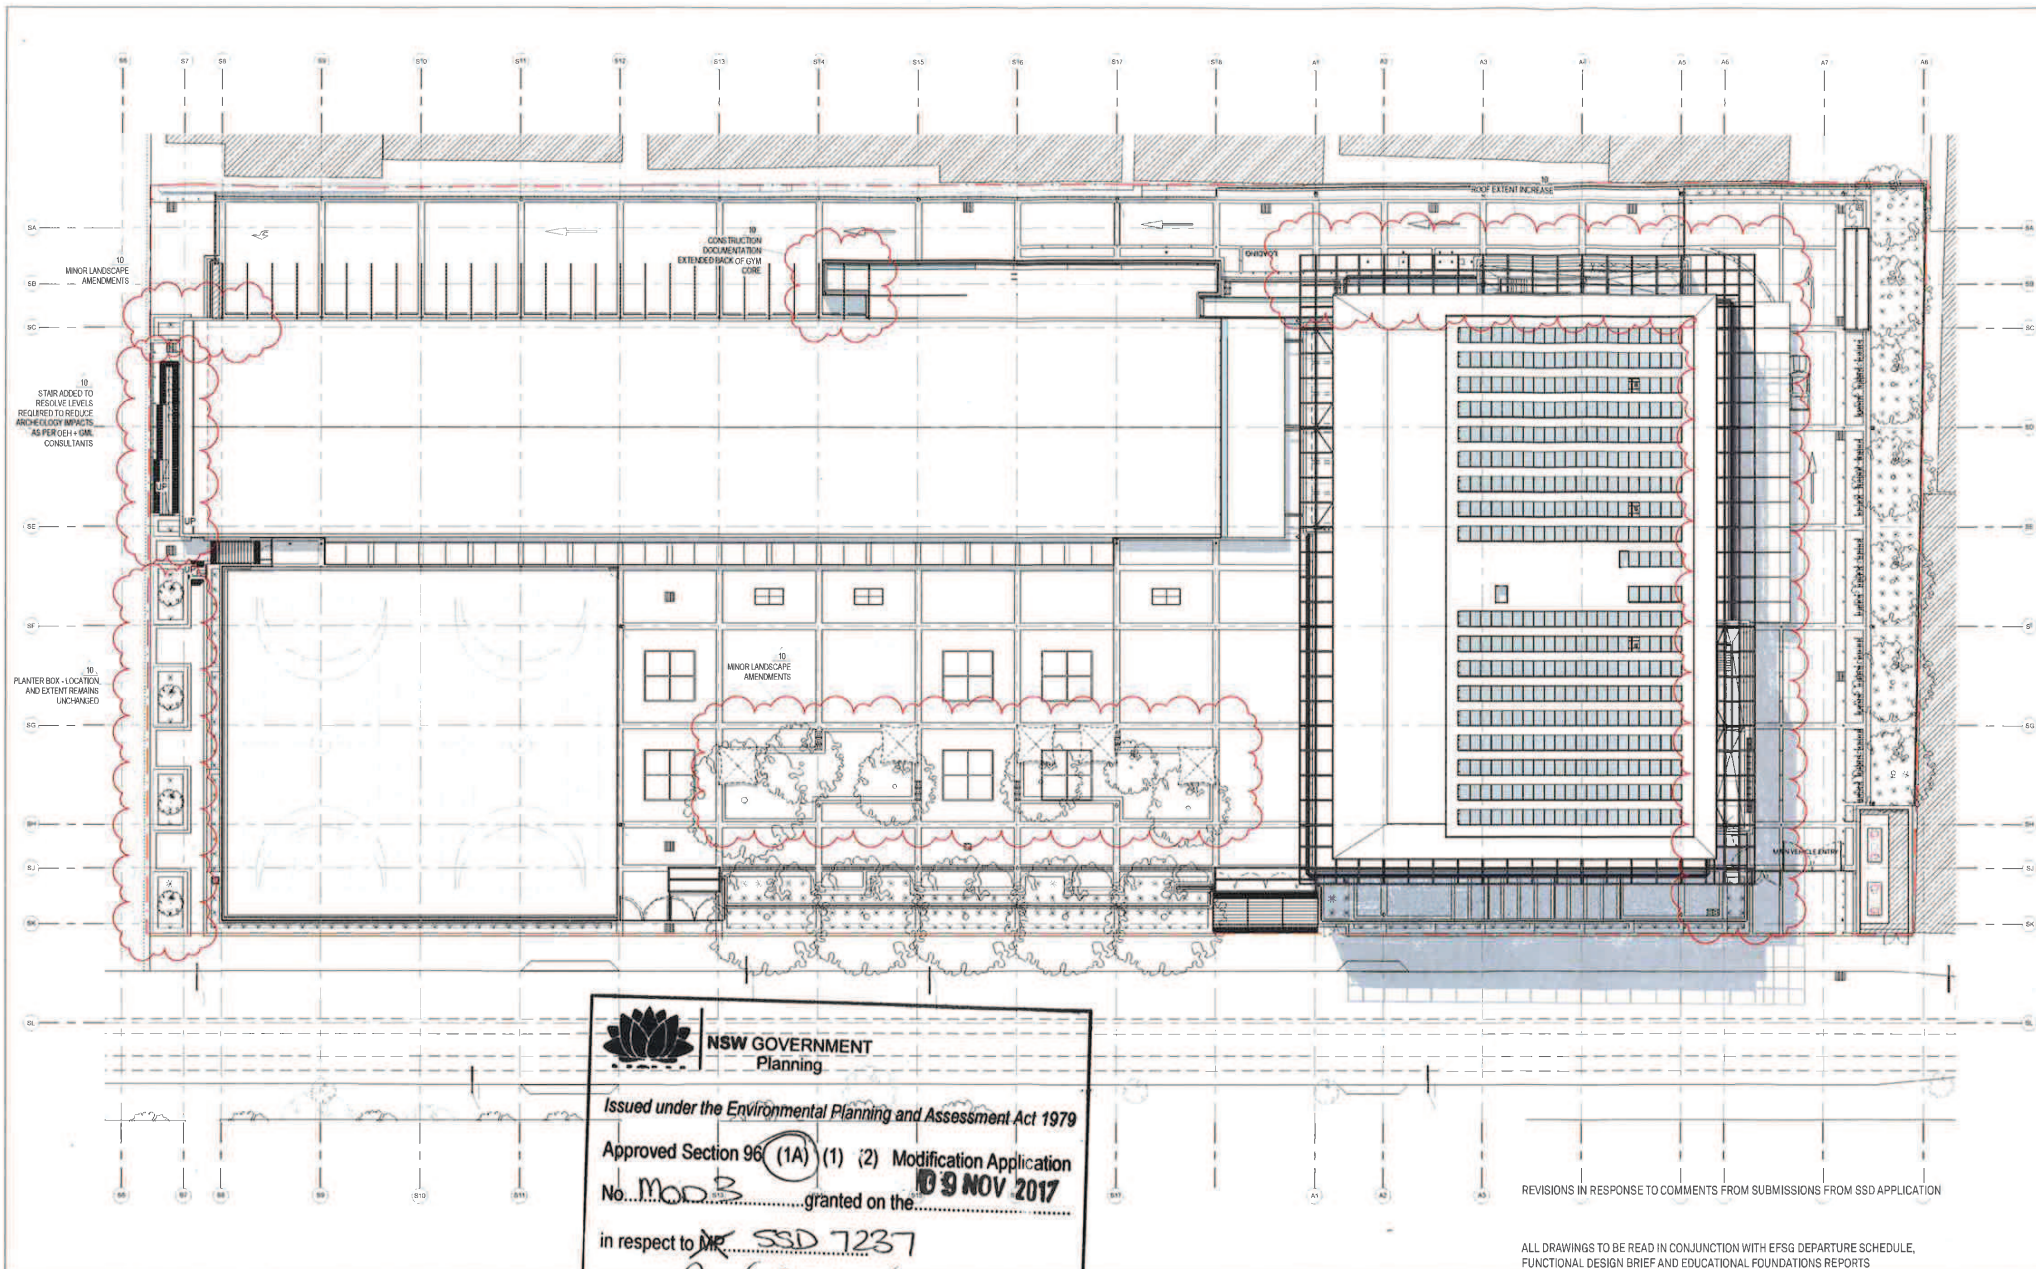

GRIMSHAW

GRIMSHAW Architects
Telephone +61 (0)2 9253 0200
Address Level 3, 24 Hickson Rd
Wahia Bay
Sydney NSW 2000
Australia



BNV Architecture
Telephone +61 (0)2 6287 7200
Address Level 11
255 Pitt Street
Sydney NSW 2000
Australia

www.grimshaw-architects.com

www.from.com.au

NSW GOVERNMENT
Planning

Issued under the Environmental Planning and Assessment Act 1979

Approved Section 96 (1A) (1) (2) Modification Application

No. MOD 3 granted on the 09 NOV 2017

in respect to ~~MR~~ SSD 7237

Signed..... A. Coman

PROPERTY	DATE	FOR
22 02 16	DoE	20

1	11 03 16	DoE
2	01 10 16	DoE
3	12 04 16	DoE APPROVAL
4	16 04 16	DoE APPROVAL

5	12-04-16	PLANNING DRAFT
6	02-05-16	PLANNING ISSUE
7	14-06-16	QS
8	25-08-16	PLANNING ISSUE

9	22.11.16	PLANNING ISSUE
10	01.08.17	PLANNING AMENDMENT

100

CLIENT
Department of Education

GRISHAW PROJECT NO.
15091

DRAWING KEY

PROJECT
APHS

ADDRESS
(PPS)

(APHS)
80-100 Macquarie Street
Parramatta NSW 2150
Australia



SCALE AT A
1 : 250

STATUS:
PLANNING AMENDMENT

DRAWING
SITE PLANS APHS - GA
ROOF

DRAWN	CHECKED	AUTHORISED
GAS	EE / LJ	LB

DRAWING NUMBER	REVISION
A02-1020	10



NSW GOVERNMENT
Planning

Issued under the Environmental Planning and Assessment Act 1979


Approved Section 96 (1A) (1) (2) Modification Application

No. MOD 3 granted on the 09 NOV 2017

in respect to MP SSD 7237

Signed A. Colman

Sheet No. 6 of 20

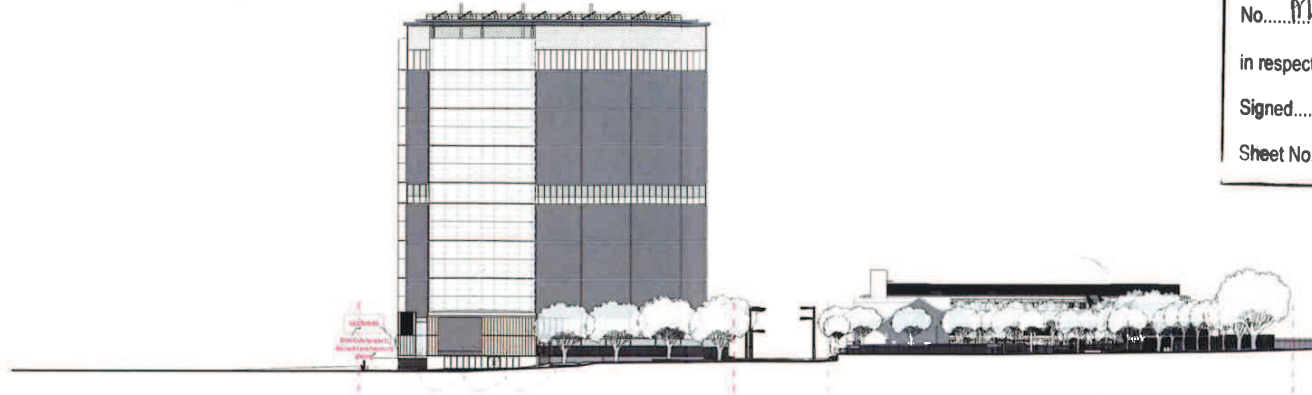

2 CONTEXT_ELEVATION_WEST
1:500



1 CONTEXT_ELEVATION_EAST
1:500

REVISIONS IN RESPONSE TO COMMENTS FROM SUBMISSIONS FROM SSD APPLICATION

ALL DRAWINGS TO BE READ IN CONJUNCTION WITH EFSG DEPARTURE SCHEDULE,
FUNCTIONAL DESIGN BRIEF AND EDUCATIONAL FOUNDATIONS REPORTS

GRIMSHAW

GRIMSHAW Architects
Telephone +61 (0)2 9253 0200
Address Level 3, 24 Hickson Rd
Sydney NSW 2000
Australia
www.grimshaw-architects.com



BVN Architecture
Telephone +61 (0)2 6297 7200
Address Level 11
200 Pitt Street
Sydney NSW 2000
Australia
www.bvn.com.au

INTELLECTUAL PROPERTY

GRIMSHAW ARCHITECTS AND BVN ARCHITECTURE
OWN THE COPYRIGHT AND ALL RIGHTS TO
THESE DRAWINGS AND ALL RIGHTS TO
THESE DRAWINGS. NO PART OF THESE
DRAWINGS MAY BE REPRODUCED OR
TRANSMITTED IN ANY FORM OR BY
ANY MEANS, WITHOUT THE WRITTEN
CONSENT OF GRIMSHAW ARCHITECTS
AND BVN ARCHITECTURE.

REV	DATE	FOR
1	22.02.16	D&E
2	04.03.16	D&E
3	11.03.16	D&E
4	15.03.16	ARUP
5	21.03.16	D&E
6	04.04.16	Aspect
7	12.04.16	D&E APPROVAL
8	15.04.16	PLANNING DRAFT
9	02.05.16	PLANNING ISSUE
10	14.06.16	CD
11	25.08.16	PLANNING ISSUE
12	08.03.17	PLANNING

CLIENT
Department of Education

GRIMSHAW PROJECT NO.
15091

DRAWING KEY



PROJECT
APHS

ADDRESS
(PPS)
175 Macquarie Street

(APHS)
80-100 Macquarie Street
Parramatta NSW 2150
Australia


NORTH
SCALE WAS
1:500

STATUS
PLANNING AMENDMENT


DRAWING
ELEVATIONS CONTEXT -
PPS & APHS - EAST AND
WEST ELEVATION

DRAWN CHECKED AUTHORISED
GAS EE / LJ LB

DRAWING NUMBER REVISION
A06-1001 12

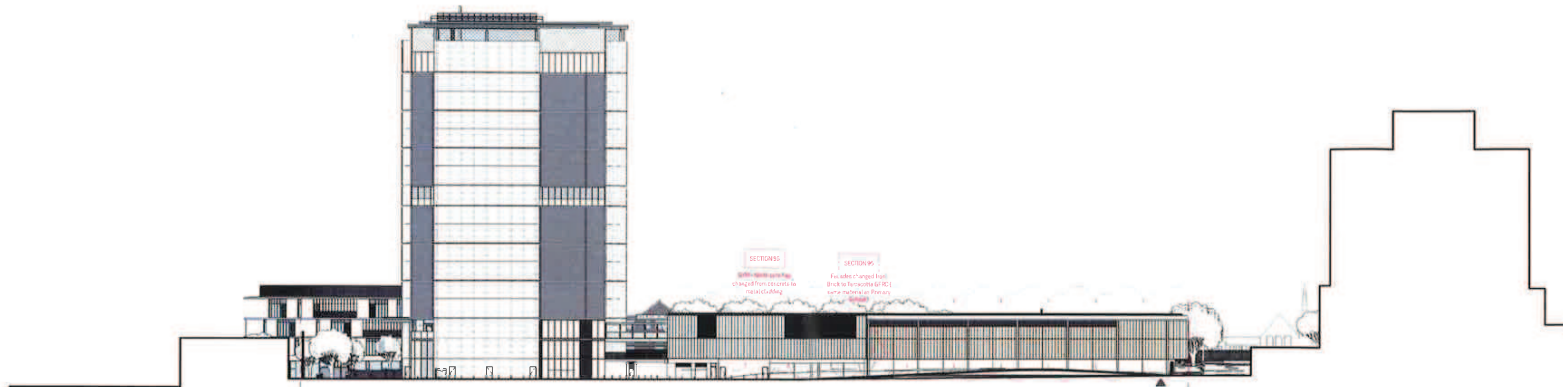

2 CONTEXT_ELEVATION_NORTH
1:500

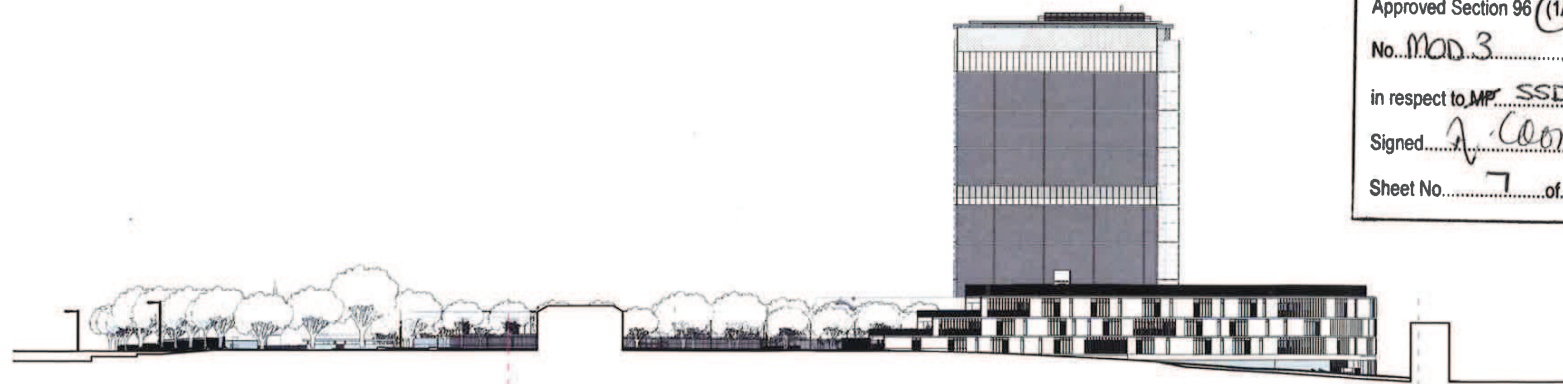

1 CONTEXT_ELEVATION_SOUTH
1:500



NSW GOVERNMENT
Planning

Issued under the Environmental Planning and Assessment Act 1979

Approved Section 96 (1A) (1) (2) Modification Application

No. MOD 3 granted on the **09 NOV 2017**

in respect to MP SSD 7237

Signed A. Coonan

Sheet No. 7 of 20

REVISIONS IN RESPONSE TO COMMENTS FROM SUBMISSIONS FROM SSD APPLICATION

ALL DRAWINGS TO BE READ IN CONJUNCTION WITH EPSG DEPARTURE SCHEDULE,
FUNCTIONAL DESIGN BRIEF AND EDUCATIONAL FOUNDATIONS REPORTS

GRIMSHAW

GRIMSHAW Architects
Telephone +61 (0)2 9293 0000
Address Level 3, 24 Hickson Rd
Vaucluse NSW 2000
Australia

www.grimshaw-architects.com

BVN

BVN Architecture
Telephone +61 (0)2 9297 7200
Address Level 11
255 Pitt Street
Sydney NSW 2000
Australia

www.bvn.com.au

INTELLECTUAL PROPERTY

GRIMSHAW ARCHITECTS
AND BVN ARCHITECTURE ARE NOT TO BE
USED TO PROMOTE OR ENDORSE ANY
PRODUCTS OR SERVICES WITHOUT THE
WRITTEN PERMISSION OF GRIMSHAW
ARCHITECTS AND BVN ARCHITECTURE.
ANY UNAUTHORIZED USE OF THIS DOCUMENT IS AT THE
USER'S RISK AND WITHOUT LIABILITY TO GRIMSHAW
ARCHITECTS AND BVN ARCHITECTURE.

REV	DATE	FOR
1	22.02.16	D/E
2	04.03.16	D/E
3	11.03.16	D/E
4	15.03.16	ARUP
5	21.03.16	D/E
6	04.04.16	Amend
7	12.04.16	D/E APPROVAL
8	15.04.16	PLANNING DRAFT
9	02.05.16	PLANNING ISSUE
10	14.06.16	CD
11	25.06.16	PLANNING ISSUE
12	08.03.17	PLANNING

CLIENT
Department of Education

GRIMSHAW PROJECT NO.
15091

DRAWING KEY



PROJECT
APHS

ADDRESS
(PPS)
175 Macquarie Street

(APHS)
80-100 Macquarie Street
Parramatta NSW 2150
Australia

NORTH

SCALE 1:500

STATUS
PLANNING AMENDMENT

DRAWING
CONTEXT - PPS & APHS
- NORTH AND SOUTH
ELEVATION

DRAWN BY
GAS
CHECKED BY
EE / LJ
AUTHORISED BY
LB

DRAWING NUMBER
A06-1002
REVISION
12



NSW GOVERNMENT
Planning

Issued under the Environmental Planning and Assessment Act 1979


Approved Section 96 (1A) (1) (2) Modification Application

No. MOD 3 granted on the 09 NOV 2017

in respect to MP SSD 7237

Signed A. Coman

Sheet No. 8 of 20

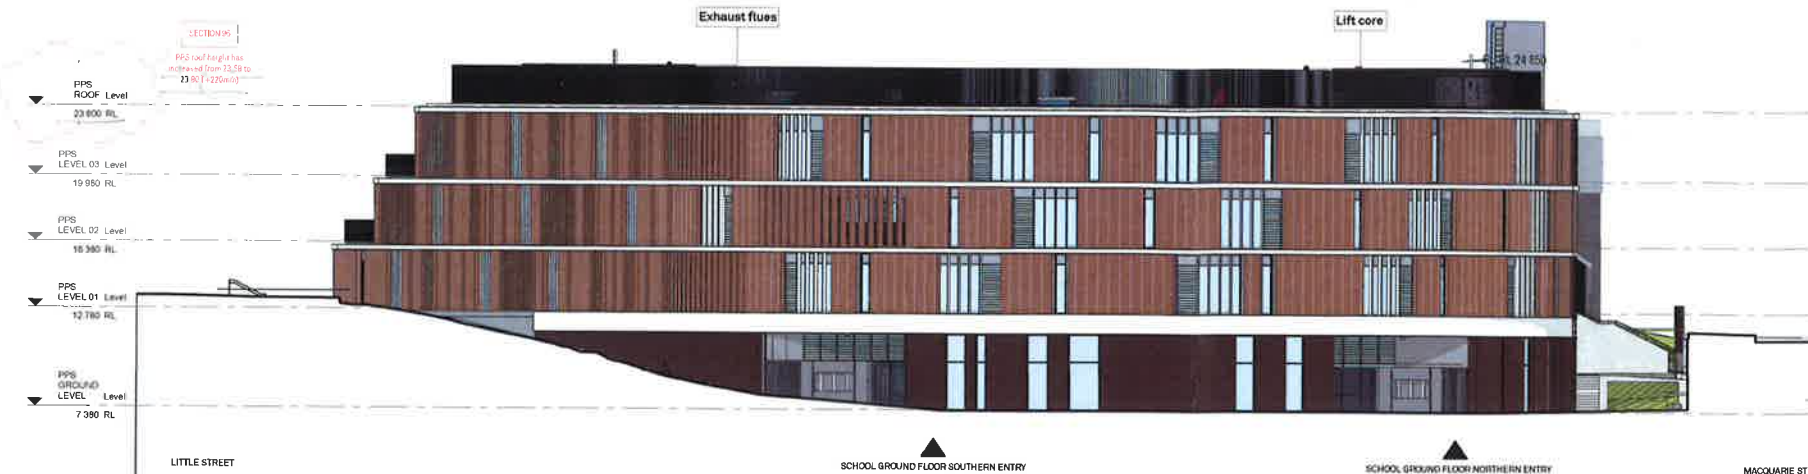

ELEVATION CHARLES STREET

1
1:200



ELEVATION LITTLE STREET

2
1:200



ELEVATION MAQUARIE STREET

3
1:200

REVISIONS IN RESPONSE TO COMMENTS FROM SUBMISSION FROM SSD APPLICATION

GRIMSHAW

GRIMSHAW Architects
Telephone +61 (0)2 9253 0200
Address Level 3, 24 Hickson Rd
Wahai Bay
Sydney NSW 2000
Australia

www.grimshaw-architects.com



BVN Architecture
Telephone +61 (0)2 8267 7200
Address Level 11
255 Pitt Street
Sydney NSW 2000
Australia

www.bvn.com.au


INTELLECTUAL PROPERTY

© COPYRIGHT GRIMSHAW ARCHITECTS. ALL RIGHTS TO USE THIS DOCUMENT ARE SUBJECT TO PAYMENT IN FULL OF ALL GRIMSHAW CHARGES. THIS DOCUMENT MAY ONLY BE USED FOR THE EXPRESS PURPOSE AND PROJECT FOR WHICH IT HAS BEEN CREATED AND DELIVERED. AS NOTIFIED IN WRITING BY GRIMSHAW AND THIS DOCUMENT MAY NOT BE OTHERWISE USED, COPIED, ADAPTED, REPRODUCED OR TRANSMITTED IN ANY FORM OR BY ANY MEANS, WITHOUT THE WRITTEN PERMISSION OF GRIMSHAW ARCHITECTS. FROM AND AGAINST ALL LOSS OR DAMAGE.

REV	DATE	FOR
1	23.02.18	DoE
2	04.03.18	DoE
3	10.03.18	
4	16.03.18	consultants
5	21.03.18	DoE
6	14.04.18	DoE Approval
7	14.06.18	OS
8	26.08.18	PLANNING ISSUE
9	08.03.17	PLANNING

CLIENT
DEPARTMENT OF
EDUCATION

DRAWING KEY

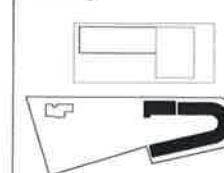

PROJECT
Parramatta Public School

ADDRESS
(PPS)
175 Macquarie Street

(APHS)
80-100 Macquarie Street
Parramatta NSW 2150
Australia

NORTH



SCALE
1:200

STATUS
PLANNING AMENDMENT

DRAWING
ELEVATIONS PPS - STREET
ELEVATIONS

DRAWN CHECKED AUTHORISED
JHD WH AC

DRAWING NUMBER REVISION
A06-1101 9



NSW GOVERNMENT
Planning

Issued under the Environmental Planning and Assessment Act 1979

Approved Section 96 (1A) (1) (2) Modification Application

No. MOD 3 granted on the 09 NOV 2017

in respect to MP SSD 7237

Signed: J. Coonan

Sheet No. 9 of 20



COURTYARD ELEVATION 1

1 1:200



COURTYARD ELEVATION 2

2 1:200

REVISIONS IN RESPONSE TO COMMENTS FROM SUBMISSION FROM SSD APPLICATION

GRIMSHAW

GRIMSHAW Architects
Telephone +61 (0)2 9253 0200
Address Level 3, 24 Hickson Rd
Sydney NSW 2000
Australia

www.grimshaw-architects.com

BVN

BVN Architecture
Telephone +61 (0)2 9297 7200
Address Level 11
255 Pitt Street
Sydney NSW 2000
Australia

www.bvn.com.au


INTELLECTUAL PROPERTY

© COPYRIGHT GRIMSHAW ARCHITECTS
UNLESS OTHERWISE AGREED IN WRITING, ALL RIGHTS TO
USE THIS DOCUMENT ARE SUBJECT TO PAYMENT IN FULL
OF ALL GRIMSHAW CHARGES. THIS DOCUMENT MAY ONLY
BE USED FOR THE EXPRESS PURPOSE AND PROJECT FOR
WHICH IT HAS BEEN CREATED AND DELIVERED. AS
NOTED IN WRITING BY GRIMSHAW, AND THIS
DOCUMENT MAY NOT BE OTHERWISE USED, OR COPIED
ANY UNAUTHORIZED USE OF THIS DOCUMENT IS AT THE
USER'S SOLE RISK AND WITHOUT LIMITING GRIMSHAW'S
RIGHTS THE USER RELEASES AND HOLDS GRIMSHAW
FROM AND AGAINST ALL LOSS OR ARISING

REV.	DATE	FOR
1	23.02.16	DoE
2	04.03.16	DoE
3	10.03.16	
4	18.03.16	consultants
5	21.03.16	DoE
6	14.04.16	DoE Approval
7	14.06.16	QS
8	26.06.16	PLANNING ISSUE
9	08.02.17	PLANNING

CLIENT
DEPARTMENT OF
EDUCATION

DRAWING KEY

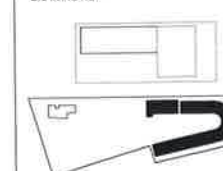

PROJECT
Parramatta Public School

ADDRESS
(PPS)
175 Macquarie Street

(APHS)
80-100 Macquarie Street
Parramatta NSW 2150
Australia

NORTH



SCALE
1:200

STATUS
PLANNING AMENDMENT

DRAWING
ELEVATIONS PPS -
COURTYARD ELEVATIONS &
SECTIONS

DRAWN	CHECKED	AUTHORISED
JHD	WH	AC

DRAWING NUMBER	REVISION
A06-1102	9



NSW GOVERNMENT
Planning

Issued under the Environmental Planning and Assessment Act 1979

Approved Section 96 (1A) (1) (2) Modification Application

No. MOD 3 granted on the 09 NOV 2017

in respect to MP SSD 7237

Signed A. Cosman

Sheet No. 10 of 20

13
Facades changed from brick
to Terracotta GFRC




PARRAMATTA PUBLIC SCHOOL

MACQUARIE STREET

PRIMARY ENTRANCE

SERVICE LAVE

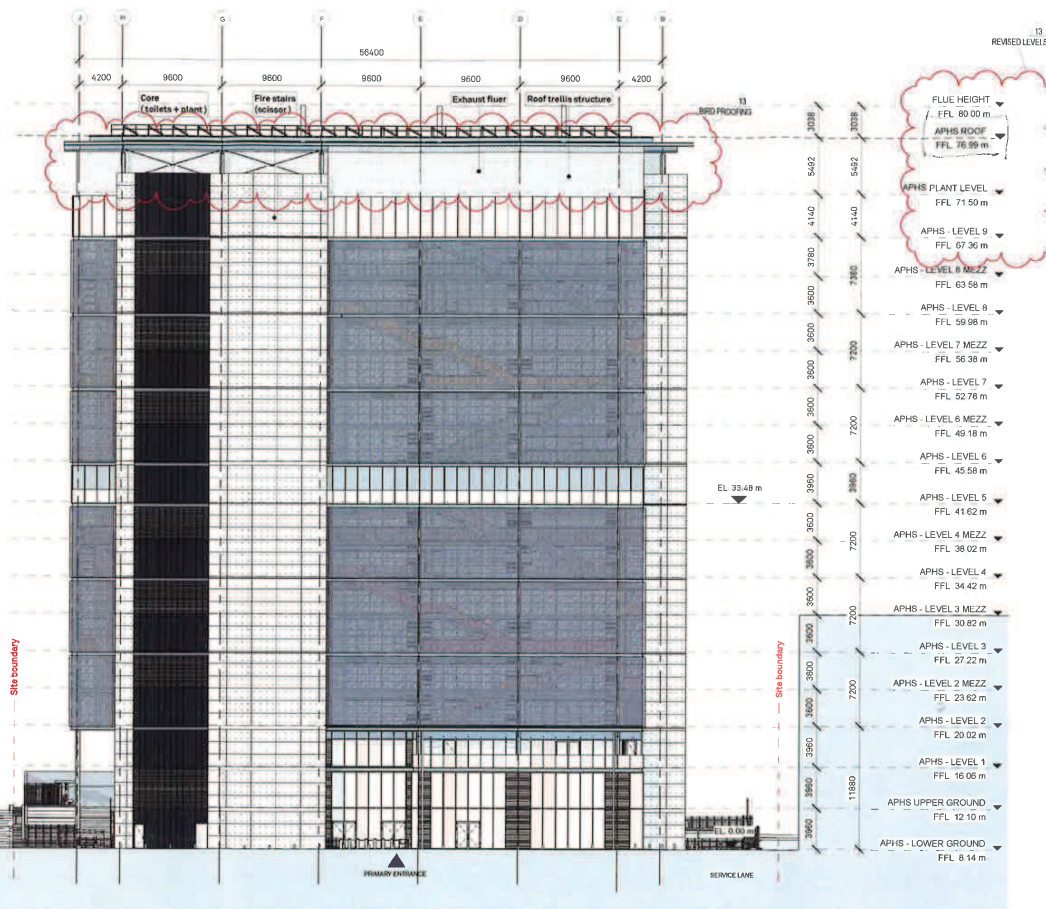

REVISIONS IN RESPONSE TO COMMENTS FROM SUBMISSIONS FROM SSD APPLICATION

ALL DRAWINGS TO BE READ IN CONJUNCTION WITH EFSG DEPARTURE SCHEDULE,
FUNCTIONAL DESIGN BRIEF AND EDUCATIONAL FOUNDATIONS REPORTS

GRIMSHAW

GRIMSHAW Architects
Telephone +61 (0)2 9253 0200
Address Level 3, 24 Hickson Rd
Vaucliff Bay
Sydney NSW 2000
Australia

www.grimshaw-architects.com

BVN


BVN Architecture
Telephone +61 (0)2 8257 7200
Address Level 11
255 Pitt Street
Sydney NSW 2000
Australia

www.bvn.com.au

INTELLECTUAL PROPERTY

©2017 GRIMSHAW ARCHITECTS AND BVN ARCHITECTURE. ALL RIGHTS RESERVED. THIS DOCUMENT IS THE PROPERTY OF GRIMSHAW ARCHITECTS AND BVN ARCHITECTURE. IT IS TO BE USED ONLY FOR THE PROJECT AND SITE SPECIFICALLY IDENTIFIED. IT IS NOT TO BE REPRODUCED, COPIED, OR OTHERWISE USED FOR ANY OTHER PROJECT OR SITE WITHOUT THE WRITTEN PERMISSION OF GRIMSHAW ARCHITECTS AND BVN ARCHITECTURE. THIS DOCUMENT IS THE PROPERTY OF GRIMSHAW ARCHITECTS AND BVN ARCHITECTURE. IT IS TO BE USED ONLY FOR THE PROJECT AND SITE SPECIFICALLY IDENTIFIED. IT IS NOT TO BE REPRODUCED, COPIED, OR OTHERWISE USED FOR ANY OTHER PROJECT OR SITE WITHOUT THE WRITTEN PERMISSION OF GRIMSHAW ARCHITECTS AND BVN ARCHITECTURE.

REV.	DATE	FOR
2	04 03 16	DoE
3	11 03 16	DoE
4	15 01 16	ARUP
5	21 03 16	DoE
6	04 06 16	Aspect
7	12 04 16	DIE APPROVAL
8	15 04 16	PLANNING DRAFT
9	02 05 16	PLANNING ISSUE
10	14 06 16	OS
11	29 08 16	PLANNING ISSUE
12	08 05 17	PLANNING
13	01 06 17	PLANNING AMENDMENT

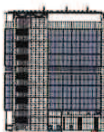

- Type A - perforated metal louvers
- Type B - perforated metal louvers
- Type C - glass louvers
- Type D - glass louvers
- Perforated metal panels
- Concrete panels
- Glass screens (alight glazed)
- Solid insulated

CLIENT
Department of Education

GRIMSHAW PROJECT NO
16091

DRAWING KEY



PROJECT
APHS

ADDRESS
(PPS)
175 Macquarie Street

(APHS)
80-100 Macquarie Street
Parramatta NSW 2150
Australia

NORTH

SCALE AT A1
As indicated

STATUS
PLANNING AMENDMENT

DRAWING
ELEVATIONS APHS - EAST
ELEVATION

DRAWN CHECKED AUTHORIZED
GAS EE / LJ LB

DRAWING NUMBER REVISION
A06-1201 13



NSW GOVERNMENT
Planning

Issued under the Environmental Planning and Assessment Act 1979


Approved Section 96 (1A) (1) (2) Modification Application

No. MOD 3 granted on the 09 NOV 2017

in respect to MP SSD 7237

Signed J. L. L. L.

Sheet No. 11 of 20

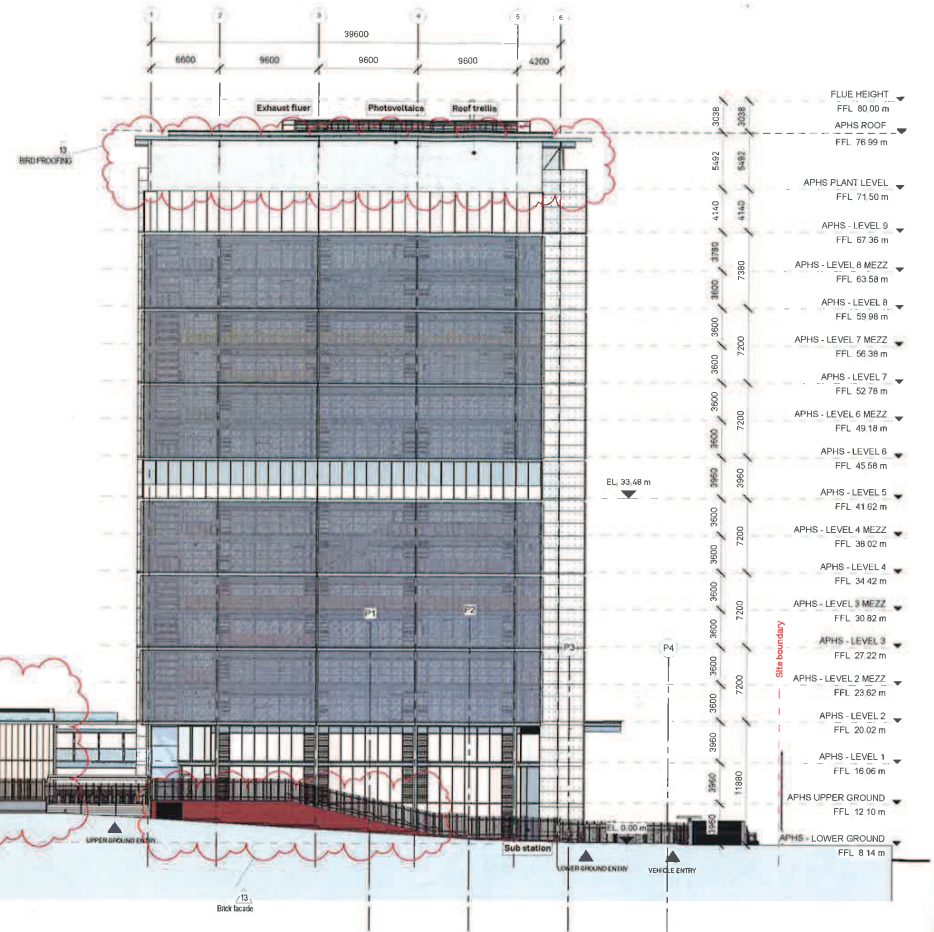

REVISIONS IN RESPONSE TO COMMENTS FROM SUBMISSIONS FROM SSD APPLICATION

ALL DRAWINGS TO BE READ IN CONJUNCTION WITH EMSG DEPARTURE SCHEDULE, FUNCTIONAL DESIGN BRIEF AND EDUCATIONAL FOUNDATIONS REPORTS

GRIMSHAW

GRIMSHAW Architects
Telephone +61 (0)2 9253 0200
Address Level 2, 24 Hickson Rd
Vaucluse NSW 2000
Australia

www.grimshaw-architects.com

BVN

BVN Architecture
Telephone +61 (0)2 8297 7200
Address Level 11
255 Pitt Street
Sydney NSW 2000
Australia

www.bvn.com.au

INTELLECTUAL PROPERTY

© COPYRIGHT GRIMSHAW ARCHITECTS
UNLESS OTHERWISE ADVISED IN WRITING, ALL RIGHTS IN
THIS DOCUMENT ARE RESERVED. NO PART OF THIS DOCUMENT
OR ANY OF ITS CONTENTS MAY BE REPRODUCED OR
TRANSMITTED IN ANY FORM OR BY ANY MEANS
ELECTRONIC OR MECHANICAL, INCLUDING PHOTOCOPYING,
RECORDING, OR BY ANY INFORMATION STORAGE AND
RETRIEVAL SYSTEM, WITHOUT PERMISSION IN WRITING
FROM GRIMSHAW ARCHITECTS.

REV	DATE	FOR
2	04.03.16	D/E
3	11.03.16	D/E
4	15.03.16	ARUP
5	21.03.16	D/E
6	04.04.16	APHS
7	12.04.16	D/E APPROVAL
8	15.04.16	PLANNING DRAFT
9	02.05.16	PLANNING ISSUE
10	14.06.16	QS
11	23.08.16	PLANNING ISSUE
12	08.03.17	PLANNING
13	01.05.17	PLANNING AMENDMENT

- Type A - perforated metal louvers
- Type B - perforated metal louvers
- Type C - glass louvers
- Type D - glass louvers
- Perforated metal panels
- Concrete panels
- Glazed screens (single glazed)
- Solid insulated



CLIENT
Department of Education

GRIMSHAW PROJECT NO
15091

DRAWING KEY



PROJECT
APHS

ADDRESS
(PPS)
175 Macquarie Street

(APHS)
80-100 Macquarie Street
Parramatta NSW 2150
Australia

NORTH

SCALE AT A1
As indicated

STATUS
PLANNING AMENDMENT

DRAWING
ELEVATIONS APHS - SOUTH
ELEVATION

DRAWN
GAS

REVISION
13



NSW GOVERNMENT
Planning

Issued under the Environmental Planning and Assessment Act 1979


Approved Section 96 (1A) (1) (2) Modification Application

No. MOD 3 granted on the 09 NOV 2017

in respect to MP SSD 7237

Signed: J. C. C. C.

Sheet No. 12 of 20

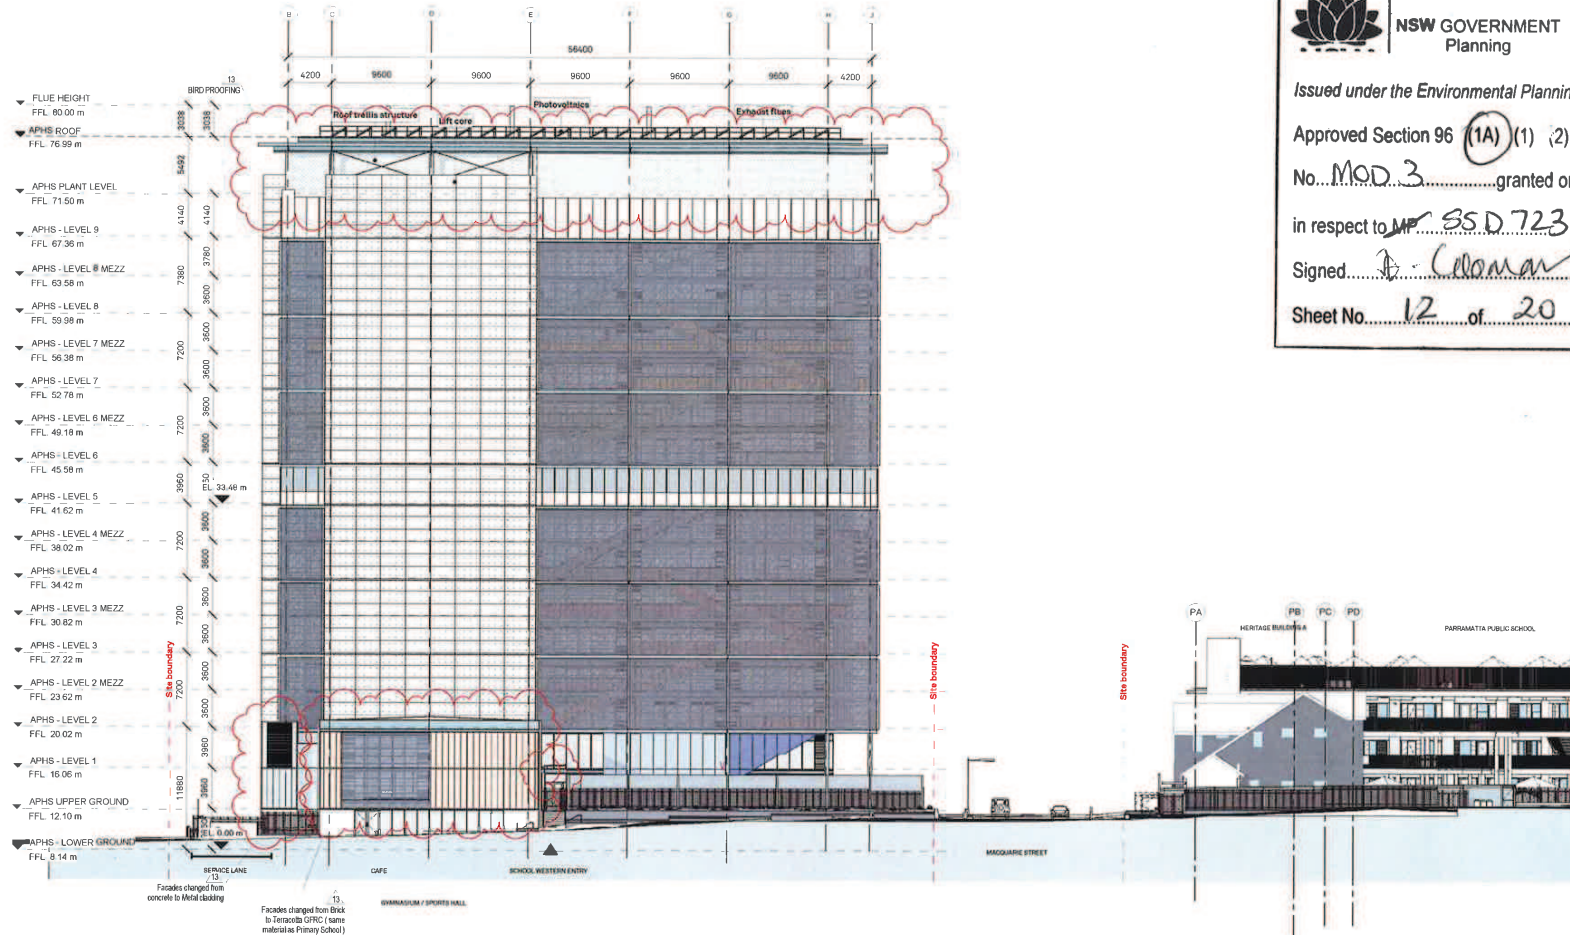

REVISIONS IN RESPONSE TO COMMENTS FROM SUBMISSIONS FROM SSD APPLICATION

ALL DRAWINGS TO BE READ IN CONJUNCTION WITH EMSG DEPARTMENT SCHEDULE,
FUNCTIONAL DESIGN BRIEF AND EDUCATIONAL FOUNDATIONS REPORTS

GRIMSHAW

GRIMSHAW Architects
Telephone +61 (0)2 9253 0200
Address Level 3, 24 Hickson Rd
Vaucluse NSW 2000
Australia

www.grimshaw-architects.com

BVN


BVN Architects
Telephone +61 (0)2 8287 7200
Address Level 11
255 Pitt Street
Sydney NSW 2000
Australia

www.bvn.com.au

INTELLECTUAL PROPERTY

© COPYRIGHT GRIMSHAW ARCHITECTS
ALL RIGHTS RESERVED. NO PART OF THIS DOCUMENT MAY BE REPRODUCED OR TRANSMITTED IN ANY FORM OR BY ANY MEANS, ELECTRONIC OR MECHANICAL, INCLUDING PHOTOCOPYING, RECORDING, OR BY ANY INFORMATION STORAGE AND RETRIEVAL SYSTEM, WITHOUT PERMISSION IN WRITING FROM GRIMSHAW ARCHITECTS. ANY UNAUTHORIZED USE OF THIS DOCUMENT IS AT THE USER'S SOLE RISK AND GRIMSHAW ARCHITECTS WILL BE RESPONSIBLE FOR ANY SUCH UNAUTHORIZED USE.

REV	DATE	FOR
2	04 03 16	DeE
3	11 03 16	DeE
4	15 03 16	ARUP
5	21 03 16	DeE
6	04 04 16	Alipet
7	12 04 16	DIE APPROVAL
8	15 04 16	PLANNING DRAFT
9	02 05 16	PLANNING ISSUE
10	14 06 16	GS
11	25 08 16	PLANNING ISSUE
12	08 03 17	PLANNING
13	01 08 17	PLANNING AMENDMENT

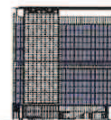

CLIENT
Department of Education

GRIMSHAW PROJECT NO
15091

DRAWING KEY



PROJECT
APHS

ADDRESS
(PPS)
175 Macquarie Street

(APHS)
80-100 Macquarie Street
Parramatta NSW 2150
Australia

NORTH

SCALE AT A1
As indicated

STATUS
PLANNING AMENDMENT

DRAWING
ELEVATIONS APHS - WEST
ELEVATION

DRAWN
GAS

DRAWING NUMBER
A06-1203

REVISION
13



NSW GOVERNMENT
Planning


Issued under the Environmental Planning and Assessment Act 1979

Approved Section 96 (1A) (1) (2) Modification Application
No. Mod 3 granted on the 09 NOV 2017

in respect to MP SSD 7237

Signed H. Coonan

Sheet No. 13 of 20

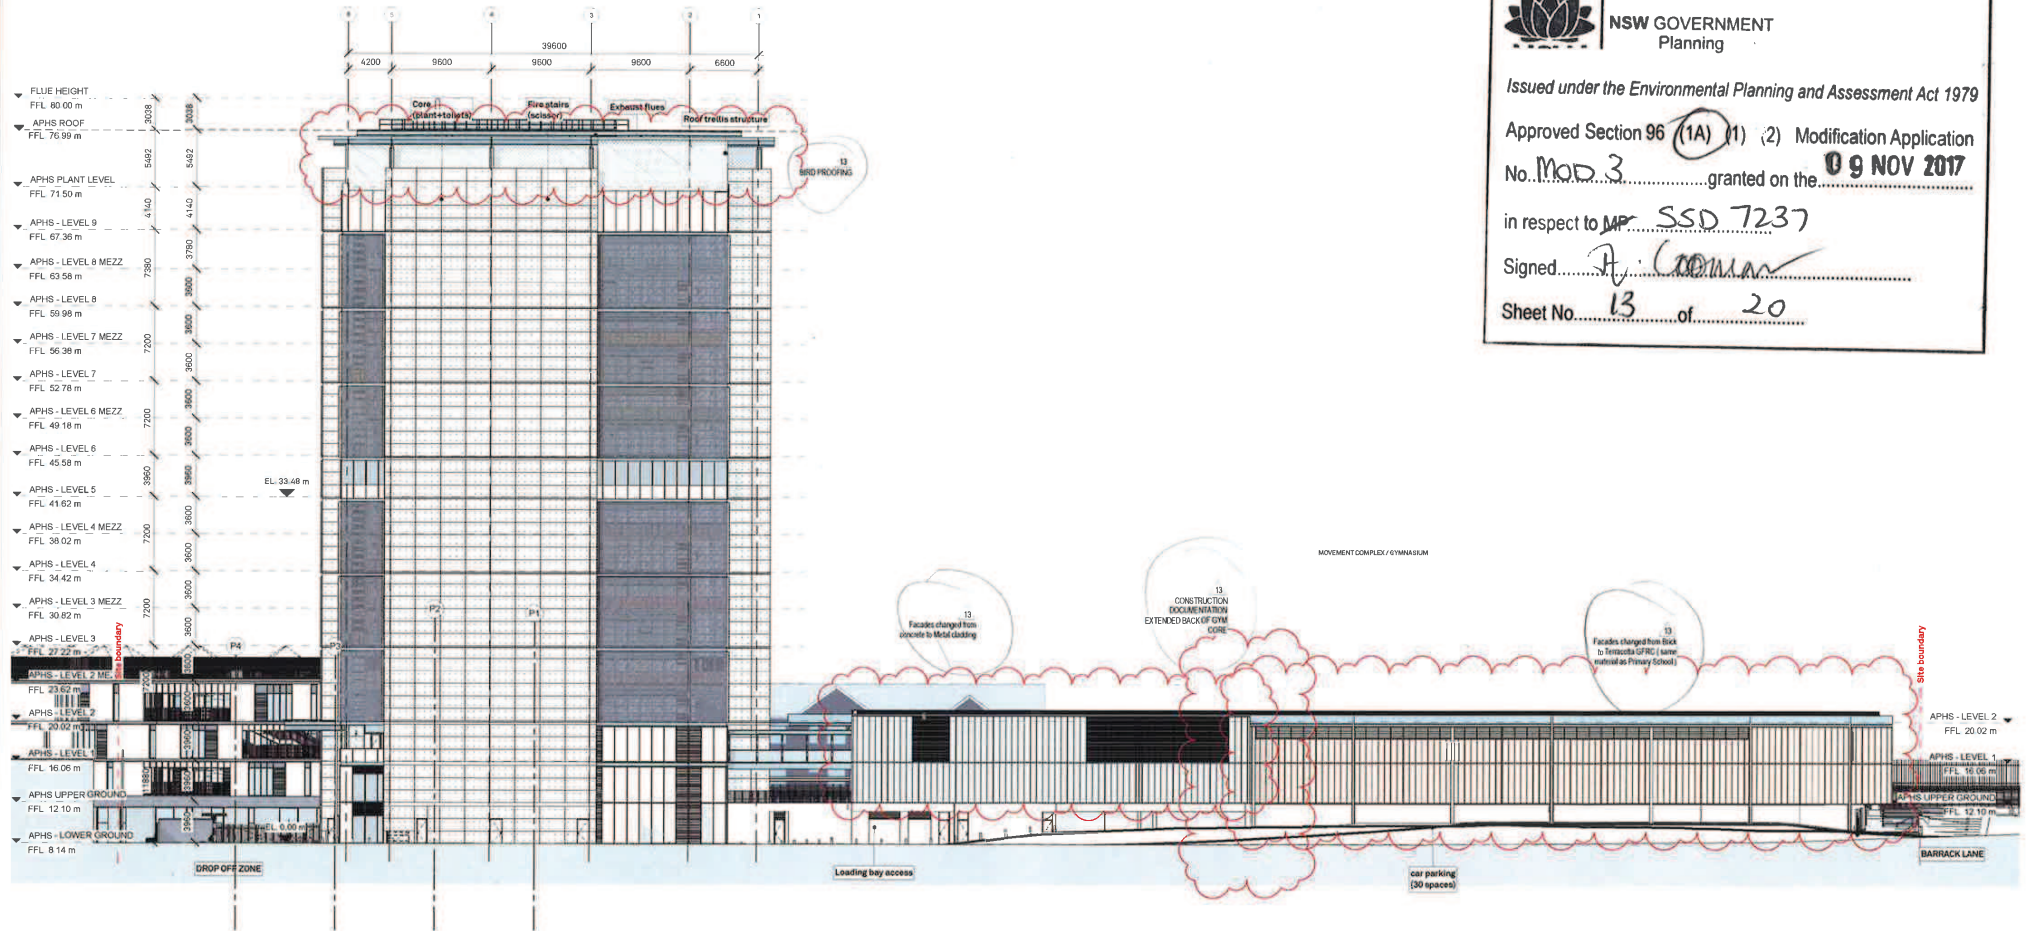

REVISIONS IN RESPONSE TO COMMENTS FROM SUBMISSIONS FROM SSD APPLICATION

ALL DRAWINGS TO BE READ IN CONJUNCTION WITH EPSG DEPARTURE SCHEDULE,
FUNCTIONAL DESIGN BRIEF AND EDUCATIONAL FOUNDATIONS REPORTS

GRIMSHAW

GRIMSHAW Architects
Telephone +61 (0)2 9253 0200
Address Level 3, 24 Hickson Rd
Vaucluse NSW 2000
Australia
www.grimshawarchitects.com

BVN

BVN Architecture
Telephone +61 (0)2 6297 7200
Address Level 11
288 Pitt St (West)
Sydney NSW 2000
Australia
www.bvn.com.au

INTELLECTUAL PROPERTY

© Copyright Grimshaw Architects
Barrack Lane Education Precinct (Barrack Lane Education Precinct) is a project of the NSW Government. All rights in this document are reserved by the NSW Government. No part of this document may be reproduced or transmitted in any form or by any means electronic or mechanical, including photocopying, recording, or by any information storage or retrieval system, without prior written permission from the NSW Government. This document is the property of the NSW Government and is loaned to you for your use only. It is to be returned to the NSW Government when no longer required. The NSW Government does not warrant the accuracy or completeness of the information contained in this document. The NSW Government is not responsible for any loss or damage arising from the use of this document. The NSW Government is not responsible for any loss or damage arising from the use of this document.

REV	DATE	FOR
2	04 03 16	D/E
3	11 03 16	D/E
4	15 03 16	ASUP
5	21 03 16	D/E
6	04 04 16	ASUP
7	12 04 16	D/E APPROVAL
8	15 04 16	PLANNING DRAFT
9	02 05 16	PLANNING ISSUE
10	14 06 16	GS
11	25 06 16	PLANNING ISSUE
12	06 07 17	PLANNING
13	01 08 17	PLANNING AMENDMENT



CLIENT
Department of Education

GRIMSHAW PROJECT NO.
15091

DRAWING KEY



PROJECT
APHS

ADDRESS
(PPS)
175 Macquarie Street

(APHS)
80-100 Macquarie Street
Parramatta NSW 2150
Australia

NORTH

SCALE AT A1
As Indicated

STATUS
PLANNING AMENDMENT

DRAWING
ELEVATIONS APHS - NORTH
ELEVATION

DRAWN
GAS

CHECKED
EE / LJ

AUTHORISED
LB

DRAWING NUMBER
A06-1204


REVISION
13



Approved Section 96 (1A) (1) (2) Modification Application
No. MOD 3 granted on the 09 NOV 2017

Signed..... A. Coleman

Sheet No. 14 of 20

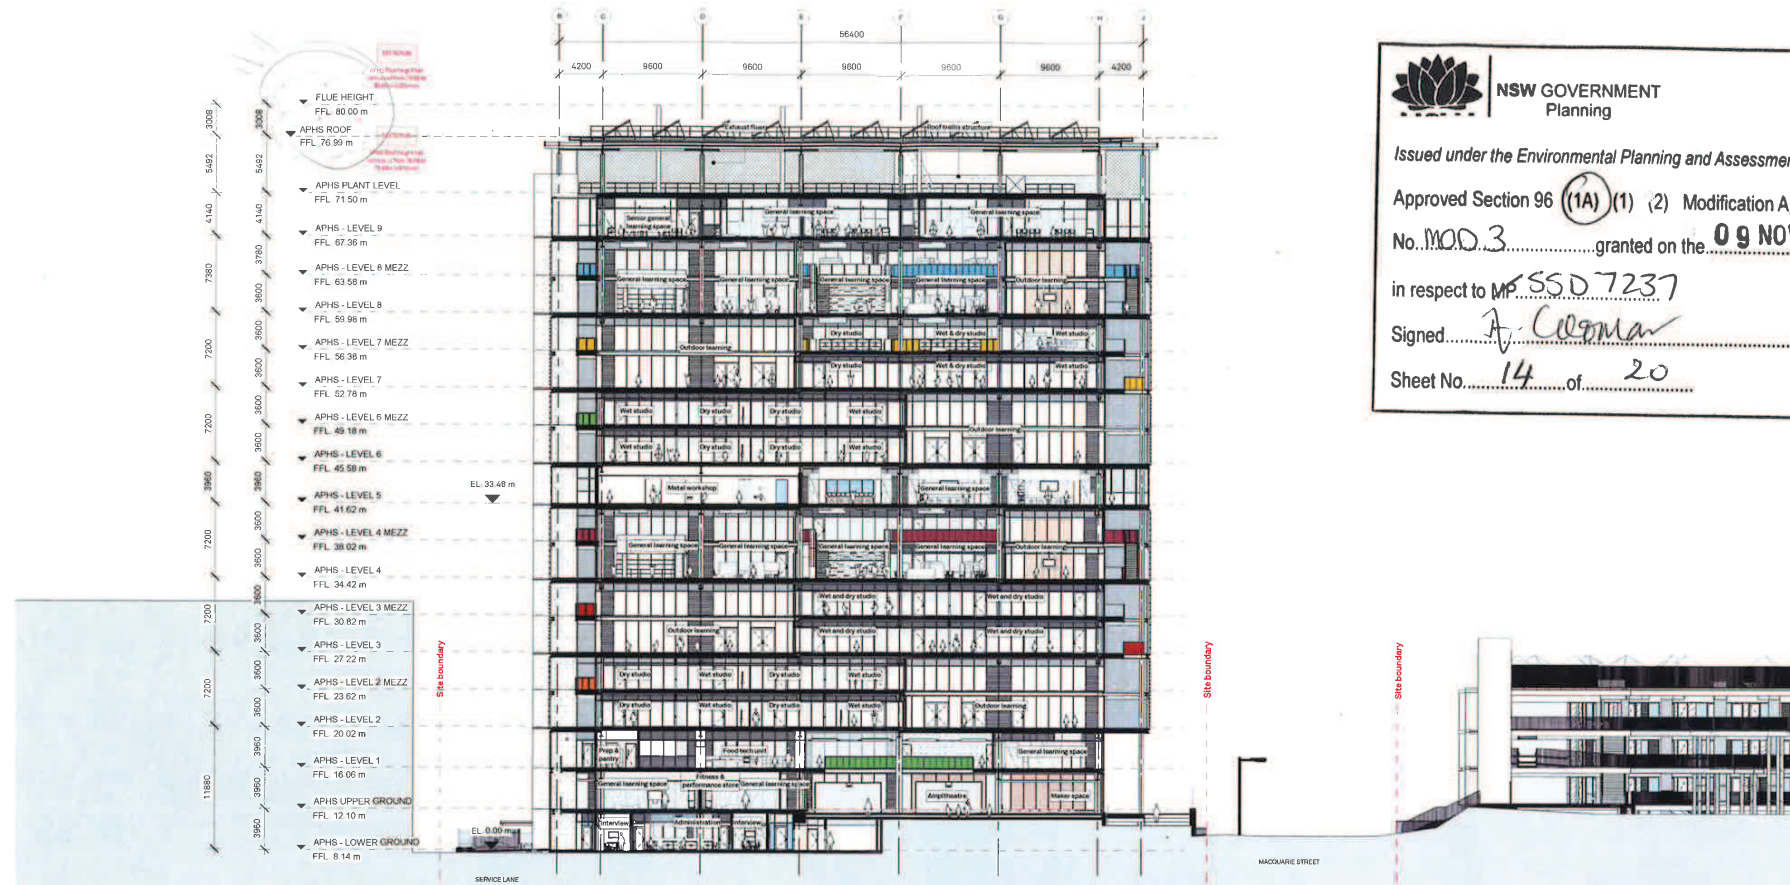

ALL DRAWINGS TO BE READ IN CONJUNCTION WITH EFSG DEPARTURE SCHEDULE,
FUNCTIONAL DESIGN BRIEF AND EDUCATIONAL FOUNDATIONS REPORTS

GRIMSHAW Architects
Telephone +61 (0)2 9253 0200
Address Level 3, 24 Hickson Rd
Walsh Bay
Sydney NSW 2000
Australia


BVN Architecture
Telephone +61 (0)2 8297 7200
Address Level 11
255 Pitt Street
Sydney NSW 2000
Australia
www.bvn.com.au

INTELLECTUAL PROPERTY

©COPYRIGHT GARRISON ARCHITECTS
UNLESS OTHERWISE SPECIFICALLY WRITING, ALL RIGHTS TO
USE THIS DOCUMENT ARE SUBJECT TO PAYMENT IN FULL
OF ALL GARRISON CHARGES. THIS DOCUMENT MAY ONLY
BE USED FOR THE EXPRESS PURPOSE AND PROJECT FOR
WHICH IT HAS BEEN CREATED AND DELIVERED. AS
NOTED IN WRITING BY GARRISON, AND THIS
DOCUMENT MAY NOT BE OTHERWISE USED. NO COPY-
RIGHT INFRINGEMENT WILL BE ASSERTED AGAINST THE
USER'S SOLE RISK AND WITHOUT LIMITING GARRISON'S
RIGHTS THE USER RELEASES AND AGREES TO GARRISON
FROM AND AGAINST ALL LOSS OR DAMAGES.

REV	DATE	FOR
1	22.02.16	DoE
2	04.03.16	DoE
3	11.03.16	DoE
4	15.03.16	ARUP
5	21.03.16	DoE
6	12.04.16	DoE APPROVAL
7	15.04.16	PLANNING DRAFT
8	02.05.16	PLANNING ISSUE
9	14.06.16	QS
10	25.08.16	PLANNING ISSUE
11	08.03.17	PLANNING

CLIENT
Department of Education

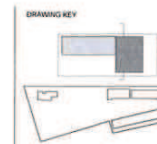GRIMSHAW PROJECT NO.
15091PROJECT
APHS

ADDRESS
(PPS)
175 Macquarie Street

(APHS)
80-100 Macquarie Street
Parramatta NSW 2150
Australia



SCALE AT A1
1 : 250

STATUS
PLANNING AMENDMENT

DRAWING
SECTIONS APHS - SECTION
A-A NORTH SOUTH

DRAWN	CHECKED	AUTHORISED
GAS	EE / LJ	LB

DRAWING NUMBER	REVISION
A07-1201	11



NSW GOVERNMENT
Planning

Issued under the Environmental Planning and Assessment Act 1979



Approved Section 96 (1A) (1) (2) Modification Application

No. MOD 3 granted on the 09 NOV 2017

in respect to MP 550 7237

Signed A. Colman

Sheet No. 15 of 20

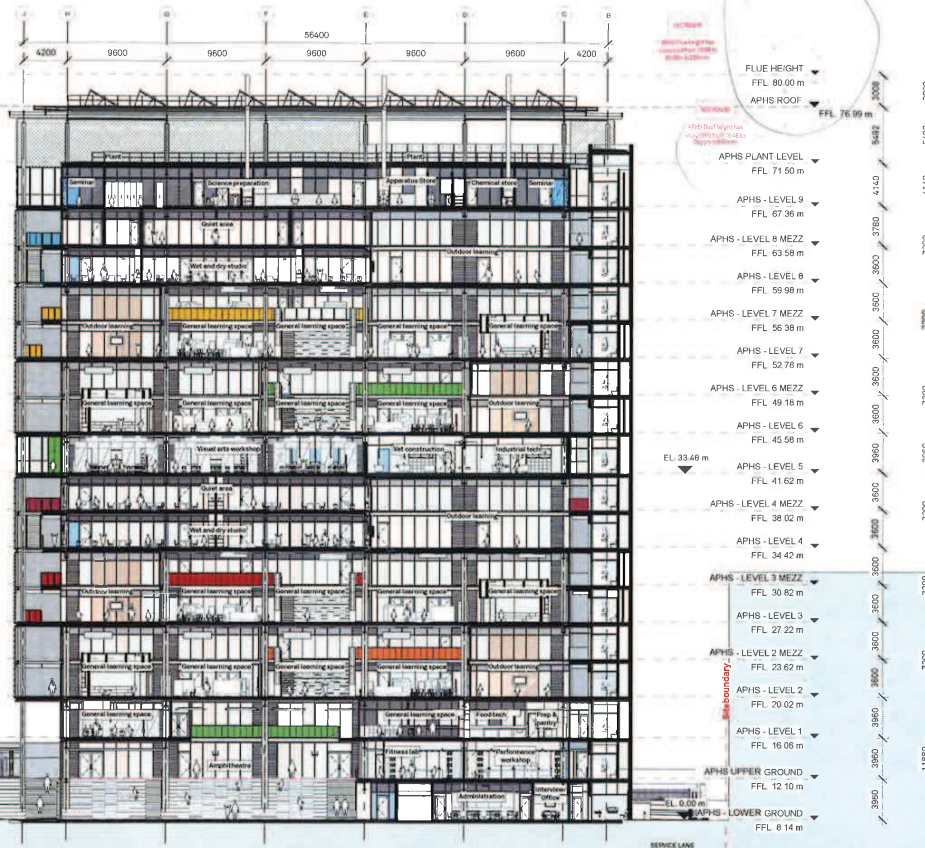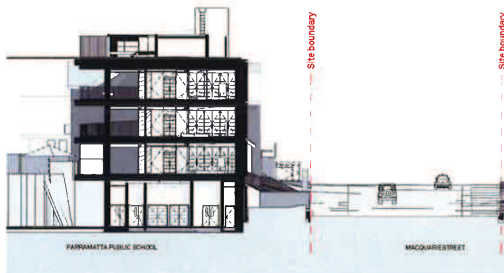

REVISIONS IN RESPONSE TO COMMENTS FROM SUBMISSIONS FROM SSD APPLICATION

ALL DRAWINGS TO BE READ IN CONJUNCTION WITH EFS6 DEPARTURE SCHEDULE,
FUNCTIONAL DESIGN BRIEF AND EDUCATIONAL FOUNDATIONS REPORTS

GRIMSHAW

GRIMSHAW Architects
Telephone +61 (0)2 9253 0200
Address Level 3, 24 Nickson Rd
Wahby Bay
Sydney NSW 2000
Australia

www.grimshawarchitects.com



BVM Architecture
Telephone +61 (0)2 6297 7200
Address Level 11
255 Pitt Street
Sydney NSW 2000
Australia

www.bvm.com.au

INTELLECTUAL PROPERTY

©COPYRIGHT GRIMSHAW ARCHITECTS
ALL RIGHTS RESERVED. NO PART OF THIS DOCUMENT MAY BE
REPRODUCED OR TRANSMITTED IN ANY FORM OR BY ANY
MEANS, ELECTRONIC OR MECHANICAL, INCLUDING
PHOTOCOPYING, RECORDING, OR BY ANY INFORMATION
STORAGE AND RETRIEVAL SYSTEM, WITHOUT THE
WRITTEN PERMISSION OF GRIMSHAW ARCHITECTS.

REV	DATE	FOR
1	22.02.16	D&E
2	04.03.16	D&E
3	11.03.16	D&E
4	21.03.16	D&E
5	12.04.16	D&E APPROVAL
6	15.04.16	PLANNING DRAFT
7	02.05.16	PLANNING ISSUE
8	14.06.16	CD
9	25.06.16	PLANNING ISSUE
10	08.07.17	PLANNING

CLIENT
Department of Education

GRIMSHAW PROJECT NO
15091

DRAWING KEY



PROJECT
APHS

ADDRESS
(PPS)
175 Macquarie Street

(APHS)
80-100 Macquarie Street
Parramatta NSW 2150
Australia

NORTH

SCALE AT A1
1 : 250

STATUS
PLANNING AMENDMENT

DRAWING
SECTIONS APHS - SECTION
B-B NORTH SOUTH

DRAWN CHECKED AUTHORIZED
GAS EE / LJ LB

DRAWING NUMBER REVISION
A07-1202 10



Issued under the Environmental Planning and Assessment Act 1979

Approved Section 96 (1A) (1) (2) Modification Application

No. MOD 3 granted on the 09 NOV 2017

in respect to ~~MP~~ SSD 7237

Signed J. Coonan

Sheet No. 16 of 20



REVISIONS IN RESPONSE TO COMMENTS FROM SUBMISSIONS FROM SSD APPLICATION

ALL DRAWINGS TO BE READ IN CONJUNCTION WITH EFSG DEPARTURE SCHEDULE,
FUNCTIONAL DESIGN BRIEF AND EDUCATIONAL FOUNDATIONS REPORTS

GRIMSHAW Architects
Telephone +61 (0)2 9253 0200
Address Level 3, 24 Hickson Rd
Walsh Bay
Sydney NSW 2000
Australia

www.grimshaw-architects.com

Telephone +61 (0)2 6297 7200
Address Level 11
255 Pitt Street
Sydney NSW 2000
Australia

www.bvm.com.au

INTELLECTUAL PROPERTY


©COPYRIGHT GRAMSWAY ARCHITECTS
UNLESS OTHERWISE AGREED TO IN WRITING, ALL RIGHTS TO
USE THIS DOCUMENT ARE SUBJECT TO PAYMENT IN FULL
OF ALL PENDING CHARGES. THIS DOCUMENT MAY ONLY
BE USED FOR THE EXPRESS PURPOSE AND PROJECT FOR
WHICH IT HAS BEEN CREATED AND DELIVERED. AS
NOTIFIED IN WRITING BY GRAMSWAY, AND THIS
DOCUMENT MAY NOT BE REPRODUCED OR COPIED
AND ANY UNAUTHORIZED USE OF THIS DOCUMENT AS A
USER'S TOOL IS RISKY AND WITHOUT LIMITING GRAMSWAY
BOWEN THE USER RELEASES AND INDEMNIFIES GRAMSWAY

REV	DATE	FOR
1	22 02 16	DoE
2	04 03 16	DoE
3	11 03 16	DoE
4	21 03 16	DoE
5	12 04 16	DoE APPROVAL
6	15 04 16	PLANNING DRAFT
7	02 05 16	PLANNING ISSUE
8	14 06 16	QS
9	25 08 16	PLANNING ISSUE
10	08 03 17	PLANNING

CLIENT
Department of Education

GRIMSHAW PROJECT NO
15091

DRAWING KEY

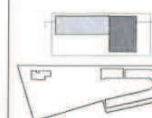PROJECT
APHS

ADDRESS
(PPS)
175 Macquarie Street

(APHS)
80-100 Macquarie Street
Parramatta NSW 2150
Australia



SCALE AT A1
1 : 250

STATUS
PLANNING AMENDMENT

DRAWING
SECTIONS APHS - SECTION
C-C EAST WEST

DRAWN	CHECKED	AUTHORISED
GAS	EE / LJ	LB

DRAWING NUMBER	REVISION
A07-1203	10



NSW GOVERNMENT
Planning

Issued under the Environmental Planning and Assessment Act 1979

Approved Section 96 (1A) (1) (2) Modification Application

No. MOD 3 granted on the 09 NOV 2017

in respect to MP SSD 7237

Signed J. Gorman

Sheet No. 17 of 20



REVISIONS IN RESPONSE TO COMMENTS FROM SUBMISSIONS FROM SSD APPLICATION

ALL DRAWINGS TO BE READ IN CONJUNCTION WITH EFSG DEPARTURE SCHEDULE,
FUNCTIONAL DESIGN BRIEF AND EDUCATIONAL FOUNDATIONS REPORTS

GRIMSHAW

GRIMSHAW Architects
Telephone +61 (0)2 9253 0200
Address Level 13, 24 Hickson Rd
Wahro Bay
Sydney NSW 2000
Australia

www.grimshaw-architects.com



BVN Architecture
Telephone +61 (0)2 9297 7200
Address Level 11
258 Pitt Street
Sydney NSW 2000
Australia

www.bvn.com.au

INTELLECTUAL PROPERTY

© Grimshaw Architects. All rights reserved. This document is the property of Grimshaw Architects. It is not to be reproduced, stored in a retrieval system, or transmitted in any form or by any means, electronic, mechanical, photocopying, recording, or by any information storage and retrieval system, without the prior written permission of Grimshaw Architects. This document may not be reproduced, stored, or transmitted in any form or by any means, electronic, mechanical, photocopying, recording, or by any information storage and retrieval system, without the prior written permission of Grimshaw Architects. This document may not be reproduced, stored, or transmitted in any form or by any means, electronic, mechanical, photocopying, recording, or by any information storage and retrieval system, without the prior written permission of Grimshaw Architects.

REV	DATE	FOR
1	22.03.16	D/E
2	04.03.16	D/E
3	11.03.16	D/E
4	21.03.16	D/E
5	12.04.16	D/E APPROVAL
6	15.04.16	PLANNING DRAFT
7	02.05.16	PLANNING ISSUE
8	14.06.16	OS
9	25.06.16	PLANNING ISSUE
10	06.03.17	PLANNING AMENDMENT
11	01.08.17	

CLIENT
Department of Education

GRIMSHAW PROJECT NO
16091

DRAWING KEY



PROJECT
APHS

ADDRESS
(PPS)
175 Macquarie Street

(APHS)
80-100 Macquarie Street
Parramatta NSW 2150
Australia


NORTH
SCALE AT A1
1:250

STATUS
PLANNING AMENDMENT

DRAWING SECTIONS APHS - SECTION
D-D EAST WEST

DRAWN CHECKED AUTHORIZED
GAS EE/LJ LB

DRAWING NUMBER REVISION
A07-1204 11

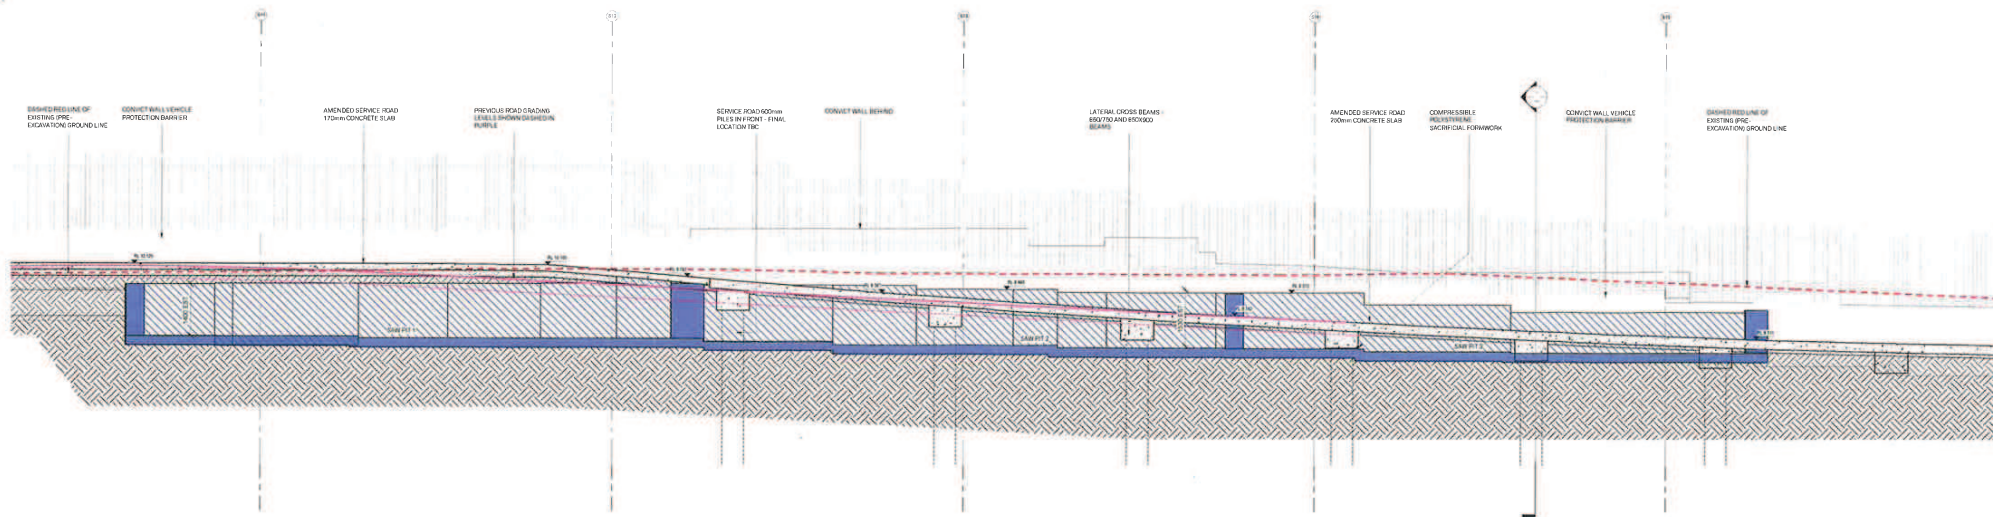

1 SERVICE ROAD & ARCHAEOLOGY - SECTION 1



NSW GOVERNMENT
Planning

Issued under the Environmental Planning and Assessment Act 1979

Approved Section 96 (1A) (1) (2) Modification Application

No. MOD 3 granted on the 09 NOV 2017

in respect to MP SSD 7237

Signed A. Comer

Sheet No. 18 of 20

GRIMSHAW

GRIMSHAW ARCHITECTS
Telephone +61 (0)2 9253 0200
Address Level 3, 24 Hume Rd
Woolahilly
Sydney NSW 2000
Australia
www.grimshaw-architects.com



BVA
Telephone +61 (0)2 9297 7200
Address Level 11
255 Pitt Street
Sydney NSW 2000
Australia
www.bva.com.au

INTELLECTUAL PROPERTY
© 2017 GRIMSHAW ARCHITECTS
ALL RIGHTS RESERVED

REV. DESCRIPTION
+ FOR INFORMATION

DATE
18 08 17

CLIENT
Department of Education

DRAWING KEY



PROJECT
Arthur Phillip High School and
Panmatta Public School
ADDRESS
171 - 177 Macquarie
Street
(APHS)
152 - 116 Macquarie
Street
Panmatta, NSW 2150
Australia

GRIMSHAW PROJECT NO
15091

SCALE

SCALE @ A0
1:50

STATUS
FOR INFORMATION

DRAWING

APHS ARCHAEOLOGY IMPACTS 02

DRAWING NUMBER
AR-SK_R_0274


DRAWN
OP

CHECKED


REVISION
1

AUTHORISED


- SURVEYED ARCHAEOLOGY PLAN
- EXTENT OF EXCAVATED ARCHAEOLOGY
- "SOFT" ARCHAEOLOGY (IN SECTION)
- HARD ARCHAEOLOGY (IN SECTION)

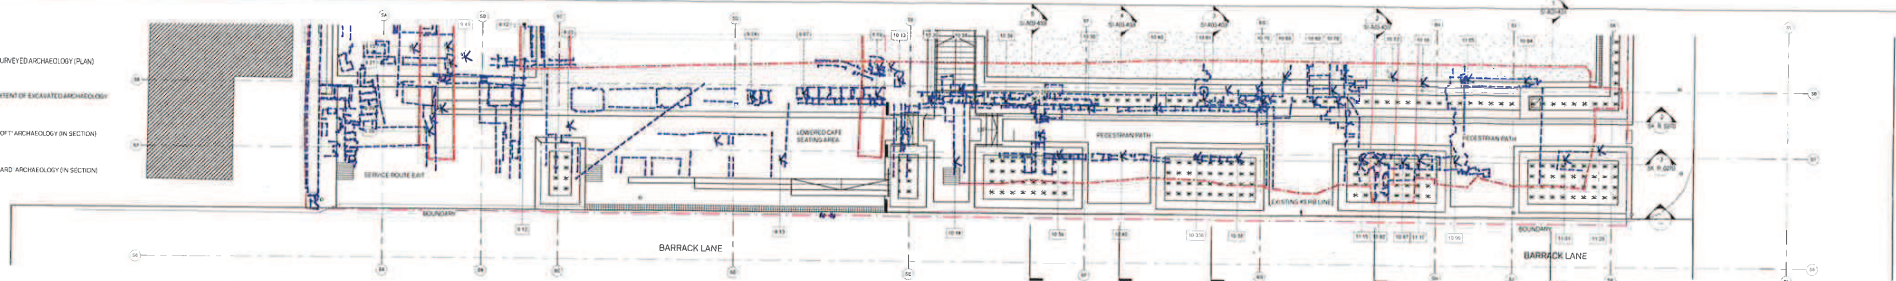


1 APHS WEST LANDSCAPING & ARCHAEOLOGY OVERLAY - PLAN

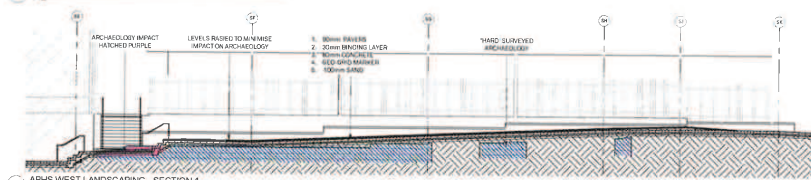


2 APHS WEST LANDSCAPING - SECTION 1

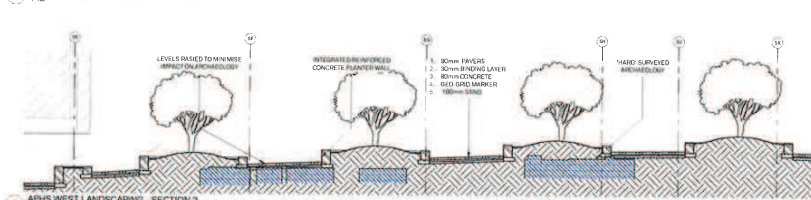


3 APHS WEST LANDSCAPING - SECTION 2

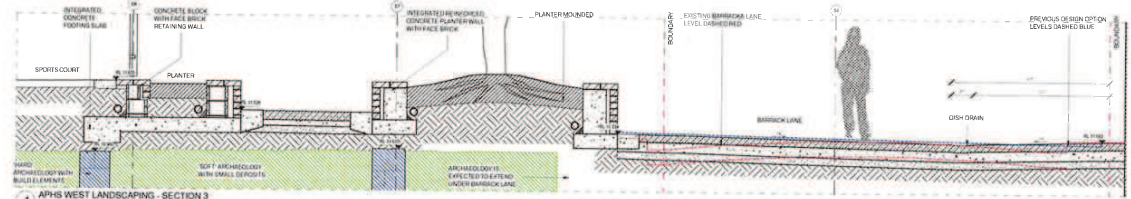


4 APHS WEST LANDSCAPING - SECTION 3

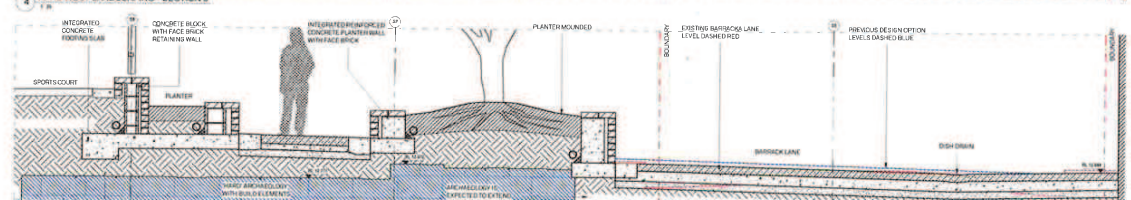


5 APHS WEST LANDSCAPING - SECTION 4

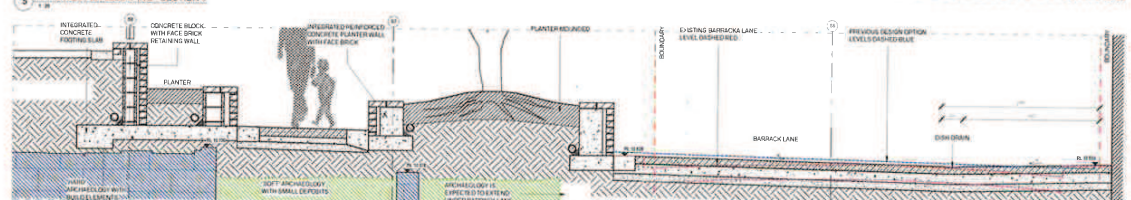

6 APHS WEST LANDSCAPING - SECTION 5

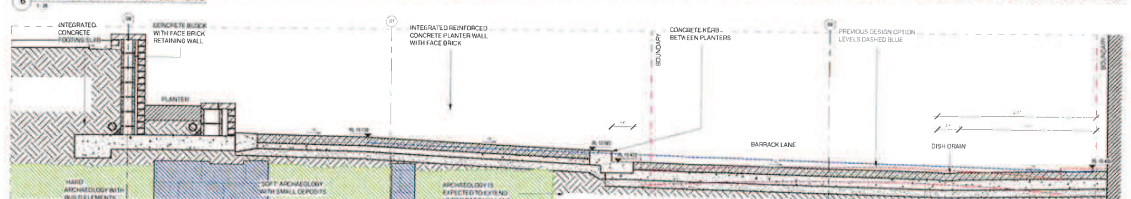

7 APHS WEST LANDSCAPING - SECTION 6

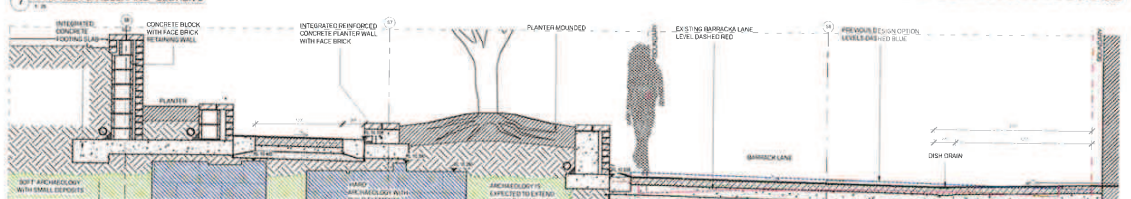

8 APHS WEST LANDSCAPING - SECTION 7



NSW GOVERNMENT
Planning

Issued under the Environmental Planning and Assessment Act 1979

Approved Section 96 (1A) (1) (2) Modification Application

No. MOO 3 granted on the 09 NOV 2017

in respect to MP SSD 7237

Signed A. Coman

Sheet No. 19 of 20

GRIMSHAW

GRIMSHAW ARCHITECTS
Telephone: 61 (0) 2 9271 0200
Address: Level 3, 24 Hudson Rd
Sydney NSW 2000
Australia



BUN ARCHITECTS
Telephone: 61 (0) 2 9271 7200
Address: Level 11
251 Pitt Street
Sydney NSW 2000
Australia

INTELLECTUAL PROPERTY
1. FOR INFORMATION
2. FOR INFORMATION
3. FOR INFORMATION

REV DESCRIPTION
1. FOR INFORMATION
2. FOR INFORMATION
3. FOR INFORMATION

DATE
18/04/17
20/04/17
18/05/17

CLIENT
Department of Education



PROJECT
Arthur Phillip High School and
Parramatta Public School
ADDRESS
171 - 177 Macquarie Street
(APHS)
102 - 116 Macquarie Street
Parramatta, NSW 2150
Australia



GRIMSHAW PROJECT NO
18091

NORTH
SCALE @ A4
As Indicated
STATUS
FOR INFORMATION


APHS WEST BOUNDARY &
BARRACK LANE INTEGRATION

GRIMSHAW NUMBER
AR-SK_R_0270


REVISION
3
AUTHORISED

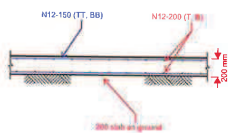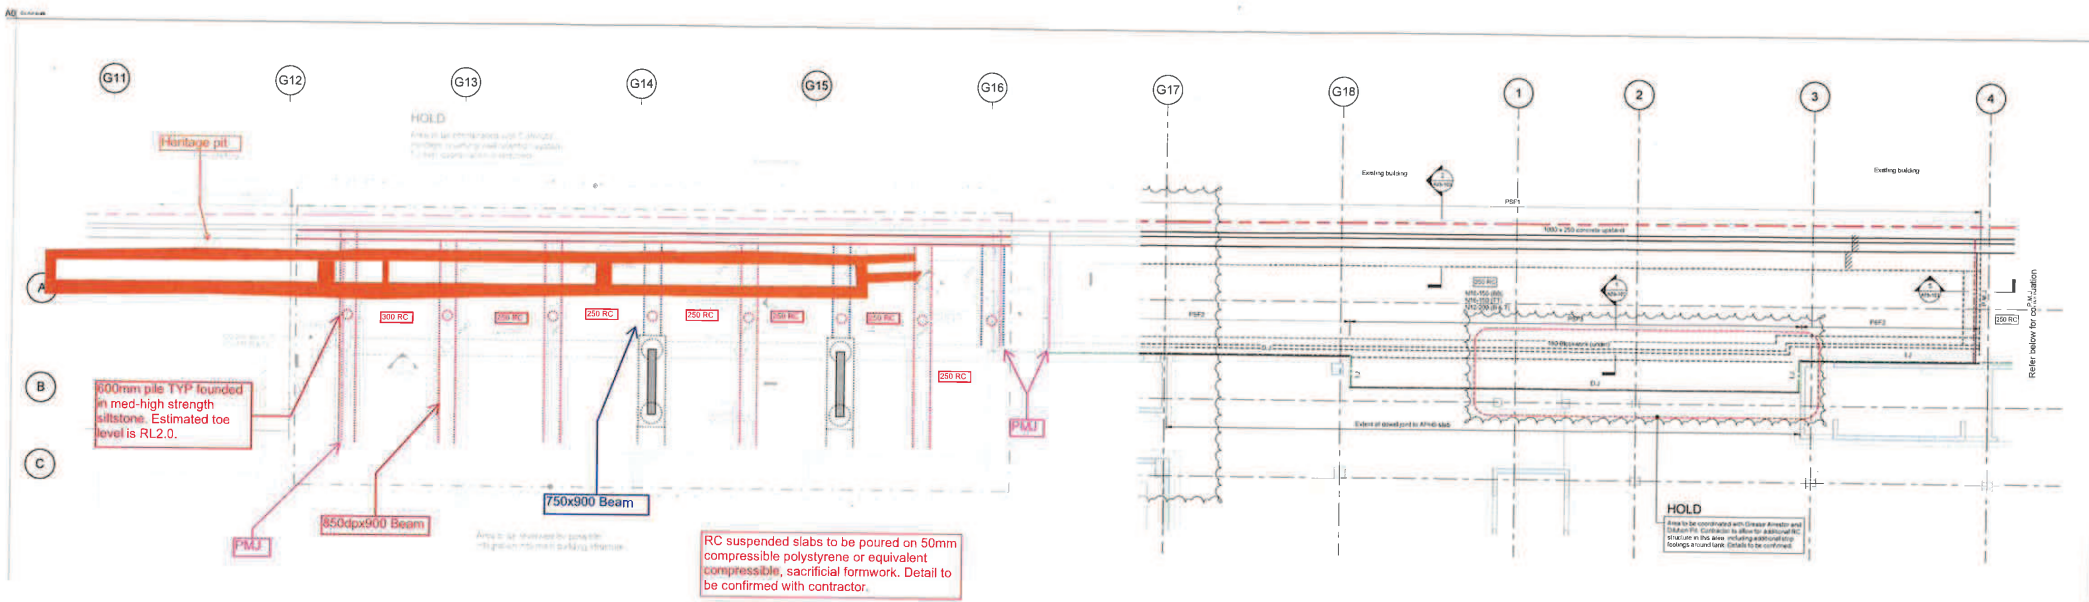

Section 1
Scale 1:20 A59-161

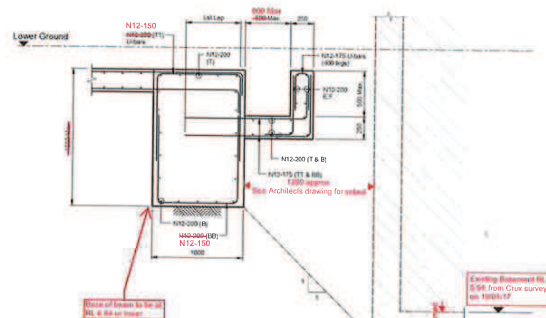

Section 2
Scale 1:20 A59-161

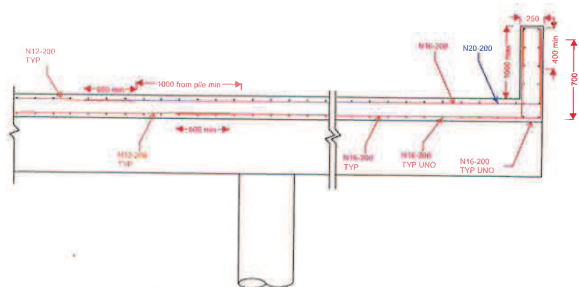

TYPICAL UPSTAND EDGE BEAM DETAIL
Heritage pit location not shown

S-SK-176 (rev3)

Adjusted Beam Layout for
Service Road Next to Heritage
Wall

Arup PL 29/06/17



NSW GOVERNMENT
Planning

Issued under the Environmental Planning and Assessment Act 1979

Approved Section 96 (1A) (1) (2) Modification Application

No. MOD 3 granted on the 09 NOV 2017

in respect to MP SSD 7237

Signed A. Coman

Sheet No. 20 of 20