




Sheet No. 1 of 4

CODE	DESCRIPTION
1	PRIMARY SHREDDER
2	WASTE SCREEN
3	SECONDARY SCREEN
4	UNDERSIZE AIR SEPARATOR
5	PRIMARY AIR SEPARATOR
6	BALLISTIC SEPARATOR
7	PEF SHREDDER
8	TIMBER SHREDDER
9	BALER
10	WRAPPER

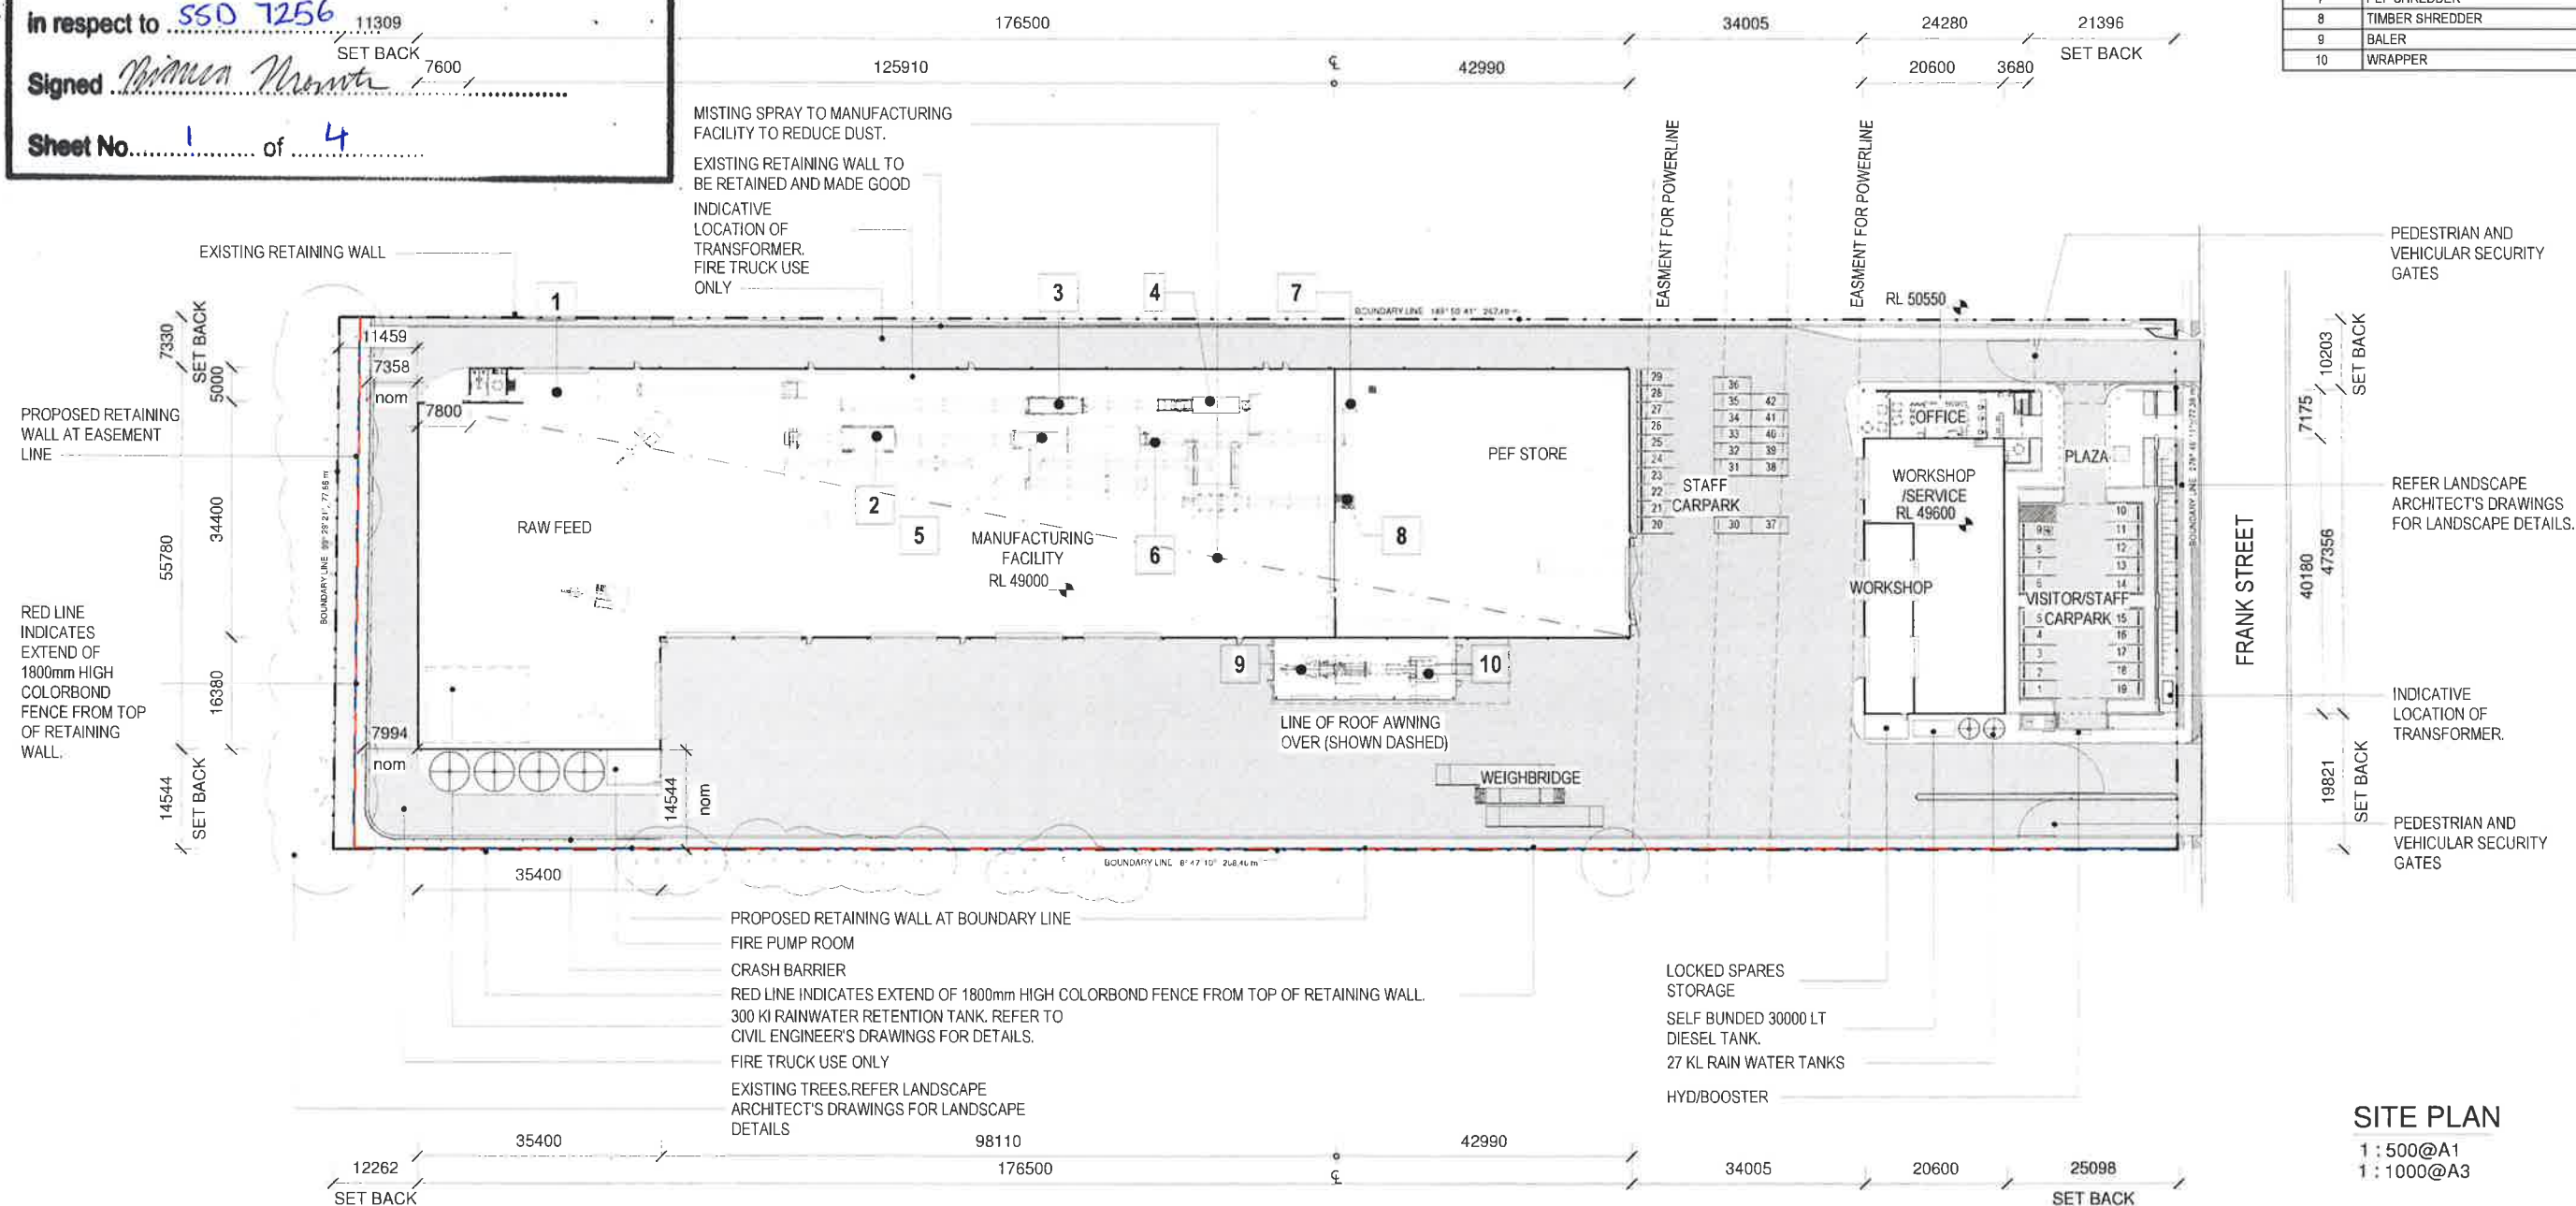

SITE PLAN

```
1:500@A1
1:1000@A3
```

[illegible]

CLIENT

ARCHITECT

BELL Architecture
Suite 1, 77 King William Road Unley SA 5061 PO
Box 3091 Unley SA 5061 P 08 8373 3870 F 08
8352 2839



3EL

JOB TITLE
Resource Co - Wetherill Park Sydney
NSW

JOB NO
BA150078

DRAWING SCALE @ A1
1 = 500

DRAWN BY
Author

DRAWING TITLE
SITE PLAN

DRAWING NO.
SK1101

REVISION
P3

CODE	DESCRIPTION
1	PRIMARY SHREDDER
2	WASTE SCREEN
3	SECONDARY SCREEN
4	UNDERSIZE AIR SEPARATOR
5	PRIMARY AIR SEPARATOR
6	BALLISTIC SEPARATOR
7	PEF SHREDDER
8	TIMBER SHREDDER
9	BALER
10	WRAPPER

RED LINE INDICATES
EXTEND OF 1800mm HIGH
COLORBOND FENCE FROM
TOP OF RETAINING WALL.

MISTING SPRAY TO MANUFACTURING
FACILITY TO REDUCE DUST.
EXISTING RETAINING WALL TO BE RETAINED AND MADE GOOD
INDICATIVE
LOCATION OF THE
PAD MOUNT
TRANSFORMER, TO
BE CONFIRMED

EXISTING RETAINING WALL
PROPOSED RETAINING
WALL

RAW FEED

MANUFACTURING
FACILITY

PEF STORE

LINE OF ROOF AWNING
OVER (SHOWN DASHED)

WEIGHBRIDGE



Planning & Environment

Issued under the *Environmental Planning and Assessment Act 1979*

Approved Section 4.55 (1A) Modification Application

No. MOD 1 granted on the 24 SEPT 2018

in respect to SSD 7256

Signed Maria Mramor

Sheet No. 2 of 4

PROPOSED RETAINING WALL AT BOUNDARY LINE
CRASH BARRIER
EXISTING TREES, REFER LANDSCAPE
ARCHITECT'S DRAWINGS FOR LANDSCAPE
RED LINE INDICATES EXTEND OF 1800mm HIGH
COLORBOND FENCE FROM TOP OF RETAINING WALL.
RAINWATER RETENTION TANK. REFER TO CIVIL
ENGINEER'S DRAWINGS FOR DETAILS.

FOR DEVELOPMENT APPROVAL

THIS DRAWING IS OWNED BY AND REMAINS THE PROPERTY OF BELL ARCHITECTURE. ALL
RIGHTS RESERVED. NO REPRODUCTION OR USE OF THIS DRAWING MAY BE MADE WITHOUT THE
PERMISSION OF THE ARCHITECT. THE CLIENT IS ADVISED THAT THE ARCHITECT'S DRAWINGS
DO NOT CONSTITUTE A GUARANTEE OF THE ACCURACY OF THE INFORMATION PROVIDED. THE
ARCHITECT'S DRAWINGS ARE TO BE USED IN CONJUNCTION WITH THE TERMS AND CONDITIONS OF THE
CLIENT'S AGREEMENT FOR THE PROJECT. A SIGNED AND DATED COPY OF THIS DRAWING
MUST BE SUBMITTED TO THE LOCAL COUNCIL FOR APPROVAL. THE CONTRACTOR SHALL VERIFY ALL DIMENSIONS
ON SITE PRIOR TO COMMENCEMENT OF WORK. THE CONTRACTOR SHALL BE RESPONSIBLE FOR OBTAINING ALL
NECESSARY APPROVALS AND PERMITS. THE ARCHITECT'S DRAWINGS ARE NOT TO BE USED FOR ANY OTHER
PURPOSE WITHOUT THE WRITTEN PERMISSION OF BELL ARCHITECTURE.

ISSUE	DATE	DESCRIPTION	ISSUED BY	DATE	DESCRIPTION	ISSUED BY
#1	18/01/2018	DATE OF INCLUSION ADDED	JL			
#2	27/01/2018	FOR DEVELOPMENT APPROVAL	JL			
#3	25/01/2018	FOR DEVELOPMENT APPROVAL	JL			



CLIENT

ARCHITECT

BELL Architecture
Suite 1.77 King William Road Unley SA 5061 PO
Box 2031 Unley SA 5061 P 08 8378 3970 F 08
8357 2639



JOB TITLE
Resource Co - Welherill Park Sydney
NSW

JOB NO
BA150078

DRAWING SCALE @ A1
1 : 250

DRAWN BY
JD

DRAWING TITLE
SITE PLAN DETAIL-PART 1

DRAWING NO
SK1102

REVISION
P3

SITE PLAN-PART 1
1 : 250@A1
1 : 500@A3

REFER TO DRAWINGS SK1103




Approved Application No. SSD 7256

granted on the.....

Signed Shagzi DP

Sheet No. 3 of 6

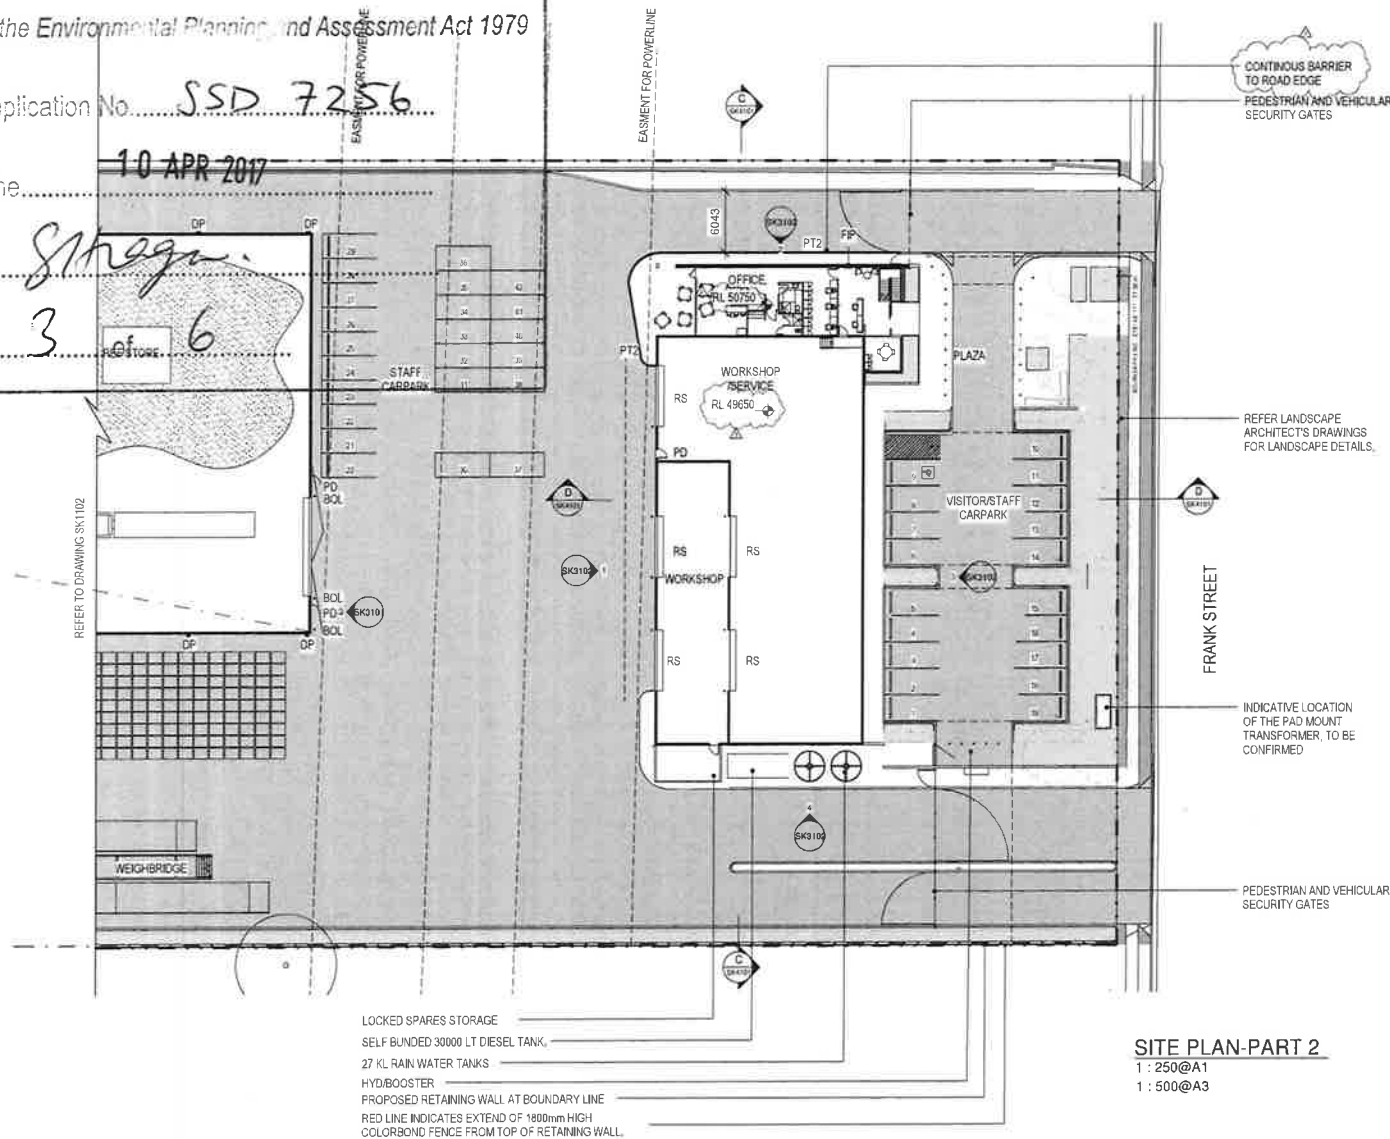

EXTERNAL MATERIAL SCHEDULE			
Manufacturing and Workshop Building			
CODE	ELEMENT	MATERIAL & FINISH	COLOUR
APL	Apex Flashing	Polished metal sheet, Colourbond zinc	Surfmate
BC	Barge Capings	Polished metal sheet, Colourbond zinc	Surfmate
BO	Brackets	Polished metal sheet, Colourbond zinc	14 match RO
BOC	Brackets	Polished metal sheet, Colourbond zinc	Surfmate Yellow
DS	Downpipes 150mm dia	Polished metal sheet, Colourbond zinc	Surfmate
DS	Flashed Gutter	Polished metal sheet, Colourbond zinc	Surfmate
PC	Parapet Capping	Polished metal sheet, Colourbond zinc	Surfmate
PCP	6 corner caps	Polished complete panels	Naturel zinc/alve
PD	Primed Doors	Painted board and core, painted	14 match Surfmate
PTA	Roof and apex frame to awnings	Mild steel, painted	14 match Surfmate
PD	Roof Capings / Apex Capings	Polished metal sheet, Colourbond zinc	Surfmate
PD	Roof Finishing	Painted Colourbond zinc sheeting	Surfmate
PS	Roof Struts	Polished metal sheet, Colourbond zinc	Surfmate
PM-OP	Roofs and downpipes	Polished metal sheet, Colourbond zinc	14 match OP
WCI	External Cladding	Painted Colourbond zinc sheeting	Surfmate

[illegible]

FOR DEVELOPMENT APPROVAL

[illegible]

CLIENT

ARCHITECT

BELL Architecture
Suite 1177 King William Road Unley SA 5061 PO Box
3091 Unley SA 5061 P. 08 8373 7820 F. 08 8352 203

RESOURCE

BELL

JOB TITLE
Resource Co. Wetherill Park Sydney
NSW

JOB NO
BA150078

GRAPHIC SCALE (1" = 10')

	DAAW
	9

DRAWING TITLE
SITE PLAN DETAIL-PART 2

SK1103

REVISION
P3



Planning &
Environment

Issued under the Environmental Planning and Assessment Act 1979


Approved Section 4.55 (.I.A..) Modification Application

No. MOD.1 granted on the 24 SEPT 2016

in respect to SSD 7256

Signed [Signature]


Sheet No. 3 of 4

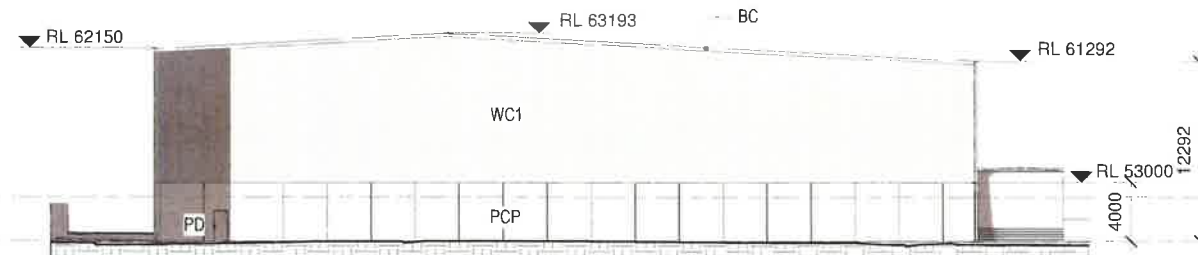

1 N.E.-MANUFACTURING FACILITY

1 : 250@A1
1 : 500@A3


MANUFACTURE FACILITY L1
RL 52000
MANUFACTURE FACILITY GL
RL 49000

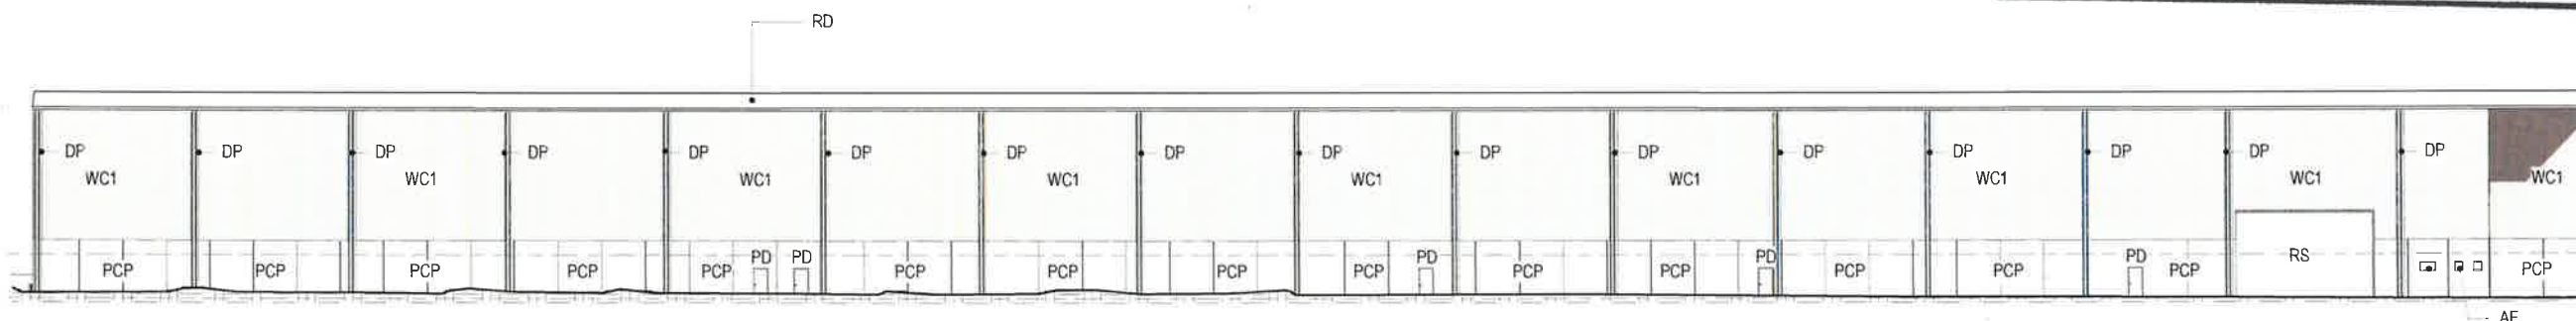

2 E.E.-MANUFACTURING FACILITY

1 : 250@A1
1 : 500@A3


MANUFACTURE FACILITY L1
RL 52000
MANUFACTURE FACILITY GL
RL 49000

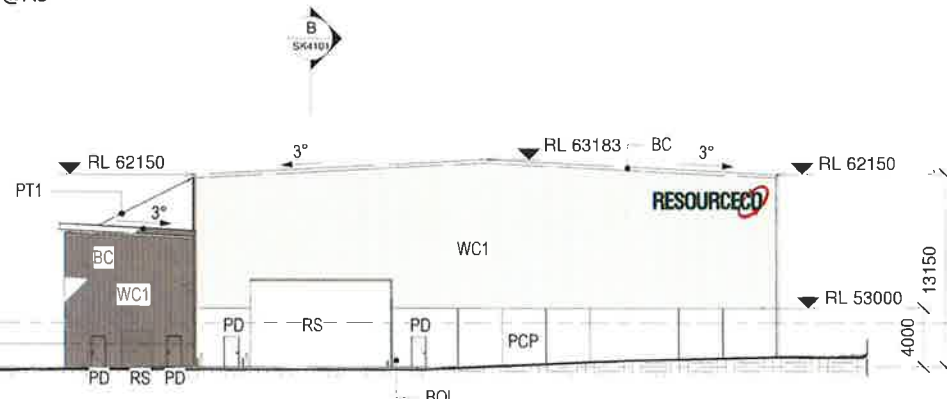

3 S.E.-MANUFACTURING FACILITY

1 : 250@A1
1 : 500@A3

MANUFACTURE FACILITY L1
RL 52000
MANUFACTURE FACILITY GL
RL 49000

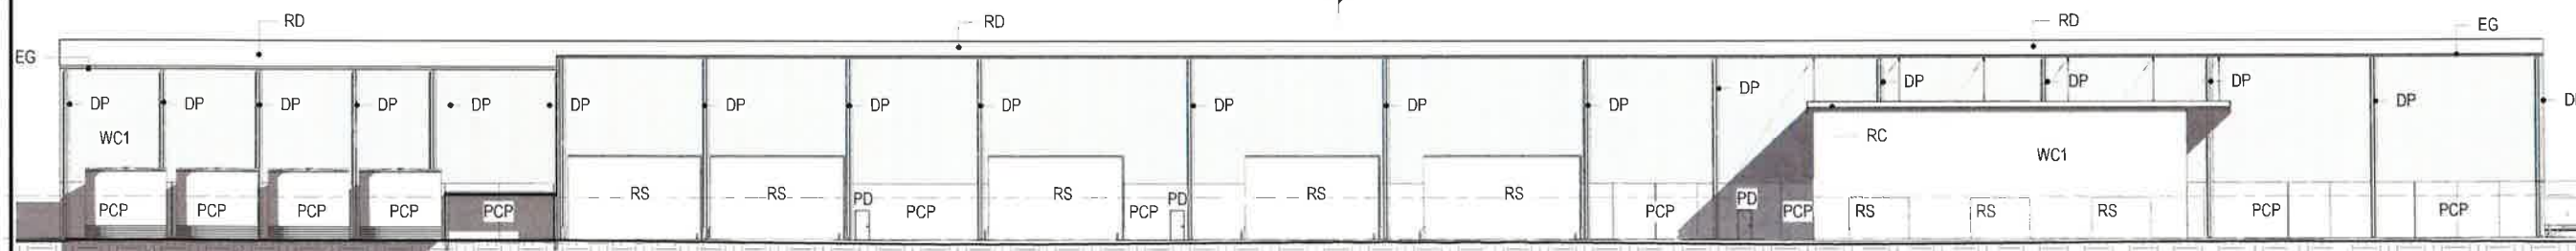

4 W.E.-MANUFACTURING FACILITY

1 : 250@A1
1 : 500@A3

MANUFACTURE FACILITY L1
RL 53000
MANUFACTURE FACILITY GL
RL 52000
MANUFACTURE FACILITY GL
RL 49000

EXTERNAL MATERIAL SCHEDULE Warehouse Building

CODE	ELEMENT	MATERIAL & FINISH	COLOUR
AF1	Apron Flashing	Folded metal sheet, Colorbond steel	Surfmist
BC	Barge Capping	Folded metal sheet, Colorbond steel	Surfmist
BG	Box Gutter	Folded metal sheet, Colorbond steel	To match HD
BOL	Bollard	Steel, painted	Safety Yellow
DP	Downpipe 150mm dia	Folded metal sheet, Colorbond steel	Surfmist
EG	Eaves Gutter	Folded metal sheet, Colorbond steel	Surfmist
PC	Parapet Capping	Folded metal sheet, Colorbond steel	Surfmist
PCP	External Walls	Precast concrete panels	Natural concrete
PD	Personnel Doors	Metal faced solid core, painted	To match Surfmist
PT1	Exposed steel frame to awnings	Mild steel, painted	To match Surfmist
RC	Ridge Capping / Apex Capping	Folded metal sheet, Colorbond steel	Surfmist
RD	Roof Sheet	Profiled Colorbond steel sheeting	Surfmist
RS	Roller Shutters	Powdercoat finish	Deep Ocean
SUMP+DP	Sump and downpipe	Folded metal sheet, Colorbond steel	To match DP
WC1	External Cladding	Profiled Colorbond steel sheeting	Surfmist

FOR DEVELOPMENT APPROVAL

THIS DRAWING IS OWNED BY AND REMAINS THE PROPERTY OF BELL ARCHITECTURE. ALL RIGHTS RESERVED. NO REPRODUCTION OR USE OF THIS DRAWING WITHOUT THE WRITTEN PERMISSION OF BELL ARCHITECTURE IS PERMITTED. THE CLIENT RELEASES BELL ARCHITECTURE FROM LIABILITY FOR THE DESIGN AND CONSTRUCTION OF THE PROJECT. THE CLIENT RELEASES BELL ARCHITECTURE FROM LIABILITY FOR THE DESIGN AND CONSTRUCTION OF THE PROJECT. THE CLIENT RELEASES BELL ARCHITECTURE FROM LIABILITY FOR THE DESIGN AND CONSTRUCTION OF THE PROJECT.

ISSUE	DATE	DESCRIPTION	ISSUED BY	DATE	DESCRIPTION	ISSUED BY
P1	18/01/2016	BA150078 - BELL ARCHITECTURE	GP			
P2	26/01/2016	FOR DEVELOPMENT APPROVAL	GP			
P3	26/01/2016	FOR DEVELOPMENT APPROVAL	GP			

CLIENT

RESOURCECO

ARCHITECT

BELL Architecture
Suite 1, 77 King William Road, Sydney NSW 1585
Box 2001, Sydney NSW 1585 P 08 8373 3870 F 08 8373 2938

BELL

JOB TITLE
Resource Co - Wetherill Park Sydney
NSW

JOB NO
BA150078


DRAWING SCALE @ A1
1 : 250

DRAWN BY
JD

DRAWING TITLE
ELEVATIONS -
MANUFACTURING FACILITY

DRAWING NO
SK3101

REVISION
P3

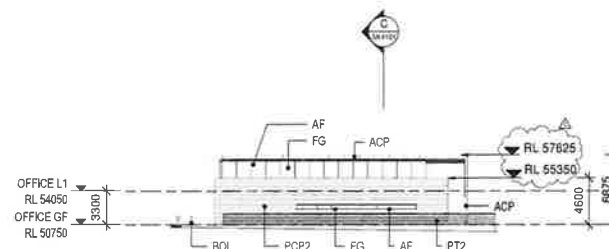

2 E.E.-OFFICE/WORKSHOP
1 : 250@A1
1 : 500@A3




Approved Application No. SSD 7256

granted on the.....1.0.APR 2017.

Signed.....*Shane*.....

Sheet No. 5 of  6

EXTERNAL MATERIAL SCHEDULE			
Manufacturing and Workshop Building			
CODE	ELEMENT	MATERIAL & FINISH	COLOUR
W/L	Apex Flashing	Polished metal sheet, Coibond steel	Surfmate
GC	Roofing Capping	Polished metal sheet, Coibond steel	Surfmate
IGL	Roof Gutter	Polished metal sheet, Coibond steel	1st match RD
BC	Big Buffer	Steel, painted	Safety Yellow
GP	Overhang 150mm dia	Polished metal sheet, Coibond steel	Surfmate
EC	Earth Lifter	Polished metal sheet, Coibond steel	Surfmate
PC	Parapet Capping	Polished metal sheet, Coibond steel	Surfmate
PCP	External Walls	Precast concrete panels	Natural concrete
PP	Perimeter Doors	Metal framed solid core, painted	1st match Surfmate
PTT	Ground over frame to parapet	Weld steel, surfaced	1st match Surfmate
IC	Roof Capping / Apex Capping	Polished metal sheet, Coibond steel	Surfmate
ICD	Roof Draining	Polished Coibond steel sheathing	Surfmate
ICD	Roof Staircase	Prefabricated steel	Surfmate
SCMP-GP	Surge and Staircase	Polished metal sheet, Coibond steel	1st match RD

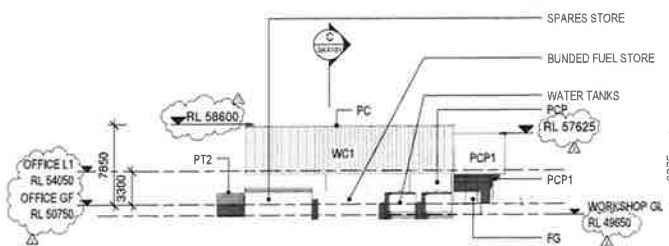[illegible]

4 W.E.-OFFICE/WORKSHOP
1: 250@A1
1: 500@A3

[illegible]

ARCHITECT
BELL Architecture
Suite 1, 77 King W.
20th Storey, S.A. 5000

RESOURCE

3311

DRAWING TITLE
ELEVATIONS-OFFICE /
WORKSHOP

REVISION
P3



Planning & Environment

Issued under the Environmental Planning and Assessment Act 1979

Approved Section 4.55 (1A) Modification Application

No. MOD.1 granted on the 24 SEPT 2018


in respect to SSD 7256

Signed *Miauna Narmate*

Sheet No. 4 of 4

A BUILDING SECTION

1 : 250@A1
1 : 500@A3

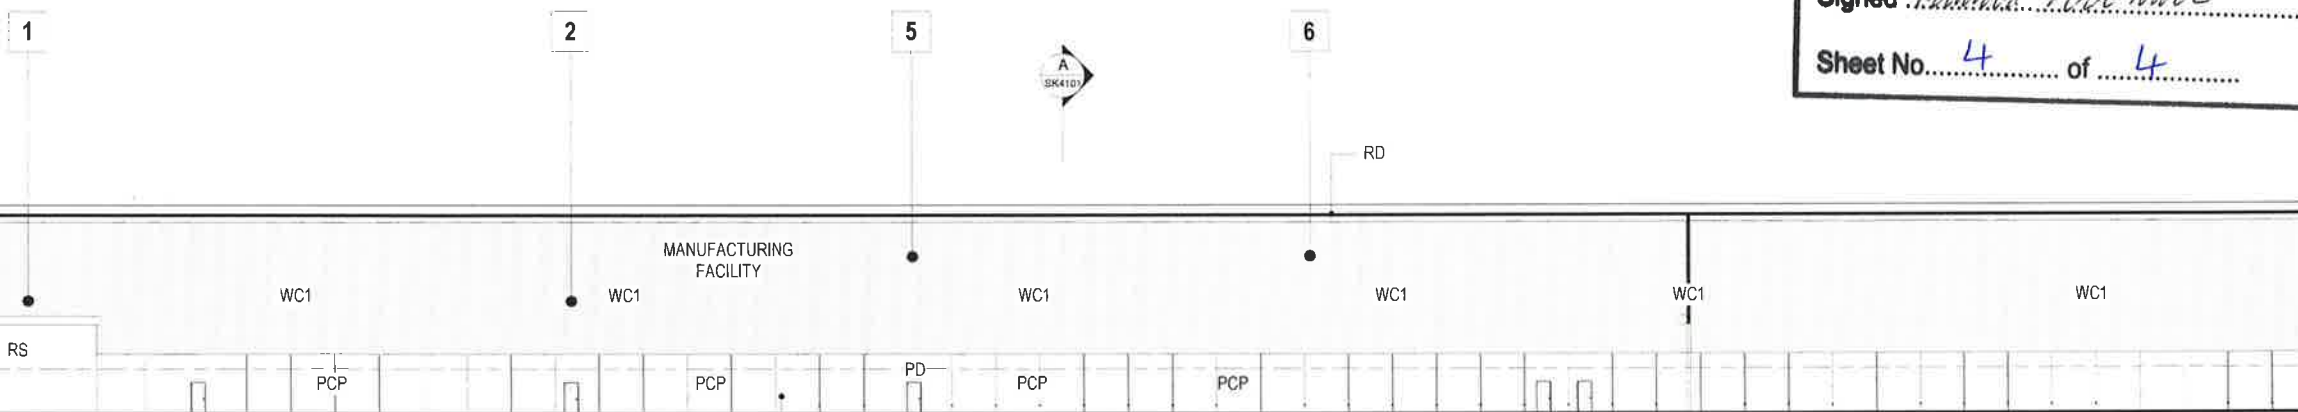

B BUILDING SECTION

1 : 250@A1
1 : 500@A3



C BUILDING SECTION

1 : 250@A1
1 : 500@A3



D BUILDING SECTION

1 : 250@A1
1 : 500@A3



CODE	DESCRIPTION
1	PRIMARY SHREDDER
2	WASTE SCREEN
3	SECONDARY SCREEN
4	UNDERSIZE AIR SEPARATOR
5	PRIMARY AIR SEPARATOR
6	BALLISTIC SEPARATOR
7	PEF SHREDDER
8	TIMBER SHREDDER
9	BALER
10	WRAPPER

FOR DEVELOPMENT APPROVAL

THIS DRAWING IS OWNED BY AND REMAINS THE PROPERTY OF BELL ARCHITECTURE. ALL RIGHTS RESERVED. NO REPRODUCTION OR DISSEMINATION OF THIS DRAWING WITHOUT THE WRITTEN PERMISSION OF BELL ARCHITECTURE. THE CLIENT IS ADVISED TO USE THIS DRAWING FOR THE WORK SPECIFIC TO THIS SITE, SUBJECT TO THE FULL PAYMENT OF THE ARCHITECT'S FEES AND COMPLIANCE WITH THE TERMS AND CONDITIONS OF THE ENGAGEMENT AGREEMENT FOR THIS PROJECT. PLEASE NOTE: DIMENSIONS SHALL BE USED, DO NOT SCALE FOR DIMENSIONS. THE CONTRACTOR SHALL VERIFY ALL DIMENSIONS ON SITE PRIOR TO THE COMMENCEMENT OF WORK. 18/03/2018 2:11 PM
Project: Resource Co - Wetherill Park Sydney
Drawing: SECTION A-D

ISSUE	DATE	DESCRIPTION	ISSUED BY	ISSUE	DATE	DESCRIPTION	ISSUED BY
P-3	18/03/2018	BALLISTIC INCLUSION	GH				
P-2	22/03/2018	FOR DEVELOPMENT APPROVAL	JZ				
P-1	25/03/2018	FOR DEVELOPMENT APPROVAL	JZ				

CLIENT



ARCHITECT

BELL Architecture
Suite 1, 77 King William Road Unley SA 5061 PO
Box 3081 Unley SA 5061 P 08 8373 3670 F 08
8357 2938

JOB TITLE

Resource Co - Wetherill Park Sydney
NSW

DRAWING TITLE

SECTIONS

JOB NO

BA150078

DRAWING SCALE @ A1

1 : 250

DRAWN BY

JD

DRAWING NO

SK4101

REVISION

P3