


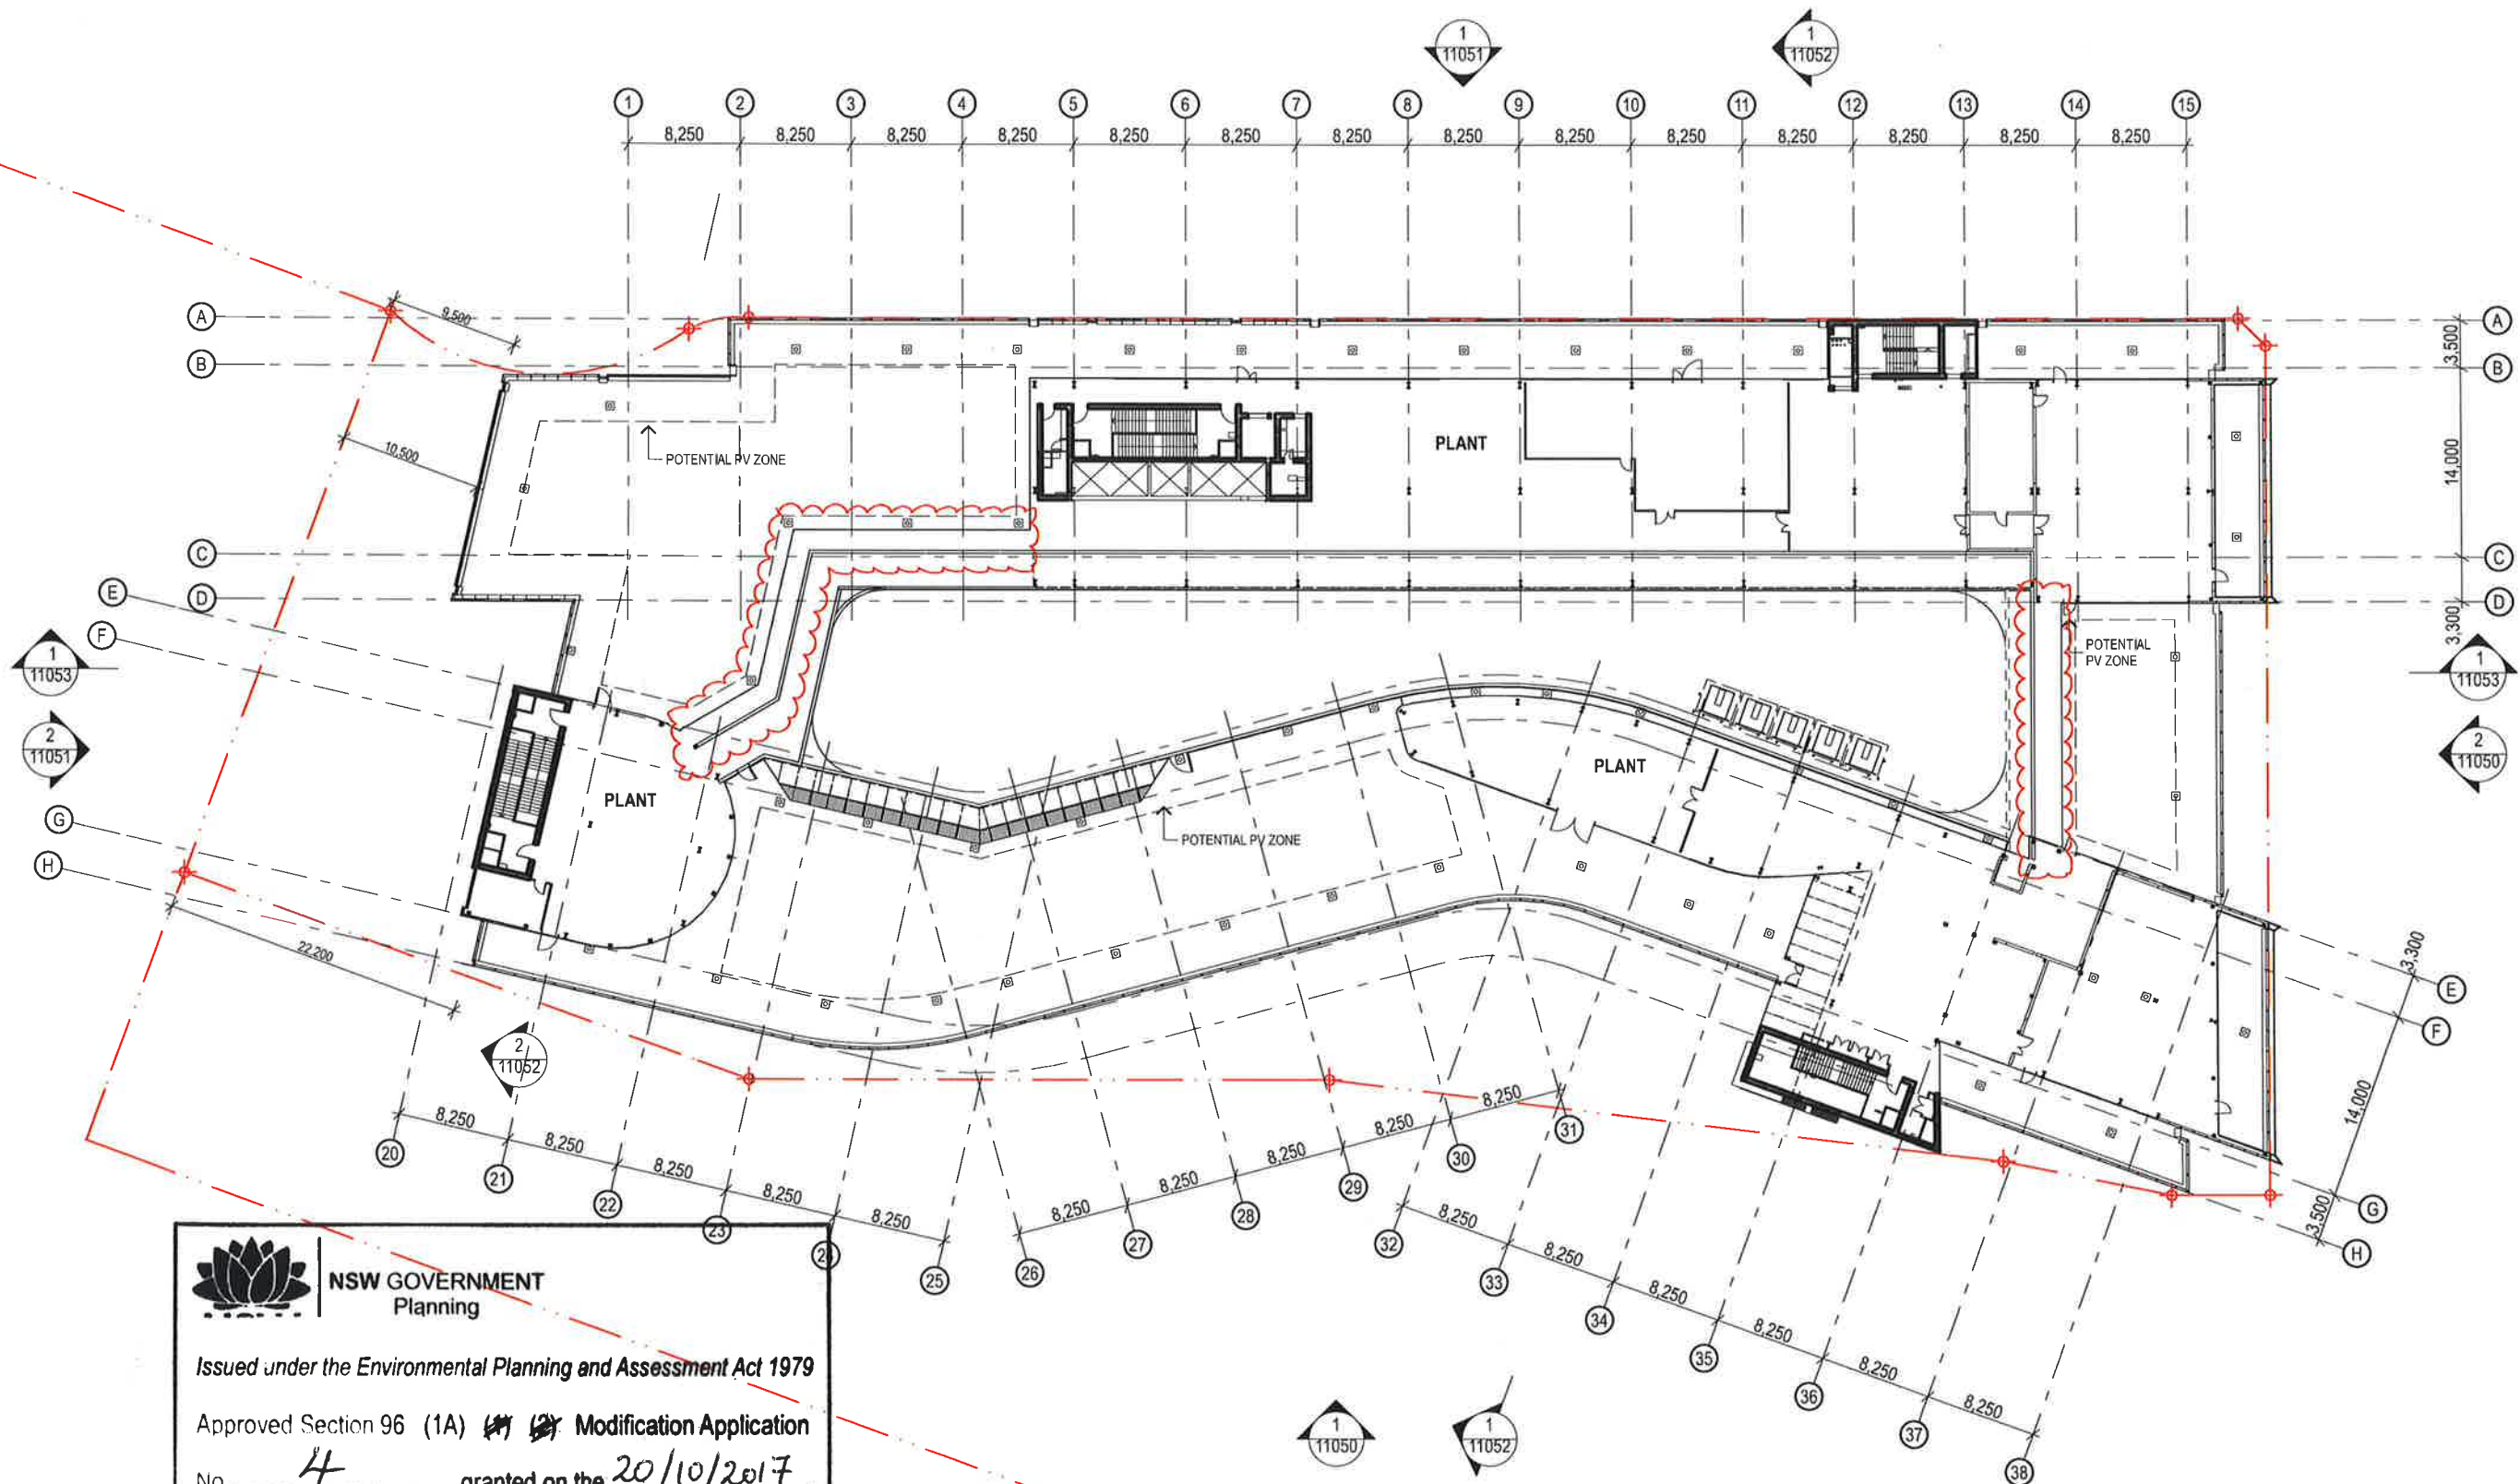

NSW GOVERNMENT
Planning

Issued under the Environmental Planning and Assessment Act 1979

Approved Section 96 (1A) ~~1A~~ ~~2A~~ Modification Application

No. 4 granted on the 20/10/2017

in respect to SSD 7317

Signed B. Kk

Sheet No. 1 of 4

Level 08 Plant GA Plan

MIRVAC - AUSTRALIAN TECHNOLOGY PARK - BUILDING 1

0 5 10 20m
1:500 @ A3




25/07/17

fjmt-AR-DWG-11008_DA5

fjmt

francis-jones morehen thorp

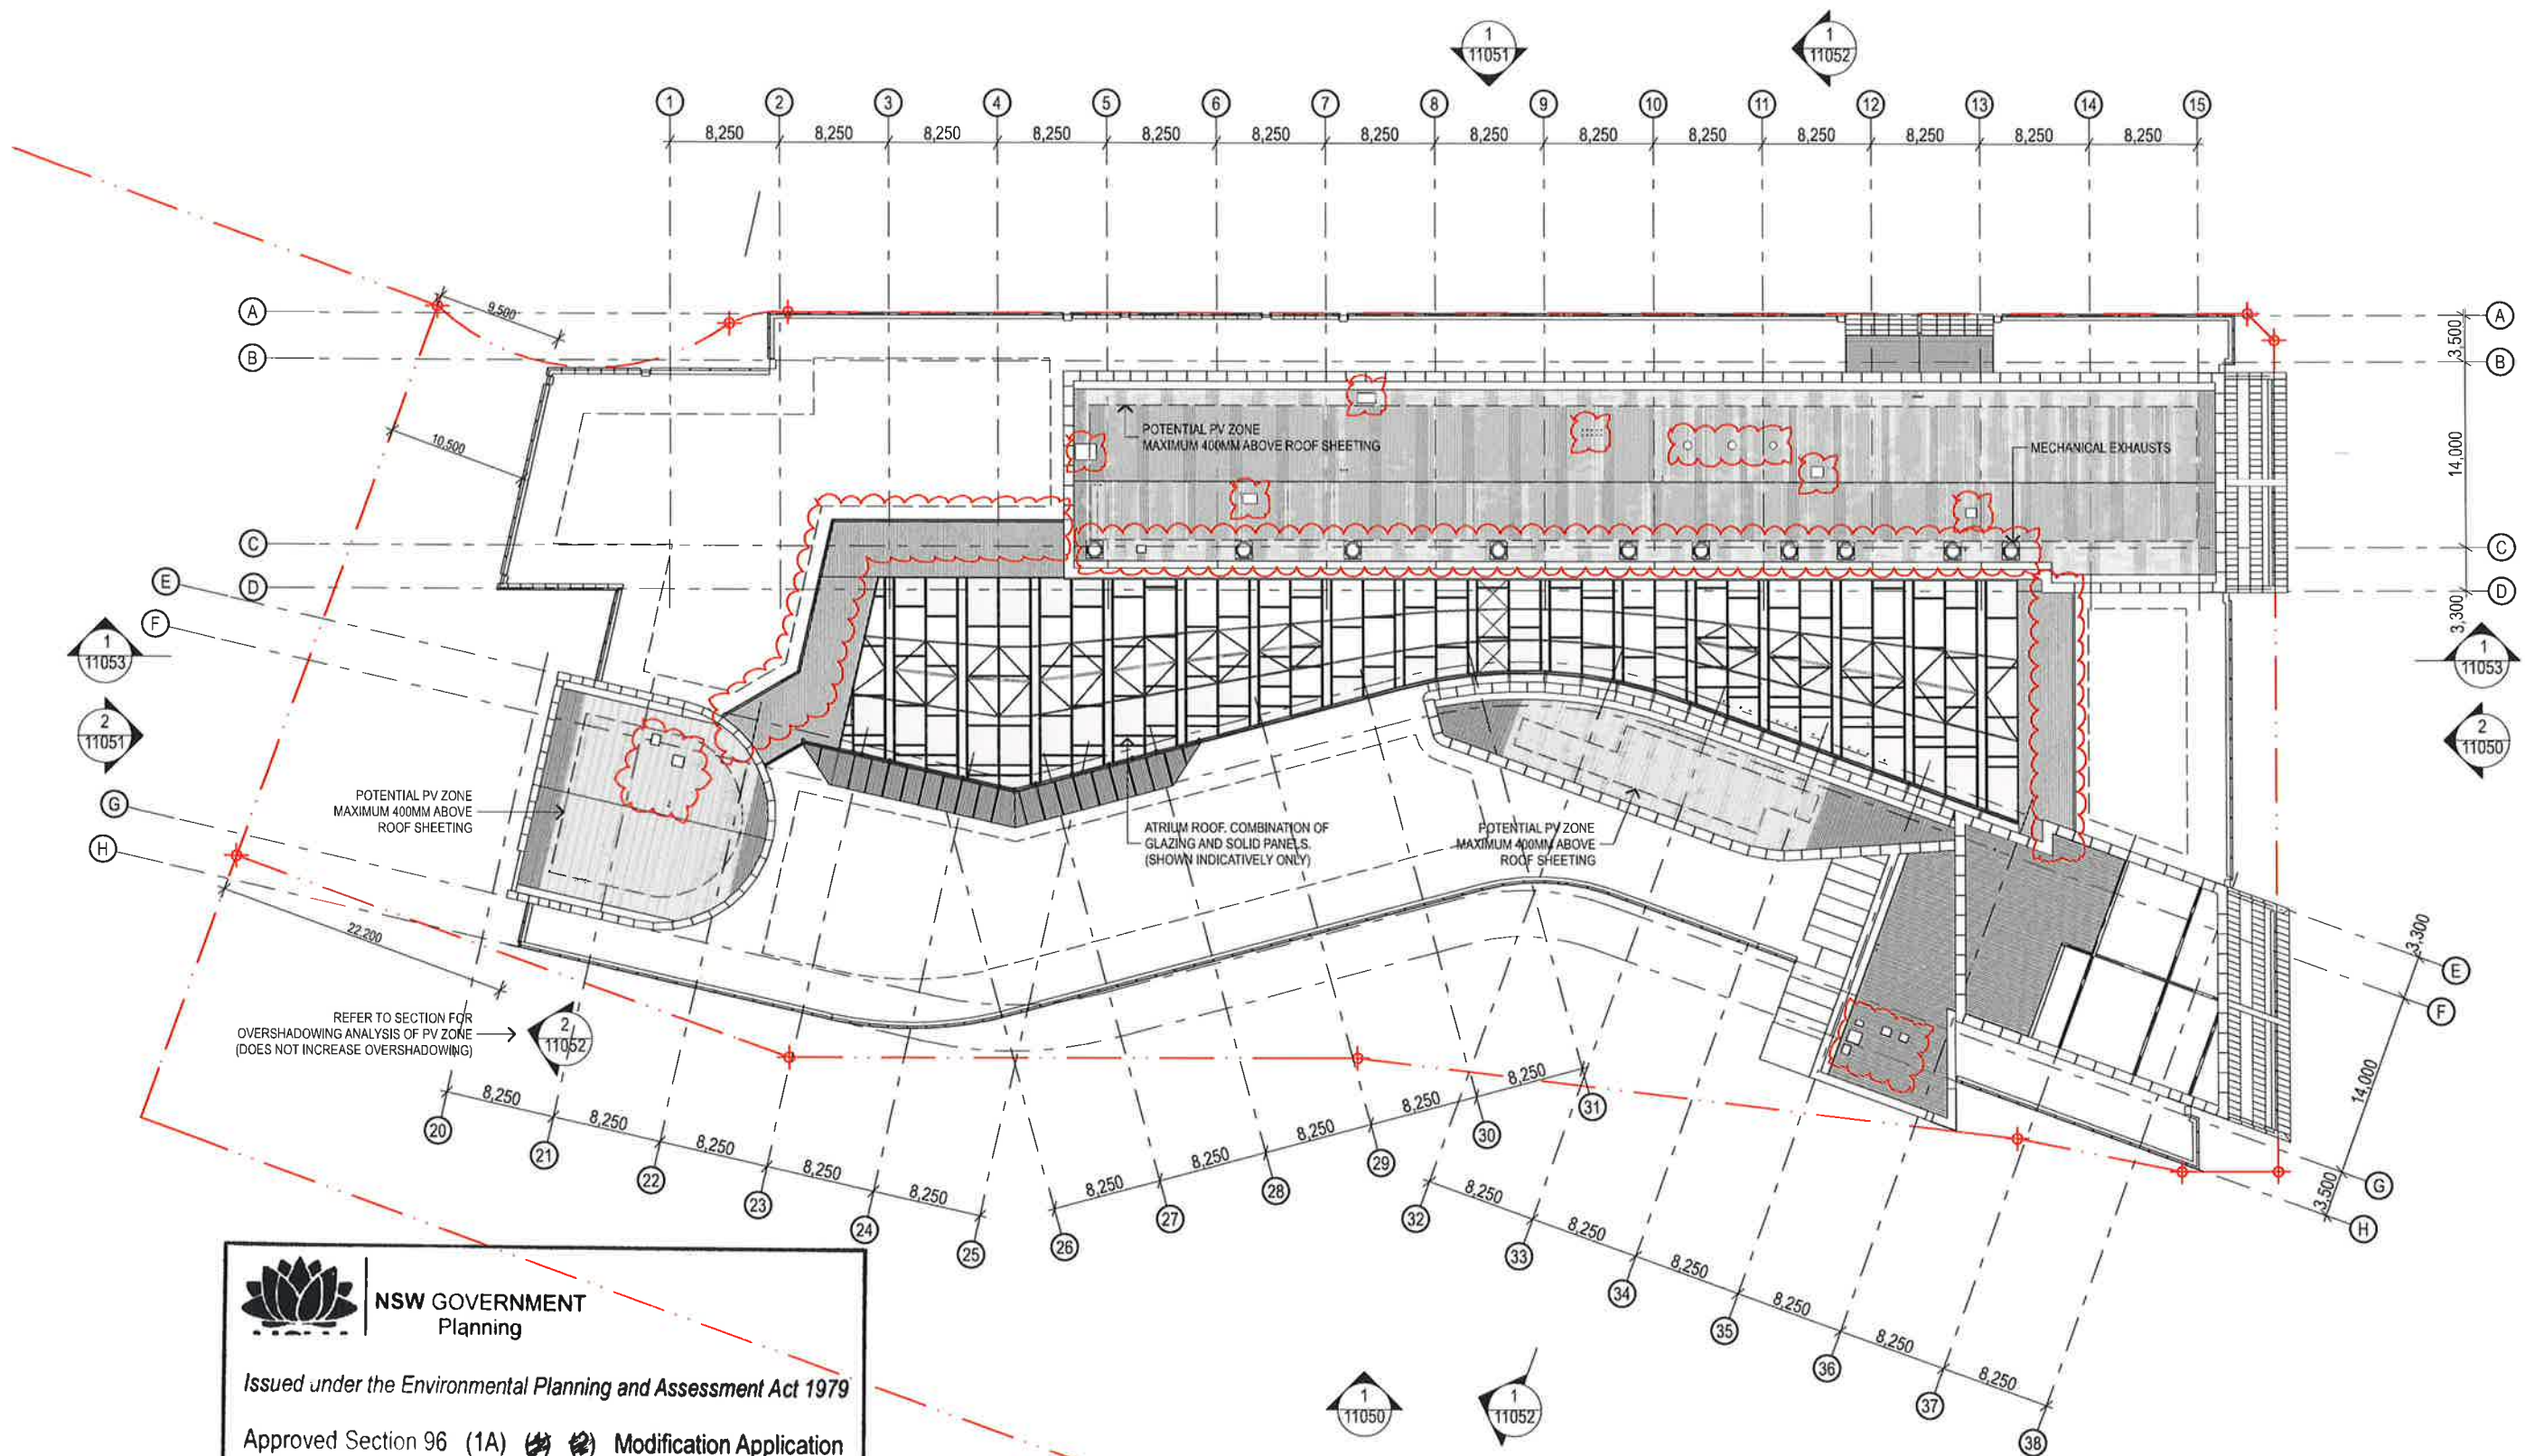

NSW GOVERNMENT Planning

Issued under the Environmental Planning and Assessment Act 1979

Approved Section 96 (1A) ~~1A~~ ~~2A~~ Modification Application

No 4 granted on the 20/10/2017

in respect to SSD 7317

Signed B. K. K.

Sheet No. 2 of 4

Roof Plan

MIRVAC - AUSTRALIAN TECHNOLOGY PARK - BUILDING 1

0 5 10 20m
1:500 @ A3

25/07/17

fjmt-AR-DWG-11009_DA7



NSW GOVERNMENT
Planning

Issued under the Environmental Planning and Assessment Act 1979



Approved Section 96 (1A) Modification Application

No. 4 granted on the 20/10/2017

Respect to SSP7317

Signed Br. K. K.

Sheet No. 3 of 4

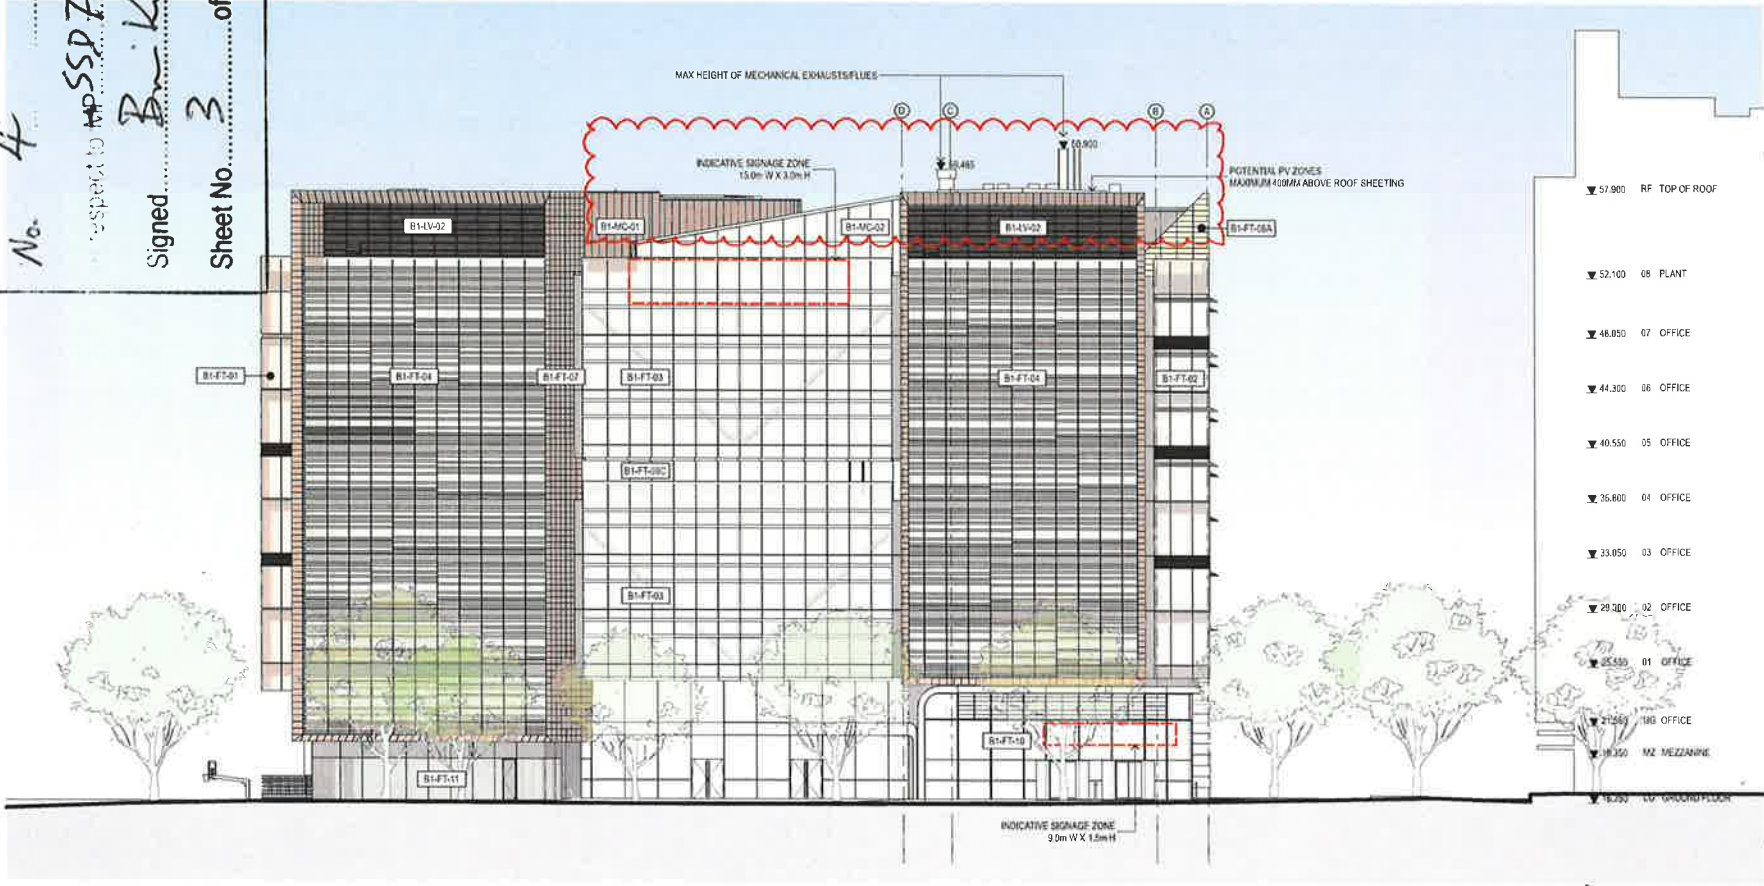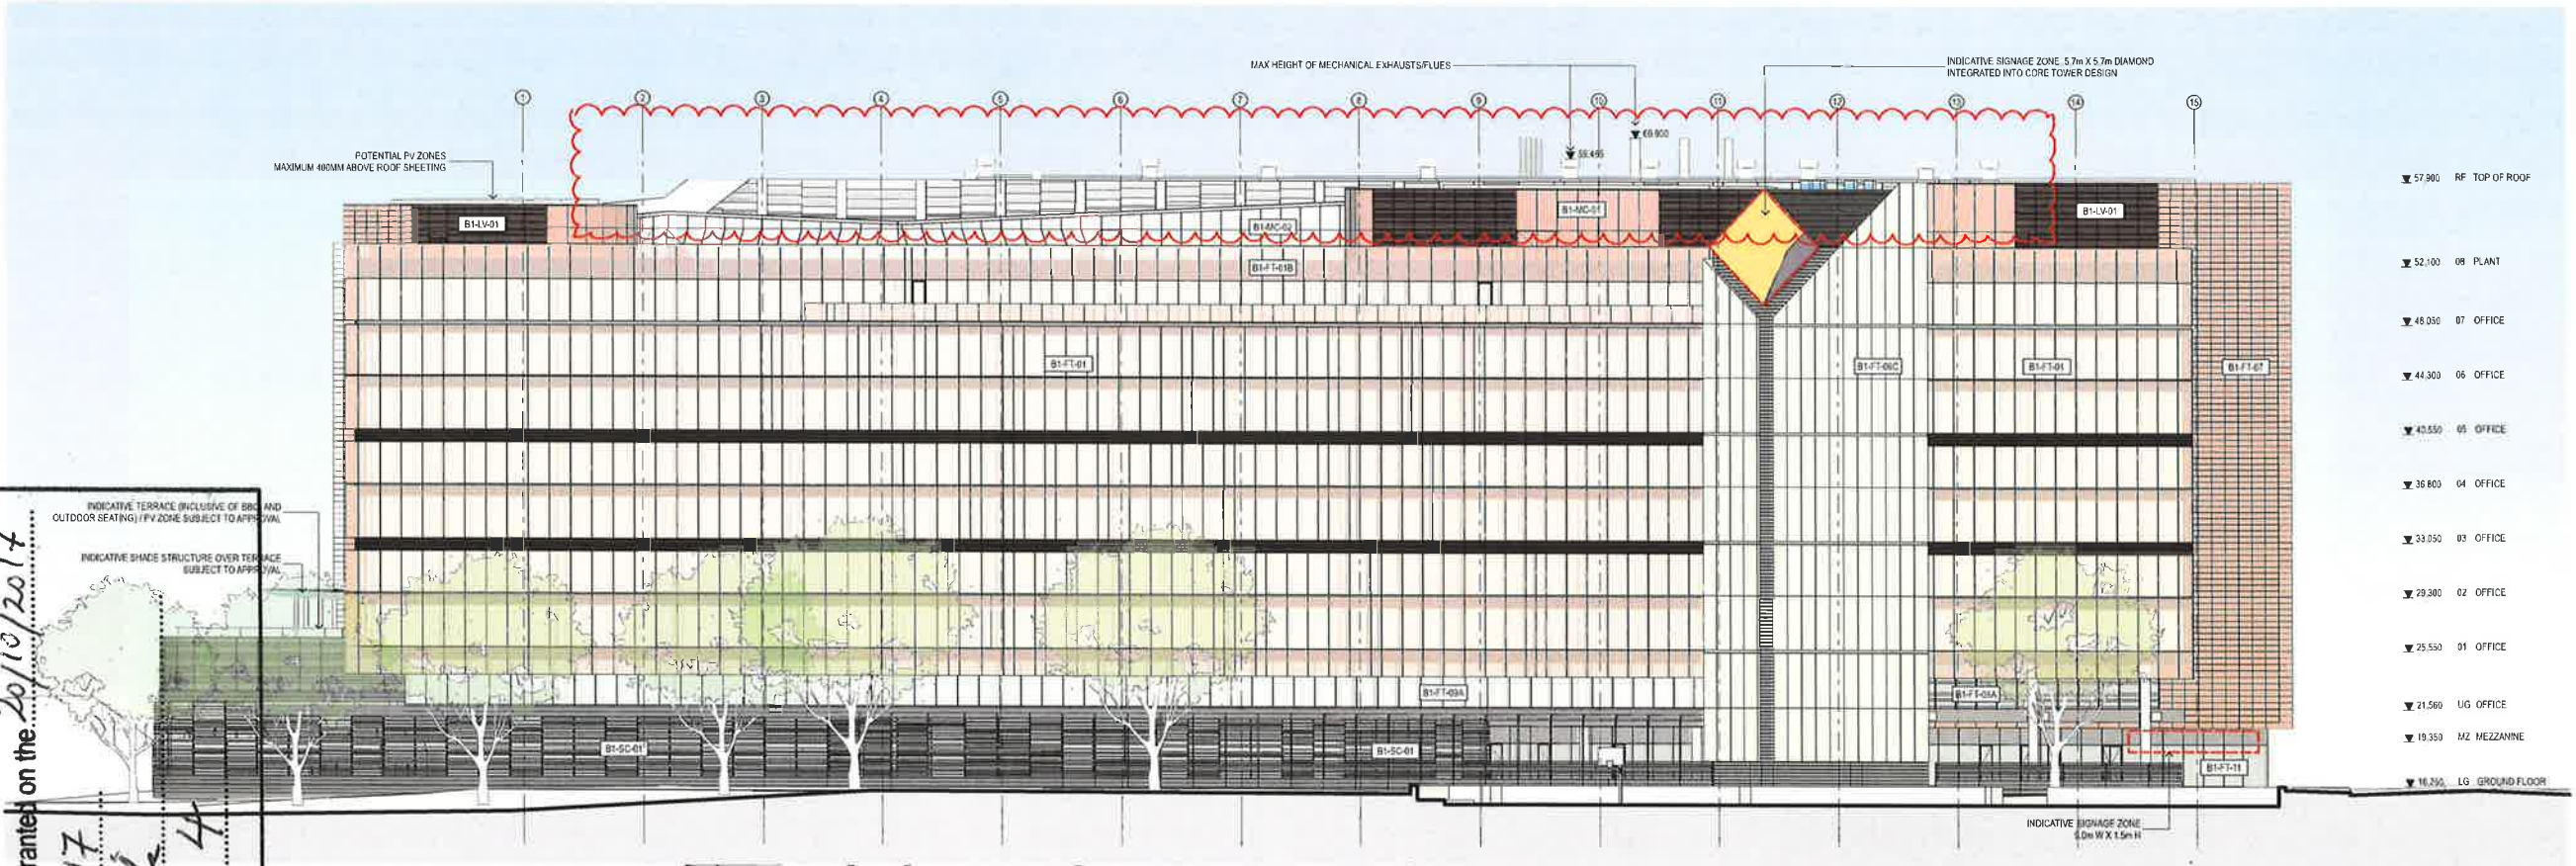

FACADE TYPE	LOCATION	DESCRIPTION
B1-FT-01	SOUTH VOLUMES	GLAZED CURTAIN WALL, PROFILED & GLAZED SPANDRELS
B1-FT-02	NORTH VOLUMES	GLAZED CURTAIN WALL, PROFILED & GLAZED SPANDRELS EXTERNAL ALUMINIUM SUNSHADES
B1-FT-03	EAST / WEST RECESSES	GLAZED CURTAIN WALL, GLAZED SPANDREL ALUMINIUM SUNSHADES
B1-FT-04	EAST VOLUMES	GLAZED CURTAIN WALL, GLAZED SPANDREL ALUMINIUM BATTENS
B1-FT-05	NORTH-WEST VOLUME	GLAZED CURTAIN WALL, GLAZED SPANDREL
B1-FT-06	CORE CLADDING NORTH CORE WEST CORE SOUTH CORE	SOLID PANEL CLADDING
B1-FT-07	EAST RETURNS	SOLID PANEL CLADDING
B1-FT-08	SOLID CLADDING AMENITIES NORTH-WEST VOLUME RECESS	SOLID PANEL CLADDING
B1-FT-09	WINDOW WALL UG SOUTH UG NORTH L4 EAST	GLAZED WINDOW WALL WITH ALUMINIUM BATTENS EAST OF CORE ONLY
B1-FT-10	LOBBY (GROUND FLOOR)	LOBBY GLAZING
B1-FT-11	RETAIL (GROUND FLOOR)	RETAIL GLAZING
B1-FT-12	CARPAK CLADDING	METAL ARCHITECTURAL SCREEN WITH SOLID AND BATTENS
B1-MC-01/02	ROOF PLANT	METAL SOLID CLADDING
B1-LV-01/02	ROOF PLANT	ALUMINIUM LOUVRES
B1-SC-01	SOUTH CHILDCARE	SCREEN WALL WITH OPPORTUNITY FOR INTEGRATED ARTWORK AND VERTICAL LANDSCAPING SUBJECT TO DEVELOPMENT OF ARTWORK STRATEGY



NSW GOVERNMENT
Planning

Issued under the Environmental Planning and Assessment Act 1979



Approved Section 96 (1A) ~~LA~~ Modification Application

No 4 granted on the 20/10/2017

in respect to ~~SSD 73/7~~

Signed *B. Kh*

Sheet No 4 of 4

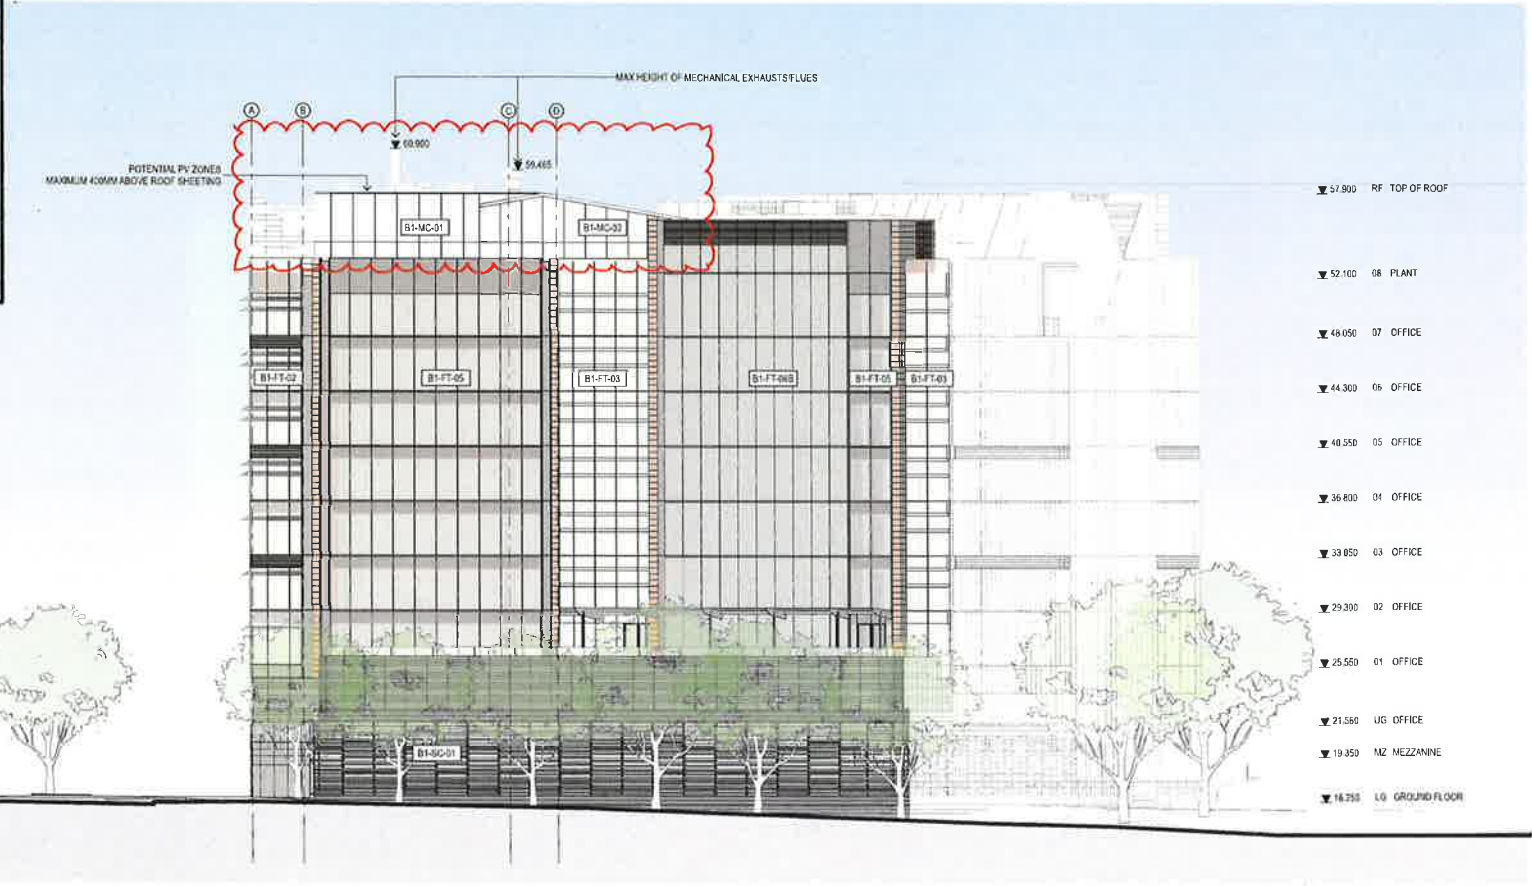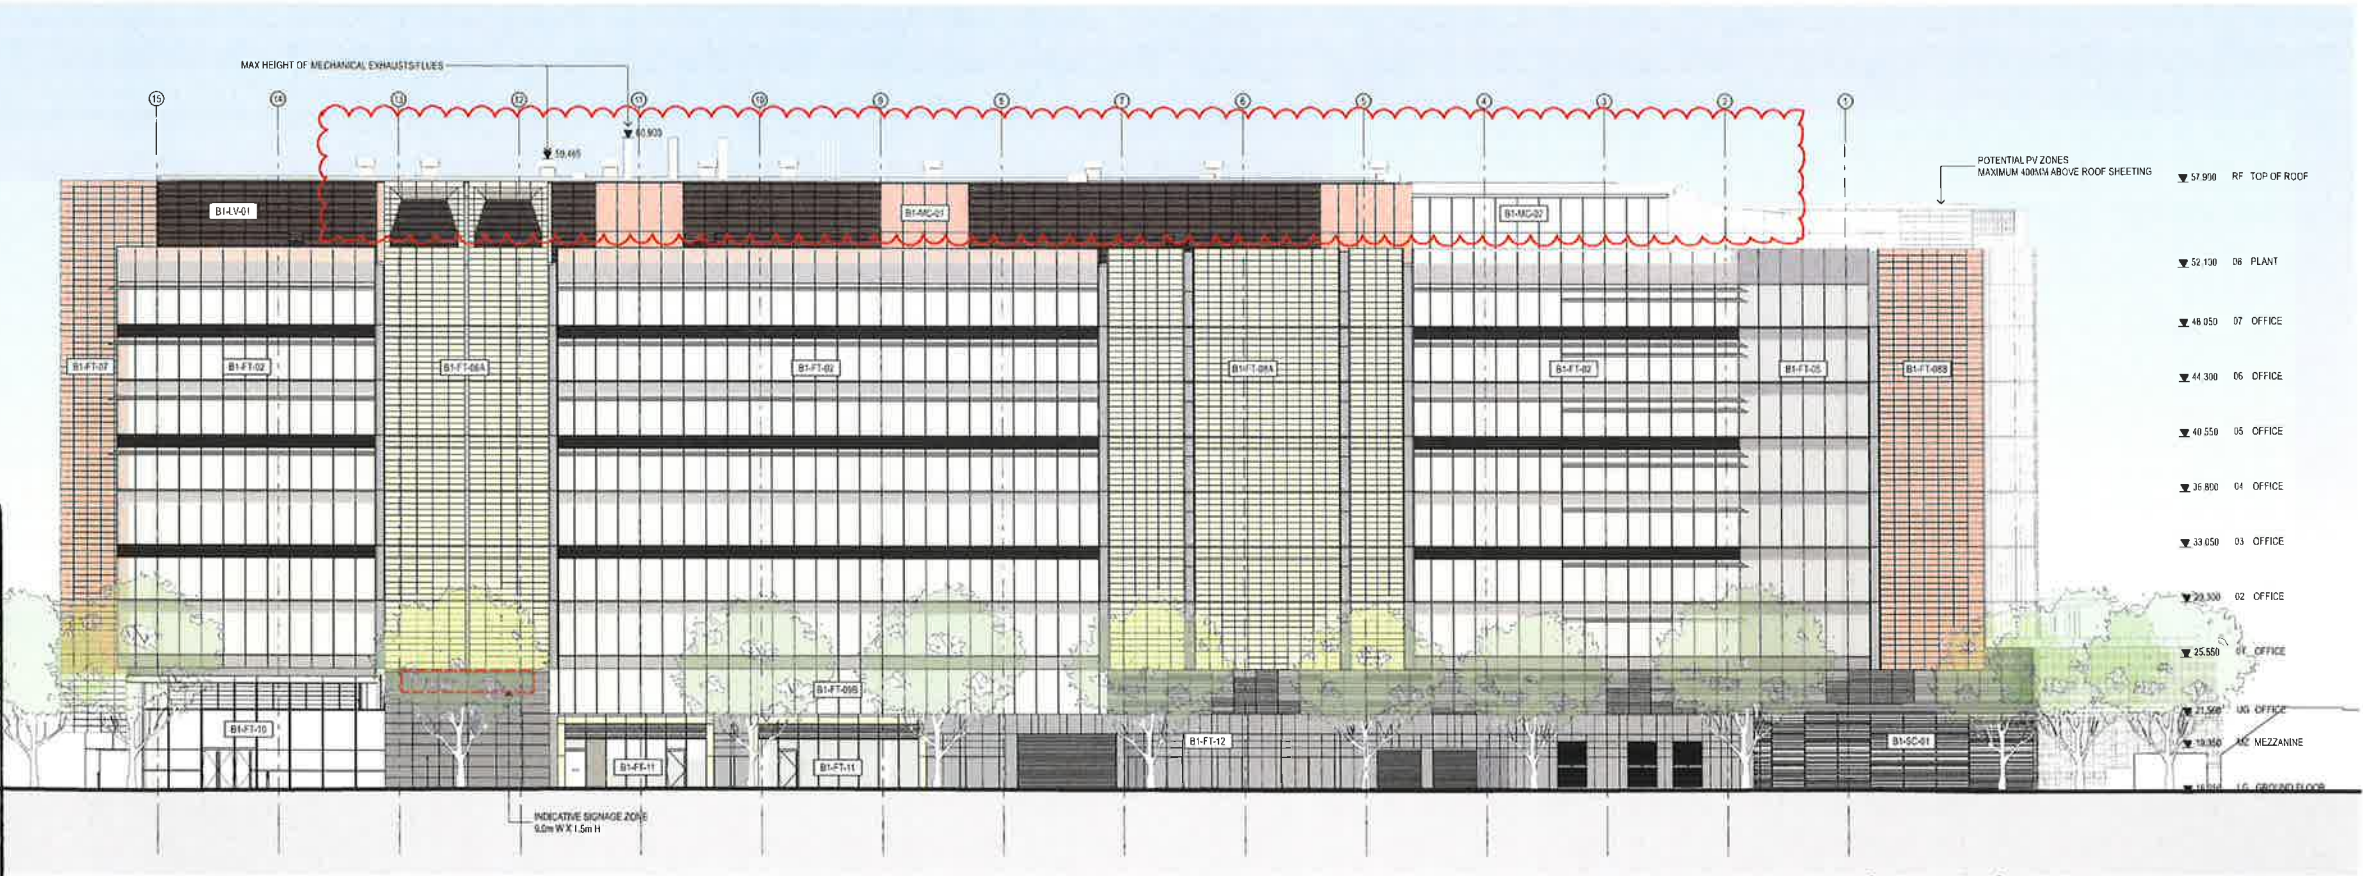

FACADE TYPE	LOCATION	DESCRIPTION
B1-FT-01	SOUTH VOLUMES	GLAZED CURTAIN WALL, PROFILED & GLAZED SPANDRELS
B1-FT-02	NORTH VOLUMES	GLAZED CURTAIN WALL, PROFILED & GLAZED SPANDRELS EXTERNAL ALUMINIUM SUNSHADES
B1-FT-03	EAST / WEST RECESSES	GLAZED CURTAIN WALL, GLAZED SPANDREL ALUMINIUM SUNSHADES
B1-FT-04	EAST VOLUMES	GLAZED CURTAIN WALL, GLAZED SPANDREL ALUMINIUM BATTENS
B1-FT-05	NORTH-WEST VOLUME	GLAZED CURTAIN WALL, GLAZED SPANDREL
B1-FT-06 A B C	CORE CLADDING NORTH CORE WEST CORE SOUTH CORE	SOLID PANEL CLADDING
B1-FT-07	EAST RETURNS	SOLID PANEL CLADDING
B1-FT-08 A B C	SOLID CLADDING AMENITIES NORTH-WEST VOLUME RECESS	SOLID PANEL CLADDING
B1-FT-09 A B C	WINDOW WALL UG SOUTH UG NORTH L4 EAST	GLAZED WINDOW WALL WITH ALUMINIUM BATTENS EAST OF CORE ONLY
B1-FT-10	LOBBY (GROUND FLOOR)	LOBBY GLAZING
B1-FT-11	RETAIL (GROUND FLOOR)	RETAIL GLAZING
B1-FT-12	CARPARK CLADDING	METAL ARCHITECTURAL SCREEN WITH SOLID AND BATTENS
B1-MC-01/02	ROOF PLANT	METAL SOLID CLADDING
B1-LV-01/02	ROOF PLANT	ALUMINIUM LOUVRES
B1-SC-01:	SOUTH CHILDCARE	SCREEN WALL WITH OPPORTUNITY FOR INTEGRATED ARTWORK AND VERTICAL LANDSCAPING SUBJECT TO DEVELOPMENT OF ARTWORK STRATEGY