

7 April 2020

Supriya Mukherji Sydney Trains Ground Floor (East), 36 - 46 George Street Burwood NSW 2134

Dear Supriya

2 FIGTREE DRIVE, SYDNEY OLYMPIC PARK (SSD 7662) **CONSENT CONDITION E22**

Mirvac is intending to obtain their third and fourth interim occupational certificates for Building 2 and 5 at 2B & 2D Figtree Drive, Sydney Olympic Park. In order to satisfy consent condition E22, summarised below, please see attached as-built drawings prepared by a Registered Surveyor confirming the location of the pile walls in the basement and the location of Building 2 and Building 5, in proximity to the rail corridor. Please review and provide written confirmation that the condition below has been satisfied.


E22 - Railway Corridor - Sydney Trains

Prior to the issue of each Occupation Certificate the Applicant is to submit the as-built drawings to Sydney Trains and Consent Authority. The as-built drawings are to be endorsed by a Registered Surveyor confirming that there has been no encroachment into Sydney Trains property or easement. The Principle Certifying Authority is not to issue the Occupation certificate until written confirmation has been received from Sydney Trains confirming that this condition has been satisfied.

Yours sincerely

Steven De Pasquale Senior Development Manager

Residential NSW

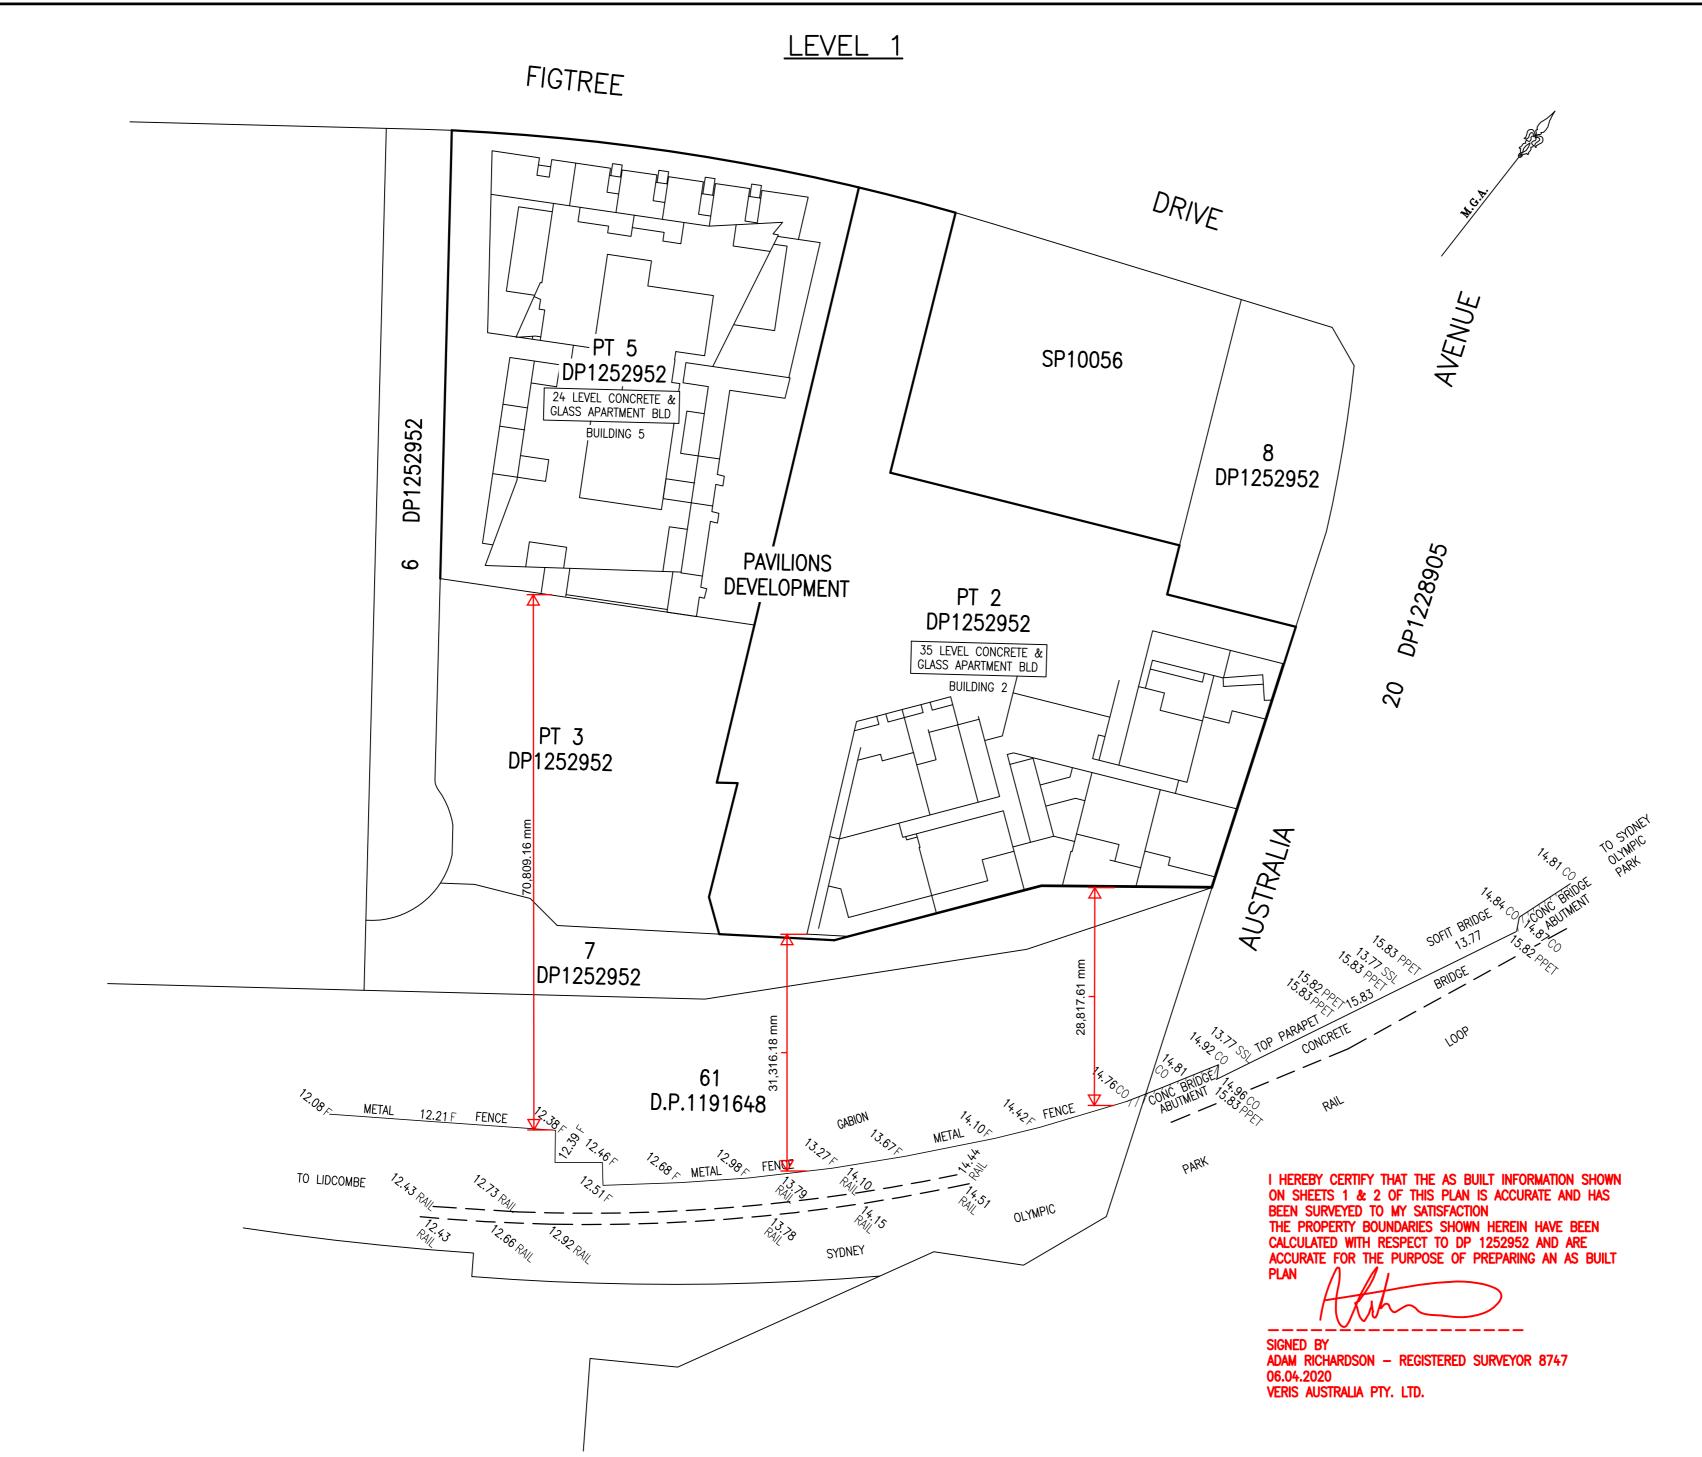

| SUE | DATE | AMENDMENT | BY | | | | | | |
|-----|------|-----------|----|--|--|--|--|--|--|
| | | | | | | | | | |
| | | | | | | | | | |
- ORIGIN OF LEVELS SSM 0000, R.L.00.000 (A.H.D.)
 BEARINGS ARE ON MGA NORTH
 NO BOUNDARY SURVEY HAS BEEN UNDERTAKEN.
 BEARINGS & DISTANCES HAVE BEEN COMPILED FROM TITLE AND/OR DEED INFORMATION SUPPLIED BY
 DEPARTMENT OF LANDS NSW. RELATIONSHIP OF IMPROVEMENTS AND DETAIL TO BOUNDARIES IS DIAGRAMMATIC ONLY AND SPECIFIC DETAILS,
- IF CRITICAL, WILL REQUIRE FURTHER SURVEY.

 SERVICES SHOWN ARE BASED ON VISIBLE SURFACE INDICATORS EVIDENT AT THE DATE OF SURVEY AND THE RELEVANT SERVICE DIAGRAMS OF THE VARIOUS AUTHORITIES. ALL SERVICE MUST BE VERIFIED ON SITE PRIOR
- TO ANY WORK BEING UNDERTAKEN. VERIS AUSTRALIA PTY LTD BEAR NO RESPONSIBILITY FOR THE ACCURACY OR COMPLETENESS OF THE SERVICES SHOWN HEREON.
- RIDGE, EAVE & GUTTER HEIGHTS HAVE BEEN OBTAINED BY AN INDIRECT METHOD AND ARE ACCURATE FOR PLANNING PURPOSES ONLY.
- ADJOINING BUILDINGS AND DWELLINGS HAVE BEEN PLOTTED FOR DIAGRAMMATIC PURPOSES ONLY AND SPECIFIC DETAILS, IF CRITICAL, WILL REQUIRE FURTHER SURVEY.
- THE DIAMETER (0), SPREAD (S) & HEIGHT (H) OF EACH TREE IS INDICATIVE ONLY AND SPECIFIC DETAILS, IF CRITICAL, WILL REQUIRE FURTHER SURVEY.

 CONTOURS ARE AN INDICATION OF THE TOPOGRAPHY ONLY. SPOT LEVELS SHOULD BE USED IF DETAILED
- DESIGN IS TO BE UNDERTAKEN.

LEGEND OF TYPICAL CODES

LEGEND OF TYPICAL SERVICES

| — c — | COMMUNICATIONS CABLE | | RECYCLED WATER |
|-----------|-------------------------------|----------|---------------------------|
| CSWP | CERAMIC STORMWATER PIPE | RM | RISING MAIN |
| — Е — | UNDERGROUND ELECTRICITY | | ROADS & MARITIME SERVICES |
| | CABLES | — s — | SEWER |
| —AE——AO— | UNDERGROUND ELECTRICITY & | —— so —— | SEWER OUTFALL |
| | OPTUS CABLES | —— st —— | SHARED TRENCH |
| —— FS —— | FIRE SERVICE | —— SW —— | STORM WATER |
| — G — | GAS LINE | —SWCK- | STORMWATER CREEK |
| —— GE —— | GAS LINE & ELECTRICITY CABLES | — T — | TELSTRA CABLES |
| NBN | NATIONAL BROAD BAND CABLES | —— тс —— | TELSTRA & GAS CABLES |
| NG | NATURAL GAS LINE | — U — | UNKNOWN SERVICE |
| — он — | OVERHEAD CABLES | —— vo —— | VOCUS CABLES |
| —— OPT —— | OPTUS CABLE | VR | VERIZON CABLES |
| —— PE —— | PRIVATE ELECTRICITY | — w — | WATER SUPPLY |
| PS | PRIVATE SEWER | —— ww —— | WATER MAIN |

- ALL UNDERGROUND SERVICE INFORMATION INCLUSIVE OF GENERAL POSITION AND SURFACE COVER DEPTHS NOTED ON THE PLAN ARE APPROXIMATELY ONLY.

 ALL UNDERGROUND SERVICE INFORMATION HAS BEEN COMPILED FROM SERVICE AUTHORITY PLANS PROVIDED SERVICE INFORMATION HAS BEEN COMPILED FROM SERVICE AUTHORITY PLANS PROVIDED
- BY THE AUTHORITIES. THE LOCATION OF SERVICES BETWEEN SURVEYED POINTS (AS INDICATED) HAVE BEEN SHOWN DIAGRAMMATICALLY ONLY USING THE SERVICE DIAGRAMS AS PROVIDED. THE EXACT LOCATION OF THESE SERVICES BETWEEN THE SURVEYED POINTS MUST BE VERIFIED PRIOR TO ANY EXCAVATION OR PILING. NO WARRANTY IS GIVEN AGAINST
- THE POSSIBILITY OF THE EXISTENCE OF FURTHER UNCHARTED SERVICES.
 ALL CONTRACTORS, TRADESMEN, BUILDING & PROJECT CONSULTANTS MUST CONTACT THE VARIOUS AUTHORITIES, IN ACCORDANCE WITH STANDARD "DIAL BEFORE YOU DIG" PROCEDURES PRIOR TO UNDERTAKING ANY WORKS WITHIN THE VICINITY OF THE SERVICE LINES TO VERIFY THE POSITION OF THE SERVICE LINES.



approved under Professional Standards Legislation



REDUCTION RATIO 1:500 10 15 20 25 30 35 40 45 50 LENGTHS ARE IN METRES

CLIENT: MIRVAC

TITLE No: 1/DP1252952 DATUM: A.H.D. DATE OF SURVEY: 16.01.20

SURVEYOR: AR DRAFTER: CC

ISSUE:1

REF: 140632

ISSUE DATE:06.04.20 SHEET SIZE:


SHEET 1 OF 2 SHEETS

PLAN SHOWING 'PAVILIONS' **BUILDING 2 & 5 IN PROXIMITY** TO THE SYDNEY OLYMPIC PARK RAIL LOOP CORRIDOR



Veris Australia Pty Ltd Suite 301, Level 3, 55 Holt Street Surry Hills NSW 2012 PO Box 1807 Strawberry Hills NSW 2012 t: (02) 92124655 email: surryhills@veris.com.au

web site: www.veris.com.au

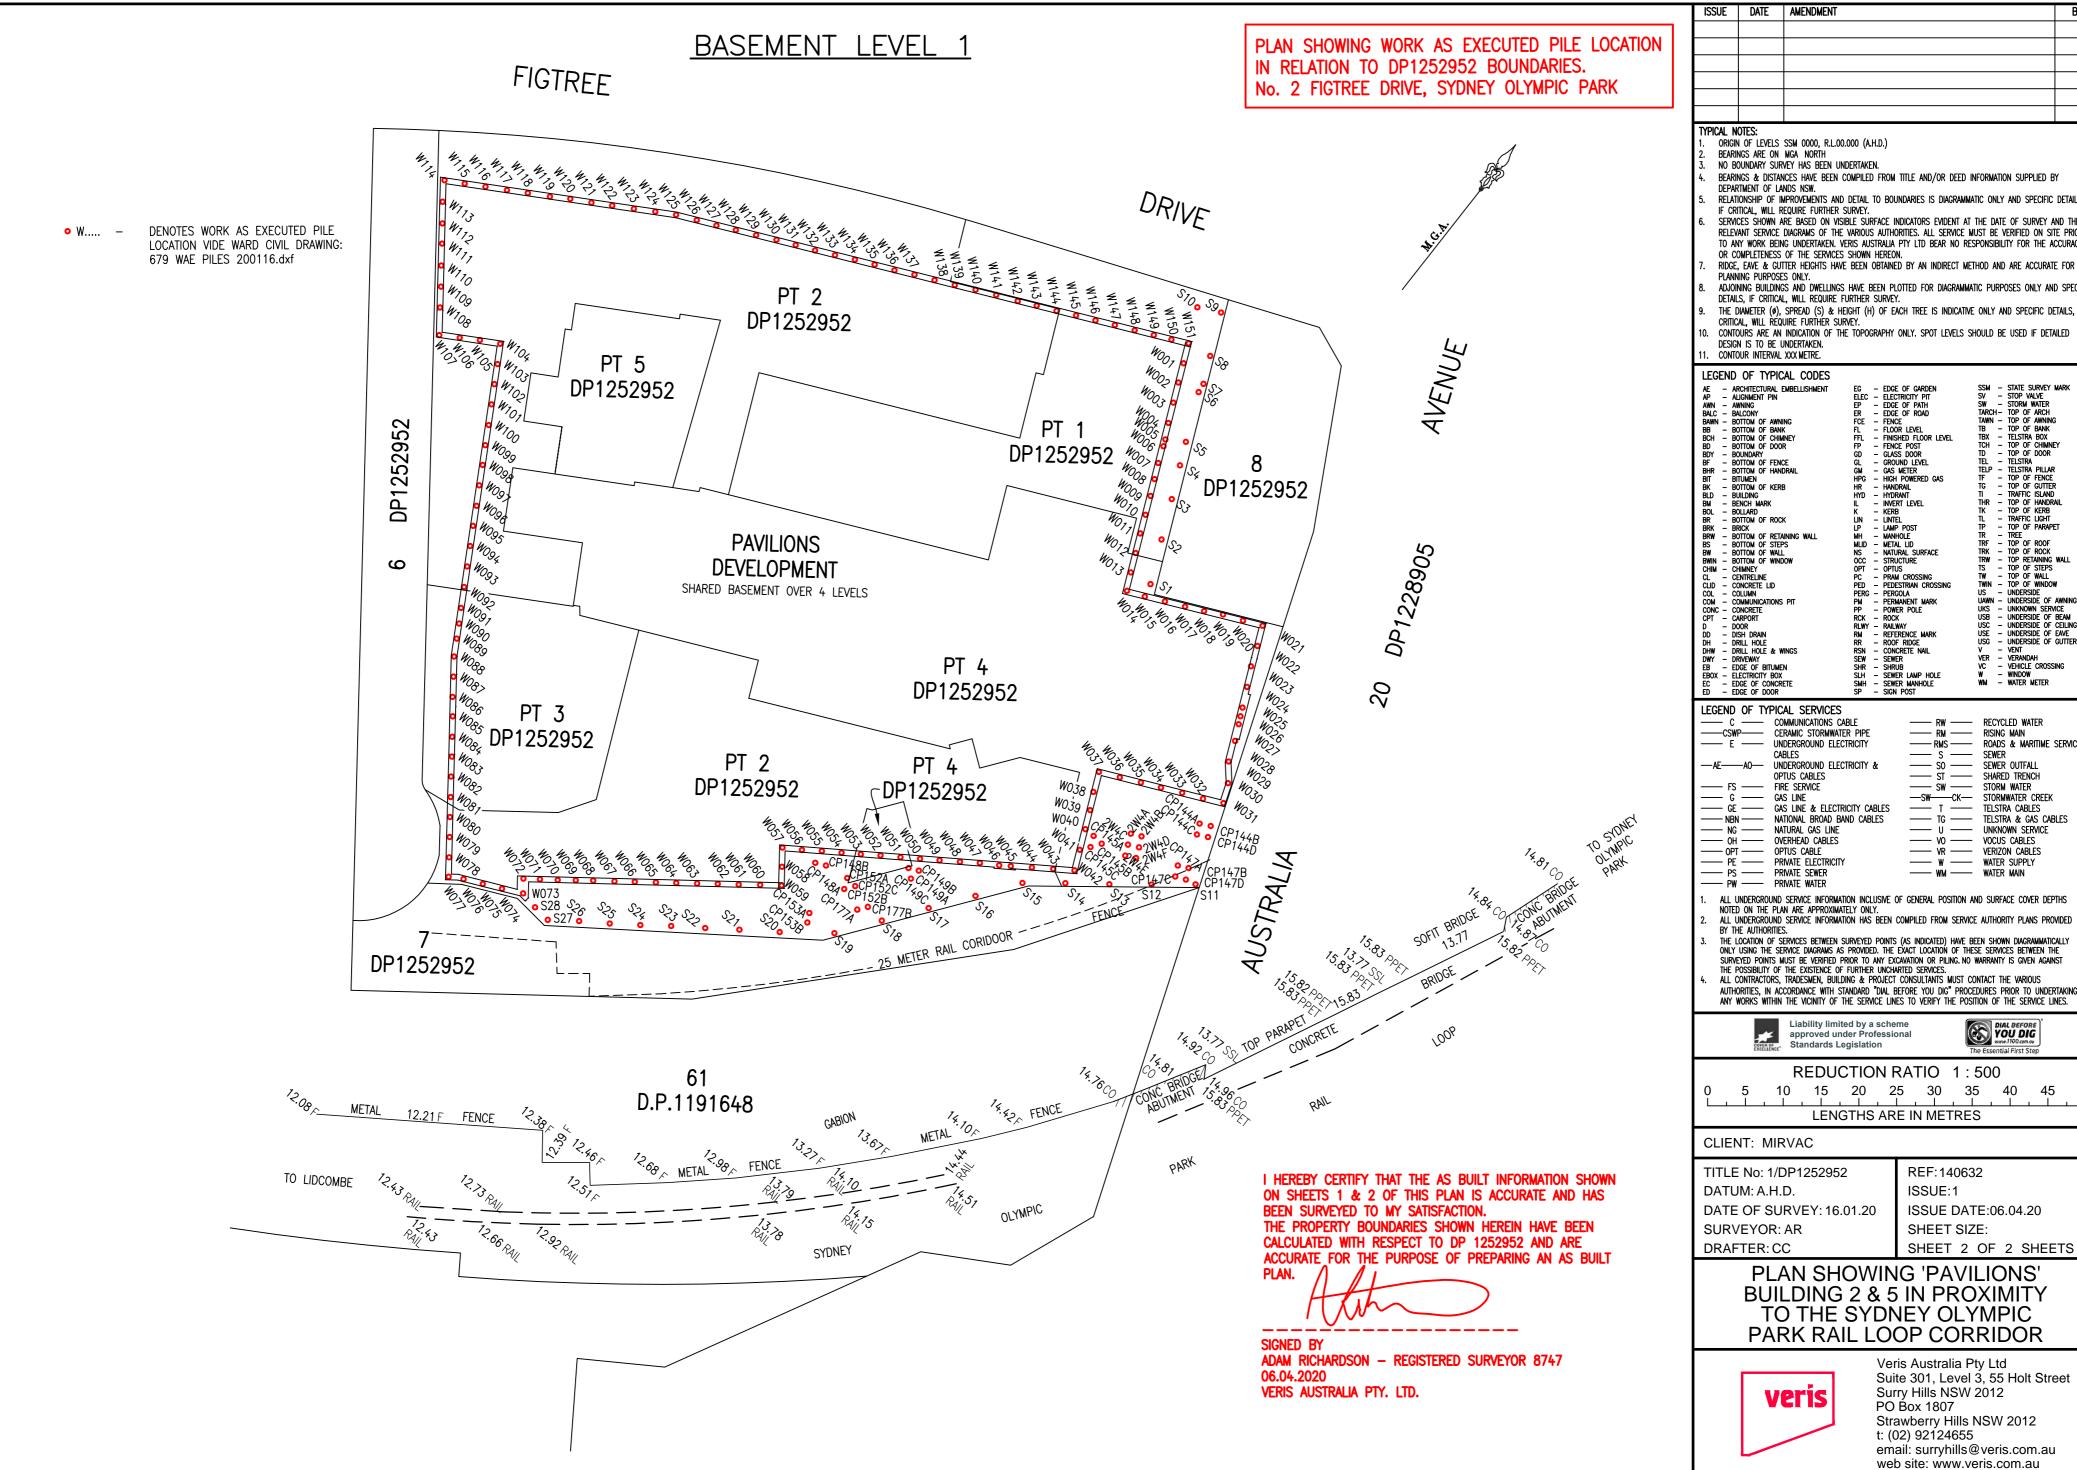

| ISSUE | DATE | AMENDMENT | BY |
|-------|------|-----------|----|
| | | | |
| | | | |
- BEARINGS & DISTANCES HAVE BEEN COMPILED FROM TITLE AND/OR DEED INFORMATION SUPPLIED BY
- IF CRITICAL, WILL REQUIRE FURTHER SURVEY.

 SERVICES SHOWN ARE BASED ON VISIBLE SURFACE INDICATORS EVIDENT AT THE DATE OF SURVEY AND THE RELEVANT SERVICE DIAGRAMS OF THE VARIOUS AUTHORITIES. ALL SERVICE MUST BE VERIFIED ON SITE PRIOR TO ANY WORK BEING UNDERTAKEN. VERIS AUSTRALIA PTY LTD BEAR NO RESPONSIBILITY FOR THE ACCURACY
- ADJOINING BUILDINGS AND DWELLINGS HAVE BEEN PLOTTED FOR DIAG

| LEGEND OF TYPICAL CODES AE — ARCHITECTURAL EMBELLISHMENT AP — ALICNMENT PIN AWN — AWNING BALC — BALCONY BAWN — BOTTOM OF BANK BCH — BOTTOM OF BANK BCH — BOTTOM OF CHIMNEY BB — BOTTOM OF FENCE BHP — BOTTOM OF FENCE BHR — BOTTOM OF KERB BLD — BUILDING BM — BENCH MARK BOL — BOLLARD BR — BOTTOM OF ROCK BRW — BOTTOM OF ROCK BRW — BOTTOM OF RETAINING WALL BSW — BOTTOM OF TEAL BWIN — BOTTOM OF TEAL BWIN — BOTTOM OF WALL | | | | | | |
|---|------|---|----------------------|-------|----|----------------------|
| AF _ APCHITECTURAL EMBELLISHMENT | FG | _ | FDCF OF CARDEN | SSM | _ | STATE SURVEY MARK |
| AP _ ALIGNMENT PIN | FLEC | _ | FI FCTRICITY PIT | SV | _ | STOP VALVE |
| AWN _ AWNING | FP | _ | FDCF OF PATH | SW | _ | STORM WATER |
| RAIC - RAICONY | FR | _ | FDGE OF ROAD | TARCH | 1- | TOP OF ARCH |
| BAWN - BOTTOM OF AWNING | FCF | _ | FENCE | TAWN | _ | TOP OF AWNING |
| RR - ROTTOM OF RANK | FI | _ | FLOOR LEVEL | TB | _ | TOP OF BANK |
| BCH - BOTTOM OF CHIMNEY | FFI | _ | FINISHED FLOOR LEVEL | TBX | _ | TELSTRA BOX |
| BD - BOTTOM OF DOOR | FP | _ | FENCE POST | TCH | _ | TOP OF CHIMNEY |
| RDY - ROLINDARY | GD. | _ | GLASS DOOR | TD | _ | TOP OF DOOR |
| BE - BOTTOM OF FENCE | GI | _ | GROUND LEVEL | TEL | _ | TELSTRA |
| BHR - BOTTOM OF HANDRAIL | GM | _ | GAS METER | TELP | _ | TELSTRA PILLAR |
| RIT - RITIMEN | HPG | _ | HIGH POWERED GAS | TF | _ | TOP OF FENCE |
| BK - BOTTOM OF KERB | HR | _ | HANDRAIL | TG | _ | TOP OF GUTTER |
| BID - BUILDING | HYD | _ | HYDRANT | TI | _ | TRAFFIC ISLAND |
| BM - BENCH MARK | IL. | _ | INVERT LEVEL | THR | _ | TOP OF HANDRAIL |
| BOL - BOLLARD | ĸ | _ | KERB | TK | _ | TOP OF KERB |
| BR - BOTTOM OF ROCK | LIN | _ | LINTEL | TL | _ | TRAFFIC LIGHT |
| BRK - BRICK | LP | _ | LAMP POST | TP | _ | TOP OF PARAPET |
| BRW — BOTTOM OF RETAINING WALL | MH | _ | MANHOLE | TR | _ | TREE |
| BS - BOTTOM OF STEPS | MLID | _ | METAL LID | TRF | - | TOP OF ROOF |
| BW - BOTTOM OF WALL | NS | _ | NATURAL SURFACE | TRK | - | TOP OF ROCK |
| BWIN - BOTTOM OF WINDOW | OCC | _ | STRUCTURE | TRW | - | TOP RETAINING WALL |
| CHIM - CHIMNEY | OPT | - | OPTUS | TS | - | TOP OF STEPS |
| CL – CENTRELINE | PC | - | PRAM CROSSING | TW | - | TOP OF WALL |
| CLID — CONCRETE LID | PED | - | PEDESTRIAN CROSSING | TWIN | - | TOP OF WINDOW |
| COL - COLUMN | PERG | - | PERGOLA | US | - | UNDERSIDE |
| COM - COMMUNICATIONS PIT | PM | - | PERMANENT MARK | UAWN | - | UNDERSIDE OF AWNING |
| CONC - CONCRETE | PP | - | POWER POLE | UKS | - | UNKNOWN SERVICE |
| CPT - CARPORT | RCK | - | ROCK | USB | - | UNDERSIDE OF BEAM |
| D - DOOR | RLWY | - | RAILWAY | USC | - | UNDERSIDE OF CEILING |
| DD — DISH DRAIN | RM | - | REFERENCE MARK | USE | - | UNDERSIDE OF EAVE |
| DH — DRILL HOLE | RR | - | ROOF RIDGE | USG | - | UNDERSIDE OF GUTTER |
| DHW - DRILL HOLE & WINGS | RSN | - | CONCRETE NAIL | ٧ | - | VENT |
| DWY - DRIVEWAY | SEW | - | SEWER | VER | - | VERANDAH |
| EB — EDGE OF BITUMEN | SHR | - | SHRUB | VC | - | VEHICLE CROSSING |
| EBOX — ELECTRICITY BOX | SLH | - | SEWER LAMP HOLE | W | - | WINDOW |
| | | | CEMED MANITULE | WM | | WALER MEIER |

| LD - LDGL OF D | 301 3101 | 1 1 0 3 1 | |
|----------------|-------------------------------|-----------|---------------------------|
| LEGEND OF TY | PICAL SERVICES | | |
| — c — | COMMUNICATIONS CABLE | RW | RECYCLED WATER |
| ——CSWP—— | CERAMIC STORMWATER PIPE | —— RM —— | RISING MAIN |
| I — E — | UNDERGROUND ELECTRICITY | —— RMS —— | ROADS & MARITIME SERVICES |
| | CABLES | — s — | SEWER |
| —AE——AO— | UNDERGROUND ELECTRICITY & | — so — | SEWER OUTFALL |
| | OPTUS CABLES | — rs — | SHARED TRENCH |
| — FS — | FIRE SERVICE | — sw — | STORM WATER |
| — G — | GAS LINE | —SW——CK— | STORMWATER CREEK |
| —— GE —— | GAS LINE & ELECTRICITY CABLES | — T — | TELSTRA CABLES |
| NBN | NATIONAL BROAD BAND CABLES | —— тG —— | TELSTRA & GAS CABLES |
| NG | NATURAL GAS LINE | — U — | UNKNOWN SERVICE |
| — он — | OVERHEAD CABLES | — vo — | VOCUS CABLES |
| OPT | OPTUS CABLE | VR | VERIZON CABLES |
| —— РЕ —— | PRIVATE ELECTRICITY | — w — | WATER SUPPLY |
| —— PS —— | PRIVATE SEWER | —— wм —— | WATER MAIN |
| PW | PRIVATE WATER | | |

- ALL UNDERGROUND SERVICE INFORMATION INCLUSIVE OF GENERAL POSITION AND SURFACE COVER DEPTHS NOTED ON THE PLAN ARE APPROXIMATELY ONLY.

 ALL UNDERGROUND SERVICE INFORMATION HAS BEEN COMPILED FROM SERVICE AUTHORITY PLANS PROVIDED.
- BY THE AUTHORITIES.

 THE LOCATION OF SERVICES BETWEEN SURVEYED POINTS (AS INDICATED) HAVE BEEN SHOWN DIAGRAMMATICALLY ONLY USING THE SERVICE DIAGRAMS AS PROVIDED. THE EXACT LOCATION OF THESE SERVICES BETWEEN THE SURVEYED POINTS MUST BE VERIFIED PRIOR TO ANY EXCAVATION OR PILING, NO WARRANTY IS GIVEN AGAINST
- AUTHORITIES, IN ACCORDANCE WITH STANDARD "DIAL BEFORE YOU DIG" PROCEDURES PRIOR TO UNDERTAKING ANY WORKS WITHIN THE VICINITY OF THE SERVICE LINES TO VERIFY THE POSITION OF THE SERVICE LINES.


DIAL BEFORE
YOU DIG

LENGTHS ARE IN METRES

ISSUE DATE:06.04.20 SHEET SIZE:

PLAN SHOWING 'PAVILIONS' **BUILDING 2 & 5 IN PROXIMITY** TO THE SYDNEY OLYMPIC PARK RAIL LOOP CORRIDOR

> Veris Australia Pty Ltd Suite 301, Level 3, 55 Holt Street Surry Hills NSW 2012 PO Box 1807 Strawberry Hills NSW 2012 t: (02) 92124655 email: surryhills@veris.com.au

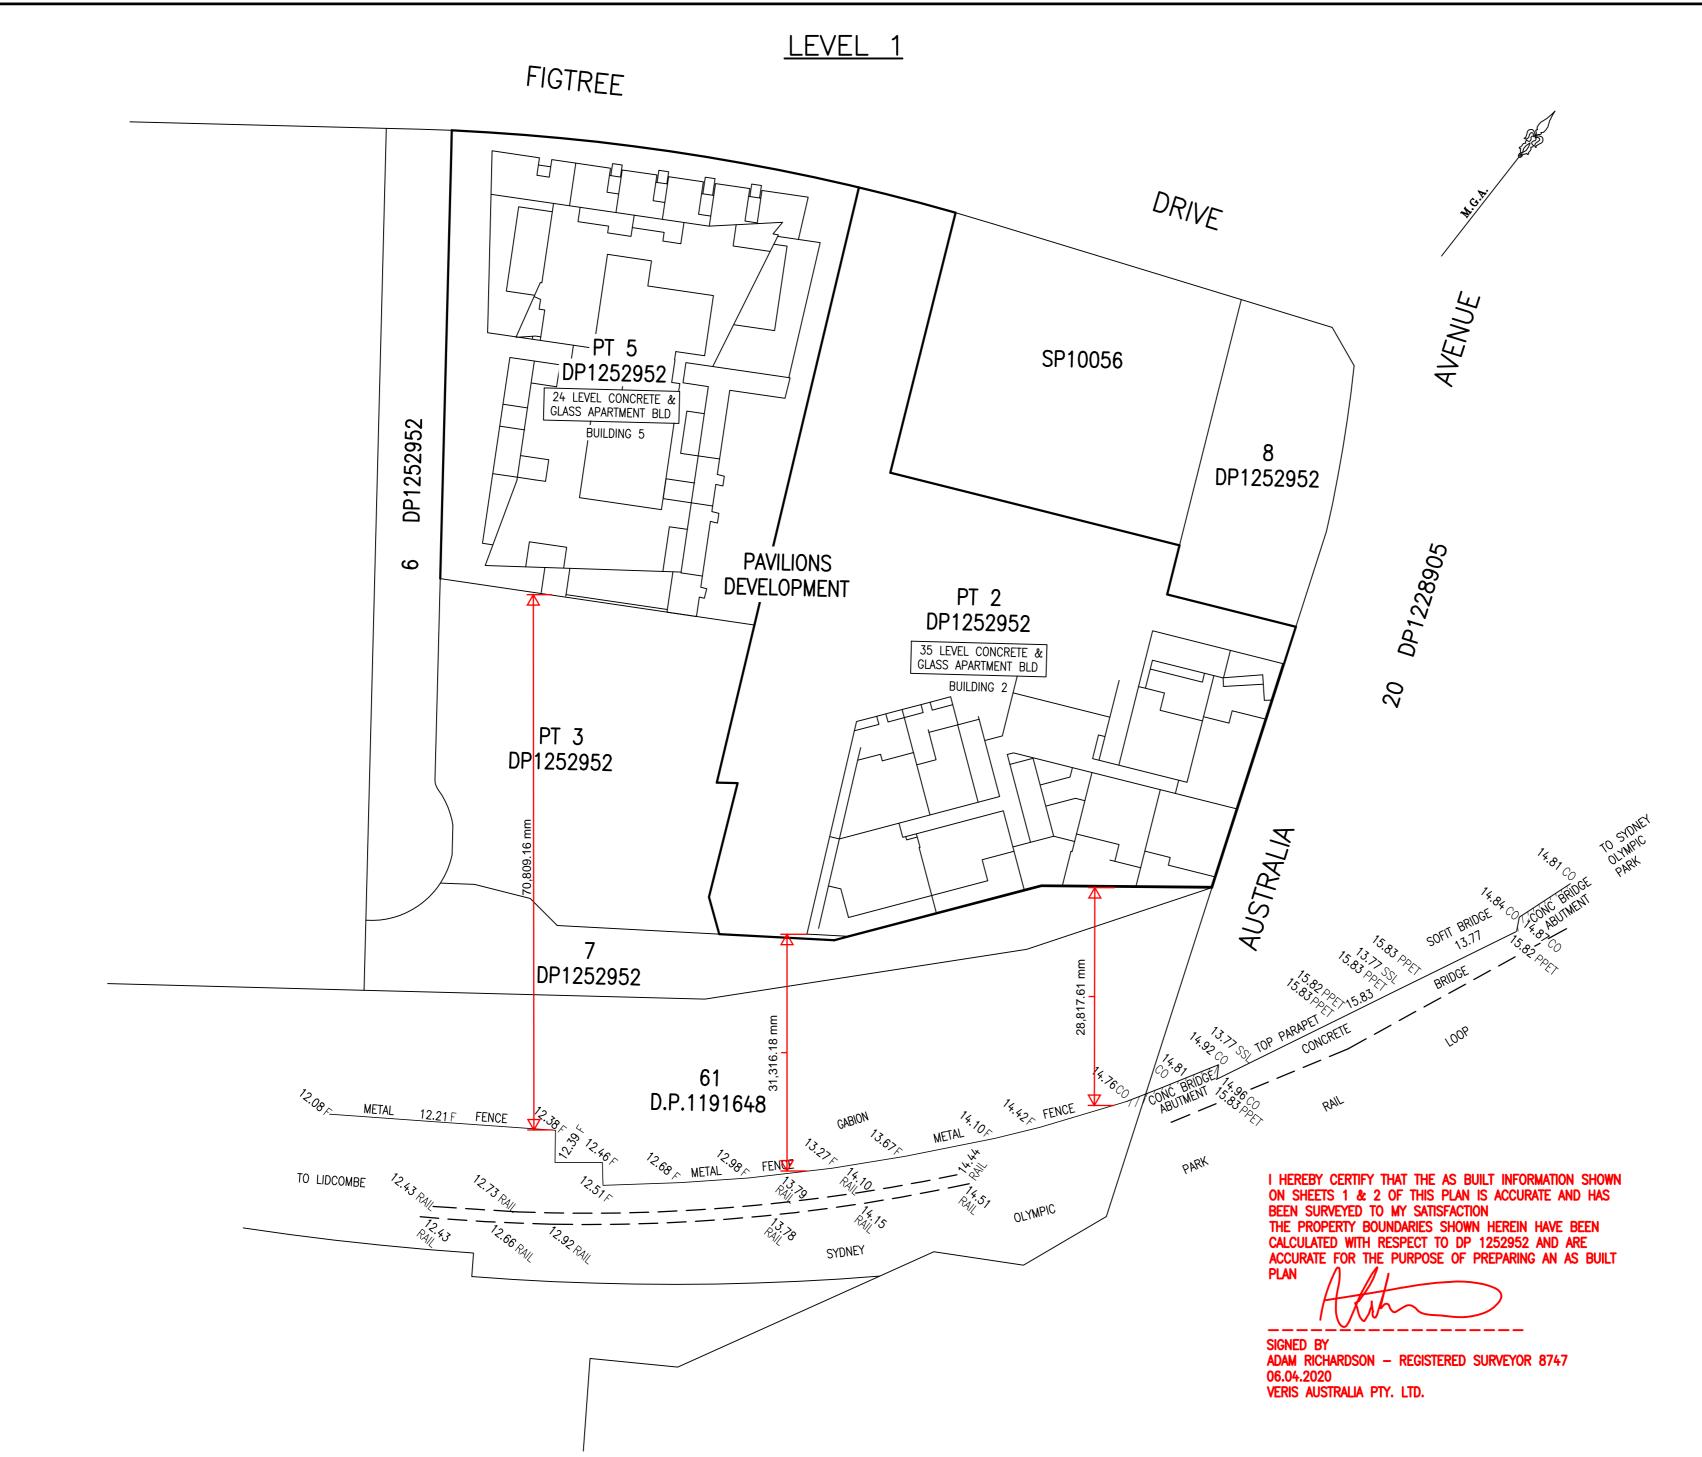

| SUE | DATE | AMENDMENT | BY | | | | | | |
|-----|------|-----------|----|--|--|--|--|--|--|
| | | | | | | | | | |
| | | | | | | | | | |
- ORIGIN OF LEVELS SSM 0000, R.L.00.000 (A.H.D.)
 BEARINGS ARE ON MGA NORTH
 NO BOUNDARY SURVEY HAS BEEN UNDERTAKEN.
 BEARINGS & DISTANCES HAVE BEEN COMPILED FROM TITLE AND/OR DEED INFORMATION SUPPLIED BY
 DEPARTMENT OF LANDS NSW. RELATIONSHIP OF IMPROVEMENTS AND DETAIL TO BOUNDARIES IS DIAGRAMMATIC ONLY AND SPECIFIC DETAILS,
- IF CRITICAL, WILL REQUIRE FURTHER SURVEY.

 SERVICES SHOWN ARE BASED ON VISIBLE SURFACE INDICATORS EVIDENT AT THE DATE OF SURVEY AND THE RELEVANT SERVICE DIAGRAMS OF THE VARIOUS AUTHORITIES. ALL SERVICE MUST BE VERIFIED ON SITE PRIOR
- TO ANY WORK BEING UNDERTAKEN. VERIS AUSTRALIA PTY LTD BEAR NO RESPONSIBILITY FOR THE ACCURACY OR COMPLETENESS OF THE SERVICES SHOWN HEREON.
- RIDGE, EAVE & GUTTER HEIGHTS HAVE BEEN OBTAINED BY AN INDIRECT METHOD AND ARE ACCURATE FOR PLANNING PURPOSES ONLY.
- ADJOINING BUILDINGS AND DWELLINGS HAVE BEEN PLOTTED FOR DIAGRAMMATIC PURPOSES ONLY AND SPECIFIC DETAILS, IF CRITICAL, WILL REQUIRE FURTHER SURVEY.
- THE DIAMETER (0), SPREAD (S) & HEIGHT (H) OF EACH TREE IS INDICATIVE ONLY AND SPECIFIC DETAILS, IF CRITICAL, WILL REQUIRE FURTHER SURVEY.

 CONTOURS ARE AN INDICATION OF THE TOPOGRAPHY ONLY. SPOT LEVELS SHOULD BE USED IF DETAILED
- DESIGN IS TO BE UNDERTAKEN.

LEGEND OF TYPICAL CODES

LEGEND OF TYPICAL SERVICES

| — c — | COMMUNICATIONS CABLE | | RECYCLED WATER |
|-----------|-------------------------------|-----------|---------------------------|
| CSWP | CERAMIC STORMWATER PIPE | RM | RISING MAIN |
| — Е — | UNDERGROUND ELECTRICITY | —— RMS —— | ROADS & MARITIME SERVICES |
| | CABLES | — s — | SEWER |
| —AE——AO— | UNDERGROUND ELECTRICITY & | —— so —— | SEWER OUTFALL |
| | OPTUS CABLES | —— st —— | SHARED TRENCH |
| —— FS —— | FIRE SERVICE | —— SW —— | STORM WATER |
| — G — | GAS LINE | —SWCK- | STORMWATER CREEK |
| —— GE —— | GAS LINE & ELECTRICITY CABLES | — T — | TELSTRA CABLES |
| NBN | NATIONAL BROAD BAND CABLES | —— тс —— | TELSTRA & GAS CABLES |
| NG | NATURAL GAS LINE | — U — | UNKNOWN SERVICE |
| — он — | OVERHEAD CABLES | —— vo —— | VOCUS CABLES |
| —— OPT —— | OPTUS CABLE | VR | VERIZON CABLES |
| —— PE —— | PRIVATE ELECTRICITY | — w — | WATER SUPPLY |
| PS | PRIVATE SEWER | —— ww —— | WATER MAIN |

- ALL UNDERGROUND SERVICE INFORMATION INCLUSIVE OF GENERAL POSITION AND SURFACE COVER DEPTHS NOTED ON THE PLAN ARE APPROXIMATELY ONLY.

 ALL UNDERGROUND SERVICE INFORMATION HAS BEEN COMPILED FROM SERVICE AUTHORITY PLANS PROVIDED SERVICE INFORMATION HAS BEEN COMPILED FROM SERVICE AUTHORITY PLANS PROVIDED
- BY THE AUTHORITIES. THE LOCATION OF SERVICES BETWEEN SURVEYED POINTS (AS INDICATED) HAVE BEEN SHOWN DIAGRAMMATICALLY ONLY USING THE SERVICE DIAGRAMS AS PROVIDED. THE EXACT LOCATION OF THESE SERVICES BETWEEN THE SURVEYED POINTS MUST BE VERIFIED PRIOR TO ANY EXCAVATION OR PILING. NO WARRANTY IS GIVEN AGAINST
- THE POSSIBILITY OF THE EXISTENCE OF FURTHER UNCHARTED SERVICES.
 ALL CONTRACTORS, TRADESMEN, BUILDING & PROJECT CONSULTANTS MUST CONTACT THE VARIOUS AUTHORITIES, IN ACCORDANCE WITH STANDARD "DIAL BEFORE YOU DIG" PROCEDURES PRIOR TO UNDERTAKING ANY WORKS WITHIN THE VICINITY OF THE SERVICE LINES TO VERIFY THE POSITION OF THE SERVICE LINES.



approved under Professional Standards Legislation



REDUCTION RATIO 1:500 10 15 20 25 30 35 40 45 50 LENGTHS ARE IN METRES

CLIENT: MIRVAC

TITLE No: 1/DP1252952 DATUM: A.H.D. DATE OF SURVEY: 16.01.20

SURVEYOR: AR DRAFTER: CC

ISSUE:1

REF: 140632

ISSUE DATE:06.04.20 SHEET SIZE:


SHEET 1 OF 2 SHEETS

PLAN SHOWING 'PAVILIONS' **BUILDING 2 & 5 IN PROXIMITY** TO THE SYDNEY OLYMPIC PARK RAIL LOOP CORRIDOR



Veris Australia Pty Ltd Suite 301, Level 3, 55 Holt Street Surry Hills NSW 2012 PO Box 1807 Strawberry Hills NSW 2012 t: (02) 92124655 email: surryhills@veris.com.au

web site: www.veris.com.au

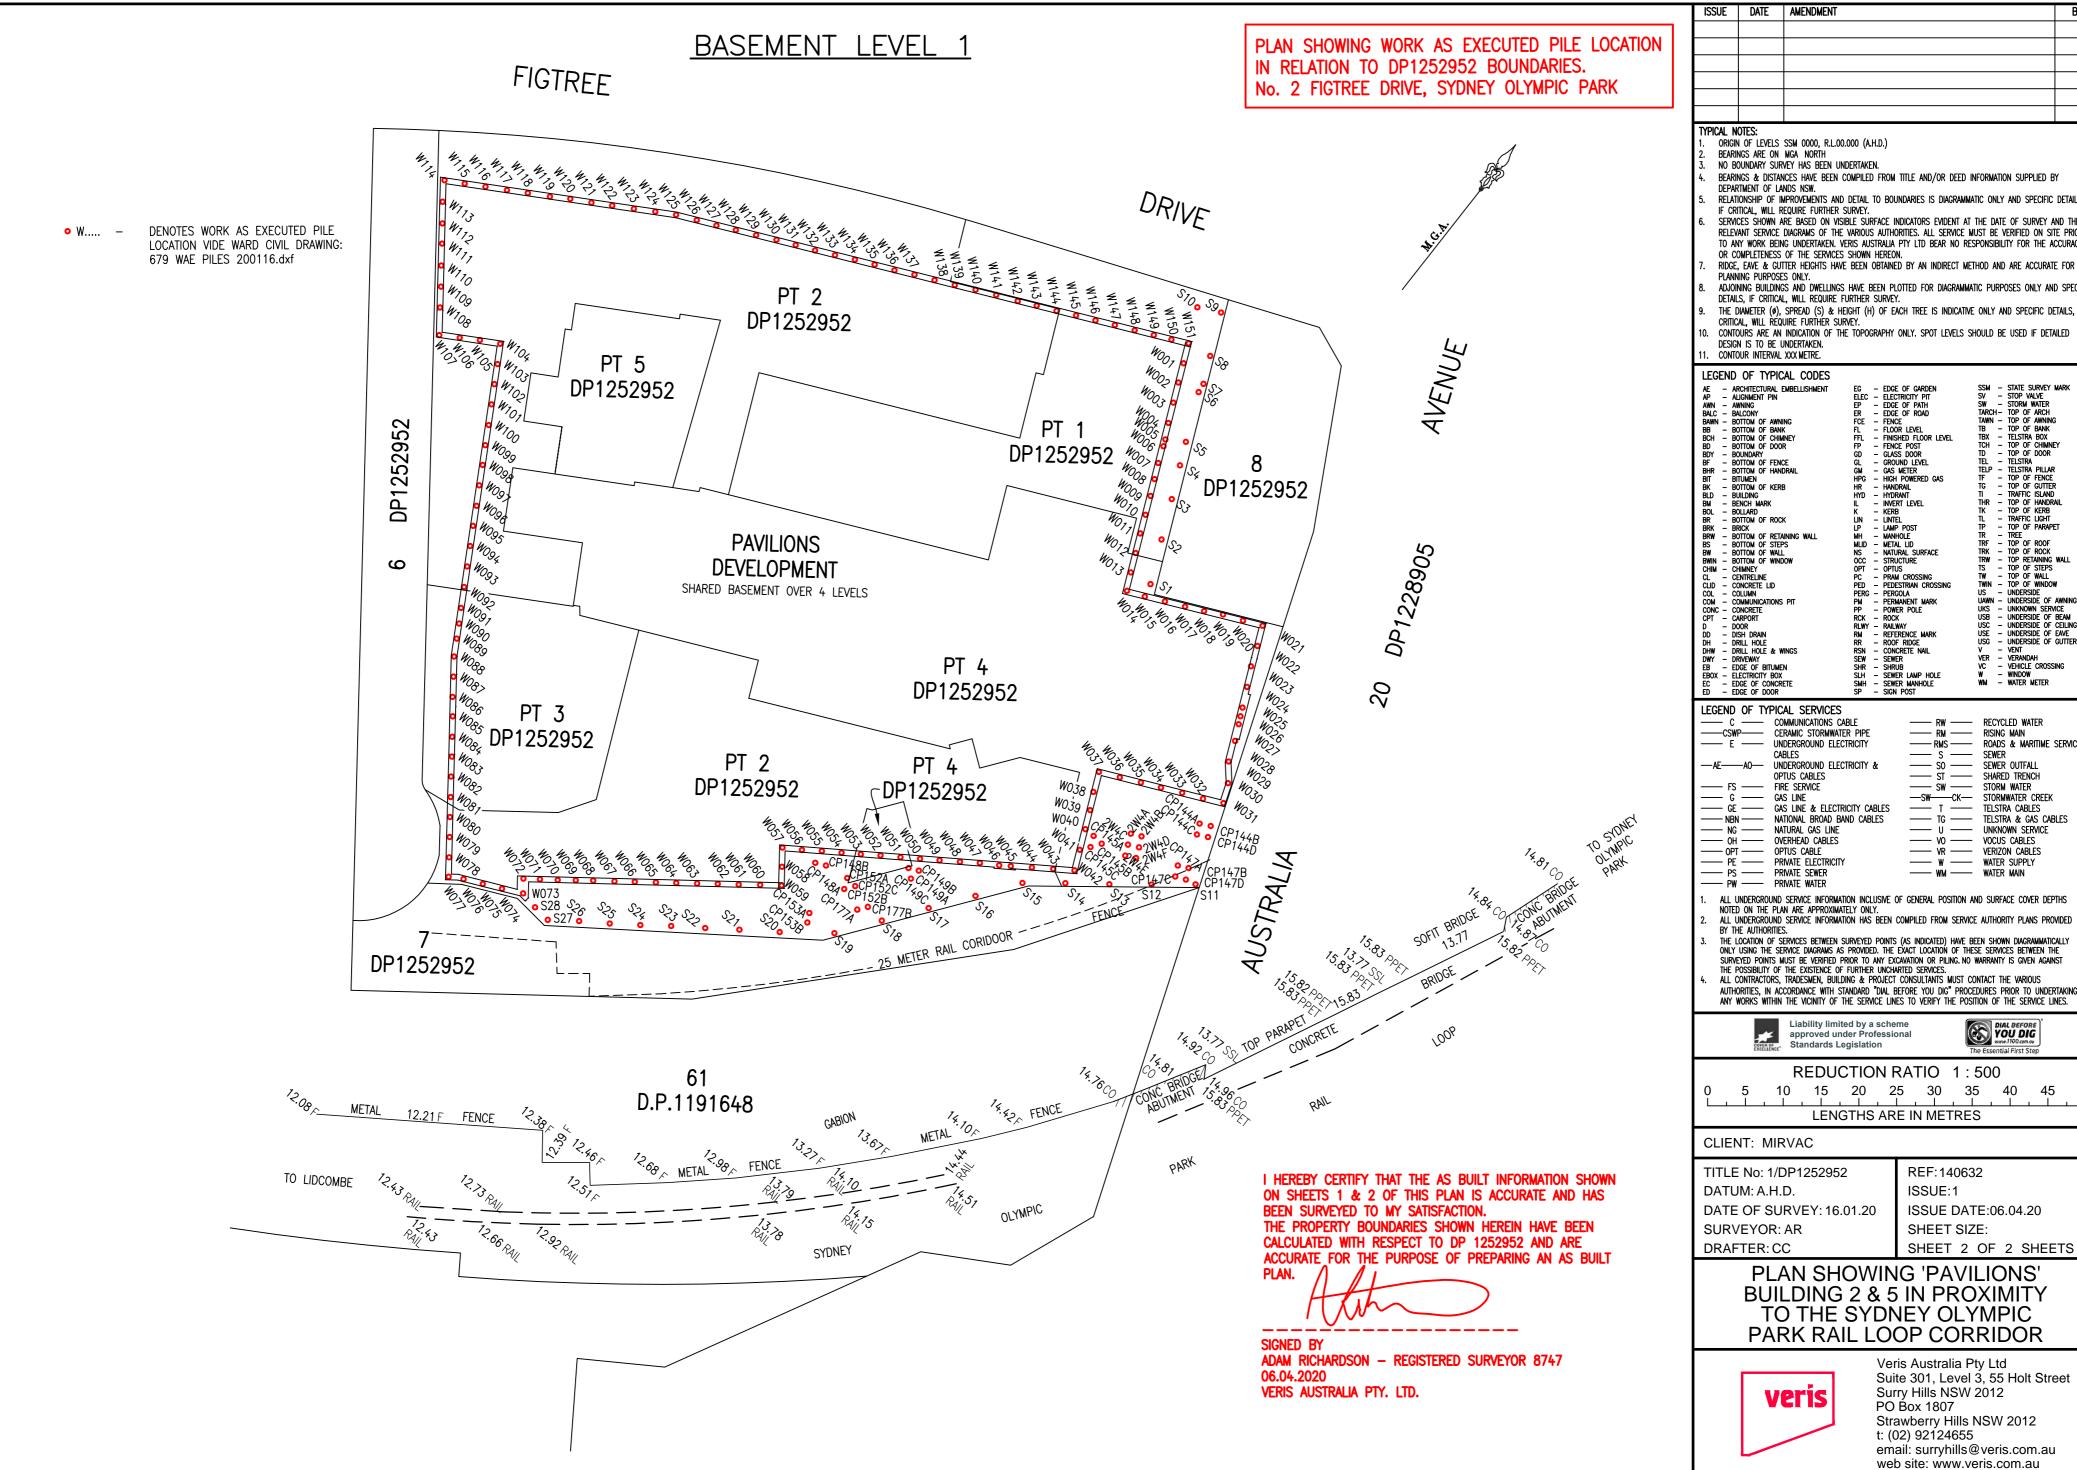

| ISSUE | DATE | AMENDMENT | BY |
|-------|------|-----------|----|
| | | | |
| | | | |
- BEARINGS & DISTANCES HAVE BEEN COMPILED FROM TITLE AND/OR DEED INFORMATION SUPPLIED BY
- IF CRITICAL, WILL REQUIRE FURTHER SURVEY.

 SERVICES SHOWN ARE BASED ON VISIBLE SURFACE INDICATORS EVIDENT AT THE DATE OF SURVEY AND THE RELEVANT SERVICE DIAGRAMS OF THE VARIOUS AUTHORITIES. ALL SERVICE MUST BE VERIFIED ON SITE PRIOR TO ANY WORK BEING UNDERTAKEN. VERIS AUSTRALIA PTY LTD BEAR NO RESPONSIBILITY FOR THE ACCURACY
- ADJOINING BUILDINGS AND DWELLINGS HAVE BEEN PLOTTED FOR DIAG

| LEGEND OF TYPICAL CODES AE — ARCHITECTURAL EMBELLISHMENT AP — ALICNMENT PIN AWN — AWNING BALC — BALCONY BAWN — BOTTOM OF BANK BCH — BOTTOM OF BANK BCH — BOTTOM OF CHIMNEY BB — BOTTOM OF FENCE BHP — BOTTOM OF FENCE BHR — BOTTOM OF KERB BLD — BUILDING BM — BENCH MARK BOL — BOLLARD BR — BOTTOM OF ROCK BRW — BOTTOM OF ROCK BRW — BOTTOM OF RETAINING WALL BSW — BOTTOM OF TEAL BWIN — BOTTOM OF TEAL BWIN — BOTTOM OF WALL | | | | | | |
|---|------|---|----------------------|-------|----|----------------------|
| AF _ APCHITECTURAL EMBELLISHMENT | FG | _ | FDCF OF CARDEN | SSM | _ | STATE SURVEY MARK |
| AP _ ALIGNMENT PIN | FLEC | _ | FI FCTRICITY PIT | SV | _ | STOP VALVE |
| AWN _ AWNING | FP | _ | FDCF OF PATH | SW | _ | STORM WATER |
| RAIC - RAICONY | FR | _ | FDGE OF ROAD | TARCH | 1- | TOP OF ARCH |
| BAWN - BOTTOM OF AWNING | FCF | _ | FENCE | TAWN | _ | TOP OF AWNING |
| RR - ROTTOM OF RANK | FI | _ | FLOOR LEVEL | TB | _ | TOP OF BANK |
| BCH - BOTTOM OF CHIMNEY | FFI | _ | FINISHED FLOOR LEVEL | TBX | _ | TELSTRA BOX |
| BD - BOTTOM OF DOOR | FP | _ | FENCE POST | TCH | _ | TOP OF CHIMNEY |
| RDY - ROLINDARY | GD. | _ | GLASS DOOR | TD | _ | TOP OF DOOR |
| BE - BOTTOM OF FENCE | GI | _ | GROUND LEVEL | TEL | _ | TELSTRA |
| BHR - BOTTOM OF HANDRAIL | GM | _ | GAS METER | TELP | _ | TELSTRA PILLAR |
| RIT - RITIMEN | HPG | _ | HIGH POWERED GAS | TF | _ | TOP OF FENCE |
| BK - BOTTOM OF KERB | HR | _ | HANDRAIL | TG | _ | TOP OF GUTTER |
| BID - BUILDING | HYD | _ | HYDRANT | TI | _ | TRAFFIC ISLAND |
| BM - BENCH MARK | IL. | _ | INVERT LEVEL | THR | _ | TOP OF HANDRAIL |
| BOL - BOLLARD | ĸ | _ | KERB | TK | _ | TOP OF KERB |
| BR - BOTTOM OF ROCK | LIN | _ | LINTEL | TL | _ | TRAFFIC LIGHT |
| BRK - BRICK | LP | _ | LAMP POST | TP | _ | TOP OF PARAPET |
| BRW — BOTTOM OF RETAINING WALL | MH | _ | MANHOLE | TR | _ | TREE |
| BS - BOTTOM OF STEPS | MLID | _ | METAL LID | TRF | - | TOP OF ROOF |
| BW - BOTTOM OF WALL | NS | _ | NATURAL SURFACE | TRK | - | TOP OF ROCK |
| BWIN - BOTTOM OF WINDOW | OCC | _ | STRUCTURE | TRW | - | TOP RETAINING WALL |
| CHIM - CHIMNEY | OPT | - | OPTUS | TS | - | TOP OF STEPS |
| CL – CENTRELINE | PC | - | PRAM CROSSING | TW | - | TOP OF WALL |
| CLID — CONCRETE LID | PED | - | PEDESTRIAN CROSSING | TWIN | - | TOP OF WINDOW |
| COL - COLUMN | PERG | - | PERGOLA | US | - | UNDERSIDE |
| COM - COMMUNICATIONS PIT | PM | - | PERMANENT MARK | UAWN | - | UNDERSIDE OF AWNING |
| CONC - CONCRETE | PP | - | POWER POLE | UKS | - | UNKNOWN SERVICE |
| CPT - CARPORT | RCK | - | ROCK | USB | - | UNDERSIDE OF BEAM |
| D - DOOR | RLWY | - | RAILWAY | USC | - | UNDERSIDE OF CEILING |
| DD — DISH DRAIN | RM | - | REFERENCE MARK | USE | - | UNDERSIDE OF EAVE |
| DH — DRILL HOLE | RR | - | ROOF RIDGE | USG | - | UNDERSIDE OF GUTTER |
| DHW - DRILL HOLE & WINGS | RSN | - | CONCRETE NAIL | ٧ | - | VENT |
| DWY - DRIVEWAY | SEW | - | SEWER | VER | - | VERANDAH |
| EB — EDGE OF BITUMEN | SHR | - | SHRUB | VC | - | VEHICLE CROSSING |
| EBOX — ELECTRICITY BOX | SLH | - | SEWER LAMP HOLE | W | - | WINDOW |
| | | | CEMED MANITULE | WM | | WALER MEIER |

| LD - LDGL OF D | 301 3101 | 1 1 0 3 1 | |
|----------------|-------------------------------|-----------|---------------------------|
| LEGEND OF TY | PICAL SERVICES | | |
| — c — | COMMUNICATIONS CABLE | RW | RECYCLED WATER |
| ——CSWP—— | CERAMIC STORMWATER PIPE | —— RM —— | RISING MAIN |
| I — E — | UNDERGROUND ELECTRICITY | —— RMS —— | ROADS & MARITIME SERVICES |
| | CABLES | — s — | SEWER |
| —AE——AO— | UNDERGROUND ELECTRICITY & | — so — | SEWER OUTFALL |
| | OPTUS CABLES | — rs — | SHARED TRENCH |
| — FS — | FIRE SERVICE | — sw — | STORM WATER |
| — G — | GAS LINE | —SW——CK— | STORMWATER CREEK |
| —— GE —— | GAS LINE & ELECTRICITY CABLES | — T — | TELSTRA CABLES |
| NBN | NATIONAL BROAD BAND CABLES | —— тG —— | TELSTRA & GAS CABLES |
| NG | NATURAL GAS LINE | — U — | UNKNOWN SERVICE |
| — он — | OVERHEAD CABLES | — vo — | VOCUS CABLES |
| OPT | OPTUS CABLE | VR | VERIZON CABLES |
| —— РЕ —— | PRIVATE ELECTRICITY | — w — | WATER SUPPLY |
| —— PS —— | PRIVATE SEWER | —— wм —— | WATER MAIN |
| PW | PRIVATE WATER | | |

- ALL UNDERGROUND SERVICE INFORMATION INCLUSIVE OF GENERAL POSITION AND SURFACE COVER DEPTHS NOTED ON THE PLAN ARE APPROXIMATELY ONLY.

 ALL UNDERGROUND SERVICE INFORMATION HAS BEEN COMPILED FROM SERVICE AUTHORITY PLANS PROVIDED.
- BY THE AUTHORITIES.

 THE LOCATION OF SERVICES BETWEEN SURVEYED POINTS (AS INDICATED) HAVE BEEN SHOWN DIAGRAMMATICALLY ONLY USING THE SERVICE DIAGRAMS AS PROVIDED. THE EXACT LOCATION OF THESE SERVICES BETWEEN THE SURVEYED POINTS MUST BE VERIFIED PRIOR TO ANY EXCAVATION OR PILING, NO WARRANTY IS GIVEN AGAINST
- AUTHORITIES, IN ACCORDANCE WITH STANDARD "DIAL BEFORE YOU DIG" PROCEDURES PRIOR TO UNDERTAKING ANY WORKS WITHIN THE VICINITY OF THE SERVICE LINES TO VERIFY THE POSITION OF THE SERVICE LINES.

DIAL BEFORE
YOU DIG

LENGTHS ARE IN METRES

ISSUE DATE:06.04.20 SHEET SIZE:

PLAN SHOWING 'PAVILIONS' **BUILDING 2 & 5 IN PROXIMITY** TO THE SYDNEY OLYMPIC PARK RAIL LOOP CORRIDOR

> Veris Australia Pty Ltd Suite 301, Level 3, 55 Holt Street Surry Hills NSW 2012 PO Box 1807 Strawberry Hills NSW 2012 t: (02) 92124655 email: surryhills@veris.com.au