



Vipac Engineers and Scientists Limited
279 Normanby Rd, Port Melbourne, VIC 3207 Australia
Private Bag 16, Port Melbourne, VIC 3207, Australia
t. +61 3 9647 9700 | e. melbourne@vipac.com.au
w. www.vipac.com.au | A.B.N. 33 005 453 627 | A.C.N. 005 453 627

Alton Property Group

93-107 Cecil Ave & 9-10 Roger Ave, Castle Hill

Qualitative Natural Ventilation Study

30N-24-0299-TRP-129379-0

4 February 2026

Job Title:	93-107 Cecil Ave & 9-10 Roger Ave, Castle Hill		
Report Title:	Qualitative Natural Ventilation Study		
Document Reference:	30N-24-0299-TRP-129379-0		
Prepared For:	Alton Property 3/14-16 York St Sydney, New South Wales, 2000, Australia Contact: Karen Chow Tel: 02 9188 3498		Prepared By: Vipac Engineers and Scientists Limited 279 Normanby Rd, Port Melbourne, VIC 3207 Australia Tel: +61 3 9647 9700
Author:	Alexis Dalamagas		Project Engineer
	04 Feb 2026		
Reviewer:	Peyman Mayeli		Senior Engineer
	4 Feb 2026		
Issued By:	Alexis Dalamagas		Project Engineer
	4 Feb 2026		
Revision History:			
Rev. #	Comments / Details of change(s) made	Date	Revised by:
Rev. 00	Original issue	4 Feb 2026	

NOTE: This report has been prepared solely for the benefit of the client to whom this report is addressed for use herein ("Client") unless otherwise agreed in writing by Vipac Engineers and Scientists Limited ACN 005 453 627 ("Vipac"). Neither the whole of this report or any part of it may be published, duplicated or circulated without the prior written approval of Vipac except as required by law. Vipac does not assume any responsibility or liability for any losses suffered as a result of the publication, duplication or circulation of this report and excludes all liability whatsoever to any third party who may use or rely on the whole, or any part of this report.

Vipac has prepared this report using all reasonable care, skill and due diligence within the time period, budget and resources allocated to Vipac as agreed with the Client. Vipac excludes all liability to the Client whatsoever, whether in whole or in part, for the Client's use or reliance on the report other than for the purposes set out in the report, or any matters outside the agreed scope of the work.

For the purposes of preparing this report, reliance has been placed upon the material, representations, information and instructions provided to Vipac unless otherwise stated in the report. Originals of documents provided have not been required and no audit or examination of the validity of the documentation, representations, information or instructions provided has been undertaken except to the extent otherwise stated in this report. Information and findings contained in this report are based on Vipac's interpretation of data collected.

This document contains commercial, conceptual, engineering and other information that is proprietary to Vipac. The inclusion of this information in the report does not grant the Client any license to use the information without Vipac's prior written permission.

Executive Summary

Vipac Engineers & Scientists Pty Ltd has been engaged by **Alton Property Group** to conduct a qualitative assessment of natural ventilation potential of the proposed development at **93-107 Cecil Ave & 9-10 Roger Ave, Castle Hill**. This appraisal is based on Vipac's experience as a wind-engineering consultancy.

Drawings of the proposed development were provided by **Aplus Design Group** in **December 2025**.

Based on our engineering observations and the qualitative study, it is concluded that for the proposed development:

- **68.3% (69 out of 101)** apartments in **Stage 1** are expected to be cross ventilated with the current design; thereby meeting the Apartment Design Guide (ADG) requirements.
- **64.1% (77 out of 120)** apartments in **Stage 2** are expected to be cross ventilated with the current design; thereby meeting the Apartment Design Guide (ADG) requirements.

This analysis has been made on the basis of our engineering assumptions and on experience gained from model scale wind tunnel or Computational Fluid Dynamics (CFD) analysis of a range of developments of similar magnitude to the proposed development.

Table of Contents

Introduction	5
1 Local Wind Climate	8
2 Natural Ventilation Analysis	9
2.1 Australian Design Guide (ADG) Requirements.....	9
3 Results and Discussion	10
3.1 ADG Assessment	10
3.1.1 Stage 1 (Buildings E & S)	10
3.1.2 Stage 2 (Buildings N & W)	15
4 Conclusion	21
Appendix A Environmental Wind Effects.....	22
Appendix B Drawing List.....	23
Appendix C Floor Plans	24
Appendix D References	33

Introduction

Vipac Engineers and Scientists Pty Ltd has been commissioned by **Alton Property Group** to undertake a qualitative cross ventilation assessment at **93-107 Cecil Ave & 9-10 Roger Ave, Castle Hill**. This report is qualitative review to assess the natural ventilation under Apartment Design Guide (ADG).

Natural ventilation is taken to mean that quantity of fresh air that enters a building without mechanical assistance. Supply of outside air indoors can decrease the level of indoor pollutant as well as cooling the building. There are two main mechanisms for natural ventilation: 'stack (or chimney)' effect and 'wind pressure' effect.

Stack effect is produced by two columns of air at different temperature, where the interference between the two columns is unstable and tends to allow the colder air to move into the warmer air at low level and the warmer air into cooler air at an upper level. The rate of air circulation due to stack effect in a building depends on separated distance (height) of the cold and hot air, opening area at a bottom and top of the building and temperature difference.

Wind pressure effect is produced by the interaction of wind with the building. The interaction will produce a building surface with local suctions and pressures. The pressures are used as intake of outside air and suction as removal of indoor air. The different pressure distribution across the building will be used to achieve the required indoor air circulation.

The proposed development is comprised of 4 buildings split into stages – Stage 1 with 2. The proposed development comprises of residential buildings with an approximate roof height of 105m (E), 82m (S), 89m (W) and 118m (N). The site is bounded by Cecil Avenue to the northeast, Roger Avenue to the south and existing developments to the remaining directions. The site plan of the proposed development and the northeastern elevation of the building are shown in Figure 1 and Figure 2, respectively. Assumed terrain categories for wind speed estimation is shown in Figure 3.

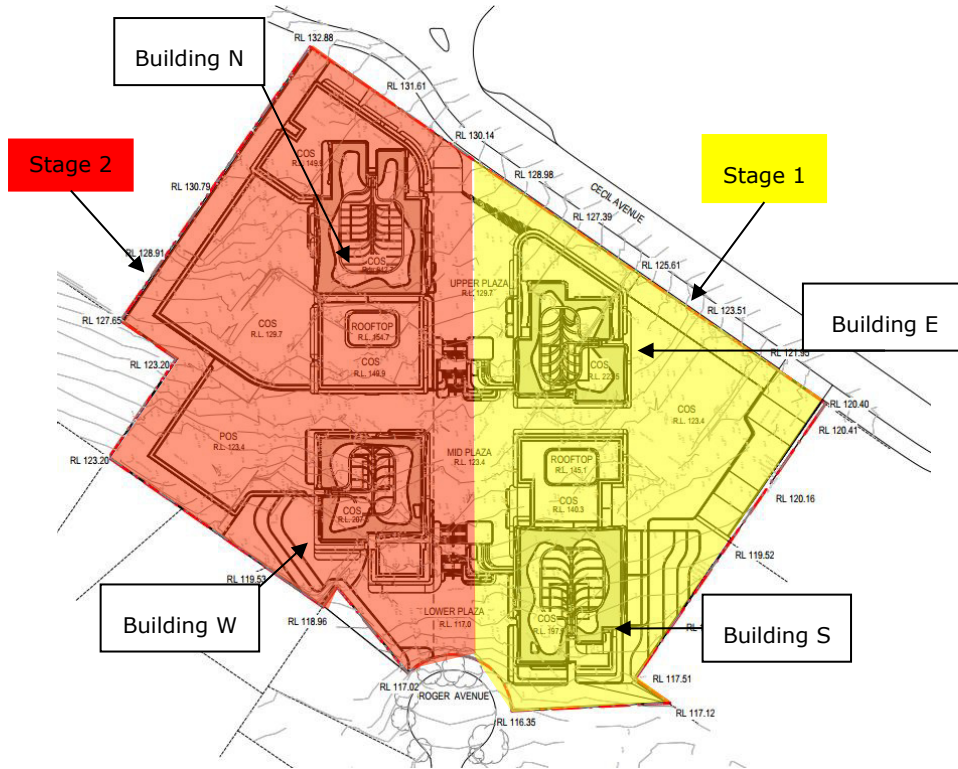


Figure 1 - Site plan of the proposed development.

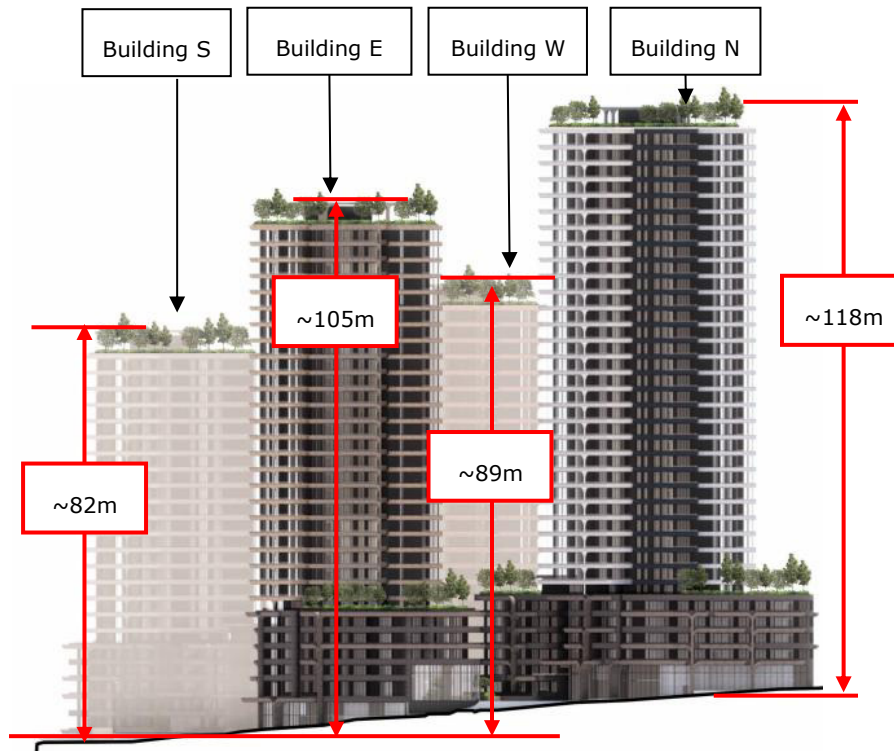


Figure 2 - Northeastern elevation of the proposed development.


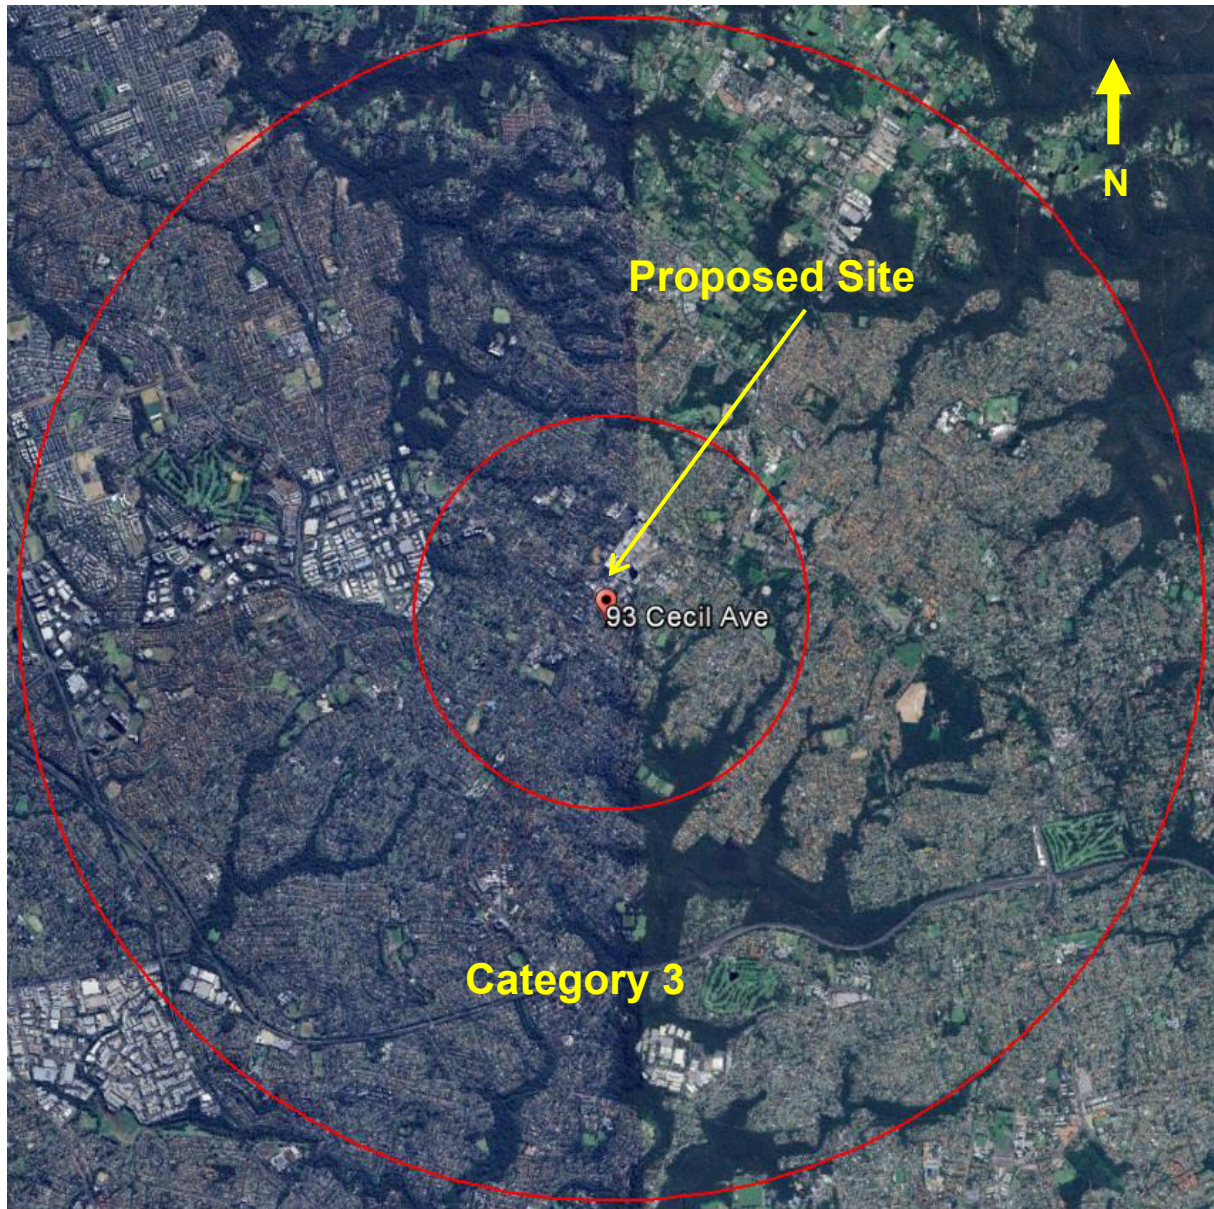


Figure 3 - Assumed terrain categories (TC) for wind speed estimation.

The mean and gust wind speeds have been recorded in the Bankstown Wind Station WS_066137 (the wind station recommended by some Councils in non-coastal areas of Sydney) for over 20 years. These data have been analysed and directional probability distribution of wind speeds have been determined. The directional distribution of hourly mean wind speed at a gradient height (~300 m) is shown in Figure 4. The winds from the west are strongest and more frequent followed by those from the northwest / west and south / southeast directions.

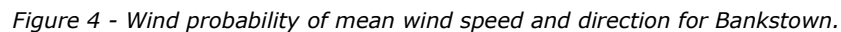

2 Natural Ventilation Analysis

Natural ventilation through apartments is driven by differential pressures between dominant openings, which are generated by the outside wind flow around the building structure and additional elements. The pressure distribution will vary according to the incoming wind directions and turbulence characteristics from the upstream, the angle between the local wind and the building façade, elevation of the apartment to ground level, local façade geometry, and size of door opening. Wind frequency exceeded at **80%** of the time were selected for this assessment. This resulted in a calm to light breeze reference wind speed of **2m/s**.

2.1 Australian Design Guide (ADG) Requirements

The NSW State Environmental Planning Policy (Housing) 2021 supported by the Australian Design Guide (ADG) is relevant to the assessment of the natural ventilation through residential components of proposed development. Section 4B-3 of the Australian Design Guide (ADG) states that:

"At least 60% of the apartments are naturally cross ventilated in the first nine storeys of the building. Apartments at ten storeys or greater are deemed to be cross ventilated only if any enclosure of the balconies at these levels allows adequate natural ventilation and cannot be fully enclosed".

The proposed development implements a number of the ADG recommendations to maximize the natural cross ventilation throughout the development:

- The proposed development has been provided with opening on multiple sides of the apartments for the majority of the proposed floor plans, allowing it to make use of wind-induced natural ventilation throughout the year and thereby minimising energy costs; and
- The overall depth of cross-over or cross through units does not exceed 18m as per Design Criteria of Objective 4B-3.

3 Results and Discussion

3.1 ADG Assessment

The natural ventilation for the proposed residential apartments has been qualitatively assessed. Cross ventilation is achieved by the differential pressure between the windward and leeward building façades. Description of the natural ventilation principles that apply for the proposed development are shown in Appendix A.

The following comments are made regarding the proposed cross ventilation system for the development:

- Balconies featuring sliding doors are positioned on all façades offering openings to various directions, thus significantly improving airflow, which is a favourable design selection. Reducing shielding is anticipated for the upper levels as a result; therefore, the proposed development benefits from all prevailing Sydney winds, creating the potential for cross ventilation (Figure 5 to Figure 23).
- Based on a qualitative study **68.3% (69 out of 101)** of the apartments within stage 1 (Table 2) and **64.2% (77 out of 120)** of the apartments within stage 2 (Table 3) of the proposed development comply with the cross-ventilation requirements of the Australian Design Guide (ADG) for the first nine storeys (Table 1). A total of **66% (146 out of 221)** of the apartments within the proposed development comply with the cross-ventilation requirements of the Australian Design Guide (ADG) for the first nine storeys (Table 1).

Table 1 - Total number of apartments with openings to support natural cross ventilation.

Number of Apartments	Number of Apartments with Openings to Support Cross Ventilation (as per ADG)	Percentage (%)
221	146	66%

3.1.1 Stage 1 (Buildings E & S)

Table 2 - Apartments with openings to support natural cross ventilation (Stage 1).

Levels	Number of Apartments		Number of Apartments with Openings to Support Cross Ventilation (as per ADG)	Percentage (%)
	Building E	Building S		
Lower Ground		5	2	40%
Ground		5	2	40%
Upper Ground		7	4	57%
Level 1		9	8	44%
Level 2	2	10	9	67%
Level 3	3	10	8	69%
Level 4	5	10	8	53%
Level 5	5	4	8	89%
Level 6	5	5	8	80%
Level 7	4		4	100%
Level 8	4		4	100%
Level 9	4		4	100%
Level 10	4		4	100%
Total	101		69	68.3%

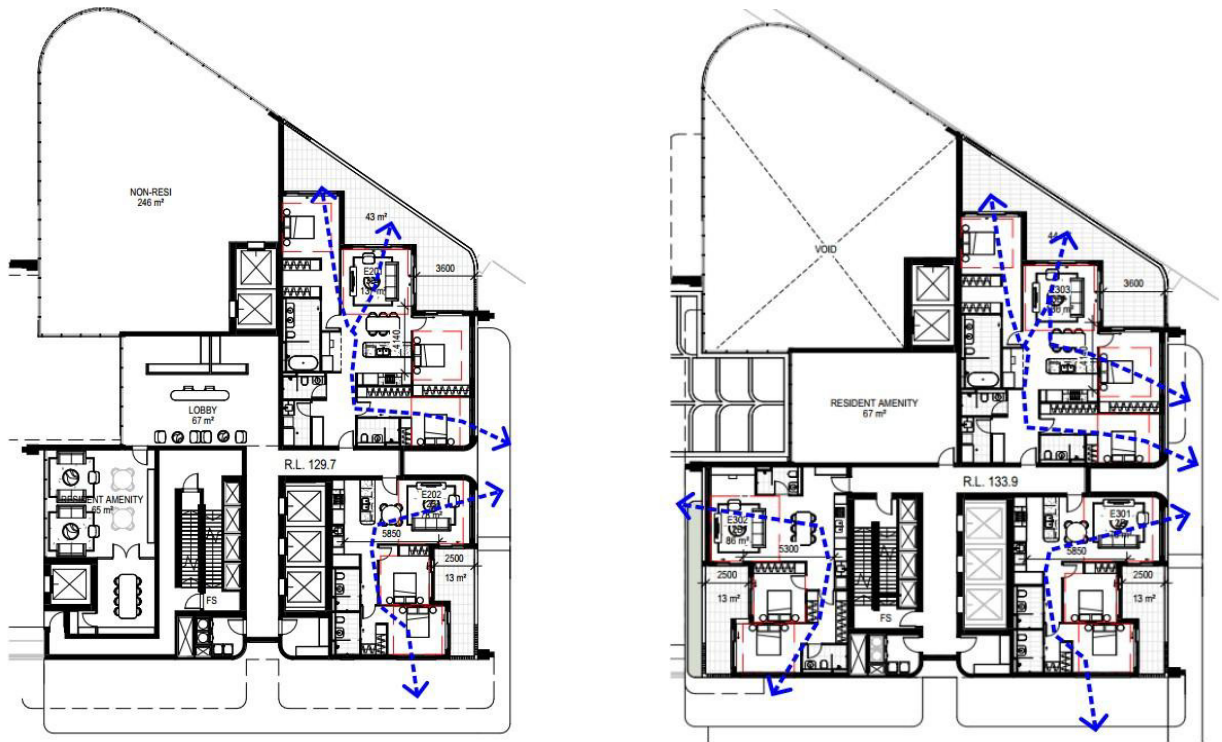


Figure 5 - Natural cross ventilation flow paths for Building E Level 2 (left) and Level 3 (right).

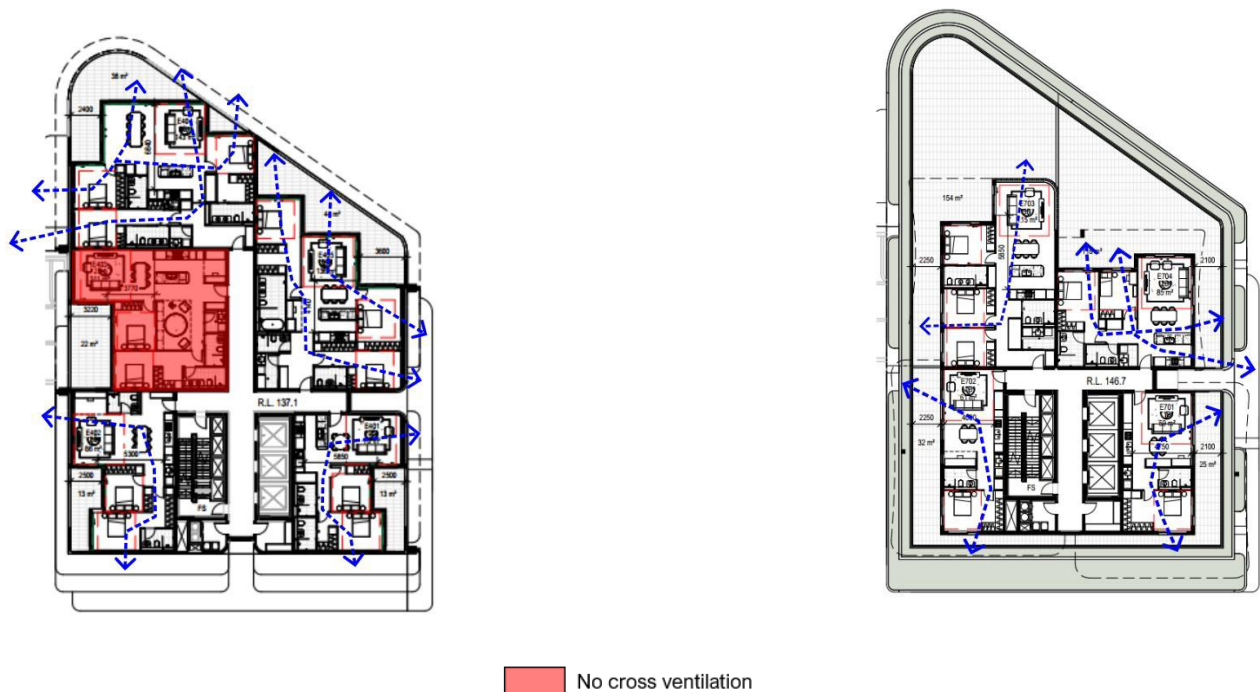


Figure 6 - Natural cross ventilation flow paths for Building E Level 4-6 (left) and Level 7 (right).

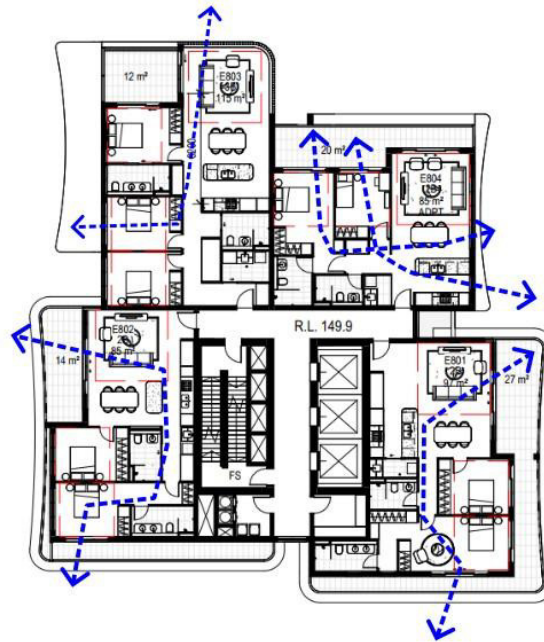


Figure 7 - Natural cross ventilation flow paths for Building E Level 8-10

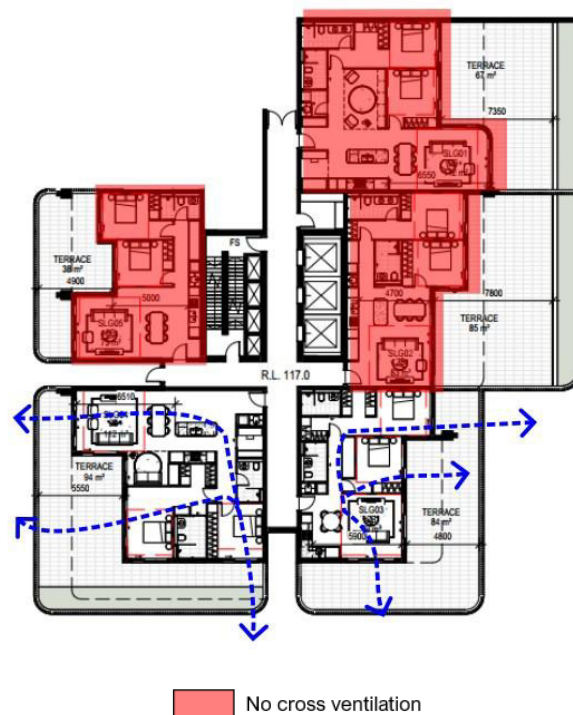


Figure 8 - Natural cross ventilation flow paths for Building S Lower Ground

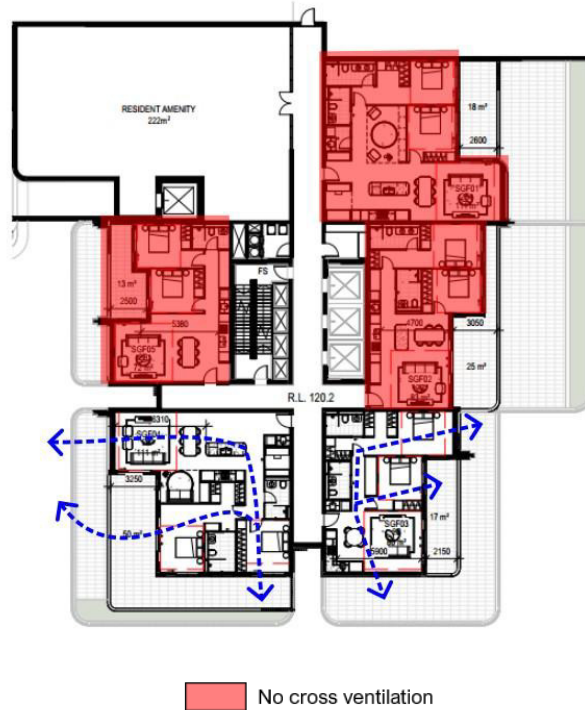


Figure 9 - Natural cross ventilation flow paths for Building S Ground

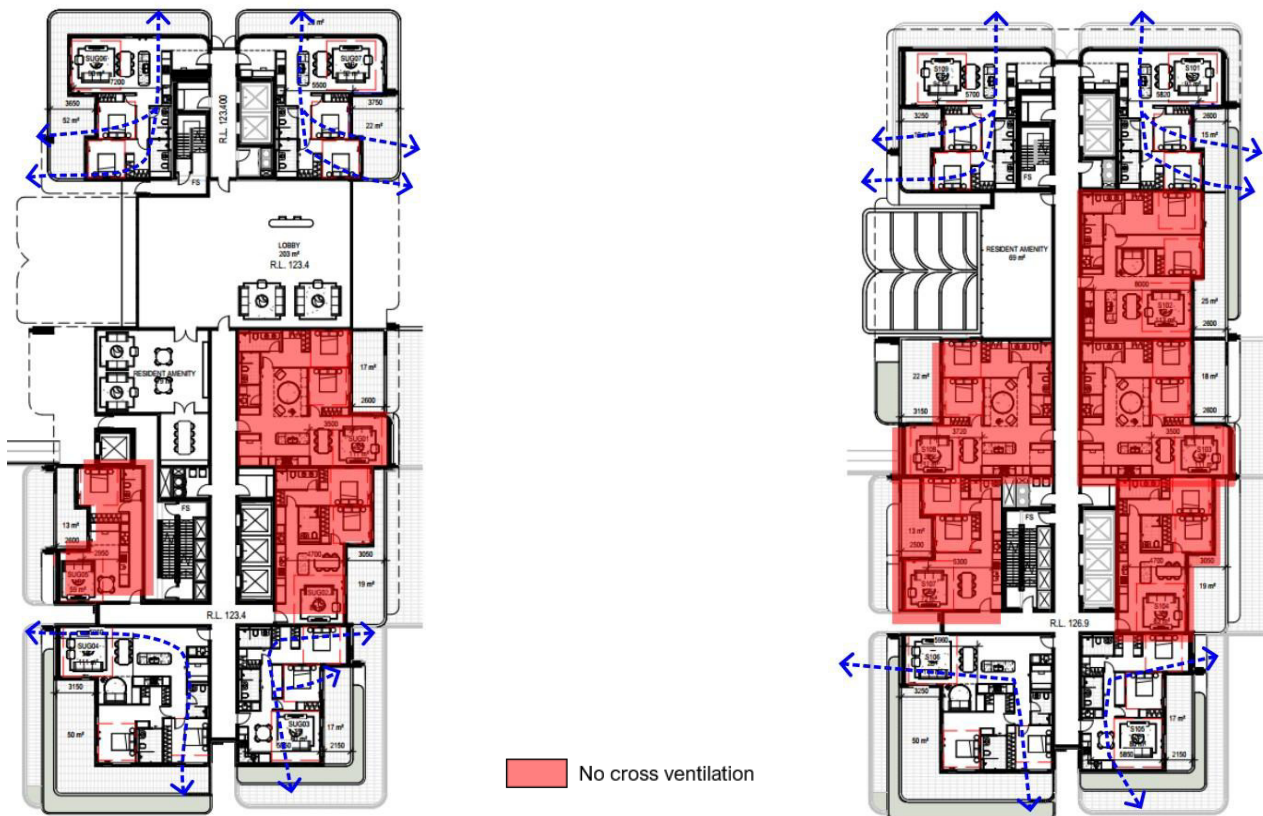


Figure 10 - Natural cross ventilation flow paths for Building S Upper Ground (left) and Level 1 (right).

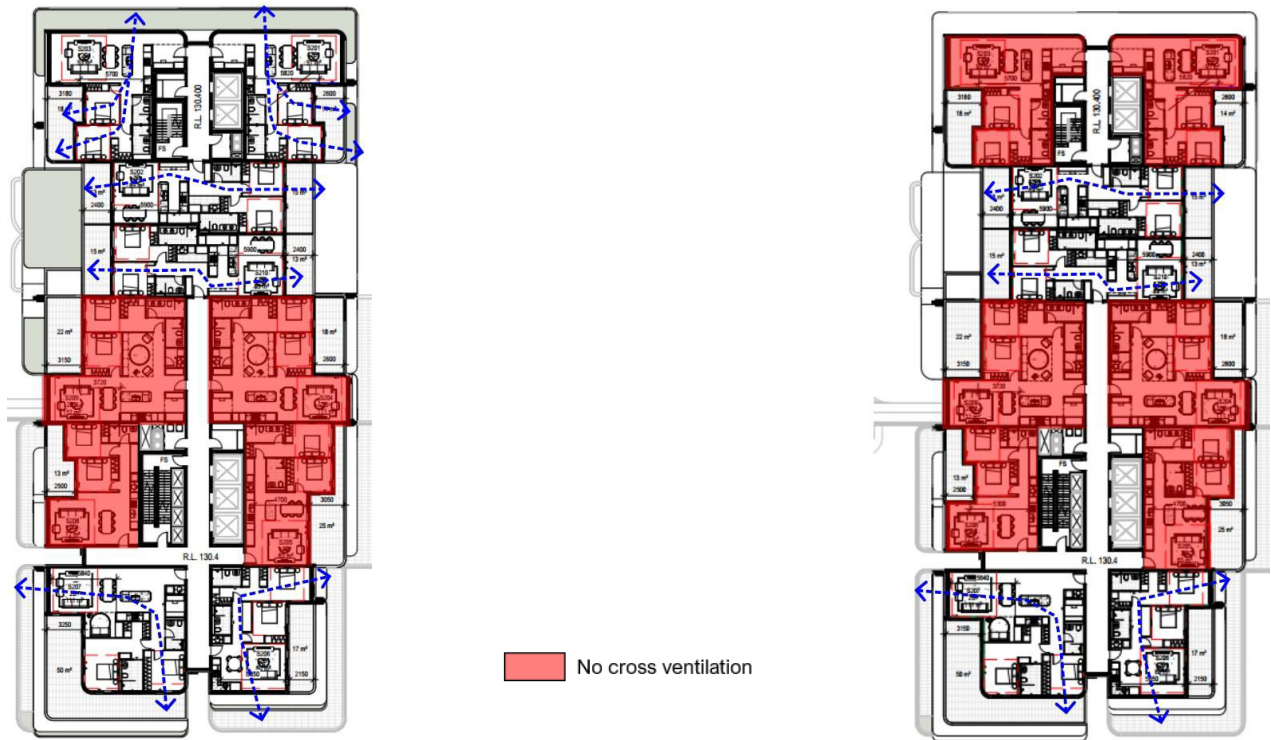


Figure 11 - Natural cross ventilation flow paths for Building S Level 2-3 (left) and Level 4 (right).

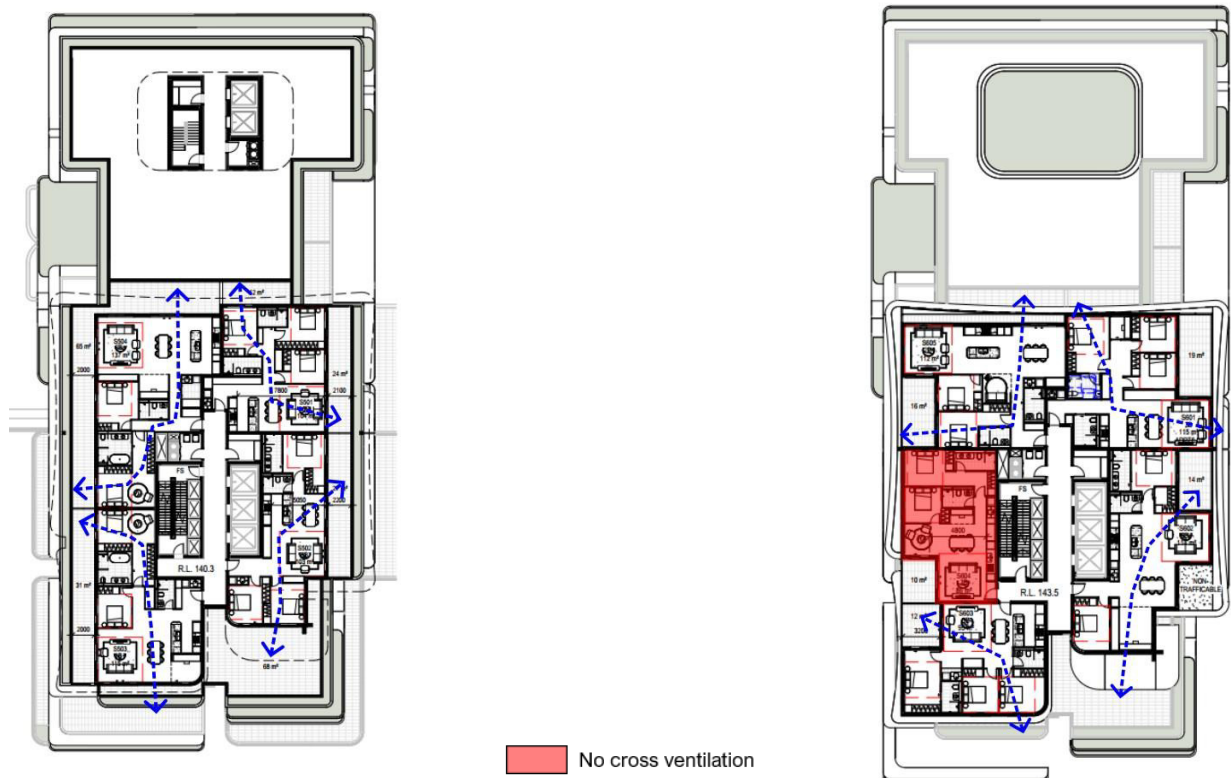


Figure 12 - Natural cross ventilation flow paths for Building S Level 5 (left) and Level 6 (right).

3.1.2 Stage 2 (Buildings N & W)

Table 3 - Apartments with openings to support natural cross ventilation (Stage 2).

Levels	Number of Apartments		Number of Apartments with Openings to Support Cross Ventilation (as per ADG)	Percentage (%)
	Building N	Building W		
Lower Ground		1	1	100%
Ground		1	1	100%
Upper Ground		4	4	100%
Level 1		4	4	100%
Level 2	5	5	7	70%
Level 3	7	5	7	58%
Level 4	14	5	10	53%
Level 5	14	4	10	56%
Level 6	14	4	10	56%
Level 7	14	2	9	56%
Level 8	5		4	80%
Level 9	6		5	83%
Level 10	6		5	83%
Total	120		77	64.2%

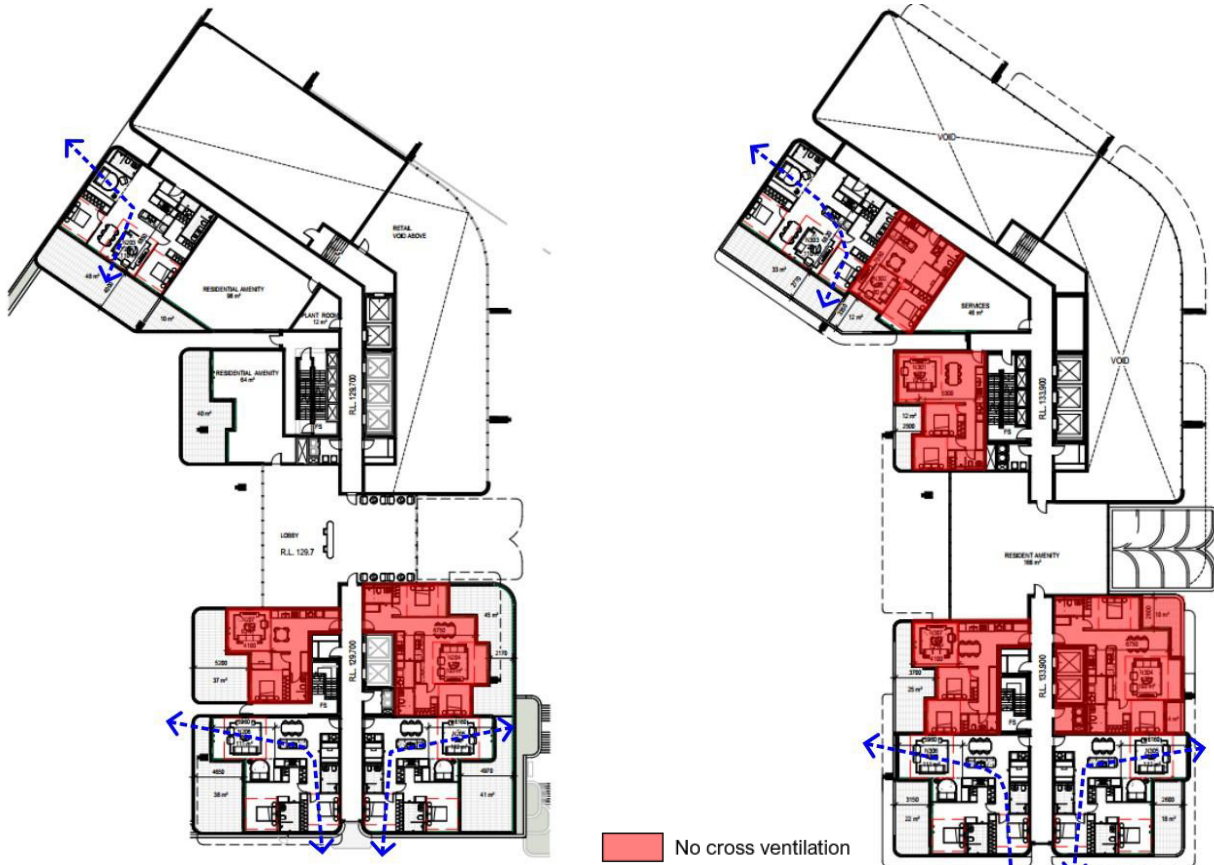


Figure 13 - Natural cross ventilation flow paths for Building N Level 2 (left) and Level 3 (right).

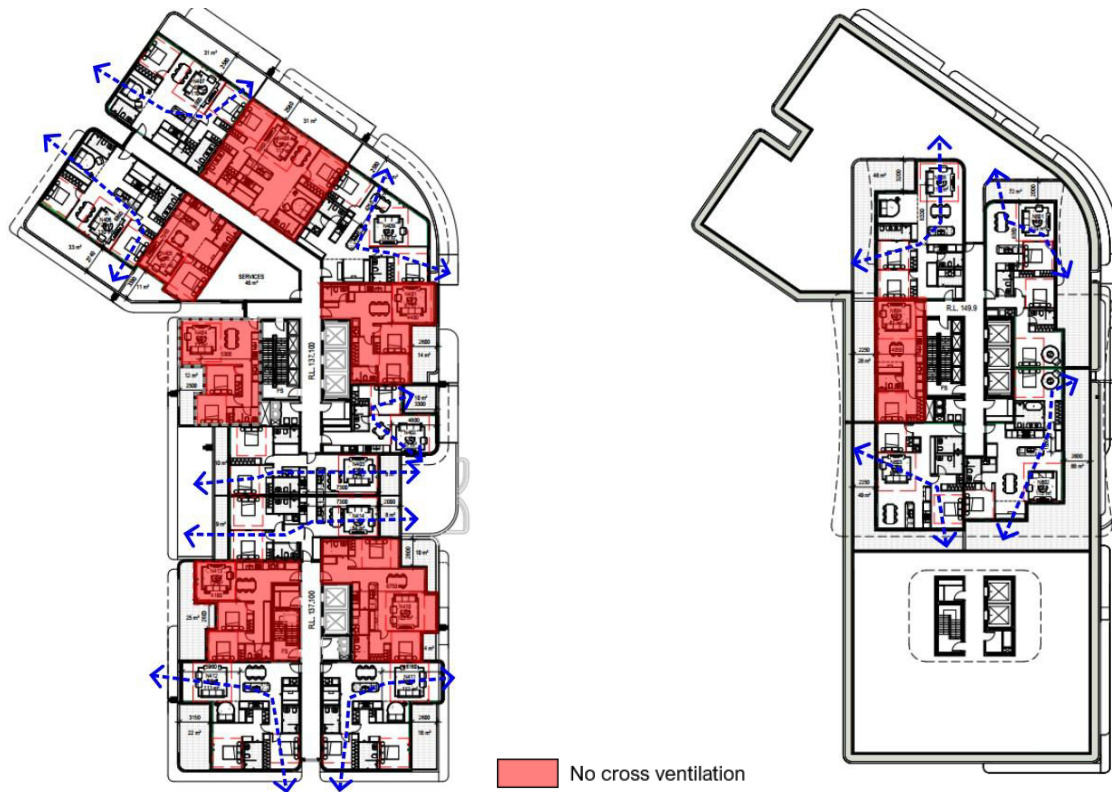


Figure 14 - Natural cross ventilation flow paths for Building N Level 4-7 (left) and Level 8 (right).

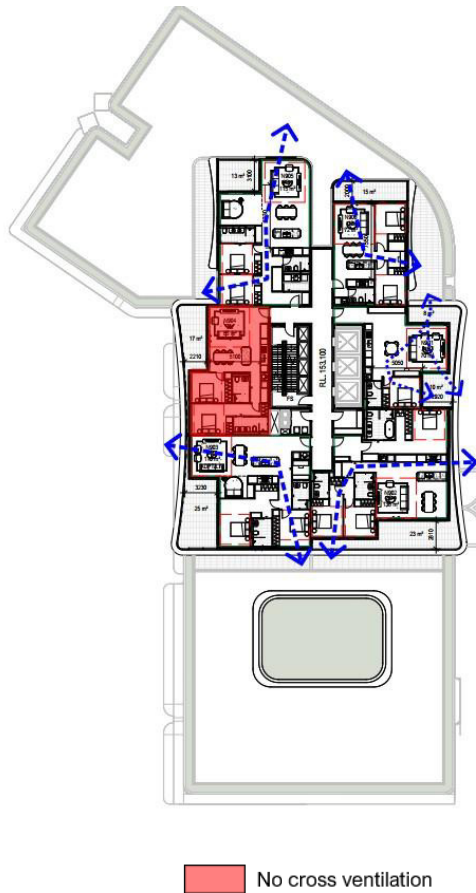


Figure 15 - Natural cross ventilation flow paths for Building N Level 9-10.

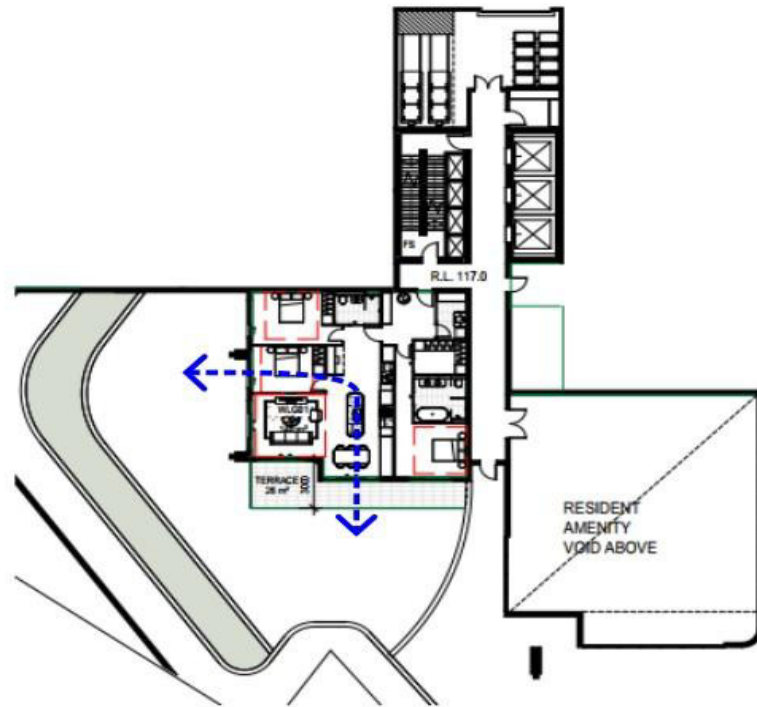


Figure 16 - Natural cross ventilation flow paths for Building W Lower Ground.

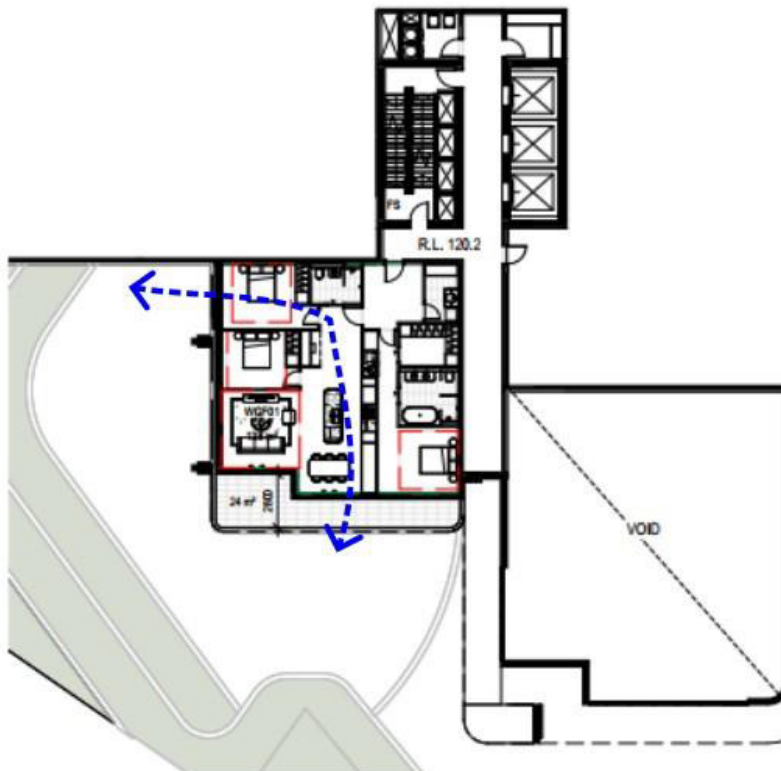


Figure 17 - Natural cross ventilation flow paths for Building W Ground.

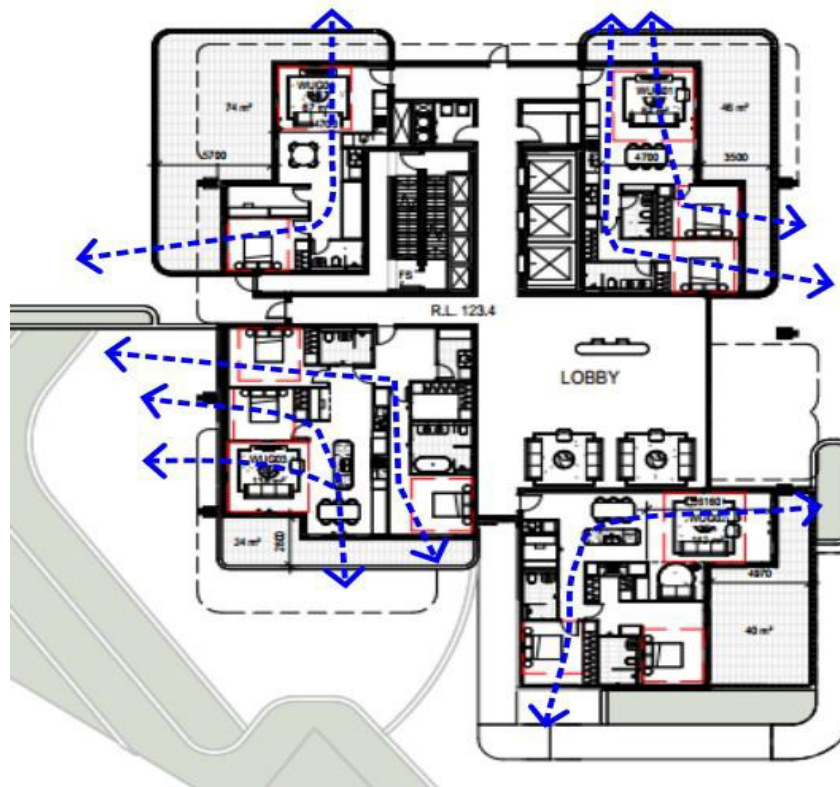


Figure 18 - Natural cross ventilation flow paths for Building W Upper Ground.

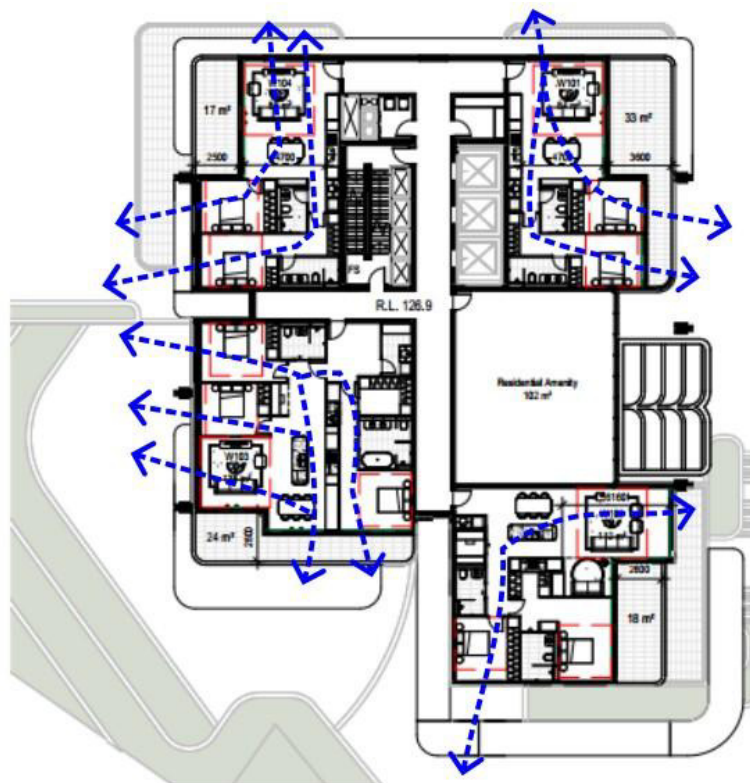


Figure 19 - Natural cross ventilation flow paths for Building W Level 1.

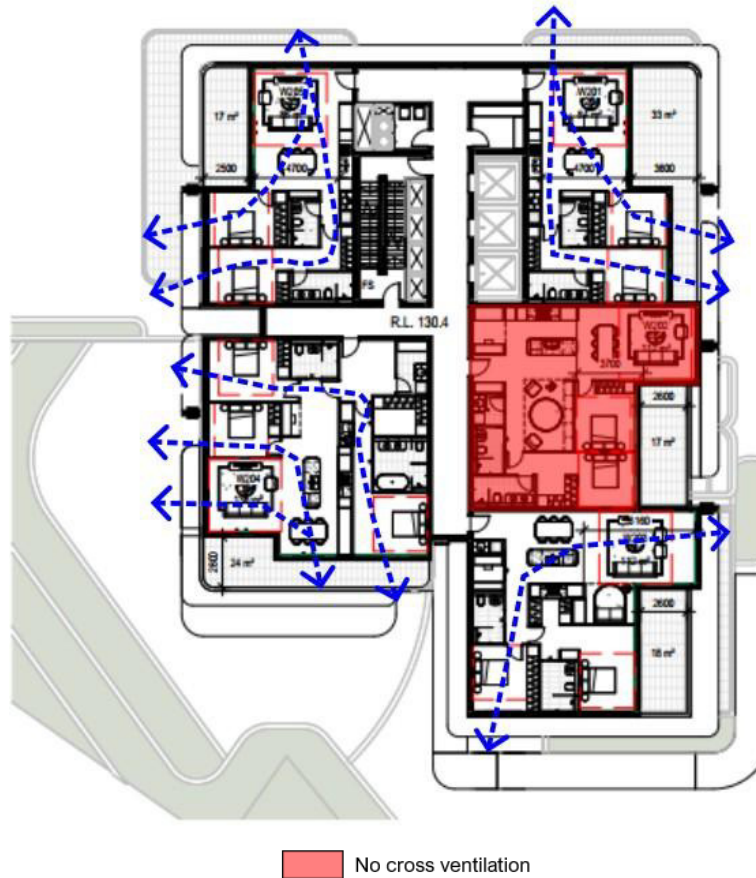


Figure 20 - Natural cross ventilation flow paths for Building W Level 2-3

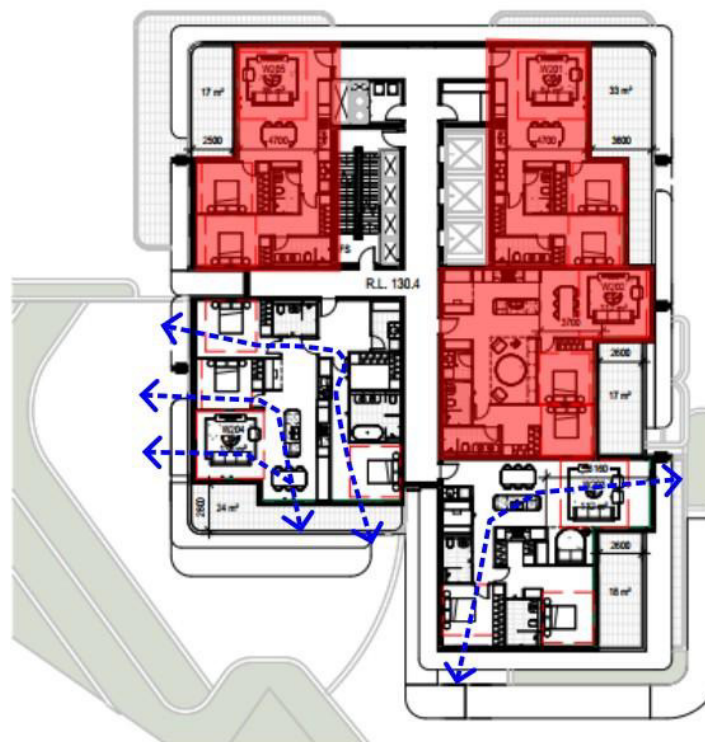


Figure 21 - Natural cross ventilation flow paths for Building W Level 4.

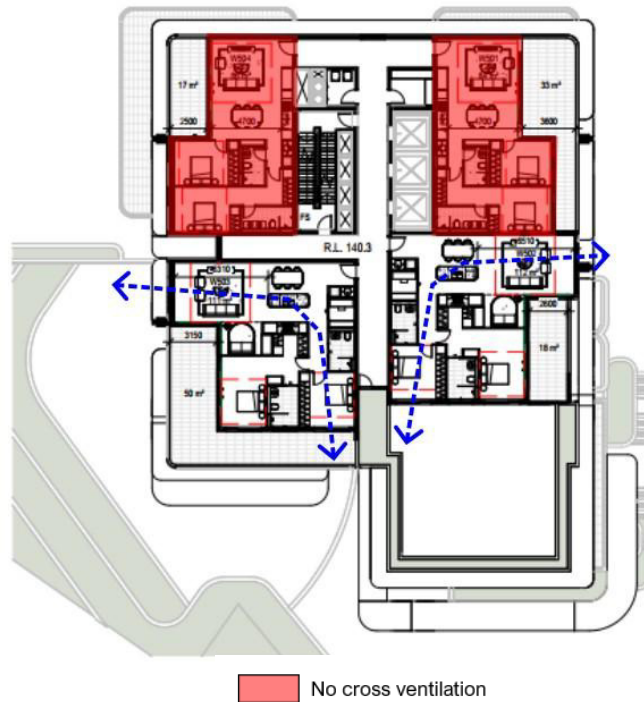


Figure 22 - Natural cross ventilation flow paths for Building W Level 5-6.

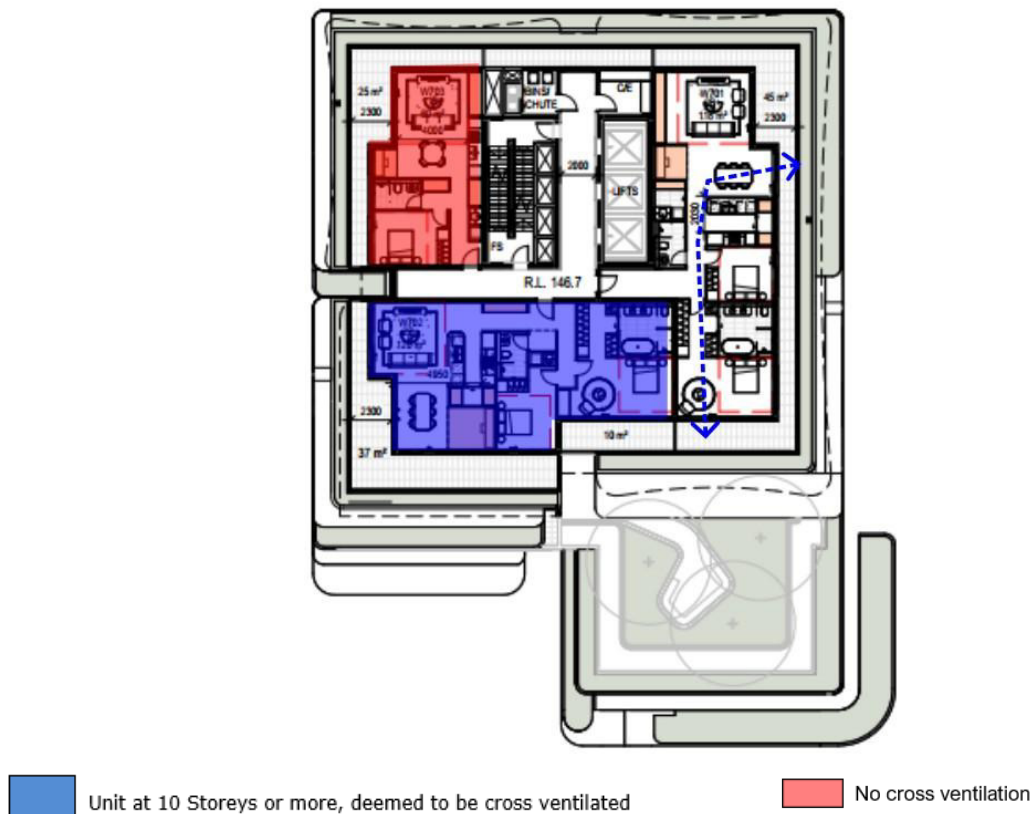


Figure 23 - Natural cross ventilation flow paths for Building W Level 7.

4 Conclusion

Vipac Engineers & Scientists Pty Ltd has been engaged by **Alton Property Group** to conduct a qualitative assessment of natural ventilation potential of the proposed development at **93-107 Cecil Ave & 9-10 Roger Ave, Castle Hill**. This appraisal is based on Vipac's experience as a wind-engineering consultancy.

Drawings of the proposed development were provided by **Aplus Design Group** in **December**.

Based on our engineering observations and the qualitative study, it is concluded that for the proposed development:


- **68.3% (69 out of 101)** apartments in **Stage 1** are expected to be cross ventilated with the current design; thereby meeting the Apartment Design Guide (ADG) requirements.
- **64.2% (77 out of 120)** apartments in **Stage 2** are expected to be cross ventilated with the current design; thereby meeting the Apartment Design Guide (ADG) requirements.

This analysis has been made based on our engineering assumptions and on experience gained from model scale wind tunnel or Computational Fluid Dynamics (CFD) analysis of a range of developments of similar magnitude to the proposed development.

Appendix A Environmental Wind Effects

Natural Ventilation (Stack effects)

Stack ventilation uses temperature differences to move air. Hot air rises because it generates lower pressure due to the density variation. For this reason, it is sometimes called buoyancy driven flow ventilation. In the stack effect, hot air plume rises due to buoyancy and its low-pressure sucks in fresh air from outside.

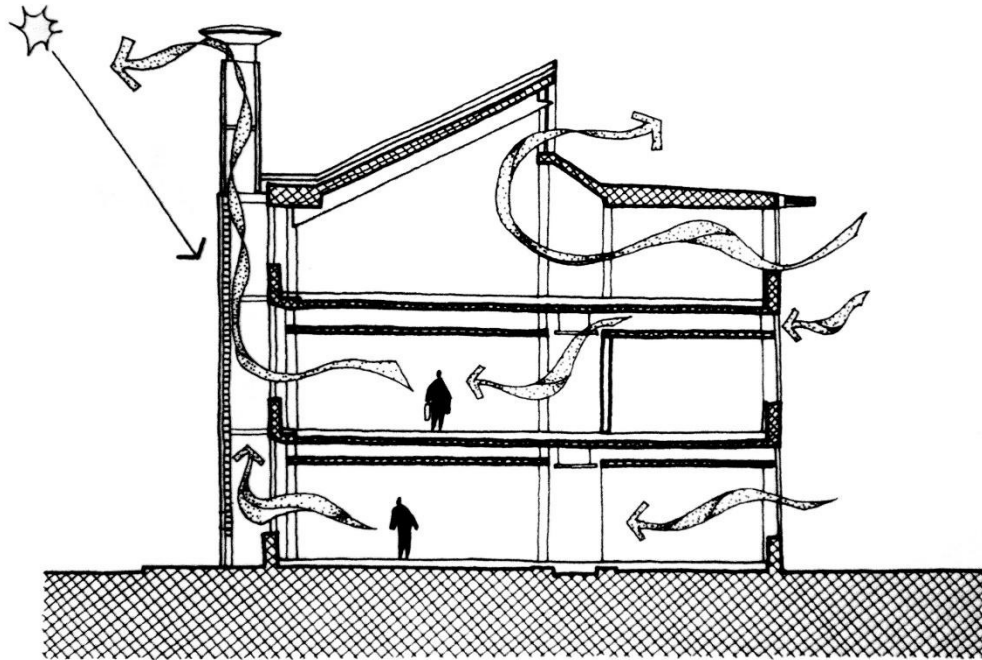


Source: G.Z brown and Mark Dekay, published by Wiley.

Natural Ventilation (Wind effects)

Wind induced natural ventilation works on the pressure differential concept. If a building massing has multiple openings and there exists a pressure difference between those openings, e.g. the wind pressure at one opening is greater than the pressure at the other side of the openings; airflow will be pushed through building openings in the direction positive to negative sign.

$$ACH = \frac{\text{Volumetric flow rate inside the enclosed space} \left(\frac{m^3}{s} \right)}{\text{Volume of the enclosed space} (m^3)} \times 3600$$

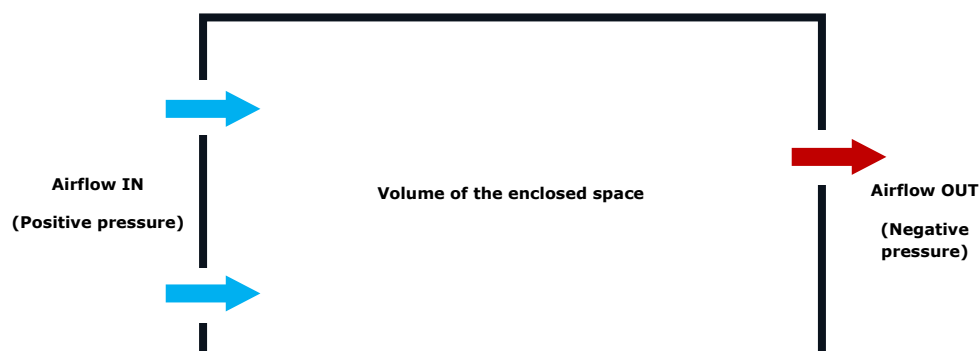

Appendix B Drawing List

a24033_93-107 Cecil Ave Castle Hill_A500_Detailed Plans.pdf


a24033_93-107 Cecil Ave. Castle Hill_Amended DA.pdf

S-Level 04.pdf

S-Level 04-03.pdf

Pages from a24033_93-107 Cecil Ave Castle Hill_Cross vent markup.pdf

Appendix C Floor Plans

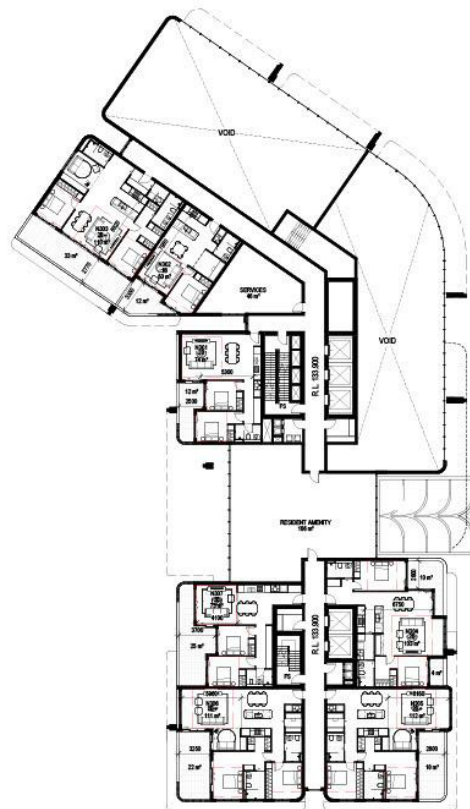


REV	DESCRIPTION	DATE
A	SODA	19110225
B	SDRP	25110225
C	AMENDED DA	19120225



PROJECT:
93-107 Cecil Avenue and
9-10 Roger Ave, Castle Hill

DRAWING TITLE:
BUILDING N - LEVEL 3

DATE	SCALE	DRAWING NO.	REV.
Issue Date: 1/25/2025	1:250 @ A4	AS22	C
DRAWN BY: PROJECT NO: 19120225			
DO NOT SCALE			
USE PLOTTED DIMENSIONS AT ALL TIMES			

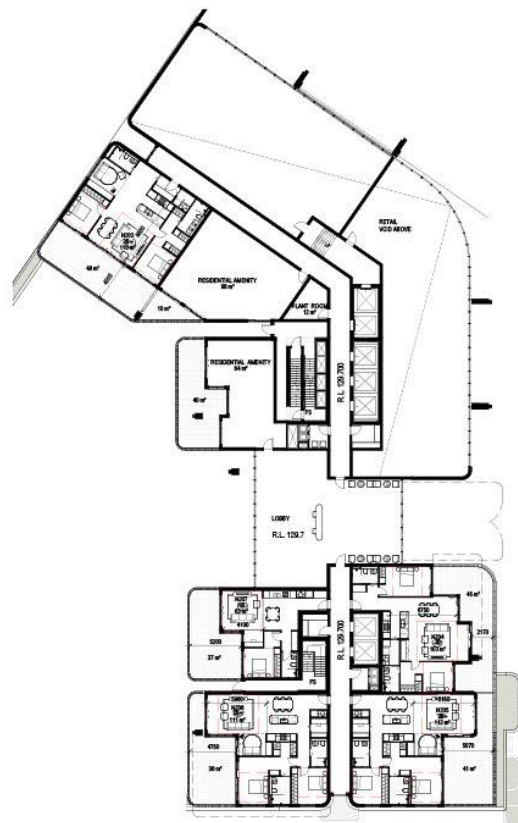

REV	DESCRIPTION	DATE
A	SODA	19110225
B	SDRP	25110225
C	AMENDED DA	19120225



PROJECT:
93-107 Cecil Avenue and
9-10 Roger Ave, Castle Hill

DRAWING TITLE:
BUILDING N - LEVEL 2

DATE	SCALE	DRAWING NO.	REV.
Issue Date: 1/25/2025	1:250 @ A4	AS21	C
DRAWN BY: PROJECT NO: 19120225			
DO NOT SCALE			
USE PLOTTED DIMENSIONS AT ALL TIMES			



REV	DESCRIPTION	DATE
A	SSDA	1911/2025
B	SCRP	2511/2025
C	AMENDED DA	1912/2025



PROJECT:
93-107 Cecil Avenue and
9-10 Roger Ave, Castle Hill

DRAWING TITLE:
BUILDING N - LEVEL 4 - 7

DATE: Issue Date	SCALE: 1:100 @A4	DRAWING NO: A523	REV: C
DRAWN BY: UN	PROJECTED BY: JONES	DO NOT SCALE	30% 100%
USE FIGURED DIMENSIONS AT ALL TIMES			



REV	DESCRIPTION	DATE
A	SSDA	1911/2025
B	SCRP	2511/2025
C	AMENDED DA	1912/2025




PROJECT:
93-107 Cecil Avenue and
9-10 Roger Ave, Castle Hill

DRAWING TITLE:
BUILDING N - LEVEL 8

DATE: Issue Date	SCALE: 1:100 @A4	DRAWING NO: A524	REV: C
DRAWN BY: UN	PROJECTED BY: JONES	DO NOT SCALE	30% 100%
USE FIGURED DIMENSIONS AT ALL TIMES			



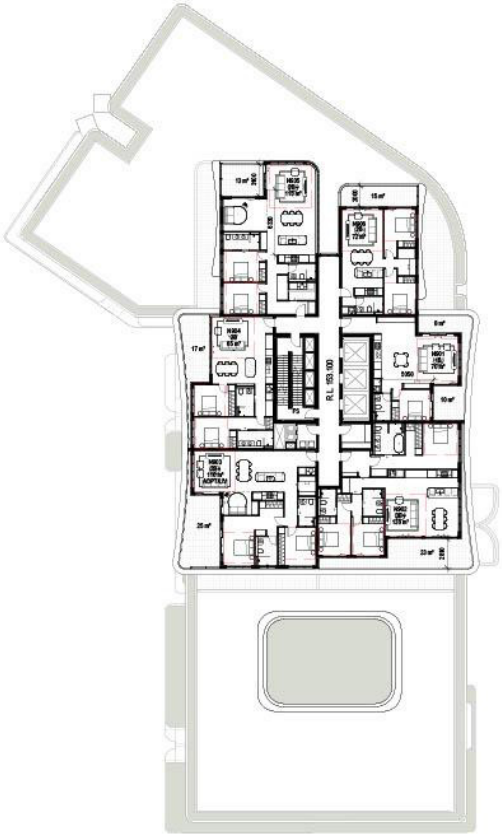


REV	DESCRIPTION	DATE
A	SSDA	1911/03/25
B	SCRP	2511/03/25
C	AMENDED DA	1912/03/25

Q+
www.qplus.com.au
PH: 1300 360 700
LEVEL 1, 4 BARRACK STREET
SYDNEY, NSW 2000
REGISTERED ARCHITECT
ARCHITECTS NO. 1103

PROJECT:
93-107 Cecil Avenue and
9-10 Roger Ave, Castle Hill

DRAWING TITLE:
BUILDING N - LEVEL 9 - 36

DATE:	SCALE:	DRAWING NO.:	REV.:
25/01/2025	1:100 @A3	A525	C
DRAWN BY:	PROJECTED BY:		
UN	JOHNS		
DO NOT SCALE			
USE FIGURED DIMENSIONS AT ALL TIMES			

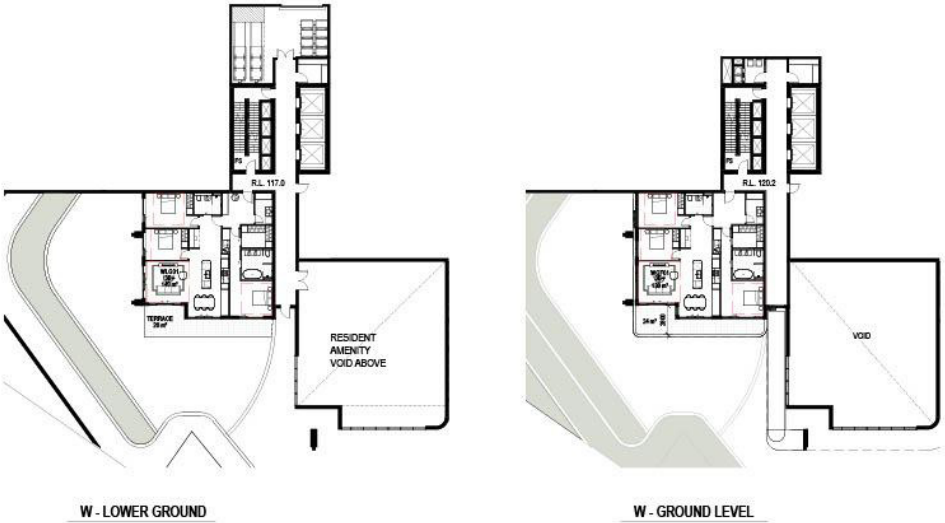

REV	DESCRIPTION	DATE
A	SSDA	1911/03/25
B	SCRP	2511/03/25
C	AMENDED DA	1912/03/25

Q+
www.qplus.com.au
PH: 1300 360 700
LEVEL 1, 4 BARRACK STREET
SYDNEY, NSW 2000
REGISTERED ARCHITECT
ARCHITECTS NO. 1103

PROJECT:
93-107 Cecil Avenue and
9-10 Roger Ave, Castle Hill

DRAWING TITLE:
BUILDING W - LG - G

DATE:	SCALE:	DRAWING NO.:	REV.:
25/01/2025	1:100 @A3	A541	C
DRAWN BY:	PROJECTED BY:		
UN	JOHNS		
DO NOT SCALE			
USE FIGURED DIMENSIONS AT ALL TIMES			



W - UPPER GROUND



W - LEVEL 01

REV	DESCRIPTION	DATE
A	SSDA	18/11/2025
B	SORP	25/11/2025
C	AMENDED DA	19/12/2025



Q+ www.qplus.com.au
 PH: 1300 366 700
 LEVEL 3, 9 BARRACK STREET
 SYDNEY, NSW 2000
 NOMINATED ARCHITECT
 KACRO LIDJANO NSW 7133

PROJECT:



93-107 Cecil Avenue and
9-10 Roger Ave, Castle Hill

DRAWING TITLE:


DRAWING TITLE:
BUILDING W - UG - LEVEL 1

DATE: Issue Date	SCALE: 1 : 300 @ A3	DRAWING No: A542	SIZE: C
DRAWN BY: PROJECT NO:			

DO NOT SCALE

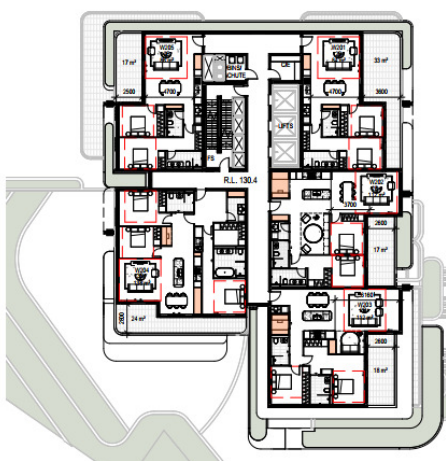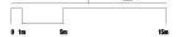

W - LEVEL 02 - 03

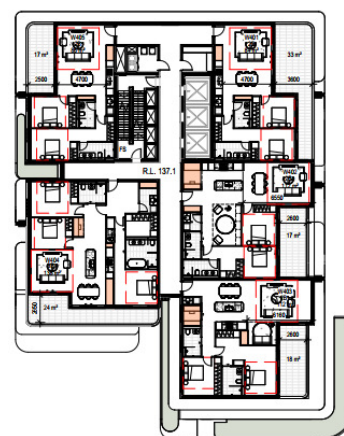

W - LEVEL 04

LEGEND:

- 3.60m MIN. ADG DIMENSION
FOR LIVING (1BR)
4m MIN. ADG DIMENSION FOR
LIVING (2BR, 3BR)
3m MIN. ADG DIMENSION FOR
BEDROOM
- STORAGE
REFER TO COMPLIANCE

REV	DESCRIPTION	DATE
A	SSDA	18/11/2025
B	SDRP	25/11/2025
C	AMENDED DA	19/12/2025



Q+ www.apkiedg.com.au
PH: 1300 386 788
LEVEL 3, 9 BARRACK STREET
SYDNEY, NSW 2000
NOMINATED ARCHITECT
KAICH LUNG NGUYEN 7133

PROJECT:

93-107 Cecil Avenue and
9-10 Roger Ave, Castle Hill

DRAWING TITLE:

DRAWING TITLE:
BUILDING W - LEVEL 2 - 4


DATE: Issue Date	SCALE: As indicated @ 1/8"	DRAWING No: A543	REV: C
---------------------	-------------------------------	---------------------	-----------

DO NOT SCALE


DO NOT SCALE

USE FIGURED DIMENSIONS
AT ALL TIMES.

A circular arrow indicating a 90-degree angle, with 'SPU' and 'SAM' labels.

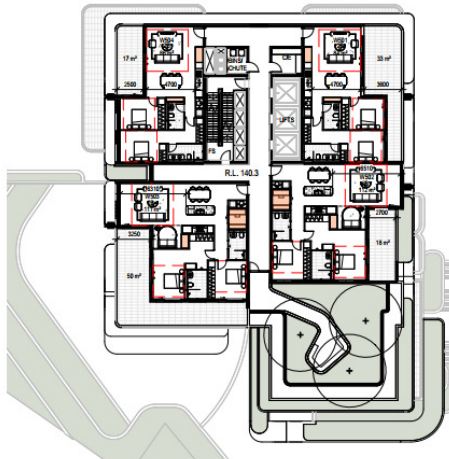

W - LEVEL 05 - 06

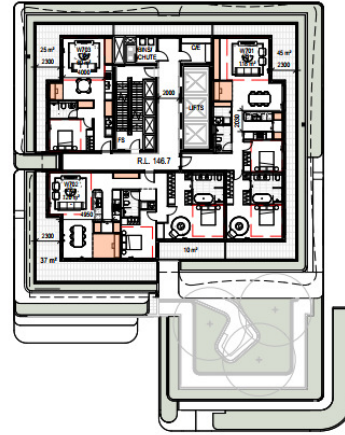

W - LEVEL 07

LEGEND:

- 3.60m MIN. AGG DIMENSION FOR LIVING (1BR)
- 4m MIN. AGG DIMENSION FOR LIVING (2BR, 3BR)
- 3m MIN. AGG DIMENSION FOR BEDROOM
- STORAGE
REFER TO COMPLIANCE TABLE SHEET A1001-A1015

REV	DESCRIPTION	DATE
A	SSDA	18/11/2025
B	SDRP	25/11/2025
C	AMENDED DA	19/12/2025



www.qplus.com.au
PH: 1300 388 788
LEVEL 3, BARRACK STREET
SYDNEY, NSW 2000
NOMINATED ARCHITECT
NOMINATING 19/11/23

PROJECT:
93-107 Cecil Avenue and
9-10 Roger Ave, Castle Hill

DRAWING TITLE:
BUILDING W - LEVEL 5 - 7

DATE	SCALE	DESIGNER	REV
Issue Date	As Issued	A544	C
DRAWN BY:	PROJECT NO.		
LM	40003		

DO NOT SCALE
USE FIGURED DIMENSIONS
AT ALL TIMES.



W - LEVEL 8 - 25

REV	DESCRIPTION	DATE
A	SSDA	18/11/2025
B	SDRP	25/11/2025
C	AMENDED DA	19/12/2025



www.qplus.com.au
PH: 1300 388 788
LEVEL 3, BARRACK STREET
SYDNEY, NSW 2000
NOMINATED ARCHITECT
NOMINATING 19/11/23

PROJECT:
93-107 Cecil Avenue and
9-10 Roger Ave, Castle Hill

DRAWING TITLE:
BUILDING W - LEVEL 7 - 25

DATE	SCALE	DESIGNER	REV
Issue Date	1:100 (A4)	A544	C
DRAWN BY:	PROJECT NO.		
LM	40003		

DO NOT SCALE
USE FIGURED DIMENSIONS
AT ALL TIMES.







REV	DESCRIPTION	DATE
A	SSDA	1911/03/25
B	SORP	2511/03/25
C	AMENDED DA	1912/03/25

Q+
www.qplus.com.au
PH: 180 300 700
LEVEL 1, BARRACK STREET
SYDNEY, NSW 2000
REGISTERED ARCHITECT
ARCHITECTING NSW 7103


PROJECT:
93-107 Cecil Avenue and
9-10 Roger Ave, Castle Hill

DRAWING TITLE:
BUILDING E - LEVEL 8 - 30

DATE:	SCALE:	DRAWING NO.:	REV.:
25/03/25	1:100 @ A4	A504	C
DRAWN BY:	PROJECTED BY:		
UN	JOHNS		
DO NOT SCALE			
USE PLOTTED DIMENSIONS AT ALL TIMES			



S - LOWER GROUND

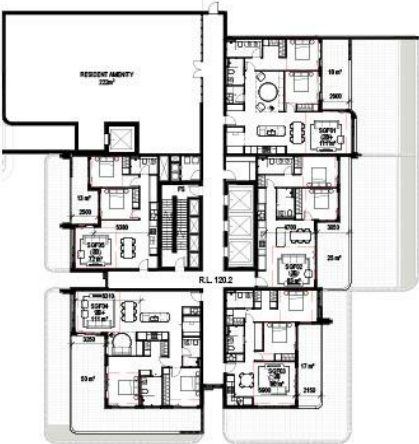

S - GROUND LEVEL

REV	DESCRIPTION	DATE
A	SSDA	1911/03/25
B	SORP	2511/03/25
C	AMENDED DA	1912/03/25

Q+
www.qplus.com.au
PH: 180 300 700
LEVEL 1, BARRACK STREET
SYDNEY, NSW 2000
REGISTERED ARCHITECT
ARCHITECTING NSW 7103

PROJECT:
93-107 Cecil Avenue and
9-10 Roger Ave, Castle Hill

DRAWING TITLE:
BUILDING S - LG - G

DATE:	SCALE:	DRAWING NO.:	REV.:
25/03/25	1:100 @ A4	A511	C
DRAWN BY:	PROJECTED BY:		
UN	JOHNS		
DO NOT SCALE			
USE PLOTTED DIMENSIONS AT ALL TIMES			



S - UPPER GROUND



S - LEVEL 01

REV	DESCRIPTION	DATE
A	SSDA	18/11/2025
B	SDRP	25/11/2025
C	AMENDED DA	19/12/2025




PROJECT:
93-107 Cecil Avenue and
9-10 Roger Ave, Castle Hill


DRAWING TITLE:
BUILDING S - UG - L1

DATE	SCALE	DRAWING NO.	REV.
Issue Date	1:100 (A4)	A512	C
DRAWN BY:	PROJECT NO.		
UN	1000		

DO NOT SCALE
USE DIMENSIONS
AT ALL TIMES

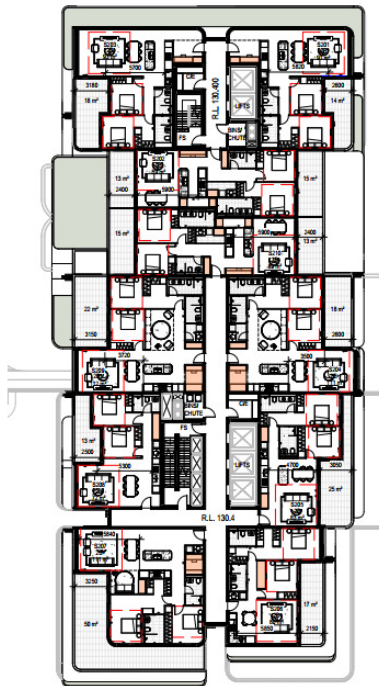

S - LEVEL 02 - 04

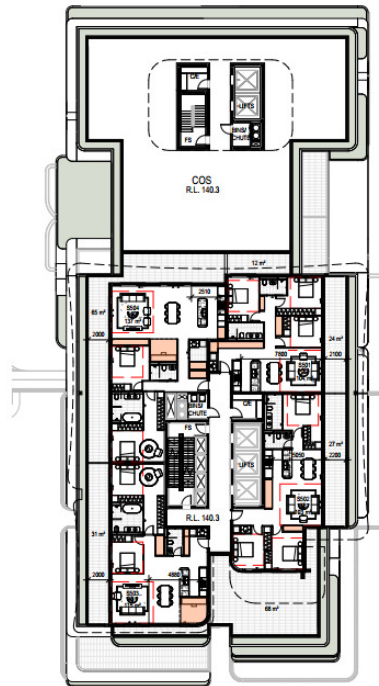

S - LEVEL 05

- LEGEND:
- 3.6m MIN. ADG DIMENSION FOR LIVING (LBR)
 - 4m MIN. ADG DIMENSION FOR LIVING (LBR, 3BR)
 - 3m MIN. ADG DIMENSION FOR BEDROOM
 - STORAGE
 - REFER TO COMPLIANCE TABLE SHEET A1001-A1015

REV	DESCRIPTION	DATE
A	SSDA	18/11/2025
B	SDRP	25/11/2025
C	AMENDED DA	19/12/2025



PROJECT:
93-107 Cecil Avenue and
9-10 Roger Ave, Castle Hill

DRAWING TITLE:
BUILDING S - LEVEL 2-5

DATE	SCALE	DRAWING NO.	REV.
Issue Date	As Indicated @	A513	C
DRAWN BY:	PROJECT NO.		
UN	1000		

DO NOT SCALE
USE DIMENSIONS
AT ALL TIMES



LEGEND:

- 3.65m MIN. ADD. DIMENSION FOR LIVING (1 BR)
- 4m MIN. ADD. DIMENSION FOR LIVING (2 BR, 3 BR)
- 3m MIN. ADD. DIMENSION FOR BEDROOM
- STORAGE REFER TO COMPLIANCE TABLE SHEET A1001-A1015

REV	DESCRIPTION	DATE
A	SSDA	18/11/2025
B	SDRP	25/11/2025
C	AMENDED DA	19/12/2025

Q+ www.qplus.com.au
PH: 1300 288 788
LEVEL 1, 8 BARRACK STREET
SYDNEY, NSW 2000
REGISTERED ARCHITECT
KACH LEUNG NBR 7133

PROJECT:
93-107 Cecil Avenue and
9-10 Roger Ave, Castle Hill

DRAWING TITLE:
BUILDING S - LEVEL 2 - 5

DATE	SCALE	DRAWING NO.	REV.
Issue Date	As Issued (A)	A513	C

DO NOT SCALE
USE DIMENSIONS
AT ALL TIMES.



REV	DESCRIPTION	DATE
A	SSDA	18/11/2025
B	SDRP	25/11/2025
C	AMENDED DA	19/12/2025

Q+ www.qplus.com.au
PH: 1300 288 788
LEVEL 1, 8 BARRACK STREET
SYDNEY, NSW 2000
REGISTERED ARCHITECT
KACH LEUNG NBR 7133

PROJECT:
93-107 Cecil Avenue and
9-10 Roger Ave, Castle Hill

DRAWING TITLE:
BUILDING S - LEVEL 6 - 22

DATE	SCALE	DRAWING NO.	REV.
Issue Date	1:300 (A)	A514	C

DO NOT SCALE
USE DIMENSIONS
AT ALL TIMES.

Appendix D References

- [1] Structural Design Actions, Part 0: General Principles, Australian/New Zealand Standard 1170.0:2011
- [2] Structural Design Actions, Part 2: Wind Actions, Australian/New Zealand Standard 1170.2:2021
- [3] Blocken, B. (2014) '50 years of Computational Wind Engineering: Past, present and future', *Journal of Wind Engineering and Industrial Aerodynamics*, 129, pp. 69–102.
- [4] Blocken a et al. (2011) CFD simulation for pedestrian wind comfort and wind safety in urban areas: General Decision Framework and Case Study for the Eindhoven University Campus, *Environmental Modelling & Software*.
- [5] Holmes, J.D. and Bekele, S. (2022) *Wind loading of structures*. Boca Raton: CRC Press.
- [6] Selvam, R.P. (2022) *Computational Fluid Dynamics for Wind Engineering*. Hoboken, NJ: Wiley Blackwell.
- [7] Deaves, D.M. and Harris, R.I (1978). A Mathematical model of the structure of strong winds. CIRIA Report 76, England.
- [8] Apartment Design Guide – Part 4 – designing the building.
<https://www.planning.nsw.gov.au/sites/default/files/2023-03/apartment-design-guide-part-4-designing-the-building.pdf>.
- [9] Standards Australia AS 1668.2:2002 – The use of ventilation and air conditioning in buildings – Part 2: Ventilation design for indoor contaminant control.
- [10] Apartment design guidelines for victoria.
https://www.planning.vic.gov.au/___data/assets/pdf_file/0030/80994/Apartment-Design-Guidelines-for-Victoria_August-2017.pdf.
- [11] Chen, C.-M., Lin, Y.-P., Chung, S.-C. and Lai, C.-M. (2022). Effects of the Design Parameters of Ridge Vents on Induced Buoyancy-Driven Ventilation. *Buildings*, 12(2), p.112.
- [12] Hsieh, L., Chen, L., Wang, S. and Su, C. (2021). Airflow visualization and performance assessment for a roof ridge ventilator under wind using Schlieren photography technique. *Case Studies in Thermal Engineering*, 26, pp.101044–101044.
- [13] C. Ghiaus and Allard, F. (2006). *Natural ventilation in 'Building Ventilation: the state of the art'*. Available at: https://www.researchgate.net/publication/281880673_Natural_ventilation_in_Building_Ventilation_the_state_of_the_art.
- [14] Zubialde-Elzaurdia, M., Lucas, F. and Bastide, A. (2021) Using CFD simulation to improve estimation of wind pressure coefficient for naturally ventilated buildings in tropical climate, upf. Available at: <https://upf.hal.science/hal-03180305>.