



# APPENDIX B – UPDATED PROJECT DESCRIPTION – SSD-10448 MOD 10

## Project Description SSD-10448

### PART A CONDITIONS FOR CONCEPT PROPOSAL

#### NOISE LIMITS

A16. The Applicant must:


(a) ensure the cumulative noise emission of fixed external mechanical plant for each warehouse building does not exceed a sound power level (SWL) of 90 dB(A) (except Warehouse 8 whose fixed external mechanical plant must not exceed a cumulative sound power level (SWL) of 98 dB(A)) and do not exhibit tonal characteristic or strong low frequency content; and

### APPENDIX 1 CONCEPT PROPOSAL


Table 5 Schedule of Approved Plans – Concept Proposal

Drawing No	Title	Issue	Date
<b>Architectural Plan prepared by SBA Architects</b>			
<del>MP6-02</del> MP01	Aspect Industrial Estate Lots 1-5 (DP 1285305) Mamre Road, Kemps Creek – SSDA-MOD <del>6-10</del> Estate Masterplan	<del>C</del> B	<del>02/04/2024</del> 03/04/2025
<b>Landscape Plan prepared by Site Image Landscape Architects</b>			
003	Aspect Industrial Estate Kemps Creek Landscape-Masterplan MOD <del>6</del> IVE Fitout	<del>I</del> A	<del>04/04/2024</del> 08/04/2025
<b>Tree Canopy Plan prepared by Site Image Landscape Architects</b>			
<del>MOD6-SK001</del> 2001	Kemps Creek Lots 1,2 & 5 DP 1285305 & Lots 6 & 7 DP 1291562 Mamre Road Kemps Creek Tree Canopy Plan	<del>D</del> 02	<del>04/04/2024</del> 15/04/2024

Delete Figure 1: Concept Proposal

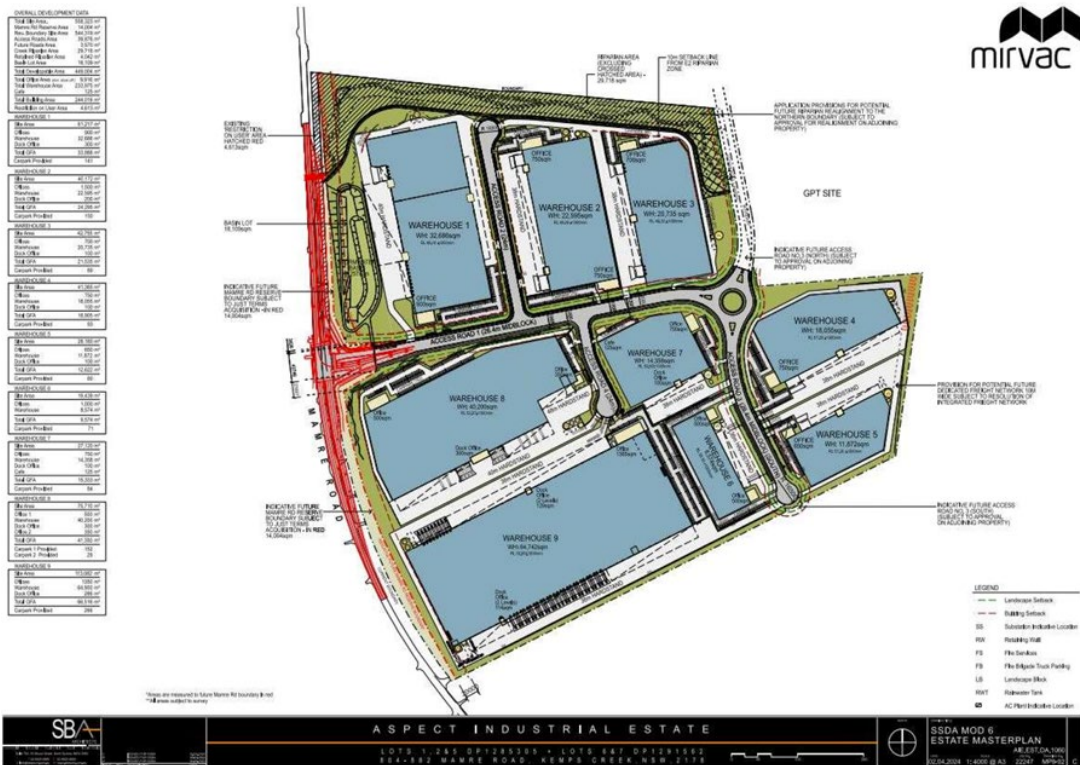

Insert new Figure 1: Concept Proposal

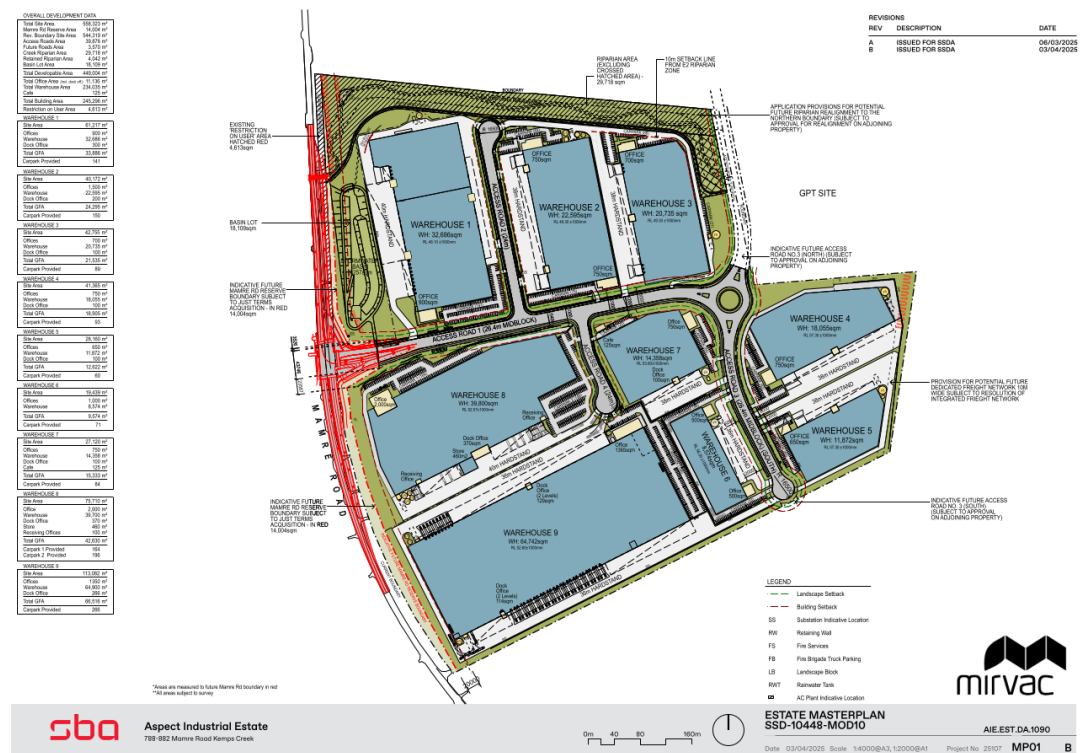

Insert new Figure 1A: Tree Canopy Plan

