


## Appendix J. Survey



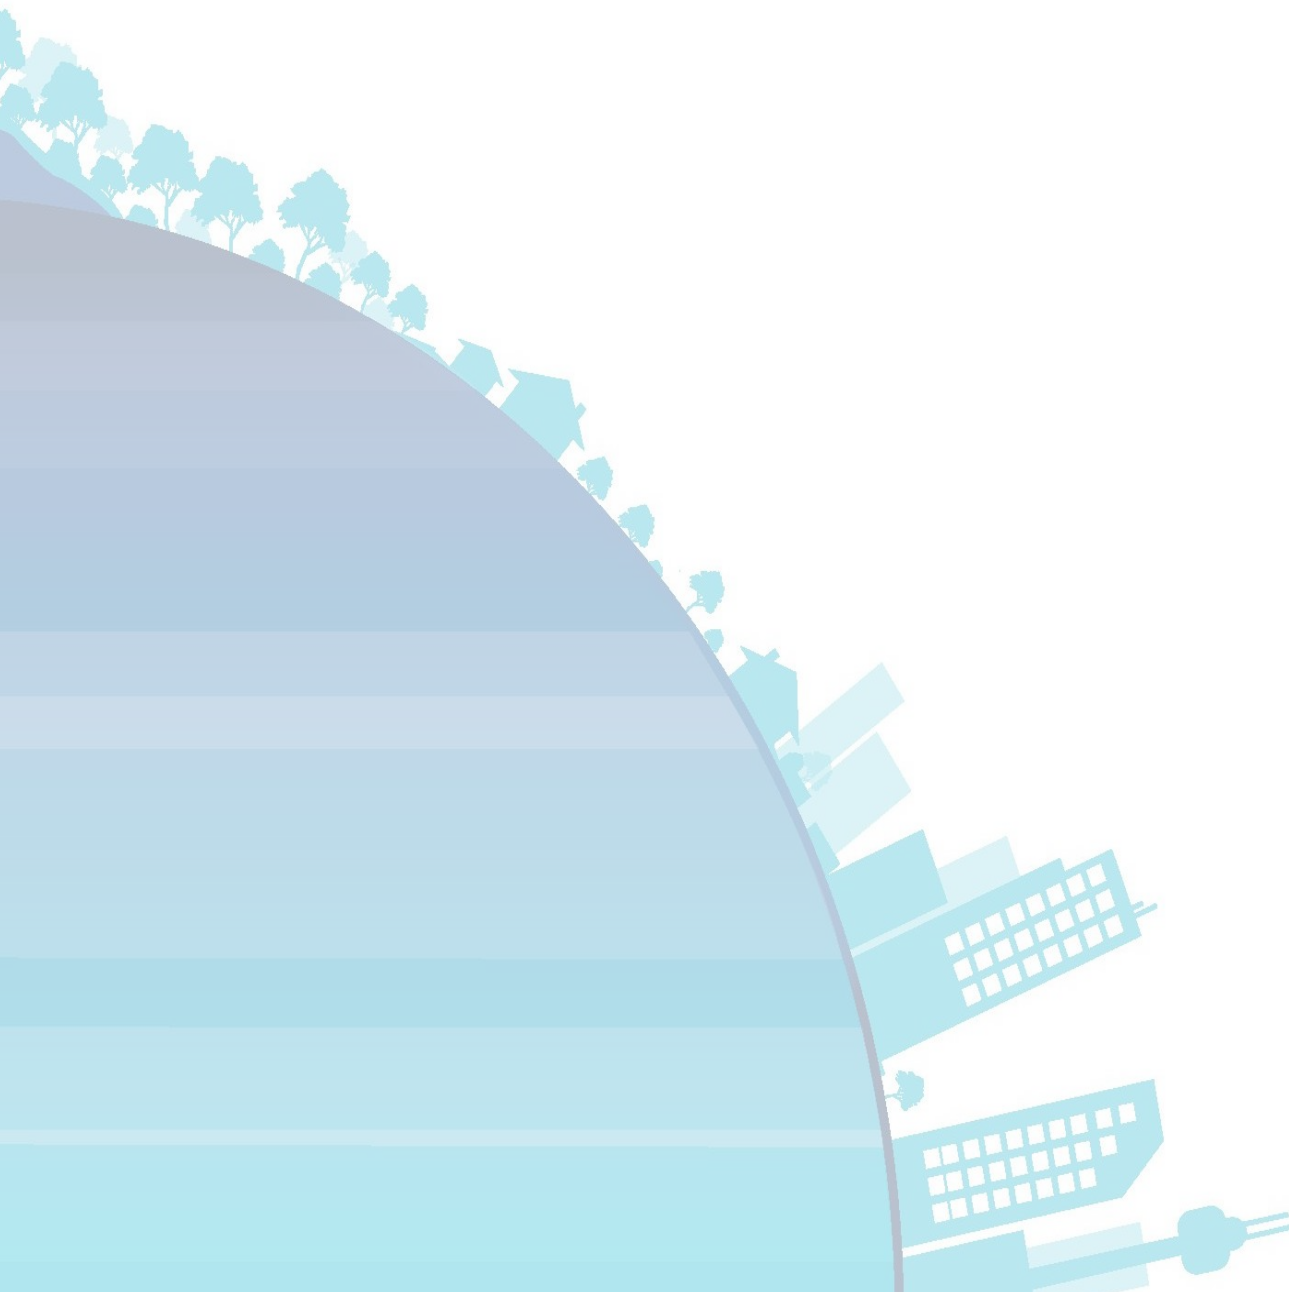

A1

NOTES :

\* THIS TITLEBLOCK IS AN INTEGRAL PART OF THIS DRAWING AND SHOULD NOT BE REMOVED.

**LEGEND**  
WHERE POSSIBLE STRING LABELS CORRESPOND WITH SERVICE LOCATION TABLE BY ONE SEARCH LOCATORS.

E17- ELECTRICITY BY SERVICE CONSULTANT  
G1 - GAS BY SERVICE CONSULTANT  
W1 - WATER BY SERVICE CONSULTANT  
T15 - COMMUNICATIONS BY SERVICE CONSULTANT  
SW1 - STORMWATER BY SERVICE CONSULTANT

ALL LEVELS SHOWN ARE TO THE TOP OF THE SERVICE  
STORMWATER LEVES ARE TO THE INVERT OF THE PIPE

Liability Limited by a Scheme Approved under Professional Standards Legislation

**COVER OF EXCELLENCE**

**DIAL BEFORE YOU DIG**  
www.1100.com.au

| © PROJECT SURVEYORS-2016<br>REPRODUCTION WITHOUT WRITTEN<br>APPROVAL IS STRICTLY PROHIBITED |                                             |          |  |
|---------------------------------------------------------------------------------------------|---------------------------------------------|----------|--|
|                                                                                             |                                             |          |  |
| F                                                                                           | UPDATED DETAIL & UG SERVICES AS PER MARK UP | 04.10.17 |  |
| D                                                                                           | UPDATED DETAIL & UG SERVICES                | 02.05.17 |  |
| A                                                                                           | FLOOR LEVELS & GOODS LIFT ADDED             | 24.02.17 |  |
| REV                                                                                         | AMENDMENTS                                  | DATE     |  |

CLIENT: UOW  
PLAN OF: OVALS CARPARK UOW

SHOWING: GENERAL DETAIL AND SITE LEVELS

PURPOSE: ARCHITECTURAL DESIGN COUNCIL SUBMISSION

**SHEET 1 OF 4**

SCALE 1:200

0 5 10 15 20


SURVEYOR : SCOTT D  
DATUM : AUSTRALIAN HEIGHT DATUM  
ORIGIN : SSM 53689 RL 51.16  
JOB REF. : B3671  
DRAWING No. B3671-PS-FINAL1  
CHECKED : EDYTA K  
DATE OF SURVEY: 20/12/2016  
REDUCTION RATIO : 1:200

**MACQUARIE PARK**

PO Box 4004  
MACQUARIE CENTRE NSW 2113  
SUITE 404, LEVEL 4  
No13-15 LYON PARK ROAD,  
MACQUARIE PARK NSW 2113

PHONE : 9888 3848  
FAX : 9888 3875  
email: office@projectsurveyors.com.au  
www.projectsurveyors.com.au  
ABN 20 068 433 974

**PROJECT SURVEYORS**  
Professional Innovative... Results.

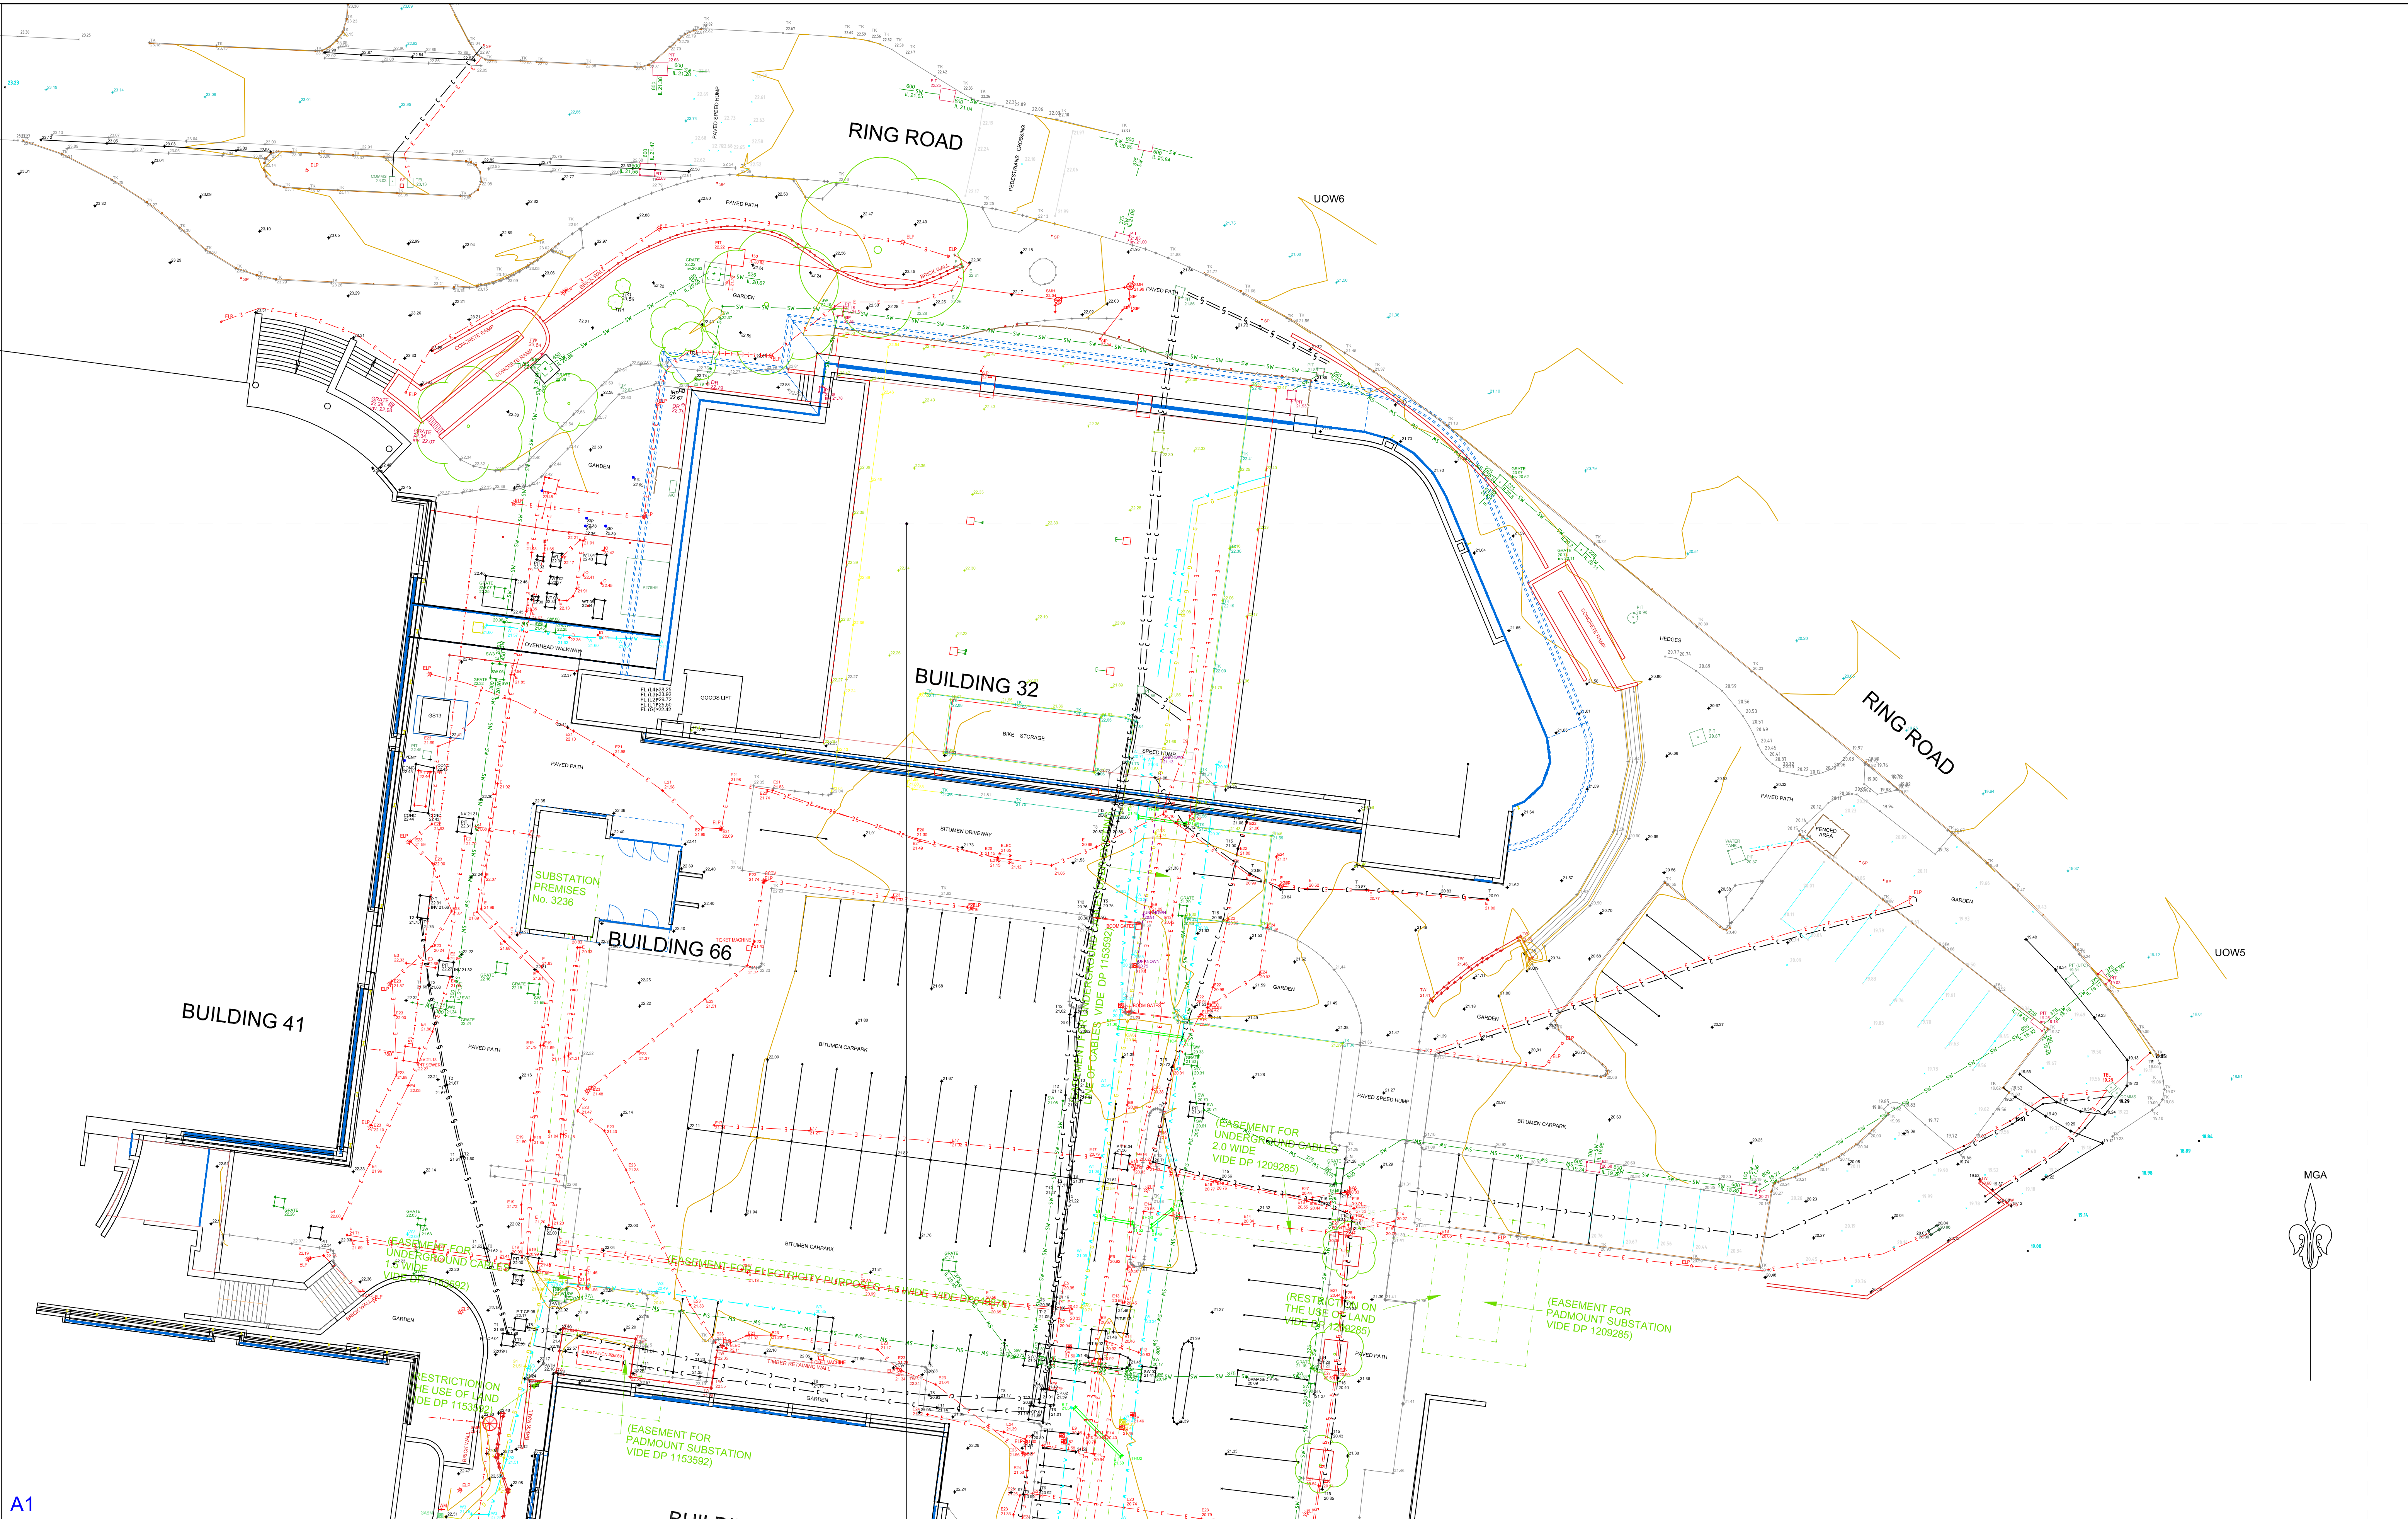

A1

NOTES :

\* THIS TITLEBLOCK IS AN INTEGRAL PART OF THIS DRAWING AND SHOULD NOT BE REMOVED.

**LEGEND**  
WHERE POSSIBLE STRING LABELS CORRESPOND WITH SERVICE LOCATION TABLE BY ONE SEARCH LOCATORS.

E17- ELECTRICITY BY SERVICE CONSULTANT  
G1 - GAS BY SERVICE CONSULTANT  
W1 - WATER BY SERVICE CONSULTANT  
T15 - COMMUNICATIONS BY SERVICE CONSULTANT  
SW1 - STORMWATER BY SERVICE CONSULTANT

ALL LEVELS SHOWN ARE TO THE TOP OF THE SERVICE  
STORMWATER LEVES ARE TO THE INVERT OF THE PIPE

Liability Limited by a Scheme Approved under Professional Standards Legislation

**COVER OF EXCELLENCE**

**DIAL BEFORE YOU DIG**  
www.1100.com.au

| © PROJECT SURVEYORS-2016<br>REPRODUCTION WITHOUT WRITTEN<br>APPROVAL IS STRICTLY PROHIBITED |                                             |          |  |
|---------------------------------------------------------------------------------------------|---------------------------------------------|----------|--|
|                                                                                             |                                             |          |  |
| F                                                                                           | UPDATED DETAIL & UG SERVICES AS PER MARK UP | 04.10.17 |  |
| D                                                                                           | UPDATED DETAIL & UG SERVICES                | 02.05.17 |  |
| A                                                                                           | FLOOR LEVELS & GOODS LIFT ADDED             | 24.02.17 |  |
| REV                                                                                         | AMENDMENTS                                  | DATE     |  |

CLIENT: UOW  
PLAN OF: OVALS CARPARK UOW

SHOWING: GENERAL DETAIL AND SITE LEVELS

PURPOSE: ARCHITECTURAL DESIGN COUNCIL SUBMISSION

**SHEET 2 OF 4**

SCALE 1:200

0 5 10 15 20

SURVEYOR : SCOTT D  
DATUM : AUSTRALIAN HEIGHT DATUM  
ORIGIN : SSM 53689 RL 51.16  
JOB REF : B3671  
DRAWING No. B3671-PS-FINAL-2  
CHECKED : EDYTA K  
DATE OF SURVEY: 20/12/2016  
REDUCTION RATIO : 1:200

**MACQUARIE PARK**

PO Box 4004  
MACQUARIE CENTRE NSW 2113  
SUITE 404, LEVEL 4  
No13-15 LYON PARK ROAD,  
MACQUARIE PARK NSW 2113

PHONE : 9888 3848  
FAX : 9888 3875  
email: office@projectsurveyors.com.au  
www.projectsurveyors.com.au  
ABN 20 068 433 974

**PROJECT SURVEYORS**  
Professional Innovative... Results.

A1

NOTES :

\* THIS TITLEBLOCK IS AN INTEGRAL PART OF THIS DRAWING AND SHOULD NOT BE REMOVED.

LEGEND

WHERE POSSIBLE STRING LABELS CORRESPOND WITH SERVICE LOCATION TABLE BY ONE SEARCH LOCATORS.  
PHV - HIGH VOLTAGE ELECTRICITY BY POTHOLE  
PLV- LOW VOLTAGE ELECTRICITY BY POTHOLE  
PGAS - GAS BY POTHOLE  
PW100,150 - WATER BY POTHOLE  
PCOM - COMMUNICATIONS BY POTHOLE  
CONC - CONCRETE ENCASEMENT BY POTHOLE  
TH01 - STRIP TRENCH NUMBER  
ALL LEVELS SHOWN ARE TO THE TOP OF THE SERVICE



Liability Limited by a Scheme Approved under Professional Standards Legislation



**DIAL BEFORE YOU DIG**  
www.1100.com.au

© PROJECT SURVEYORS-2016  
REPRODUCTION WITHOUT WRITTEN APPROVAL IS STRICTLY PROHIBITED

| REV | AMENDMENTS                      | DATE     |
|-----|---------------------------------|----------|
| D   | UPDATED DETAIL & UG SERVICES    | 02.05.17 |
| A   | FLOOR LEVELS & GOODS LIFT ADDED | 24.02.17 |

CLIENT: UOW


PLAN OF: OVALS CARPARK  
UOW

SHOWING: GENERAL DETAIL AND  
SITE LEVELS

PURPOSE: ARCHITECTURAL DESIGN  
COUNCIL SUBMISSION

SHEET 3 OF 4

SCALE 1:200

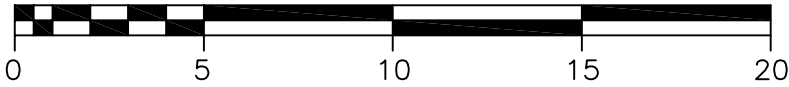

SURVEYOR : SCOTT D  
DATUM : AUSTRALIAN HEIGHT DATUM  
ORIGIN : SSM 53689 RL 51.16  
JOB REF. : B3671  
DRAWING No. B3671-PS-FINAL-POTHOLE  
CHECKED : EDYTA K  
DATE OF SURVEY: 20/12/2016  
REDUCTION RATIO : 1:200

MACQUARIE PARK

PO Box 4004  
MACQUARIE CENTRE NSW 2113  
SUITE 404, LEVEL 4  
No13-15 LYON PARK ROAD,  
MACQUARIE PARK NSW 2113

PHONE : 9888 3848  
FAX : 9888 3875  
email: office@projectsurveyors.com.au  
www.projectsurveyors.com.au  
ABN 20 068 433 974



**PROJECT  
SURVEYORS**

Professional Innovative... Results.