



ARCHITECTURAL DRAWINGS

NO.	DRAWING TITLE	SCALE
A 0100	Drawing List & Site Plan	
A 0101	Site Survey	1:100
A 0301	Demolition Plan	1:100
A 1001	Grid & Excavation Setout	1:100
A 1101	Lower Ground Floor Plan	1:100
A 1201	Ground Floor Plan	1:100
A 1301	First Floor / Mezzanine Plan	1:100
A 1302	Second Floor Plan	1:100
A 1303	Third Floor Plan	1:100
A 1304	Fourth Floor Plan	1:100
A 1401	Roof Plan	1:100
A 1501	Elevations - Sheet 1	1:100
A 1502	Elevations - Sheet 2	1:100
A 1601	Sections - Sheet 1	1:100
A 1602	Sections - Sheet 2	1:100
A1603	Sections - Sheet 3	1:100
A 1701	RCP - Lower Ground	1:100
A 1702	RCP - Ground Floor	1:100
A 1703	RCP - First Floor / Mezzanine	1:100
A 1704	RCP - Second Floor	1:100
A 1705	RCP - Third & Fourth Floor	1:100
A 2701	Wall Sections - Sheet 1 (North)	1:20
A 2702	Wall Sections - Sheet 2 (East)	1:20
A 2703	Wall Sections - Sheet 3 (West)	1:20
A 2704	Wall Sections - Sheet 4 (South)	1:20
A 2705	Wall Sections - Sheet 5	1:20
A 2706	Wall Sections - Sheet 6	1:20
A 2707	Wall Sections - Sheet 7	1:20
A 2708	Wall Sections - Sheet 8	1:20
A 2709	Wall Sections - Sheet 9	1:20
A 2710	Plan Details	1:20
A 3301	Amenities Details	1:50
A 3401	Stair 1 Plans - Plans	1:50
A 3402	Stair 1 - Roof, Elevations & Sections	1:50
A 3403	Stair 1 - Section & Details	Varies
A 3404	Stair 2, 4 & 5	1:50
A 3405	Stair 3 & 6 (External)	1:50
A 3406	Handrail / Balustrade Details	1:10
A5401	Miscellaneous Metalwork	Varies
A5801	Miscellaneous Joinery	1:50

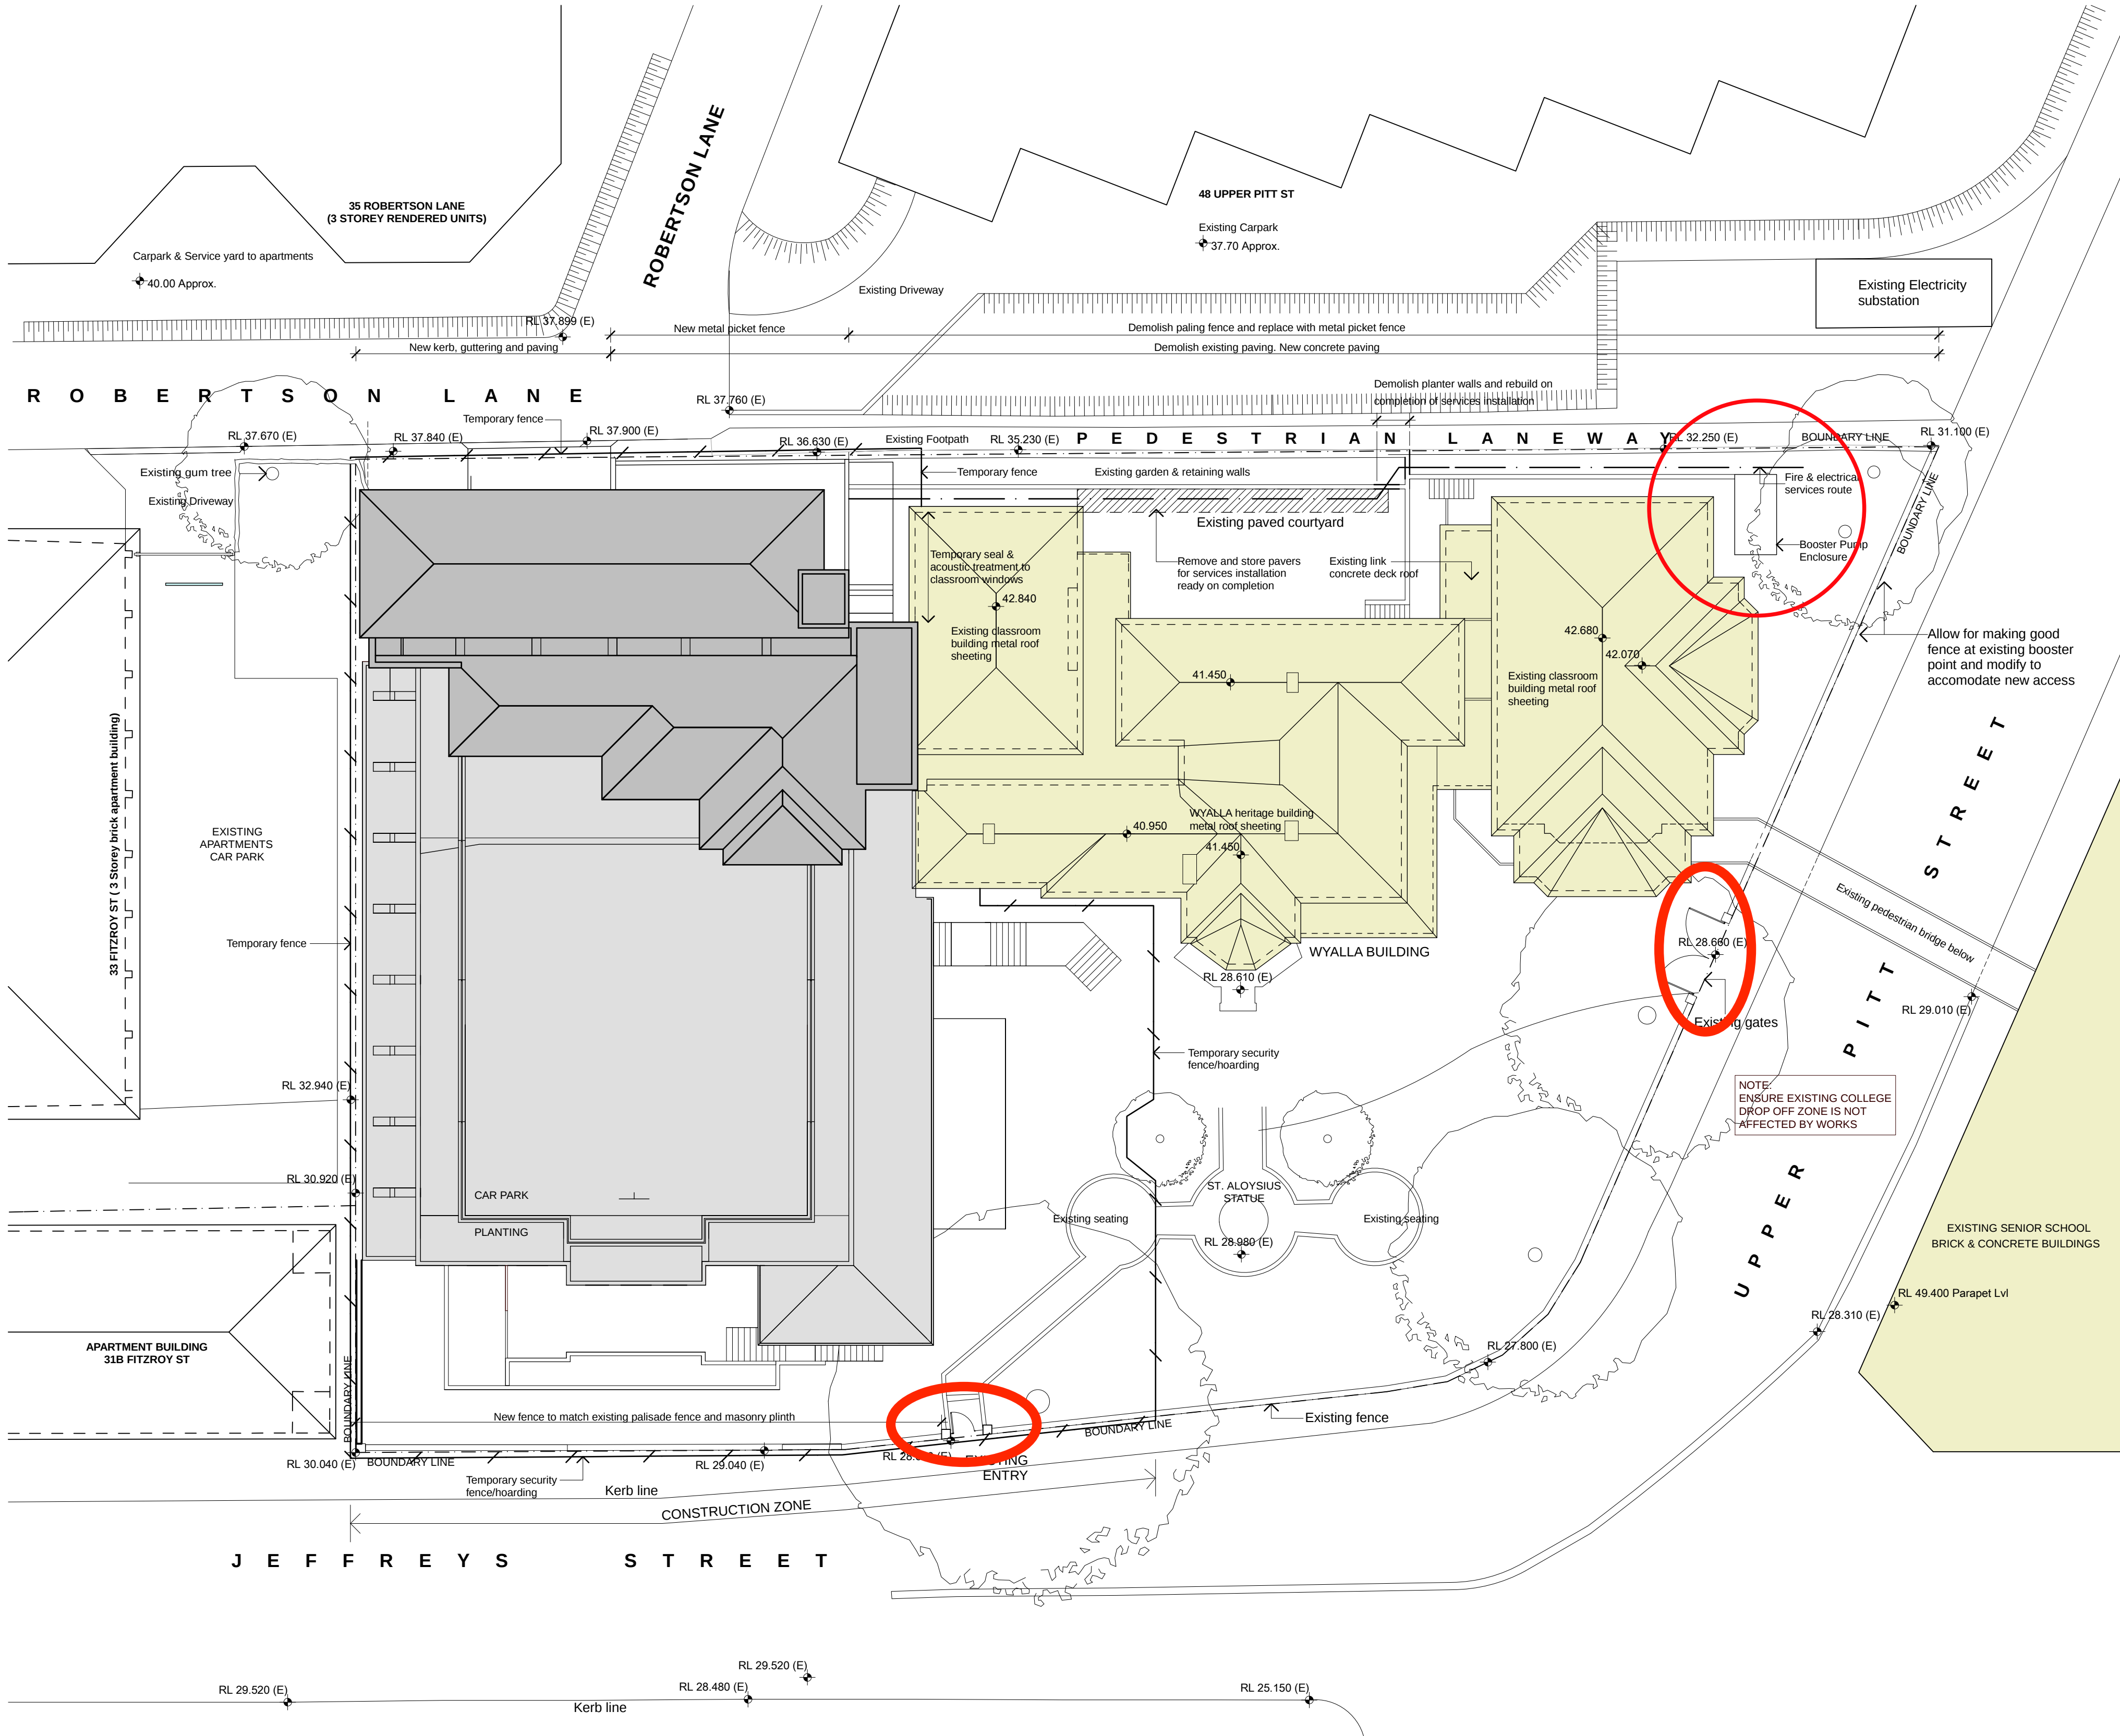

Site Plan
SCALE - 1:200

CHECK ALL DIMENSIONS ON SITE. REFER ANY DISCREPANCIES TO THE ARCHITECT BEFORE PROCEEDING WITH THE WORK.

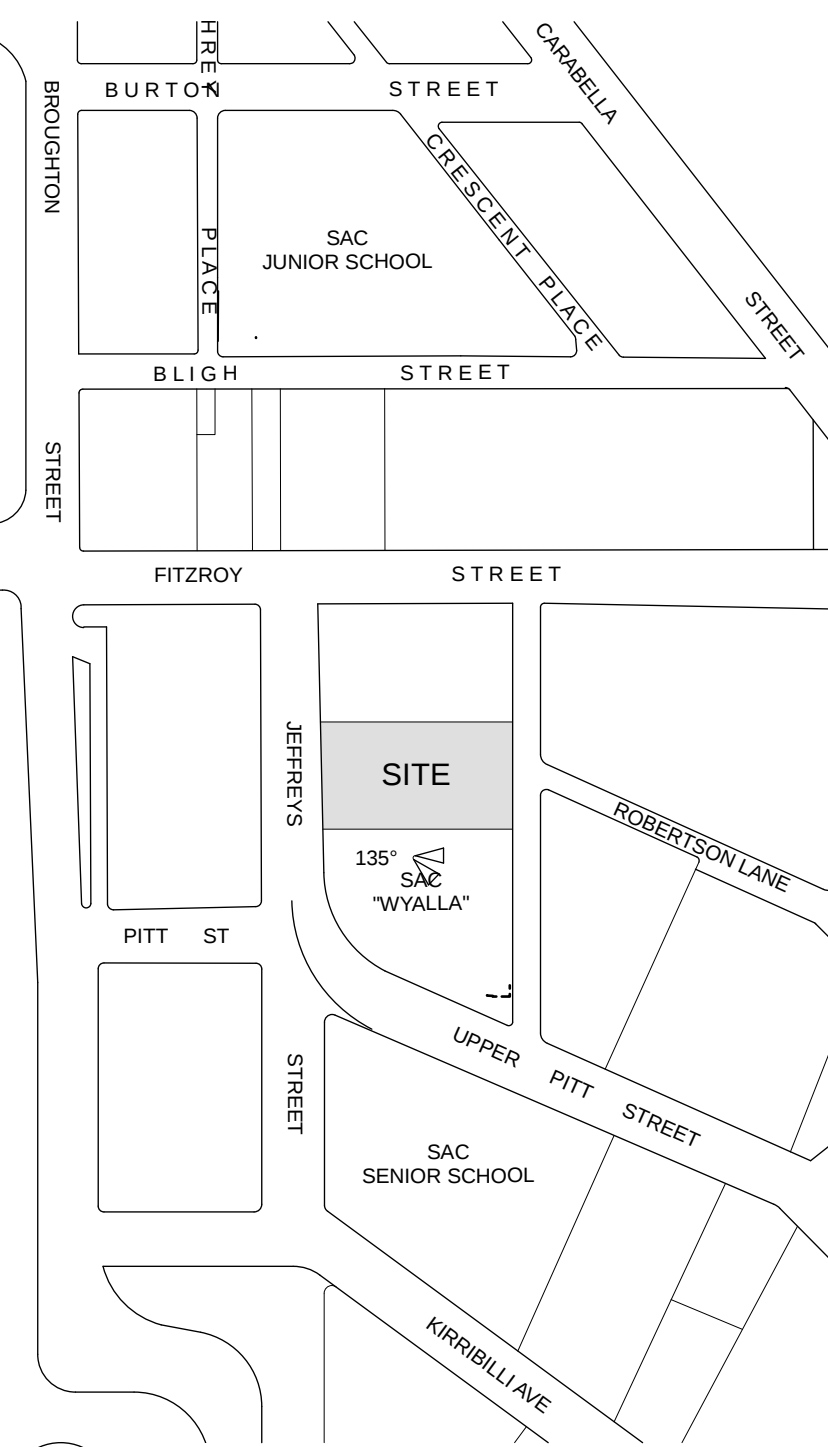

Locality Plan
SCALE - 1:2000

REVISION	DESCRIPTION	DATE	CHECKED
A	ISSUE FOR TENDER	05/08/2009	DG
B	ISSUE FOR CONTRACT. A2710 ADDED TO DRAWING LIST	15/09/2009	DG
C	ISSUE FOR CONSTRUCTION	31/10/2009	DG

POOL CONSULTANT
ACOR Consultants
L1: 24 Falcon St
PO Box 822 Crows Nest NSW 2065
Ph 9438 5098 Fax 9438 5398

HYDRAULIC ENGINEER
Sparks & Partners
L1: 91 George St PARRAMATTA NSW 2150
PO Box 979 Parramatta NSW 2124
Ph 9891 5039 Fax 9891 3699

ELECTRICAL & MECHANICAL ENGINEER
Shelmerdine
55 Hume St
Crows Nest NSW 2065
Ph 9436 3021 Fax 9439 8709

STRUCTURAL & CIVIL ENGINEER
Taylor Thomson Whitting
48 Chandos Street
St Leonards NSW 2065
Ph 9439 7288 Fax 9439 3146

PROJECT MANAGER
Farrell Coyne Projects
Suite 1, 18 Hickson Rd
Walsh Bay NSW 2000
Ph 9247 5155 Fax 9247 5156


CLIENT
St Aloysius College
Upper Pitt Street
Milton's Point NSW 2061

PROJECT
St Aloysius College
Multi-Purpose Hall
1-5 Jeffreys Street
Kirribilli NSW 2061


DRAWING TITLE
Cover Page
Drawing List & Site Plan



PROJECT No	DRAWING No	REVISION
09003	A0100	C
DRAWING SCALE	DRAWN	CHECKED
As Shown	DM	DG
DATE		

ARCHITECT
GARDNER WETHERILL & ASSOCIATES
LEVEL 2 Suite 2.01
460 Pacific Highway
St Leonards NSW 2065
T (02) 9929 6777
F (02) 9929 3999
E design@gardnerwetherill.com.au
A.C.N. 104 476 833
Notified Architect - Alistair Ross Gardner (Reg No. 3948)

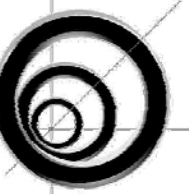

FOR CONSTRUCTION

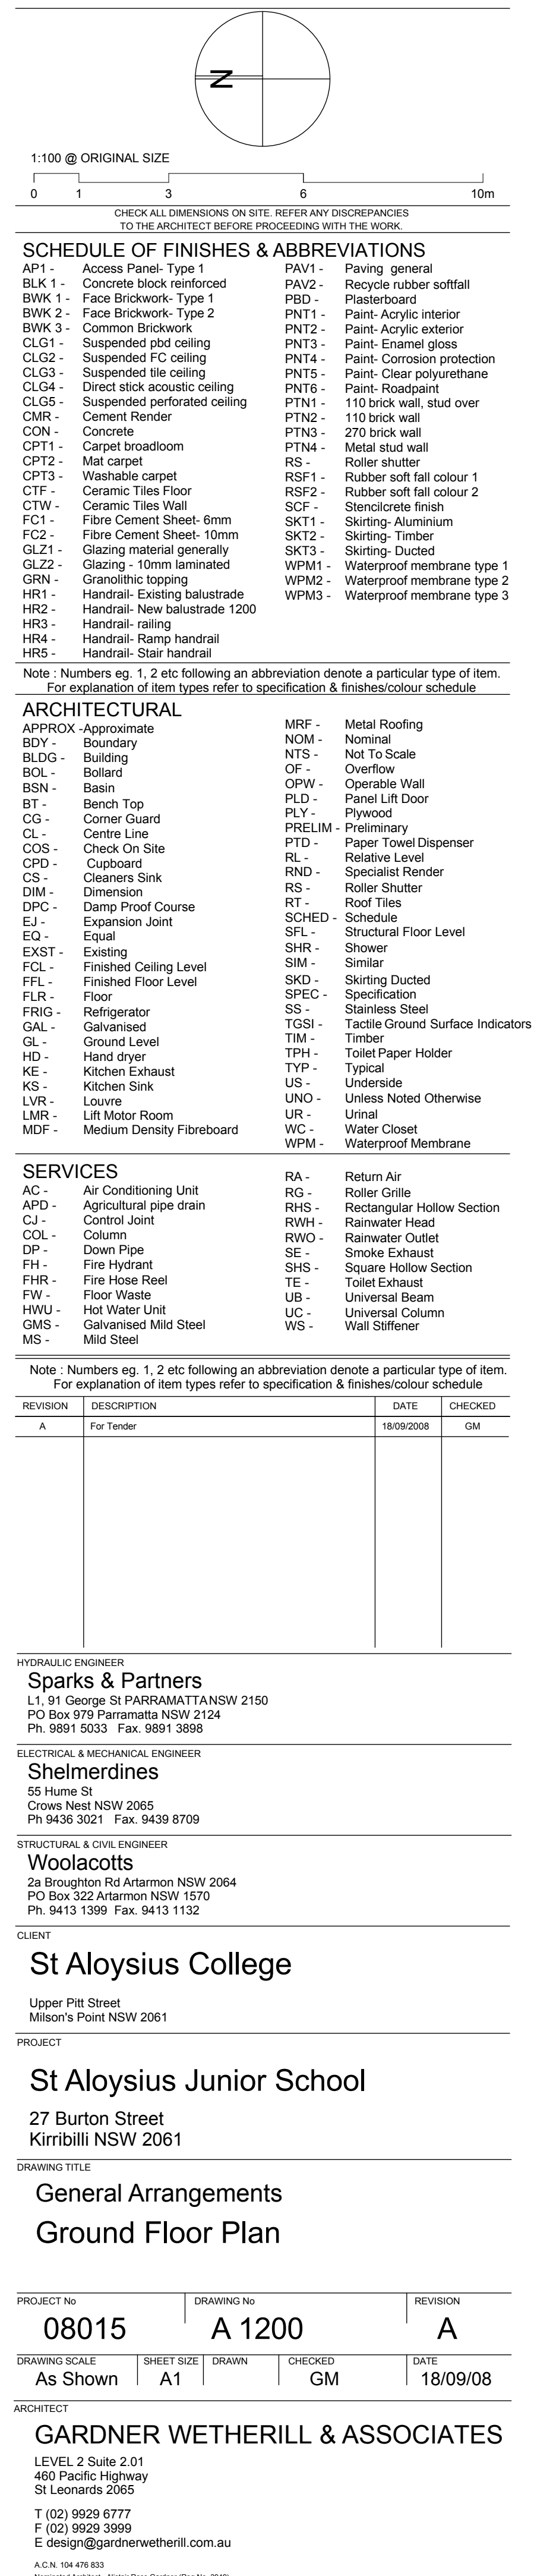

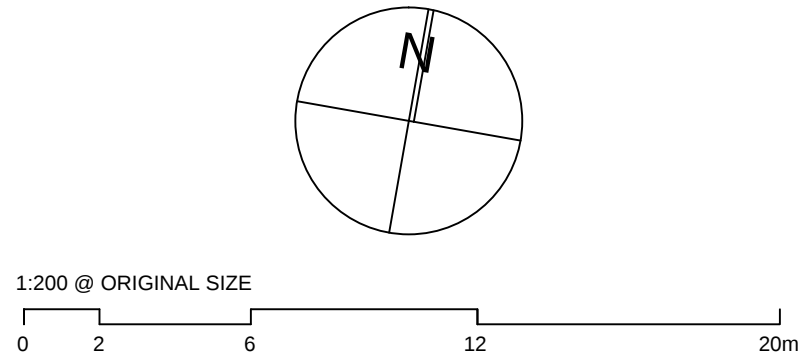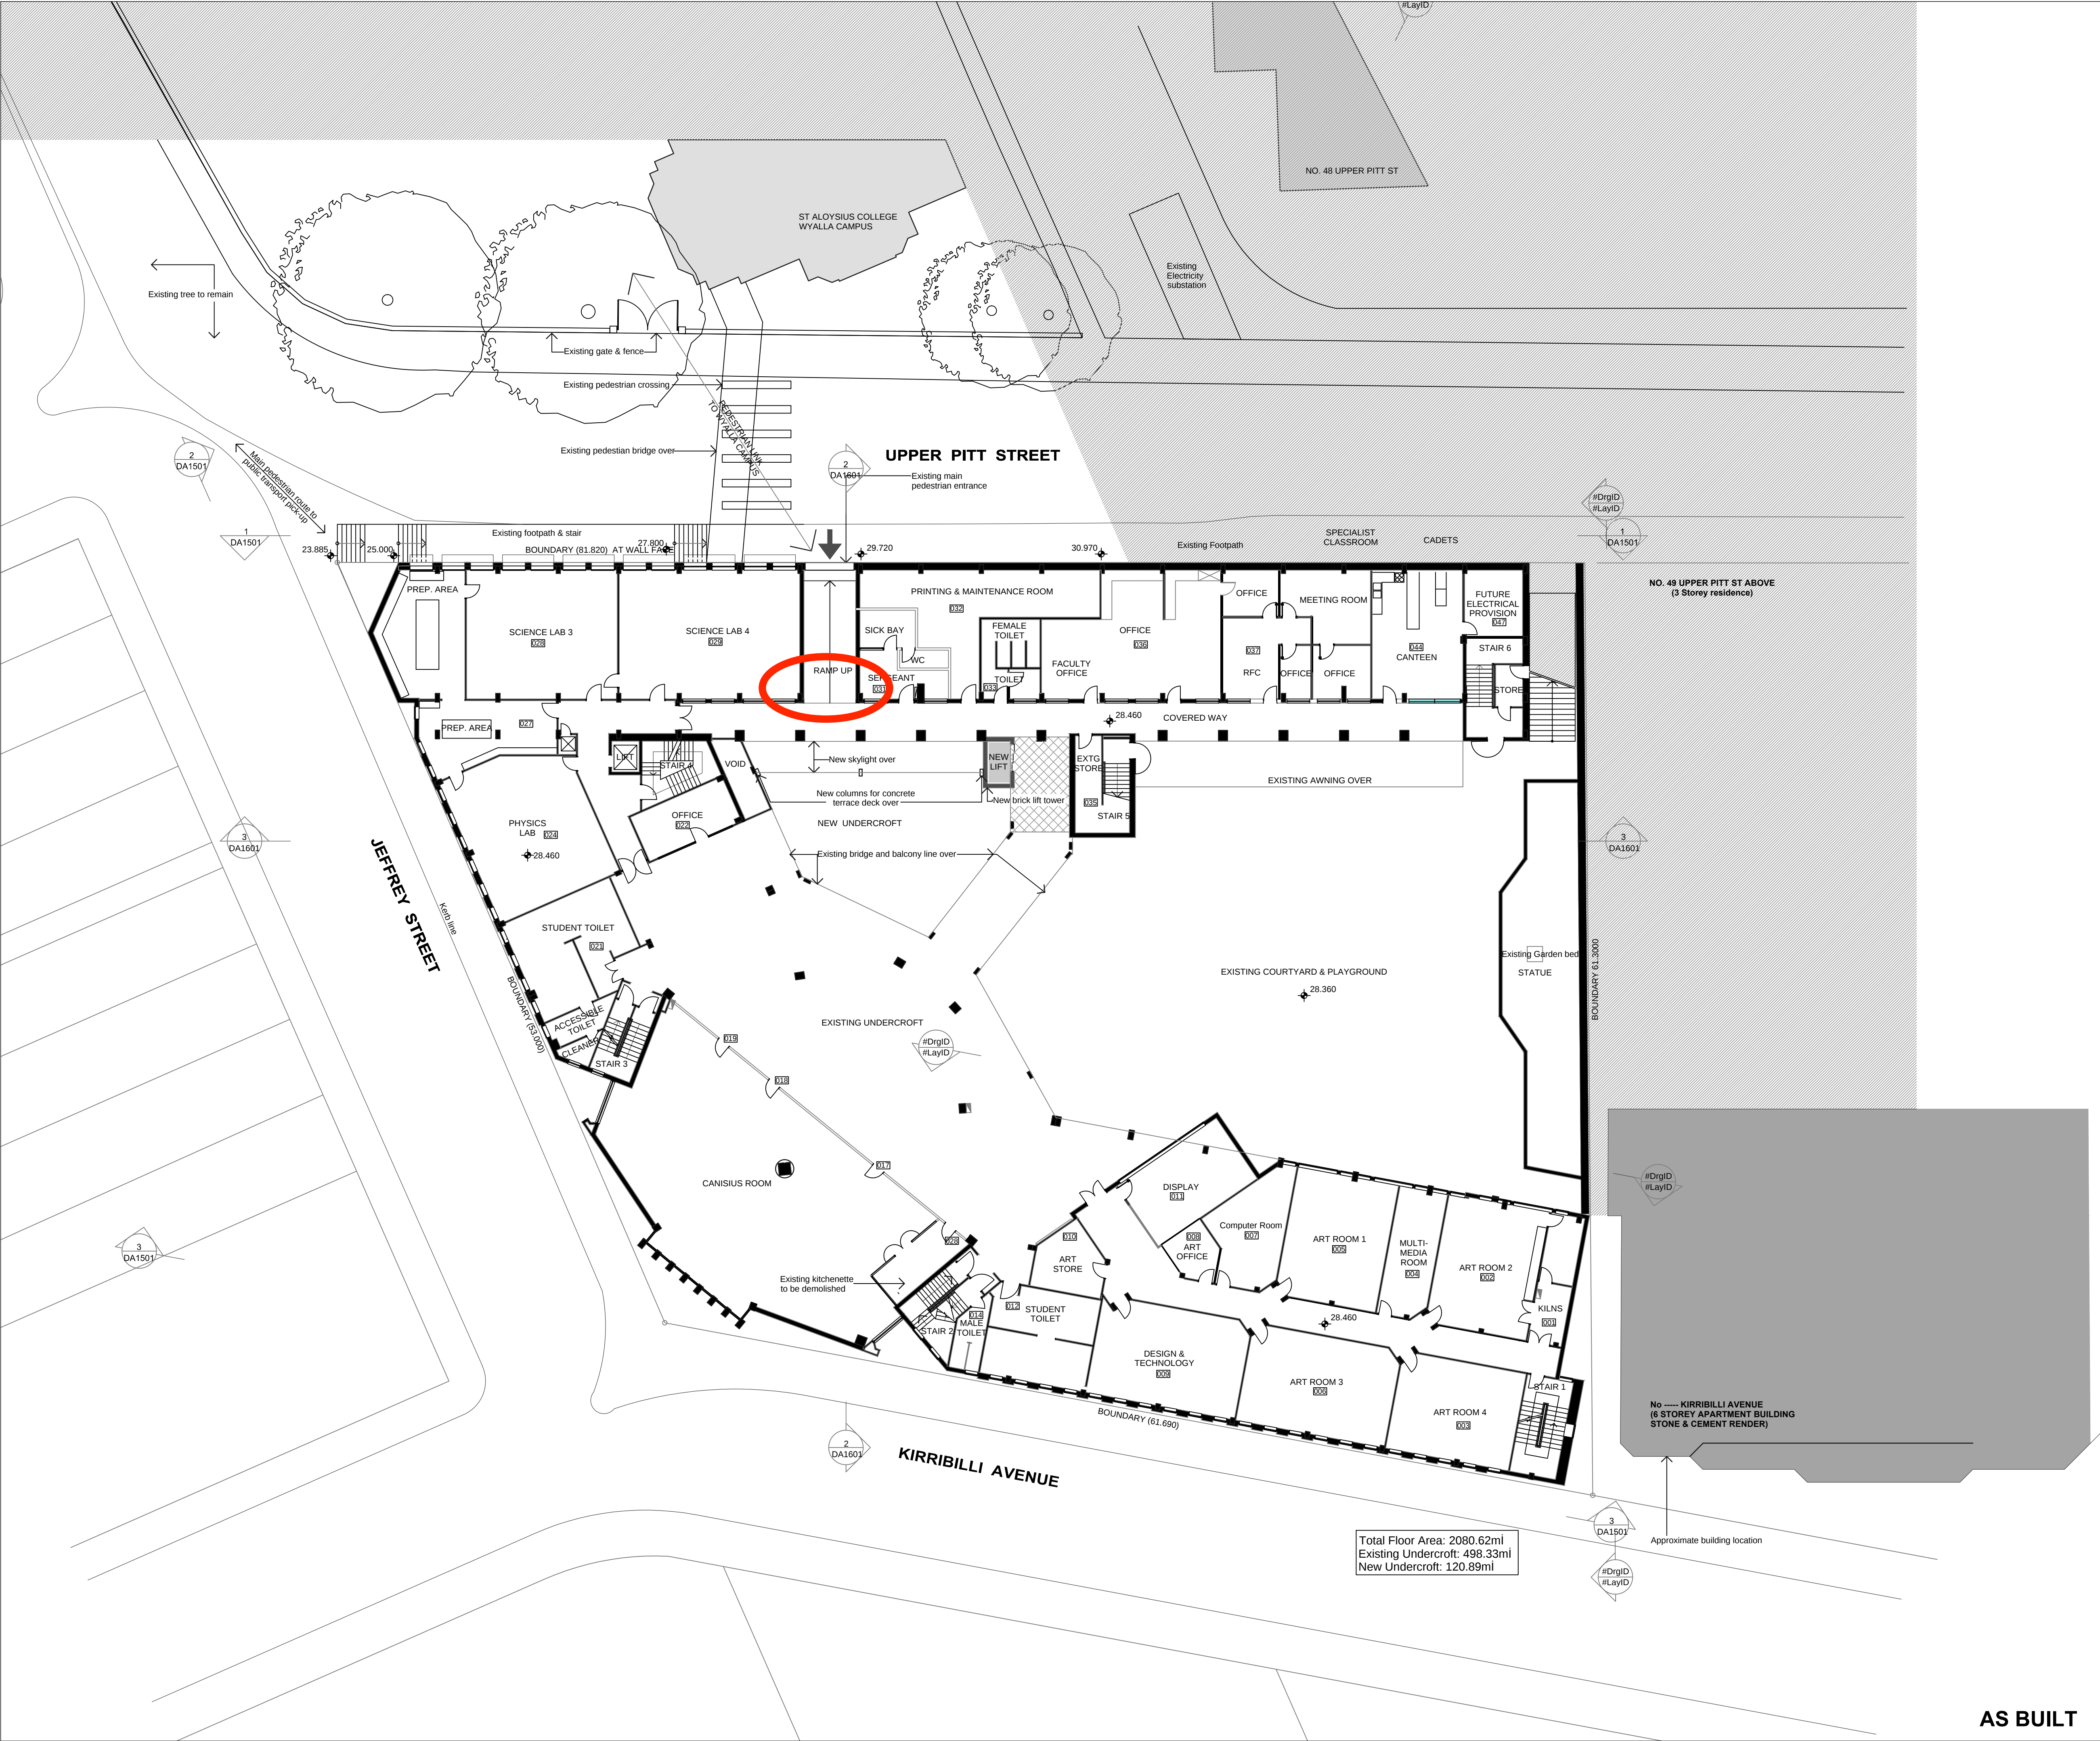

DRAWING KEY

- AREA OF INTERNAL ALTERATIONS AND REFURBISHMENT
- NEW WALLS AND PARTITIONS
- NEW AREA OF FLOOR AND/OR BUILDING ENVELOPE
- NEW GLAZING, SKYLIGHTS AND WINDOWS
- NEW AREA OF TERRACE
- LOCATIONS FOR FUTURE AIR CONDITIONING PLANT
- EXISTING WALLS AND STRUCTURE
- DEMOLISHED WALLS AND STRUCTURE

D	Drawings Upgrade - Areas	15/09/2012	SDS
C	Drawings Upgrade to Site Inspection	11/05/2012	SDS
B	Development Application Resubmission	09/09/2008	GM
A	Development Application Issue	19/12/2007	GM
REVISION	DESCRIPTION	DATE	CHECKED

FACILITIES CONSULTANT: DRAWINGS UPGRADE

AUSTRALIS FACILITIES MANAGEMENT
Unit 7 - 54 Chegwyn Street
Botant NSW 2019
Ph 9695 1925 - Fax 9666 3741



St Aloysius College



Upper Pitt Street
Milson's Point NSW 2061

PROJECT

ST. ALOYSIUS COLLEGE
SENIOR SCHOOL - MAIN CAMPUS
47 Upper Pitt Street
Milsos Point NSW 2061

DRAWING TITLE

General Arrangement Plans
Ground Floor



PROJECT No	DRAWING No	REVISION
06030	DA1201	C
DRAWING SCALE	DRAWN	CHECKED
1:200 @ A1		SDS
DATE	11/05/2012	

ARCHITECT

GARDNER WETHERILL & ASSOCIATES
LEVEL 2
7 MYRTLE STREET
NORTH SYDNEY 2060
T (02) 9929 6777
F (02) 9929 3999
E design@gardnerwetherill.com.au

A.C.N. 104 476 833
Registered Architect - Alistair Ross Gardner (Reg No. 28490)

AS BUILT

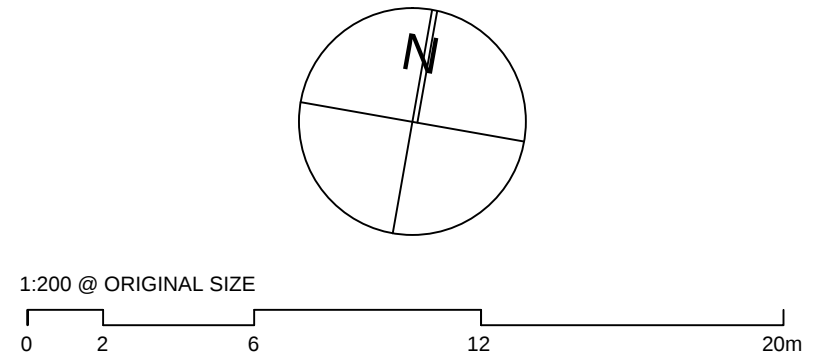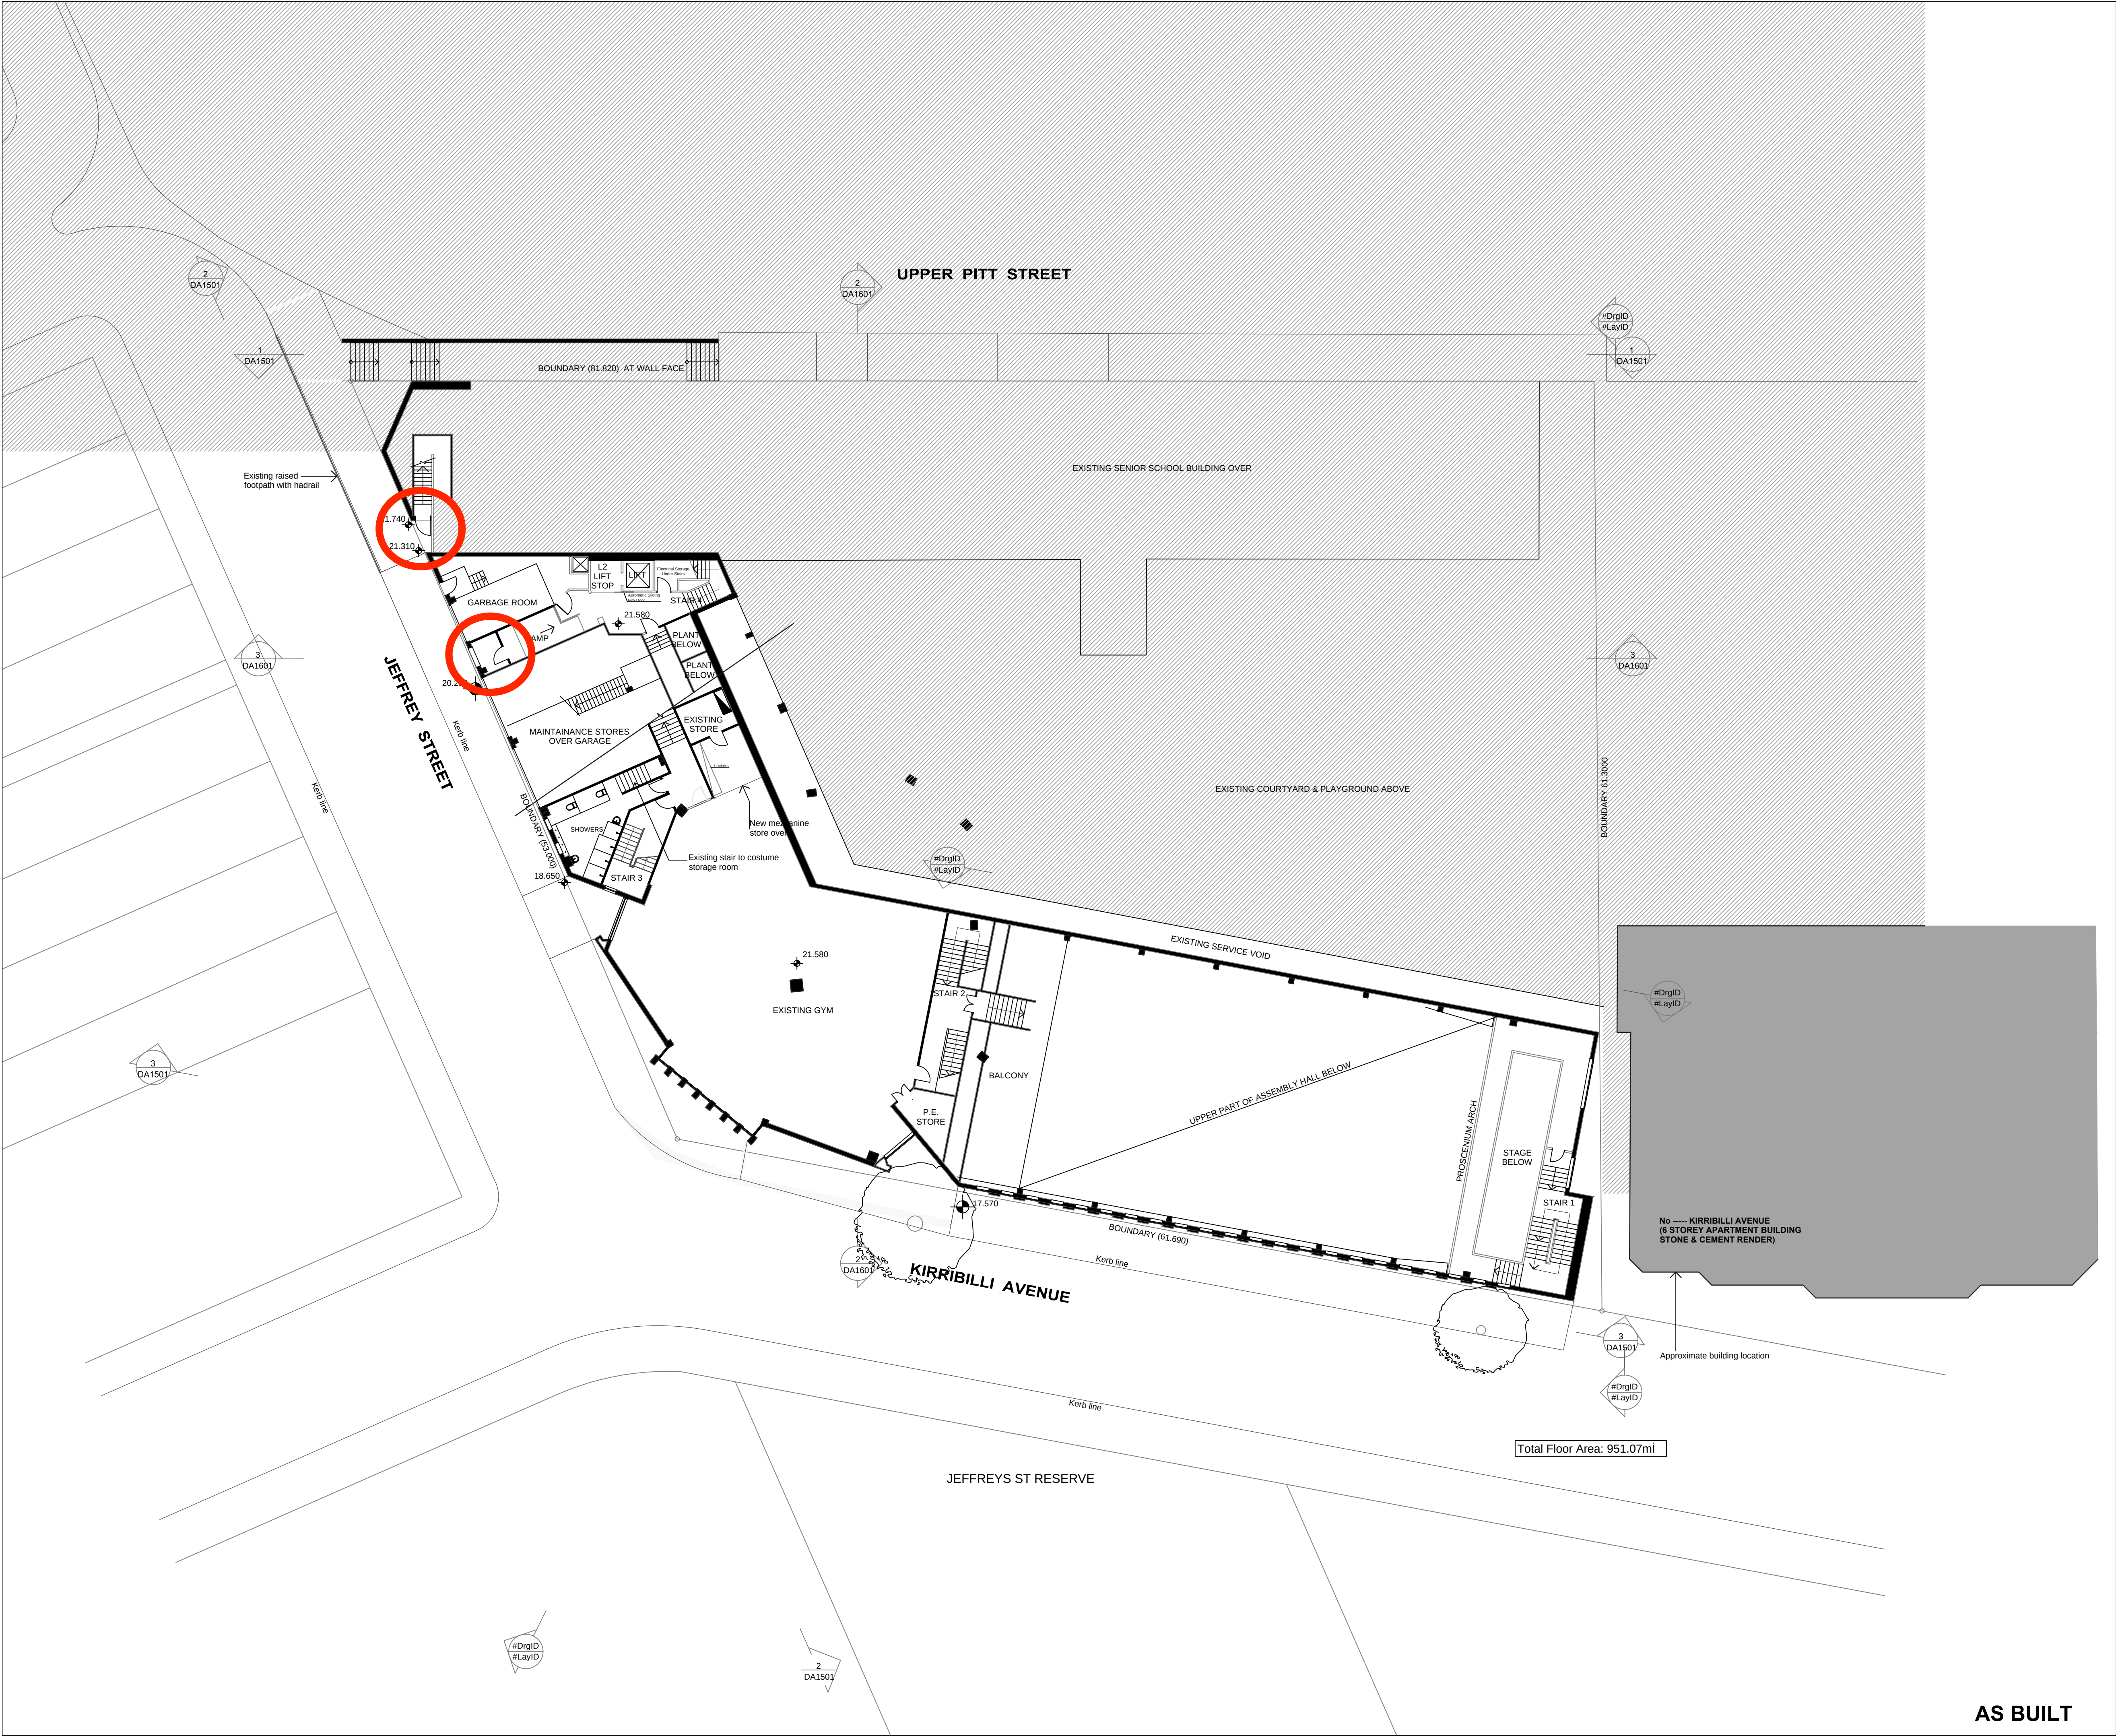

- DRAWING KEY**
- AREA OF INTERNAL ALTERATIONS AND REFURBISHMENT
 - NEW WALLS AND PARTITIONS
 - NEW AREA OF FLOOR AND/OR BUILDING ENVELOPE
 - NEW GLAZING, SKYLIGHTS AND WINDOWS
 - NEW AREA OF TERRACE
 - LOCATIONS FOR FUTURE AIR CONDITIONING PLANT
 - EXISTING WALLS AND STRUCTURE
 - DEMOLISHED WALLS AND STRUCTURE

D	Drawings Upgrade - Areas	15/08/2012	SDS
C	Drawings Upgrade to Site Inspection	11/05/2012	SDS
B	Development Application Resubmission	08/08/2008	GM
A	Development Application Issue	18/12/2007	GM
REVISION	DESCRIPTION	DATE	CHECK

FACILITIES CONSULTANT/DRAWINGS UPGRADE
AUSTRALIS FACILITIES MANAGEMENT
Unit 7 - 54 Chegwyn Street
Botany NSW 2019
Ph 9695 1925 - Fax 9666 3741



St Aloysius College



Upper Pitt Street
Milsom's Point NSW 2061



PROJECT
ST. ALOYSIUS COLLEGE
SENIOR SCHOOL - MAIN CAMPUS
47 Upper Pitt Street
Milsom's Point NSW 2061

DRAWING TITLE
General Arrangement Plans
Lower Ground Floor 2

PROJECT No	DRAWING No	REVISION
06030	DA1102	C
DRAWING SCALE	DRAWN	CHECKED
1:200 @ A3		SDS
DATE	11/05/2012	

ARCHITECT
GARDNER WETHERILL & ASSOCIATE
LEVEL 2
7 MYRTLE STREET
NORTH SYDNEY 2060
T (02) 9929 6777
F (02) 9929 3999
E design@gardnerwetherill.com.au
A.C.N. 104 476 833
Notified Architect - Alistair Ross Gardner (Reg No. 3949)

AS BUILT

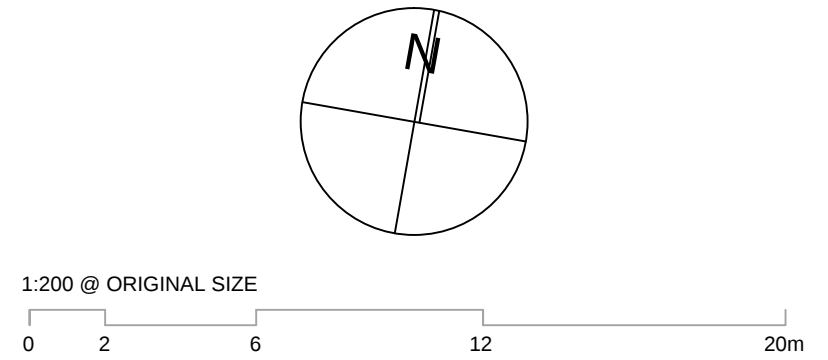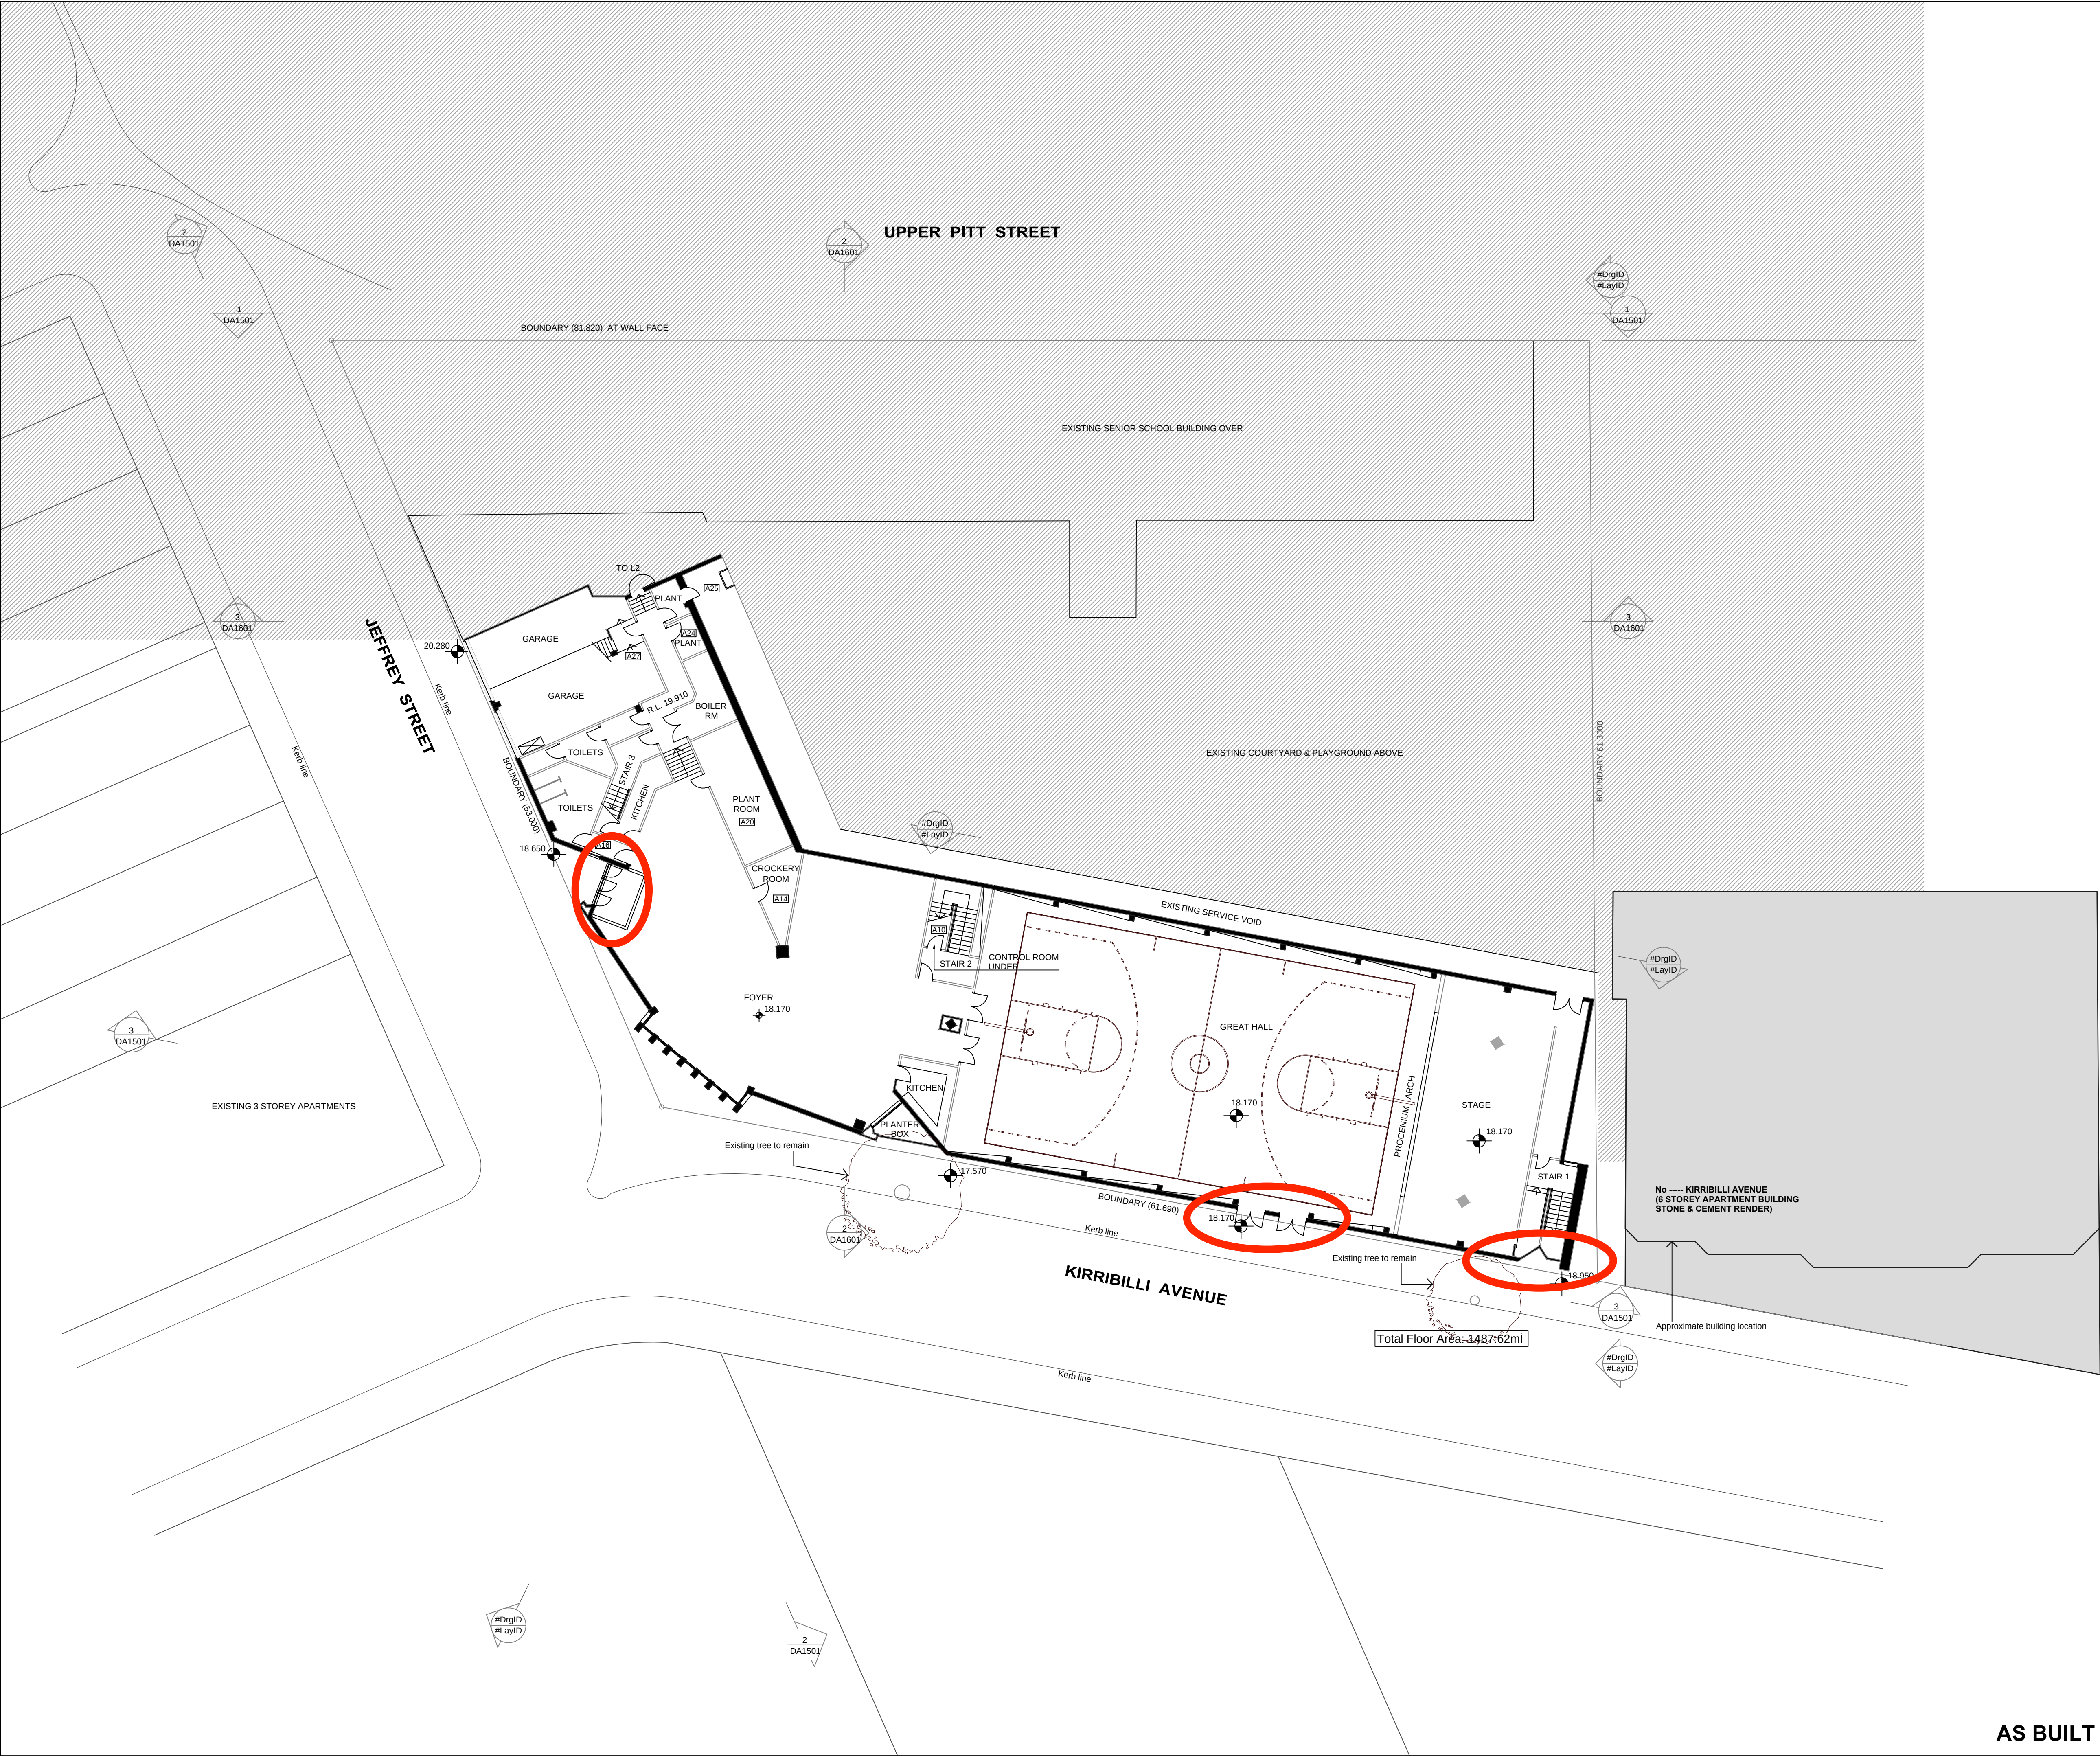

- DRAWING KEY**
- AREA OF INTERNAL ALTERATIONS AND REFURBISHMENT
 - NEW WALLS AND PARTITIONS
 - NEW AREA OF FLOOR AND/OR BUILDING ENVELOPE
 - NEW GLAZING, SKYLIGHTS AND WINDOWS
 - NEW AREA OF TERRACE
 - LOCATIONS FOR FUTURE AIR CONDITIONING PLANT
 - EXISTING WALLS AND STRUCTURE
 - DEMOLISHED WALLS AND STRUCTURE

D	Drawings Upgrade - Areas	15/08/2012	SDS
C	Drawings Upgrade to Site Inspection	11/05/2012	SDS
B	Development Application Resubmission	08/08/2008	GM
A	Development Application Issue	18/12/2007	GM
REVISION	DESCRIPTION	DATE	CHECKED

FACILITIES CONSULTANT/DRAWINGS UPGRADE
AUSTRALIS FACILITIES MANAGEMENT
Unit 7 - 54 Cherylyn Street
Botany NSW 2019
Ph 9695 1925 - Fax 9666 3741



St Aloysius College



Upper Pitt Street
Milsons Point NSW 2061

PROJECT
ST. ALOYSIUS COLLEGE
SENIOR SCHOOL - MAIN CAMPUS
47 Upper Pitt Street
Milsons Point NSW 2061



DRAWING TITLE
General Arrangement Plans
Lower Ground Floor 3

PROJECT No	DRAWING No	REVISION
06030	DA1101	C
DRAWING SCALE	DRAWN	CHECKED
1:200 @ A1	SDS	SDS
DATE	11/05/2012	

ARCHITECT
GARDNER WETHERILL & ASSOCIATE
LEVEL 2
7 MYRTLE STREET
NORTH SYDNEY 2060
T (02) 9929 6777
F (02) 9929 3999
E design@gardnerwetherill.com.au

A.C.N. 104 476 833
Notarized Architect - Alistair Ross Gardner (Reg No. 3849)

AS BUILT

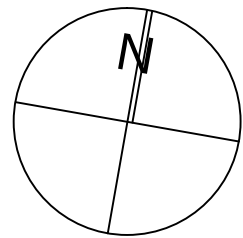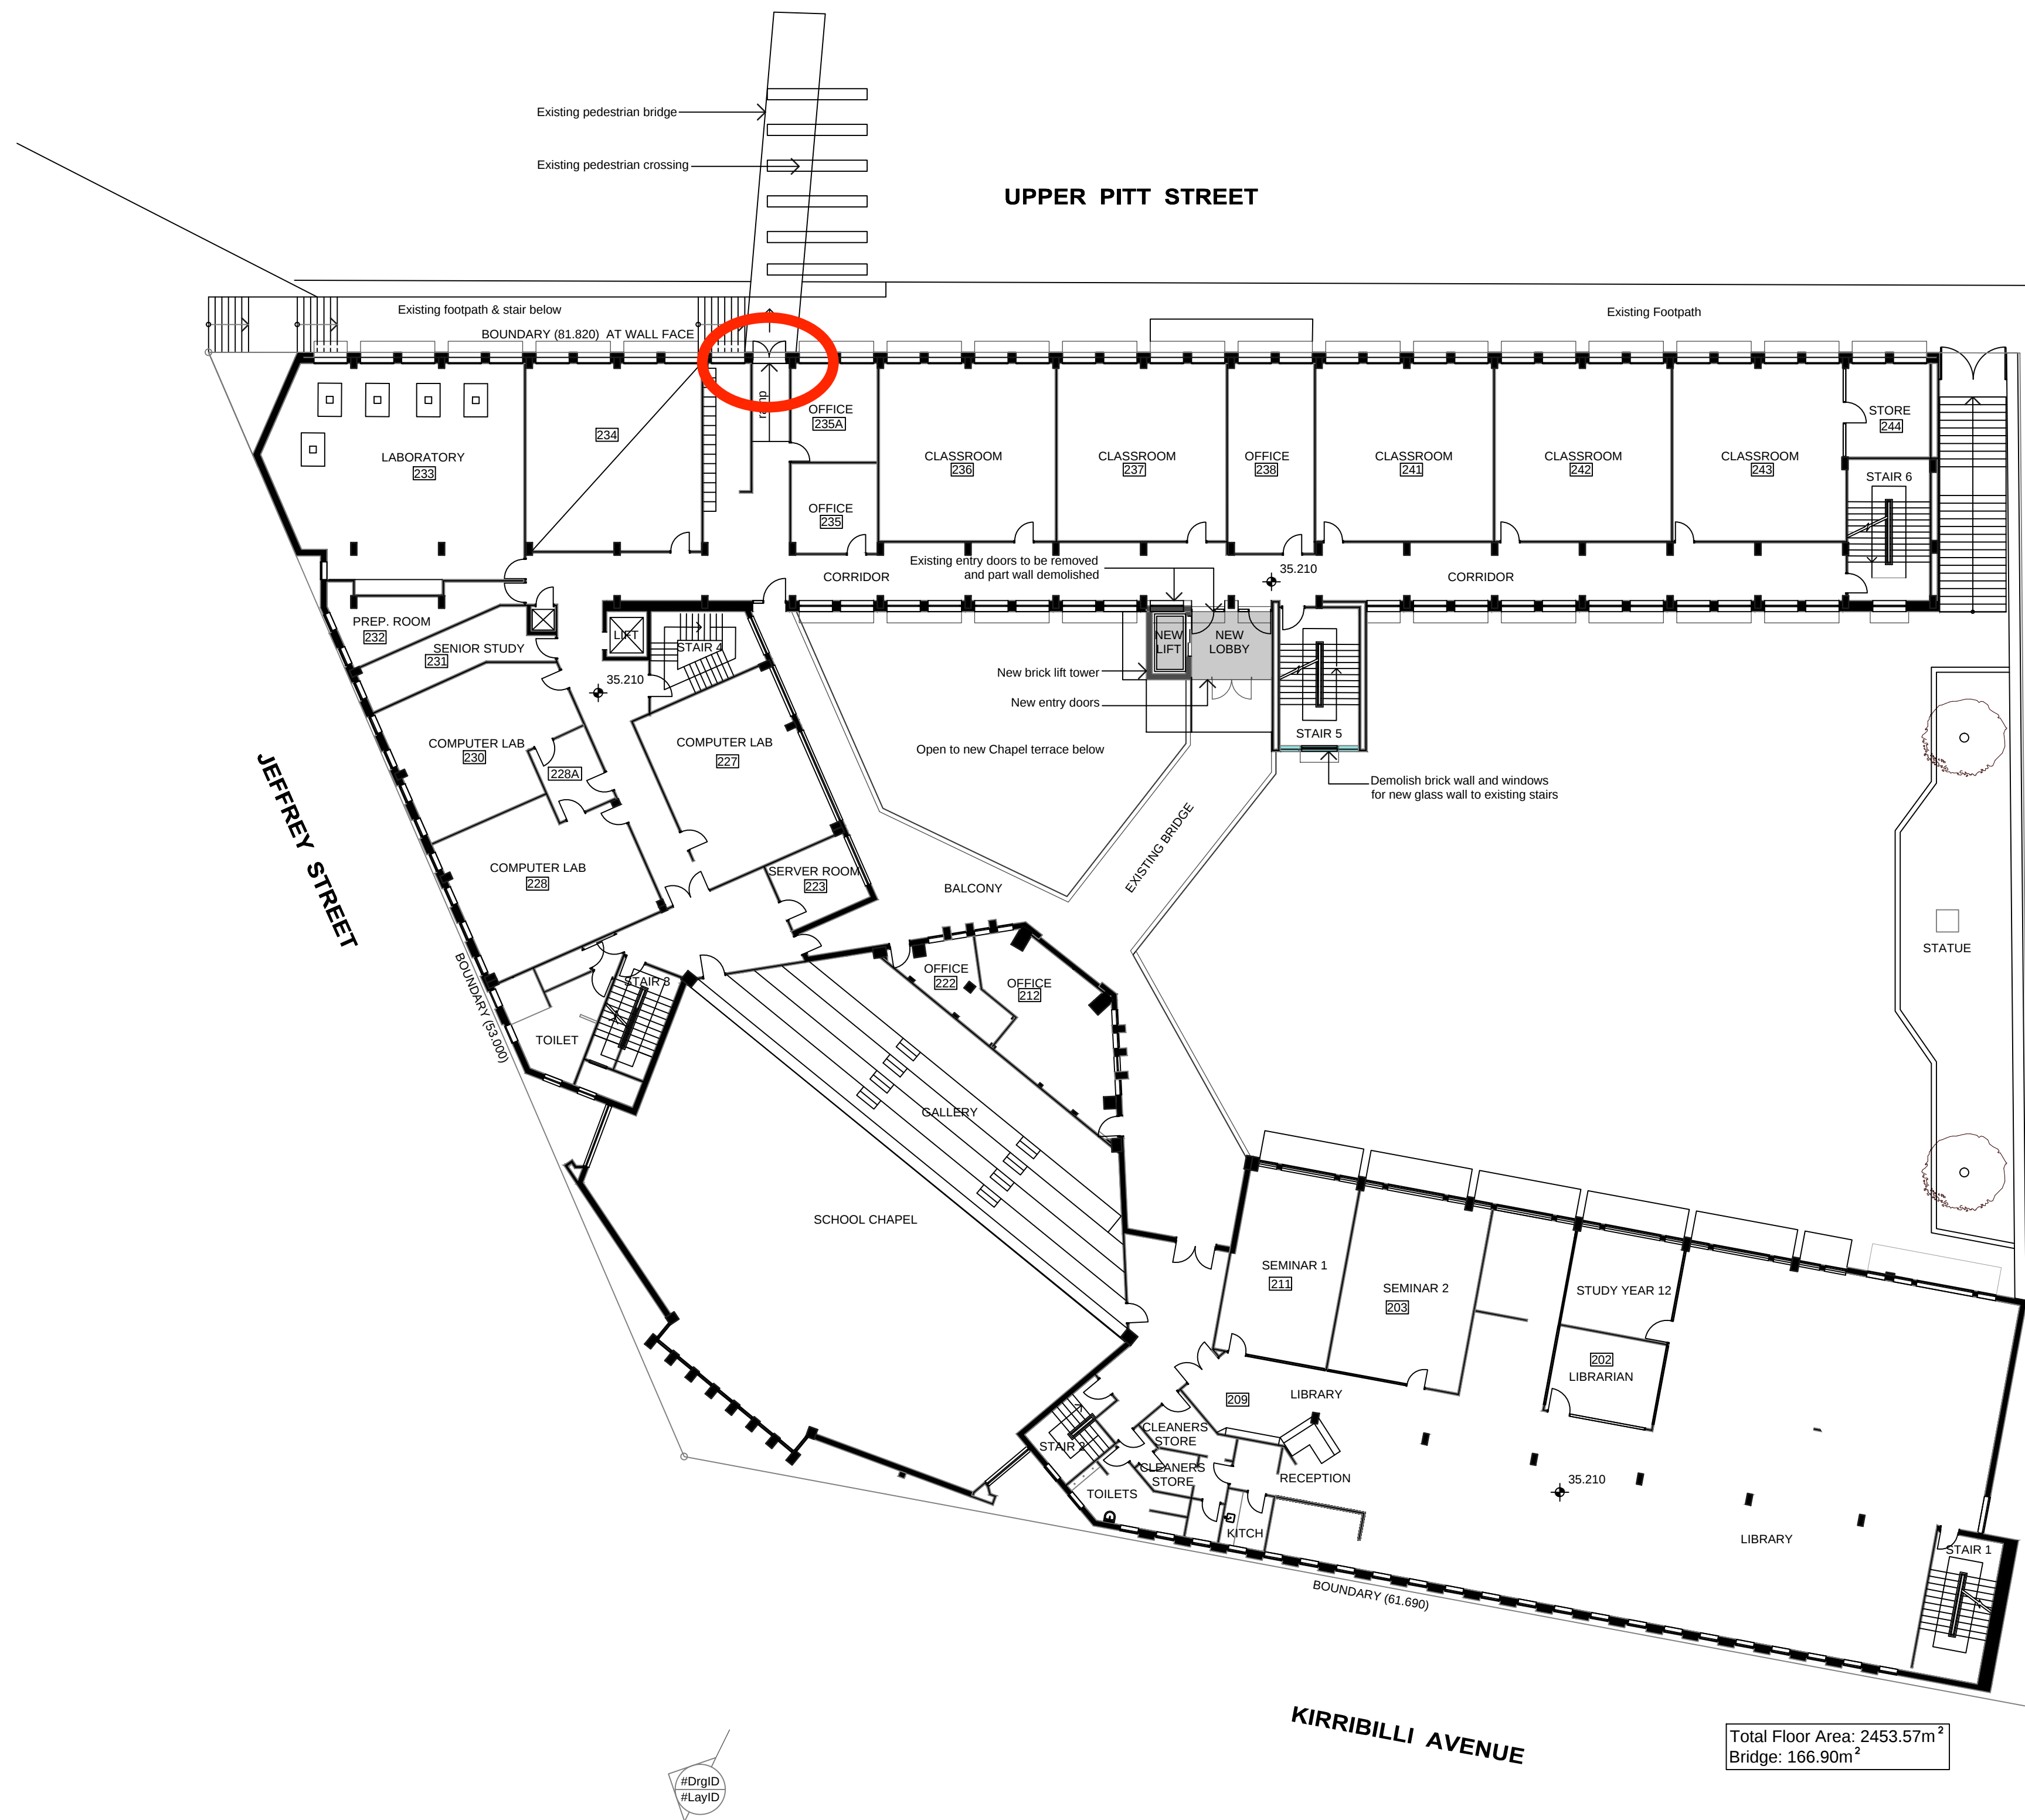

1:200 @ ORIGINAL SIZE
0 2 6 12 20m

DRAWING KEY

AREA OF INTERNAL ALTERATIONS AND REFURBISHMENT

NEW WALLS AND PARTITIONS

NEW AREA OF FLOOR AND/OR BUILDING ENVELOPE

NEW GLAZING, SKYLIGHTS AND WINDOWS

NEW AREA OF TERRACE

LOCATIONS FOR FUTURE AIR CONDITIONING PLANT

EXISTING WALLS AND STRUCTURE

DEMOLISHED WALLS AND STRUCTURE

D	Drawings Upgrade - Areas	15/08/2012	SDS
C	Drawings Upgrade to Site Inspection	14/05/2012	SDS
B	Development Application Resubmission	08/09/2008	GM
A	Development Application Issue	19/12/2007	GM
REVISION	DESCRIPTION	DATE	CHECKED

FACILITIES CONSULTANT/ DRAWINGS UPGRADE

AUSTRALIS FACILITIES MANAGEMENT
Unit 7 - 54 Cherylyn Street
Botant NSW 2019
Ph 9695 1925 - Fax 9666 3741



St Aloysius College



Upper Pitt Street
Milsons Point NSW 2061

PROJECT

ST. ALOYSIUS COLLEGE
SENIOR SCHOOL - MAIN CAMPUS
47 Upper Pitt Street
Milsons Point NSW 2061

DRAWING TITLE

General Arrangement Plans
Second Floor

PROJECT No	DRAWING No	REVISION
06030	DA1302	C
DRAWING SCALE	DRAWN	CHECKED
1:200 @ A1		SDS
DATE		14/05/2012

ARCHITECT


GARDNER WETHERILL & ASSOCIATE

LEVEL 2
7 MYRTLE STREET
NORTH SYDNEY 2060

T (02) 9929 6777
F (02) 9929 3999
E design@gardnerwetherill.com.au

A.C.N. 104 476 833
Nominated Architect - Alistair Ross Gardner (Reg No. 3849)

AS BUILT

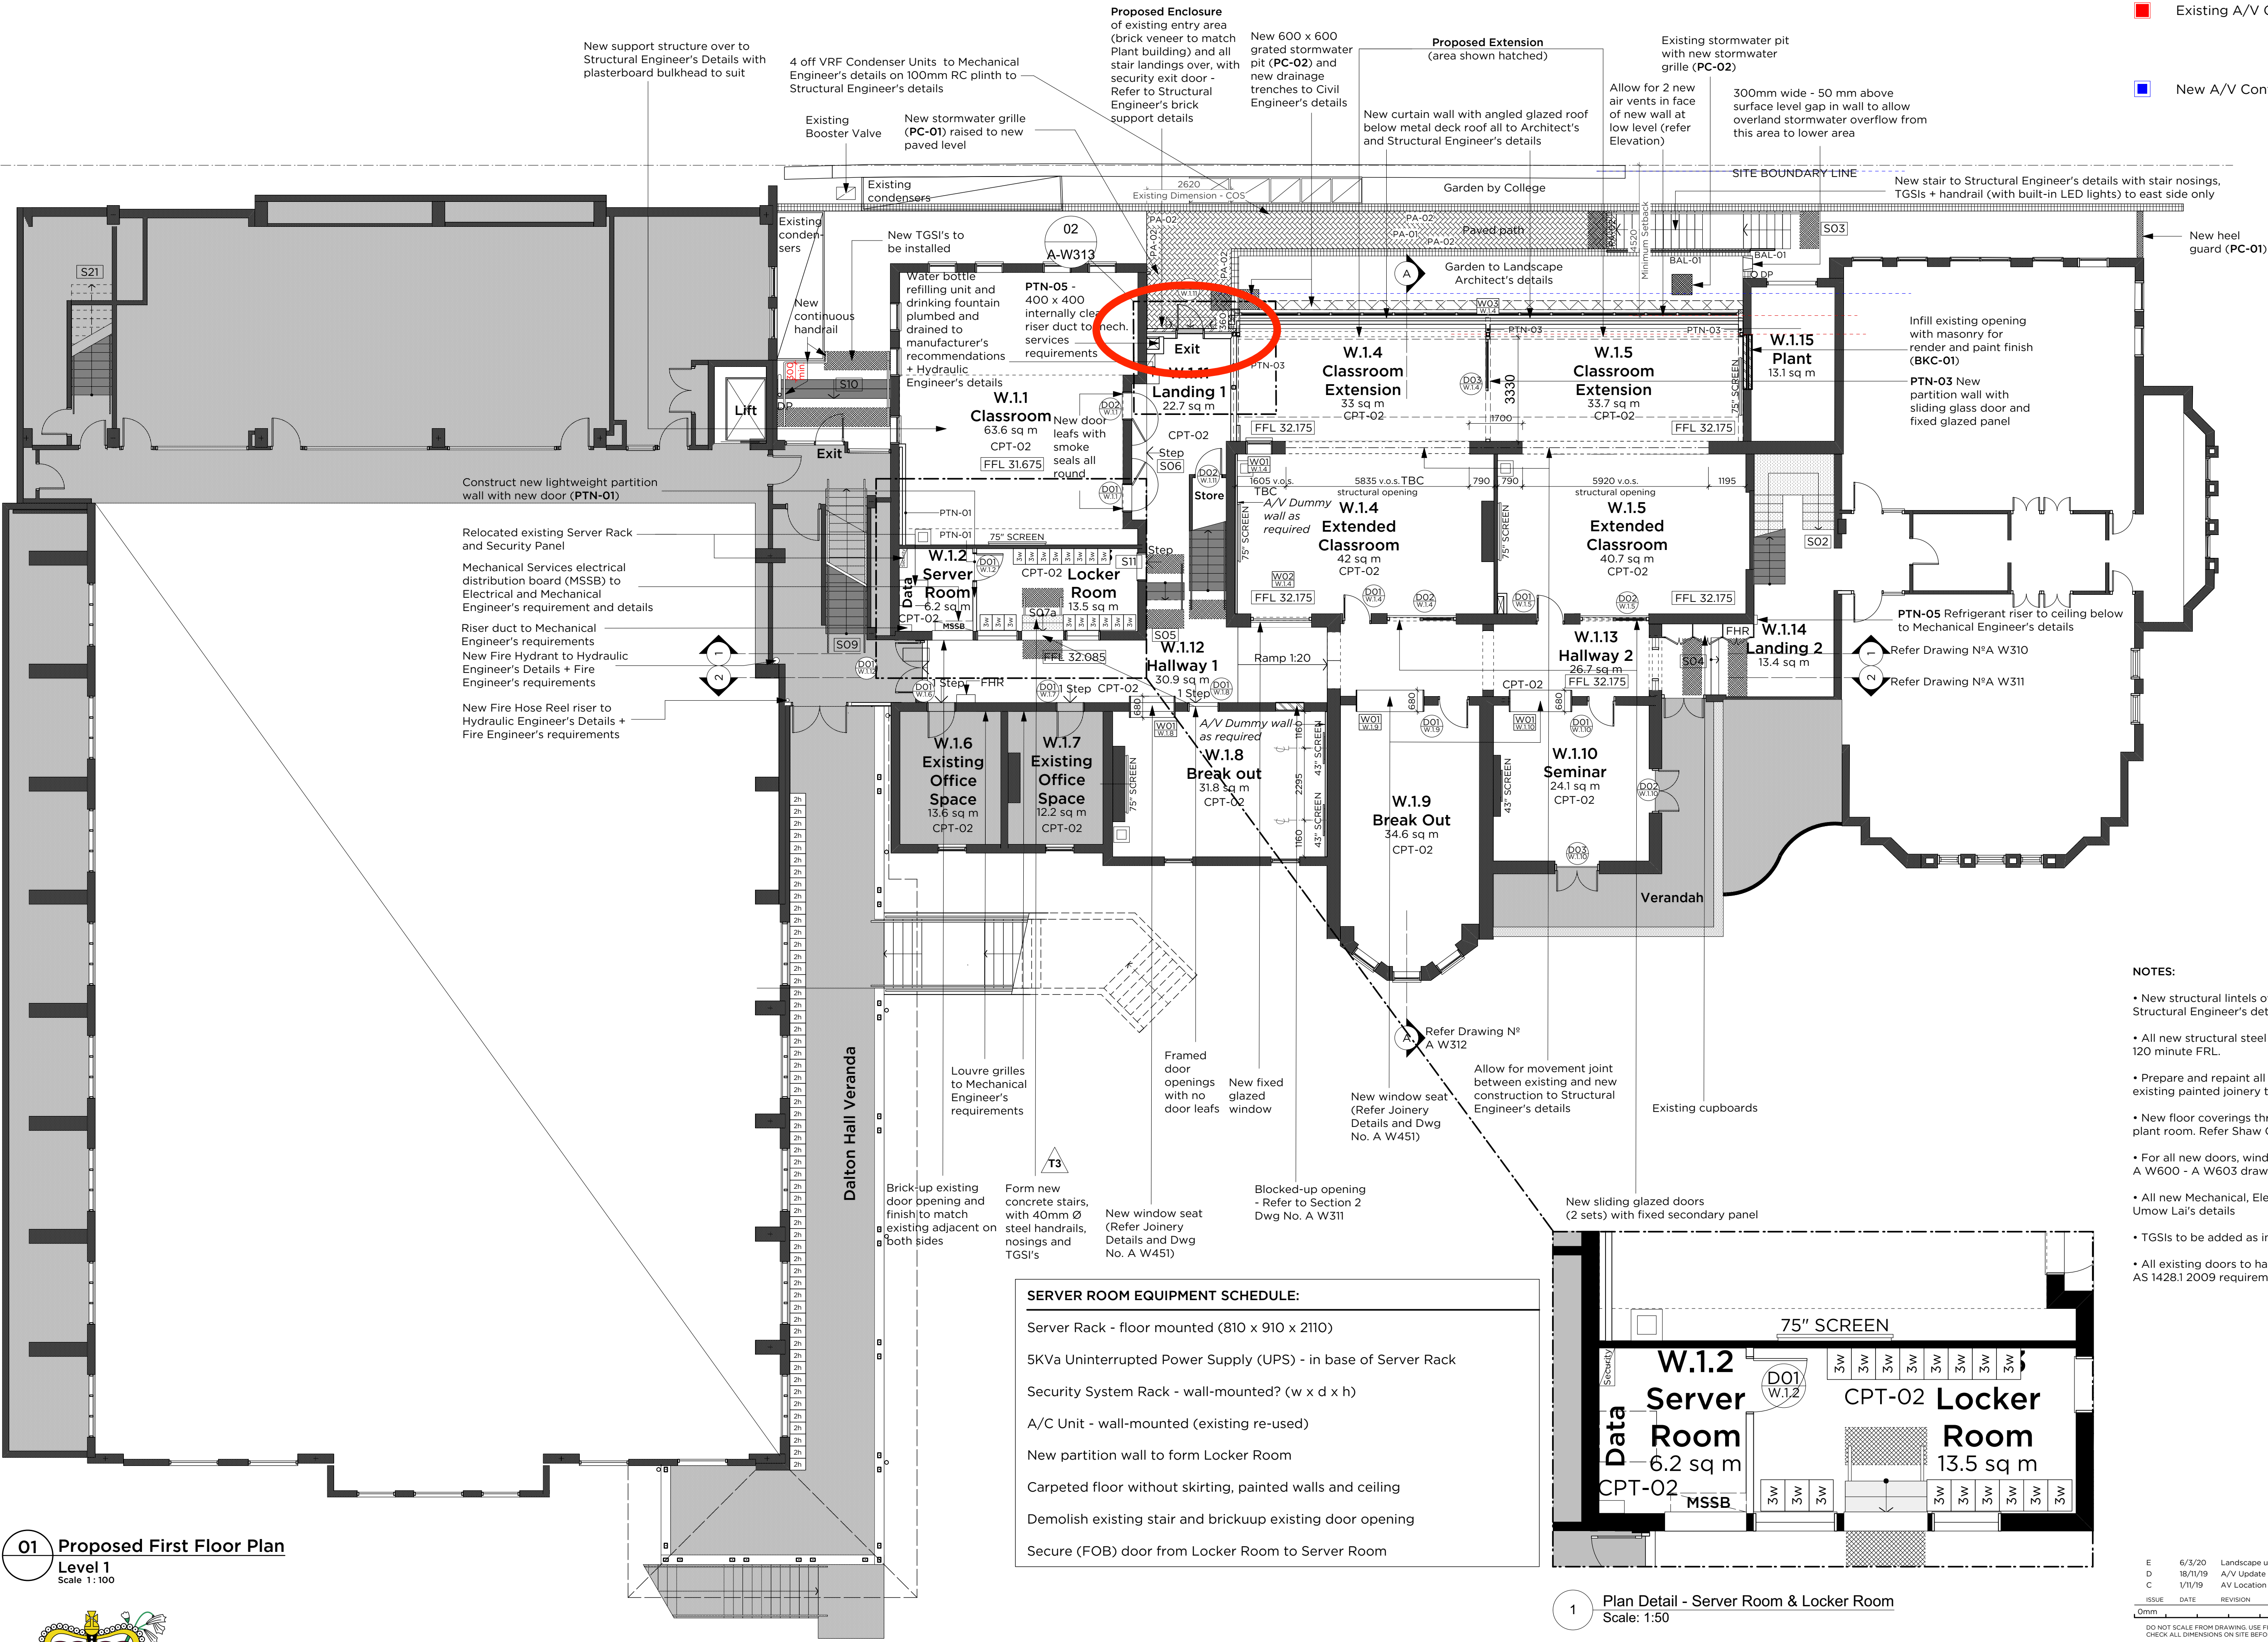


NOTES:

- New structural lintels over all new openings to Structural Engineer's details.
- All new structural steel to be fire protected to achieve 120 minute FRL.
- Prepare and repaint all interior faces of walls, doors and existing painted joinery throughout unshaded area.
- New floor coverings throughout unshaded area, except plant room. Refer Shaw Contract's details.
- For all new doors, windows and window seats, refer to A W600 - A W603 drawings.
- All new Mechanical, Electrical and Hydraulic services to Umow Lai's details
- TGSIs to be added as indicated
- All existing doors to have door hardware upgraded to AS 1428.1 2009 requirements


SERVER ROOM EQUIPMENT SCHEDULE:

- Server Rack - floor mounted (810 x 910 x 2110)
- 5KVa Uninterrupted Power Supply (UPS) - in base of Server Rack
- Security System Rack - wall-mounted? (w x d x h)
- A/C Unit - wall-mounted (existing re-used)
- New partition wall to form Locker Room
- Carpeted floor without skirting, painted walls and ceiling
- Demolish existing stair and brickup existing door opening
- Secure (FOB) door from Locker Room to Server Room

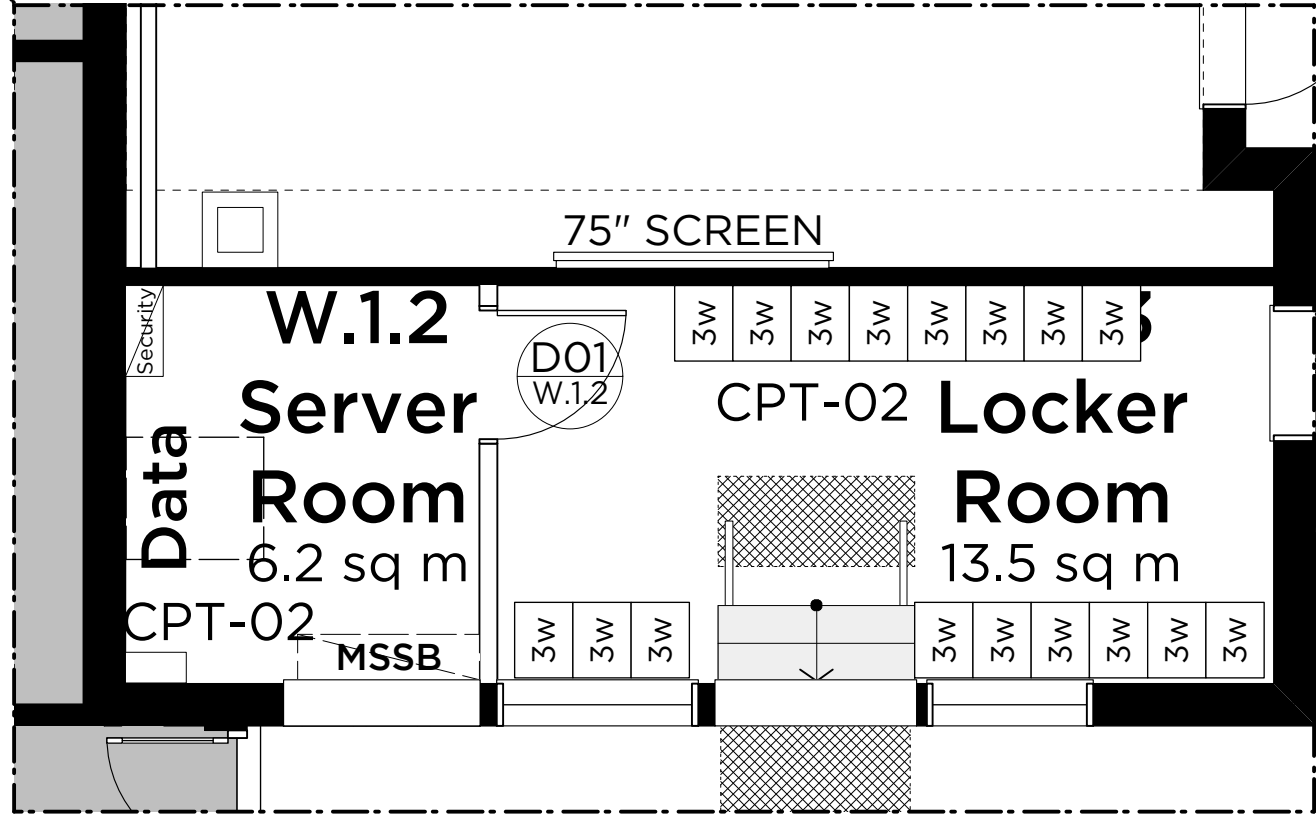

01 Proposed First Floor Plan
Level 1
Scale 1:100

1 Plan Detail - Server Room & Locker Room
Scale: 1:50

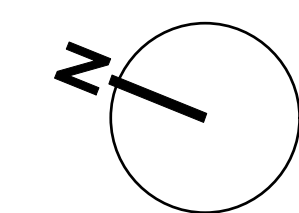

PMDL ARCHITECTURE
INTERIORS
MASTERPLANNING


pmdl.com.au

PMDL ARCHITECTURE + DESIGN PTY LTD ABN 56 002 861 337
NSW NOMINATED ARCHITECTS: ANDREW PENDER 537 DAVID MORRIS 5865 VICKI VAN DIJK 9476

E	6/5/20	Landscape updated	PROJECT #	2622
D	18/11/19	A/V Update	DWG #	
C	1/11/19	A/V Location and Support Walls updated		
ISSUE	DATE	REVISION		
0mm		50mm	100mm	
DO NOT SCALE FROM DRAWING. USE FIGURED DIMENSIONS ONLY. CHECK ALL DIMENSIONS ON SITE BEFORE MANUFACTURE OR CONSTRUCTION.				
PROJECT	Phase 1 - Wyalla & Dalton		PROJECT #	2622
CLIENT	St Aloysius' College		DWG #	
DWG	Level 1 Plan			
CLIENT REF & CONTACT	DATE	SEP 2019	DRAWN	NZ
46 PITT ST, KIRKILL, 2061	SCALE	1:100 @ A1	CHWD	TW
				E




AS BUILT

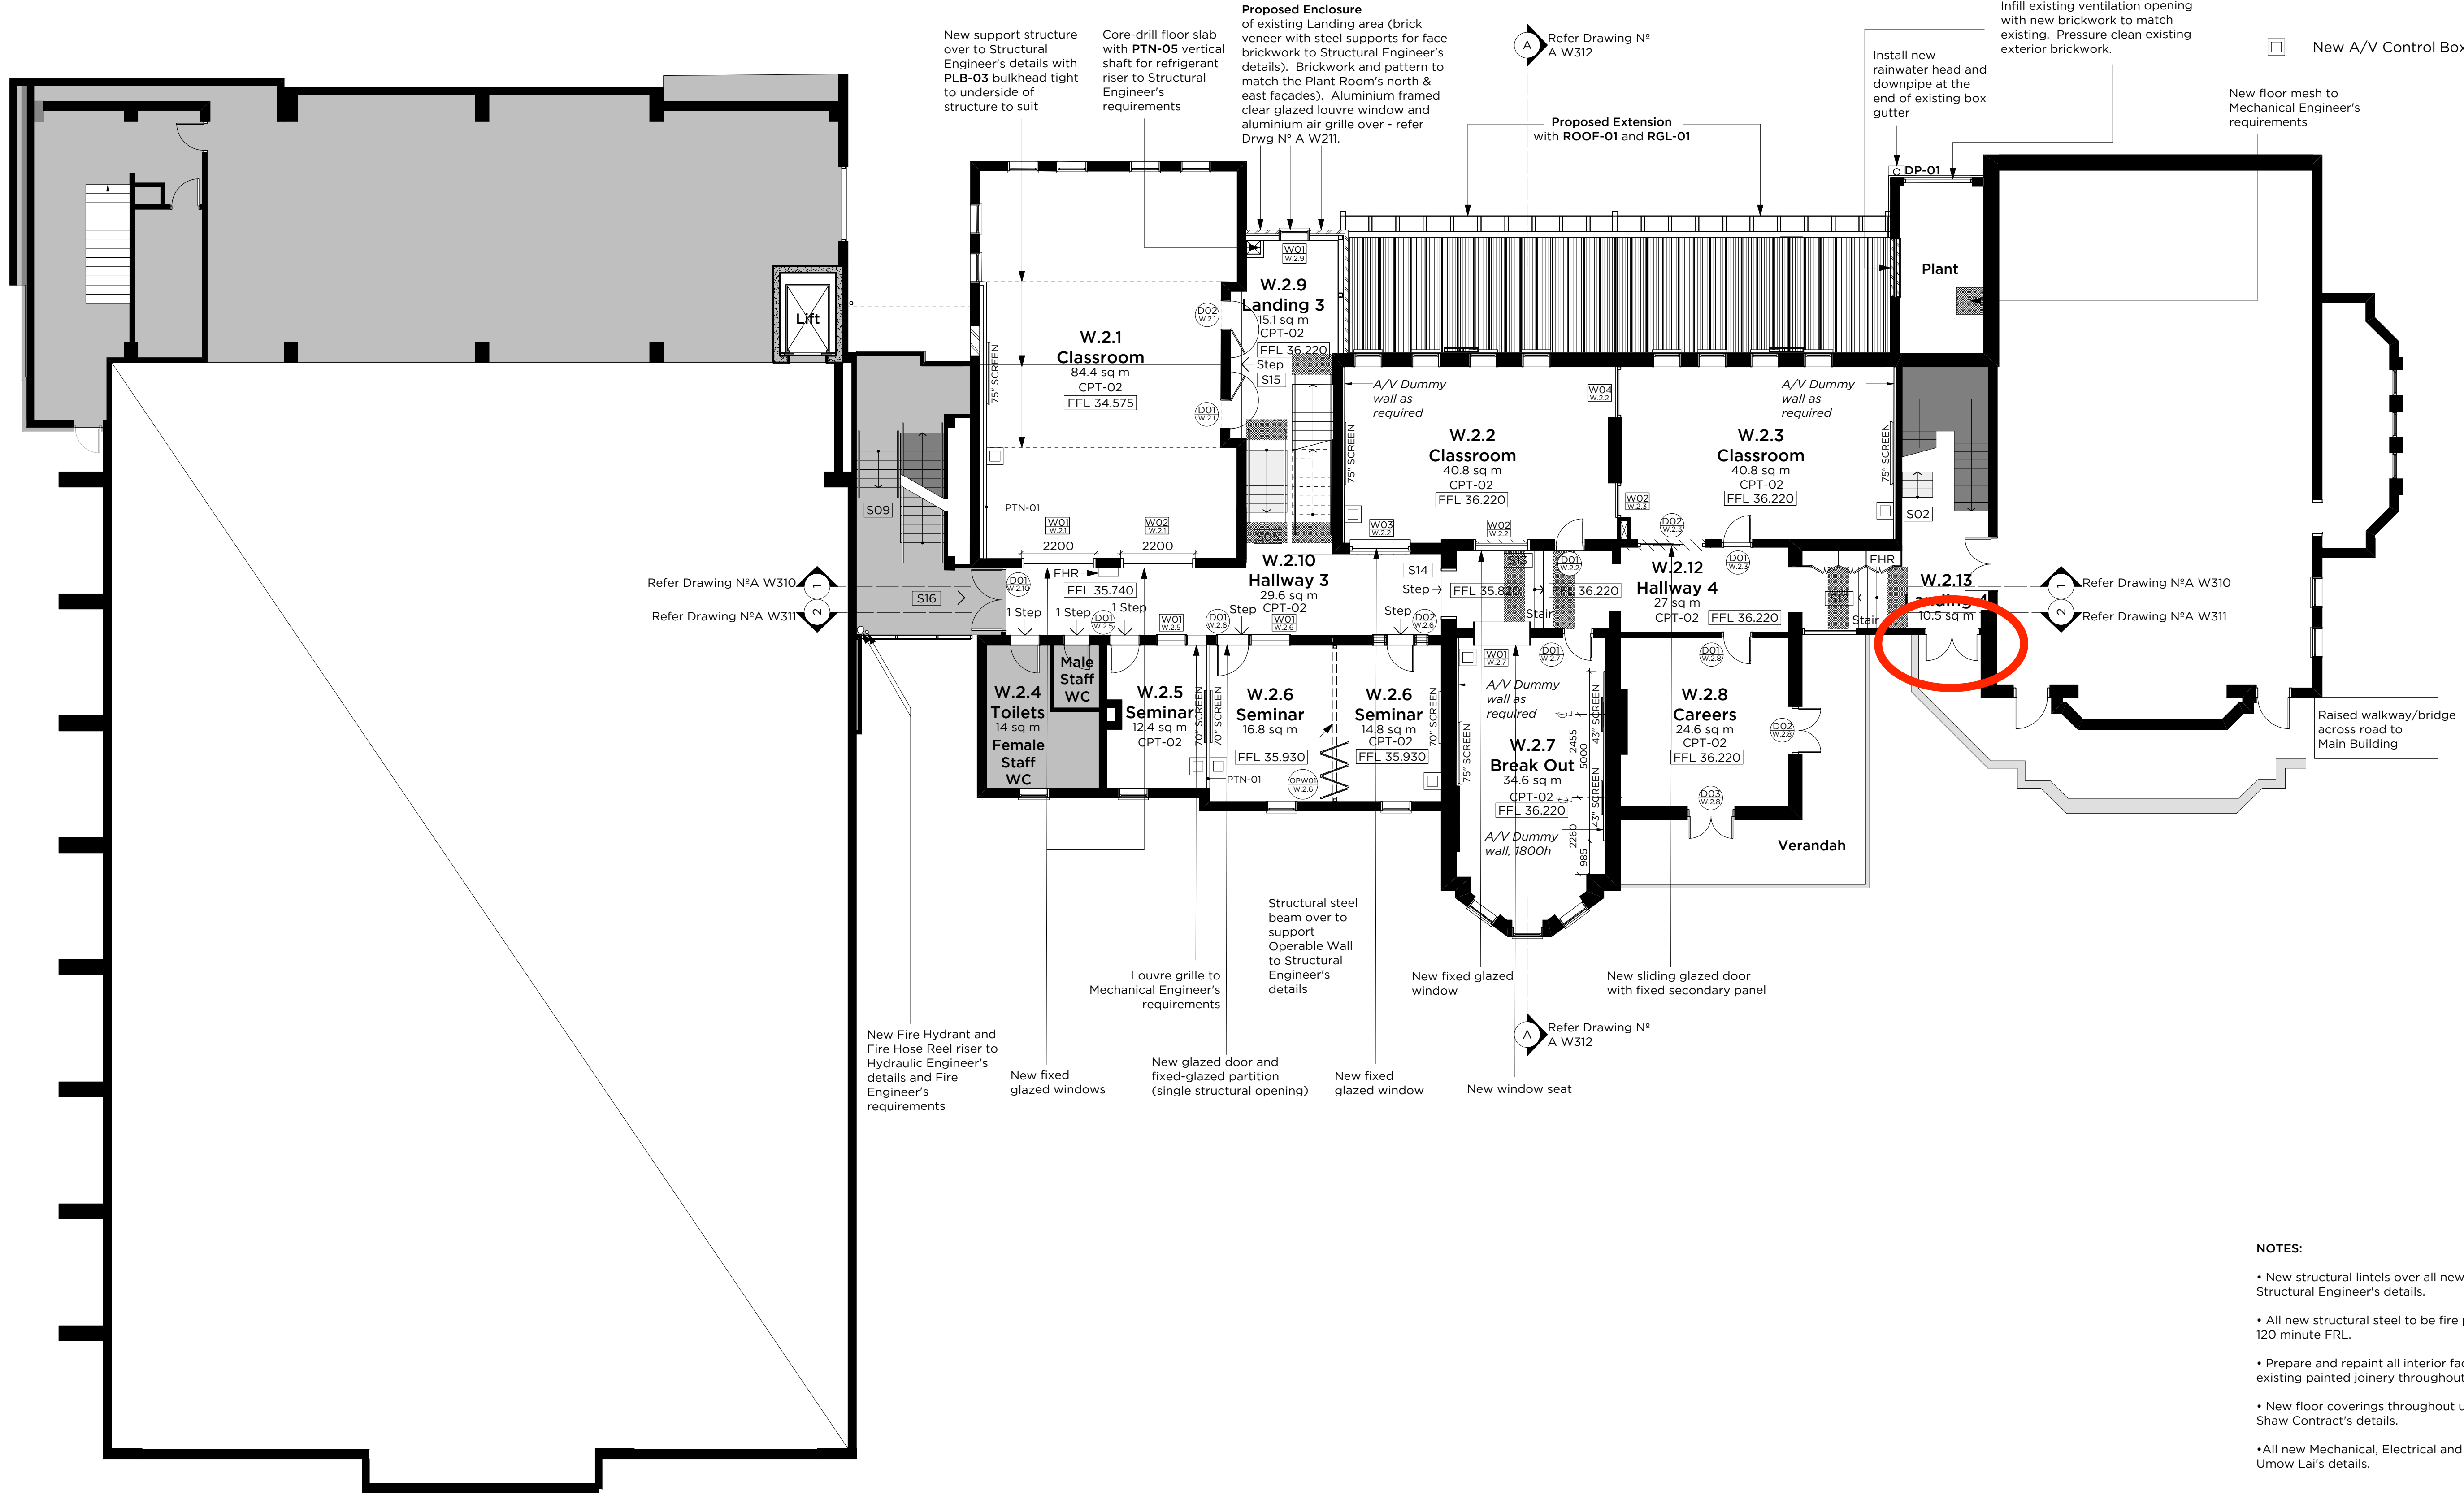

- NOTES:
- New structural lintels over all new openings to Structural Engineer's details.
 - All new structural steel to be fire protected to achieve 120 minute FRL.
 - Prepare and repaint all interior faces of walls, doors and existing painted joinery throughout unshaded area.
 - New floor coverings throughout unshaded area. Refer Shaw Contract's details.
 - All new Mechanical, Electrical and Hydraulic services to Umow Lai's details.

01 Proposed Second Floor Plan
Level 2
Scale 1: 100


AS BUILT

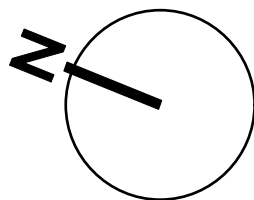

KEY

Existing A/V Control Box to remain

New A/V Control Box

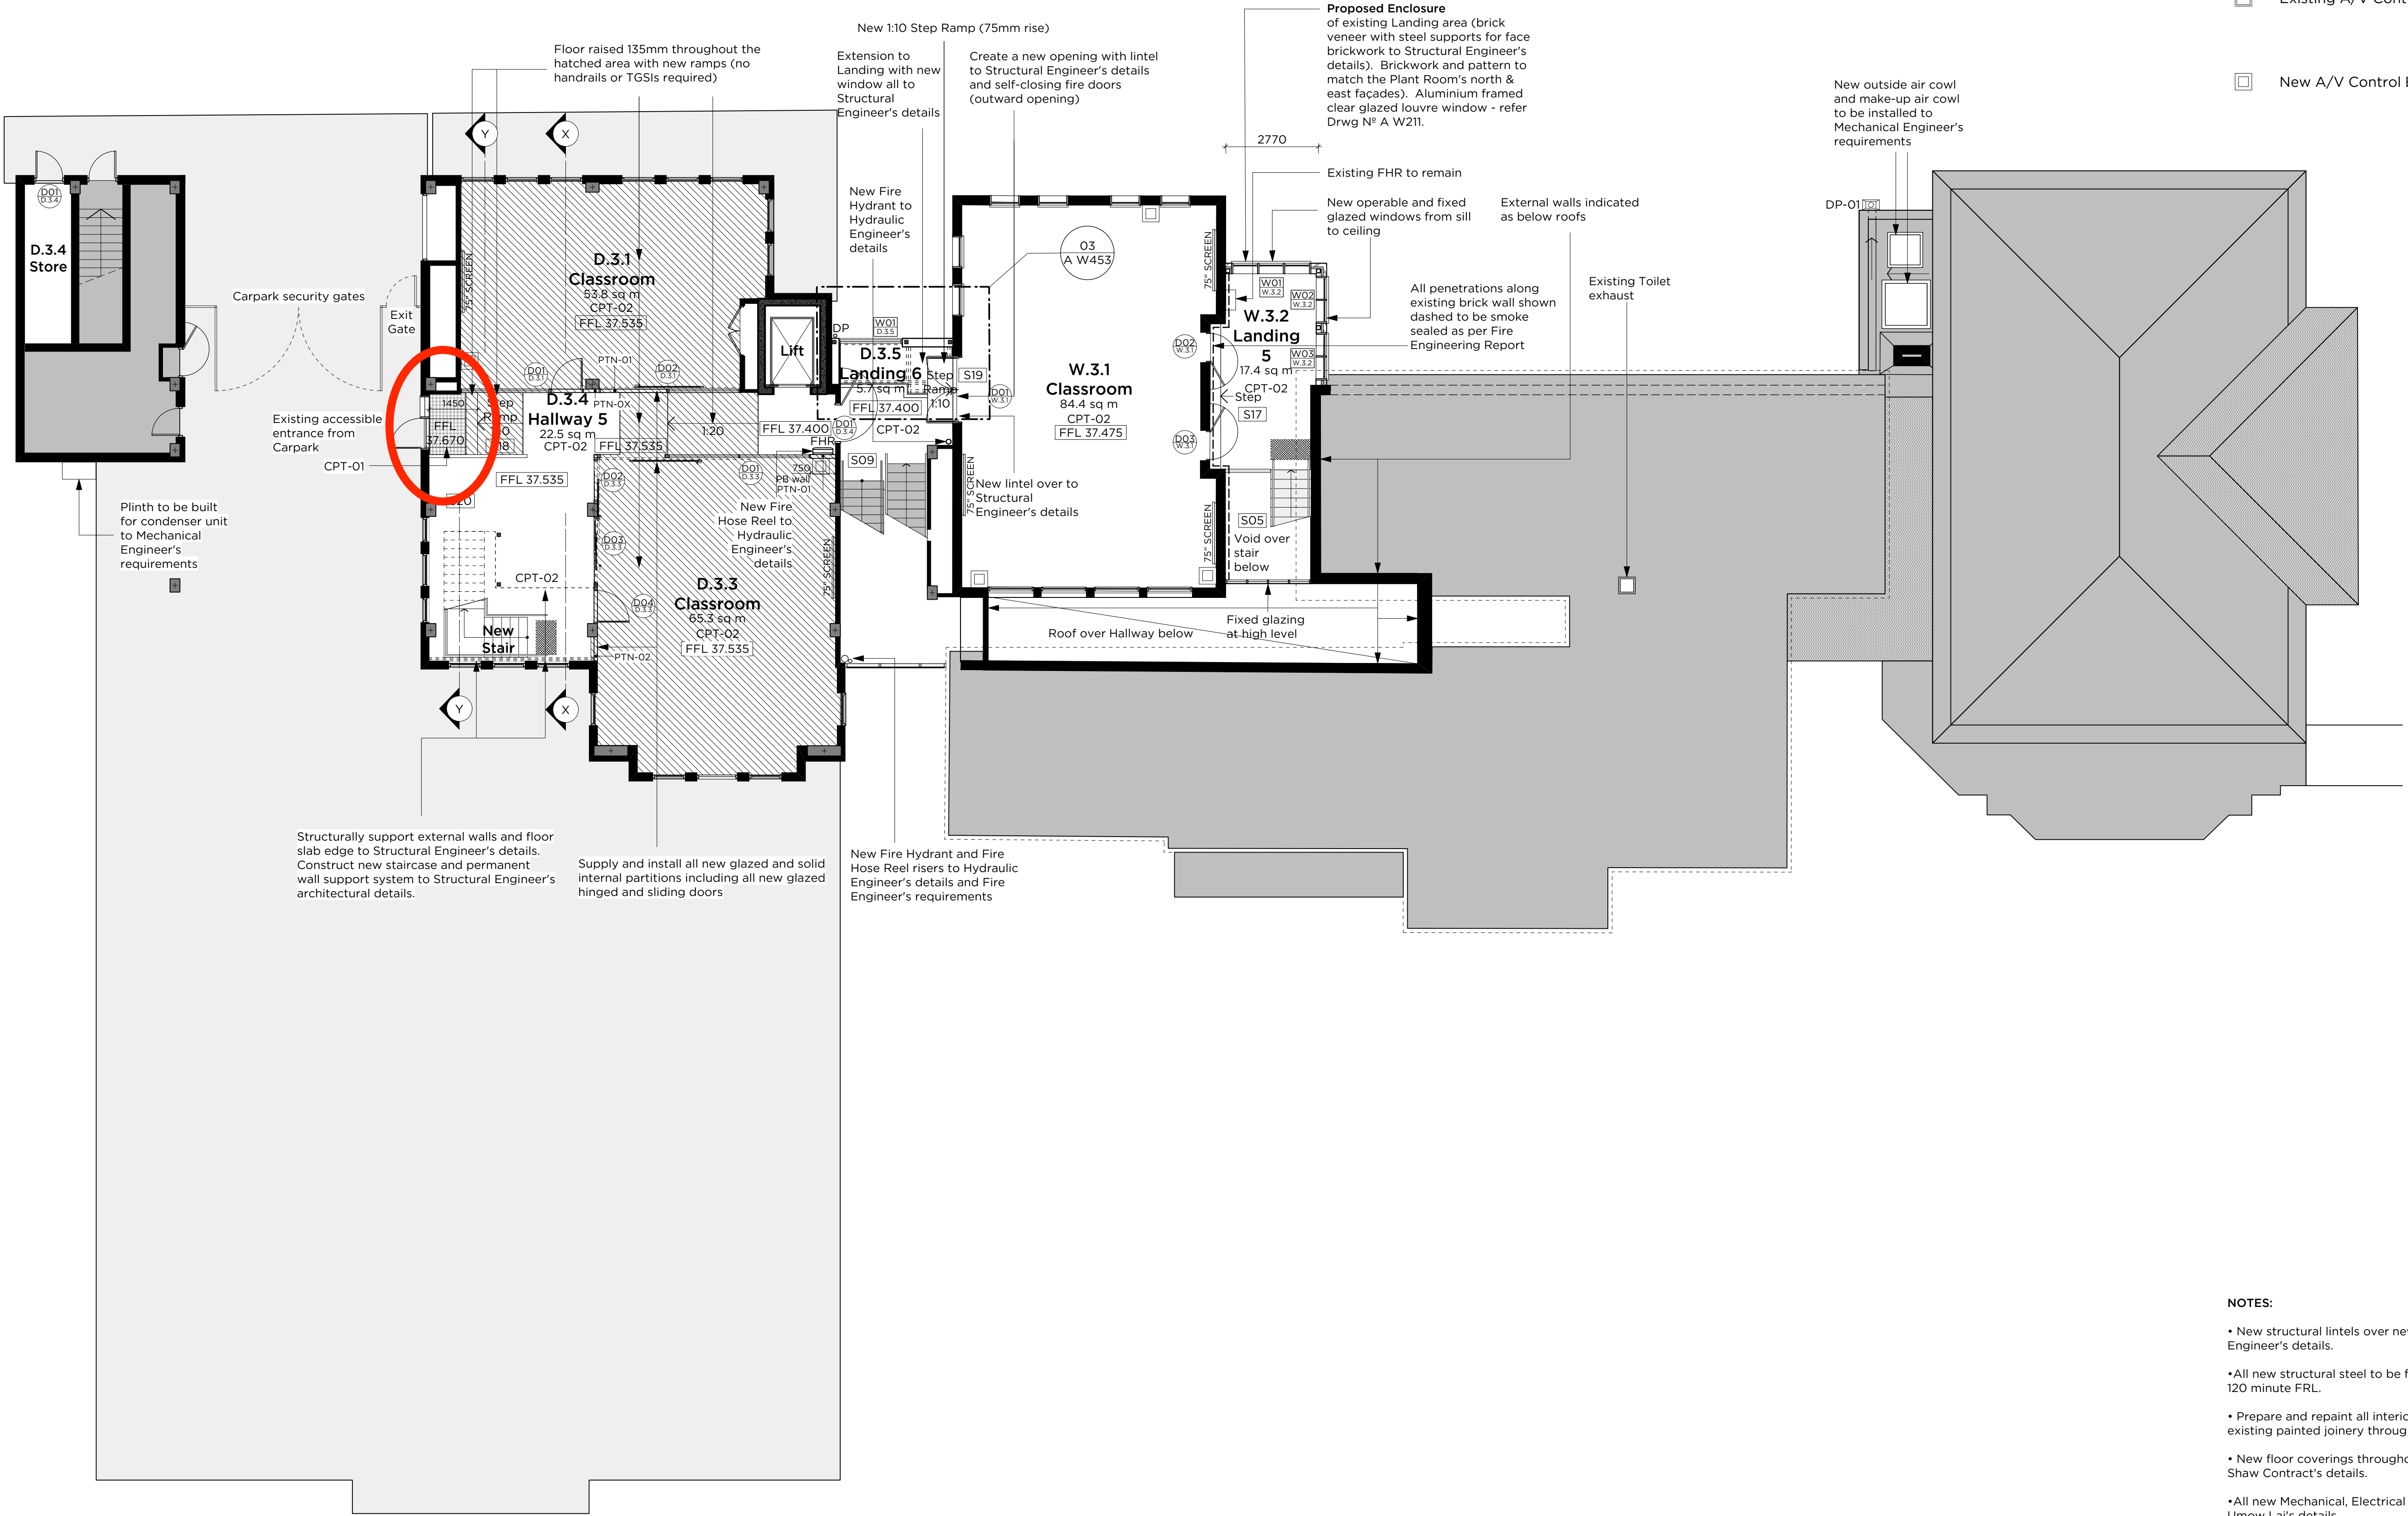

- NOTES:
- New structural lintels over new openings to Structural Engineer's details.

• All new structural steel to be fire protected to achieve 120 minute FRL.

• Prepare and repaint all interior faces of walls, doors and existing painted joinery throughout unshaded area.


• New floor coverings throughout unshaded area. Refer Shaw Contract's details.

• All new Mechanical, Electrical and Hydraulic services to Umow Lai's details.

01 Proposed Third Floor Plan

Level 3

Scale 1:100

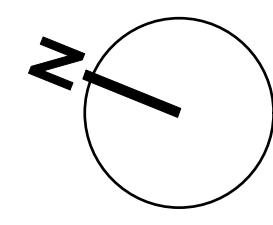

PMDL

ARCHITECTURE
INTERIORS
MASTERPLANNING

pmdl.com.au

PM DL ARCHITECTURE + DESIGN PTY LTD ABN 56 002 881 337
NSW NOMINATED ARCHITECTS: ANDREW PENDER 5317 DAVID MORRIS 5865 VICKI VAN DIJK 9476

AS BUILT

D	5/12/19	Stair layout updated
C	1/11/19	AV Location updated
B	24/10/19	Updated for CG Re-Submission
ISSUE	DATE	REVISION
0mm 50mm 100mm		
DO NOT SCALE FROM DRAWING. USE FIGURED DIMENSIONS ONLY. CHECK ALL DIMENSIONS ON SITE BEFORE MANUFACTURE OR CONSTRUCTION.		
PROJECT	Phase 1 - Wyalla & Dalton	PROJECT # 2622
CLIENT	St Aloysius' College	DWG #
DWG	Level 3 Plan	A W113
CLIENT REF & CONTACT	46 Pitt St, Kirribilli, 2061	DATE Sep 2019 DRAWN NZ REVISION
	SCALE 1:100 @ A1	CHWD TW
		D