

Mod 5 SSD9033 - Amendments to car parking numbers at end of Stage 3 project					
	Existing Car Parking on site prior to Stage 3 Project	Required under SSD9033 Mod 2	Required under SSD9033 Mod 2	Required under SSD9033 Mod 2	Proposed under SSD9033 Mod 5 - car space count at end of Stage 3 Project
		Basement Extension	Generator Relocation		
CP1	138	154	154	154	154
CP2	96	96	96	96	96
CP3	35	35	35	35	35
CP4	42	31	31	39	42
CP5	14	14	14	14	14
CP6	6	6	6	6	6
CP7	15	15	15	19	8
CP8	15	15	15	15	15
CP9	13	13	13	13	24
CP10	45	45	45	45	45
CP11	8	27	27	24	24
CP12	13	13	13	13	13
CP13	-	36	36	36	-
CP14	-	40	72	72	72
Revised Total	440	540	572	577	548
Numbers +/-		100	32	5	-29
Cumulative		100	132	137	108

LEGEND:

PROPOSED STAGE 3 AMBULATORY CARE BUILDING (ACB)

EXISTING BUILDINGS

PROPOSED NEW EXTERNAL WORKS

NOTE:

BOLLARD AND TACTIC PROVISION TO COMPLY WITH BCA AND DDA

ALL LANDSCAPING WORKS REFER TO LANDSCAPE DRAWING PACKAGE.


NOTES:

TO BE READ IN CONJUNCTION WITH SERVICES, STRUCTURAL & CIVIL DOCUMENTATION. ANY DISCREPANCY TO BE BROUGHT TO THE ATTENTION OF JACOBS.

9	26.03.2021	CT	RG	CARPARK UPDATED AS PER Smith-R1801-0001754
8	11.12.2020	CT	RG	CARPARK UPDATED AS PER Smith-G00R-000370
7	03.12.2020			CP4 UPDATED AS PER Smith-TRANSCENT-000385
6	30.11.2020			ISSUE FOR AS-BUILT
5	26.11.2020	CT	EF	UPDATE FOR PLANNING APPROVAL
4	02.11.2020	CT	EF	CARPARK UPDATE
3	09.10.2020	CT	RG/EF	CARPARK, GENERATOR, LANDSCAPES, PEDESTRIAN PATH UPDATES FOR APPROVAL
2	22.04.2020	SC	SF	ISSUE FOR CONSTRUCTION
1	21.04.2020	SC	SF	UPDATE FOR CONSTRUCTION
0	17.04.2020	SC	SF	ISSUE FOR CONSTRUCTION FOR PLANNING APPROVAL
REV	DATE	DRAWN	REV'D	APP'D

KEY PLAN

REFER TO DRAWING 4100 FOR ELEVATION & SECTION REFERENCES

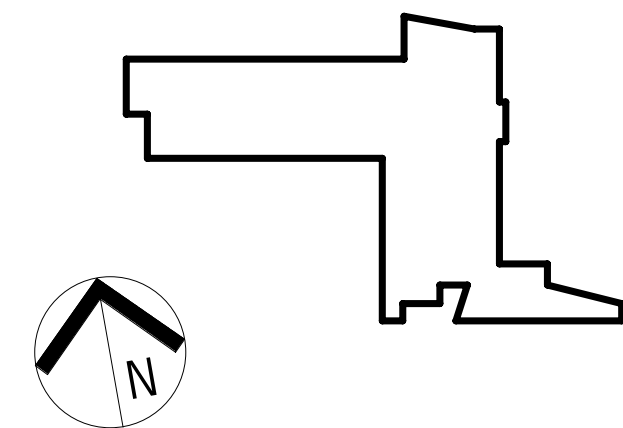

PROJECT MANAGER



PRINCIPAL



LEVEL 7, 177 PACIFIC HIGHWAY  
NORTH SYDNEY  
NSW 2060  
AUSTRALIA

TEL: +61 2 9928 2100  
FAX: +61 2 9928 2510  
WEB: jacobs.com



WAGGA WAGGA HEALTH SERVICE REDEVELOPMENT STAGE 3  
CNR EDWARD & DOCKER STREET  
WAGGA WAGGA NSW 2650

ARCHITECTURAL SERVICES  
SITE PLAN - PROPOSED

DRAWING STATUS

ISSUE FOR AS-BUILT

DRAWN	LH / EF	DRAWING CHECK	EF
DESIGNED	DG / JS	DESIGN REVIEW	AC
REVIEWED	AC / DG	DATE	10.08.2018
APPROVED	CY	DATE	17.08.2018
SCALE	As indicated @ B1		
DRAWING No.	IA172202-ACB-RB-DRG-0100	REV	9