


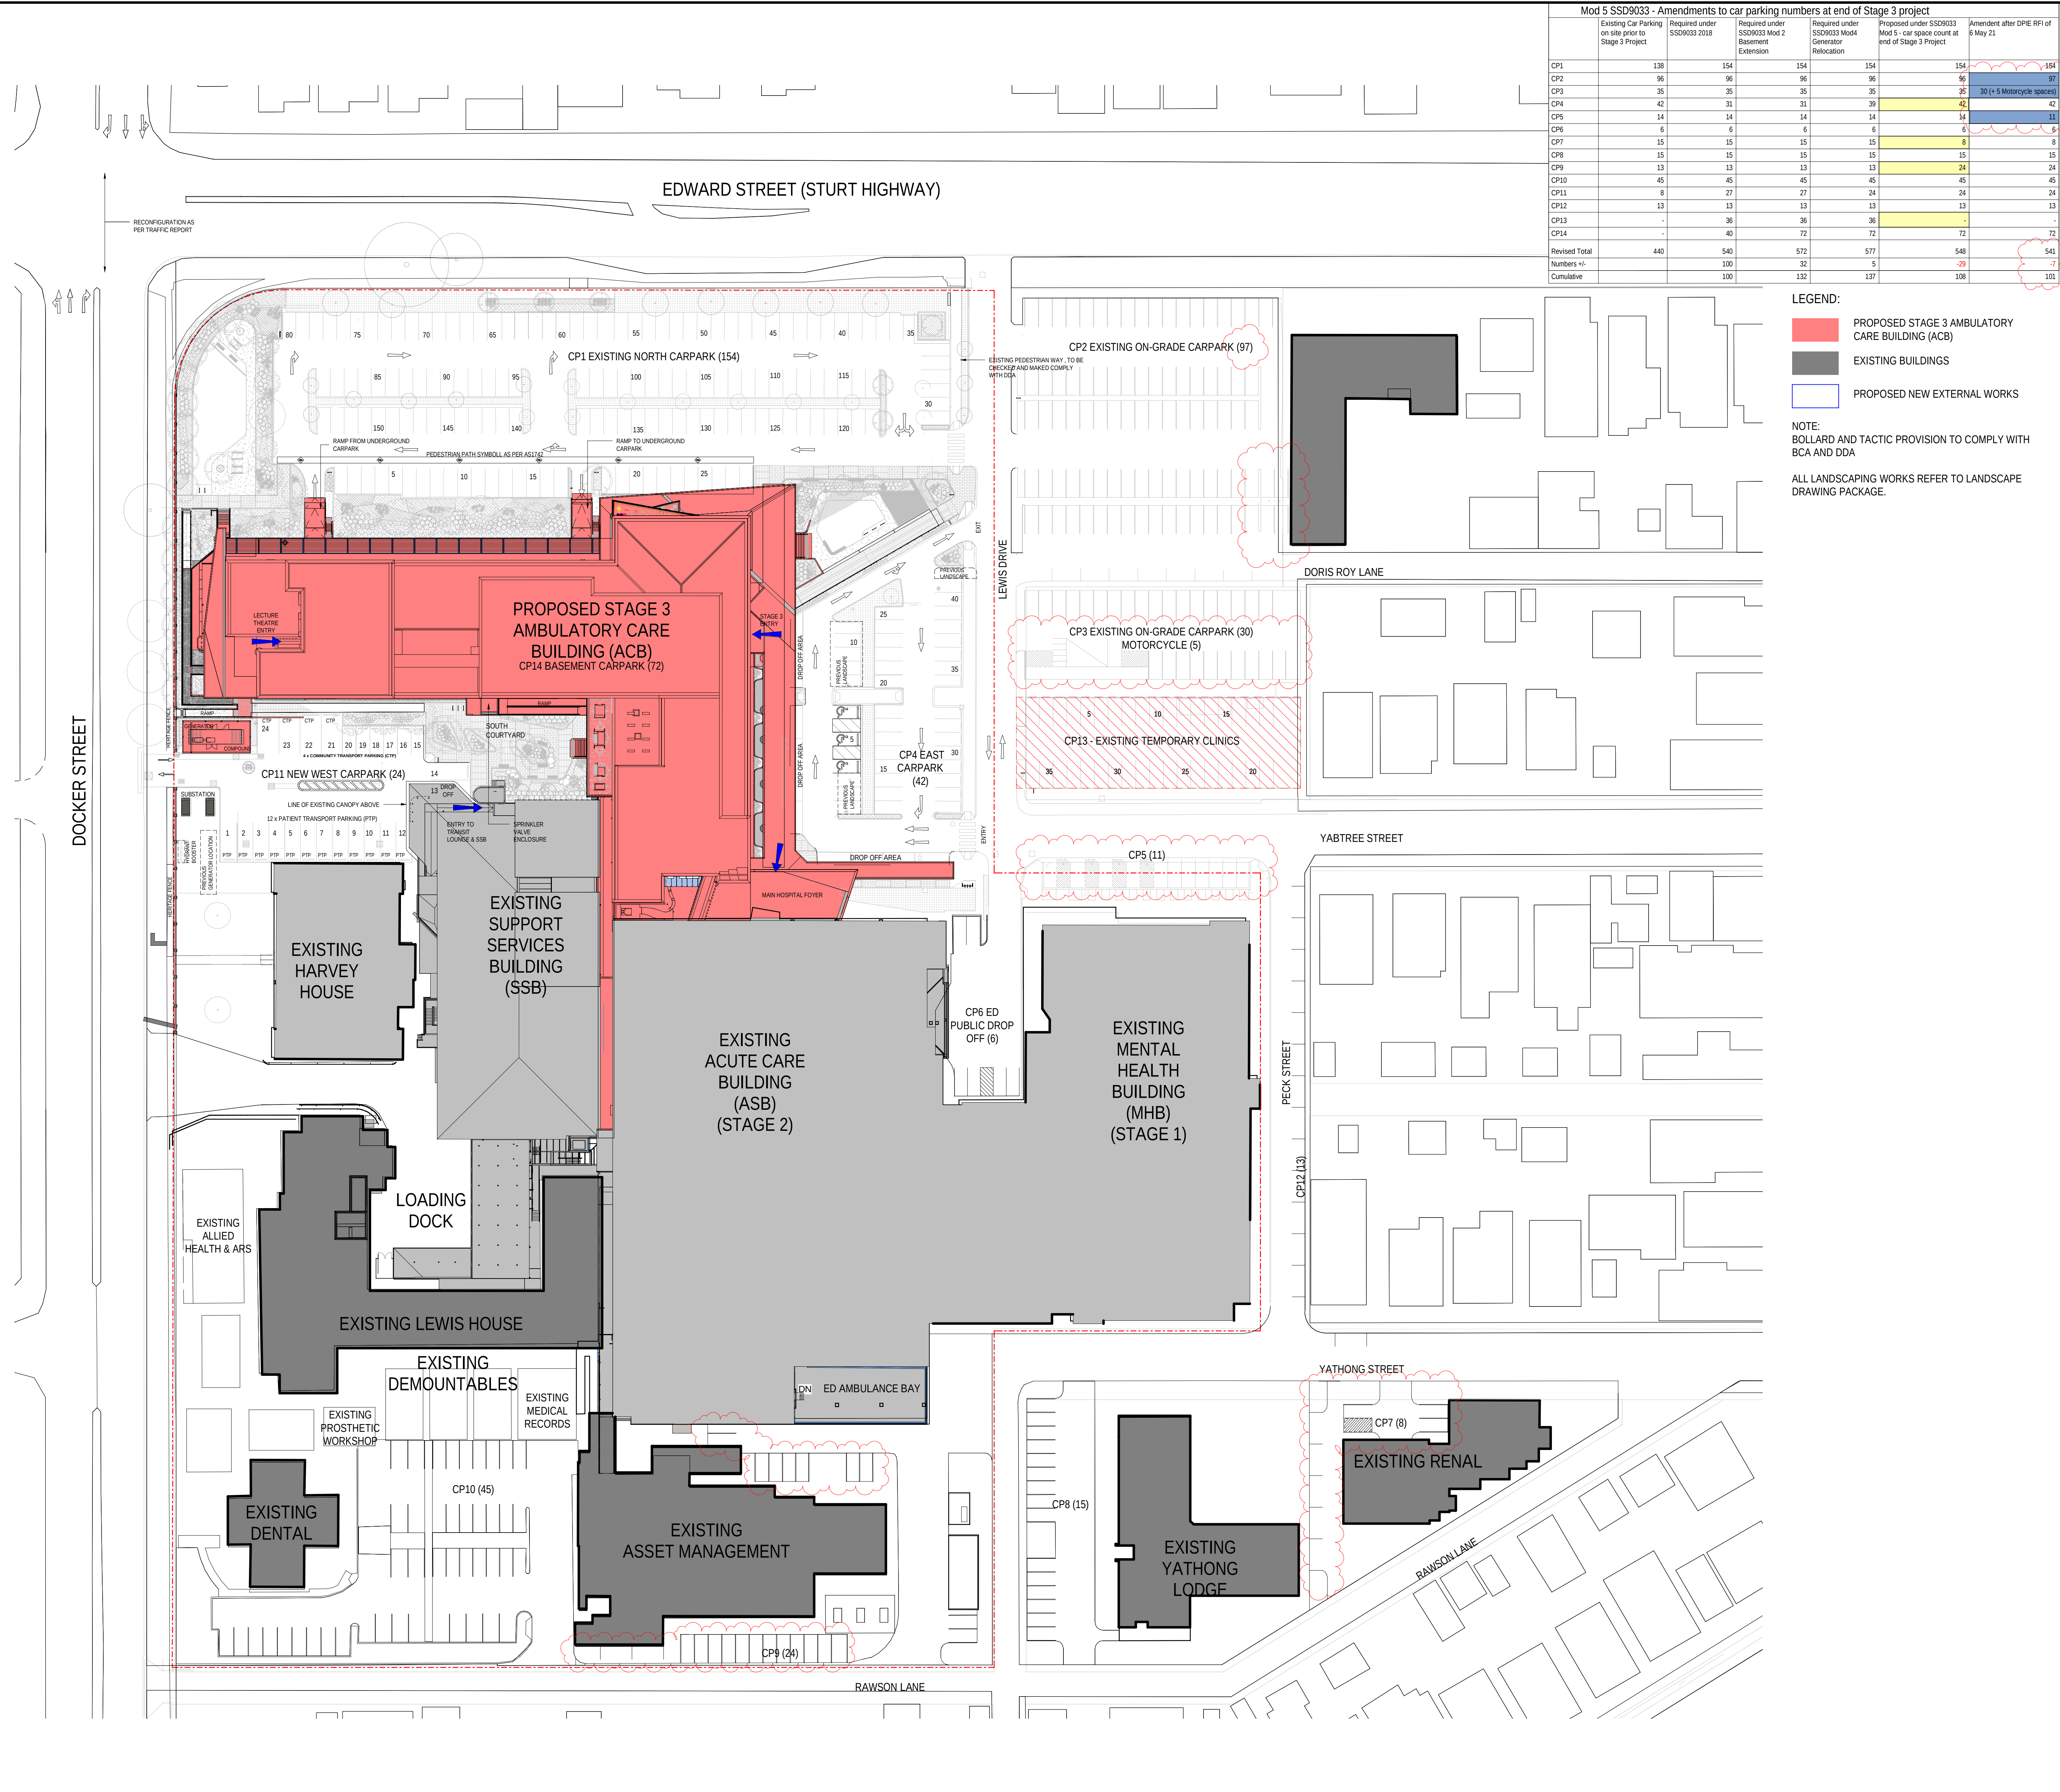

NOTES:
TO BE READ IN CONJUNCTION WITH SERVICES, STRUCTURAL & CIVIL DOCUMENTATION. ANY DISCREPANCY TO BE BROUGHT TO THE ATTENTION OF JACOBS.

REV	DATE	BY	CHKD	APPD	DESCRIPTION
10	12.05.2021	CT	SG		CARPARK UPDATED AS PER Savills-GCOR-006997
9	26.02.2021	CT	RG		CARPARK UPDATED AS PER Savills-RTTRFI-000754
8	11.12.2020	CT	RG		CARPARK UPDATED AS PER Savills-GCOR-006370
7	03.12.2020				CP4 UPDATED AS PER Savills-TRANSMT-000386
6	30.11.2020				ISSUE FOR AS-BUILT
5	26.11.2020	CT	EF		UPDATE FOR PLANNING APPROVAL
4	02.11.2020	CT	EF		CARPARK UPDATE
3	09.10.2020	CT	RG/EF		CARPARK, GENERATOR, LANDSCAPES, PEDESTRIAN PATH UPDATES FOR APPROVAL
2	22.04.2020	SC	SP		ISSUE FOR CONSTRUCTION
1					AMENDMENT

KEY PLAN
REFER TO DRAWING 4100 FOR ELEVATION & SECTION REFERENCES

PROJECT MANAGER
CPB CONTRACTORS savills

PRINCIPAL
NSW GOVERNMENT Health Infrastructure
NSW GOVERNMENT Health Murrumbidgee Local Health District

JACOBS
LEVEL 7, 177 PACIFIC HIGHWAY
NORTH SYDNEY
NSW 2060
AUSTRALIA
TEL: +61 2 9928 2000
FAX: +61 2 9928 2510
WEB: jacobson.com

PROJECT
WAGGA WAGGA HEALTH SERVICE REDEVELOPMENT
Changing more than the buildings
WAGGA WAGGA HEALTH SERVICE REDEVELOPMENT STAGE 3
CNR EDWARD & DOCKER STREET
WAGGA WAGGA NSW 2650

ARCHITECTURAL SERVICES
SITE PLAN - PROPOSED

DRAWING STATUS
ISSUE FOR AS-BUILT

DRAWN		DRAWING CHECK	
LH / EF	EF		
DESIGNED	DESIGN REVIEW		
DG / JS	AC		
REVIEWED	DATE		
AC / DG	10.08.2018		
APPROVED	DATE		
CY	17.08.2018		
SCALE			
As indicated @ B1			
DRAWING NO.			
IA127202-ACB-RB-DRG-0100			
REV			
10			