


12/05/2021 10:28:18 PM

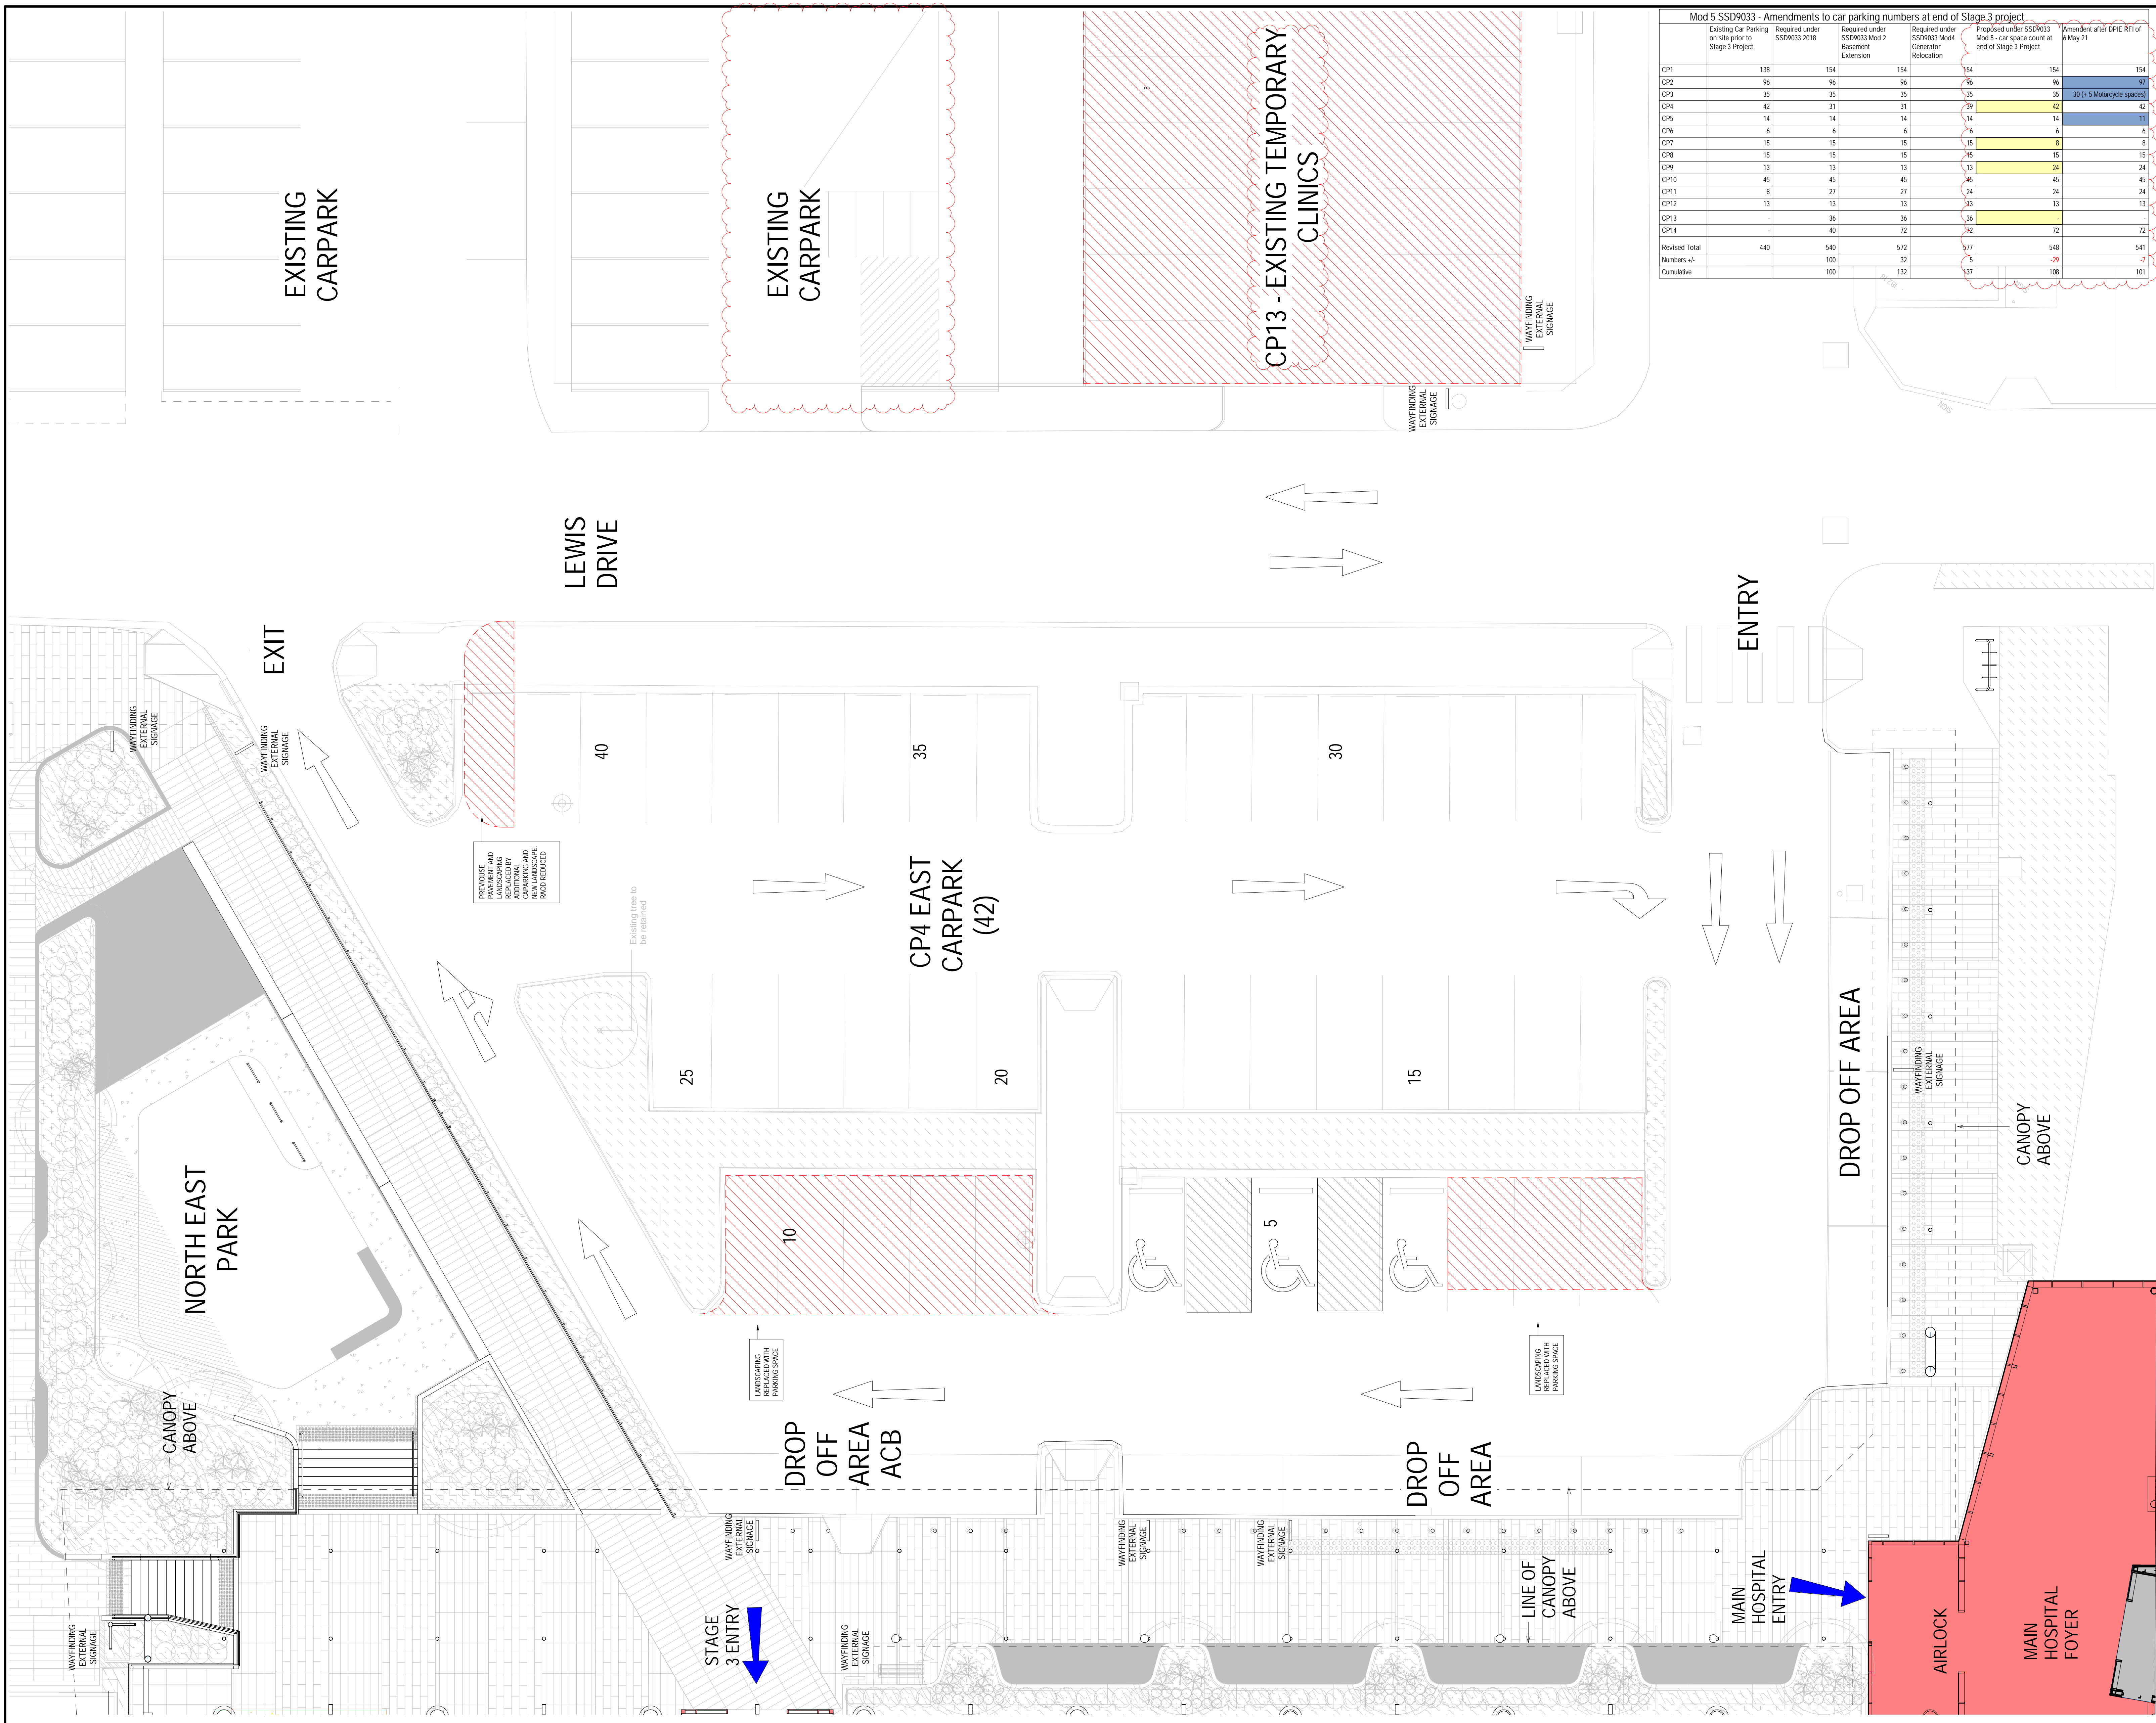

Mod 5 SSD9033 - Amendments to car parking numbers at end of Stage 3 project


	Existing Car Parking on site prior to Stage 3 Project	Required under SSD9033 2018	Required under SSD9033 Mod 2 Basement Extension	Required under SSD9033 Mod 4 Generator Relocation	Proposed under SSD9033 Mod 5 - car space count at end of Stage 3 Project	Amendment after DP/E RFI of 8 May 21
CP1	138	154	154	154	154	154
CP2	96	96	96	96	96	97
CP3	35	35	35	35	35	30 (+ 5 Motorcycle spaces)
CP4	42	31	31	31	39	42
CP5	14	14	14	14	14	18
CP6	6	6	6	6	6	6
CP7	15	15	15	15	15	8
CP8	15	15	15	15	15	15
CP9	13	13	13	13	13	24
CP10	45	45	45	45	45	45
CP11	8	27	27	27	24	24
CP12	13	13	13	13	13	13
CP13	-	36	36	36	36	-
CP14	-	40	72	72	72	72
Revised Total	440	540	572	577	577	541
Numbers +/-	100	100	32	5	29	-7
Cumulative		100	132	137	188	101

**NOTES:**  
 TO BE READ IN CONJUNCTION WITH SERVICES, STRUCTURAL & CIVIL DOCUMENTATION. ANY DISCREPANCY TO BE BROUGHT TO THE ATTENTION OF JACOBS.

**NOTE:**  
 ALL PLANTER SETOUT REFER TO IA172200-ACB-LS-DRG-00104 FOR LANDSCAPE  
 ALL KERB AND LINE MARKING SETOUR REFER TO WWH-TTW-DRW-CV-GEN-0000032 AND WWH-TTW-DRW-CV-GEN-0000034 FOR CIVIL DETAIL

REV	DATE	CT	EF	APPD	AMENDMENT
4	12.05.2021	CT	SG		CARPARK UPDATED AS PER SAVILLS GCOM04697
3	11.12.2020	CT	RG		CARPARK UPDATED AS PER SAVILLS GCOM04697
2	03.12.2020				CP4 UPDATED AS PER SAVILLS TRANSMIT 0000386
1	30.11.2020				ISSUE FOR AS-BUILT
C	25.11.2020	CT	EF		UPDATE FOR PLANNING APPROVAL
B	17.11.2020				UPDATE FOR PLANNING APPROVAL
A	03.11.2020	CT	EF		CARPARK UPDATE

REFER TO DRAWING 4100 FOR ELEVATION & SECTION REFERENCES

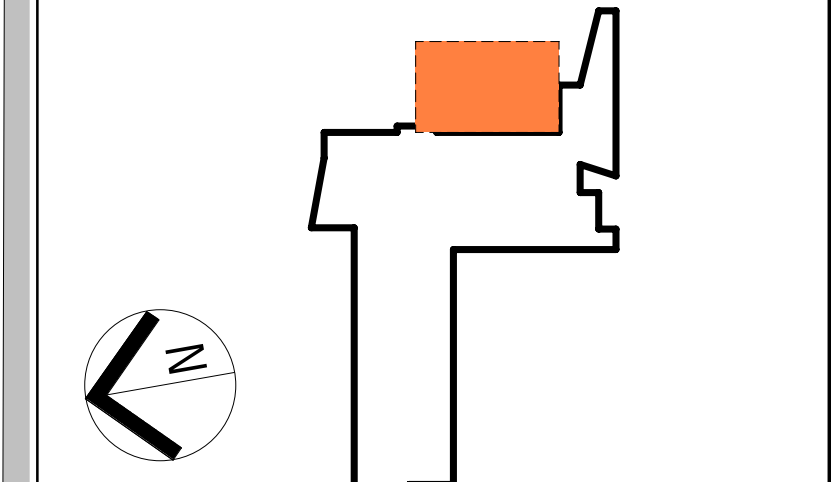

PROJECT MANAGER

PRINCIPAL

**JACOBS**

LEVEL 7, 177 PACIFIC HIGHWAY  
 NORTH SYDNEY  
 NSW 2060  
 AUSTRALIA

TEL: +61 2 9008 2100  
 FAX: +61 2 9008 2510  
 WEB: jacobs.com

PROJECT

**WAGGA WAGGA HEALTH SERVICE REDEVELOPMENT**  
 Changing more than the buildings

WAGGA WAGGA HEALTH SERVICE REDEVELOPMENT STAGE 3  
 CNR EDWARD & DOCKER STREET  
 WAGGA WAGGA NSW 2650

TITLE  
**SITE PLAN - CARPARKING - CP4**

**ISSUE FOR AS-BUILT**

DRAWN	DRAWING CHECK
CT	EF
DESIGNED DG / JS	DESIGN REVIEW AC
REVIEWED AC / DG	DATE
APPROVED	DATE

SCALE  
 As indicated @ B1

DRAWING NO.  
 IA172202-ACB-RB-DRG-0110

REV  
 4