
INSTALLATION CERTIFICATE

ARCHITECTURAL

Site Details:

Project Name.	Concord Hospital Redevelopment		
Level/Unit no.	Lot 20 DP No.	Street no. / Street name:	1 H Hospital Road,
	1139098 Canada		
	Bay Council		
Suburb:	Concord West	State:	NSW
		Postcode:	2138

Description of Work:

+ Supply and installation of façade (refer attached scope)

Development Consent:

SSD No.	SSD 9036	Consent authority:	Minister for Planning
		Dated:	28 th February 2019

Pursuant to the provisions of the Environment Planning and Assessment Regulations 2000 and Clause A2.2 of the Building Code of Australia BCA 2016 Amendment 1:

I, Travis Coppin of Brighton Ceilings
(name) (company)

hereby certify that:-

-
- a) The external walls have been completed in accordance with the DA approved plans and schedule of finishes and the performance solution demonstrating with BCA Performance Requirement FP1.4.
-

Exclusions: ~~Yes~~ or No

Details of any exclusions:


Where there are no exclusions, I certify that this certificate covers all façade elements installed to the building.

I also certify that I am an appropriately qualified and competent person practicing in the relevant area of work. I have recognised relevant experience in the area of work being certified. ~~I~~ my employer hold/s appropriate current professional indemnity insurance to the satisfaction of the building owner or the principal authorising the design work being certified.

Name:	Travis Coppin	Licence No.:	Dept of Fair Trading 85907S
Company Name:	Brighton Ceilings Pty Ltd	ABN No:	49 141 852 477
Company Address:	65 The Grand Parade Brighton Le Sands NSW 2216	Tel:	02 9599 6230
Signature:		Position Title:	Project Manager
		Date:	26/07/2021

Note: Attach any supporting documentation.

FAC1 - Terracotta cladding Panel system
FAC2 - Fibre C Façade system
FAC3 - Pale Bronze aluminium cladding Panels
FAC4 - Windows, extruded aluminium frame
FAC5 - Curtain wall glazing (extruded aluminium frame)
FAC6 - Curtain wall glazing, with aluminium glazing clips & RHS steel mullion
Breezeway Louvres (FAC6)
FAC7 - Curved curtain wall glazing, extruded aluminium frame
FAC8 - Fixed glass balustrade screen
FAC9 - Frameless fixed glazing
Single swing sliding doors
Double swing doors
FAC10 - Sheet metal wall cladding
Skylights
Lift Atrium
Hose Tests
Mock ups
Door and Auto Doors
Engineering, design & Shop drawings
FAC1 Internal Terracotta

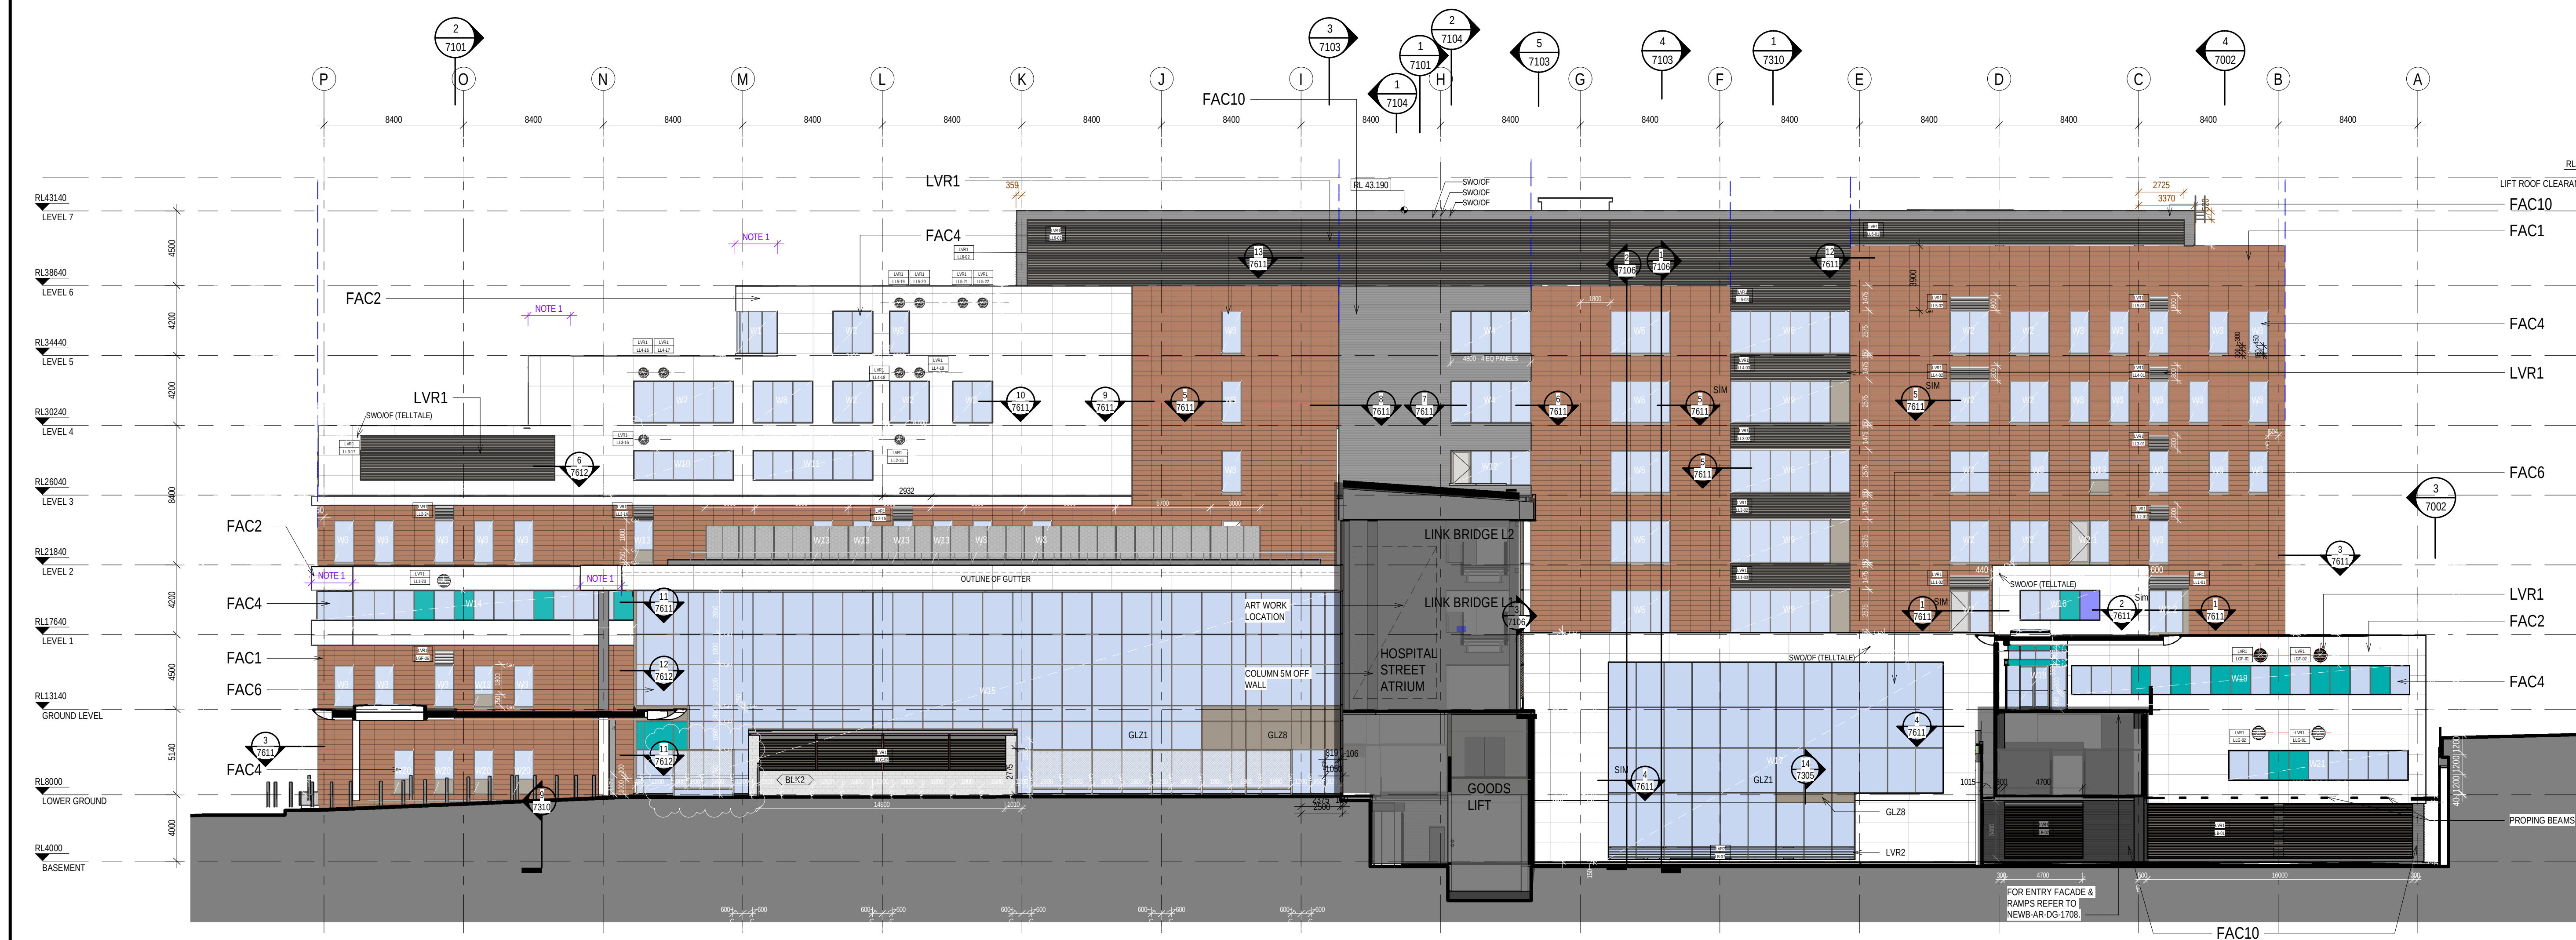


LEGEND:




TERRACOTTA

INSTALLED BY BRIGHTON

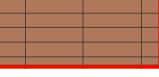


ALUM. SOLID CLADDING

INSTALLED BY BRIGHTON

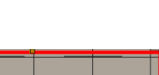

REINFORCED CONCRETE CLADDING (FIBRE C)

INSTALLED BY BRIGHTON

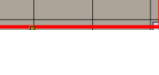

ALUM. METAL LOUVRES

INSTALLED BY CVIS

LVR1	HORIZONTAL LOUVRES
LVR2	ACTUATED POWER GLASS LOUVRES
LVR3	VERTICAL LOUVRES
LVR4	600mm DEEP ACOUSTIC LOUVRES, HORIZONTAL

GLAZING LEGEND:

	GLZ1	STANDARD CLEAR SINGLE GLAZED IGUS
	GLZ2	CLEAR SINGLE GLAZED IGUS, WITH JOCKEY SASH & INTEGRAL BLINDS
	GLZ3	TRANSLUCENT SINGLE-GLAZED IGUS
	GLZ4	WHITE OPAQUE COLOURBACK SINGLE GLAZING BACKED WITH INSULATION
	GLZ5	GREEN OPAQUE COLOURBACK SINGLE GLAZING BACKED WITH INSULATION
	GLZ6	CLEAR SINGLE GLAZING
	GLZ7	STANDARD CLEAR DOUBLE GLAZED IGUS
	GLZ8	BRONZE OPAQUE COLOURBACK SINGLE GLAZING BACKED WITH INSULATION
	GLZ9	ASSAULT GUARD CLEAR GLAZING

DIMENSION LEGEND:

 DIMENSION SET OUT FOR METAL SHEET CLADDING (COLORBOND®) - FAC10

 DIMENSION SET OUT FOR WINDOW AND LOUVERS


 DIMENSION SET OUT FOR TERRAZZOTA CLADDING - FAC1

 DIMENSION SET OUT FOR ALUMINIUM NON-COMPOSITE CLADDING - FAC3

 REINFORCED CONCRETE CLADDING (FIBRE C) - FAC2


 NOTE 1 - REFER TO CURVED FACADE SET OUT PLAN DETAILS FOR FACADE AND WINDOWS SERIES 7600

P	08/06/21	SC	WB	GENERAL UPDATE	
P	26/02/20	SC	WB	FACADE UPDATE	
O	10/12/20	SC	WB	ROUND LOUVRES UPDATE	
N	07/08/20	LH	WB	SOUTH ELEVATION UPDATE	
M	27/07/20	MW	WB	SECTION 4.55 MODIFICATION 5 ISSUE	
K	25/07/20	LH	WB	SECURE COURT-YARD UPDATE	
M	21/05/20	LH	WB	SECURE COURT-YARD UPDATE	
J	23/04/20	LH	WB	GENERAL ELEVATION UPDATE	
I	24/03/20	LH	WB	EAST ATRIUM SMOKE FAN & GENERAL UPDATE	
H	20/02/20	LH	WB	SECTION 4.55 MODIFICATION ISSUE	
G	14/02/20	LH	WB	ISSUED FOR CC44	
F	03/02/20	LH	WB	SECTION 4.55 MODIFICATION ISSUE	
REV	DATE	DRAWN	REVO	APP'D	AMENDMENT

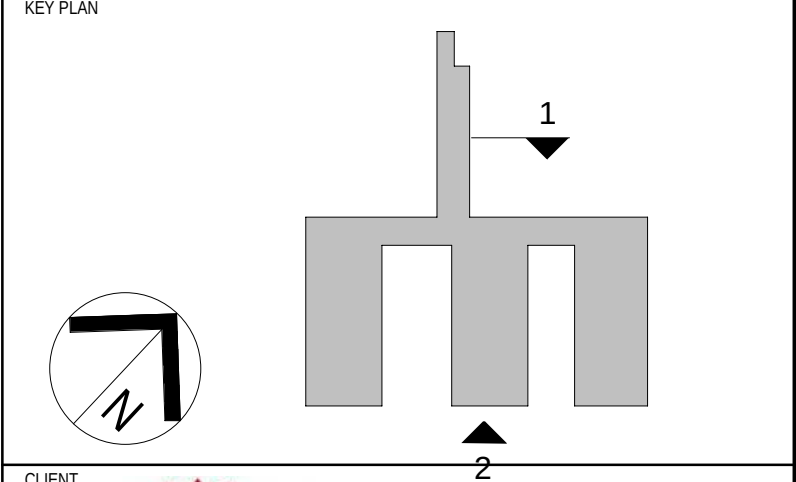

 NSW GOVERNMENT	Health Infrastructure 
JOHNSTAFF	
	roberts pizzarotti
JACOBS® LEVEL 1, 177 PACIFIC HIGHWAY NORTH SYDNEY NSW 2060 AUSTRALIA PROJECT CONCORD HOSPITAL REDEVELOPMENT STAGE 1 HOSPITAL ROAD CONCORD NSW 2139 TEL +61 2 9938 2100 FAX +61 2 9932 2510 WEB jacobus.com	
TITLE ELEVATION - NORTH & SOUTH	


DRAWING STATUS			
FOR CONSTRUCTION			
DRAWN MW/BY		DRAWING CHECK PC/WCB	
DESIGNED AC/DG		DESIGN REVIEW CY	
REVIEWED		DATE	
APPROVED		DATE	
SCALE			
1"=200' @ B1			
PROJECT No.		REV	
IA064700		NEWB-AR-DRG-7001	
		Q	

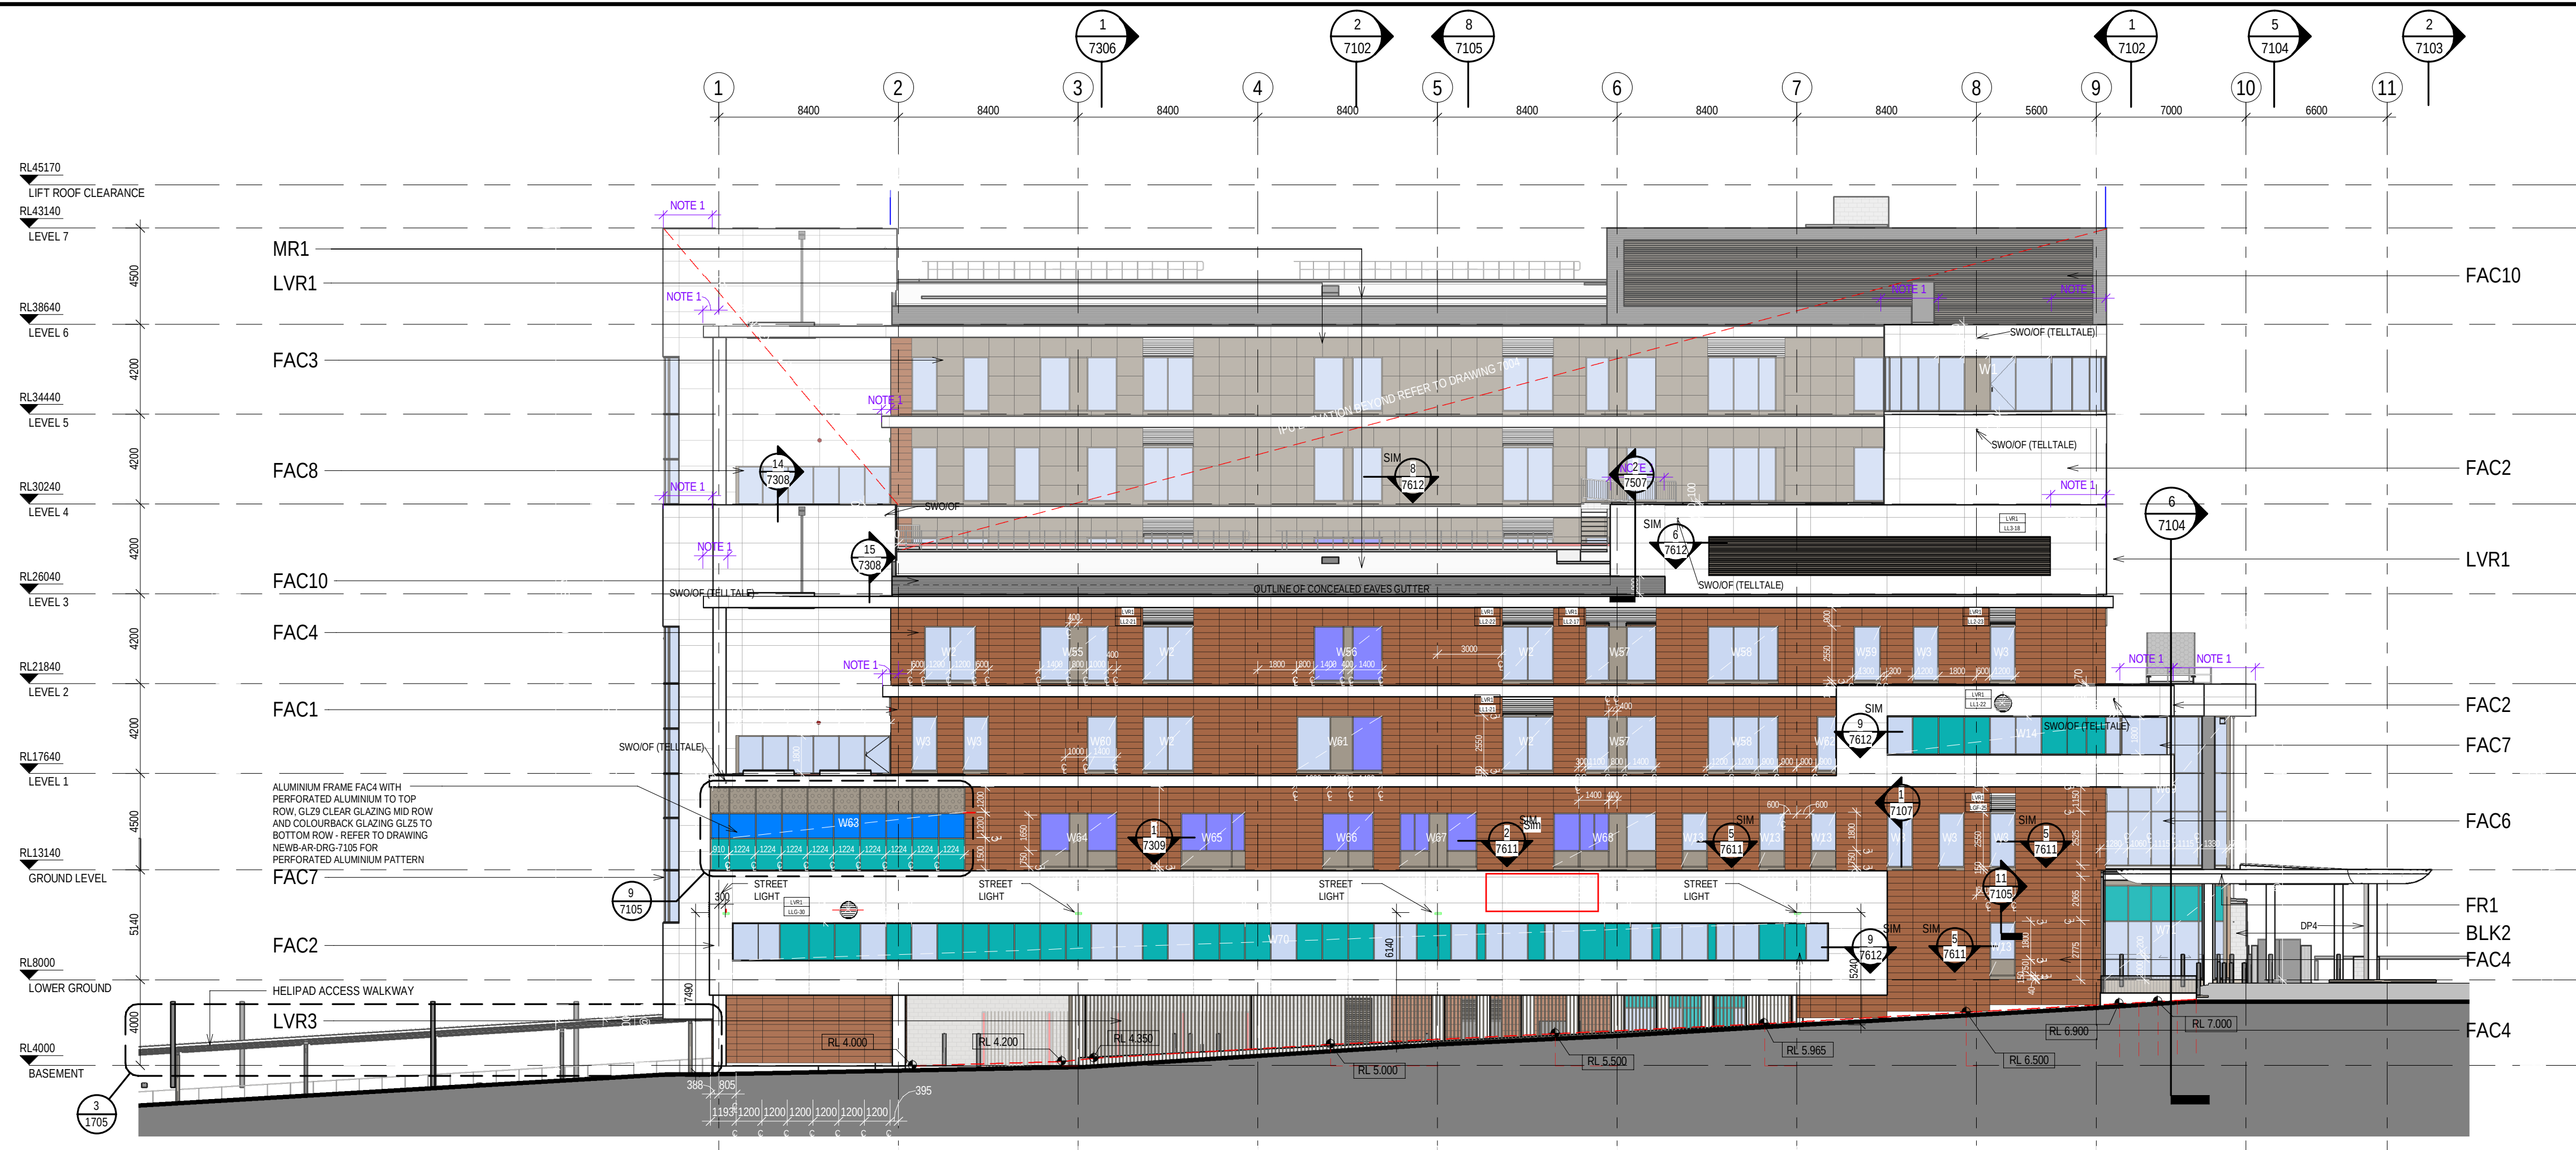


1 EAST ELEVATION
15B2 1:200



2 WEST ELEVATION
15B2 1:200

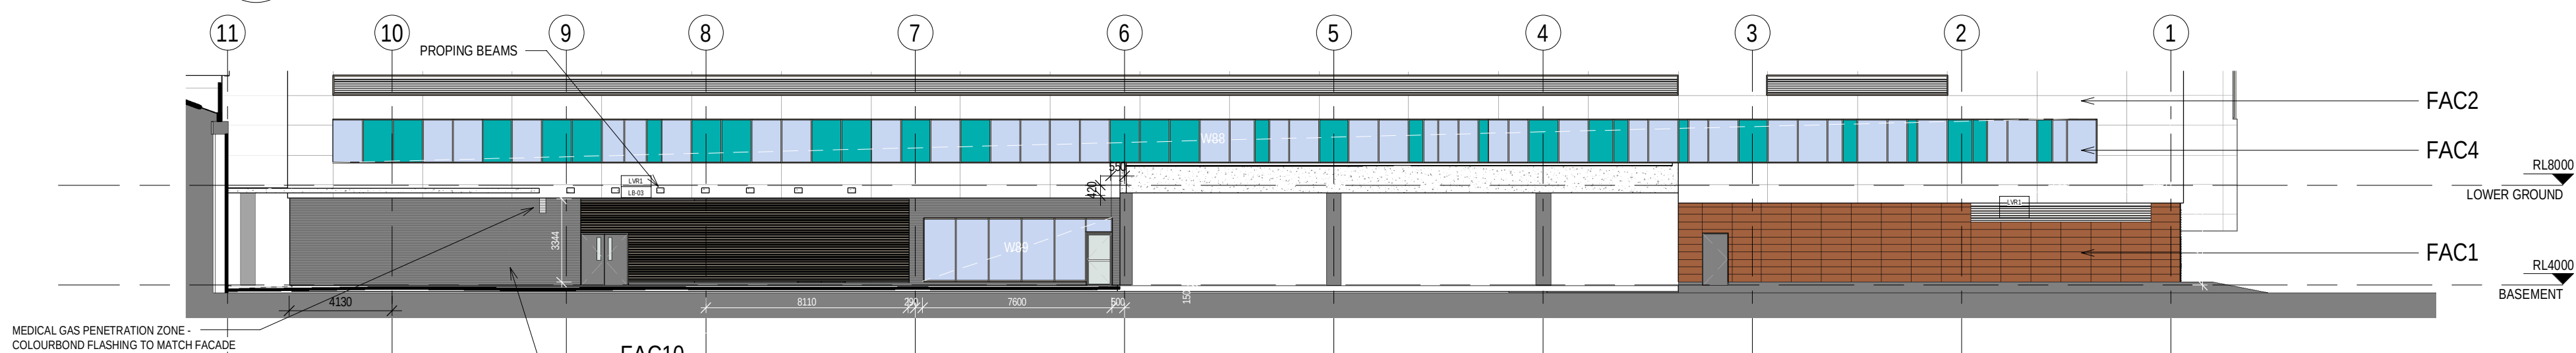

3 PART WEST ELEVATION SECTION
15B2 1:200

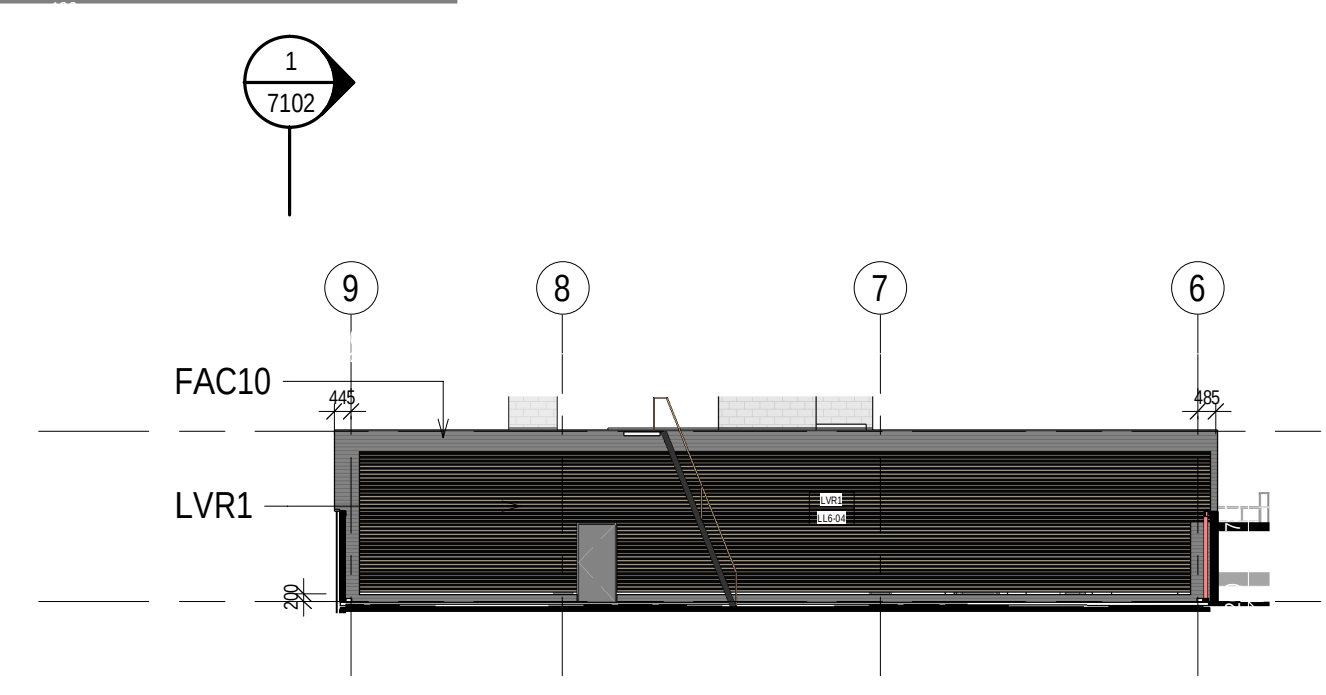

4 PART WEST PLANT ROOM ELEVATION SECTION
15B2 1:200

LEGEND:

- TERRACOTTA
INSTALLED BY BRIGHTON
- ALUM SOLID CLADDING
INSTALLED BY BRIGHTON
- REINFORCED CONCRETE CLADDING (FIBRE C)
INSTALLED BY BRIGHTON
- ALUM. METAL LOUVRES
INSTALLED BY CVS

GLAZING LEGEND:

- GLZ1 STANDARD CLEAR SINGLE GLAZED IGUS
- GLZ2 CLEAR SINGLE GLAZED IGUS WITH JOCKEY SASH & INTEGRAL BLINDS
- GLZ3 TRANSLUCENT SINGLE-GLAZED IGUS
- GLZ4 WHITE OPAQUE COLOURBACK SINGLE GLAZING BACKED WITH INSULATION
- GLZ5 GREEN OPAQUE COLOURBACK SINGLE GLAZING BACKED WITH INSULATION
- GLZ6 CLEAR SINGLE GLAZING
- GLZ7 STANDARD CLEAR DOUBLE GLAZED IGUS
- GLZ8 BRONZE OPAQUE COLOURBACK SINGLE GLAZING BACKED WITH INSULATION
- GLZ9 ASSAULT GUARD CLEAR GLAZING

DIMENSION LEGEND:

- DIMENSION SET OUT FOR METAL SHEET CLADDING (COLOURBACK) - FAC2
- DIMENSION SET OUT FOR WINDOW AND LOUVRES
- DIMENSION SET OUT FOR TERRACOTTA CLADDING - FAC1
- DIMENSION SET OUT FOR ALUMINUM NON-COMPOSITE CLADDINGS - FAC3
- REINFORCED CONCRETE CLADDING (FIBRE C) - FAC2
- NOTE 1 - REFER TO CURVED FACADE SETOUT PLAN DETAILS FOR FACADE AND WINDOWS SERIES 7100

KEY PLAN

CLIENT

NSW GOVERNMENT Health Infrastructure

JOHNSTAFF

roberts pizzarotti

JACOBS

LEVEL 1, 177 PACIFIC HIGHWAY NORTH SYDNEY NSW 2060 AUSTRALIA

TEL: +61 2 9633 2100 FAX: +61 2 9633 2333 WEB: jacobson.com

PROJECT

CONCORD HOSPITAL REDEVELOPMENT STAGE 1

HOSPITAL ROAD CONCORD NSW 2139

TITLE

ELEVATION - EAST & WEST

DRAWING STATUS

FOR CONSTRUCTION

DRAWN: MW/BY DESIGNED: PC/WB DESIGN REVIEW: CY

REVIEWED: DATE

APPROVED: DATE

SCALE

1:200 @ B1

PROJECT No. DRAWING No. REV

IA064700 NEWB-AR-DRG-7002 N



1 IPU 1 - EAST ELEVATION
15B2 1:200



2 IPU 2 - WEST ELEVATION
15B2 1:200



LEGEND:

- TERRACOTTA
INSTALLED BY BRIGHTON
- ALUM SOLID CLADDING
INSTALLED BY BRIGHTON
- REINFORCED CONCRETE CLADDING (FIBRE C)
INSTALLED BY BRIGHTON
- ALUM. METAL LOUVRES
INSTALLED BY CVS

- FR1 FLAT ROOF, MEMBRANE WITH SELECT PAVERS/BALLAST
MR1 METAL ROOF SHEETING WITH 100mm INSULATION ROOF RAISERS
LVR1 HORIZONTAL LOUVRES
LVR2 ACTUATED POWER GLASS LOUVRES
LVR3 VERTICAL LOUVRES
LVR4 600mm DEEP ACOUSTIC LOUVRES, HORIZONTAL

- GLAZING LEGEND:**
- GL21 STANDARD CLEAR SINGLE GLAZED IGUS
 - GL22 CLEAR SINGLE GLAZED IGUS, WITH JOCKEY SASH & INTEGRAL BLINDS
 - GL23 TRANSLUCENT SINGLE-GLAZED IGUS
 - GL24 WHITE OPAQUE COLOURBACK SINGLE GLAZING BACKED WITH INSULATION
 - GL25 GREEN OPAQUE COLOURBACK SINGLE GLAZING BACKED WITH INSULATION
 - GL26 CLEAR SINGLE GLAZING
 - GL27 STANDARD CLEAR DOUBLE GLAZED IGUS
 - GL28 BRONZE OPAQUE COLOURBACK SINGLE GLAZING BACKED WITH INSULATION
 - GL29 ASSAULT GUARD CLEAR GLAZING

REV	DATE	DRAWN	REV'D	APP'D	AMENDMENT
J	13.07.20	MW	WB		GENERAL UPDATE
I	20.06.20	MW	SC		GENERAL UPDATE
H	05.06.20	LH	WB		ELEVATION UPDATE
G	23.04.20	LH	WB		GENERAL ELEVATION UPDATE
F	20.02.20	LH	WB		SECTION 4.55 MODIFICATION ISSUE
E	14.02.20	LH	WB		ISSUED FOR CCA
D	03.02.20	LH	WB		SECTION 4.55 MODIFICATION ISSUE
C	04.12.19	BA	WB		UPDATES TO FACADE - EAST ELEVATION BANDING DETAIL UPDATE & COLORBACK GLASS REVERSED
B	08.11.19	BA	WB		GENERAL UPDATES
A	27.09.19	BA	WB		ISSUE FOR CONSTRUCTION
Z1	03.09.19	BA	WB		ELEVATIONS & DETAILS UPDATE - LOUVRES, WINDOW TAGS ADDED & GENERAL UPDATES

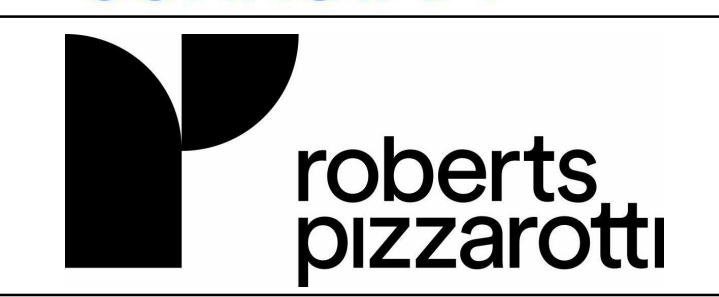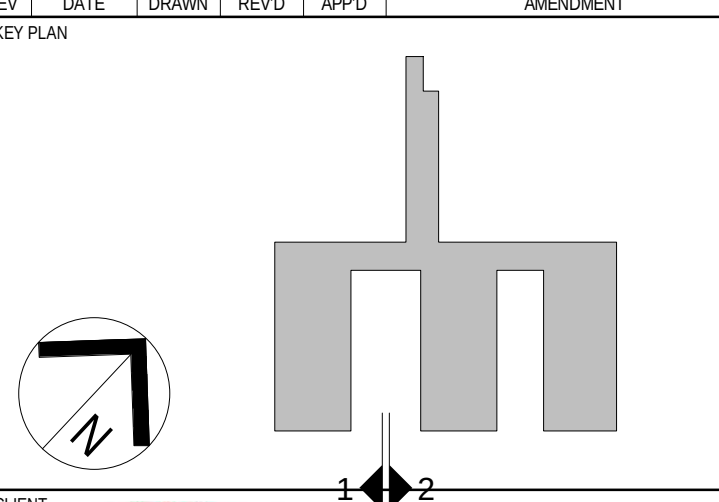

LEVEL 1, 177 PACIFIC HIGHWAY
NORTH SYDNEY
NSW 2060
AUSTRALIA

TEL: +61 2 9038 2100
FAX: +61 2 9038 2100
WEB: jacobson.com

PROJECT
CONCORD HOSPITAL
REDEVELOPMENT STAGE 1
HOSPITAL ROAD
CONCORD NSW 2139


TITLE
ELEVATION - IPU 1 EAST & IPU 2
WEST

DRAWING STATUS
FOR CERTIFICATION


DRAWN MW/BY	DRAWING CHECK PC/WB
DESIGNED AC/DG	DESIGN REVIEW CY
REVIEWED	DATE
APPROVED	DATE
SCALE 1:200 @ B1	
PROJECT No.	DRAWING No.
IA064700	NEWB-AR-DRG-7003
REV	J



1 IPU2 - EAST ELEVATION
1:200

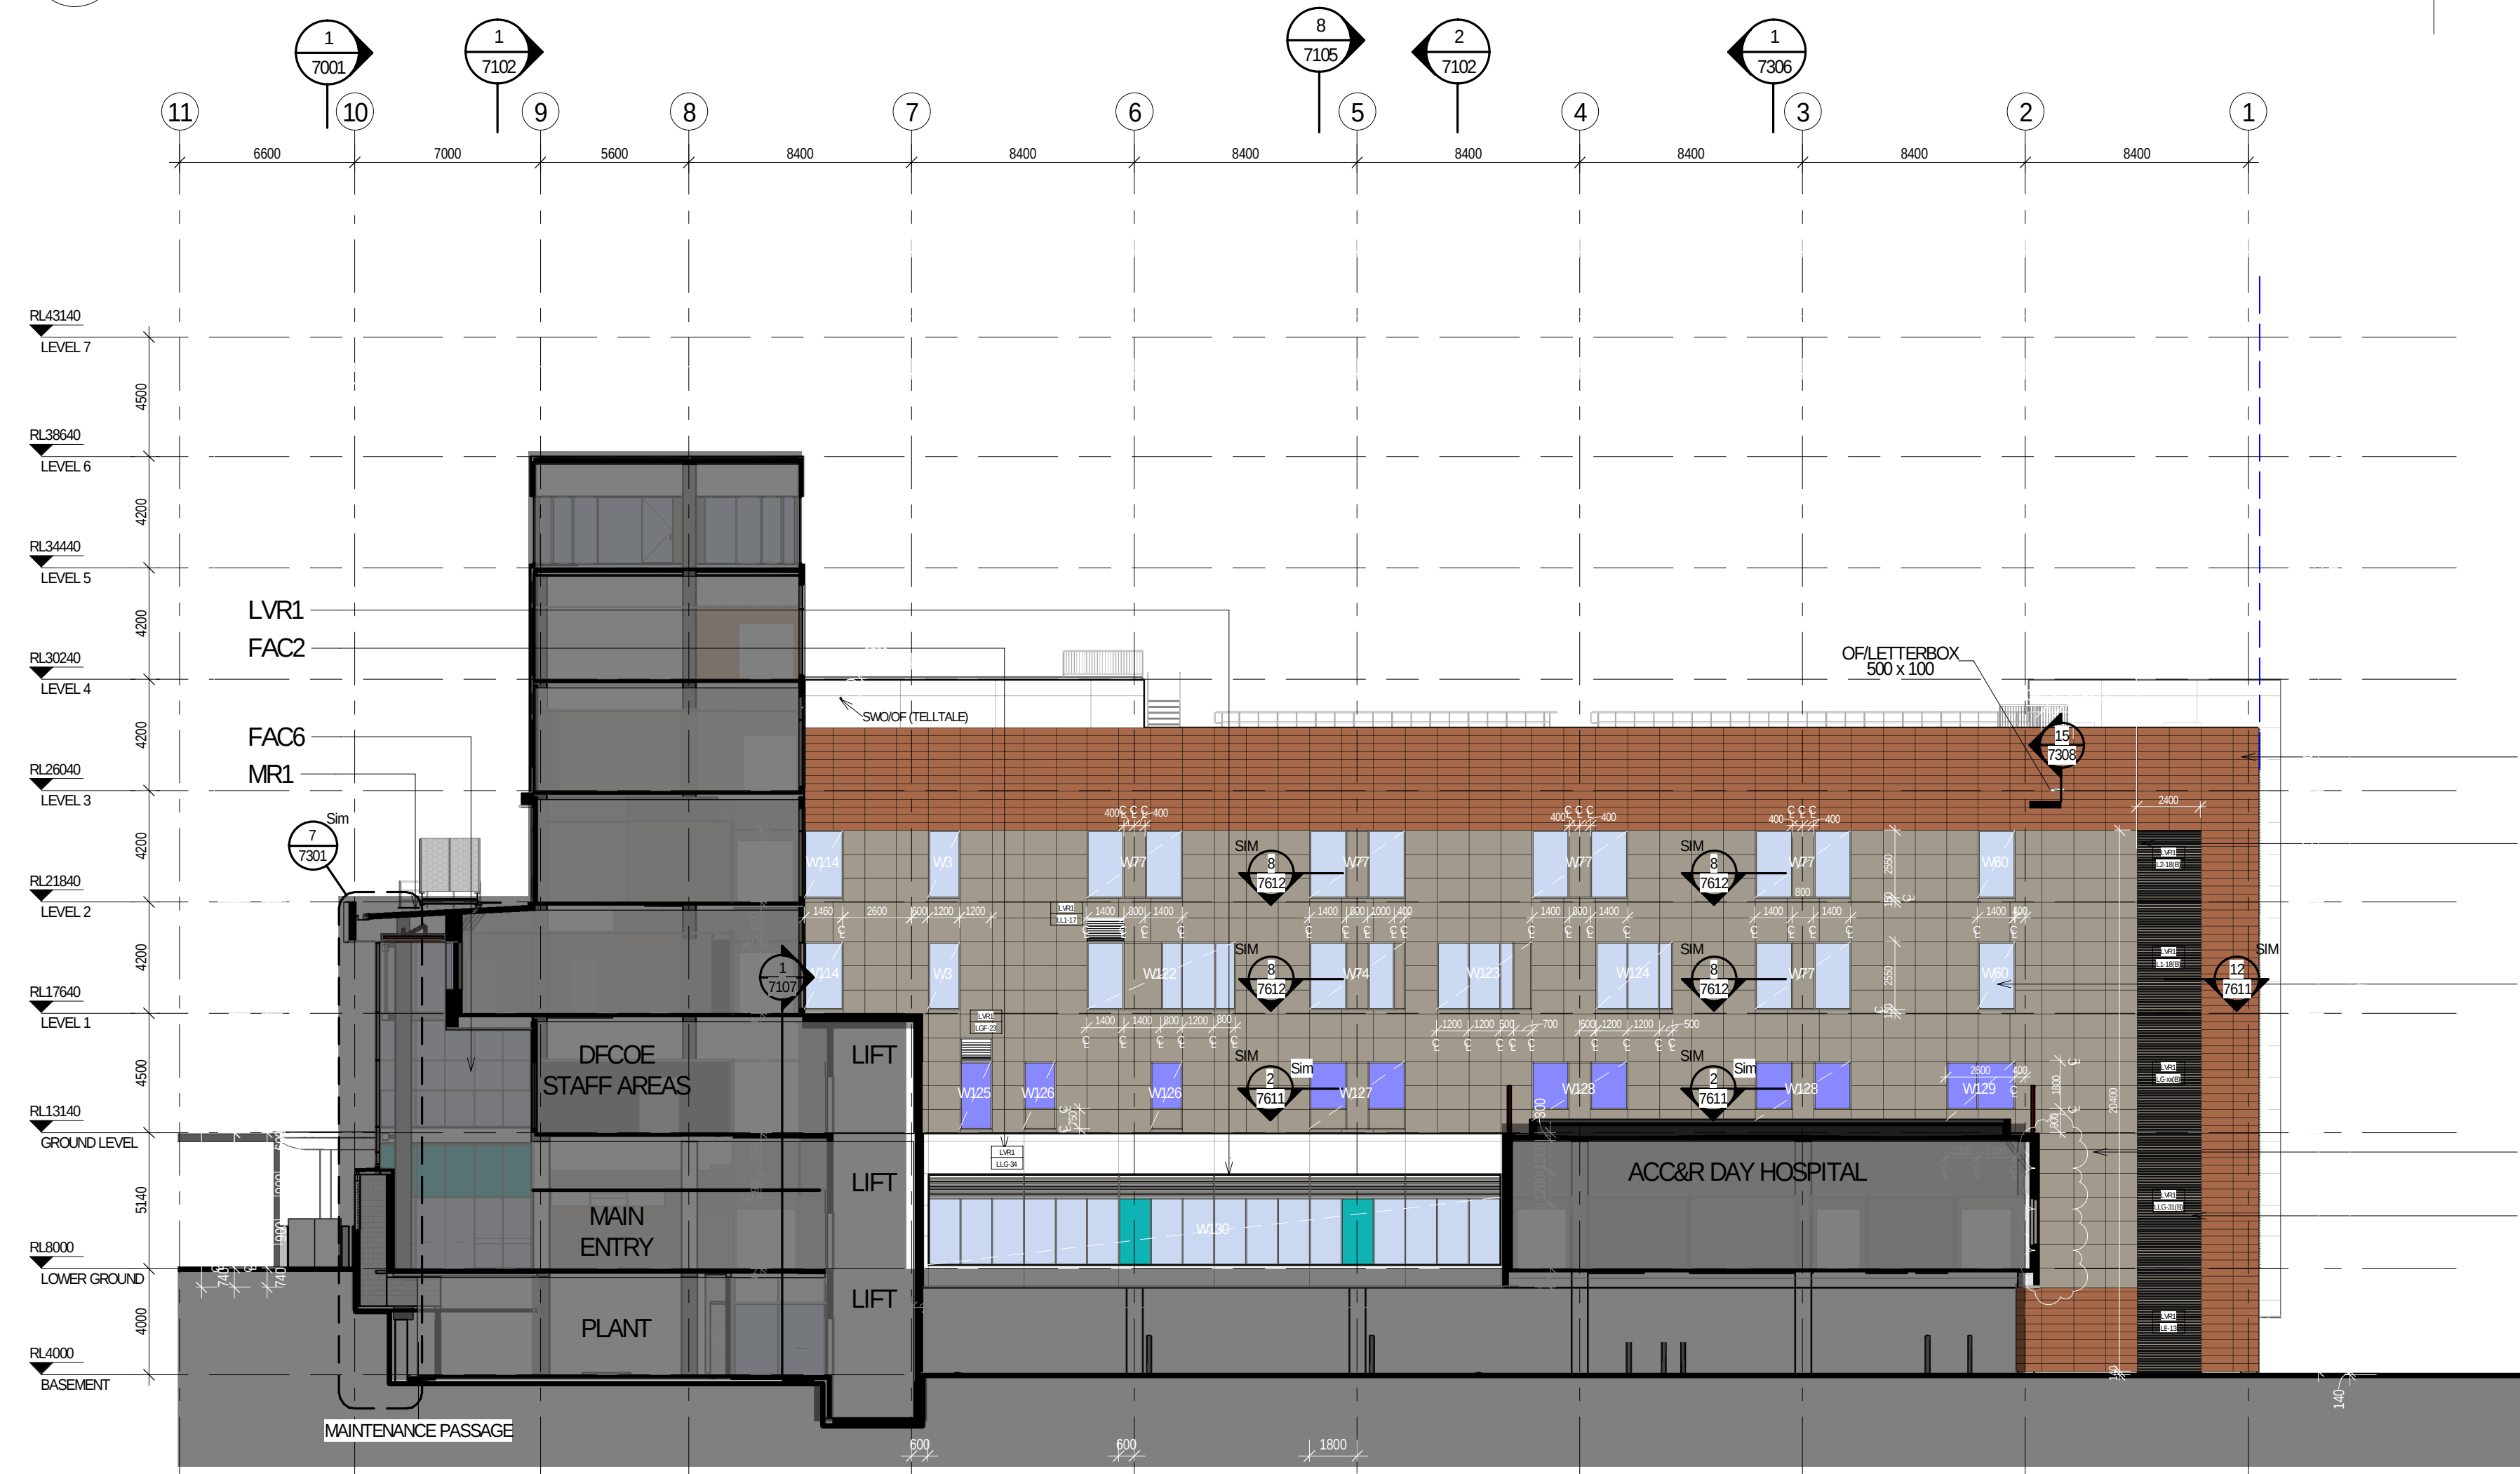

2 IPU3 - WEST ELEVATION
1:200

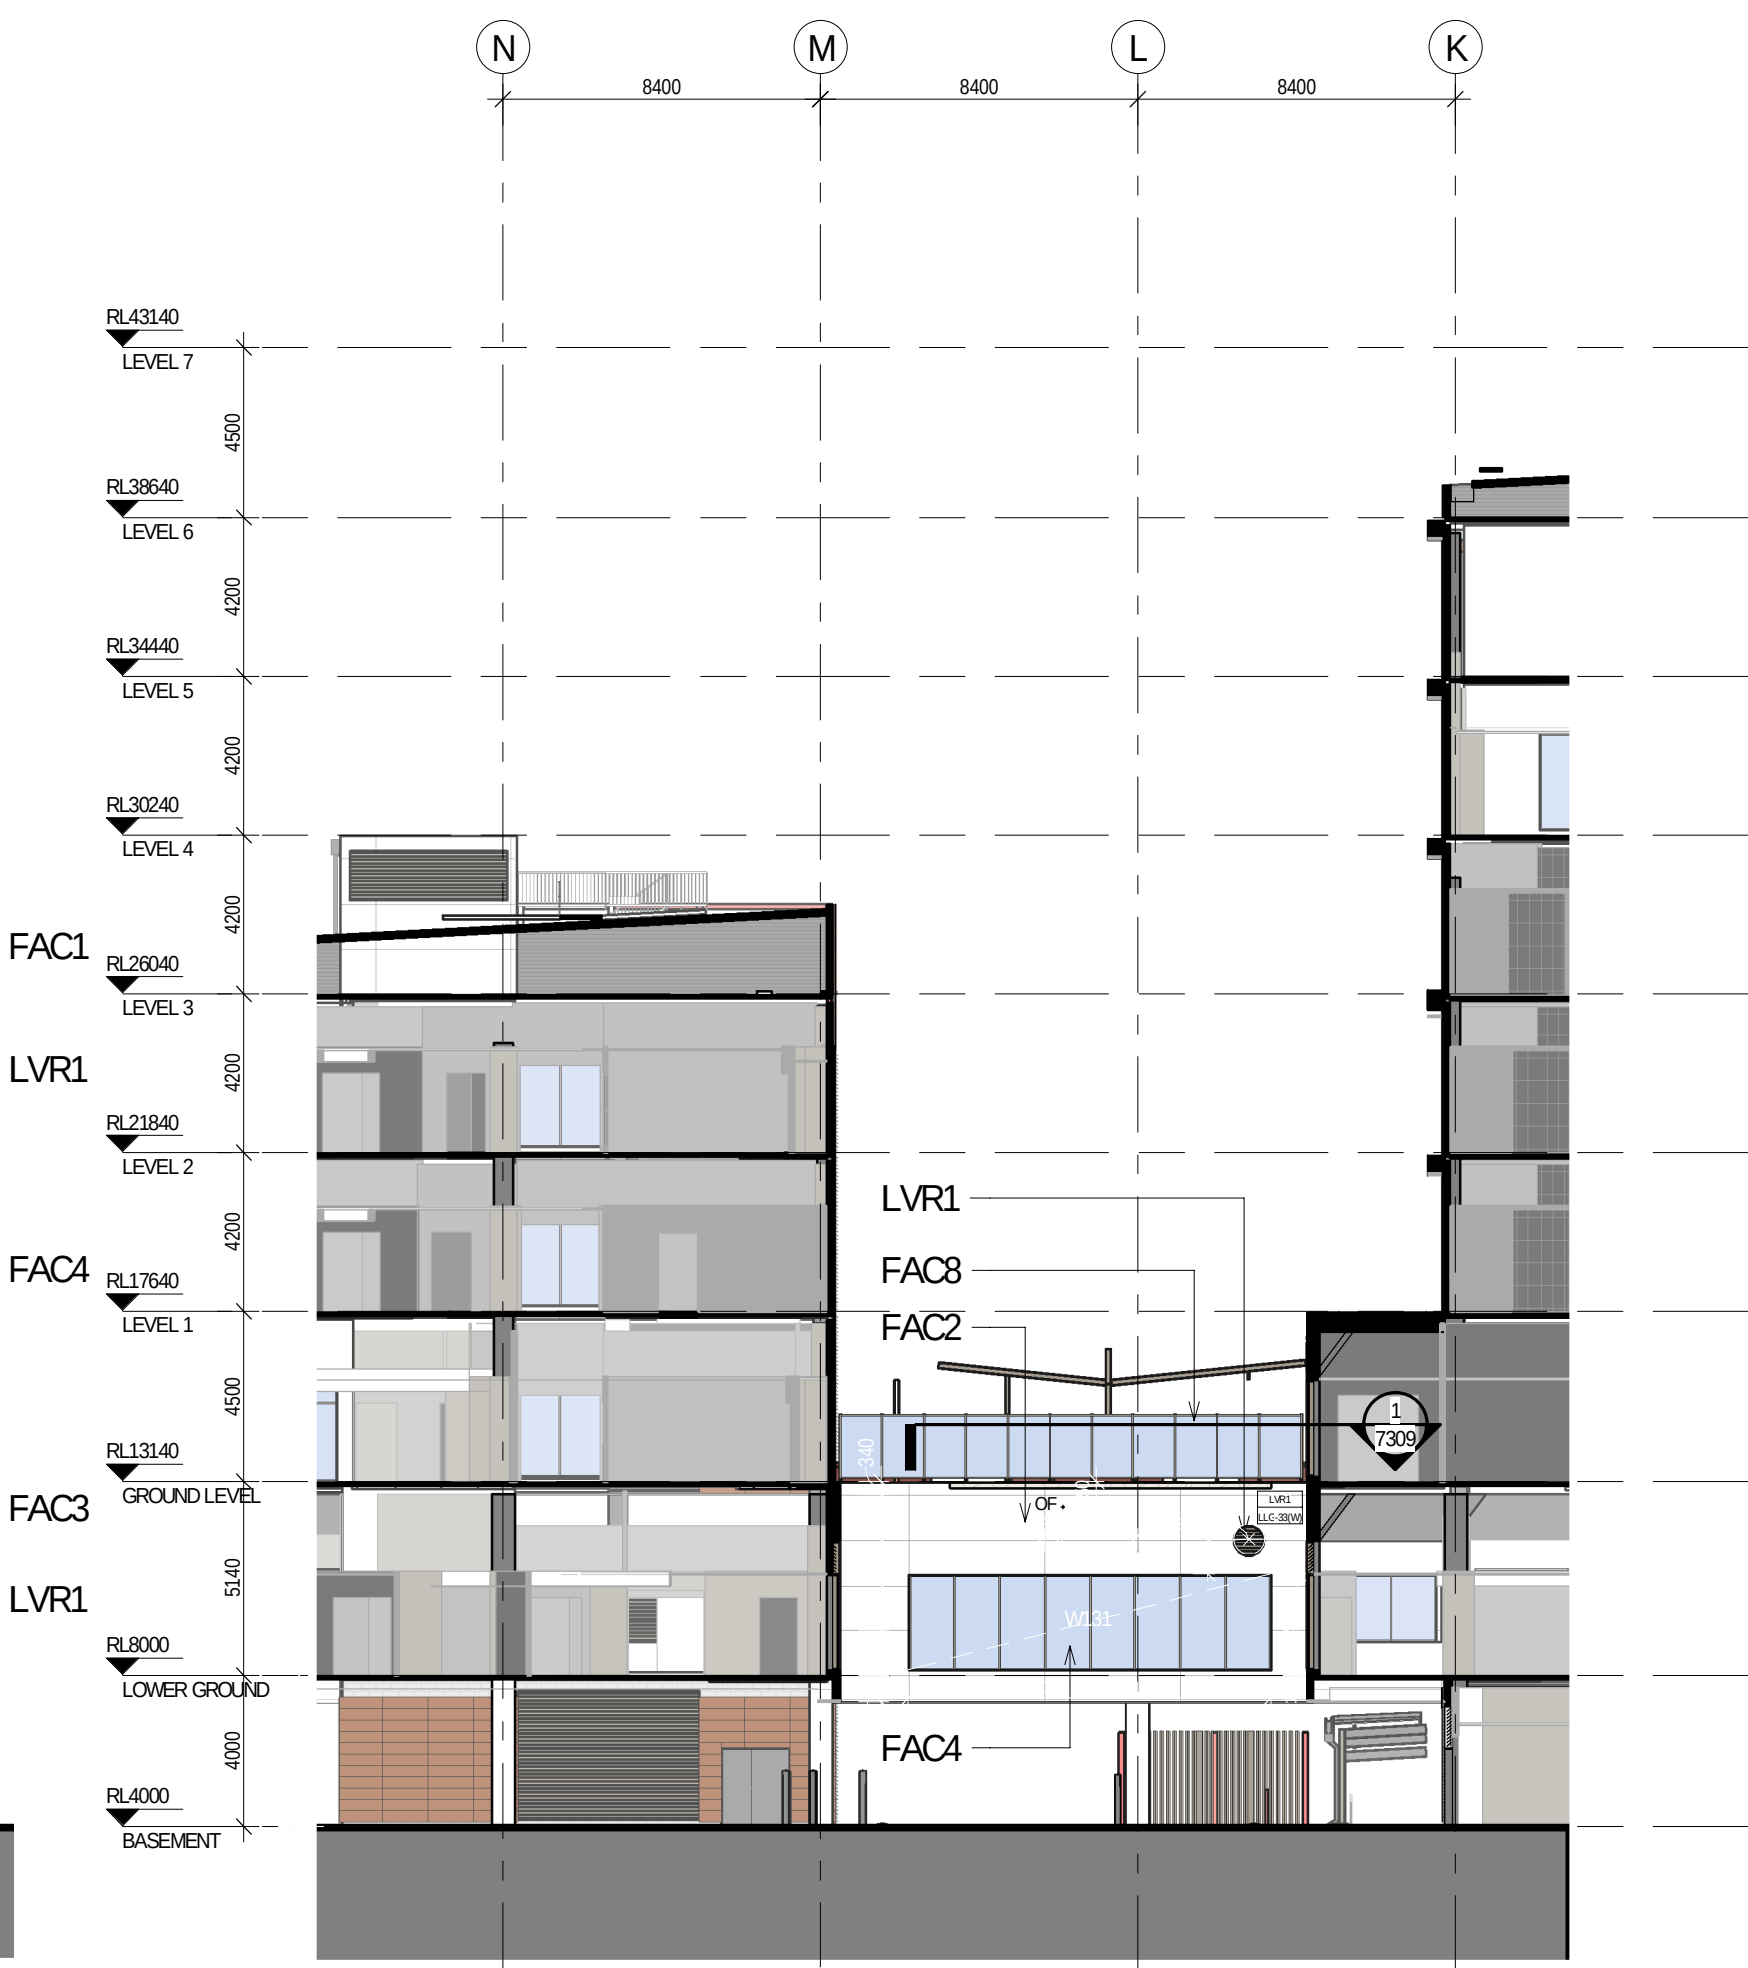

3 IPU3 - NORTH ELEVATION
1:200

LEGEND:

- TERRACOTTA
INSTALLED BY BRIGHTON
- ALUM SOLID CLADDING
INSTALLED BY BRIGHTON
- REINFORCED CONCRETE CLADDING (FIBRE C)
INSTALLED BY BRIGHTON
- ALUM. METAL LOUVRES
INSTALLED BY CVS



- FR1 FLAT ROOF, MEMBRANE WITH SELECT PAVERS/BALLAST
- MR1 METAL ROOF SHEETING WITH 100mm INSULATION ROOF RAISERS
- LVR1 HORIZONTAL LOUVRES
- LVR2 ACTUATED POWER GLASS LOUVRES
- LVR3 VERTICAL LOUVRES
- LVR4 600mm DEEP ACOUSTIC LOUVRES, HORIZONTAL

- GLAZING LEGEND:**
- GLZ1 STANDARD CLEAR SINGLE GLAZED IGUs
 - GLZ2 CLEAR SINGLE GLAZED IGUs WITH JOCKEY SASH & INTEGRAL BLINDS
 - GLZ3 TRANSLUCENT SINGLE GLAZED IGUs
 - GLZ4 WHITE OPAQUE COLOURBACK SINGLE GLAZING BACKED WITH INSULATION
 - GLZ5 GREEN OPAQUE COLOURBACK SINGLE GLAZING BACKED WITH INSULATION
 - GLZ6 CLEAR SINGLE GLAZING
 - GLZ7 STANDARD CLEAR DOUBLE GLAZED IGUs
 - GLZ8 BRONZE OPAQUE COLOURBACK SINGLE GLAZING BACKED WITH INSULATION
 - GLZ9 ASSAULT GUARD CLEAR GLAZING

DIMENSION LEGEND:

- DIMENSION SET OUT FOR METAL SHEET CLADDING (COLORBOND®) - FAC10
- DIMENSION SET OUT FOR WINDOW AND LOUVRES
- DIMENSION SET OUT FOR TERRACOTTA CLADDING - FAC1
- DIMENSION SET OUT FOR ALUMINUM NON-COMPOSITE CLADDING - FAC3
- REINFORCED CONCRETE CLADDING (FIBRE C) - FAC2
- NOTE 1 - REFER TO CURVED FACADE SETOUT PLAN DETAILS FOR FACADE AND WINDOWS SERIES 7000

REV	DATE	DRAWN	REV'D	APP'D	AMENDMENT
G	21.08.20	MM	WB		GENERAL UPDATE
F	23.04.20	LH	WB		GENERAL ELEVATION UPDATE
E	14.02.20	LH	WB		ISSUED FOR CCA
D	20.12.19	BA	WB		FACADE UPDATES - COLORBACK TO AIR LOBBY UPDATES TO NOVH AND FACADE PLAN DETAIL UPDATES (WINDOW REPOSITIONED)
C	04.12.19	BA	WB		UPDATES TO FACADE - EAST ELEVATION BANDING DETAIL UPDATE & COLORBACK GLASS REVERSED
B	08.11.19	BA	WB		GENERAL UPDATES
A	27.09.19	BA	WB		ISSUE FOR CONSTRUCTION
Z0	03.09.19	BA	WB		ELEVATIONS & DETAILS UPDATE - LOUVRES, WINDOW TAGS ADDED & GENERAL UPDATES

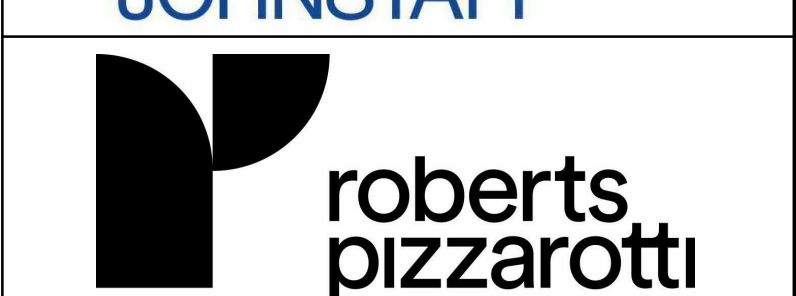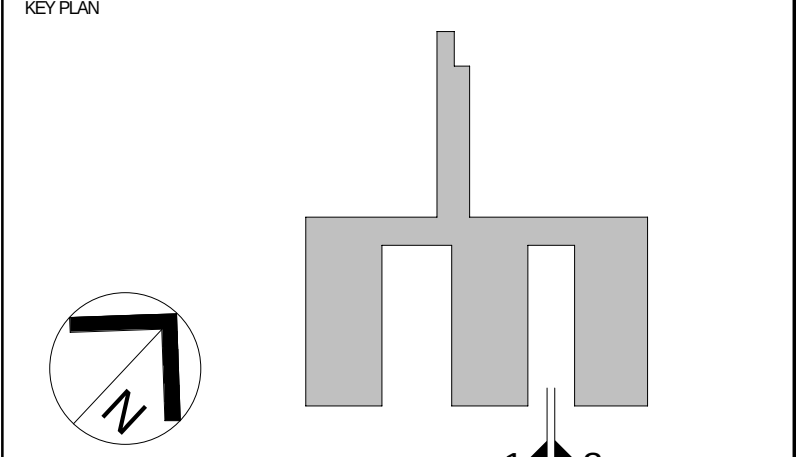

LEVEL 7, 177 PACIFIC HIGHWAY
NORTH SYDNEY
NSW 2060
AUSTRALIA

TEL: +61 2 9628 2100
FAX: +61 2 9628 2100
WEB: jacobsc.com

PROJECT
**CONCORD HOSPITAL
REDEVELOPMENT STAGE 1**

HOSPITAL ROAD
CONCORD NSW 2139

TITLE
**ELEVATION - IPU 2 EAST & IPU 3
WEST**

DRAWING STATUS
FOR CONSTRUCTION

DRAWN MM/WB	DRAWING CHECK PCMB
DESIGNED AC/DG	DESIGN REVIEW CY
REVIEWED	DATE
APPROVED	DATE
SCALE 1:200 @ B1	
PROJECT NO. IA064700	DRAWING NO. NEWB-AR-DRG-7004
REV	G