

Uecomm

To: Mr Nicholas Rouggos

201 Kent Street
Sydney, NSW, 2000



Uecomm Pty Limited
ABN 56 079 083 195

Building 8, 658 Church St,
Richmond, VIC 3121
Ph: (03) 9221 4100
Fax: (03) 9221 4193
Ah: 1800 707 447

LOCATION OF UNDERGROUND FIBRE OPTIC CABLE INFORMATION SHEET

IMPORTANT: PLEASE READ ALL INFORMATION AND CONDITIONS BELOW AND THE NOTICE ON THE REVERSE SIDE OF THE PLAN/S.

"Dial Before You Dig" Sequence No 58207257
Customer ID 1643225

Issue Date: 17/01/2017
Issue By:

Location: **Hunter Street, Sydney, NSW 2000**
Map Ref: **236E8, 236E9**
Uecomm Asset Location No. **58207257**
Dial Before You Dig Job No. **11738734**

In relation to your enquiry at the above address, Uecomm advises as follows:

The records of Uecomm Limited disclose that there ARE underground FIBRE OPTIC / TELECOMMUNICATIONS cables in the vicinity of the above enquiry as per attached plan/s.

- The underground cables referred to in this advice are defined as the underground communications cables owned or controlled by Uecomm Pty Limited.
- The person/company responsible for submitting the inquiry should take care to ensure all plans listed above have been received. For any plan listed above but not received please contact **1800 707 447**.
- Any information provided is valid only for **30 days** from the date of issue set out above.
- If the work operations extends beyond this period, or if the designs are altered in any way, you are requested to resubmit your proposal for reassessment.
- Further assistance may be obtained if necessary by telephoning **1800 707 447**.


PLEASE READ ALL INFORMATION AND DISCLAIMERS BELOW:

1. Due to the nature of underground cables and the age of some cables and records, it is impossible to conclusively ascertain the location of all cables. The accuracy and/or completeness of the information cannot be guaranteed and, accordingly, they are intended to be indicative only and, as a result, Uecomm does not accept any responsibility for any inaccuracies of its plans. They should not be solely relied upon when undertaking underground works. It is also inaccurate to assume that fibre optic cables follow straight lines and careful on-site investigations are essential to locate its exact position.
2. The following minimum clearances must be maintained:
 - 300mm when laying asset's inline, horizontal or vertical.
 - 500mm when operating vibrating equipment, e.g., jackhammers or vibrating plates.
 - 1000mm when operating mechanical excavators.
3. Due to the inherent dangers associated with excavation in the vicinity of underground cables, precautions should be taken in the undertaking of any underground works, including (but not limited to) the following:
 - All excavation sites should be examined for underground cables by careful hand excavation. Cable cover slabs if present must not be disturbed. Hand excavation needs to be undertaken with extreme care to minimise the likelihood of damage to the cable, e.g., blades of hand equipment should be orientated parallel to the line of the cable rather than digging across the cable.
 - If any undisclosed underground cables are located, Uecomm Limited should be notified immediately.
 - All personnel must be properly briefed, particularly those associated with the use of earthmoving equipment, trenching, boring and pneumatic equipment.
 - All excavations must be undertaken in accordance with the relevant legislation and regulations.


4. **DAMAGE. ANY DAMAGE TO UECOMM'S NETWORK MUST BE REPORTED IMMEDIATELY TO 1800 707 447.**
5. Uecomm recommends using Uecomm approved location contractors to provide on-site location services for Uecomm plant. You can arrange Uecomm on-site visits by calling Uecomm on 1800 707 447 and Uecomm or its approved representative will attend your site to provide guidance to the location of the Uecomm assets (the "*Uecomm Asset Alignment*"). **Uecomm requires 3 clear business days notice to conduct an on-site location.** The initial on-site visit by Uecomm will not normally incur a charge, but at the discretion of Uecomm, subsequent site visits may incur a charge to be applied at an hourly rate.
6. Uecomm will hold the relevant party responsible for any damage to Uecomm plant and all expenses incurred by Uecomm as a result of asset damage.
7. Except to the extent that liability may not be capable of lawful exclusion, Uecomm Pty Limited and its servants and agents and the related bodies corporate of Uecomm Pty Limited and their servants and agents shall be under no liability whatsoever to any person for any loss or damage (including indirect or consequential loss or damage) however caused (including, without limitation, breach of contract negligence and/or breach of statute) which may be suffered or incurred from or in connection with this information sheet or any Plans attached hereto. Except as expressly provided to the contrary in this information sheet or the attached Plans, all terms, conditions, warranties, undertakings or representations (whether expressed or implied) are excluded to the fullest extent permitted by law.

We thank you for your enquiry and appreciate your continued use of the Dial Before You Dig Service and/or Uecomm Asset Analysis Service. If you require further information please contact Uecomm on **1800 707 447**.

IMPORTANT *This document may be confidential and privileged. Unauthorised use is prohibited. If you have it in error, please notify us and shred this document. Thank you.*

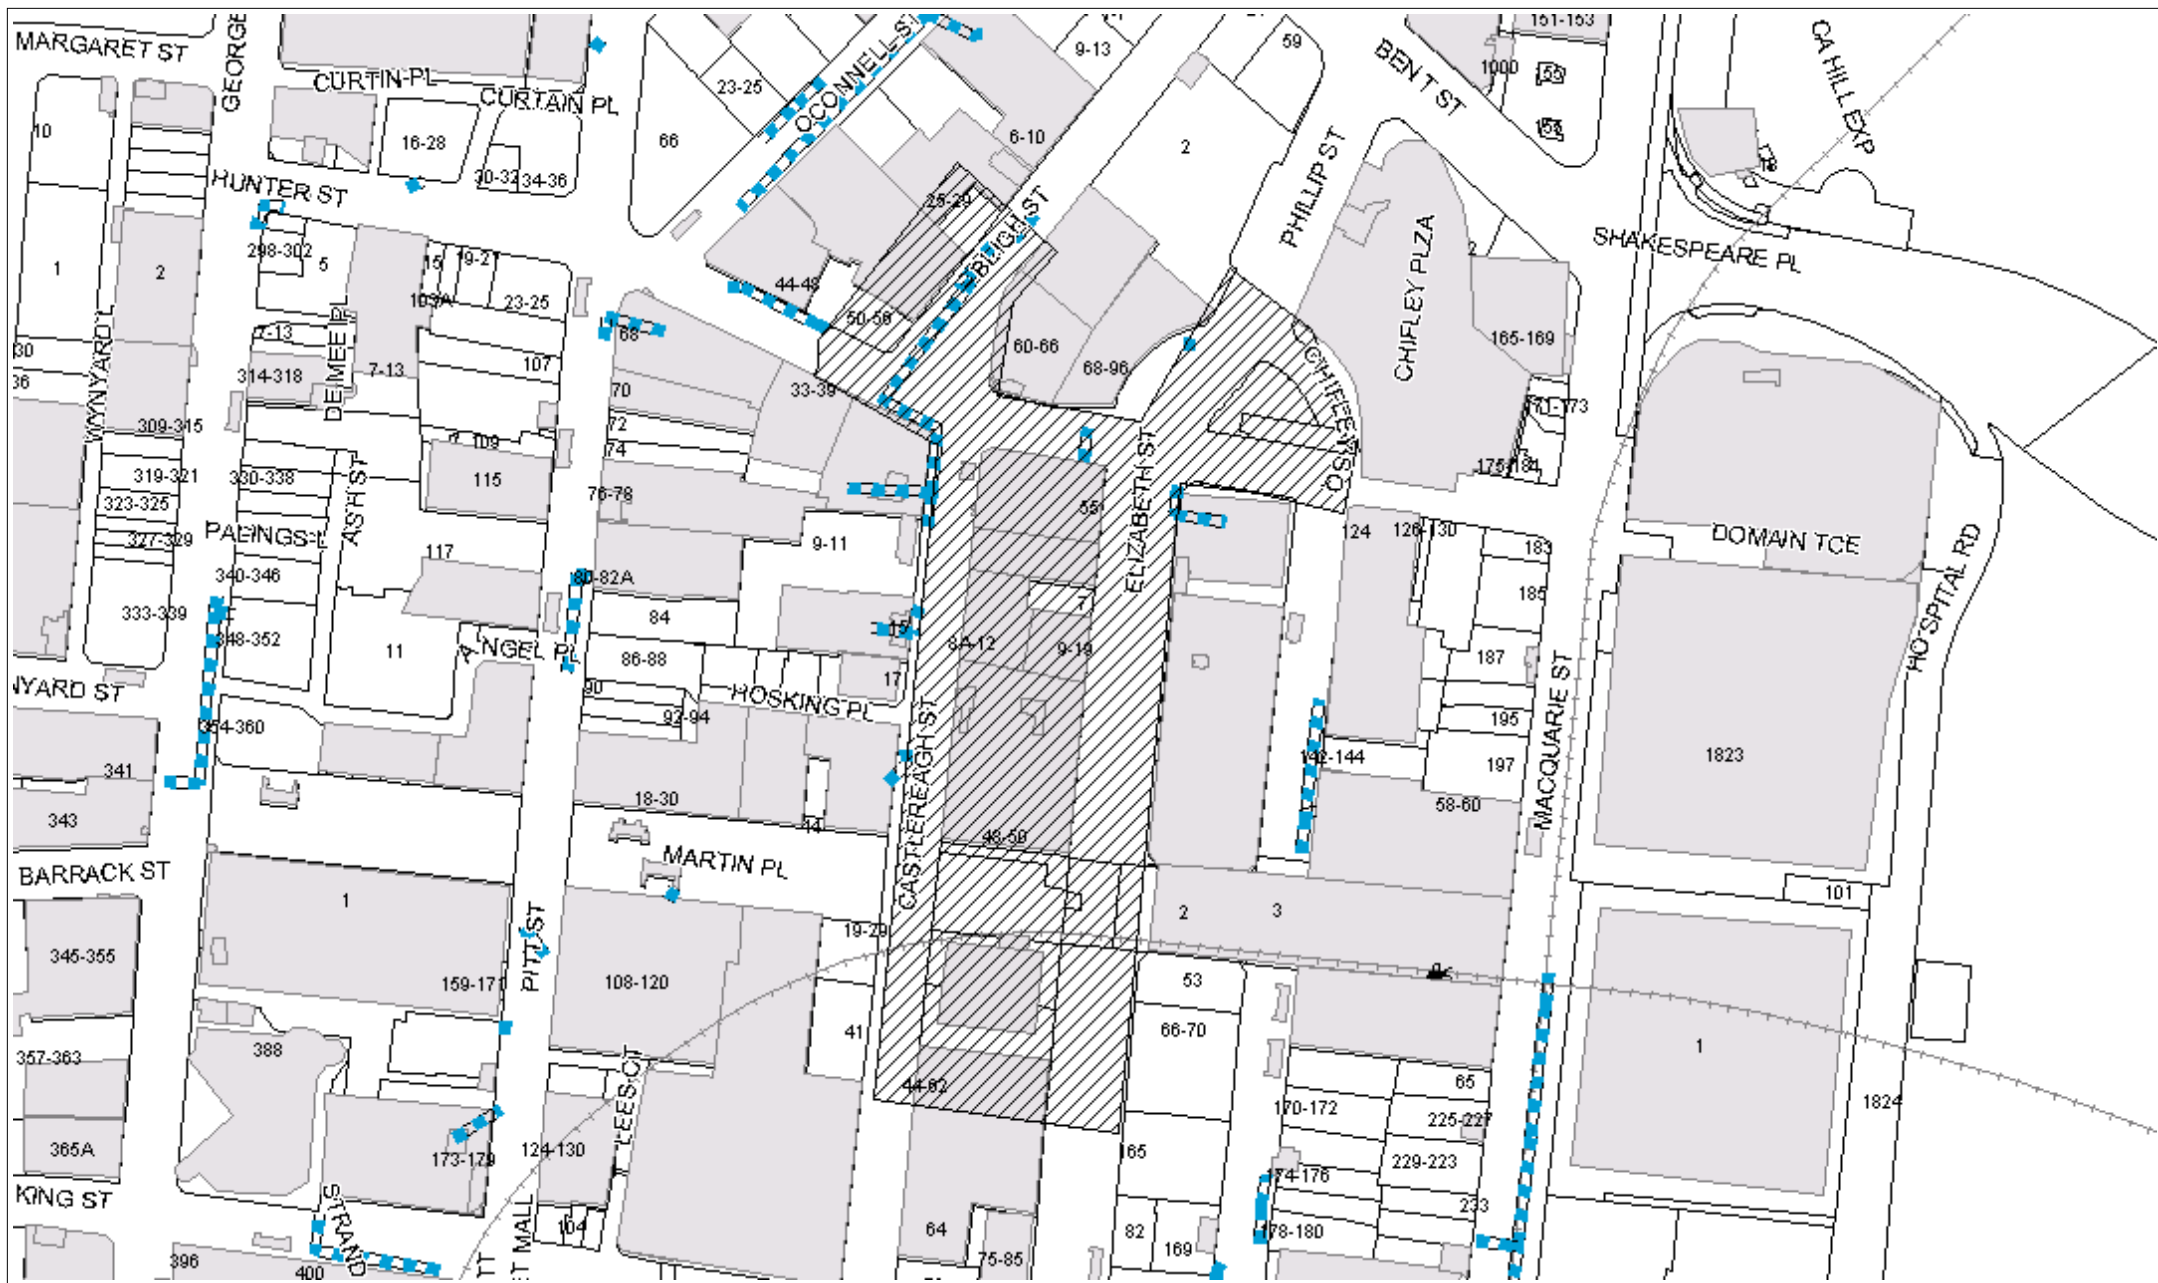

Job Location

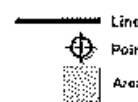

Underground Asset



To: Mr Nicholas Rouggos

201 Kent Street
Sydney, NSW, 2000



Uecomm Pty Limited
ABN 56 079 083 195

Building 8, 658 Church St,
Richmond, VIC 3121
Ph: (03) 9221 4100
Fax: (03) 9221 4193
Ah: 1800 707 447

LOCATION OF UNDERGROUND FIBRE OPTIC CABLE INFORMATION SHEET

IMPORTANT: PLEASE READ ALL INFORMATION AND CONDITIONS BELOW AND THE NOTICE ON THE REVERSE SIDE OF THE PLAN/S.

"Dial Before You Dig" Sequence No 58207257
Customer ID 1643225

Issue Date: 17/01/2017
Issue By:

Location: **Hunter Street, Sydney, NSW 2000**
Map Ref: **236E8, 236E9**
Uecomm Asset Location No. **58207257**
Dial Before You Dig Job No. **11738734**

In relation to your enquiry at the above address, Uecomm advises as follows:

The records of Uecomm Limited disclose that there ARE underground FIBRE OPTIC / TELECOMMUNICATIONS cables in the vicinity of the above enquiry as per attached plan/s.

- The underground cables referred to in this advice are defined as the underground communications cables owned or controlled by Uecomm Pty Limited.
- The person/company responsible for submitting the inquiry should take care to ensure all plans listed above have been received. For any plan listed above but not received please contact **1800 707 447**.
- Any information provided is valid only for **30 days** from the date of issue set out above.
- If the work operations extends beyond this period, or if the designs are altered in any way, you are requested to resubmit your proposal for reassessment.
- Further assistance may be obtained if necessary by telephoning **1800 707 447**.

PLEASE READ ALL INFORMATION AND DISCLAIMERS BELOW:

1. Due to the nature of underground cables and the age of some cables and records, it is impossible to conclusively ascertain the location of all cables. The accuracy and/or completeness of the information cannot be guaranteed and, accordingly, they are intended to be indicative only and, as a result, Uecomm does not accept any responsibility for any inaccuracies of its plans. They should not be solely relied upon when undertaking underground works. It is also inaccurate to assume that fibre optic cables follow straight lines and careful on-site investigations are essential to locate its exact position.
2. The following minimum clearances must be maintained:
 - 300mm when laying asset's inline, horizontal or vertical.
 - 500mm when operating vibrating equipment, e.g., jackhammers or vibrating plates.
 - 1000mm when operating mechanical excavators.
3. Due to the inherent dangers associated with excavation in the vicinity of underground cables, precautions should be taken in the undertaking of any underground works, including (but not limited to) the following:
 - All excavation sites should be examined for underground cables by careful hand excavation. Cable cover slabs if present must not be disturbed. Hand excavation needs to be undertaken with extreme care to minimise the likely hood of damage to the cable, e.g., blades of hand equipment should be orientated parallel to the line of the cable rather than digging across the cable.
 - If any undisclosed underground cables are located, Uecomm Limited should be notified immediately.
 - All personnel must be properly briefed, particularly those associated with the use of earthmoving equipment, trenching, boring and pneumatic equipment.
 - All excavations must be undertaken in accordance with the relevant legislation and regulations.



4. **DAMAGE. ANY DAMAGE TO UECOMM'S NETWORK MUST BE REPORTED IMMEDIATELY TO 1800 707 447.**
5. Uecomm recommends using Uecomm approved location contractors to provide on-site location services for Uecomm plant. You can arrange Uecomm on-site visits by calling Uecomm on 1800 707 447 and Uecomm or its approved representative will attend your site to provide guidance to the location of the Uecomm assets (the "*Uecomm Asset Alignment*"). **Uecomm requires 3 clear business days notice to conduct an on-site location.** The initial on-site visit by Uecomm will not normally incur a charge, but at the discretion of Uecomm, subsequent site visits may incur a charge to be applied at an hourly rate.
6. Uecomm will hold the relevant party responsible for any damage to Uecomm plant and all expenses incurred by Uecomm as a result of asset damage.
7. Except to the extent that liability may not be capable of lawful exclusion, Uecomm Pty Limited and its servants and agents and the related bodies corporate of Uecomm Pty Limited and their servants and agents shall be under no liability whatsoever to any person for any loss or damage (including indirect or consequential loss or damage) however caused (including, without limitation, breach of contract negligence and/or breach of statute) which may be suffered or incurred from or in connection with this information sheet or any Plans attached hereto. Except as expressly provided to the contrary in this information sheet or the attached Plans, all terms, conditions, warranties, undertakings or representations (whether expressed or implied) are excluded to the fullest extent permitted by law.

We thank you for your enquiry and appreciate your continued use of the Dial Before You Dig Service and/or Uecomm Asset Analysis Service. If you require further information please contact Uecomm on **1800 707 447**.

IMPORTANT *This document may be confidential and privileged. Unauthorised use is prohibited. If you have it in error, please notify us and shred this document. Thank you.*

LEGEND

- - ELECTRICITY POLE
- - FIBRE OPTIC CABLE
- - - CABLE CONDUIT
- - UE P5 PIT
- - UE P6 PIT
- BL - BUILDING LINE
- BOK - BACK OF KERB
- CL - CENTRELINE OF CONDUIT
- TP - TURNING POINT OF CONDUIT
- - - FENCE LINE
- ◼ - TELSTRA MANHOLE
- (T) - TELSTRA PIT

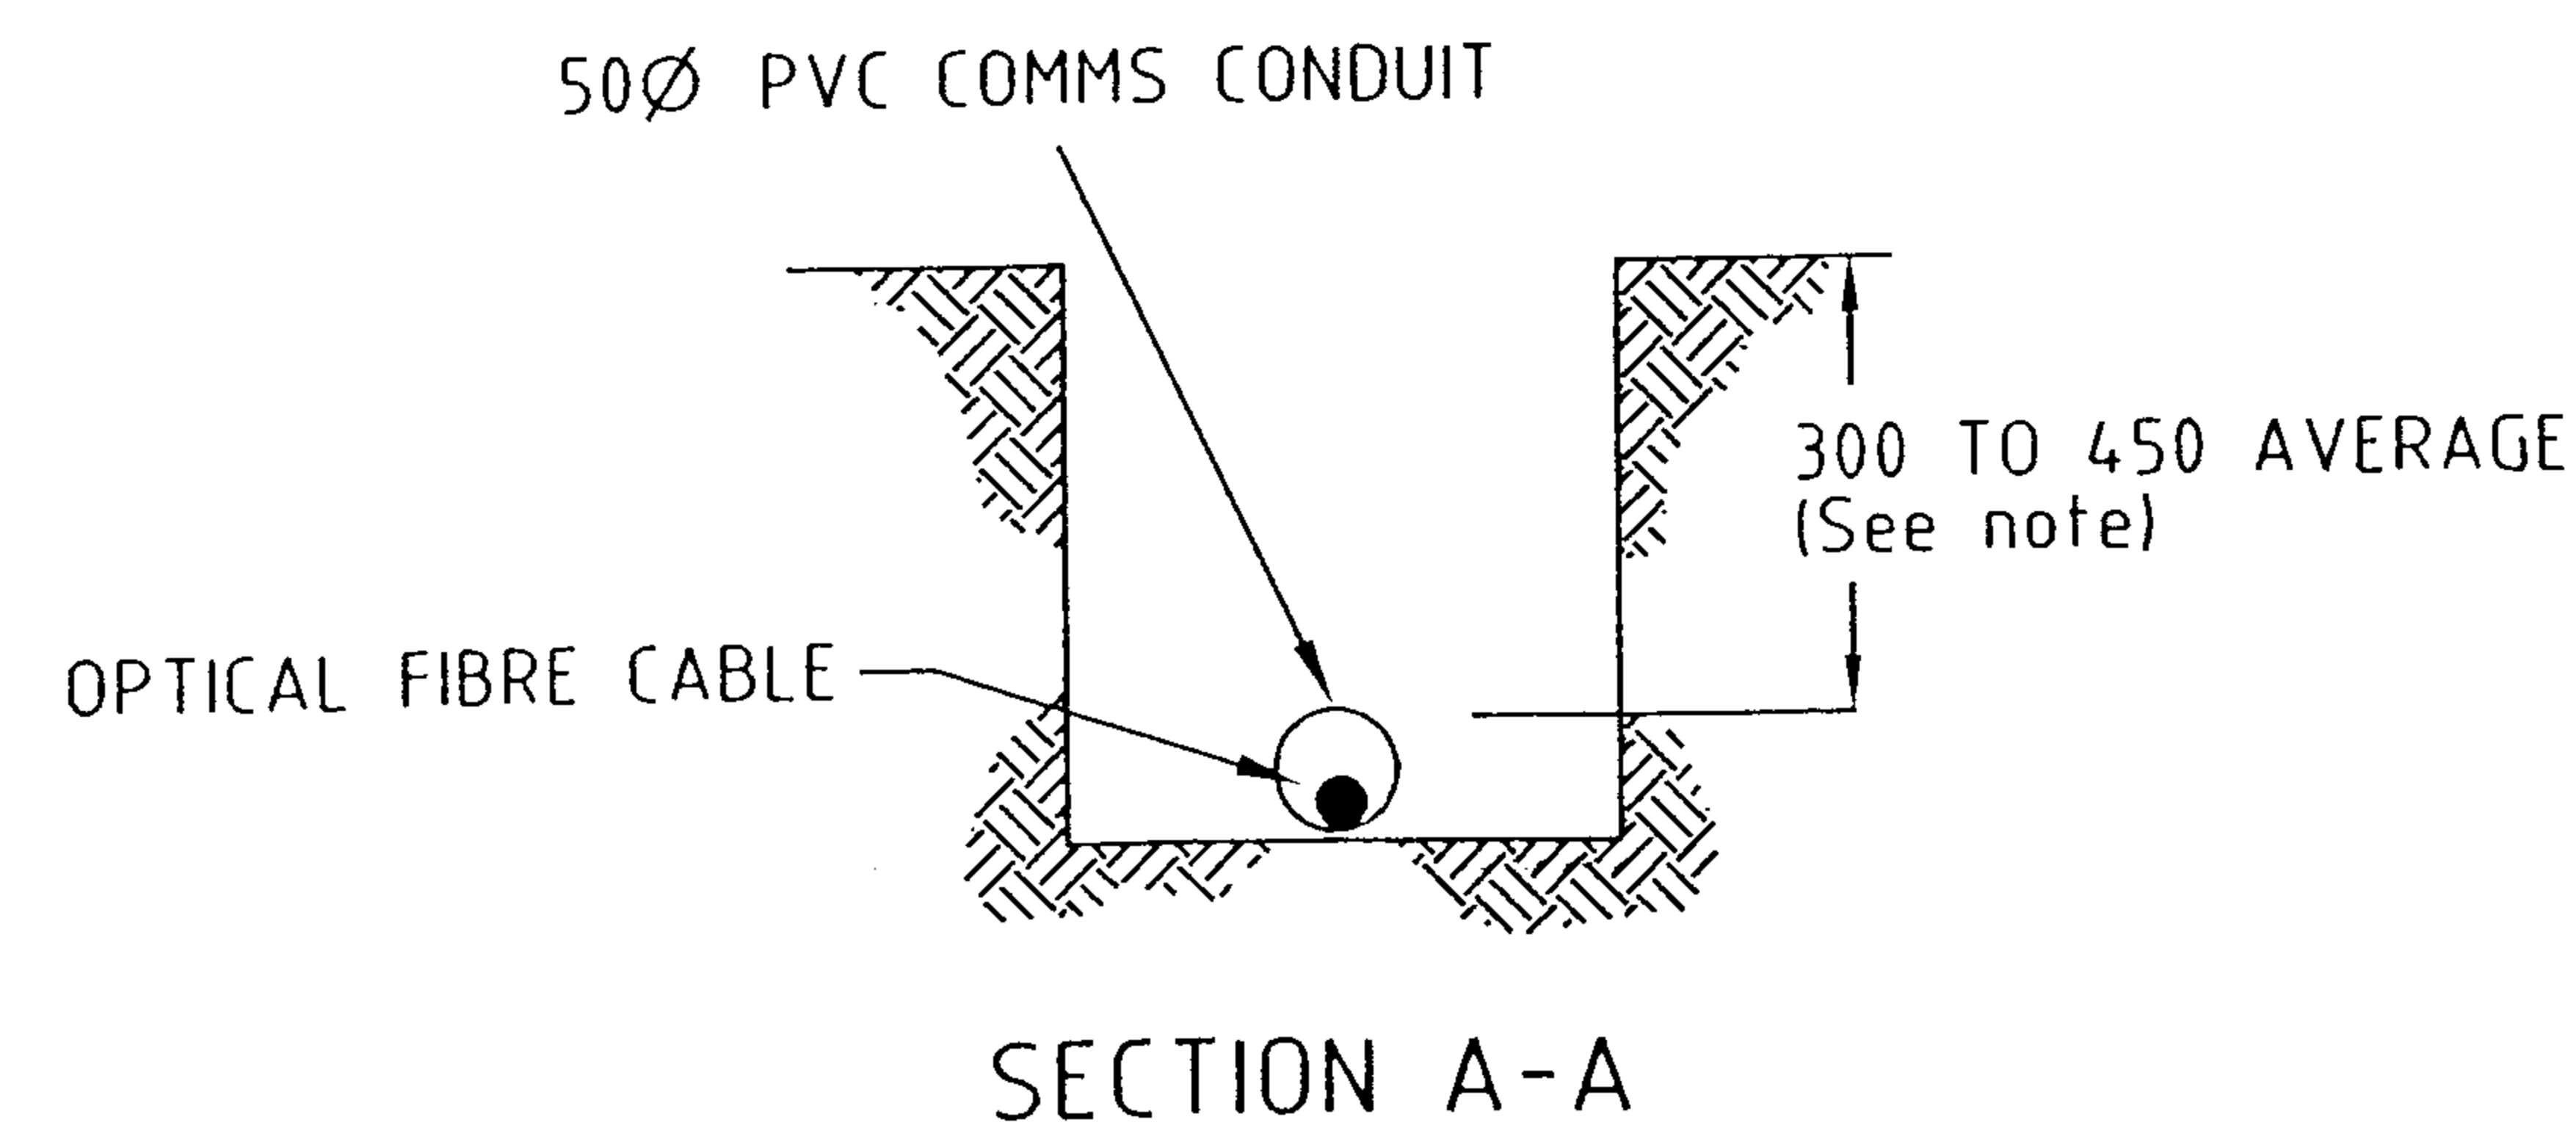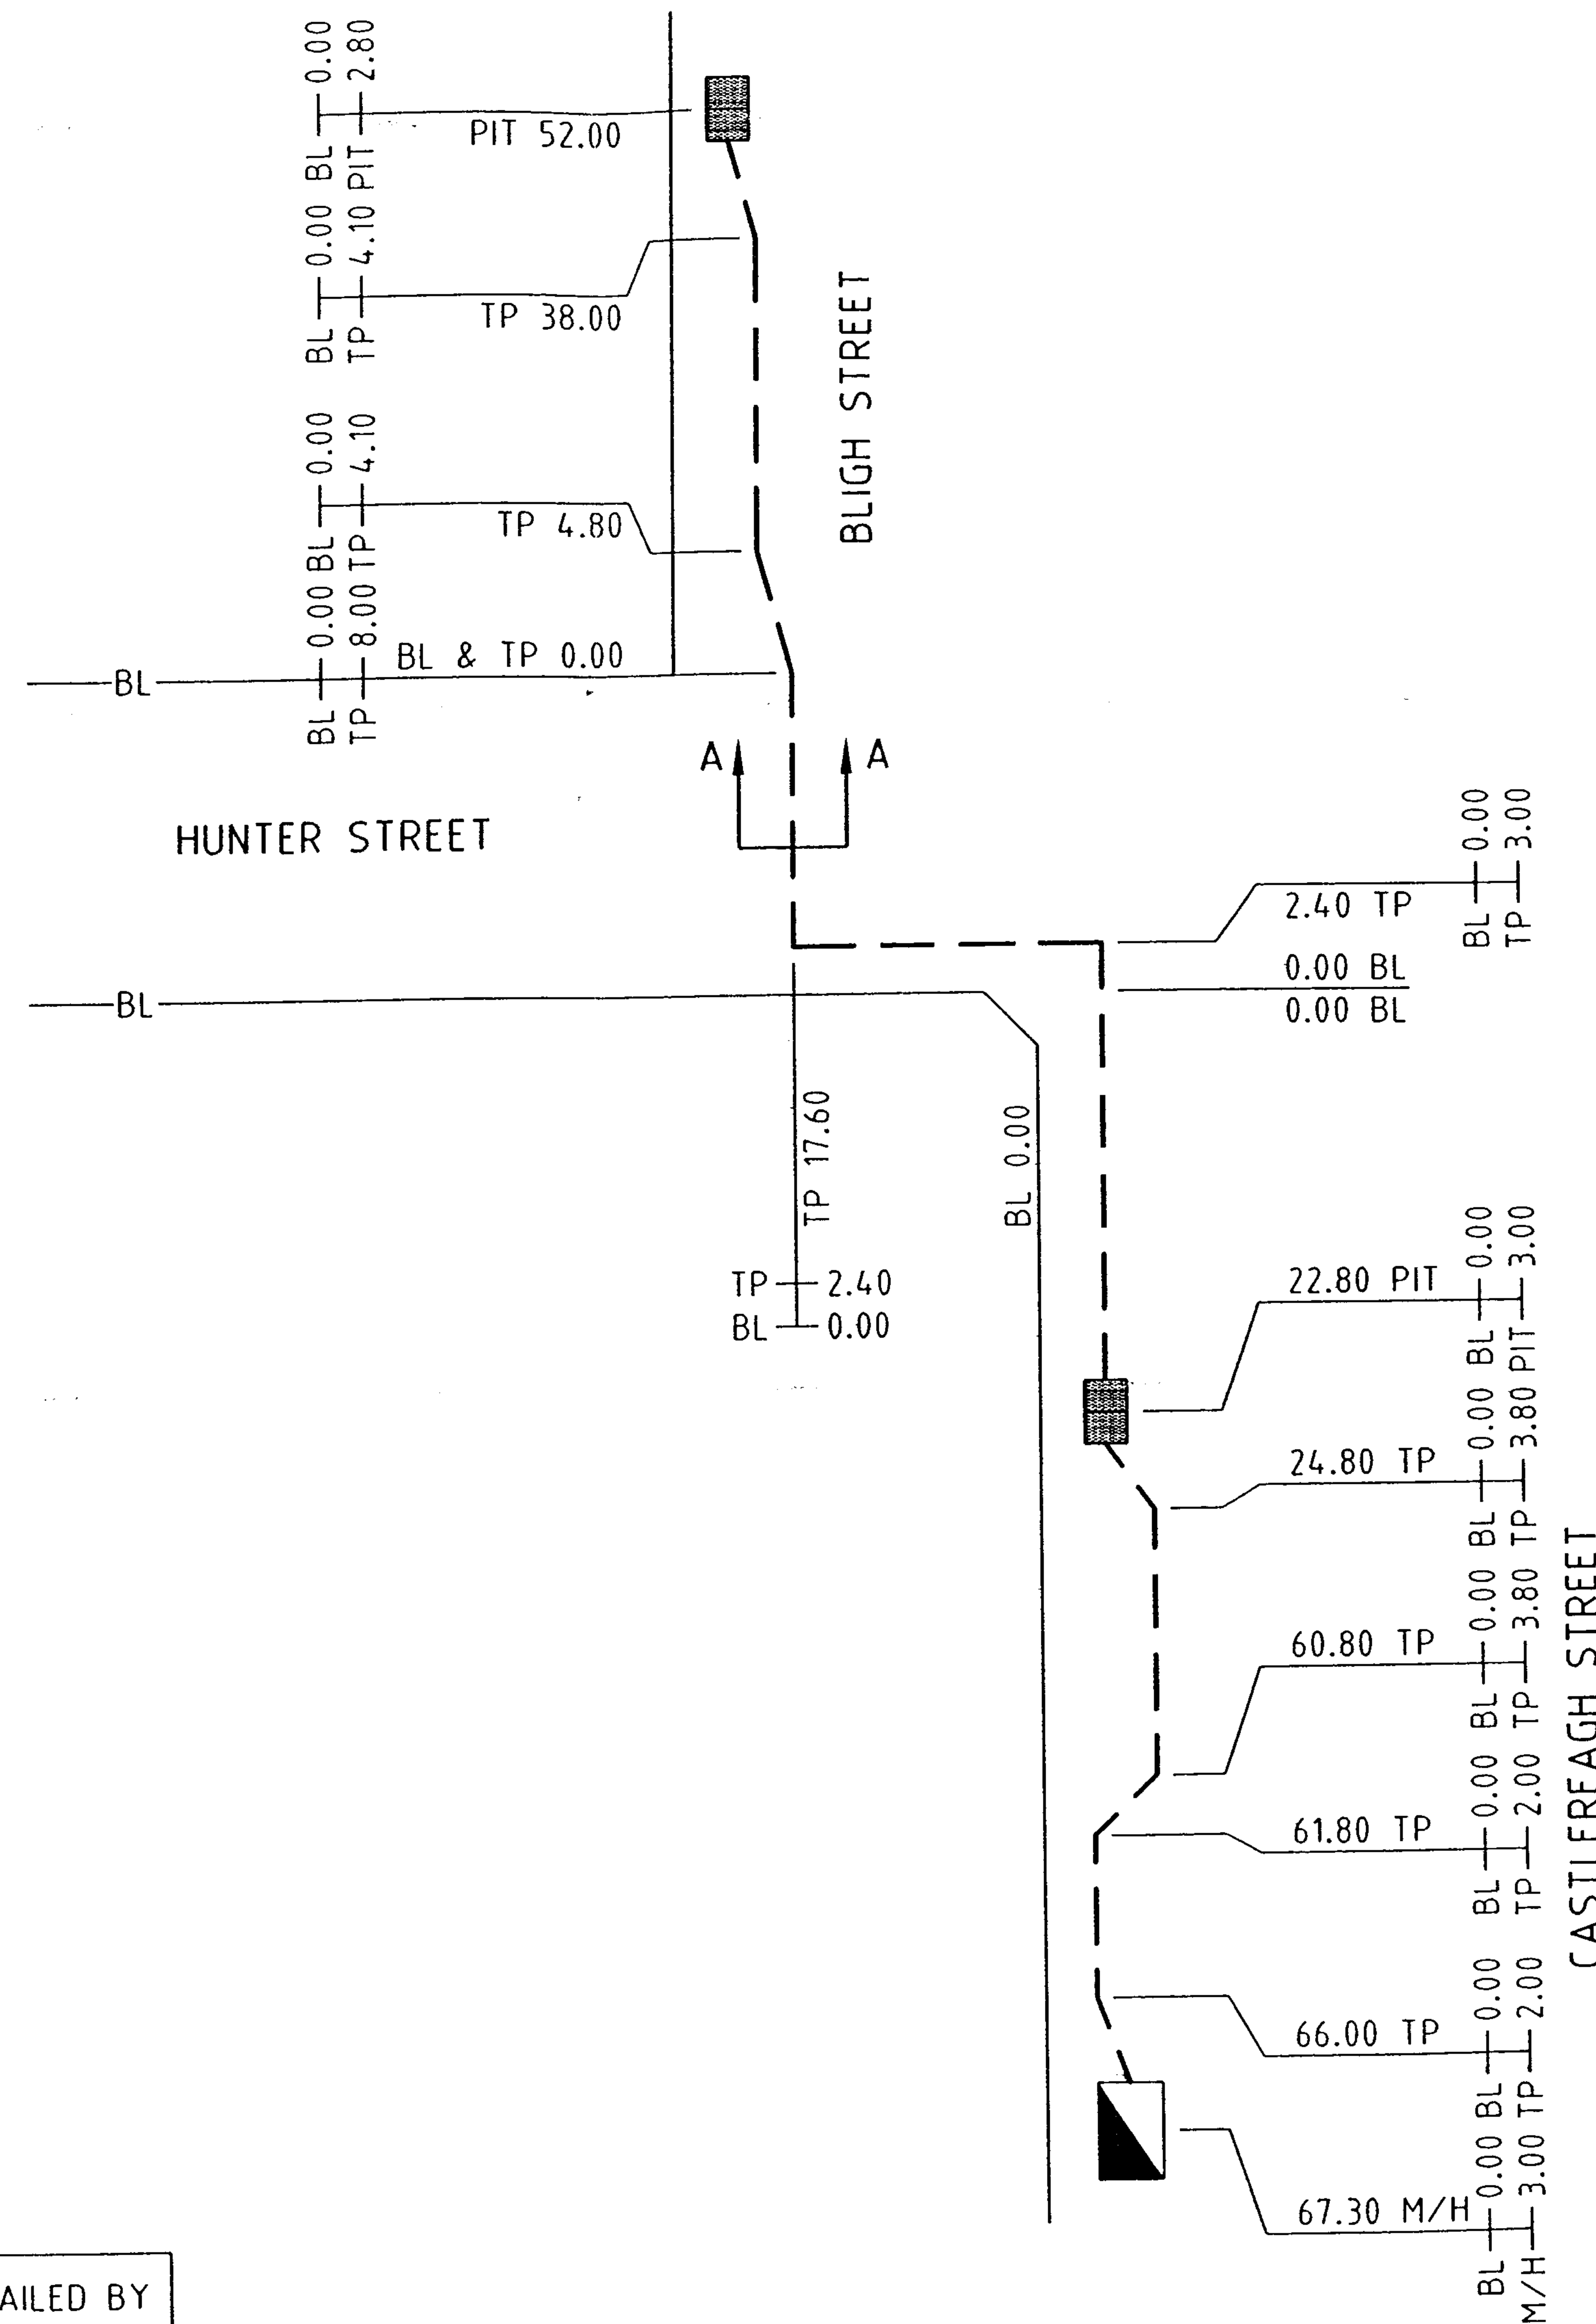

Note:
Conduit depths quoted are approximate only and may change due to unforeseen circumstances.
Excavate by hand until conduit depth is determined.

* DETAILED BY
RITEBORE

DRAWING NOT TO SCALE

REV	DESCRIPTION	DATE	DRN	CKD
-	ISSUED FOR APPROVAL - UE.COMM	17.08.01	ALS	

Civil Contractor :
RITEBORE
PTY LTD.
ACN 079 783 903

Drawn A.L.S. 16.08.01	Design Checked
Approved	Melways Ref. 263 E8 (SYDNEY UBD)
Council:	
Shire:	


Bayside
Bayside Drafting
Australia Pty. Ltd.
ABN 56 065 169 931
Telephone: (03) 9781 4011
Fax: (03) 9781 1653
Email: bdvic@baysidegrp.com.au

Uecom
MAKING THE CONNECTION
ACN 079 083 195

UNDERGROUND OPTICAL FIBRE CABLE RUN
TELSTRA MANHOLE TO UE PIT
CASTLEREAGH, HUNTER & BLIGH STREETS
SYDNEY 2000
DRAWING NUMBER **OFN5/SYD/2050**
REV. -


LEGEND

- ELECTRICITY POLE
- O/H FIBRE OPTIC CABLE
- CABLE CONDUIT (TRENCHING)
- CABLE CONDUIT (BORE TUNNELLING)
- UE P2 PIT
- UE P5 PIT
- UE P6 PIT
- UE P8 PIT
- UE P9 PIT
- BUILDING LINE
- BACK OF KERB
- CENTRELINE OF CONDUIT
- TURNING POINT OF CONDUIT
- FENCE LINE, FL
- TELSTRA MANHOLE
- TELSTRA PIT
- OPTICAL FIBRE JOINT
- JOINT LOOP (m) - POLE / UNDERGROUND
- CABLE HEAD POLE
- CABLE DEPTH

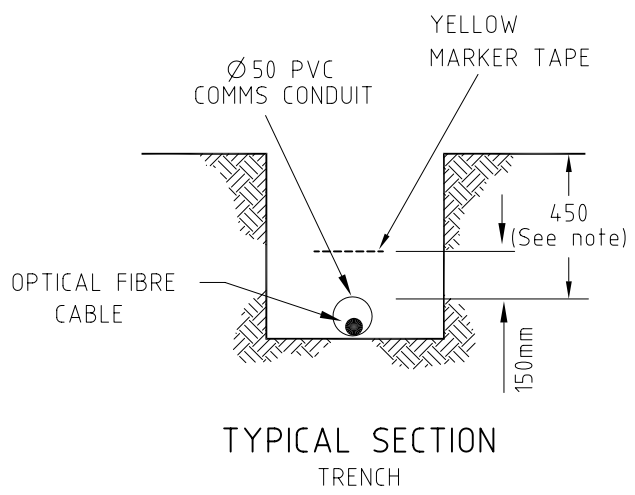

Note:

- Conduit depths quoted are approximate only and may change due to unforeseen circumstances.
- In all instances it is recommended that the position of conduits & cables should be proved on site by hand, prior to commencement of works.

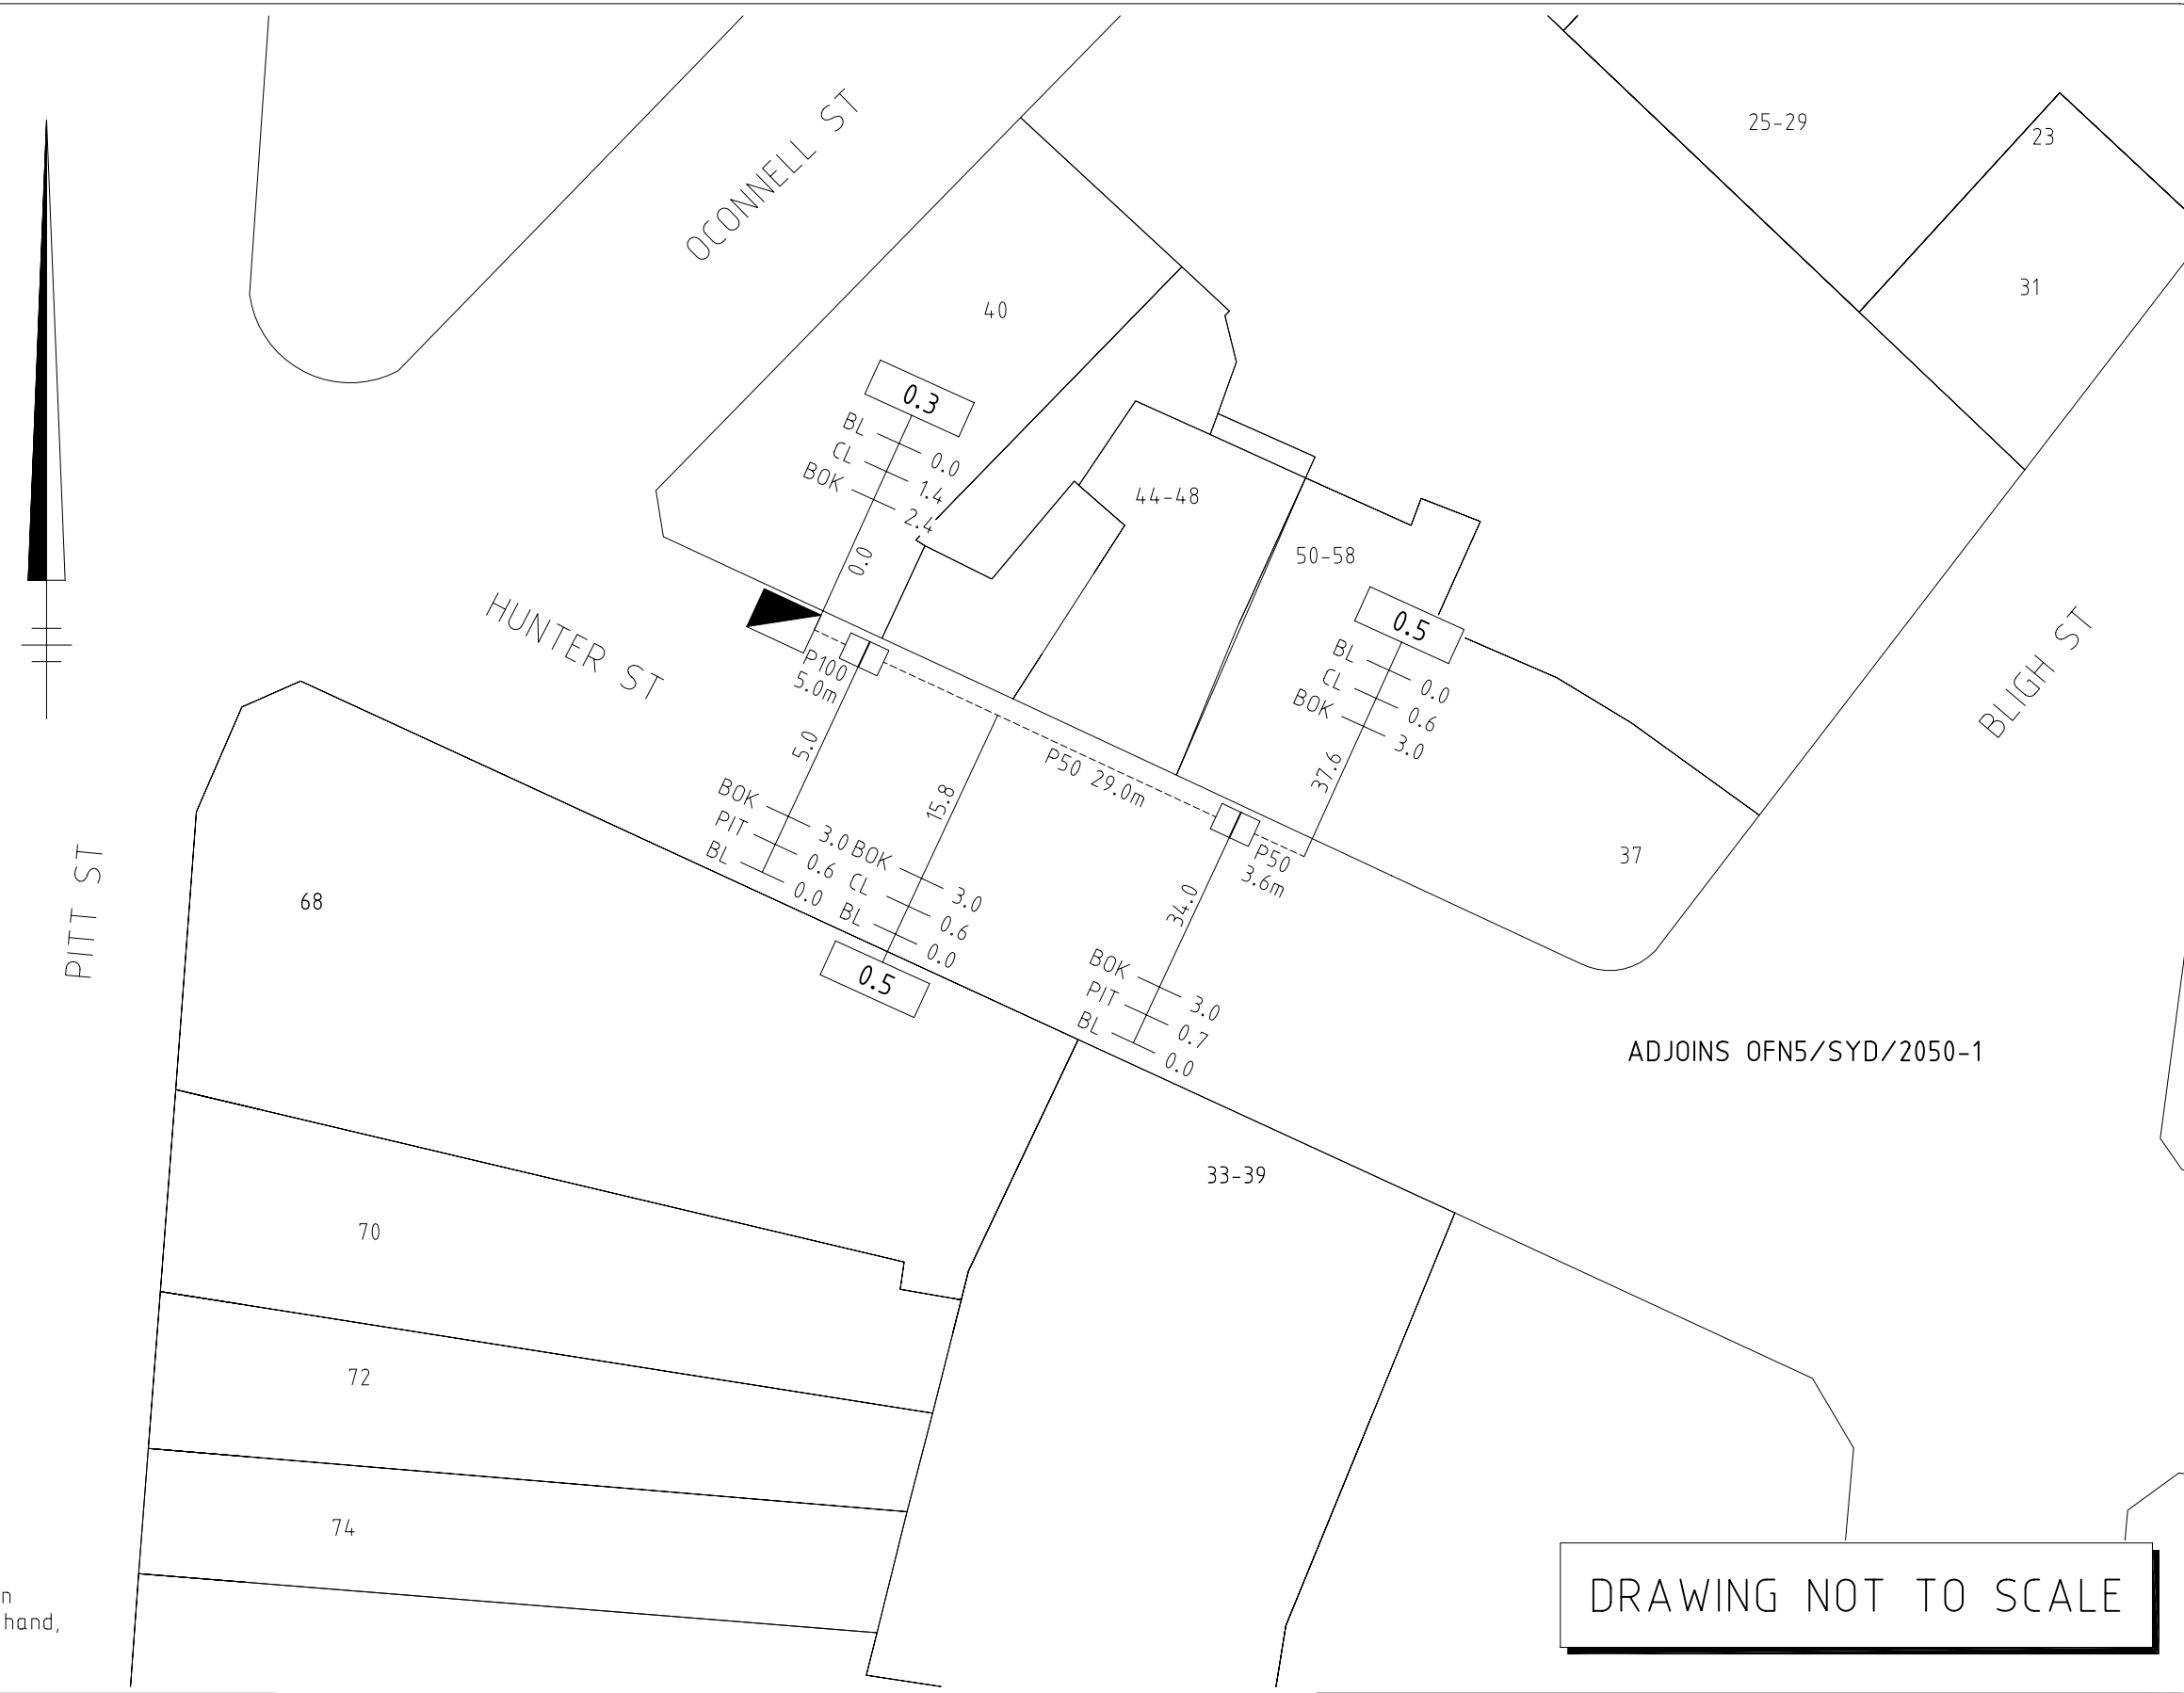

DRAWING NOT TO SCALE

REVISION						CONTACT OFFICER PH:	PROJECT NUMBER ATGDS-138	PLAN No.	SYDWAY / UBD REF / STREET SMART 56-K16 F-G5	G:\System\Uecomm\Uecomm-Brand_COLOUR.jpg	DRAWN DN 02/05/08	DRG No. OFN5/SYD/2050-2	U/G OPTIC FIBRE CABLE RUN 40-50 HUNTER ST B/N O'CONNELL & BLIGH STS SYDNEY NSW 2000	A1
											DESIGN CHECKED SG 02/05/08			
											APPROVED			
	DATE	REV.	REVISION DESCRIPTION			CHECKED	APP'D.							

PREPARED BY: S & S QUIRK PTY LTD PH:(02) 9487 7724 FAX:(02) 9487 7725, ON BEHALF OF BCE FOR UE COMM.

LEGEND

- - ELECTRICITY POLE
- - FIBRE OPTIC CABLE
- - CABLE CONDUIT (TRENCHING)
- - UE P5 PIT
- ▢

- UE P6 PIT
- ⊠

- UE A8 PIT
- B/L

- BUILDING LINE
- PIT C/L

- PIT CENTER LINE FROM B/L
- BOK

- BACK OF KERB
- CO



- COVER
- / —

- FENCE LINE
- ▴

- TELSTRA MANHOLE
- ⊙

- TELSTRA PIT
- ⊞

- TELSTRA 6 PIT

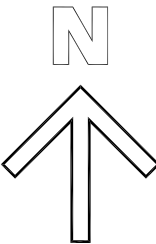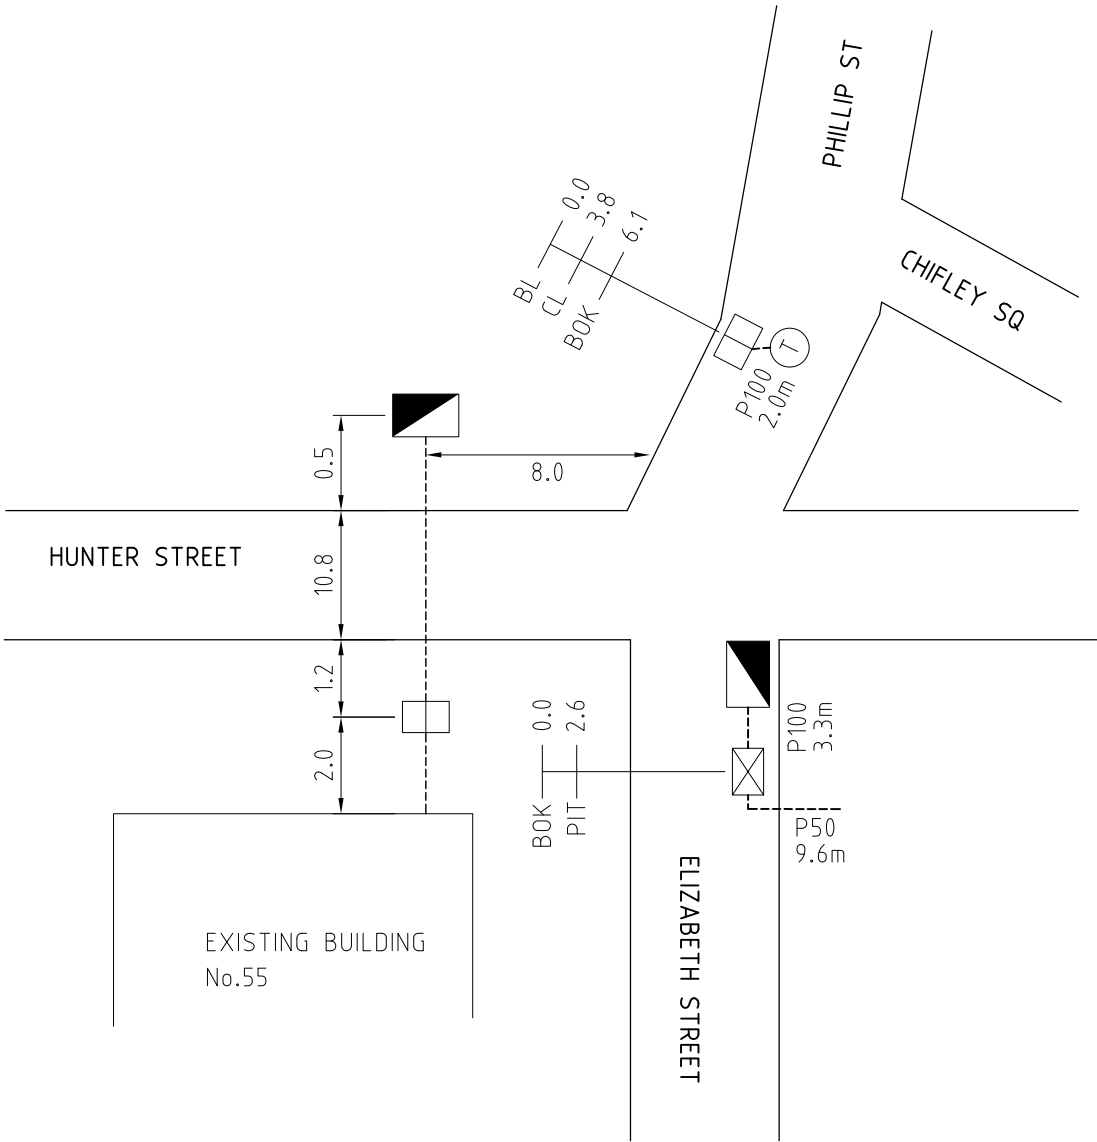

NOTE / WARNING:
BEFORE COMMENCING WORK IN THIS
AREA PLEASE CONTACT
MURRAY BRICE ON MOBILE 0413 449 060
ON BEHALF OF UECOMM

NOTE: - ALL DIMENSIONS ARE SHOWN IN METRES UNLESS NOTED OTHERWISE.

REVISIONS			
	C	NEW PIT & PIPE (QBEMS-149) UPDATE PIT & PIPE DETAILS (STGBS-250)	16.05.15
	B	NEW PIT & PIPE (STGBS-250)	09.09.09
A	RENUMBERED. WAS BCE-00-0040		12.12.00
REV	DESCRIPTION		DATE

BCE

Brice Civil Engineering Pty Ltd

A.B.N. 13 087 182 581

P.O. Box 378 Cherrybrook NSW 2126 Ph:(02) 8850 7550 Fax: (02) 8850 7551

Uecomm

MAKING THE CONNECTION

ACN 079 083 195

PROJECT:

55 HUNTER STREET
SYDNEY NSW 2000
UBD REF: 236-E8
CONDUIT: 50mm
DEPTH: 0.5 - 0.8m

“AS-BUILT”
PLANS

METHOD:

DIRECTIONAL BORE AND EXCAVATION

SCALE:

NOT TO SCALE

DRAWN

SSQ P/L

SIZE

A3

DOCUMENT No:

0FN5/SYD/2081

DATE:

05.12.00

REVISION:

C

LEGEND


- - ELECTRICITY POLE
- - FIBRE OPTIC CABLE
- - CABLE CONDUIT
- ▨ - UE P5 PIT
- ▨ - UE P6 PIT
- B/L - BUILDING LINE
- BOK - BACK OF KERB
- \ — - FENCE LINE
- ▨ - TELSTRA MANHOLE
- ⑥ - TELSTRA PIT

MARTIN PLACE


CASTLEREAGH ST

MARTIN PLACE

HOSKING PLACE

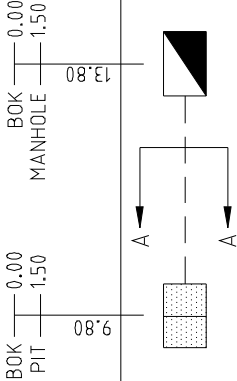

100Ø PVC COMMS CONDUIT

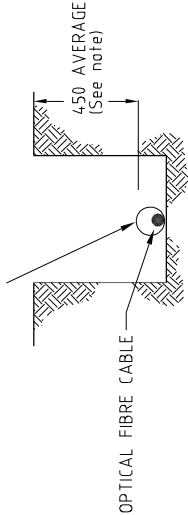

SECTION A-A

Note:
Conduit depths quoted are approximate only and may change due to unforeseen circumstances.
Excavate by hand until conduit depth is determined.



DRAWING NOT TO SCALE

REVISIONS		DRAWN		DRG No.	
		GROUN	15.02.01	0FN5/SYD/2144/1	
		APPROVED	KERKOWNE	UNDERGROUND FIBRE OPTICAL CABLES TELSTRA MANHOLE TO UE COMM 6 PIT CASTLEREAGH ST & MARTIN PLACE SYDNEY - 2000	
			15.02.01		
		UBD REF.	3-2J		
		SYDNEY		A1	
		Suite 902, 20 Berry St North Sydney - 2060			

PREPARED BY: S & S QUIRK PTY LTD PH:(02) 9482 7944 FAX:(02) 9482 7955, ON BEHALF OF BCE FOR UE COMM.


LEGEND

- - ELECTRICITY POLE
- - - - - FIBRE OPTIC CABLE
- - UE P5 PIT
- - UE P6 PIT
- B/L - BUILDING LINE
- PIT C/L - PIT CENTER LINE FROM B/L
- BOK - BACK OF KERB
- CO - COVER
- ↘ ↗ - FENCE LINE
- ▬ - TELSTRA MANHOLE
- Ⓣ - TELSTRA PIT
- Ⓣ Ⓣ - TELSTRA 6 PIT
- Ⓣ Ⓣ Ⓣ - TELSTRA 8 PIT
- COM - COMMUNICATION MANHOLE

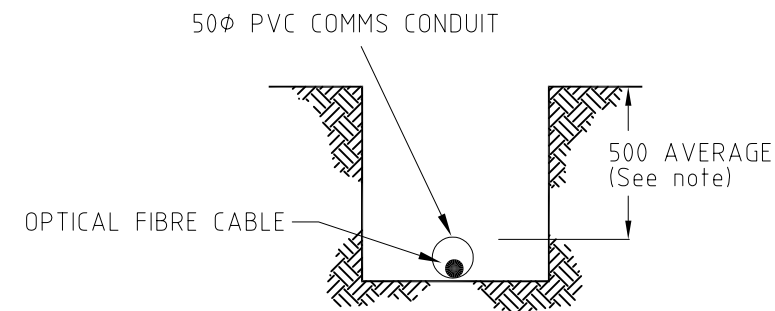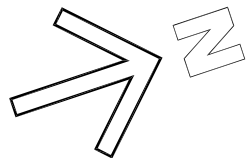

SECTION A-A

Note:
Conduit depths quoted are approximate only and may change due to unforeseen circumstances.
Excavate by hand until conduit depth is determined.

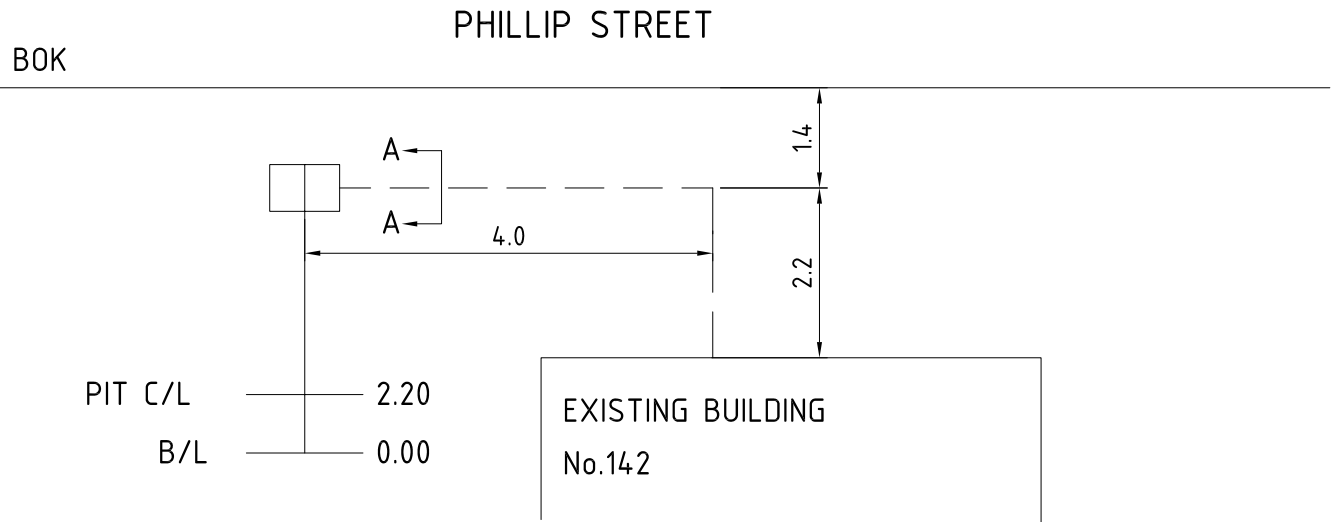

NOTE: - ALL DIMENSIONS ARE SHOWN IN METRES UNLESS NOTED OTHERWISE.

REVISIONS					
	-	RENUMBERED. WAS BCE-01-0082	15.03.01		
	REV	DESCRIPTION	DATE	CHECKED	APPROVED

BCE
Brice Civil Engineering Pty Ltd
A.B.N. 13 087 182 581

P.O. Box 378 Cherrybrook NSW 2126 Ph:(02) 8850 7550 Fax: (02) 8850 7551

Uecomm
MAKING THE CONNECTION
ACN 079 083 195

APPROVED
R. Browne

UBD REF:
1-K16

PROJECT:
No. 142
PHILLIP STREET
SYDNEY NSW 2000
CONDUIT: 50mm
DEPTH: 0.5 - 0.6m

"AS-BUILT" PLANS

METHOD:
DIRECTIONAL BORE AND EXCAVATION

SCALE:
NOT TO SCALE

DRAWN
SSQ P/L



SIZE
A3






DOCUMENT No:
OFN5/SYD/2178-1

DATE:
05.03.01

REVISION:
-

LEGEND

- - ELECTRICITY POLE
 — — — - FIBRE OPTIC CABLE
 - UE P5 PIT
 - UE P6 PIT
 B/L - BUILDING LINE
 PIT C/L - PIT CENTER LINE F

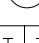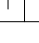- BOK - BACK OF KERB
- CO - COVER
- \ - FENCE LINE
-  - TELSTRA MANHOLE
-  - TELSTRA PIT
-  - TELSTRA 6 PIT
-  - TELSTRA 8 PIT
-  - COMMUNICATION MANHOLE

NOTE: - ALL DIMENSIONS ARE SHOWN IN METRES UNLESS NOTED OTHERWISE.



REVISIONS	REV	DESCRIPTION	DATE	CHECKED	APPROVED
	A	INITIAL ISSUE (FOR JERRY)	04.06.01		

BCE

Brice Civil Engineering Pty Ltd
A.B.N. 13 087 182 581

P.O. Box 378 Cherrybrook NSW 2126 Ph:(02) 8850 7550 Fax: (02) 8850 7551

NO. 15

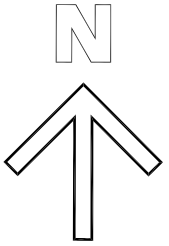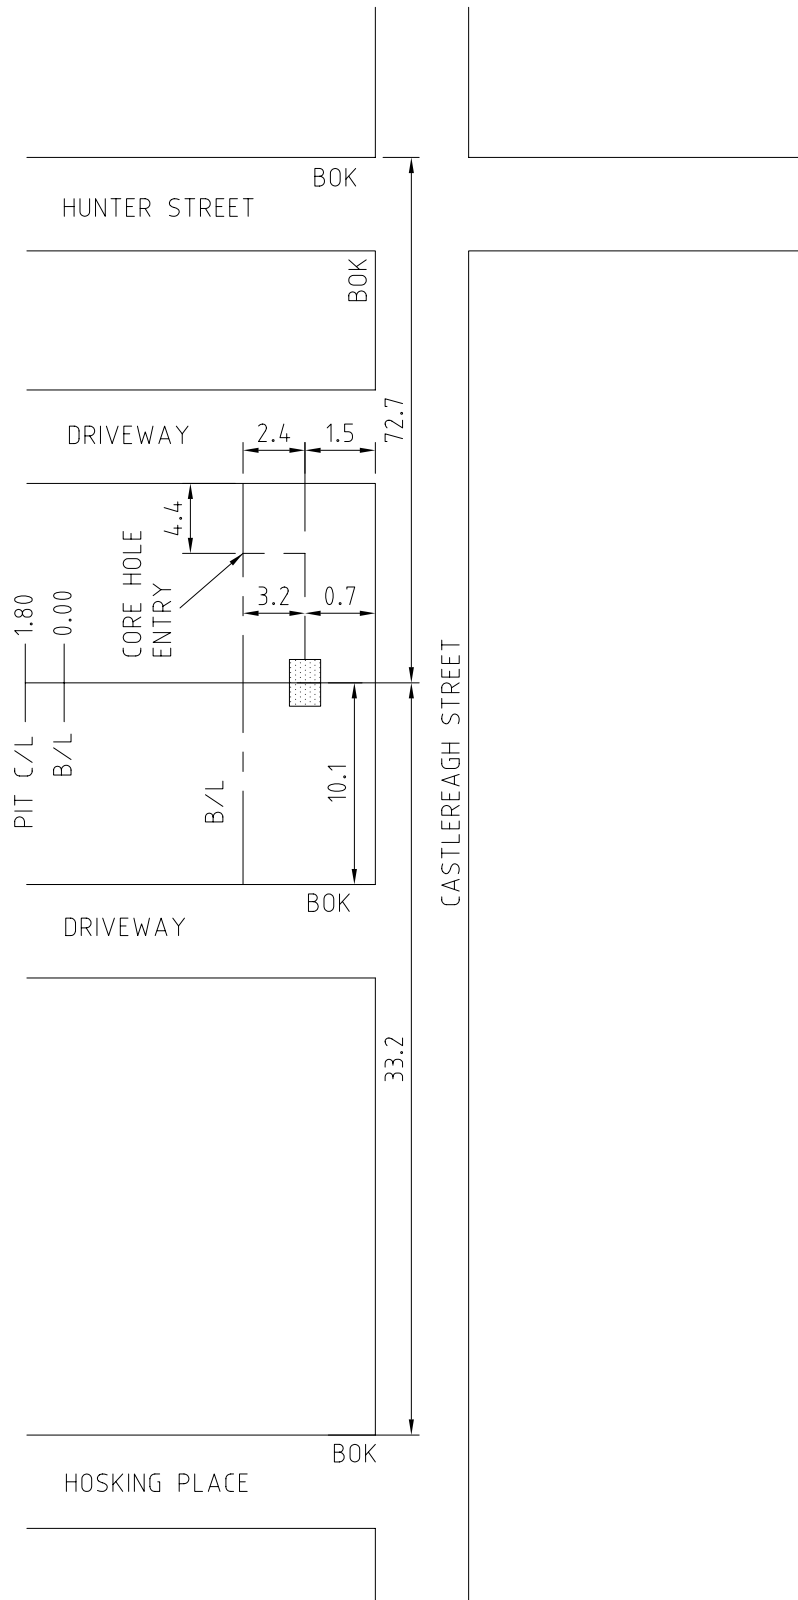


BCE-01-0093

"AS-BUILT" PLANS

METHOD: DIRECTIONAL BORE AND EXCAVATION		
SCALE: NOT TO SCALE	DRAWN SSQ P/L	SIZE A3
DOCUMENT No: 0FN5/SYD/2222-1	DATE: 04.06.01	REVISION: A

LEGEND

- - ELECTRICITY POLE
- - FIBRE OPTIC CABLE
- - CABLE CONDUIT (TRENCHING)
- - CABLE CONDUIT (BORE TUNNELLING)
- ◼ - UE P2 PIT
- ◻ - UE P5 PIT
- ◻ - UE P6 PIT
- ◻ - UE P8 PIT
- ◻ - UE P9 PIT
- BL - BUILDING LINE
- BOK - BACK OF KERB
- CL - CENTRELINE OF CONDUIT
- TP - TURNING POINT OF CONDUIT
- \ — - FENCE LINE, FL
- ◼ - TELSTRA MANHOLE
- ⊙ - TELSTRA PIT
- - OPTICAL FIBRE JOINT
- ⊙ - JOINT LOOP (m) - POLE / UNDERGROUND
- ◻ - CABLE HEAD POLE
- 0.6m - CABLE DEPTH

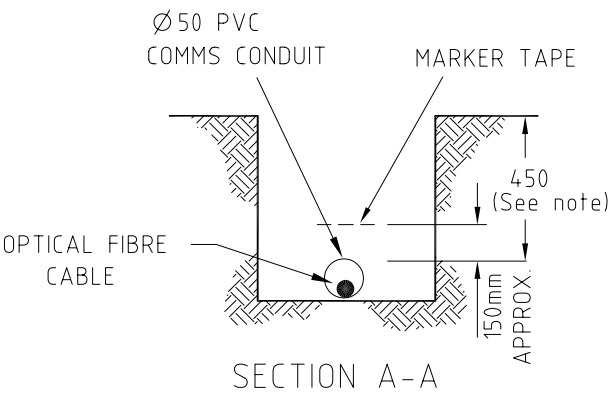

- Note:
- Conduit depths quoted are approximate only and may change due to unforeseen circumstances.
 - In all instances it is recommended that the position of conduits & cables should be proved on site by hand, prior to commencement of works.
 - Marker tape shall be installed at least 150mm above the uppermost surface of all conduits or cables.

REVISION			REVISION DESCRIPTION	CHECKED	APP'D.
	DATE	REV.			
	08.05.03	-	ISSUED FOR APPROVAL - UE.COMM (A.L.S.)		

CONTACT OFFICER	Adrian Szentessy PH: (03) 9781 4011
PROJECT NUMBER	UEC-OMTCS 102
PLAN No.	McCOURT DANDO
MELWAY / UBD REF	UBD 236 E8

Uecomm
MAKING THE CONNECTION
ACN 079 083 195

UECOMM
MEL/SYD/QLD

DRAWN <i>BAYSIDE (ALS)</i> 01.05.03
DESIGN CHECKED
APPROVED

DRG No. OFN5/SYD/2305-1	-
U/G OPTICAL FIBRE CABLE RUN No. 2 O'CONNELL STREET O'CONNELL STREET & BENT STREET SYDNEY NSW 2000	
A3	

DRAWING NOT TO SCALE

Verizon



PLEASE HAND TO ADDRESSEE IMMEDIATELY

The following drawing(s) is/are provided from Verizon records in response to your request to show the approximate location of our infrastructure within the vicinity requested.

Note:


This reply relates only to the location requested and is valid for 30 days from the date of this reply. Where additional works are planned that have not been specified within this request, Verizon require that an additional location request be submitted.

Please Contact a Verizon representative for conformation and/or site visit prior to works commencing. If Verizon infrastructure is not shown on the attached drawing, we request that you still contact us to ensure that works undertaken will not conflict with any future works.

Contacts:	Paul Spear	Direct:	02 8210 3243
	David Bahn	Direct:	02 8210 3015

Warning:


These drawings have been prepared for Verizon's own use and indicate the position of underground optical fibre networks and installations relative to property lines, kerb lines etc. as at the time the infrastructure were installed. Verizon will accept no liability for inaccuracies in the information or lack of information on such drawings for any cause whatsoever arising. Persons excavating or carrying out other earthworks will be held responsible for any damage caused to Verizon's Infrastructure. Verizon also reserves the right to recover compensation for any damages and loss of services.

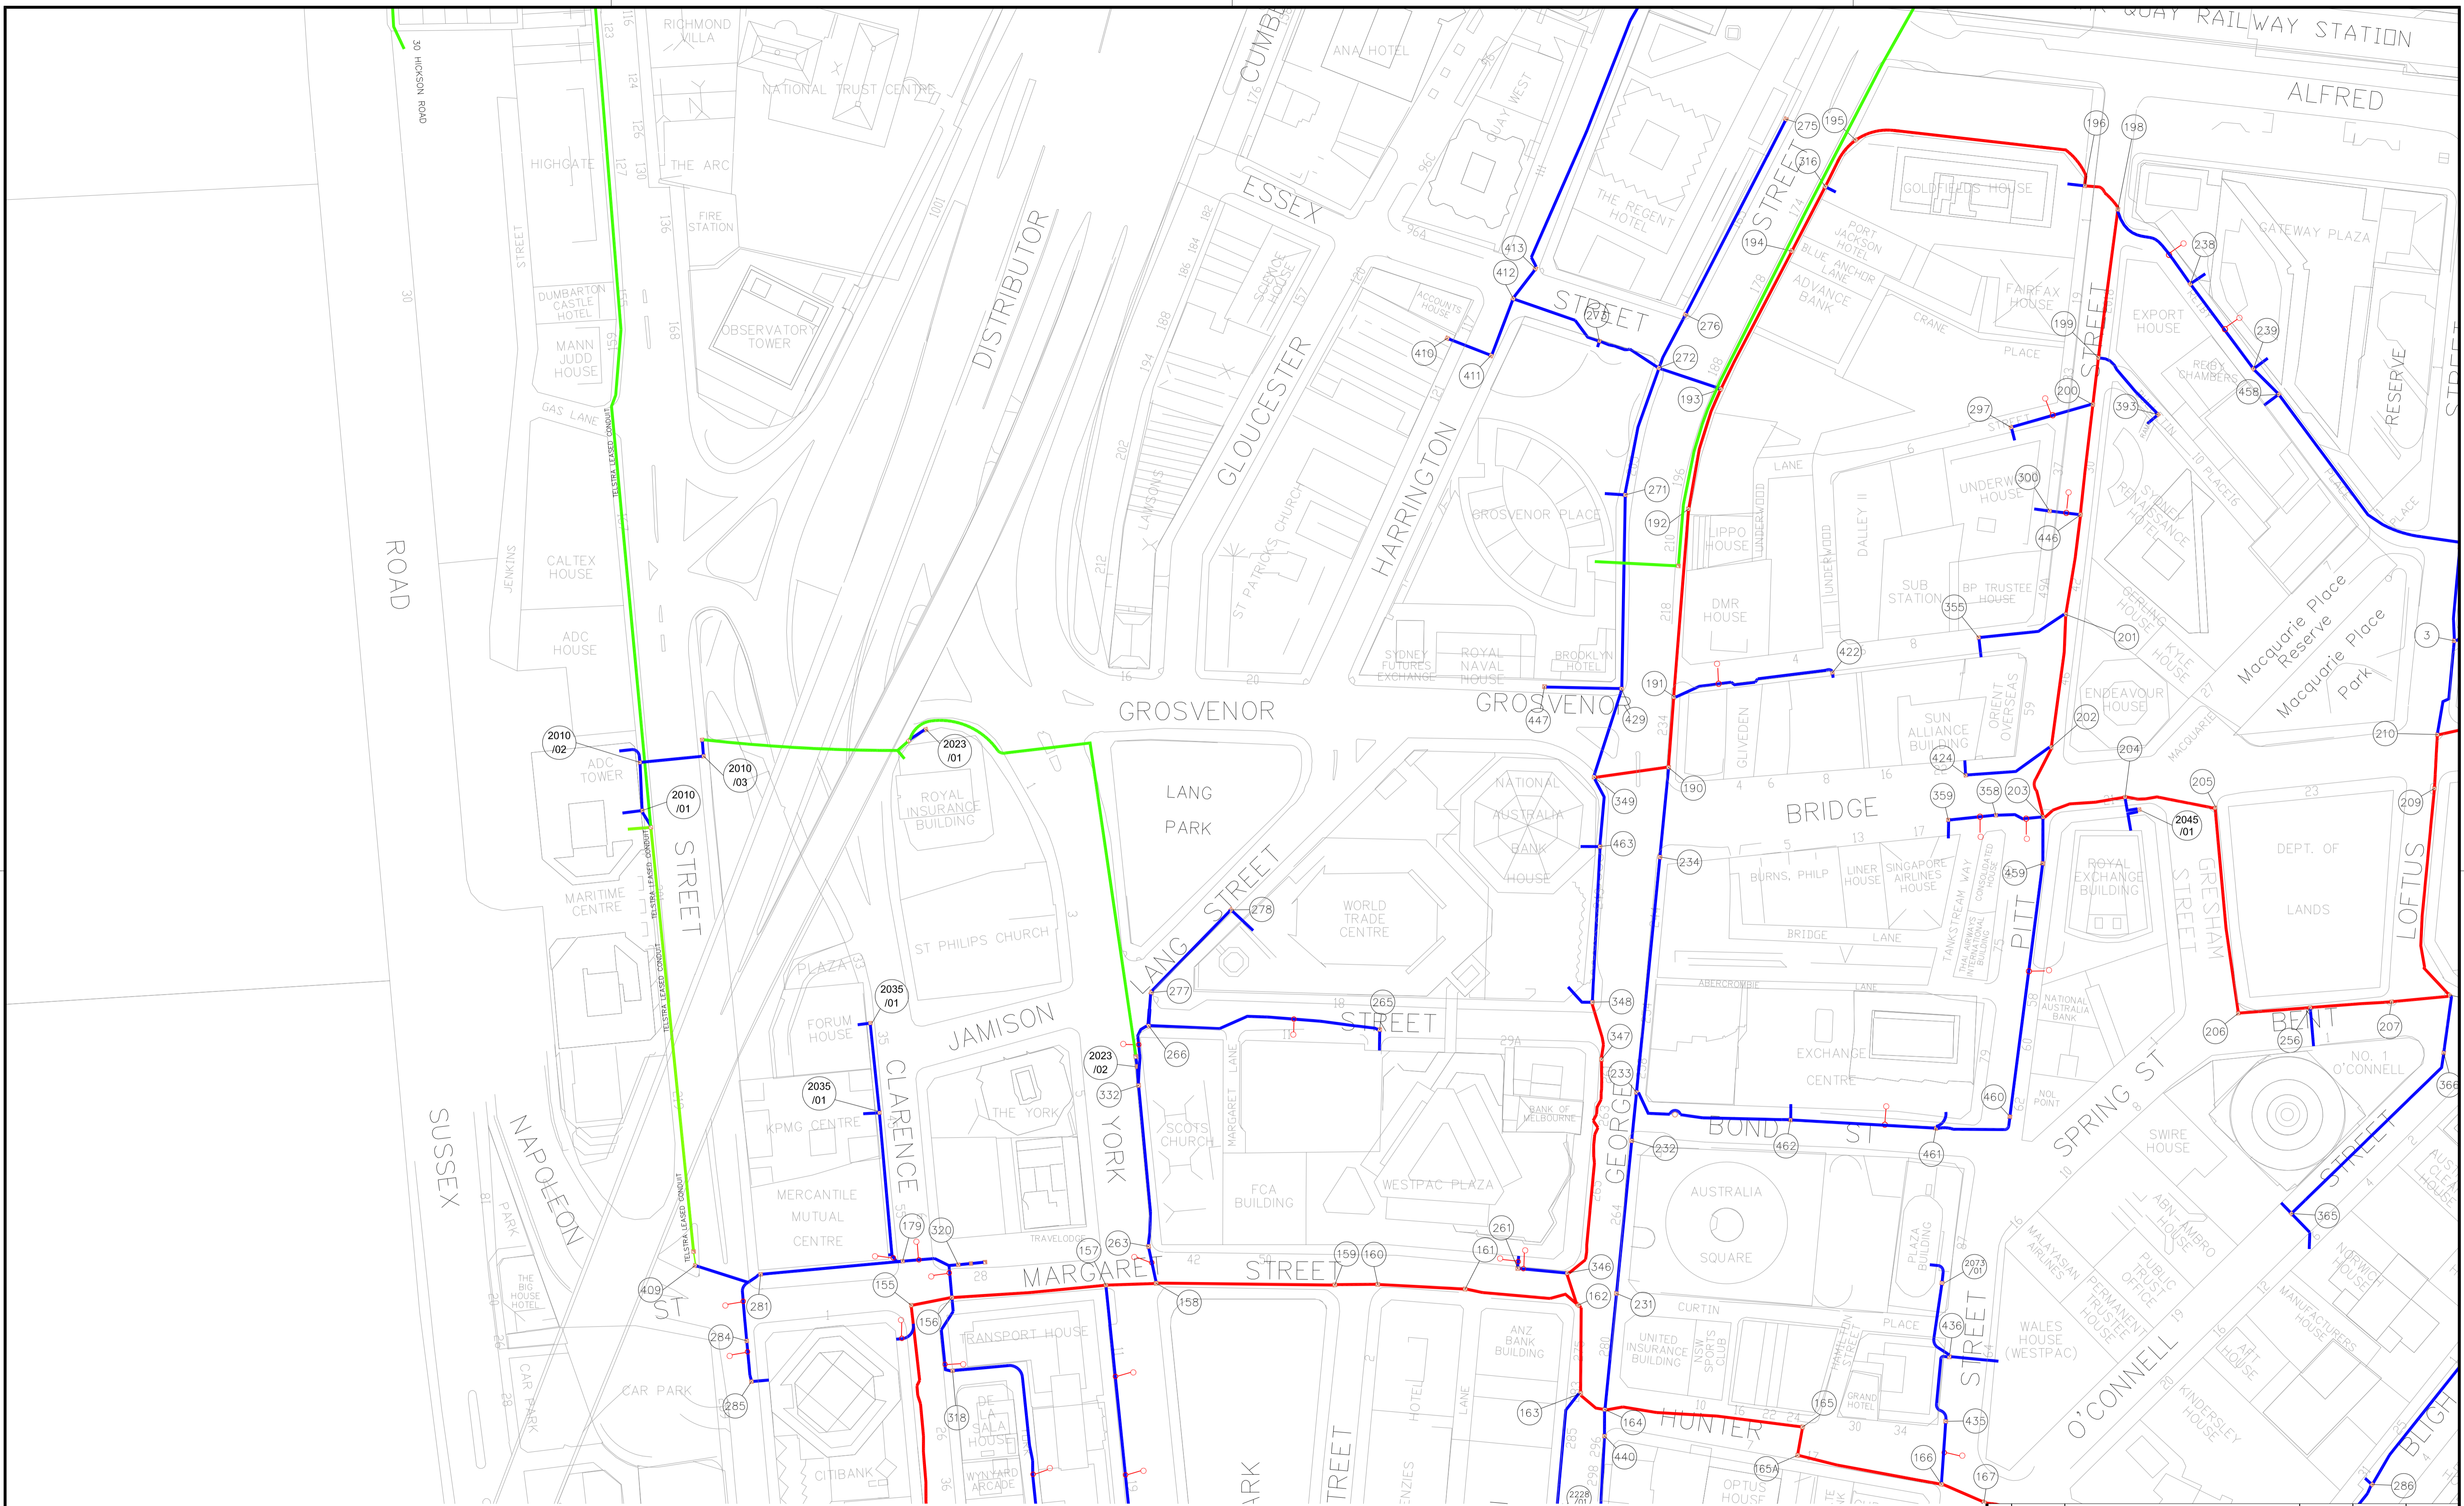

LEGEND

- VERIZON DUCT
- VERIZON DUCT
- TELSTRA DUCT
- VERIZON PIT
- TELSTRA PIT


C2	14/2/13				
C1	10/2/12				
REV	DATE(M/Y)	DESCRIPTION	DRAWN	CHECKED	APPROVED
Do not scale this drawing. Information on this document is proprietary & shall not be used, copied, reproduced or disclosed in whole or in part without written consent of Verizon.					
PROJECT Verizon SYDNEY CBD NETWORK					
DRAWING TITLE SYDNEY CBD NETWORK SHEET 2 OF 16			REVISION C2		
DRAWING NUMBER VZ			SCALE N.T.S.		

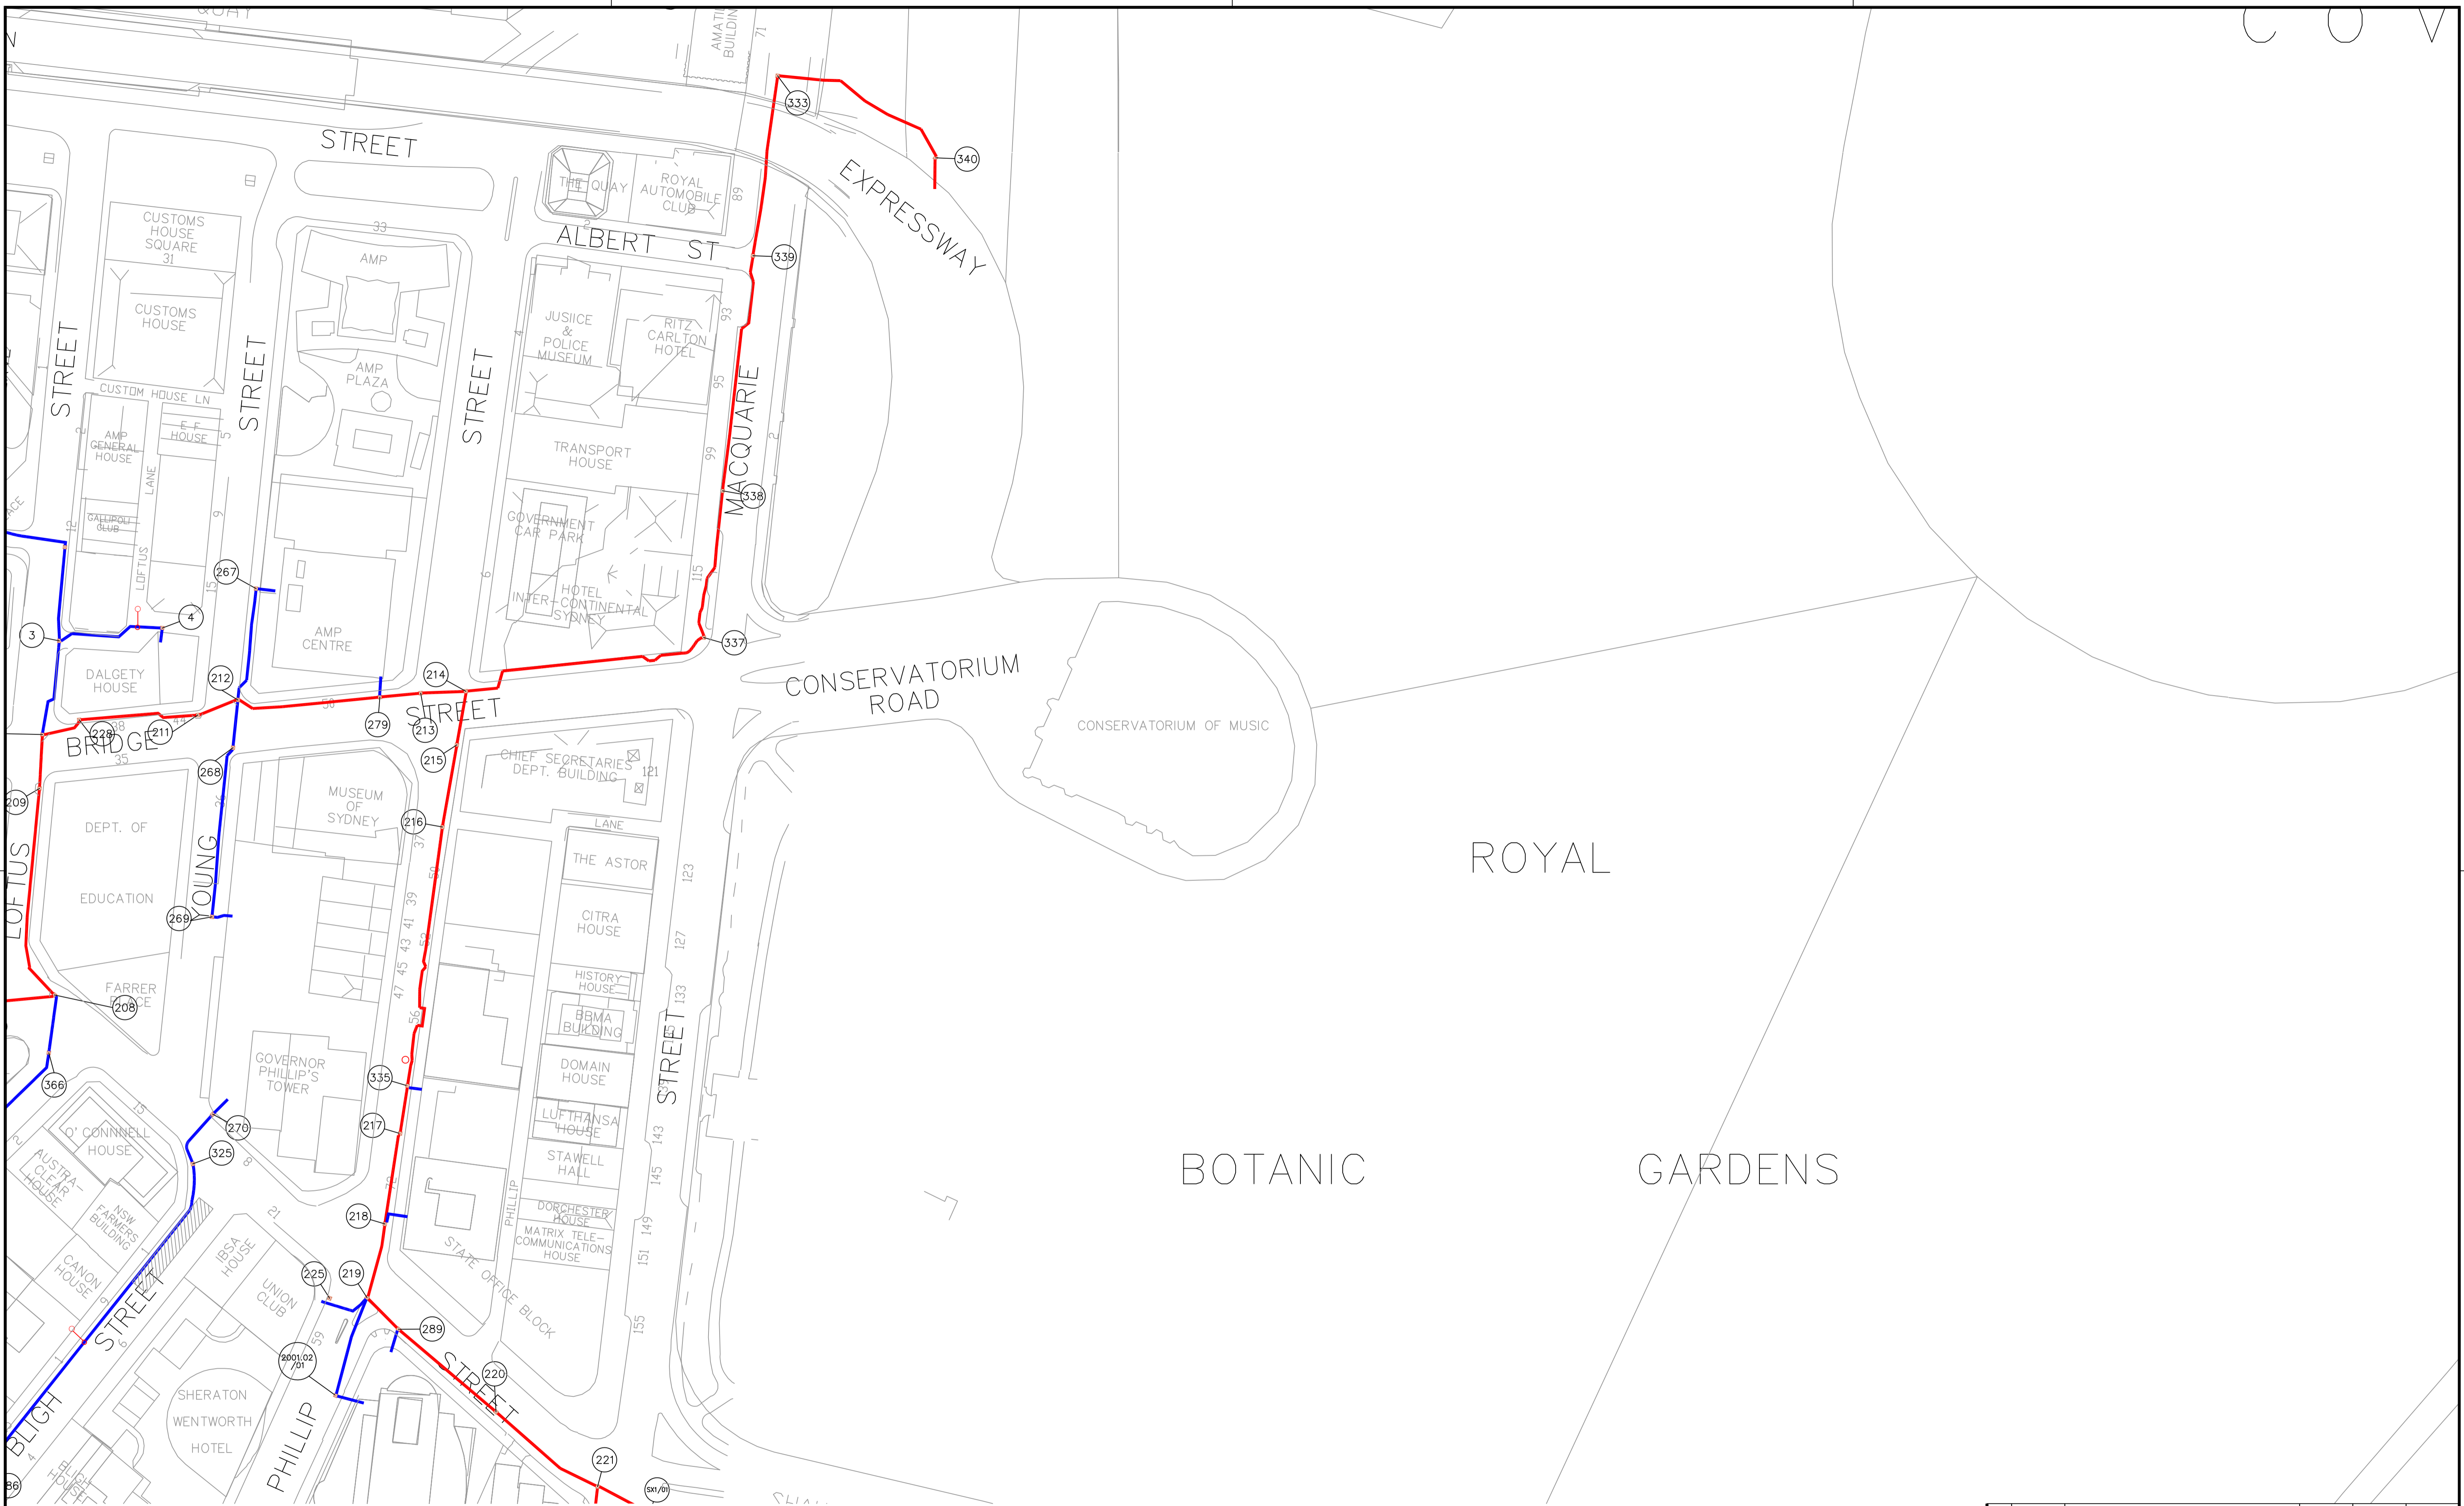

LEGEND

- VERIZON DUCT
- VERIZON DUCT
- TELSTRA DUCT
- VERIZON PIT
- TELSTRA PIT


C1	01/3/11				
REV	DATE(D/M/Y)	DESCRIPTION	DRAWN	CHECKED	APPROVED
Do not scale this drawing. Information on this document is proprietary & shall not be used, copied, reproduced or disclosed in whole or in part without written consent of Verizon.					
PROJECT			REVISION		
Verizon SYDNEY CBD NETWORK			C1		
DRAWING TITLE			SCALE		
SYDNEY CBD NETWORK			N.T.S.		
SHEET 3 OF 16			SIZE		
DRAWING NUMBER			A1		

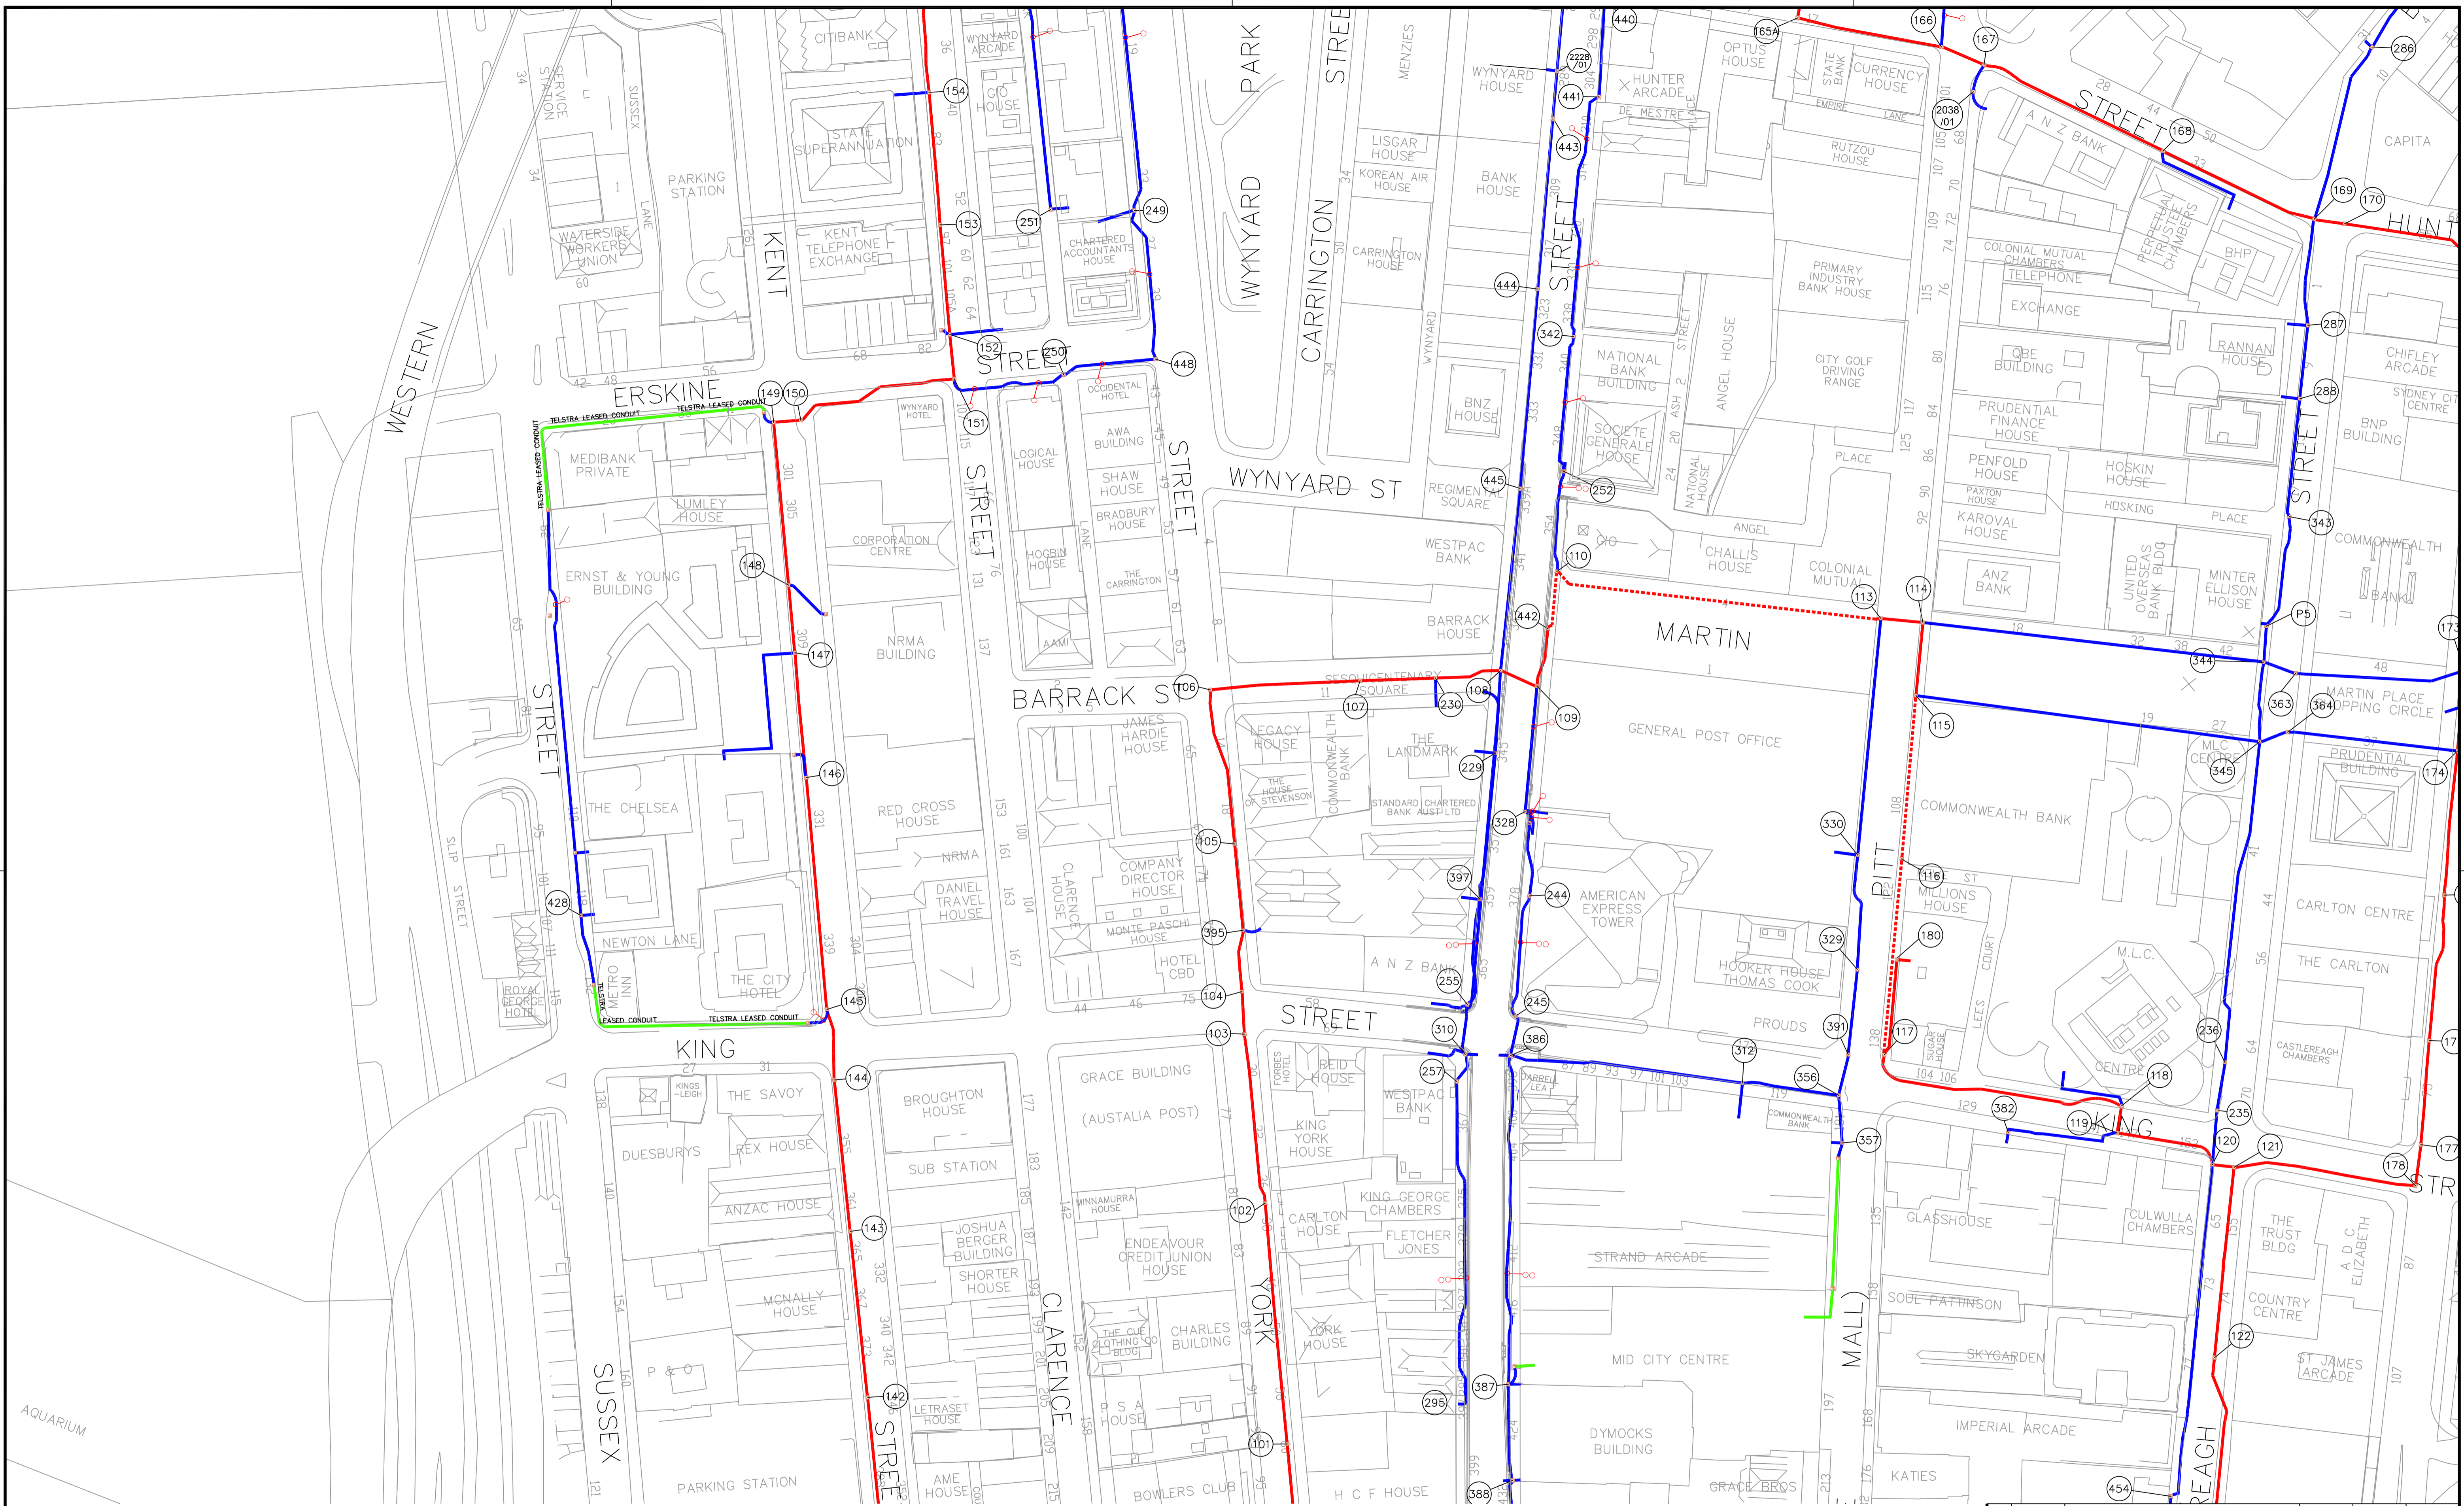

LEGEND

- VERIZON DUCT
- VERIZON DUCT
- TELSTRA DUCT
- VERIZON PIT
- TELSTRA PIT

C1	08/11/12				
REV	DATE/D/M/Y	DESCRIPTION	DRAWN	CHECKED	APPROVED
Do not scale this drawing. Information on this drawing is proprietary & shall not be used, copied, reproduced or disclosed in whole or in part without written consent of Verizon.					
PROJECT			REVISION		
Verizon SYDNEY CBD NETWORK			C1		
DRAWING TITLE			SCALE		
SYDNEY CBD NETWORK SHEET 4 OF 16			A1		
DRAWING NUMBER			N.T.S.		

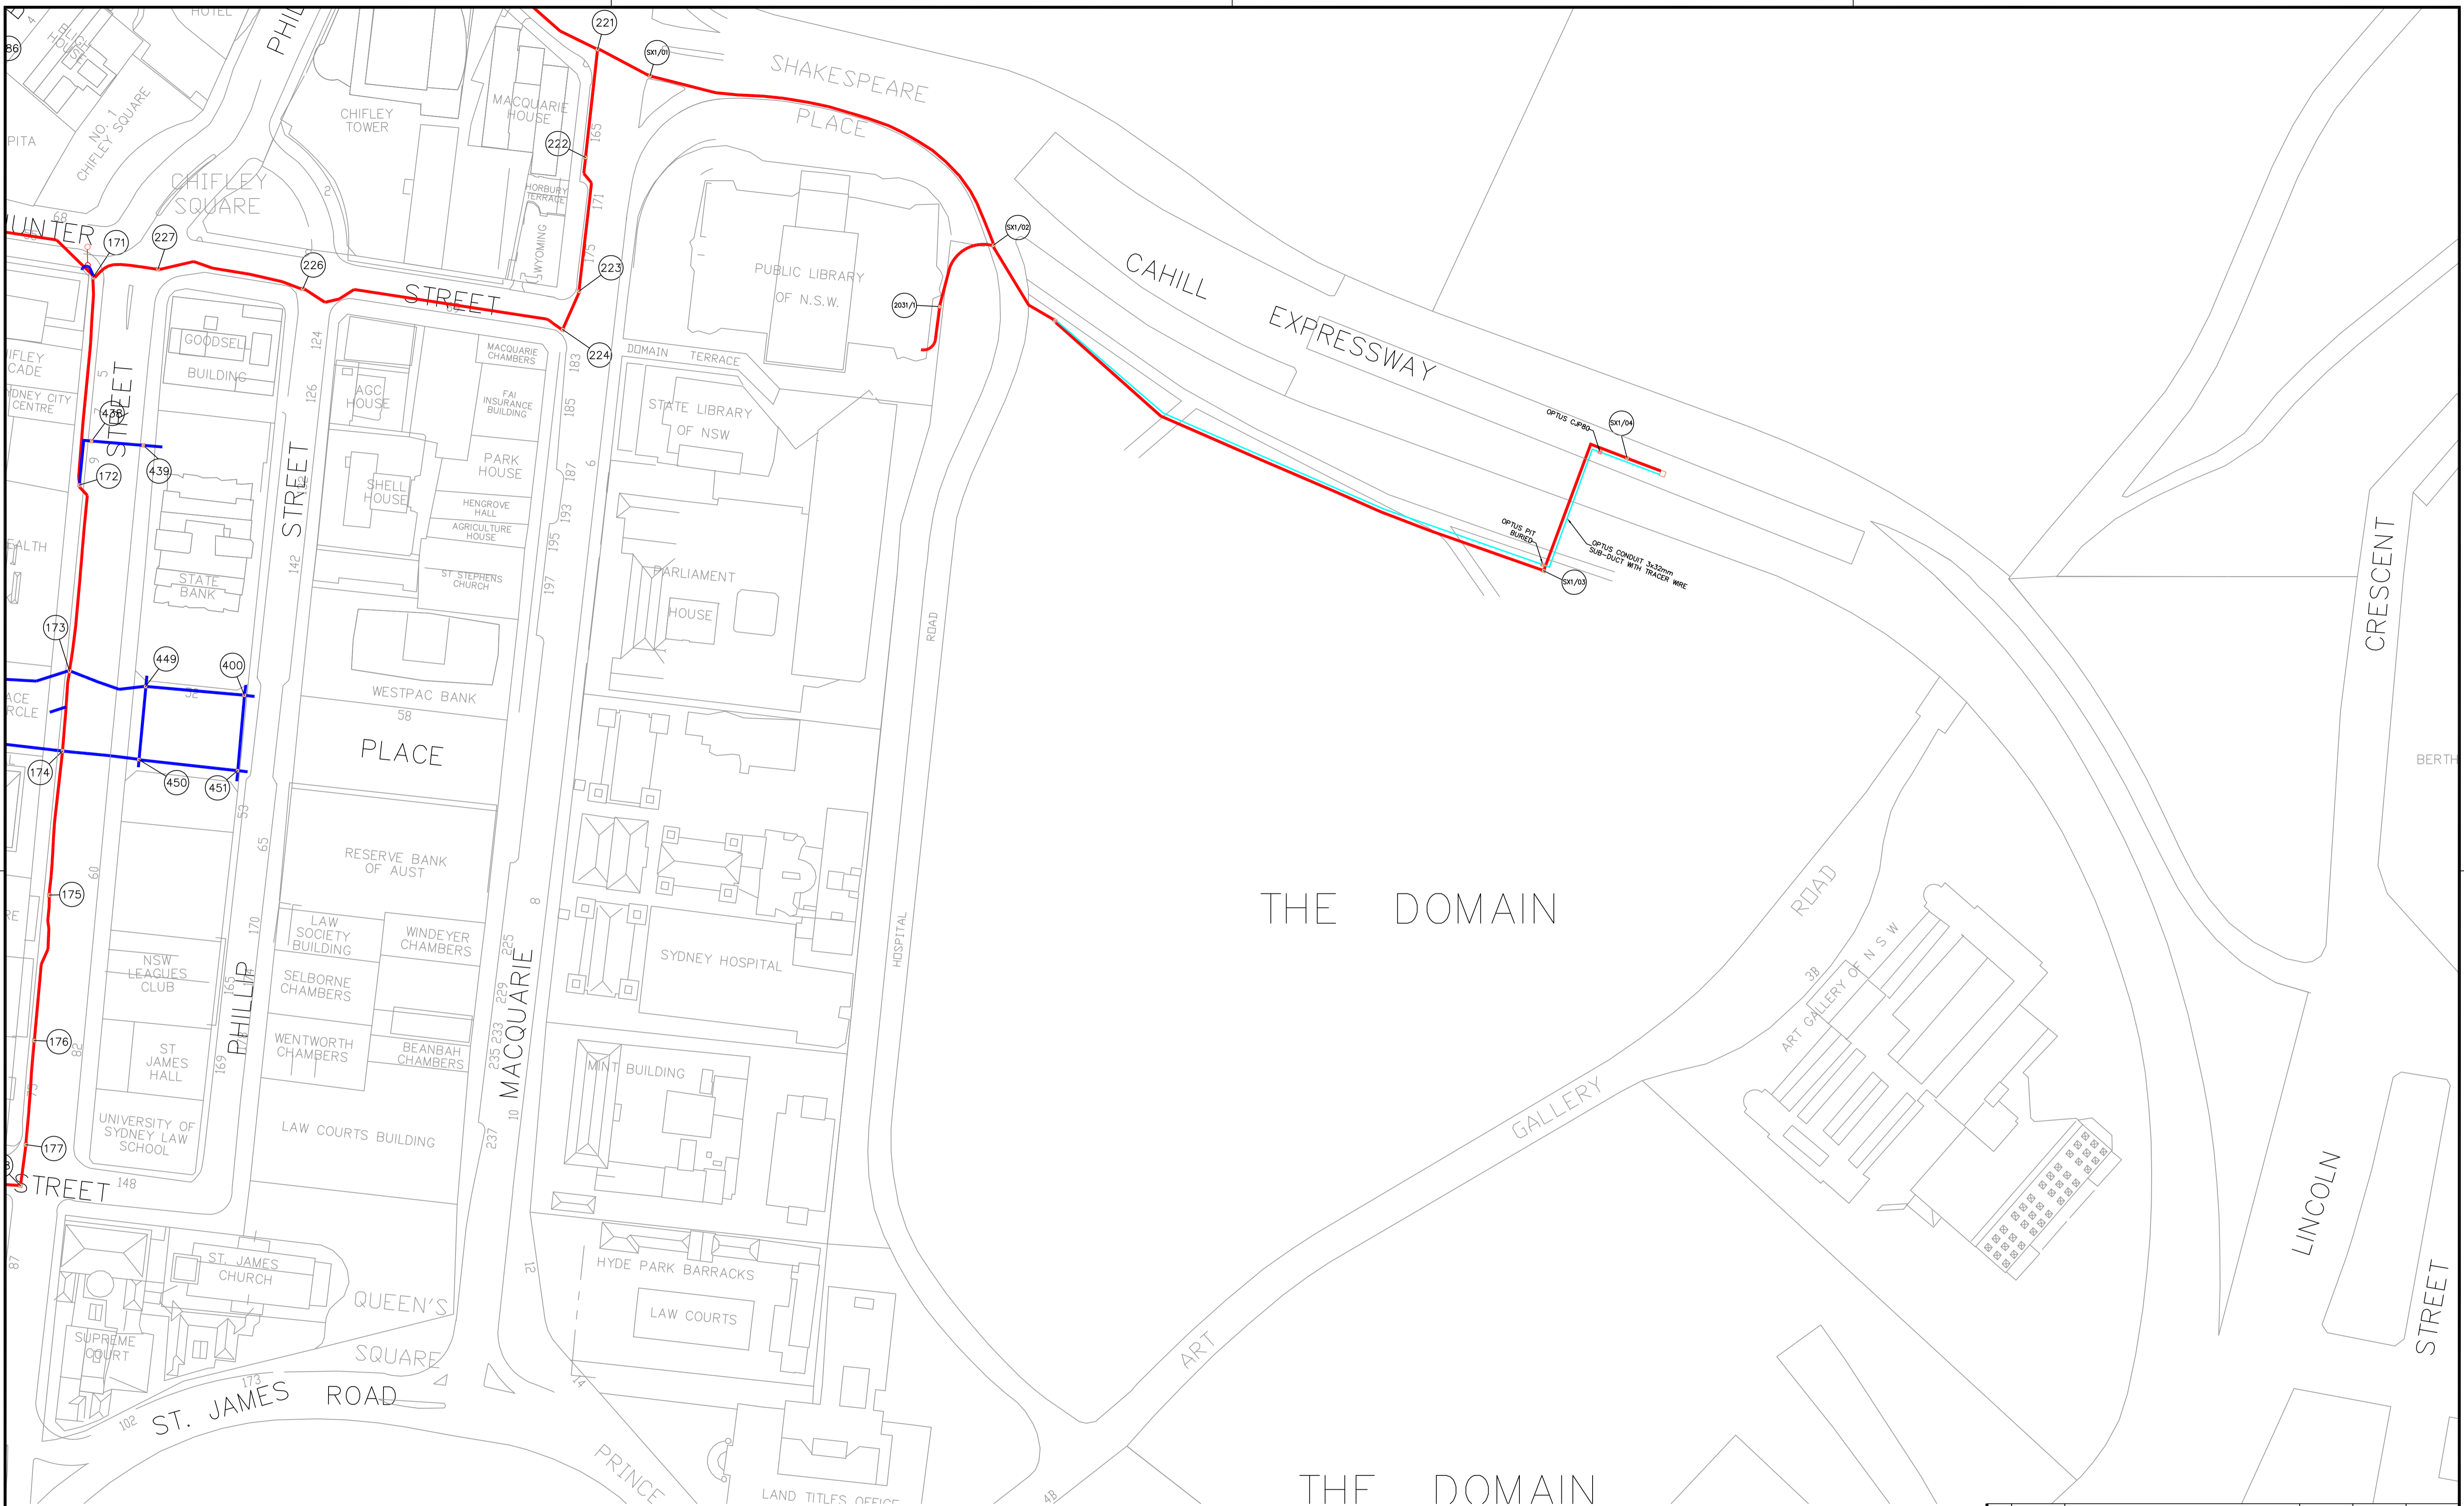

LEGEND

- VERIZON DUCT
- VERIZON DUCT
- TELSTRA DUCT
- VERIZON PIT
- TELSTRA PIT

C1	01/3/11				
REV	DATE(D/M/Y)	DESCRIPTION	DRAWN	CHECKED	APPROVED
Do not scale this drawing. Information on this document is proprietary & shall not be used, copied, reproduced or disclosed in whole or in part without written consent of Verizon.					
PROJECT Verizon SYDNEY CBD NETWORK					
DRAWING TITLE SYDNEY CBD NETWORK SHEET 5 OF 16			REVISION C1		
DRAWING NUMBER			SCALE N.T.S.	SIZE A1	

Vocus

16/01/2017

Mr Nicholas Rouggos
ARUP
201 Kent Street
Sydney 2000 NSW

Dear Mr Nicholas Rouggos

DIAL BEFORE YOU DIG – JOB: 11738734 SEQ: 58207264

Thank you for your request on 16/01/2017 17:01 , regarding the location of telecommunication services. You requested the information for the below area:

Address: Hunter Street
Suburb: Sydney
State: NSW

Additional Information: Not Supplied

YES – We can confirm that the Vocus Group has fibre optic services within the vicinity

Please find attached a copy of the services plan for the location of the works. Please note that these plans have a life of 30 days from the date you requested (above), as future works may affect your enquiry.

IMPORTANT INFORMATION

Drawings and Plans provided by the Vocus Group are reference diagrams which were correct at the time the asset was built. Exact ground cover and alignments cannot be provided with any certainty, as these may alter over time. Depths of Telecommunications plant vary considerably as do alignments. The plans provided are to be used as a guide only. It is essential to uncover / pothole the asset and positively identify the assets exact location.

Please call 1800 262 663 for any general enquiries about the information provided within this response.

Yours sincerely,

Vocus Group DBYD Team

EMERGENCY CONTACT: 1800 262 663

Vocus House Level 1, 189 Miller Street


North Sydney NSW 2060

T: 1300 88 99 88

E: info@vocus.com.au

The Vocus Group includes related bodies corporate of Vocus Communications Limited ACN 084 115 499

OVERVIEW

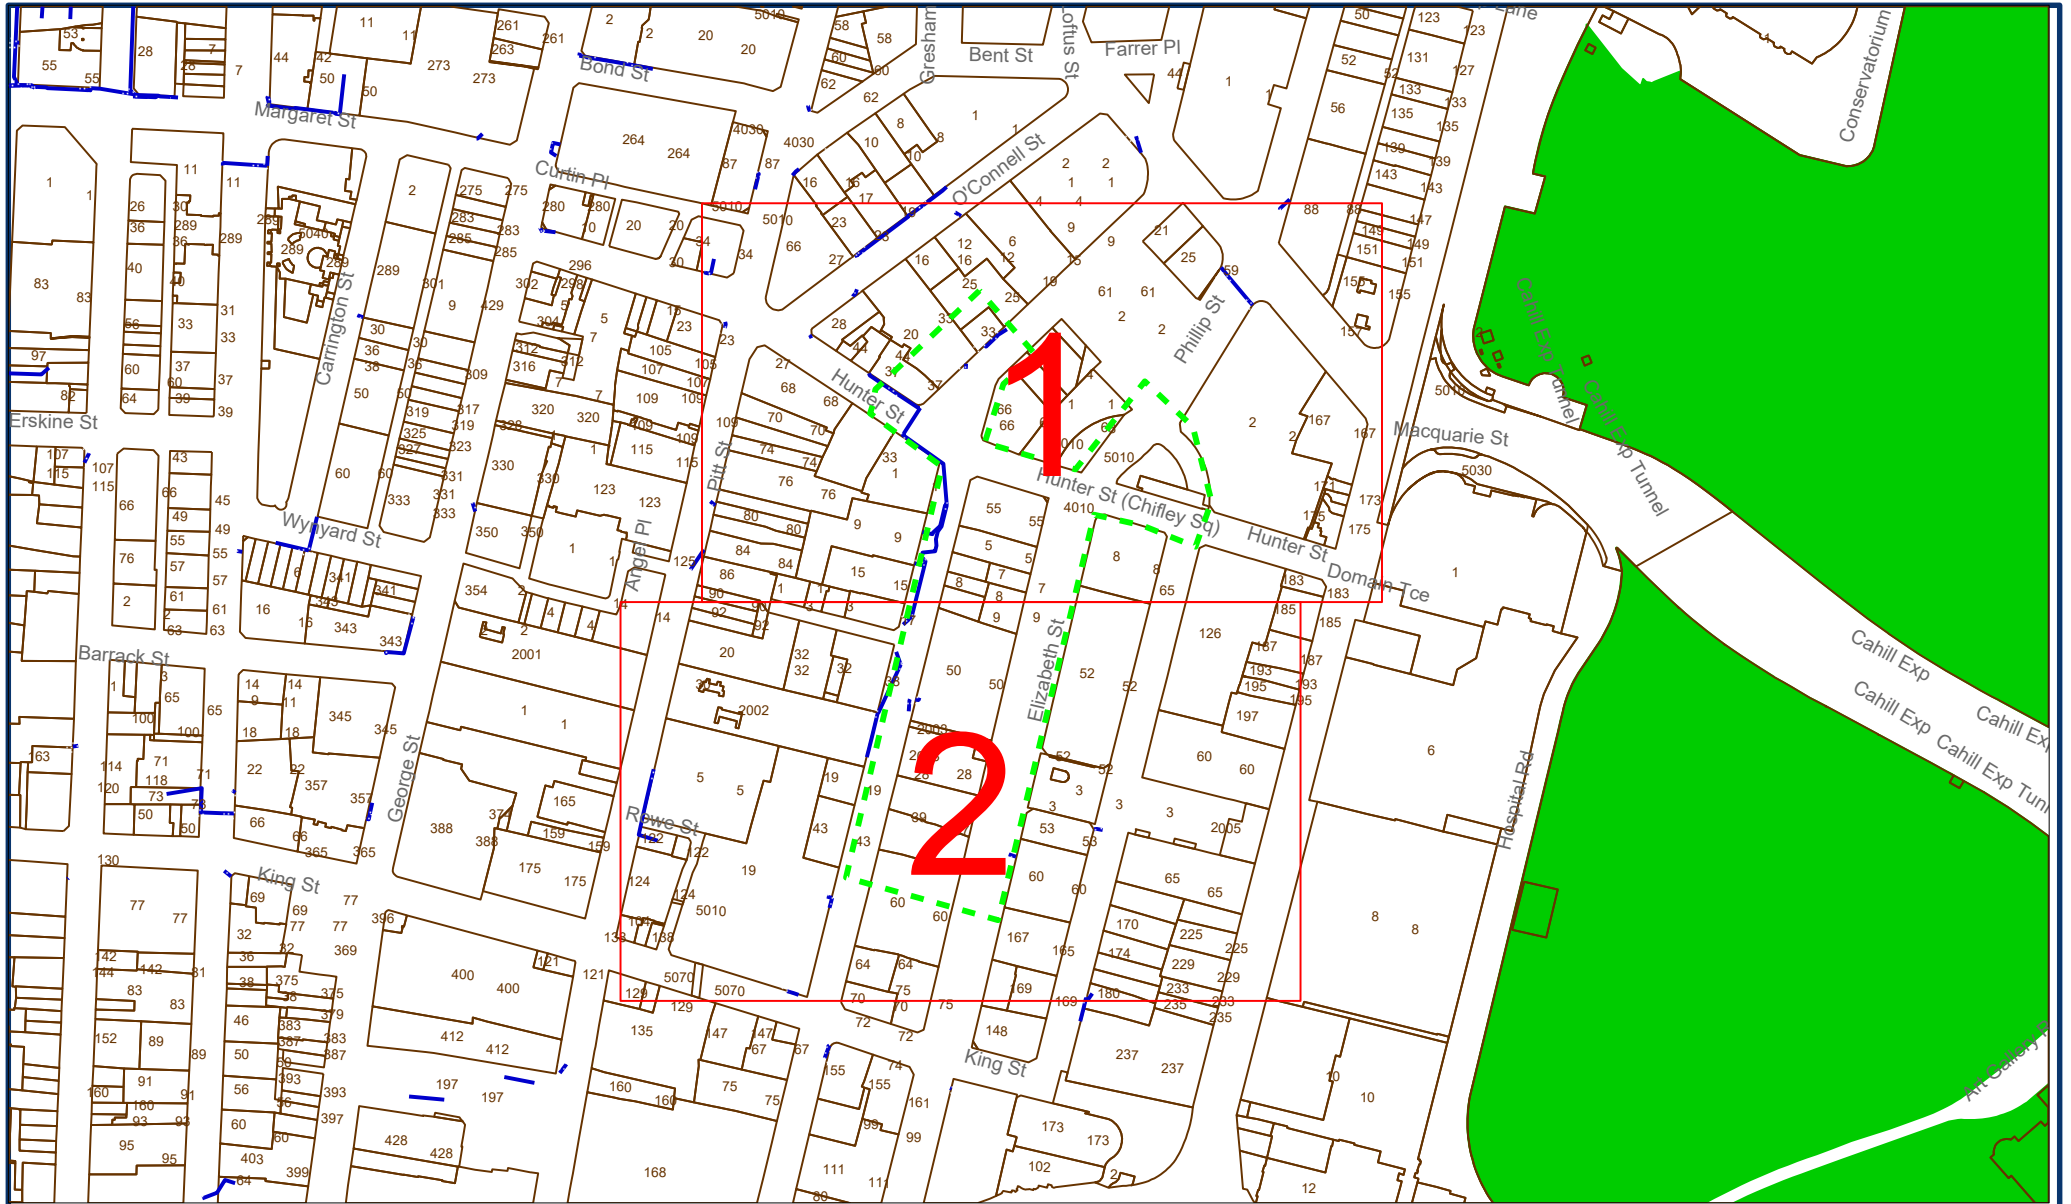


VOCUS
communications



SEQUENCE NUMBER: 58207264
JOB NUMBER: 11738734
ADDRESS: Hunter Street Sydney

SCALE 1:3000

0 0.03km

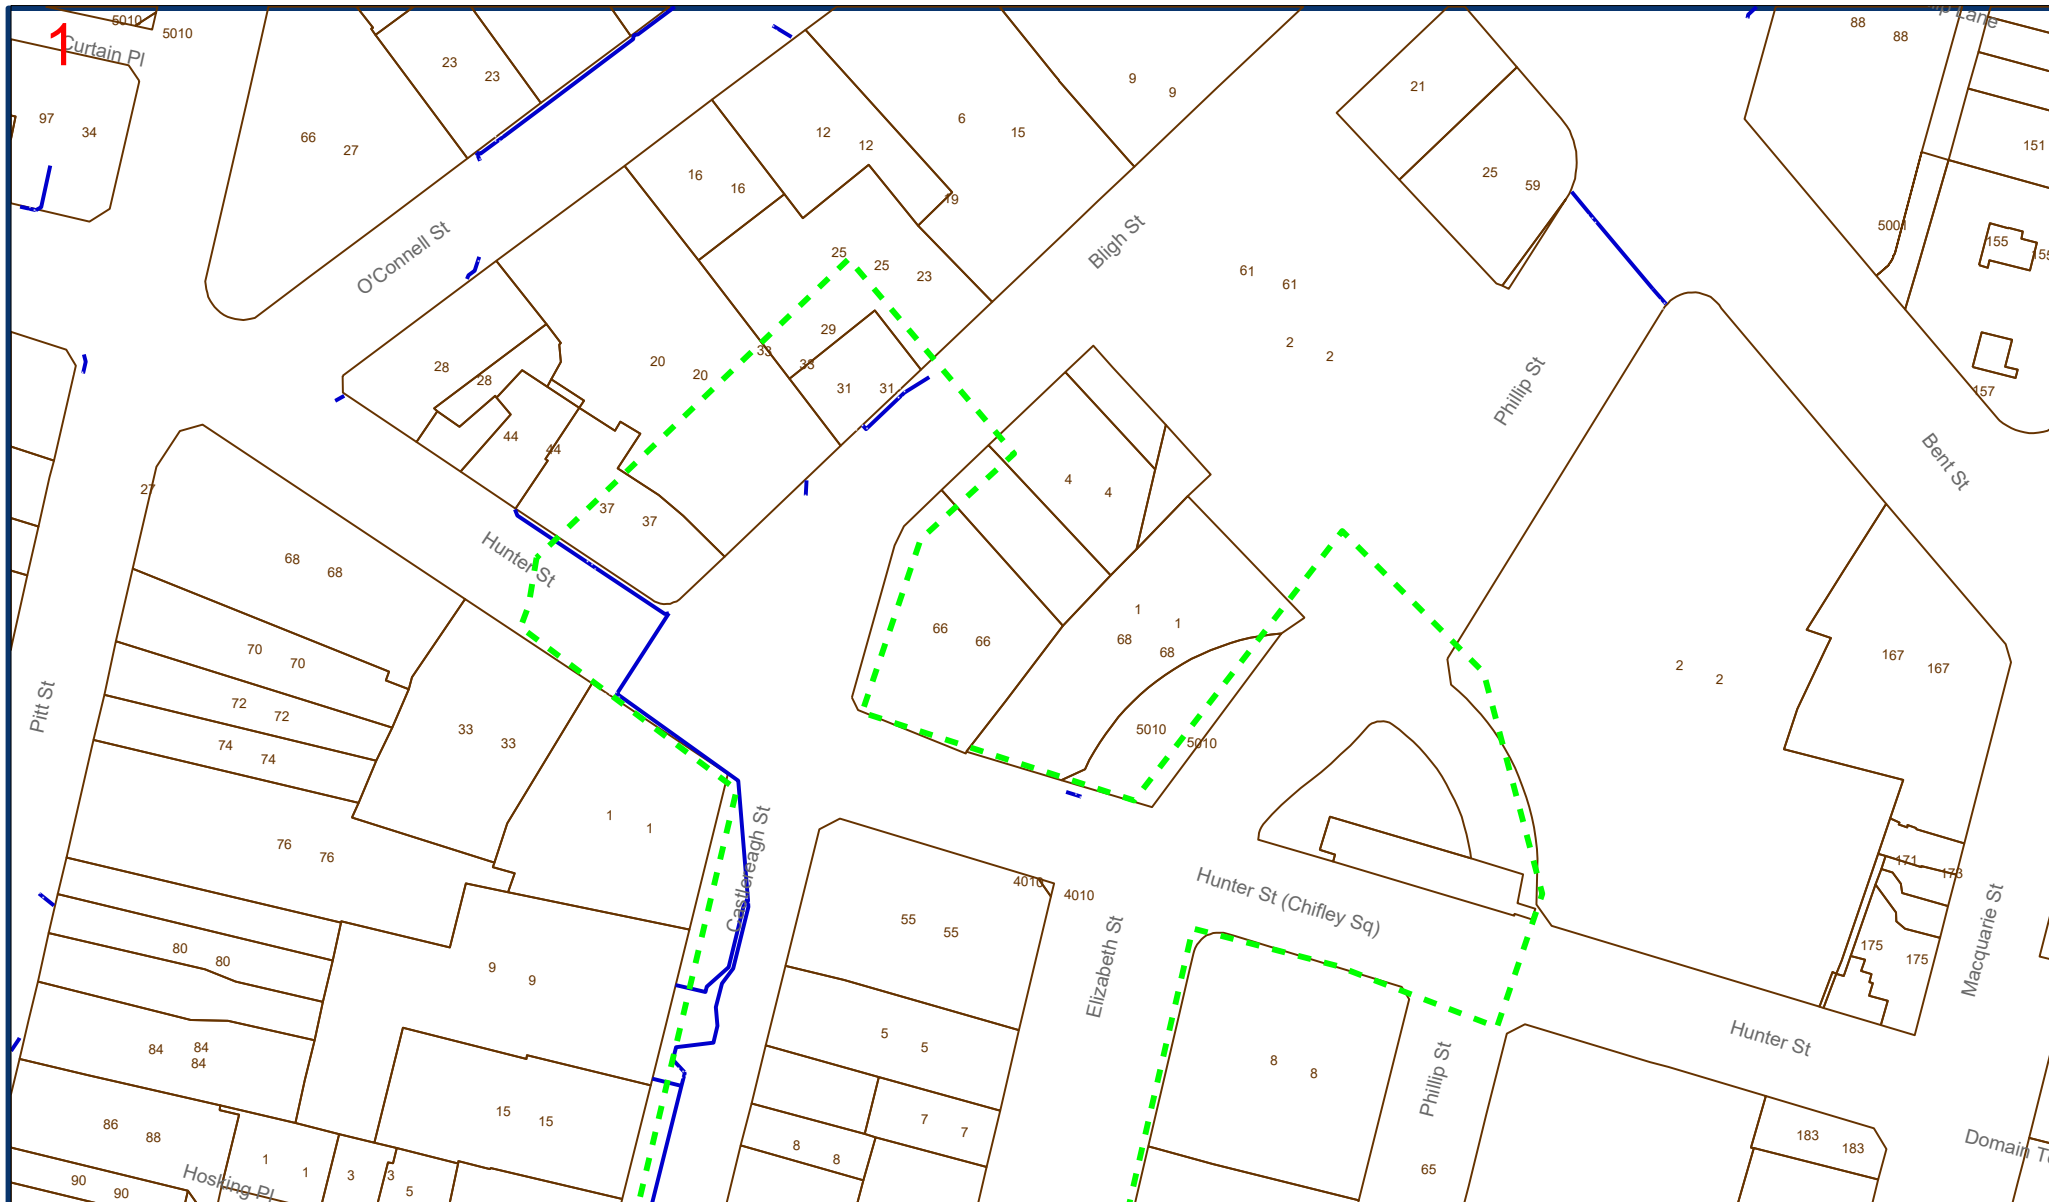

SEQUENCE NUMBER: 58207264
 JOB NUMBER: 11738734
 ADDRESS: Hunter Street Sydney

SCALE 1:1000

0 0.01km

2









SEQUENCE NUMBER: 58207264
JOB NUMBER: 11738734
ADDRESS: Hunter Street Sydney

SCALE 1:1000

0 0.01km

LEGEND

The below legend indicates the different layers within the map.

	Vocus Group Pit
	Vocus Group Conduit
	Telstra Pit
	Telstra Conduit
	Third Party Pit
	Third Party Conduit

DUTY OF CARE

When working in the vicinity of telecommunications plant, you have a legal “Duty of Care” that must be observed. The following points must be considered:

It is the responsibility of the constructor to design for protection and minimal impact of the Vocus Group plant. The Vocus Group will provide free plans showing the presence of its network to assist at the design stage. It is the constructors’ responsibility to:

- a. Request plans of the Vocus Group plant for a particular location at a reasonable time before construction begins through Dial Before You Dig.
- b. Visually locate the Vocus Group plant by vacuum excavation (potholing) where construction activities may damage or interfere with the Vocus Group plant (see “Clearances for work in the vicinity of the Vocus Group Plant” section for more information).
- c. Contact the Vocus Group (see below for details) if the Vocus Group plant is wholly or partly located near planned construction activities.

NOTE: Plans are provided free of charge up to 1 Km radius. Larger plans may incur a cost.

DAMAGE

ANY DAMAGE TO VOCUS GROUP NETWORK MUST BE REPORTED TO 1800 262 663 IMMEDIATELY

The constructor is responsible for all plant damage when works commence prior to obtaining the Vocus Group plans, or failure to follow instructions.

The Vocus Group reserves all rights to recover compensation for loss or damage to its cable network or other property including consequential losses.

ASSET RELOCATIONS

You are not permitted to relocate or alter any Vocus Group assets or network under any circumstance.

For all enquiries relating to the relocation of Vocus Group assets please email support@vocus.com.au

ON SITE LOCATION

Region	Onsite Locations Contact	Phone	Mobile	Fax
Sydney	QC Communications	(02) 9620 2407		(08) 9620 1701

The Vocus Group accepts no liability for the information provided to the Constructor by the Locators provided above. Further, the Constructor acknowledges that the Locator is the agent of the Constructor and that the Vocus Group takes no responsibility for the locators’ acts or omissions.

**If any of the above numbers are uncontactable and your call is urgent,
please call the Vocus National Service Desk on 1800 262 663**

- For all work within 2.5 metres of nominal location, the Constructor is required to prove the actual location of the plant by potholing and exposing before commencing work.
- Potholing to expose and locate the Vocus Group plant is required before work commences, at least every 3 metres where the Constructors works are parallel to the Vocus Group plant.
- The Constructor is responsible for all plant damages when works commence without the Vocus Group plans or by failure to follow advice and/or instructions from the Vocus Group.

NOTE: No machinery shall be used within 1 metre of the Vocus Group plant until the actual location has been determined by potholing using hand tools.

NOTE: No heavy earth working machinery shall be used within 5 metres of the Vocus Group plant until the actual location has been determined by potholing using hand tools.

CLEARANCES FOR WORK IN THE VICINITY OF VOCUS GROUP PLANT

These figures represent the minimum clear cover to be maintained over the Vocus Group plant. Please note that the actual cover over existing plant might be greater or less than recommended figures. Exact alignment and depths cannot be given with certainty as such levels can change over time.

Footpath and Verge Areas	450mm
Roadways	600mm

These figures represent the minimum clearance between construction and actual location of the Vocus Group plant.

Jackhammers / Pneumatic Breakers	Not within 2.5 metres of actual location
Vibrating plate or Wacker Packer compactors	Not within 500mm of actual location
Heavy Vehicle Traffic	Not to be driven across Vocus Group plant with less than 600mm cover. The constructor is to check the depth by potholing using hand tools.
Mechanical Excavators	Not within 1 metre of actual location. The constructor is to pothole and expose plant using hand tools.
Boring Equipment (in-line, horizontal and vertical)	Not within 2.5 metres of actual location. The constructor is to pothole and expose plant.

Access to the Vocus Group pits must remain accessible and at ground level at all times.

Any information provided is valid only for 30 days from the date of issue of this document. If the work operations extend beyond this period, or if the designs are altered in any way, you are requested to re-submit your proposal for re-assessment by contact Dial Before You Dig.

Phone 1100 or check the website for more details <http://www.1100.com.au>.

RESOLUTION OF POINTS OF CONFLICT

Should plant location and potholing reveal points of conflict between the Constructors planned works and the existing Vocus Group plant, the constructor should contact the Vocus Group for advice and to discuss possible solutions. The contact details are;

Fibre Operations

Phone: 1800 262 663

Email: support@vocus.com.au

Or Urgent enquiries after business hours contact 1800 262 663

Where relocation or protection of Vocus Group plant is part of an agreed solution, the costs of these works will be the responsibility of the Constructor. The Vocus Group will provide an estimated cost for works. Work by the Vocus Group will not commence until a Purchase Order is received.

ASSESSMENT OF RISK AND PROTECTIVE ACTIONS

Where protective works are required around existing Vocus Group plant, the details will be worked out on a case by case basis. Protective works are the responsibility of the Constructor.

Schedule	The Criminal Code
Chapter 10	National infrastructure
Part 10.6	Telecommunications Services
Division 474	Telecommunications offences

474.6 Interference with facilities

- (1) A person is guilty of an offence if the person tampers with, or interferes with, a facility owned or operated by:
- (a) a carrier; or
 - (b) a carriage service provider; or
 - (c) a nominated carrier.

Penalty: Imprisonment for 1 year.

- (2) For the purposes of an offence against subsection (1), absolute liability applies to the physical element of circumstance of the offence, that the facility is owned or operated by a carrier, a carriage service provider or a nominated carrier.

- (3) A person is guilty of an offence if:

(a) the person tampers with, or interferes with, a facility owned or operated by:

- (i) a carrier; or
- (ii) a carriage service provider; or
- (iii) a nominated carrier; and

(b) this conduct results in hindering the normal operation of a carriage service supplied by a carriage service provider.

Penalty: Imprisonment for 2 years.

- (4) For the purposes of an offence against subsection (3), absolute liability applies to the following physical elements of circumstance of the offence:

(a) that the facility is owned or operated by a carrier, a carriage service provider or a nominated carrier;

(b) that the carriage service is supplied by a carriage service provider.

- (5) A person is guilty of an offence if:

(a) the person uses or operates any apparatus or device (whether or not it is comprised in, connected to or used in connection with a telecommunications network); and

(b) this conduct results in hindering the normal operation of a carriage service supplied by a carriage service provider.

Penalty: Imprisonment for 2 years.

Appendix B: Combined Services Plan

LEGEND

- BH** BOREHOLE
○ TREE TRUNK
○ TREE FOLIAGE
F STREET SIGN
- ELECTRIC**
IB ELEC CABLE JUNCTION BOX
EC ELEC CABLE MARKER
EP ELEC PILLAR
EMH CABLE MANHOLE
EL ELEC POLE LIGHT
EP ELEC POWER POLE
LP LIGHT POLE
ELB ELEC JUNCTION BOX
EMH CABLE MANHOLE
- GAS**
HP GAS MARKER
GP GAS TEST POINT
GB GAS VALVE BOX
- WATER**
HP FIRE HYDRANT
WH HYDRANT
SV STOP VALVE
WT WATER TAP
- SEWER**
SLH SEWER LAMP/HOLE COVER
SMH SEWER MANHOLE
- STORMWATER**
GP GULLY PIT
DJM DRAINAGE JUNCTION MANHOLE
- COMMUNICATION**
TDP TELEPHONE DISTRIBUTION PILLAR
OPF FIBER OPTIC PIT
TP TELEPHONE PIT
TTP TWIN TELEPHONE PIT
OJB OPTICAL FIBER JUNCTION BOX
- TRAFFIC**
TL TRAFFIC LIGHTS
TSC TRAFFIC SIGNAL JUNCTION BOX
TSC TRAFFIC SIGNAL CONTROLLER
TSC TRAFFIC CONTROL SIGNAL
- MISCELLANEOUS**
UNK UNKNOWN SERVICE
GAT GATIC LID
PM PARKING METER
RUB RUBBISH BIN
G GATE
MB MAIL BOX
BH BUS SHELTER
TX TELEPHONE BOX
VC VEHICLE CROSSING
PR PRAM CROSSING

GROUND LEVELS CONTAINED IN Aerial Mapping Edited-MartinPl-Spot Heights.DWG

NOTES

1.0 ELECTRONIC FILE IS PROVIDED WITHOUT WARRANTY AND SHOULD BE USED ONLY IN CONJUNCTION WITH THE SUPPLIED PDF/PAPER COPY OF THIS PLAN.

2.0 BOUNDARIES
THE POSITION OF THE BOUNDARIES ON THE PLAN AND WITHIN THE CAD FILE ARE DERIVED FROM SURVEY ACCURATE CADASTRAL MODELING UNDERTAKEN BY RPS (APRIL 2015) AND BASED ON THE NSW LPI DIGITAL CADASTRAL DATABASE. NO FIELD INVESTIGATIONS HAVE BEEN CARRIED OUT TO CONFIRM THE LOCATION OR DIMENSIONS OF THE MODELING INVESTIGATION.

3.0 LEVELS ARE ON AUSTRALIAN HEIGHT DATUM (AHD) BASED ON THE PROJECT PRIMARY CONTROL TRAVERSE, USING PM 147421 WITH RL OF 28.993m LOCATED AT THE INTERSECTION MARTIN PLACE AND MACQUARIE ST.

4.0 ORIGIN OF CO-ORDINATES PM 147421 WITH MGA CO-ORDINATE VALUES OF E: 334536.448 N: 6251046.400

5.0 TOPOGRAPHIC DETAIL SURVEY AND MAPPING HAS BEEN CARRIED OUT BY A COMBINATION OF PHOTOGRAMMETRY AND TRADITIONAL FIELD SURVEY AND ARE ACCURATE TO ± 0.05m.

6.0 SERVICES

SURFACE INDICATORS (MANHOLES, PITS, ETC) HAVE BEEN LOCATED WHERE VISIBLE AND ACCESSIBLE EITHER BY FIELD SURVEY OR PHOTOGRAMMETRIC MAPPING. AT THE TIME OF SURVEY, SOME SERVICE INDICATORS WERE INACCESSIBLE DUE TO PARKED CARS OR VEHICULAR TRAFFIC. IN THOSE OCCURRENCES, INDICATORS HAVE BEEN LOCATED BY DIGITISING FROM DBVD AS SHOWN ON THE PLAN. THE POSITION OF UNDERGROUND SURFACE INFRASTRUCTURE SHOWN WITHIN THE DRAWING FILE DELIVERABLES HAS BEEN UNDERTAKEN FROM INTERPRETATION OF DBVD DRAWINGS (REQUEST MADE - 21/04/2015). THE EXISTENCE AND EXACT EXTENT HAS NOT BEEN CONFIRMED BY FIELD INVESTIGATION. THE POSITION AND ATTRIBUTES ARE APPROXIMATE.

- SERVICES CONNECTING SURFACE INDICATORS LOCATED BY FIELD SURVEY ARE PLOTTED TO QUALITY LEVEL C
- SERVICES DIGITISED FROM DBVD PLANS SHOWN BY PINK COLOURED LINES ARE PLOTTED TO QUALITY LEVEL D
- GAS — GAS MAIN
— ELECTRICITY — ELECTRICITY
— OPTIC FIBRE — OPTIC FIBRE
— COMMUNICATIONS — COMMUNICATIONS
— SEWER MAIN — SEWER MAIN
— TRAFFIC CONTROL SIGNALS — TRAFFIC CONTROL SIGNALS
— WATER MAIN — WATER MAIN
- ELECTRICITY SUBSTATION OR UNDERGROUND CHAMBER DIGITISED

QUALITY LEVELS BY AUSTRALIAN STANDARD

QUALITY LEVEL CLASSIFICATIONS REFLECT THE PRECISION AND ACCURACY OF UTILITY LOCATION AND ATTRIBUTE INFORMATION PURSUANT TO AS5488-2013. CLASSIFICATION OF SUBSURFACE UTILITY INFORMATION. THERE ARE 4 QUALITY LEVELS.

QUALITY LEVEL D - IS THE LOWEST OF THE FOUR QUALITY LEVELS. THE ATTRIBUTE INFORMATION AND METADATA FOR THE SUBSURFACE UTILITY WAS COMPILED FROM ANY OR A COMBINATION OF EXISTING RECORDS, CURSORY SITE INSPECTION AND ANECDOTAL EVIDENCE. D LEVEL INFORMATION DOES NOT INCLUDE ANY FIELD VERIFICATION INVOLVING DIRECT MEASUREMENT AND CAN ONLY BE CONSIDERED TO BE A BROAD INDICATION OF THE LOCATION AND TYPE OF UTILITY. TYPICALLY INDICATES THAT RECORDS SHOW AN ASSET IS PRESENT IN THE VICINITY BUT NO FIELD VERIFICATION OF SURFACE OR OTHER FEATURES WAS POSSIBLE WHATSOEVER BY GROUND SURVEY OR GEOPHYSICAL METHODS.

QUALITY LEVEL C - IS A SURFACE FEATURE CORRELATION OR AN INTERPRETATION OF THE APPROXIMATE LOCATION AND ATTRIBUTES OF A SUBSURFACE UTILITY ASSET USING A COMBINATION OF EXISTING RECORDS (AND/OR ANECDOTAL EVIDENCE) AND A SITE SURVEY OF VISIBLE EVIDENCE. THE MINIMUM REQUIREMENT FOR QUALITY LEVEL C IS RELATIVE SPATIAL POSITION. QUALITY LEVEL C INFORMATION IS COMPILED FROM FIELD OBSERVATIONS AND/OR SURVEY OF SURFACE FEATURES INDICATING THAT A UTILITY OF UNCONFIRMED ATTRIBUTES MAY RESIDE IN THE VICINITY. THIS CAN INCLUDE THE USE OF GEOPHYSICAL DETECTION METHODS FOR APPROXIMATE HORIZONTAL AND VERTICAL LOCATION. IT DOES NOT INDICATE THE LOCATION OF THE SUBSURFACE UTILITY WITH RESPECT TO THE SURFACE FEATURE (E.G. A SUBSURFACE UTILITY LINE MAY BE OFFSET FROM THE POSITION OF THE SURFACE FEATURE AND IS NOT NECESSARILY DIRECTLY BELOW IT), NOR ITS DEPTH TO ANY DEFINED ACCURACY.

QUALITY LEVEL B - PROVIDES RELATIVE SUBSURFACE FEATURE LOCATION IN THREE DIMENSIONS OR RELATIVE SPATIAL POSITION, OBTAINED BY USE OF GEOPHYSICAL DETECTION METHODS THAT HAVE A TRACE COMPONENT. THE LOCATION OF SUBSURFACE FEATURES CLASSIFIED AS LEVEL B ARE MEASURED IN TERMS OF RELATIVE SPATIAL POSITIONING WITH A MAXIMUM HORIZONTAL TOLERANCE OF ±300MM AND A MAXIMUM VERTICAL TOLERANCE OF ±500MM. QUALITY B INFORMATION IS COMPILED USING ELECTRONIC DETECTION, BUT THIS IS ONLY AN INDICATION OF THE EXISTENCE OF SUBSURFACE UTILITIES AND DOES NOT VALIDATE THE UTILITY SUBSURFACE LOCATION OR ATTRIBUTES. ELECTRONIC DETECTION CANNOT GUARANTEE ACCURATE DEPTH INFORMATION DUE TO THE POTENTIAL FOR INTERFERENCE FROM OTHER ADJACENT SERVICES OR ADVERSE GEOPHYSICAL CONDITIONS.

QUALITY LEVEL A - IS THE HIGHEST QUALITY LEVEL AND CONSISTS OF THE POSITIVE IDENTIFICATION OF THE ATTRIBUTE AND LOCATION OF A SUBSURFACE UTILITY AT A POINT TO AN ABSOLUTE SPATIAL POSITION IN THREE DIMENSIONS. IT IS THE ONLY QUALITY LEVEL THAT DEFINES A SUBSURFACE UTILITY AS "VALIDATED" WHERE THE WHOLE LINE SEGMENT CANNOT BE VERIFIED BY LINE OF SIGHT. QUALITY A SHALL NOT BE ATTRIBUTED TO THE LINE SEGMENT BETWEEN VALIDATED POINTS. QUALITY LEVEL A WILL NORMALLY INVOLVE THE PHYSICAL EXPOSURE OF THE REQUIRED ASSETS. QUALITY LEVEL A HOWEVER MAY NOT IDENTIFY THE INTERNAL STRUCTURE OR CONTENT OF THE ASSET (E.G. REDUNDANT CONDUITS AND PIPES MAY HAVE BEEN USED BY ANOTHER UTILITY OWNER E.G. FIBRE OPTIC IN OLD TELECOMMUNICATIONS CONDUITS).

ADDITIONAL NOTES ON COMMUNICATIONS SERVICES

AAPT & PIPENET WORKS
ALL CONDUITS SHOWN IN APPROXIMATE POSITION. NO ACCURATE DATA.

AMCOM
NO ACCURATE DATA.
RUNS ALONG WEST SIDE OF CASTLEREAGH ST FROM BLIGH ST TO NORTH SIDE OF MARTIN PLACE, THEN EAST SIDE OF CASTLEREAGH ST IN A SOUTHERLY DIRECTION.

VOCUS
NO ACCURATE LOCATION DATA.
CONDUITS RUNS ALONG WEST SIDE OF CASTLEREAGH ST FROM SOUTH OF MARTIN PLACE TO BLIGH ST.

AARNET DUCTS
NO ACCURATE LOCATION DATA
CONDUITS EXISTS ON
- SOUTH SIDE OF MARTIN PLACE (EAST OF ELIZABETH ST)
- EAST SIDE ELIZABETH ST.
- DOWN HUNTER ST IN BLIGH ST.

NEXTGEN
ALL CABLES IN THIRD PARTY DUCTS

OPTUS
ALL CABLES IN THIRD PARTY DUCTS WITH CONNECTIONS TO PROPERTIES. NO ACCURATE LOCATION DATA.



REVISIONS	B	11.02.2016	ADDITIONAL SURVEY COMPLETE. SERVICES ROUTES ADDED.		
	A	25.01.2016	INITIAL VERSION - POSITION OF UNDERGROUND SERVICES ROUTES TO BE REVIEWED AND SUPPLIED IN NEXT PLAN REVISION	ZHY	JC ADP
No.	DATE	REVISION DETAILS		DRAWN	CHK APP

1:500

COORDINATES: MGA ORIGIN: PM147421

DATUM: AHD ORIGIN: PM147421

10 5 0 10 20 30

SCALE IN METRES AT ORIGINAL REDUCTION RATIO

NOTES

CLIENT: NSW Transport for NSW	
SURVEY: JC	DATE OF SURVEY 04.01.2016
DRAWN: ZHY	DATE OF PLAN: 25.01.2016
CHECKED: JC	DATE LAST SAVED 22.02.2016
APPROVED: ADP	DATE APPROVED 25.01.2016

TITLE: SYDNEY METRO CITY AND SOUTH WEST Topographic Detail Survey - Martin Place Station	
DRAWING No	PR124856-27-Martin Place STN-B.dwg

JOB No	PR124856	B
www.dialbeforeyoudig.com.au	DIAL 1100 BEFORE YOU DIG	
SHEET 1	OF 1 SHEETS	SIZE A1

COPYRIGHT © RPS GROUP PLC. INFORMATION CONTAINED IN THIS DRAWING / FILE IS THE COPYRIGHT OF RPS GROUP PLC. COPYING OR USING THIS DATA IN WHOLE OR PART, IN ANY FORMAT, WITHOUT PERMISSION INFRINGES COPYRIGHT. © THIS DOCUMENT IN BOTH ELECTRONIC AND HARD COPY FORMAT IS AND SHALL REMAIN THE PROPERTY OF RPS GROUP PLC. THE INFORMATION MAY ONLY BE USED FOR THE PURPOSE FOR WHICH IT WAS COMMISSIONED AND IN ACCORDANCE WITH THE TERMS OF ENGAGEMENT FOR THE COMMISSION. UNAUTHORISED USE OF THIS INFORMATION IN ANY FORM WHATSOEVER IS PROHIBITED.

RPS AUSTRALIA EAST PTY LTD (ABN 44 140 292 762)
LEVEL 9 17 YORK STREET SYDNEY NSW 2000 GPO BOX 4401 SYDNEY NSW 2001
T: 02 9248 9800 F: 02 9248 9810 www.rpsgroup.com.au

THIS IS A COLOURED PLAN.
REPRODUCTION IN COLOUR ONLY.

creativepeople
making a difference

RPS

P:\PR124856 - SRT\27_Station Surveys\04_ACAD\PR124856-27-Martin Place STN-B.dwg 22.02.2016 3:05 PM

NOTE ON AS 5488-2013 CLASSIFICATION OF SUBSURFACE UTILITY INVESTIGATION (SUI)

Quality Levels

This Standard provides a framework for the classification of subsurface utility location and attributed information in terms of specified quality levels. The objective of this Standard is to provide utility owners, operators and locators with a framework for the consistent classification of information concerning subsurface utilities. Project risks related to underground utilities can then be properly managed.

A quality level describes the amount and accuracy of information that is collected or held on a subsurface utility.

There are four quality levels: D, C, B and A

Quality Level D (QL-D) is the lowest of these four quality levels. The attribute information and metadata of a subsurface utility can be compiled from any, or a combination of, the following:

- Existing records;
- Cursory site inspection;
- Anecdotal evidence

Quality Level C (QL-C) is described as a surface feature correlation or an interpretation of the approximate location and attributes of a subsurface utility asset using a combination of existing records (and/or anecdotal evidence) and a site survey of visible evidence. The minimum requirement for Quality Level C is relative spatial position.

Information is collected by correlating the survey of visible utility surface features such as marker plates or water hydrants and acquired dial-before-you-dig plans to 'draw' a string which shows the approximate position of services.

Quality Level B (QL-B) provides relative subsurface feature location in three dimensions. The minimum requirement for Quality Level B is relative spatial position. Information is collected by designating the horizontal and vertical location of underground utilities by using electromagnetic pipe and cable locators, sondes or flex-trace, ground penetrating radar and acoustic pulse equipment.

Quality Level A (QL-A) is the highest quality level and consists of the positive identification of the attribute and location of a subsurface utility at a point to an absolute spatial position in three dimensions. It is the only quality level that defines a subsurface utility as 'validated'. Where the whole line segment cannot be verified by line of sight, quality level A shall not be attributed to the line segment between validated points. The vertical information for this locating method is to the top or shallowest part of the located service.

PUBLIC UTILITY LEGEND

E.ELEC	E.COMMS
0" TELEPHONE DISTRIBUTION PILLAR (PTDP)	0" TELEPHONE DISTRIBUTION PILLAR (PTDP)
0" CABLE JUNCTION BOX (PEJB)	0" ABOVE GROUND JOINTING POST (PTAP)
0" CABLE MANHOLE (PEMH)	0" OPTICAL FIBRE JUNCTION BOX (PFJA)
0" DISTRIBUTION FUSE POINT	0" OPTICAL FIBRE PIT (POFP)
0" POLE - LIGHT (PLU)	0" STD 1.1m BY 1.1m MANHOLE PIT (PTMP)
0" POLE - POWER (PPU)	0" TELEPHONE BOX POINT (PTBX)
0" POLE - POWER & LIGHT (PPLU)	0" TELEPHONE TRIPLE CONCRETE PIT (PTTP)
0" POWER CABLE - UNDERGROUND (PEUP)	0" OPTICAL FIBRE-DIGITISED (DZ)
0" TRANSFORMER CABINET CENTRE (PCC)	0" OPTICAL FIBRE-UNDERGROUND (DZ)
0" HOUSE CONNECTION (EV)	0" TELEPHONE LINE-DIGITISED (DZ)
0" CONDUIT (ED)	0" TELEPHONE LINE (TN)
0" LINE-DIGITISED (ED)	0" TELEPHONE LINE-DIGITISED (DZ)
0" LINE-UNDERGROUND (EU)	0" TELEPHONE SURF (TS)
0" LINE-MINOR TRANSMISSION (UL)	
E.TCS	
0" TRAFFIC CONTROL SIGNAL (PSGL)	
0" TRAFFIC SIGNAL CONTROLLER (PSCL)	
0" TRAFFIC SIGNAL DETECTOR (PSDR)	
0" TRAFFIC SIGNAL JUNCTION BOX (PSJB)	
0" TRAFFIC SIGNAL DETECTOR (SD)	

E.COMMS (COMMUNICATIONS)

0" TELEPHONE DISTRIBUTION PILLAR (PTDP)	0" ABOVE GROUND JOINTING POST (PTAP)
0" OPTICAL FIBRE JUNCTION BOX (PFJA)	0" OPTICAL FIBRE PIT (POFP)
0" STD 1.1m BY 1.1m MANHOLE PIT (PTMP)	0" TELEPHONE BOX POINT (PTBX)
0" TELEPHONE TRIPLE CONCRETE PIT (PTTP)	0" OPTICAL FIBRE-DIGITISED (DZ)
0" OPTICAL FIBRE-UNDERGROUND (DZ)	0" TELEPHONE LINE-DIGITISED (DZ)
0" TELEPHONE LINE (TN)	0" TELEPHONE LINE-DIGITISED (DZ)
0" TELEPHONE SURF (TS)	

E.WATR

0" AIR VALVE (PNAV)	0" EARTH TERMINAL (PWET)
0" FIRE HYDRANT (PFWH)	0" HYDRANT (PWHY)
0" STOP VALVE - RECYCLED (PWSV)	0" STOP VALVE - RECYCLED (PWSV)
0" HOUSE CONNECTION (WV)	0" MAIN (WV)
0" MAIN (WV)	0" MAIN-DIGITISED (WZ)
0" MANHOLE COVER (PSMH)	0" VENT PIPE (PSVP)
0" VENT PIPE (PSVP)	0" LAMPPILE (PSLU)
0" MAN (SM)	0" MAN-DIGITISED (SZ)
0" DRAINAGE JUNCTION MANHOLE (PDJM)	0" Gully Pit Point (PSGL)
0" INLET TO SANIT (PLT)	0" INLET TO SANIT (PLT)
0" TOP OF CONCRETE JUNCTION BOX (PJBX)	0" DOWN PIPE
0" DRAINAGE PIT (DP)	0" DRAINAGE PIT (DP)
0" DRAINAGE PIPE (UNSPECIFIED DIAMETER) (DUP)	0" DRAINAGE PIPE (DUP)

E.DRAIN (SEWAGE)

0" DRAINAGE JUNCTION MANHOLE (PDJM)	0" Gully Pit Point (PSGL)
0" INLET TO SANIT (PLT)	0" INLET TO SANIT (PLT)
0" TOP OF CONCRETE JUNCTION BOX (PJBX)	0" DOWN PIPE
0" DRAINAGE PIT (DP)	0" DRAINAGE PIT (DP)
0" DRAINAGE PIPE (UNSPECIFIED DIAMETER) (DUP)	0" DRAINAGE PIPE (DUP)

E.CULT (CULTURAL)

0" BORN POST (PSBN)	0" BOLLARD (AC)
0" FLOOR LEVEL	0" CORNER OF BUILDING
0" GATE COVER (LID) (PGAT)	0" UNDETIFIED POLE (PPOL)
0" UNDETIFIED SERVICE (PUSR)	0" UNDETIFIED SERVICE (UP)
0" QUALITY LEVEL A	0" QUALITY LEVEL B
0" QUALITY LEVEL C	0" QUALITY LEVEL D
0" ELECTRICITY MAJOR TRANSMISSION LINE (QUALITY LEVEL D)	0" ELECTRICITY SUBSTATION (QUALITY LEVEL D)
0" STORMWATER CHANNEL (QUALITY LEVEL D)	

UTILITY LEGEND

0" ASBESTOS CEMENT	0" GALVANISED IRON
0" POLYVINYL CHLORIDE	0" GAS (JERMAN)
0" NOMINAL BORE (CAST IRON MAN)	0" POLYETHYLENE
0" RMBS	0" GALVANISED IRON
0" HEAVY DUTY	0" POLYVINYL CHLORIDE
0" TELSTRA & OPTUS	0" ASBESTOS CEMENT
0" CONCRETE	0" EARTHENWARE
0" GALVANISED IRON	0" POLYVINYL CHLORIDE
0" WATER (SYDNEY WATER)	0" CAST IRON CEMENT LINED
0" DUCTILE IRON CEMENT LINED	0" GALVANISED IRON
0" POLYVINYL CHLORIDE	0" VITRIFIED CLAY
0" STEEL CEMENT LINED INTERNAL BITUMEN LINED	

LEGEND

0" SURVEY CONTROL MARK	0" SURVEY SHOT R.L.
0" TELSTRA PIT - DOUBLE	0" TOP OF KERB (CONC) R.L.
0" TELSTRA PIT - SINGLE	0" BUTTER FLOW LINE (CONC) R.L.
0" WATER HYDRANT	0" LP OF KERB (CONC) R.L.
0" WATER STOP VALVE	0" TRIM MAP R.L.
0" WATER TAP	0" VERMILY LOCATED R.L.
0" SURVEY PIT (CH)	0" TOP OF WALL R.L.
0" SURVEY MANHOLE	0" BOTTOM OF WALL R.L.
0" SURVEY VENT PIPE	0" FLOOR LEVEL R.L.
0" POWER POLE	0" MOUND R.L.
0" LIGHT	0" COLUMN R.L.
0" ELECTRIC LIGHT POLE	0" SIZE OF MOUND R.L.
0" ELEC. PLANT	0" DRAINAGE PIT
0" SMALL ELEC. PIT (CH)	0" DRAINAGE PIT
0" SEWER LAMPPILE	0" URM
0" POWER POLE	0" WOLSTON
0" TELEPHONE	0" TRF
0" UNDETIFIED FEATURE	0" TRAFFIC SIGNAL JUNCTION BOX
0" UNDETIFIED FEATURE (CH)	0" TEL PIT
0" GAS WAKE BOX	0" BOUNDARY SITE
0" H.P. GAS PIPELINE MARKER	0" APPROXIMATE ADJACENT BOUNDARY
0" DATED DRAINAGE PIT - ROUND	0" EXISTENT BOUNDARY
0" DATED DRAINAGE PIT - ROUND	0" TRAFFIC LINE MARK-BREAK
0" DATED DRAINAGE PIT - ROUND	0" TRAFFIC LINE MARK-CONTINUOUS
0" DATED DRAINAGE PIT - ROUND	0" DENOTES MAJOR CONTOUR
0" DATED DRAINAGE PIT - ROUND	0" DENOTES MINOR CONTOUR

LEGEND


0" SURVEY CONTROL MARK	0" SURVEY SHOT R.L.
0" TELSTRA PIT - DOUBLE	0" TOP OF KERB (CONC) R.L.
0" TELSTRA PIT - SINGLE	0" BUTTER FLOW LINE (CONC) R.L.
0" WATER HYDRANT	0" LP OF KERB (CONC) R.L.
0" WATER STOP VALVE	0" TRIM MAP R.L.
0" WATER TAP	0" VERMILY LOCATED R.L.
0" SURVEY PIT (CH)	0" TOP OF WALL R.L.
0" SURVEY MANHOLE	0" BOTTOM OF WALL R.L.
0" SURVEY VENT PIPE	0" FLOOR LEVEL R.L.
0" POWER POLE	0" MOUND R.L.
0" LIGHT	0" COLUMN R.L.
0" ELECTRIC LIGHT POLE	0" SIZE OF MOUND R.L.
0" ELEC. PLANT	0" DRAINAGE PIT
0" SMALL ELEC. PIT (CH)	0" DRAINAGE PIT
0" SEWER LAMPPILE	0" URM
0" POWER POLE	0" WOLSTON
0" TELEPHONE	0" TRF
0" UNDETIFIED FEATURE	0" TRAFFIC SIGNAL JUNCTION BOX
0" UNDETIFIED FEATURE (CH)	0" TEL PIT
0" GAS WAKE BOX	0" BOUNDARY SITE
0" H.P. GAS PIPELINE MARKER	0" APPROXIMATE ADJACENT BOUNDARY
0" DATED DRAINAGE PIT - ROUND	0" EXISTENT BOUNDARY
0" DATED DRAINAGE PIT - ROUND	0" TRAFFIC LINE MARK-BREAK
0" DATED DRAINAGE PIT - ROUND	



10

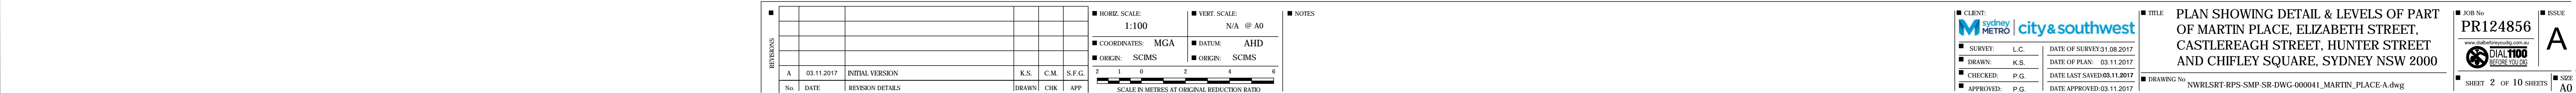

RDS

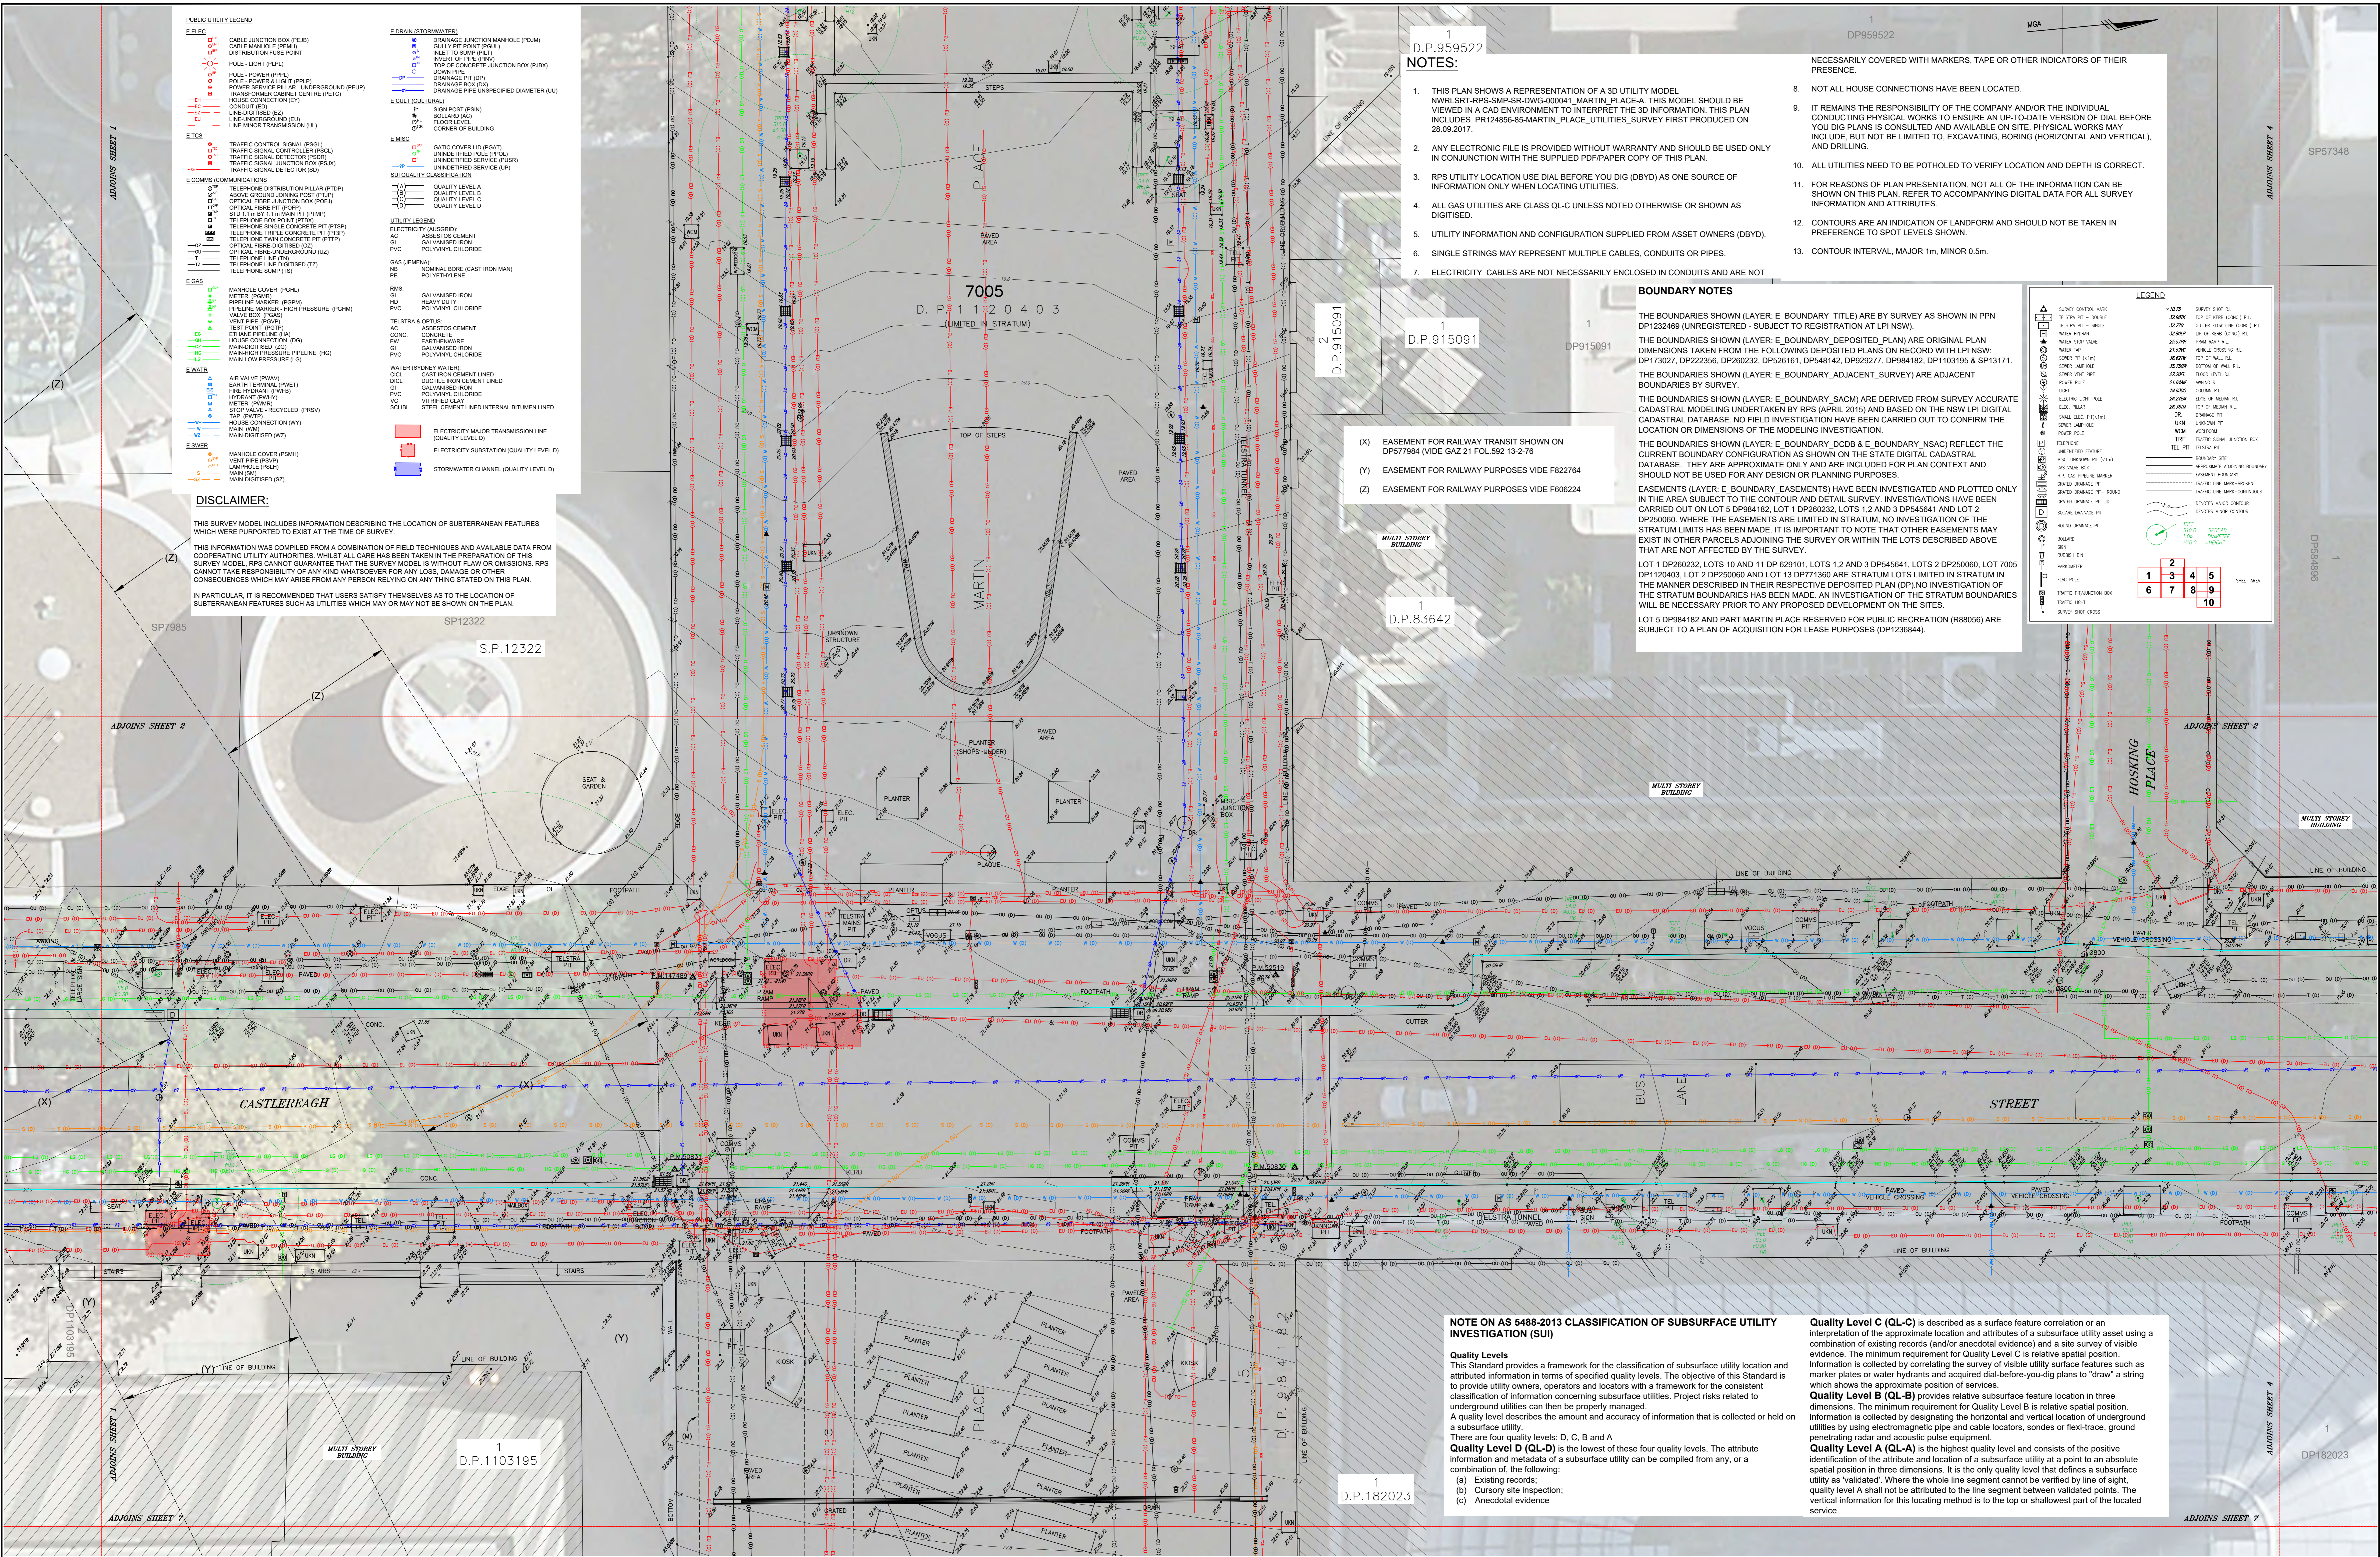

1
D.P.959522
NOTES:

1. THIS PLAN SHOWS A REPRESENTATION OF A 3D UTILITY MODEL. NVRLSRT-RPS-SMP-SR-DWG-000041 MARTIN PLACE-A. THIS MODEL SHOULD BE VIEWED IN A CAD ENVIRONMENT TO INTERPRET THE 3D INFORMATION. THIS PLAN INCLUDES PR124856-85-MARTIN_PLACE_UTILITIES_SURVEY FIRST PRODUCED ON 28.09.2017.
2. ANY ELECTRONIC FILE IS PROVIDED WITHOUT WARRANTY AND SHOULD BE USED ONLY IN CONJUNCTION WITH THE SUPPLIED PDF/PAPER COPY OF THIS PLAN.
3. RPS UTILITY LOCATION USE DIAL BEFORE YOU DIG (DBYD) AS ONE SOURCE OF INFORMATION ONLY WHEN LOCATING UTILITIES.
4. ALL GAS UTILITIES ARE CLASS QL-C UNLESS NOTED OTHERWISE OR SHOWN AS DIGITISED.
5. UTILITY INFORMATION AND CONFIGURATION SUPPLIED FROM ASSET OWNERS (DBYD).
6. SINGLE STRINGS MAY REPRESENT MULTIPLE CABLES, CONDUITS OR PIPES.
7. ELECTRICITY CABLES ARE NOT NECESSARILY ENCLOSED IN CONDUITS AND ARE NOT

- NECESSARILY COVERED WITH MARKERS, TAPE OR OTHER INDICATORS OF THEIR PRESENCE.
8. NOT ALL HOUSE CONNECTIONS HAVE BEEN LOCATED.
 9. IT REMAINS THE RESPONSIBILITY OF THE COMPANY AND/OR THE INDIVIDUAL CONDUCTING PHYSICAL WORKS TO ENSURE AN UP-TO-DATE VERSION OF DIAL BEFORE YOU DIG PLANS IS CONSULTED AND AVAILABLE ON SITE. PHYSICAL WORKS MAY INCLUDE, BUT NOT BE LIMITED TO, EXCAVATING, BORING (HORIZONTAL AND VERTICAL), AND DRILLING.
 10. ALL UTILITIES NEED TO BE POTHOLED TO VERIFY LOCATION AND DEPTH IS CORRECT.
 11. FOR REASONS OF PLAN PRESENTATION, NOT ALL OF THE INFORMATION CAN BE SHOWN ON THIS PLAN. REFER TO ACCOMPANYING DIGITAL DATA FOR ALL SURVEY INFORMATION AND ATTRIBUTES.
 12. CONTOURS ARE AN INDICATION OF LANDFORM AND SHOULD NOT BE TAKEN IN PREFERENCE TO SPOT LEVELS SHOWN.
 13. CONTOUR INTERVAL, MAJOR 1m, MINOR 0.5m.

BOUNDARY NOTES

THE BOUNDARIES SHOWN (LAYER: E_BOUNDARY_TITLE) ARE BY SURVEY AS SHOWN IN PPN DP123469 (UNREGISTERED - SUBJECT TO REGISTRATION AT LPI NSW).

THE BOUNDARIES SHOWN (LAYER: E_BOUNDARY_DEPOSITED_PLAN) ARE ORIGINAL PLAN DIMENSIONS TAKEN FROM THE FOLLOWING DEPOSITED PLANS ON RECORD WITH LPI NSW: DP173027, DP222356, DP260232, DP26161, DP548142, DP929277, DP984182, DP1103195 & SP13171.

THE BOUNDARIES SHOWN (LAYER: E_BOUNDARY_ADJACENT_SURVEY) ARE ADJACENT BOUNDARIES BY SURVEY.

THE BOUNDARIES SHOWN (LAYER: E_BOUNDARY_SACM) ARE DERIVED FROM SURVEY ACCURATE CADASTRAL MODELING UNDERTAKEN BY RPS (APRIL 2015) AND BASED ON THE NSW LPI DIGITAL CADASTRAL DATABASE. NO FIELD INVESTIGATION HAVE BEEN CARRIED OUT TO CONFIRM THE LOCATION OR DIMENSIONS OF THE MODELING INVESTIGATION.

THE BOUNDARIES SHOWN (LAYER: E_BOUNDARY_DCDB & E_BOUNDARY_NSAC) REFLECT THE CURRENT BOUNDARY CONFIGURATION AS SHOWN ON THE STATE DIGITAL CADASTRAL DATABASE. THEY ARE APPROXIMATE ONLY AND ARE INCLUDED FOR PLAN CONTEXT AND SHOULD NOT BE USED FOR ANY DESIGN OR PLANNING PURPOSES.

EASEMENTS (LAYER: E_BOUNDARY_EASEMENTS) HAVE BEEN INVESTIGATED AND PLOTTED ONLY IN THE AREA SUBJECT TO THE CONTOUR AND DETAIL SURVEY. INVESTIGATIONS HAVE BEEN CARRIED OUT ON LOT 5 DP984182, LOT 1 DP260232, LOTS 1 & 2 AND 3 DP545641 AND LOT 2 DP250060. WHERE THE EASEMENTS ARE LIMITED IN STRUTUM, NO INVESTIGATION OF THE STRUTUM LIMITS HAS BEEN MADE. IT IS IMPORTANT TO NOTE THAT OTHER EASEMENTS MAY EXIST IN OTHER PARCELS ADJOINING THE SURVEY OR WITHIN THE LOTS DESCRIBED ABOVE THAT ARE NOT AFFECTED BY THE SURVEY.

LOT 1 DP260232, LOTS 10 AND 11 DP 628101, LOTS 1 & 2 AND 3 DP545641, LOTS 2 DP250060, LOT 7005 DP1120403, LOT 2 DP250060 AND LOT 13 DP771360 ARE STRUTUM LOTS LIMITED IN STRUTUM IN THE MANNER DESCRIBED IN THEIR RESPECTIVE DEPOSITED PLAN (DP) NO INVESTIGATION OF THE STRUTUM BOUNDARIES HAS BEEN MADE. AN INVESTIGATION OF THE STRUTUM BOUNDARIES WILL BE NECESSARY PRIOR TO ANY PROPOSED DEVELOPMENT ON THE SITES.

LOT 5 DP984182 AND PART MARTIN PLACE RESERVED FOR PUBLIC RECREATION (R88056) ARE SUBJECT TO A PLAN OF ACQUISITION FOR LEASE PURPOSES (DP1236844).

LEGEND	
	10.75 SURVEY SHOT R.L.
	20.000 TOP OF NEW CONCRETE R.L.
	35.700 OUTER FLOW LINE (CONC) R.L.
	35.800 UP OF NEW CONCRETE R.L.
	25.500 FLOW RAMP R.L.
	21.500 VEHICLE CROSSING R.L.
	35.000 TOP OF NEW R.L.
	21.500 FLOOR LEVEL R.L.
	21.000 ANGLE R.L.
	18.800 COLUMN R.L.
	20.400 SIDE OF ROAD R.L.
	25.500 TOP OF NEW R.L.
	DR. DRAINAGE R.L.
	UNKN. UNKNOWN R.L.
	WOM. WORKDOWN
	TRF. TRAFFIC SIGNAL JUNCTION BOX
	TEL. TEL. PIT
	BOUNDARY SITE
	APPROXIMATE ALLOCATING BOUNDARY
	EASEMENT BOUNDARY
	TRAFFIC LINE MARK-OBSSTRUCTION
	GRATED DRAINAGE PIT - ROUND
	GRATED DRAINAGE PIT - SQUARE
	GRATED DRAINAGE PIT - ROUND
	GRATED DRAINAGE PIT - SQUARE
	TREE
	STO. - SPREAD
	FL. - FLOW
	H2O - HEIGHT

1	2	3	4	5
6	7	8	9	10


SHEET AREA

- (X) EASEMENT FOR RAILWAY TRANSIT SHOWN ON DP577984 (VIDE GAZ 21 FOL.592 13-2-76)
- (Y) EASEMENT FOR RAILWAY PURPOSES VIDE F822764
- (Z) EASEMENT FOR RAILWAY PURPOSES VIDE F060224

NOTE ON AS 5488-2013 CLASSIFICATION OF SUBSURFACE UTILITY INVESTIGATION (SUI)

Quality Levels
This Standard provides a framework for the classification of subsurface utility location and attributed information in terms of specified quality levels. The objective of this Standard is to provide utility owners, operators and locators with a framework for the consistent classification of information concerning subsurface utilities. Project risks related to underground utilities can then be properly managed.
A quality level describes the amount and accuracy of information that is collected or held on a subsurface utility.
There are four quality levels: D, C, B and A.
Quality Level D (QL-D) is the lowest of these four quality levels. The attribute identification and metadata of a subsurface utility can be compiled from any, or a combination of, the following:
(a) Existing records;
(b) Cursory site inspection;
(c) Anecdotal evidence


Quality Level C (QL-C) is described as a surface feature correlation or an interpretation of the approximate location and attributes of a subsurface utility asset using a combination of existing records (and/or anecdotal evidence) and a site survey of visible evidence. The minimum requirement for Quality Level C is relative spatial position. Information is collected by correlating the survey of visible utility surface features such as marker plates or water hydrants and acquired dial-before-you-dig plans to "draw" a string which shows the approximate position of services.
Quality Level B (QL-B) provides relative subsurface feature location in three dimensions. The minimum requirement for Quality Level B is relative spatial position. Information is collected by designating the horizontal and vertical location of underground utilities by using electromagnetic pipe and cable locators, sondes or flexi-trace, ground penetrating radar and acoustic pulse equipment.
Quality Level A (QL-A) is the highest quality level and consists of the positive identification and location of a subsurface utility at a point to an absolute spatial position in three dimensions. It is the only quality level that defines a subsurface utility as "validated". Where the whole line segment cannot be verified by line of sight, quality level A shall not be attributed to the line segment between validated points. The vertical information for this locating method is to the top or shallowest part of the located service.

REVISIONS						■ HORIZ. SCALE:			■ VERT. SCALE:			■ NOTES		
						1:100			N/A @ A0					
						■ COORDINATES: MGA			■ DATUM: AHD					
						■ ORIGIN: SCMS			■ ORIGIN: SCMS					
A 03.11.2017 INITIAL VERSION			K.S. C.M. S.F.G.			2 1 0 2 4 6								
No. DATE REVISION DETAILS			DRAWN CHK APP						SCALE IN METERS BY ORIGINAL REDUCTION RATIO					

CLIENT:	Sydney Metro City & Southwest
SURVEY:	L.C.
DRAWN:	K.S.
CHECKED:	P.G.
APPROVED:	P.G.
DATE OF SURVEY:	28.09.2017
DATE OF PLAN:	03.11.2017
DATE LAST SAVED:	03.11.2017
DATE APPROVED:	03.11.2017

TITLE
PLAN SHOWING DETAIL & LEVELS OF PART OF MARTIN PLACE, ELIZABETH STREET, CASTLEREAGH STREET, HUNTER STREET AND CHIFLEY SQUARE, SYDNEY NSW 2000

JOB No.	PR124856	ISSUE
DATE	03.11.2017	
SHEET	3 OF 10 SHEETS	A0

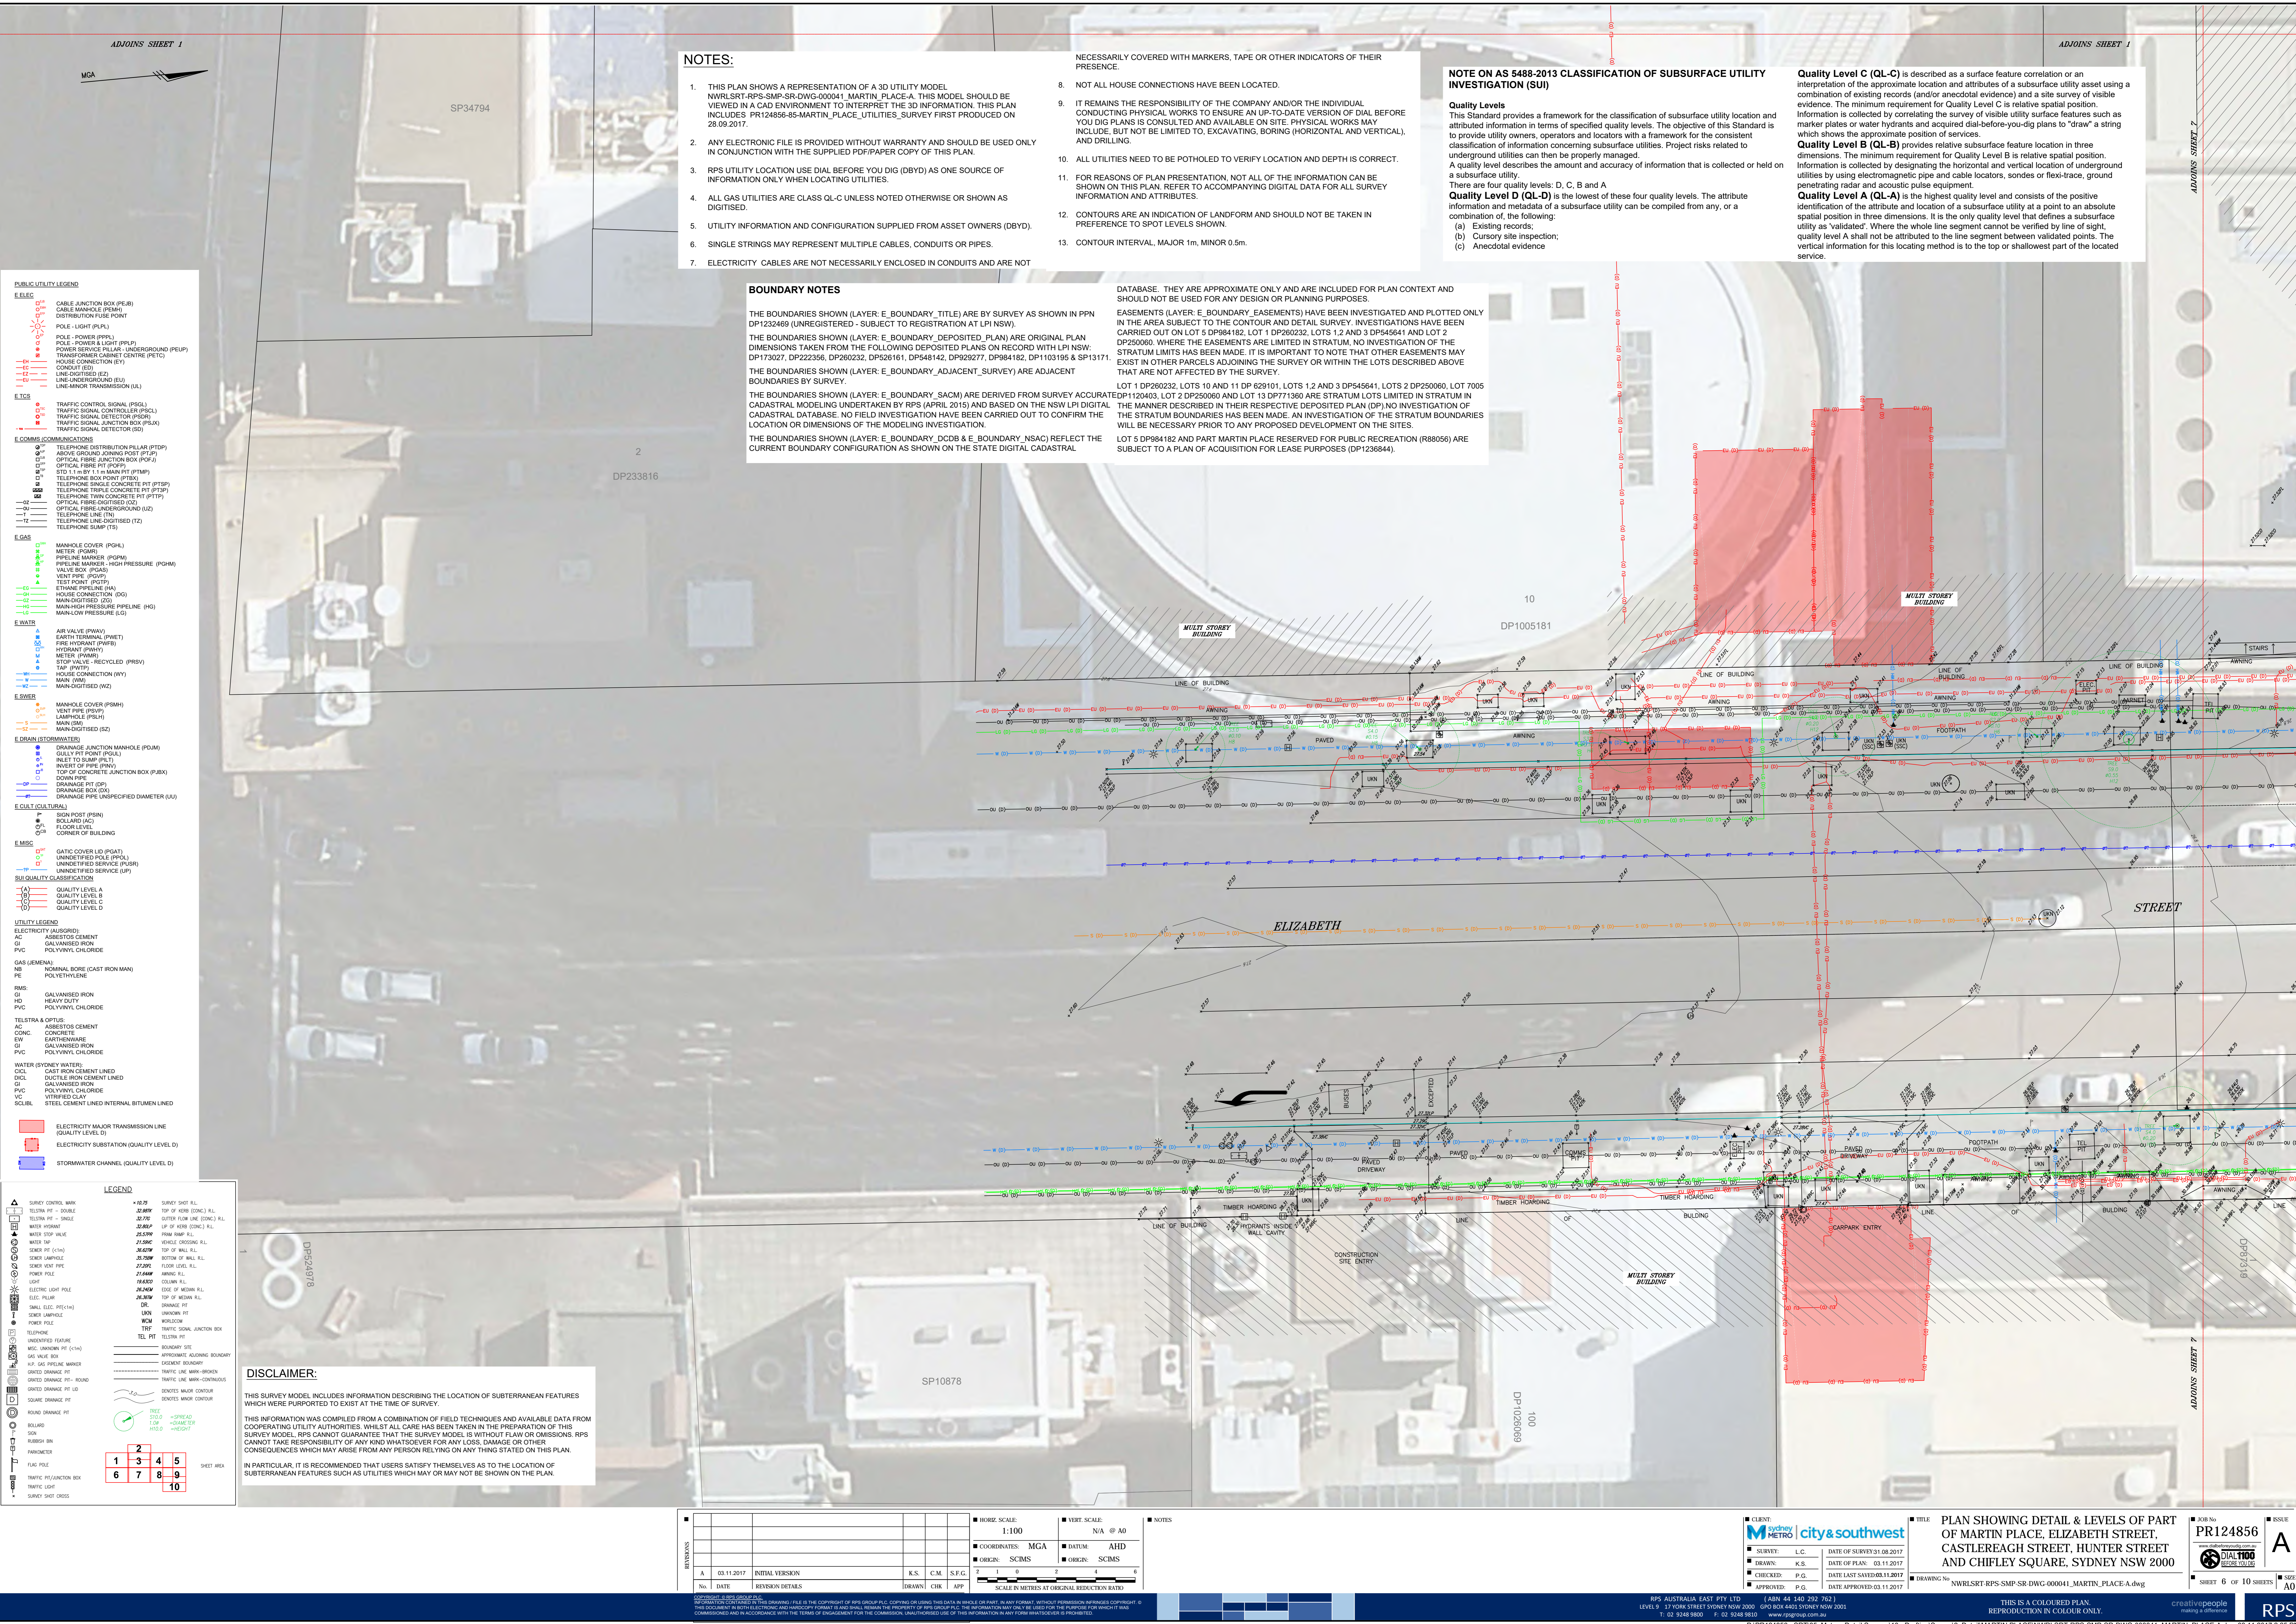

NOTES:

- THIS PLAN SHOWS A REPRESENTATION OF A 3D UTILITY MODEL. NVRLSR-RPS-SMP-SR-DWG-000041 MARTIN_PLACE_UTILITIES_SURVEY FIRST PRODUCED ON 28.09.2017.
- ANY ELECTRONIC FILE IS PROVIDED WITHOUT WARRANTY AND SHOULD BE USED ONLY IN CONJUNCTION WITH THE SUPPLIED PDF/PAPER COPY OF THIS PLAN.
- RPS UTILITY LOCATION USE DIAL BEFORE YOU DIG (DBYD) AS ONE SOURCE OF INFORMATION ONLY WHEN LOCATING UTILITIES.
- ALL GAS UTILITIES ARE CLASS QL-C UNLESS NOTED OTHERWISE OR SHOWN AS DIGITISED.
- UTILITY INFORMATION AND CONFIGURATION SUPPLIED FROM ASSET OWNERS (DBYD).
- SINGLE STRINGS MAY REPRESENT MULTIPLE CABLES, CONDUITS OR PIPES.
- ELECTRICITY CABLES ARE NOT NECESSARILY ENCLOSED IN CONDUITS AND ARE NOT NECESSARILY COVERED WITH MARKERS, TAPE OR OTHER INDICATORS OF THEIR PRESENCE.
- NOT ALL HOUSE CONNECTIONS HAVE BEEN LOCATED.
- IT REMAINS THE RESPONSIBILITY OF THE COMPANY AND/OR THE INDIVIDUAL CONDUCTING PHYSICAL WORKS TO ENSURE AN UP-TO-DATE VERSION OF DIAL BEFORE YOU DIG PLANS IS CONSULTED AND AVAILABLE ON SITE. PHYSICAL WORKS MAY INCLUDE, BUT NOT BE LIMITED TO, EXCAVATING, BORING (HORIZONTAL AND VERTICAL), AND DRILLING.
- ALL UTILITIES NEED TO BE POTHOLED TO VERIFY LOCATION AND DEPTH IS CORRECT.
- FOR REASONS OF PLAN PRESENTATION, NOT ALL OF THE INFORMATION CAN BE SHOWN ON THIS PLAN. REFER TO ACCOMPANYING DIGITAL DATA FOR ALL SURVEY INFORMATION AND ATTRIBUTES.
- CONTOURS ARE AN INDICATION OF LANDFORM AND SHOULD NOT BE TAKEN IN PREFERENCE TO SPOT LEVELS SHOWN.
- CONTOUR INTERVAL, MAJOR 1m, MINOR 0.5m.

BOUNDARY NOTES

THE BOUNDARIES SHOWN (LAYER: E_BOUNDARY_TITLE) ARE BY SURVEY AS SHOWN IN PPN DP1232469 (UNREGISTERED - SUBJECT TO REGISTRATION AT LPI NSW).

THE BOUNDARIES SHOWN (LAYER: E_BOUNDARY_DEPOSITED_PLAN) ARE ORIGINAL PLAN DIMENSIONS TAKEN FROM THE FOLLOWING DEPOSITED PLANS ON RECORD WITH LPI NSW: DP173027, DP222356, DP260232, DP526161, DP848142, DP929277, DP984182, DP103195 & SP13171.

THE BOUNDARIES SHOWN (LAYER: E_BOUNDARY_ADJACENT_SURVEY) ARE ADJACENT BOUNDARIES BY SURVEY.

THE BOUNDARIES SHOWN (LAYER: E_BOUNDARY_SACM) ARE DERIVED FROM SURVEY ACCURATED DP1120403, LOT 2 DP250060 AND LOT 13 DP771360 ARE STRATUM LOTS LIMITED IN STRATUM IN THE MANNER DESCRIBED IN THEIR RESPECTIVE DEPOSITED PLAN (DP) NO INVESTIGATION OF THE STRATUM BOUNDARIES HAS BEEN MADE. AN INVESTIGATION OF THE STRATUM BOUNDARIES WILL BE NECESSARY PRIOR TO ANY PROPOSED DEVELOPMENT ON THE SITES.

THE BOUNDARIES SHOWN (LAYER: E_BOUNDARY_DCCB & E_BOUNDARY_NSAC) REFLECT THE CURRENT BOUNDARY CONFIGURATION AS SHOWN ON THE STATE DIGITAL CADASTRAL DATABASE. THEY ARE APPROXIMATE ONLY AND ARE INCLUDED FOR PLAN CONTEXT AND SHOULD NOT BE USED FOR ANY DESIGN OR PLANNING PURPOSES.

EASEMENTS (LAYER: E_BOUNDARY_EASEMENTS) HAVE BEEN INVESTIGATED AND PLOTTED ONLY IN THE AREA SUBJECT TO THE CONTOUR AND DETAIL SURVEY. INVESTIGATIONS HAVE BEEN CARRIED OUT ON LOT 5 DP984182, LOT 1 DP260232, LOTS 1,2 AND 3 DP545641 AND LOT 2 DP250060. WHERE THE EASEMENTS ARE LIMITED IN STRATUM, NO INVESTIGATION OF THE STRATUM LIMITS HAS BEEN MADE. IT IS IMPORTANT TO NOTE THAT OTHER EASEMENTS MAY EXIST IN OTHER PARCELS ADJOINING THE SURVEY OR WITHIN THE LOTS DESCRIBED ABOVE THAT ARE NOT AFFECTED BY THE SURVEY.

LOT 1 DP260232, LOTS 10 AND 11 DP 629101, LOTS 1,2 AND 3 DP545641, LOTS 2 DP250060, LOT 7005 DP1120403, LOT 2 DP250060 AND LOT 13 DP771360 ARE STRATUM LOTS LIMITED IN STRATUM IN THE MANNER DESCRIBED IN THEIR RESPECTIVE DEPOSITED PLAN (DP) NO INVESTIGATION OF THE STRATUM BOUNDARIES HAS BEEN MADE. AN INVESTIGATION OF THE STRATUM BOUNDARIES WILL BE NECESSARY PRIOR TO ANY PROPOSED DEVELOPMENT ON THE SITES.

LOT 5 DP984182 AND PART MARTIN PLACE RESERVED FOR PUBLIC RECREATION (R88056) ARE SUBJECT TO A PLAN OF ACQUISITION FOR LEASE PURPOSES (DP1236844).

NOTE ON AS 5488-2013 CLASSIFICATION OF SUBSURFACE UTILITY INVESTIGATION (SUI)

Quality Levels

This Standard provides a framework for the classification of subsurface utility location and attributed information in terms of specified quality levels. The objective of this Standard is to provide utility owners, operators and locators with a framework for the consistent classification of information concerning subsurface utilities. Project risks related to underground utilities can then be properly managed.

A quality level describes the amount and accuracy of information that is collected or held on a subsurface utility.

There are four quality levels: D, C, B and A.

Quality Level D (QL-D) is the lowest of these four quality levels. The attribute identification of the attribute and location of a subsurface utility can be compiled from any, or a combination of, the following:

- Existing records;
- Cursory site inspection;
- Anecdotal evidence

Quality Level C (QL-C) is described as a surface feature correlation or an interpretation of the approximate location and attributes of a subsurface utility asset using a combination of existing records (and/or anecdotal evidence) and a site survey of visible evidence. The minimum requirement for Quality Level C is relative spatial position. Information is collected by correlating the survey of visible utility surface features such as marker plates or water hydrants and acquired dial-before-you-dig plans to "draw" a string which shows the approximate position of services.

Quality Level B (QL-B) provides relative subsurface feature location in three dimensions. The minimum requirement for Quality Level B is relative spatial position. Information is collected by designating the horizontal and vertical location of underground utilities by using electromagnetic pipe and cable locators, sondes or flexi-trace, ground penetrating radar and acoustic pulse equipment.

Quality Level A (QL-A) is the highest quality level and consists of the positive identification of the attribute and location of a subsurface utility at a point to an absolute spatial position in three dimensions. It is the only quality level that defines a subsurface utility as 'validated'. Where the whole line segment cannot be verified by line of sight, quality level A shall not be attributed to the line segment between validated points. The vertical information for this locating method is to the top or shallowest part of the located service.

DISCLAIMER:

THIS SURVEY MODEL INCLUDES INFORMATION DESCRIBING THE LOCATION OF SUBTERRANEAN FEATURES WHICH WERE PURPORTED TO EXIST AT THE TIME OF SURVEY.

THIS INFORMATION WAS COMPILED FROM A COMBINATION OF FIELD TECHNIQUES AND AVAILABLE DATA FROM COOPERATING UTILITY AUTHORITIES. WHILE ALL CARE HAS BEEN TAKEN IN THE PREPARATION OF THIS SURVEY MODEL, RPS CANNOT GUARANTEE THAT THE SURVEY MODEL IS WITHOUT FLAW OR OMISSIONS. RPS CANNOT TAKE RESPONSIBILITY OF ANY KIND WHATSOEVER FOR ANY LOSS, DAMAGE OR OTHER CONSEQUENCES WHICH MAY ARISE FROM ANY PERSON RELYING ON ANY THING STATED ON THIS PLAN.

IN PARTICULAR, IT IS RECOMMENDED THAT USERS SATISFY THEMSELVES AS TO THE LOCATION OF SUBTERRANEAN FEATURES SUCH AS UTILITIES WHICH MAY OR MAY NOT BE SHOWN ON THE PLAN.

LEGEND	
	10.75 SURVEY CONTROL MARK
	20.00 TETRA PT - DOUBLE
	20.75 TETRA PT - SINGLE
	20.00 WATER HOIST
	25.00 WATER STOP VALVE
	25.00 WATER TAP
	25.00 WATER METER (1/4")
	25.00 WATER MANHOLE
	25.00 WATER VENT PIPE
	25.00 LIGHT
	25.00 ELECTRIC LIGHT POLE
	25.00 ELECTRIC POLE
	25.00 SMALL ELECTRIC POLE (1/4")
	25.00 WATER MANHOLE
	25.00 POWER POLE
	25.00 TELEPHONE
	25.00 UNDERTAKEN FEATURE
	25.00 WATER MANHOLE (1/4")
	25.00 WATER STOP VALVE
	25.00 WATER TAP
	25.00 WATER METER (1/4")
	25.00 WATER MANHOLE
	25.00 WATER VENT PIPE
	25.00 LIGHT
	25.00 ELECTRIC LIGHT POLE
	25.00 ELECTRIC POLE
	25.00 SMALL ELECTRIC POLE

