





[illegible]


SERVICE LEGEND	
SOFFIT IL	0.00
FLOOR RL	0.00

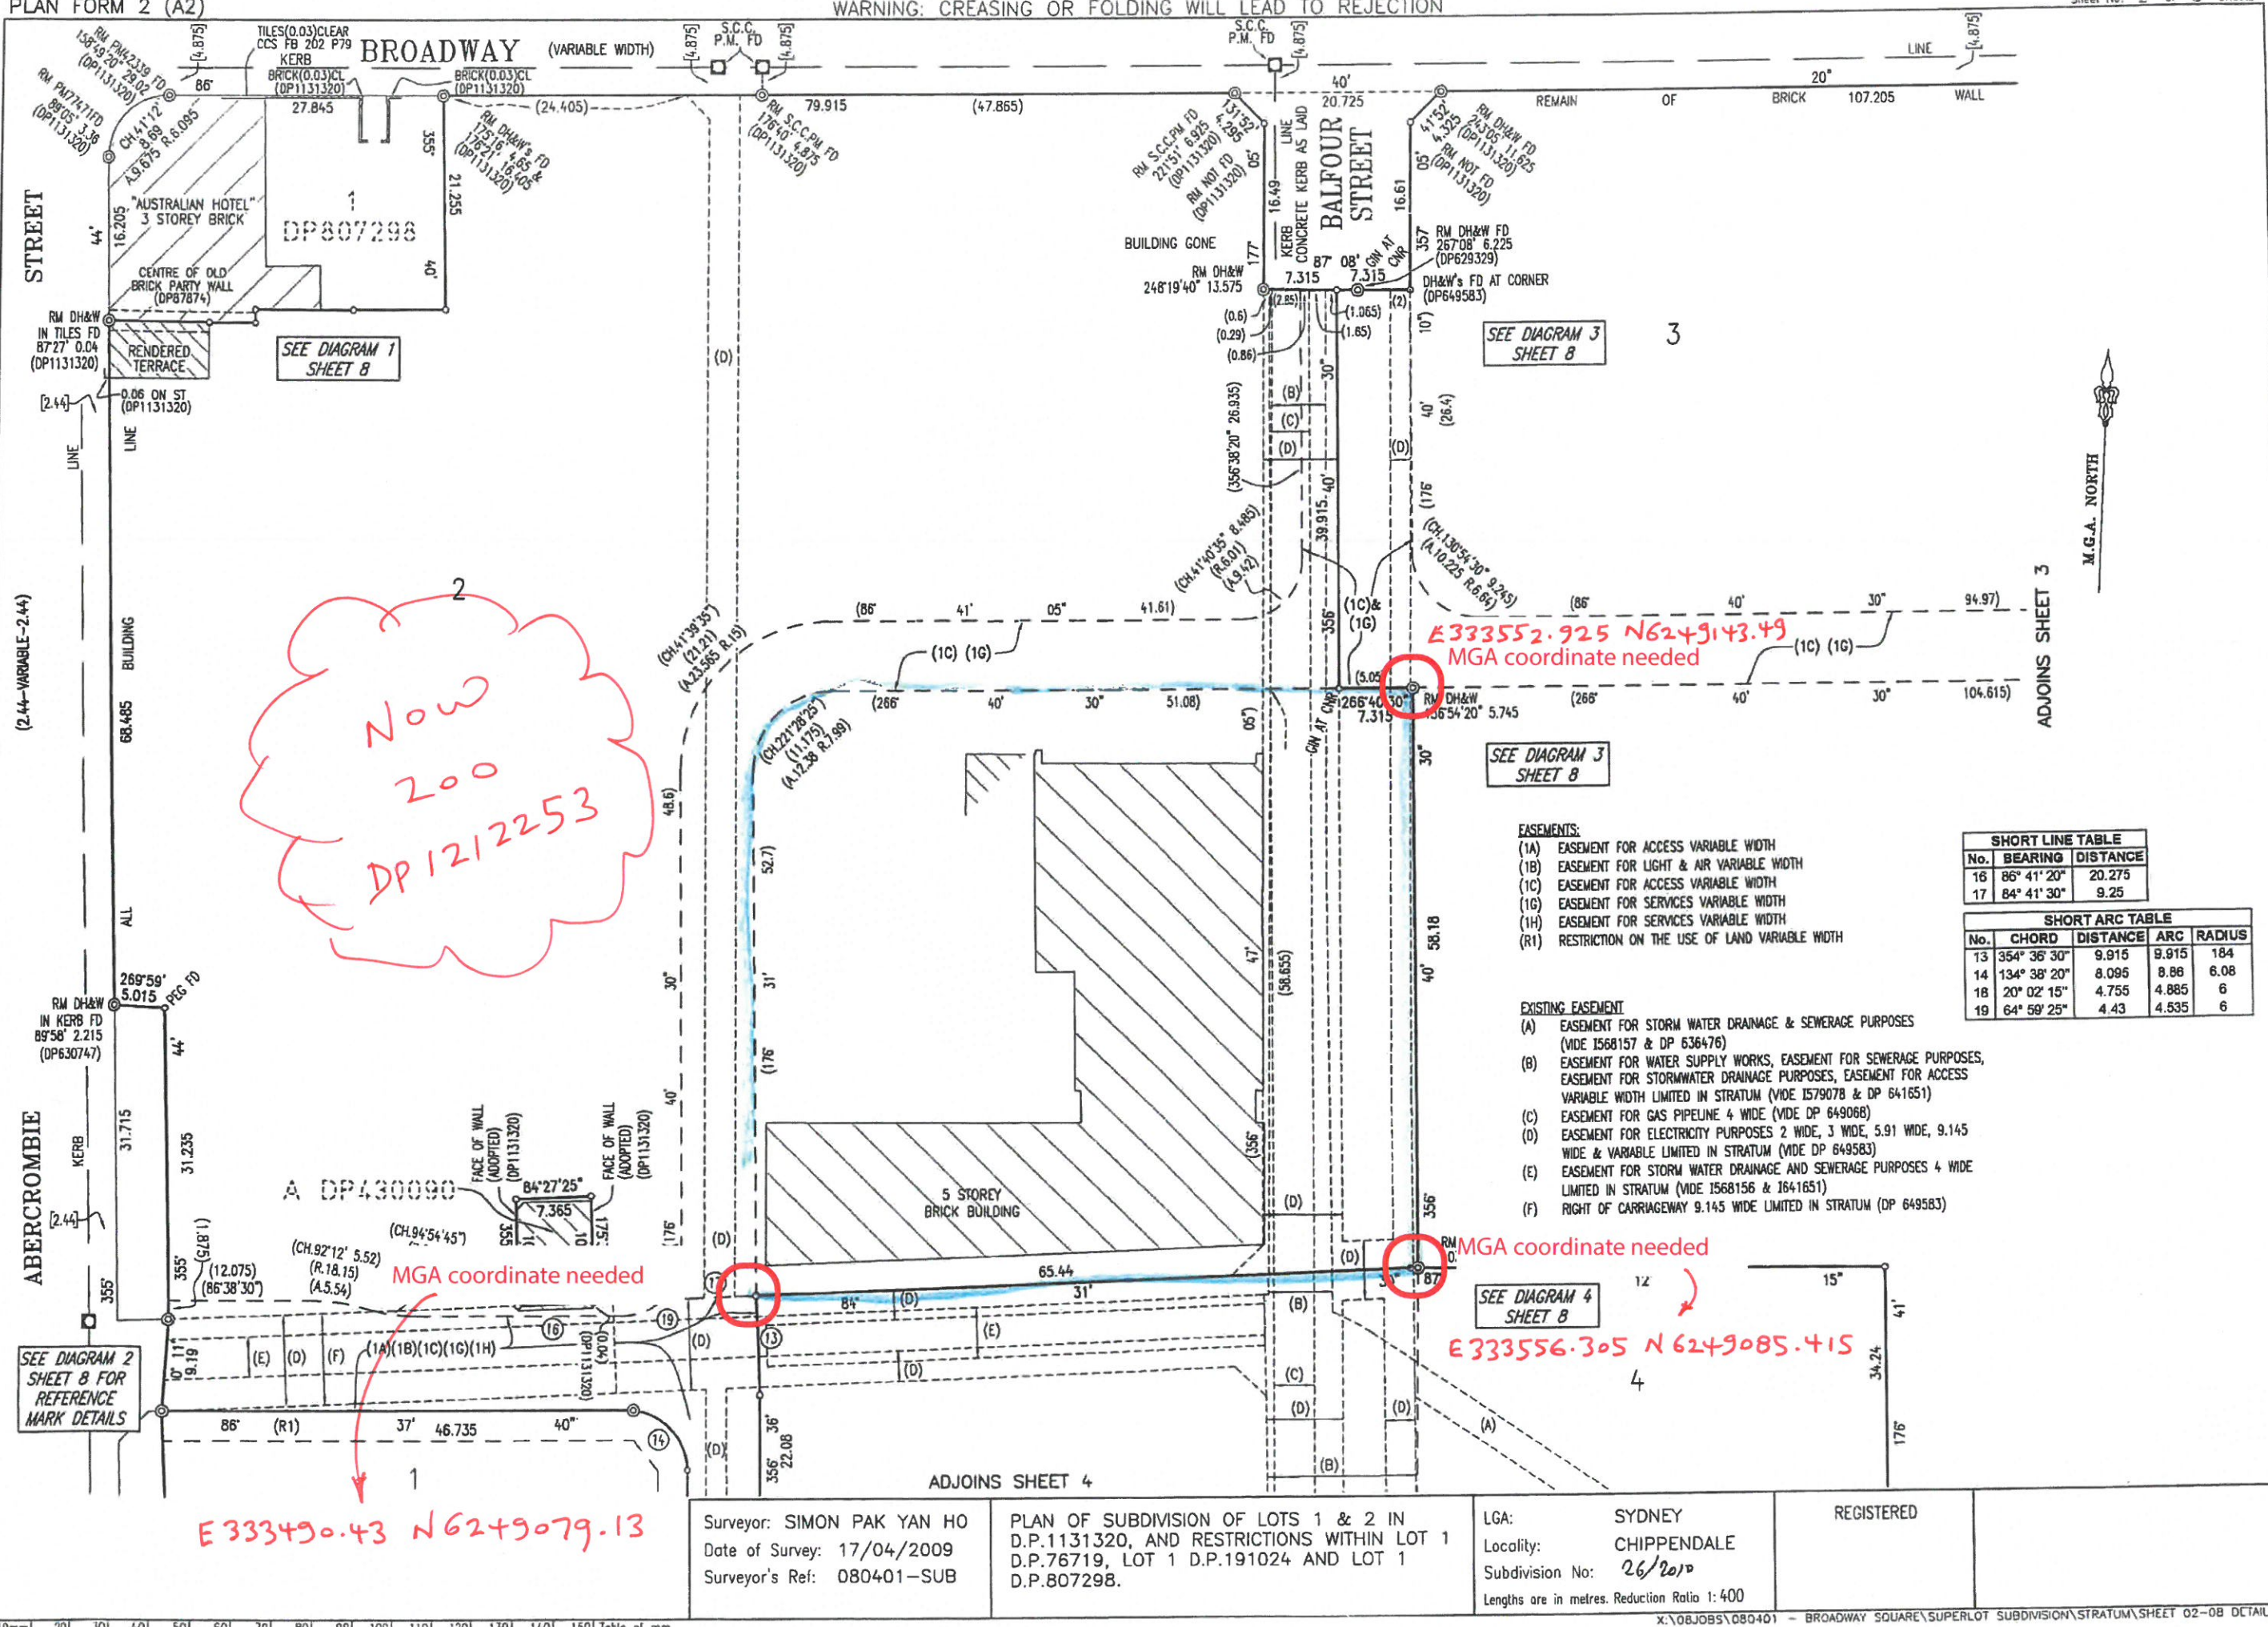


					Land Surveys Unit 8, 3 Gibbes Street Chatswood NSW 2067 T (02) 9439 6925 E sydney@landsurveys.net.au www.landsurveys.net.au	SURVEYED BY: T.J. SURVEYED ON: 24.09.18 DRAWN BY: BW DRAWN ON: 28.09.18 HOR DATUM: MGA VERT DATUM: AHD CLIENT: JOHN STAFF	CENTRAL PARK CHIPPENDALE BASEMENT 2				
					SCALE @ A2 : 1:200	This document is & shall remain the property of Land Surveys NPJS Pty Ltd. The document may only be used for the purpose for which it was commissioned & in accordance with the terms of engagement for the commission. Unauthorised use of this document in any way is prohibited. JOB No. PLAN DRG REV SHEET LAN-SU-DR - AS - 001 - A1 OF 1					
REV	DESCRIPTION	DRN	DATE	APP							

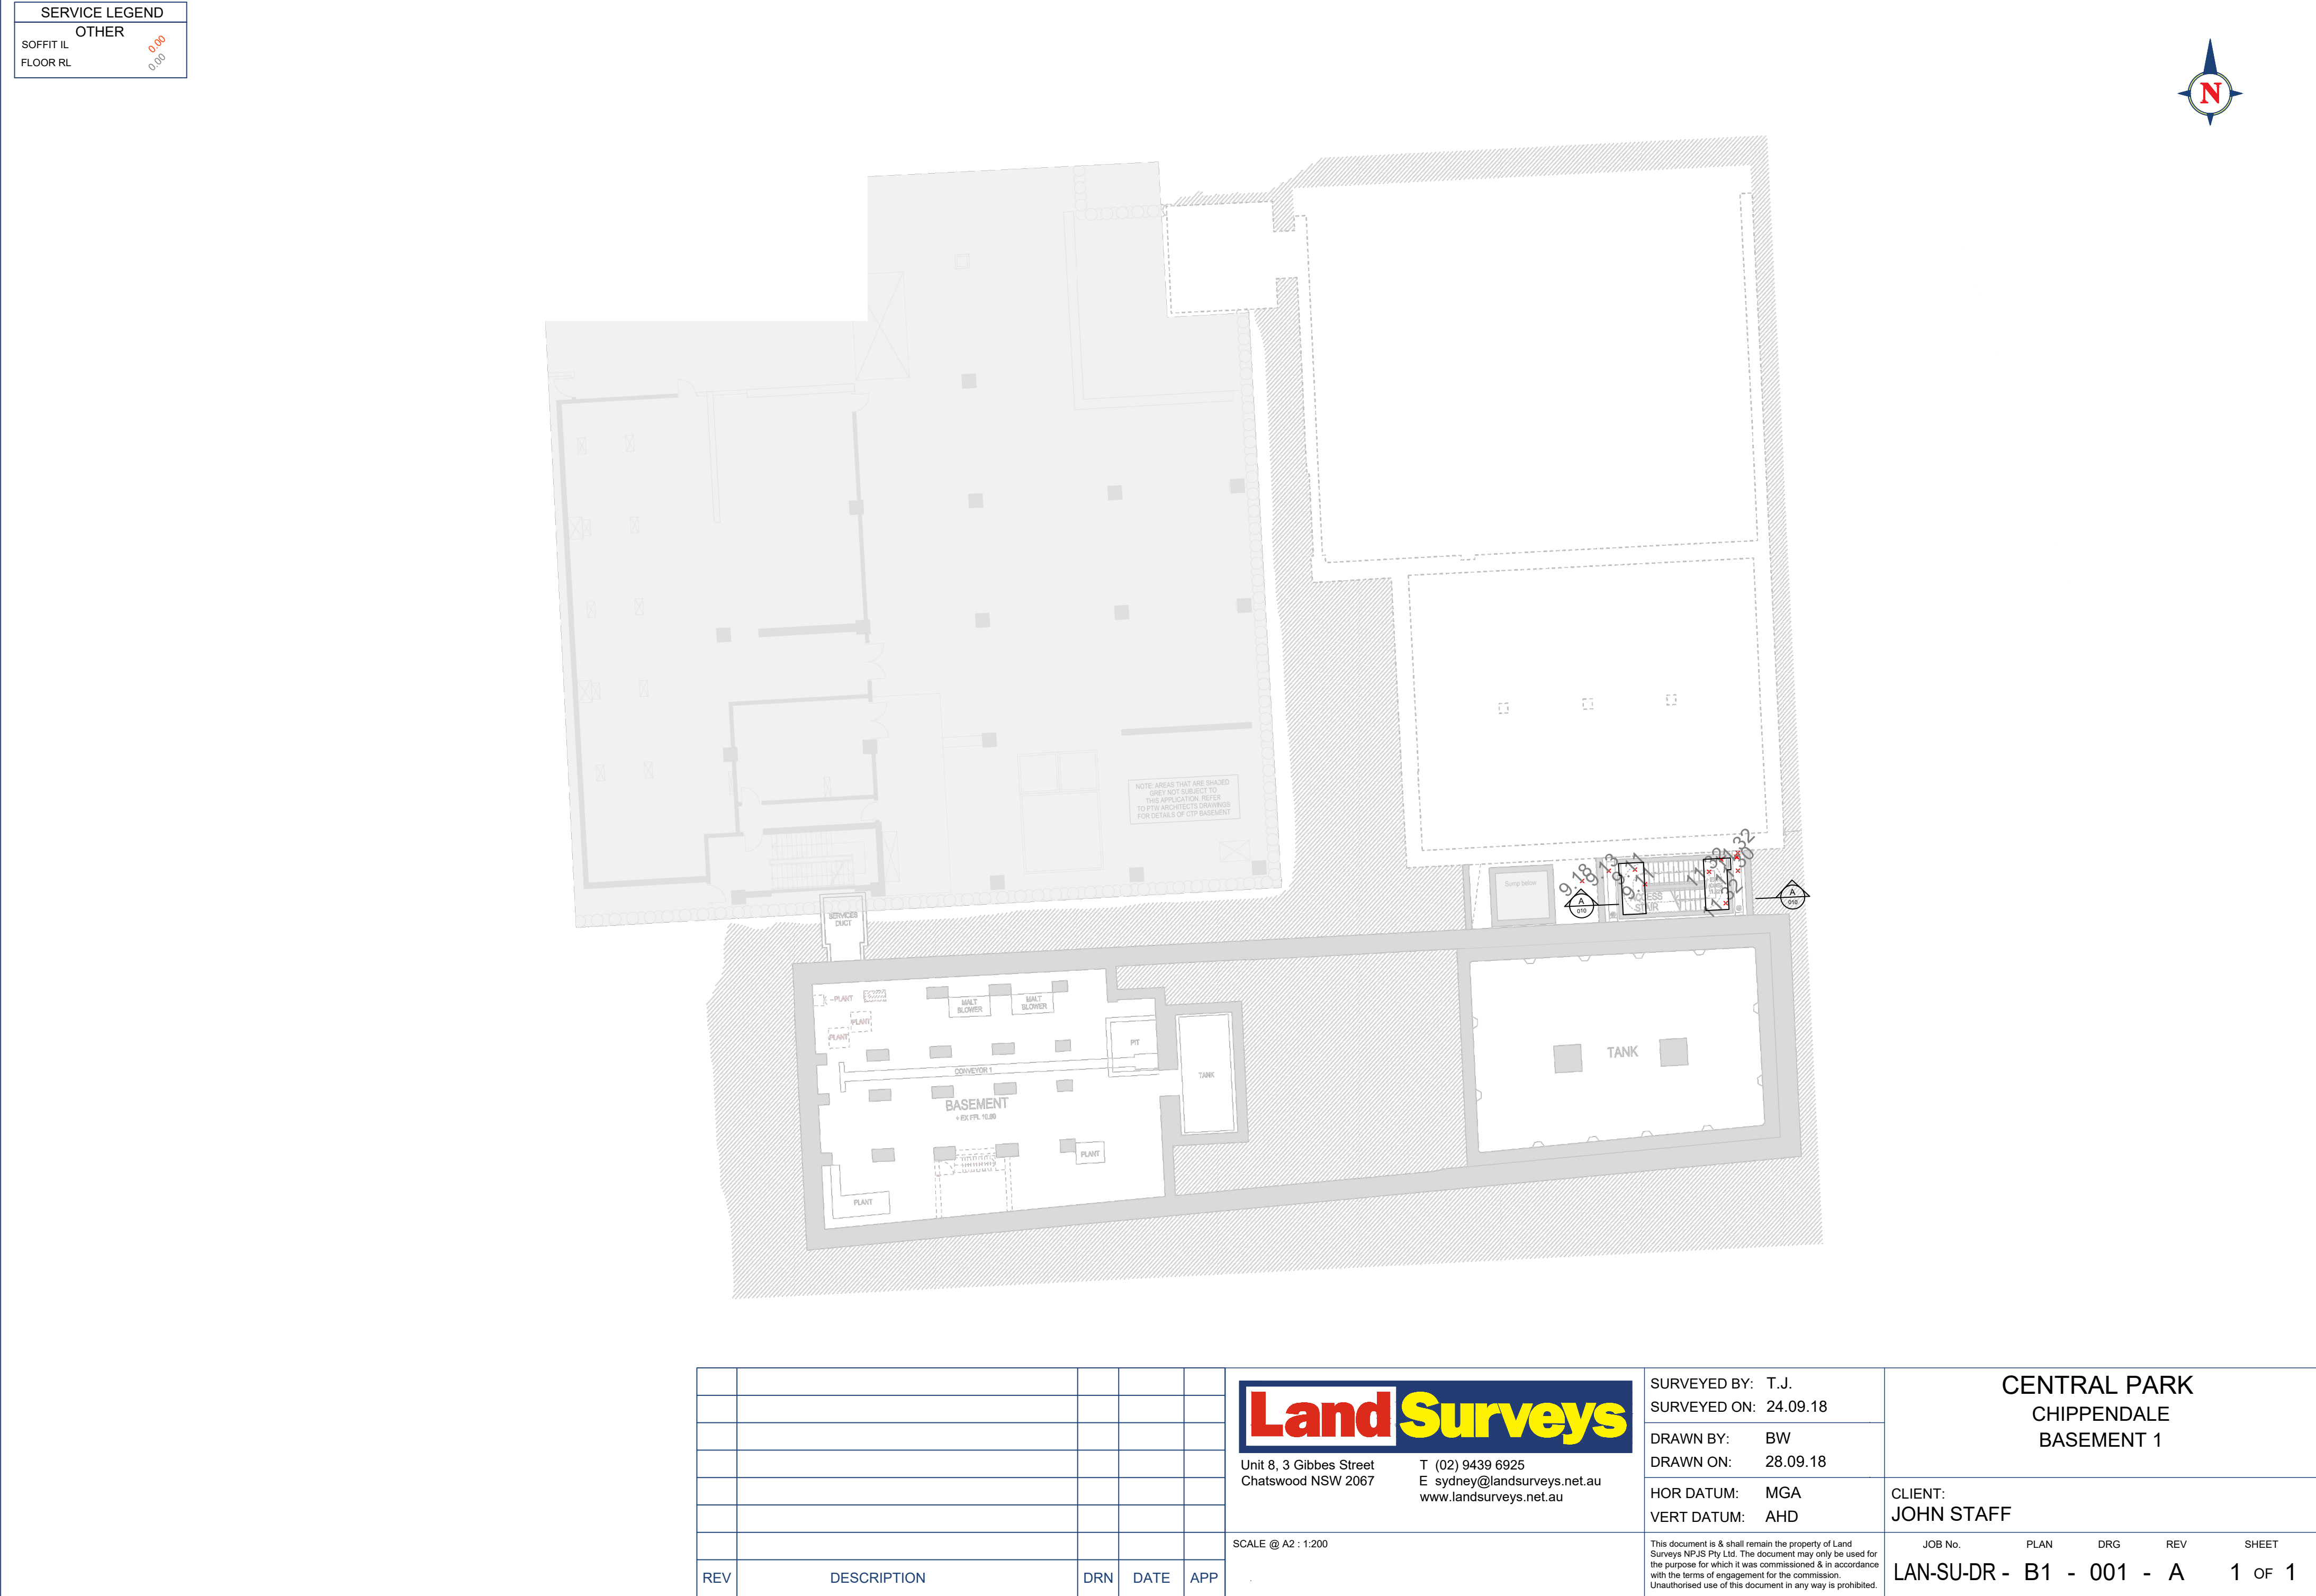


SERVICE LEGEND	
OTHER	0.00
SOFFIT IL	0.00
FLOOR RL	0.00

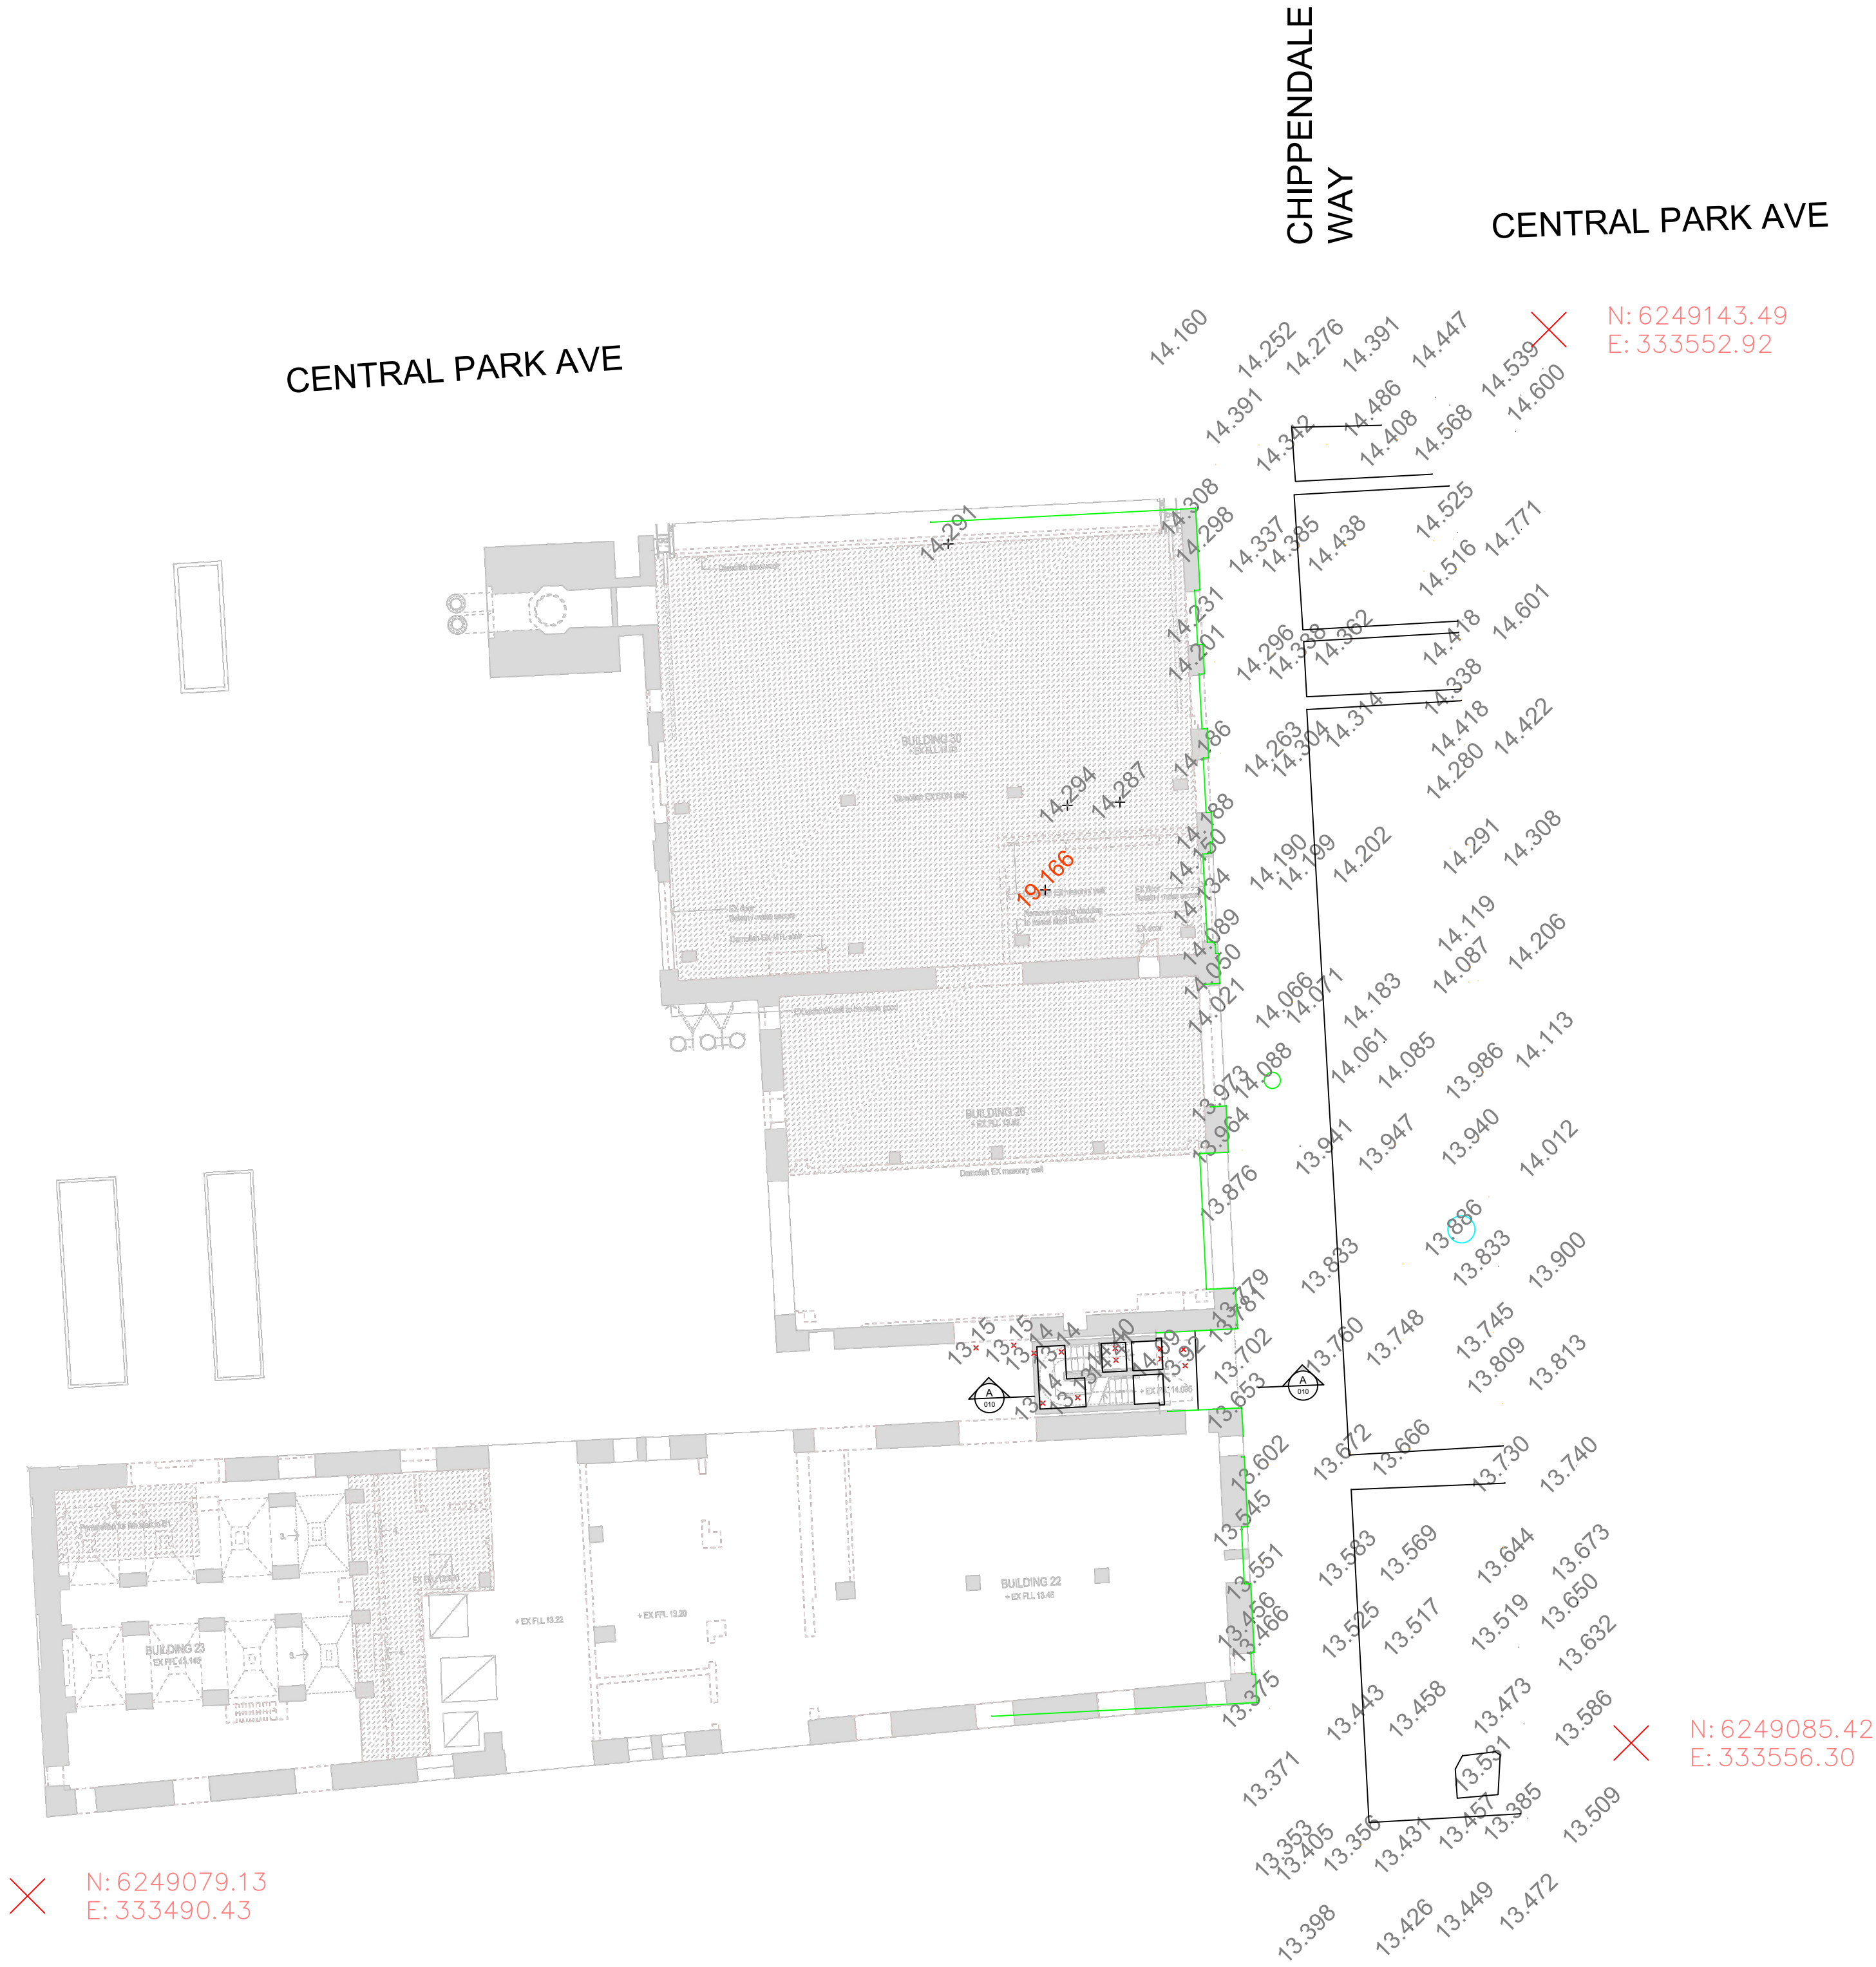


																																																																																																																																																																																																																																																																																																																																																																																																																																																																																																																																																																																																																																																																																																																																																																																																																																																																																																																																																																																																																																																																																																																																																																																																																																																																																																																																																																																																																								</
--	--	----

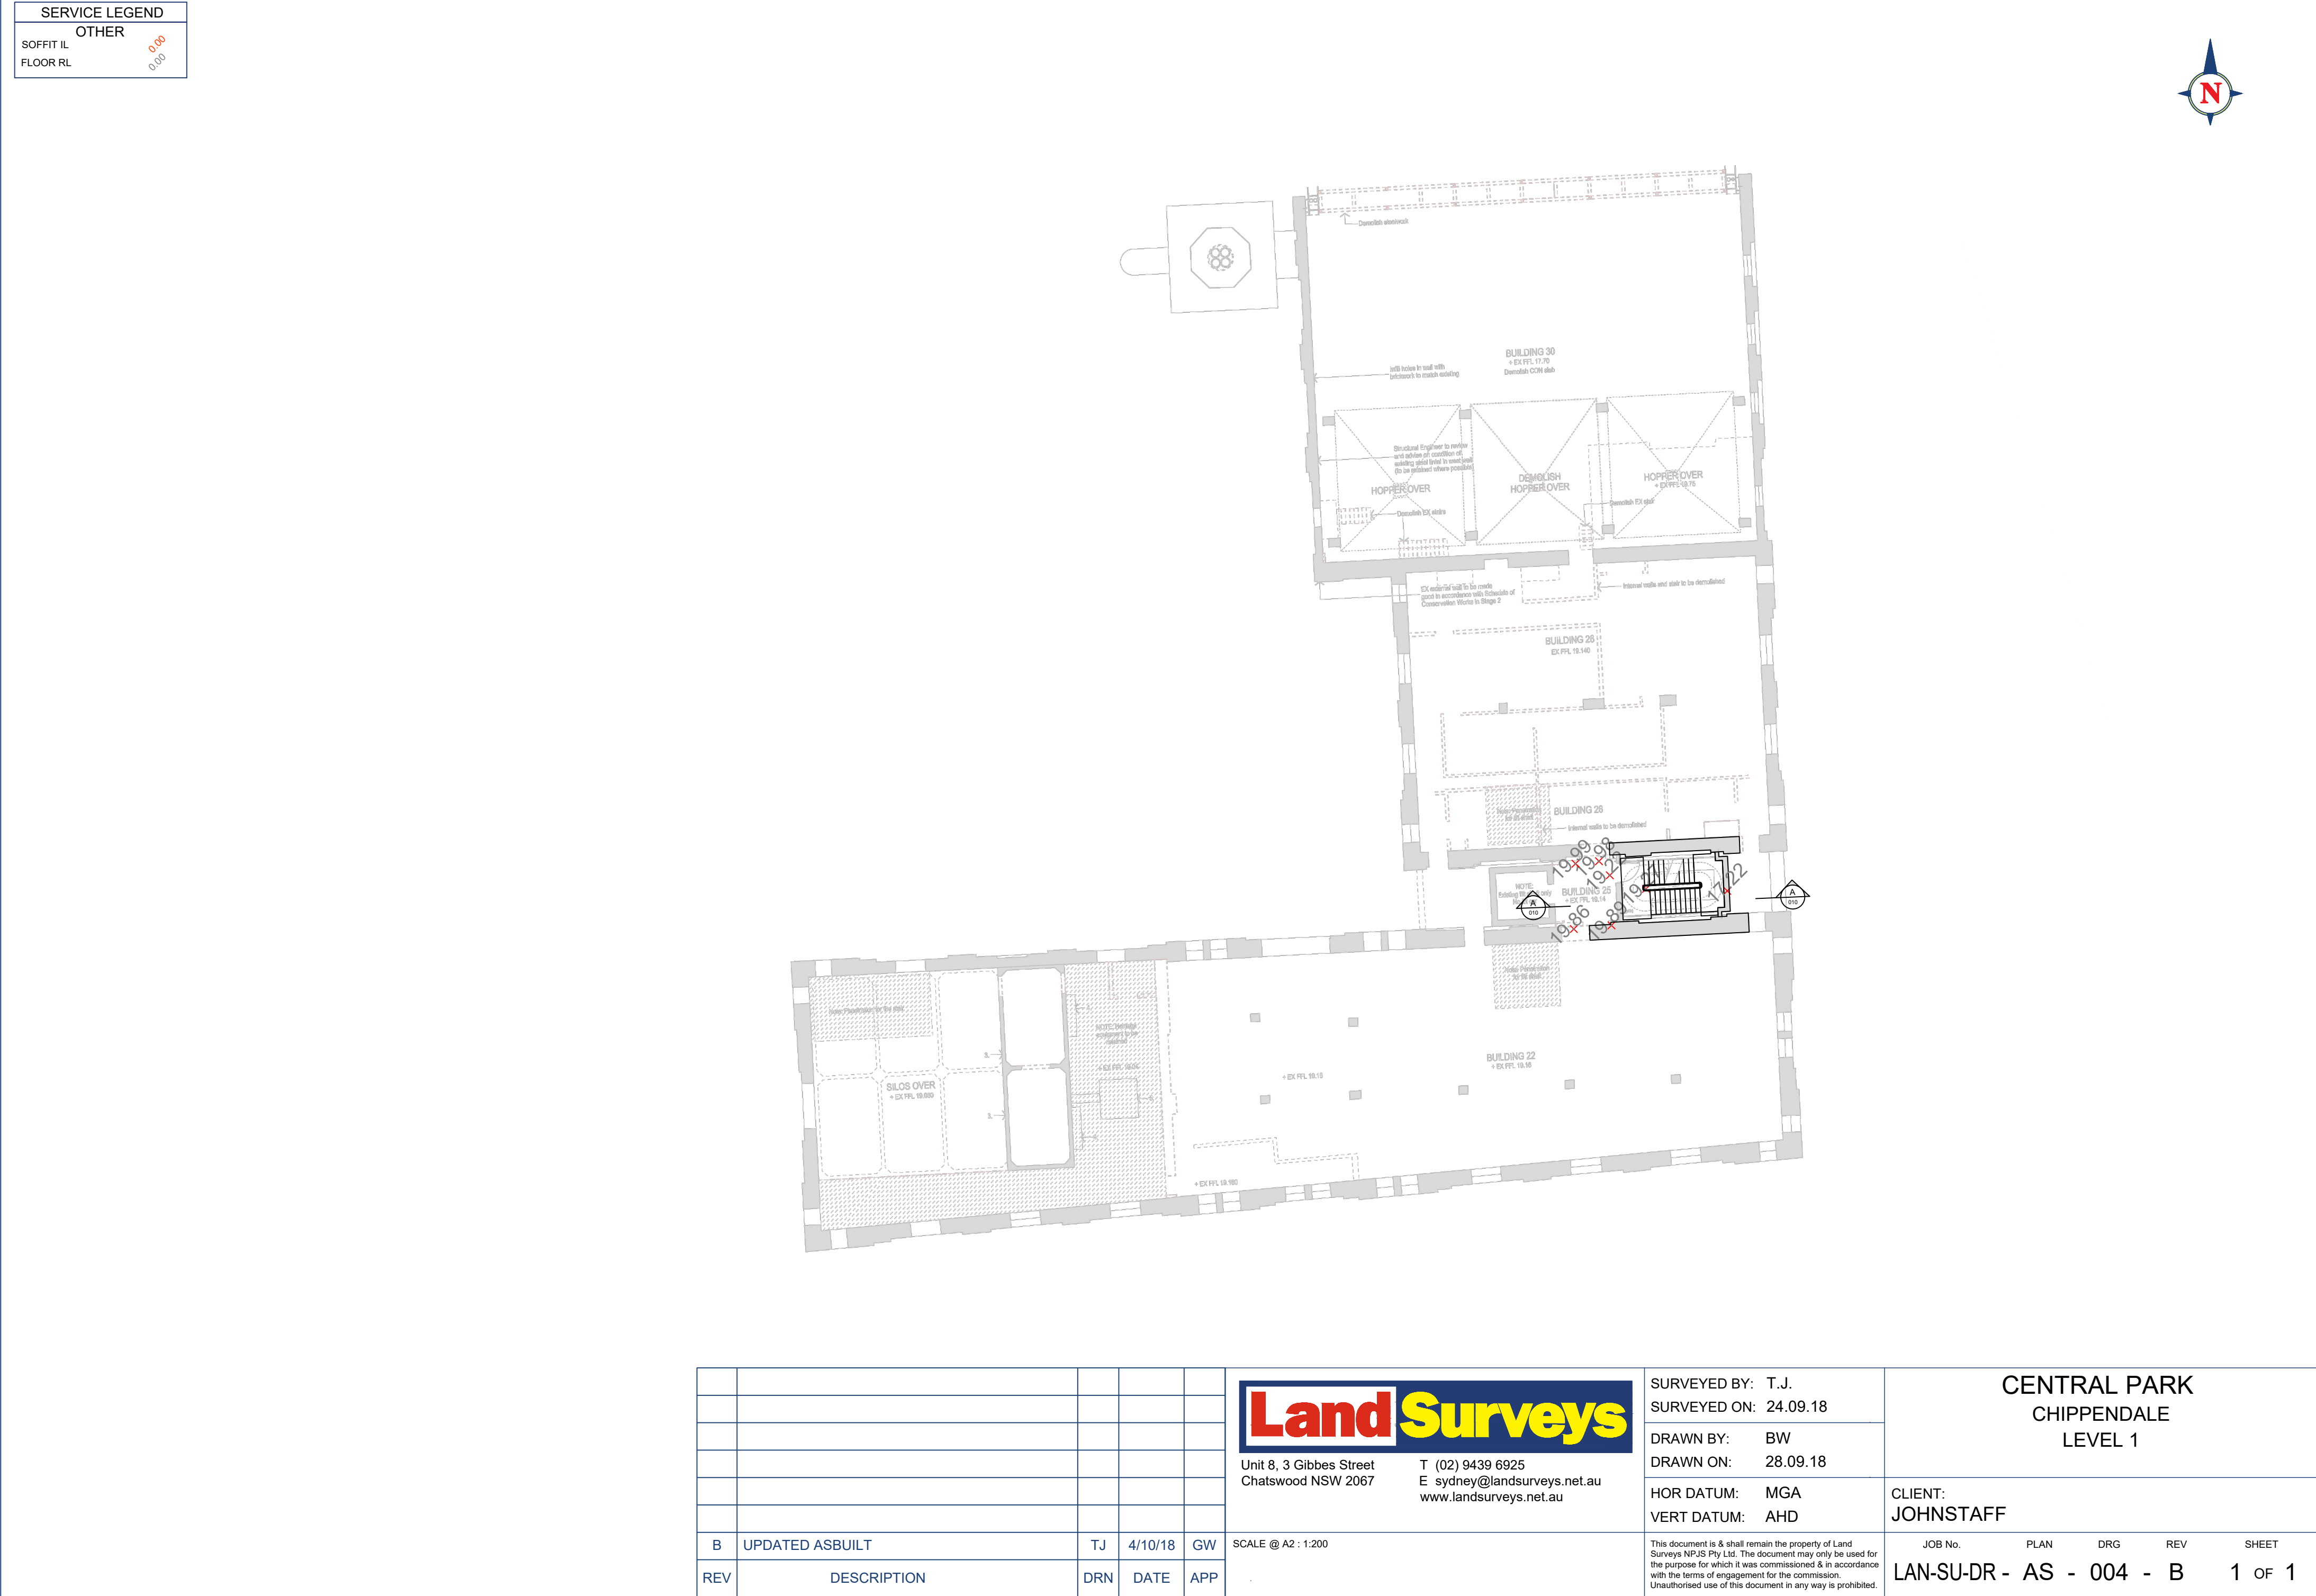

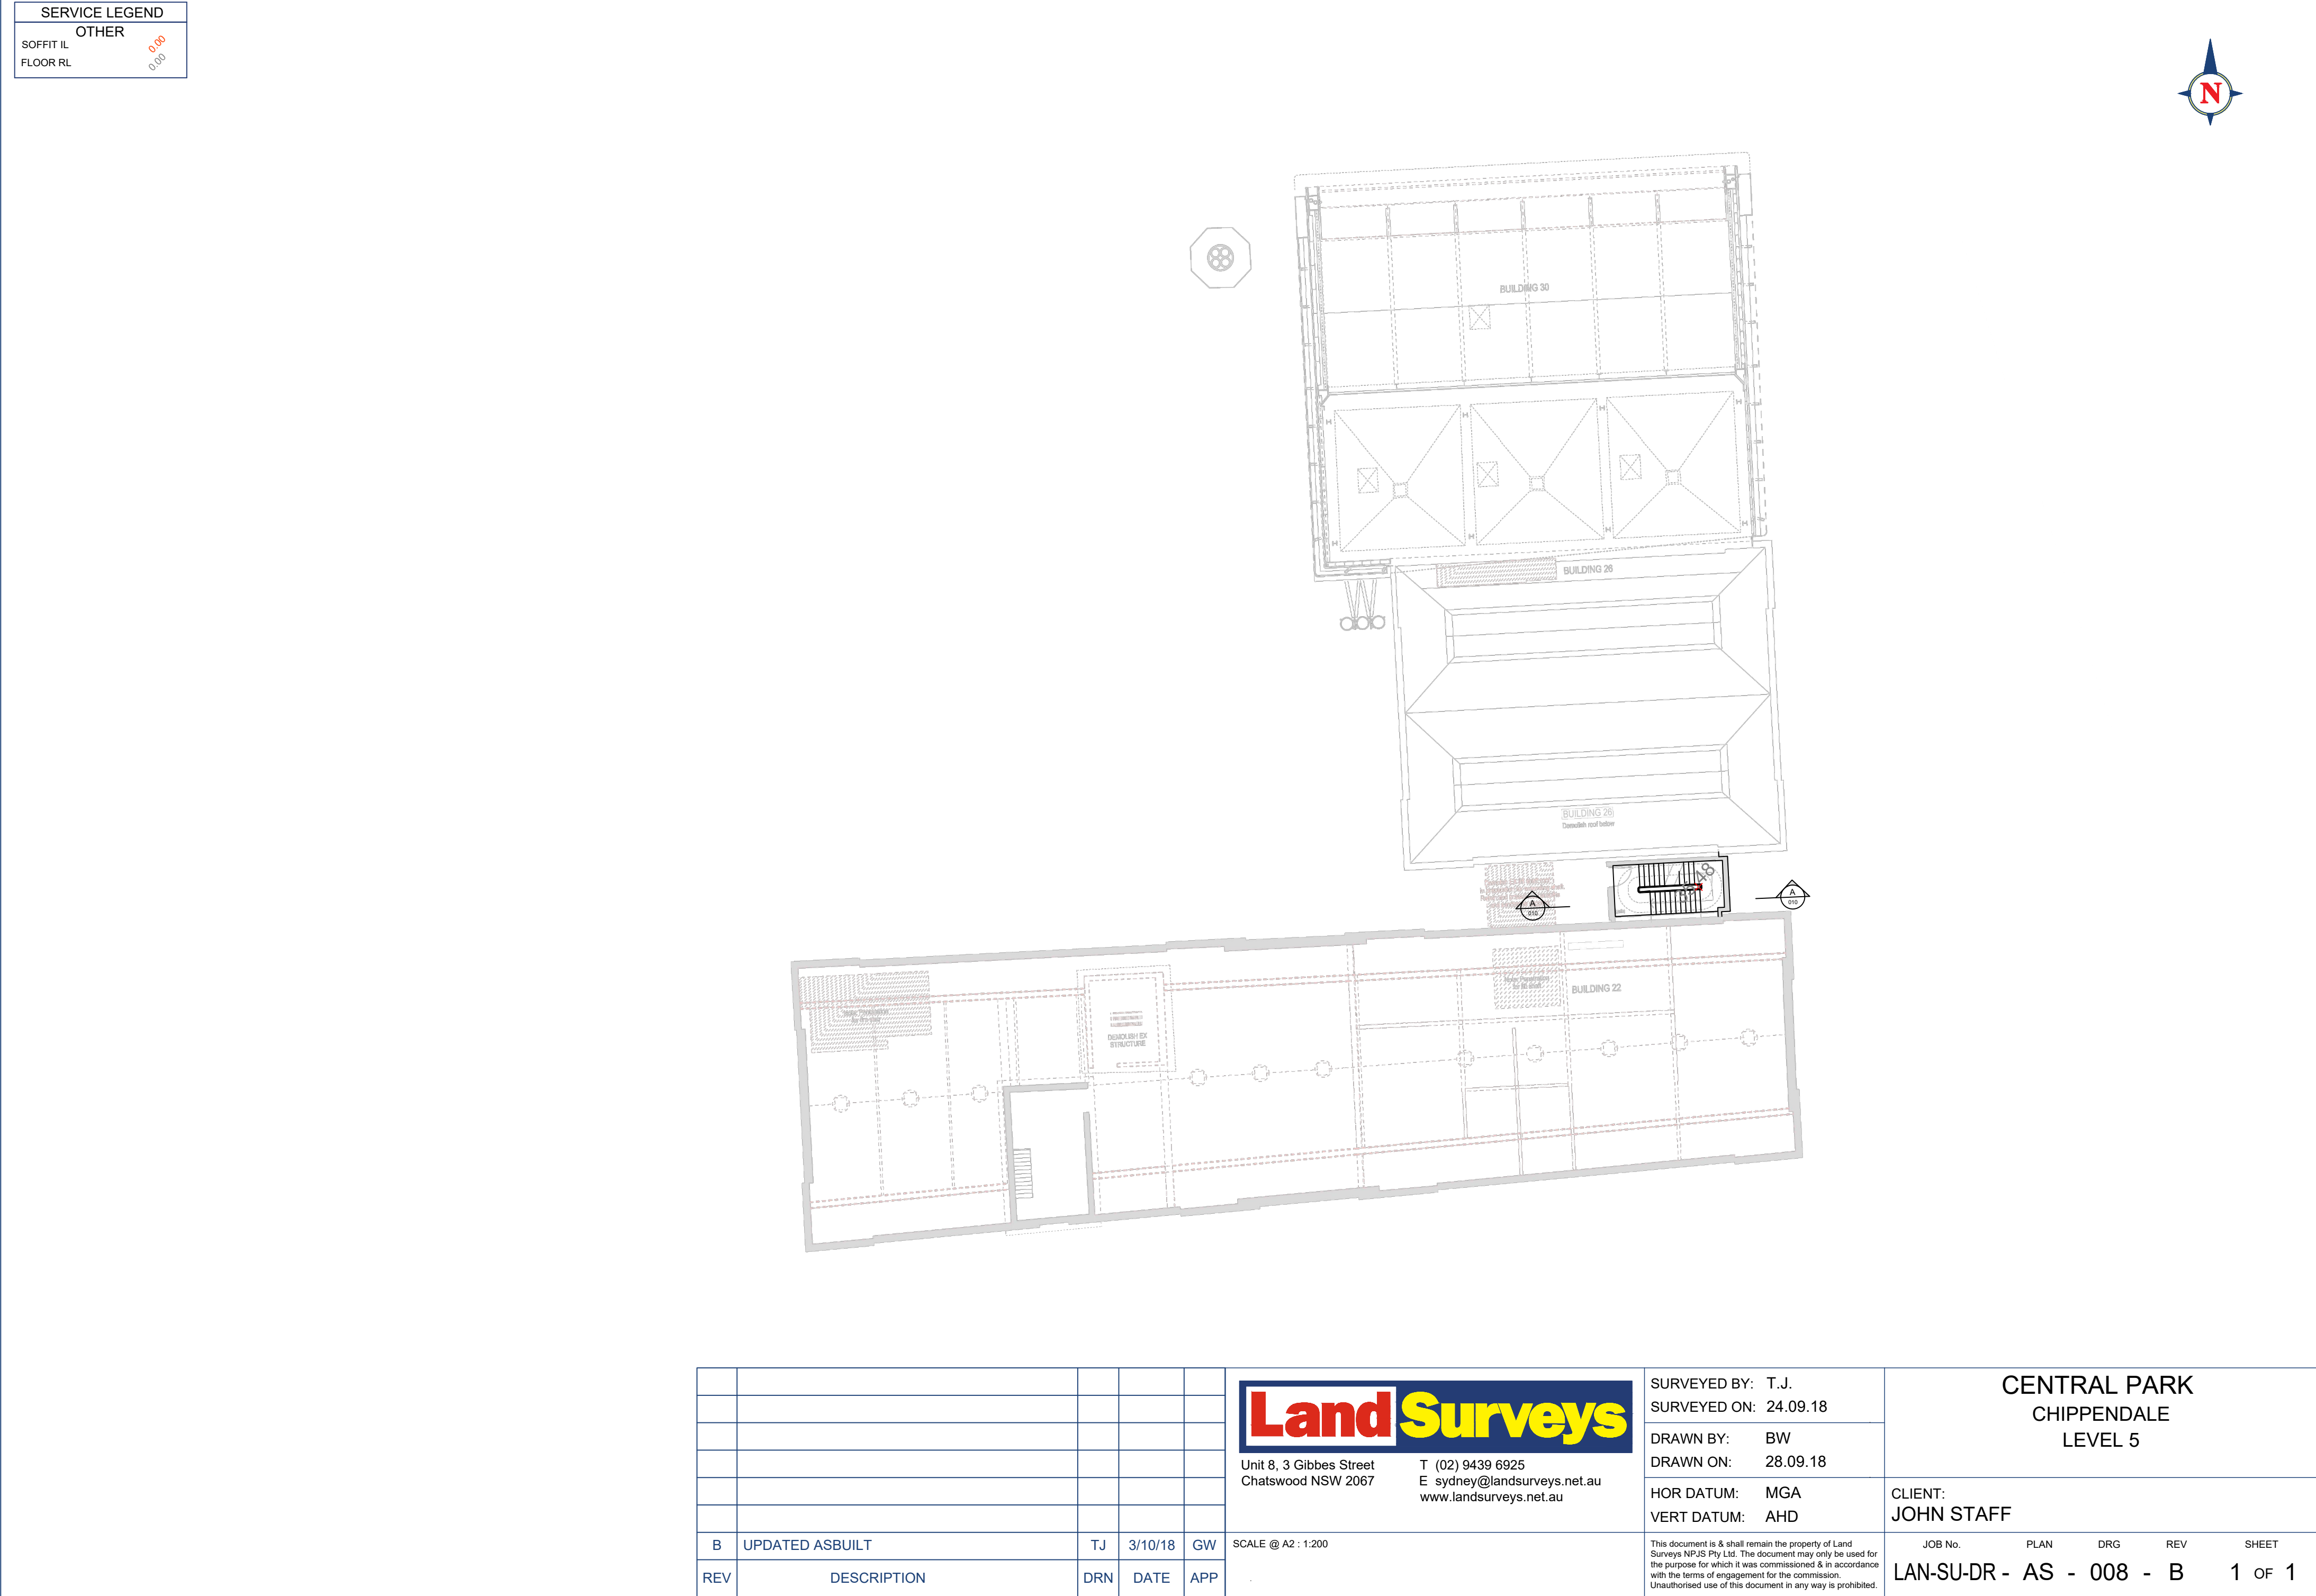


SERVICE LEGEND	
OTHER	
PARAPET RL	0.00
CHIMNEY RL	0.00

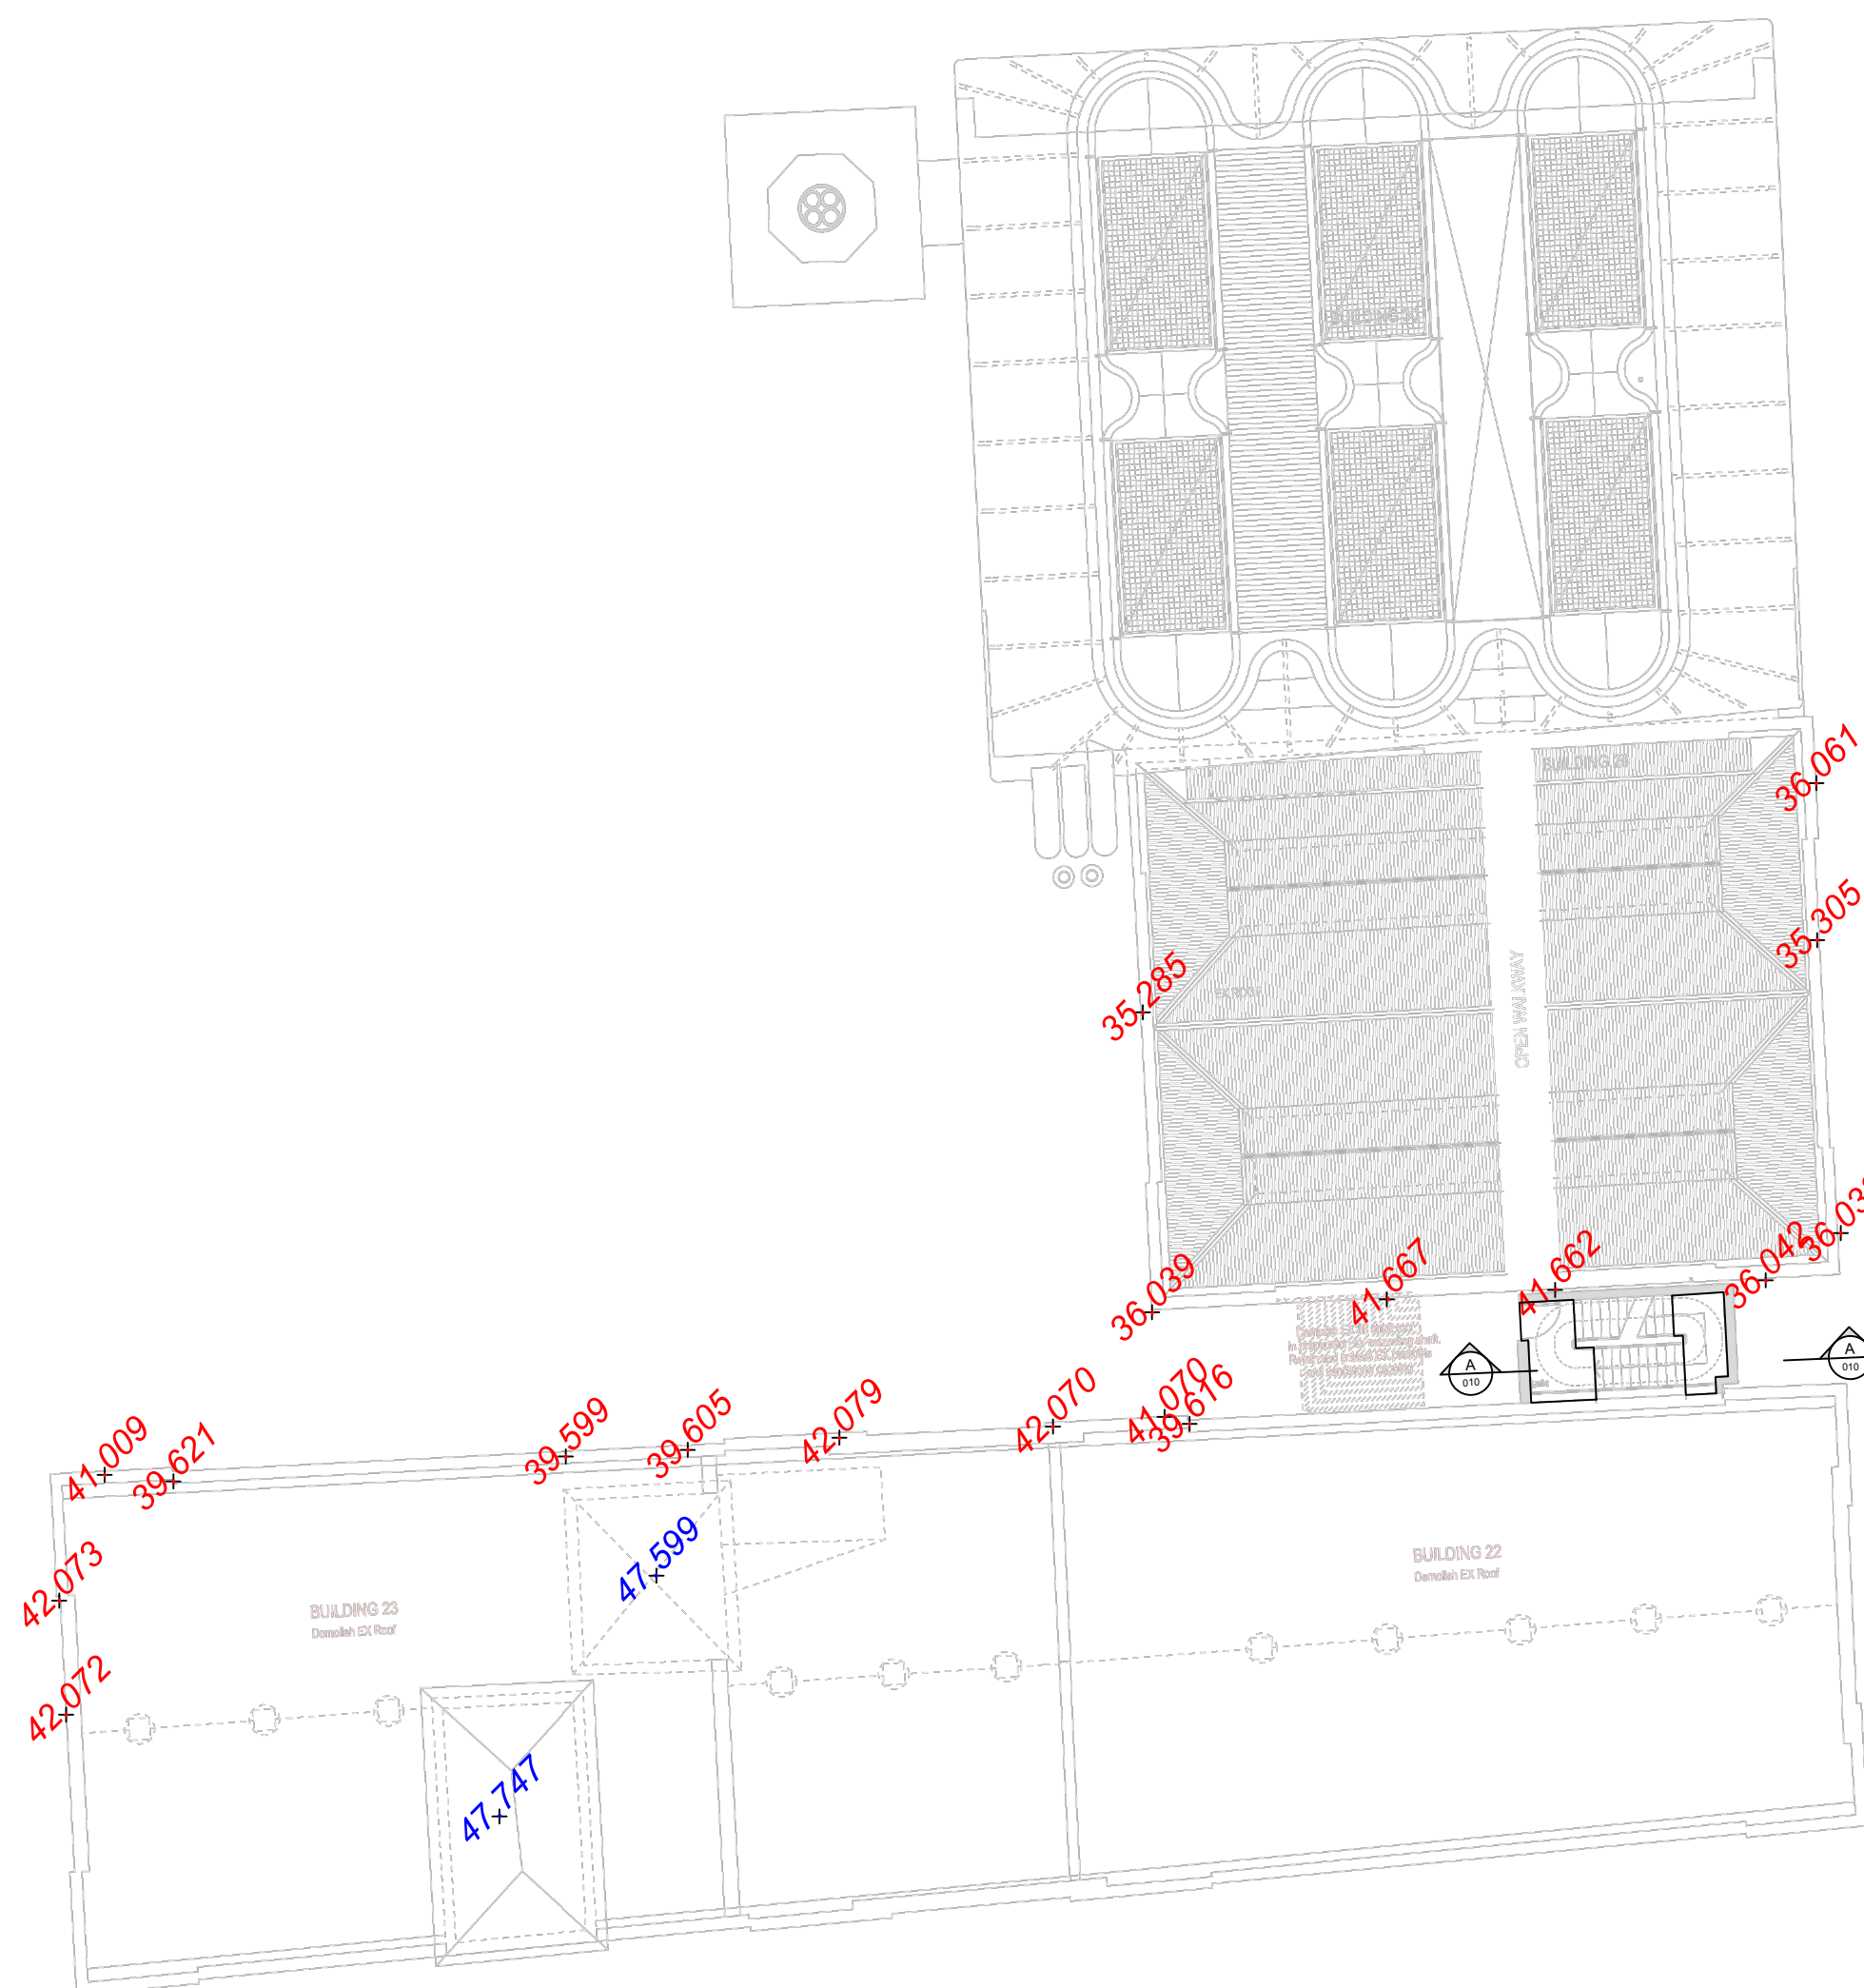


						Land Surveys Unit 8, 3 Gibbes Street Chatswood NSW 2067 T (02) 9439 6925 E sydney@landsurveys.net.au www.landsurveys.net.au	SURVEYED BY: T.J. SURVEYED ON: 24.09.18 DRAWN BY: BW DRAWN ON: 28.09.18 HOR DATUM: MGA VERT DATUM: AHD	CENTRAL PARK CHIPPENDALE ROOF CLIENT: JOB No. PLAN DRG REV SHEET LAN-SU-DR - RO - 009 - A 1 OF 1
REV	DESCRIPTION	DRN	DATE	APP		SCALE @ A2 : 1:200 This document is & shall remain the property of Land Surveys NPJS Pty Ltd. The document may only be used for the purpose for which it was commissioned & in accordance with the terms of engagement for the commission. Unauthorised use of this document in any way is prohibited.		

SERVICE LEGEND	
	OTHER
SOFFIT IL	0.00
FLOOR RL	0.00

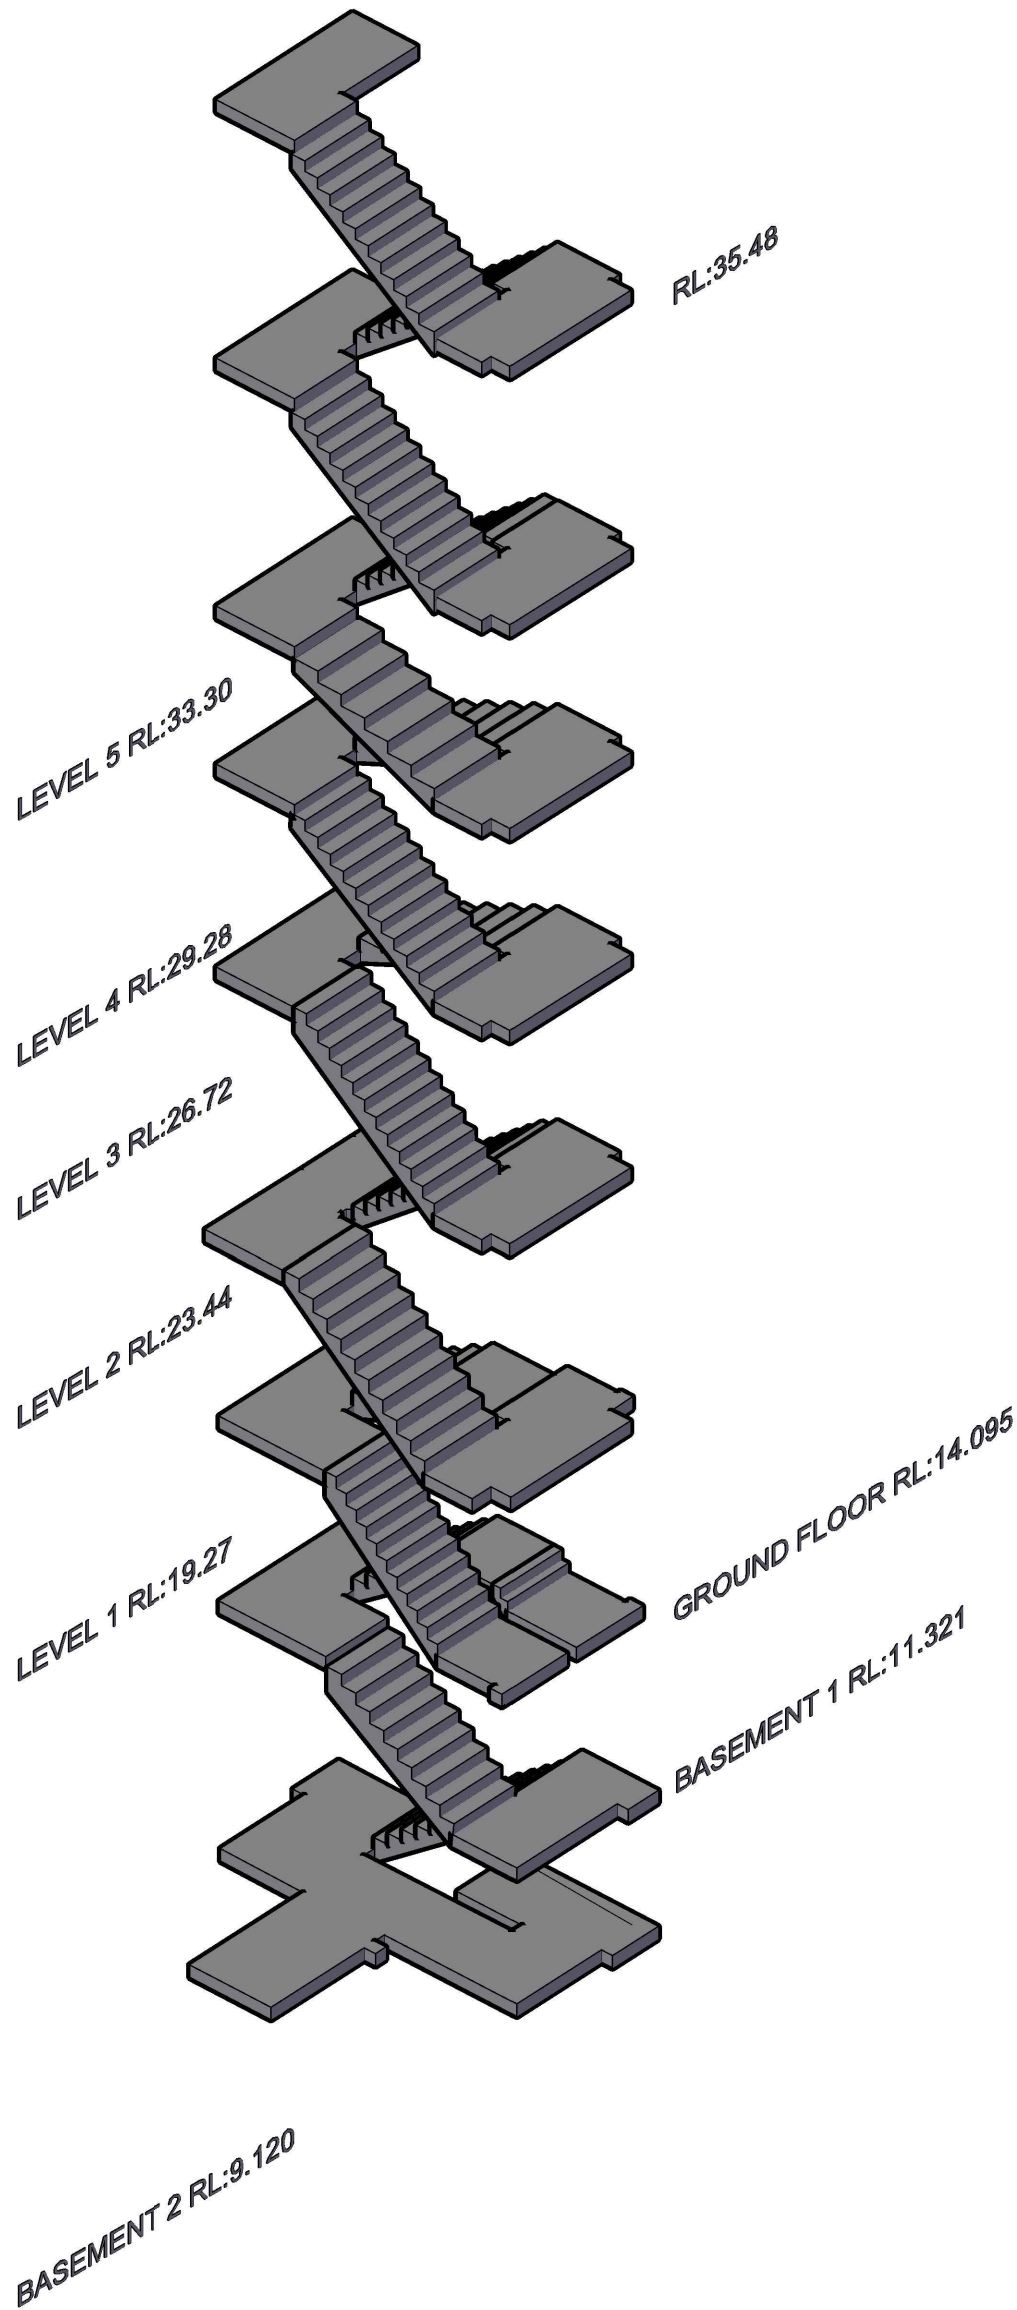

STAIR CORE ISOMETRIC VIEW
SCALE 1:100
NOTE:
STAIR TREADS ARE DRAWN INDICATIVELY ONLY.

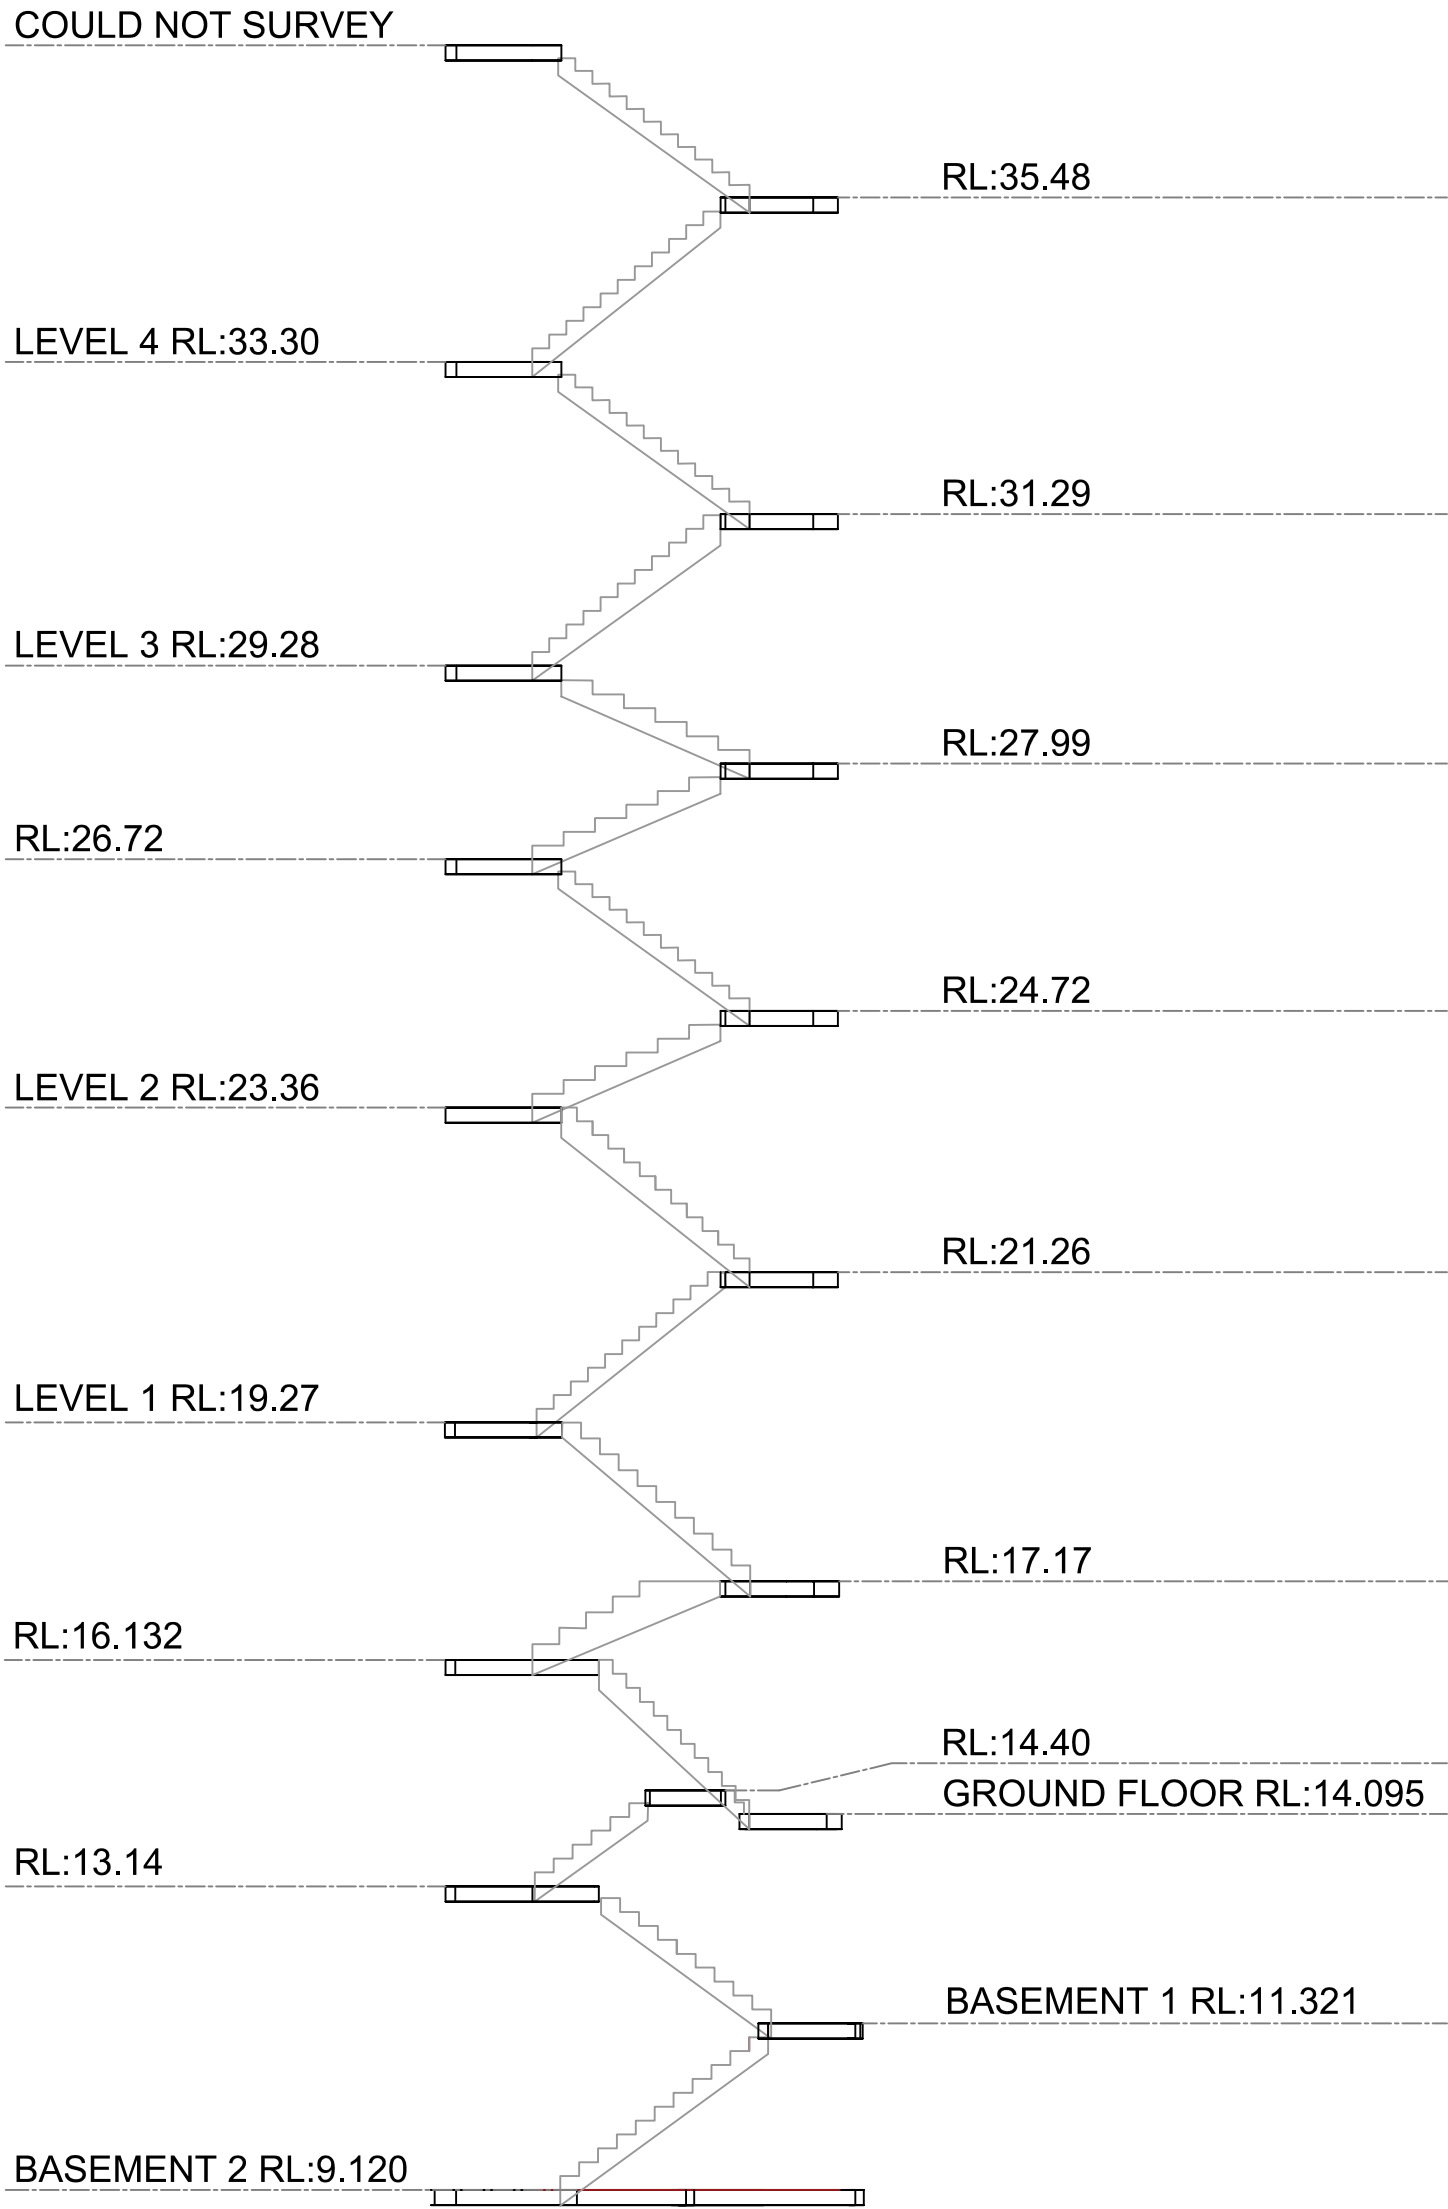

STAIR CORE ELEVATION A-A
SCALE 1:100
NOTE:
STAIR TREADS ARE DRAWN INDICATIVELY ONLY.

					LandSurveys Unit 8, 3 Gibbes Street Chatswood NSW 2067 T (02) 9439 6925 E sydney@landsurveys.net.au www.landsurveys.net.au	SURVEYED BY: T.J. SURVEYED ON: 24.09.18	CENTRAL PARK CHIPPENDALE ASBUILT STAIR ELEVATION					
						DRAWN BY: BW DRAWN ON: 02.10.18						
						HOR DATUM: MGA VERT DATUM: AHD						
							CLIENT: JOHN STAFF					
B	UPDATED ASBUILT	TJ	3/10/18	GW		SCALE @ A2 : 1:100	This document is & shall remain the property of Land Surveys NPJS Pty Ltd. The document may only be used for the purpose for which it was commissioned & in accordance with the terms of engagement for the commission. Unauthorised use of this document in any way is prohibited.	JOB No.	PLAN	DRG	REV	SHEET
REV	DESCRIPTION	DRN	DATE	APP			LAN-SU-DR - AS - 010 - B				1 OF 1	