


TEYS AUSTRALIA ABATTOIR UPGRADES DAMPIER ST, WAGGA WAGGA, NSW

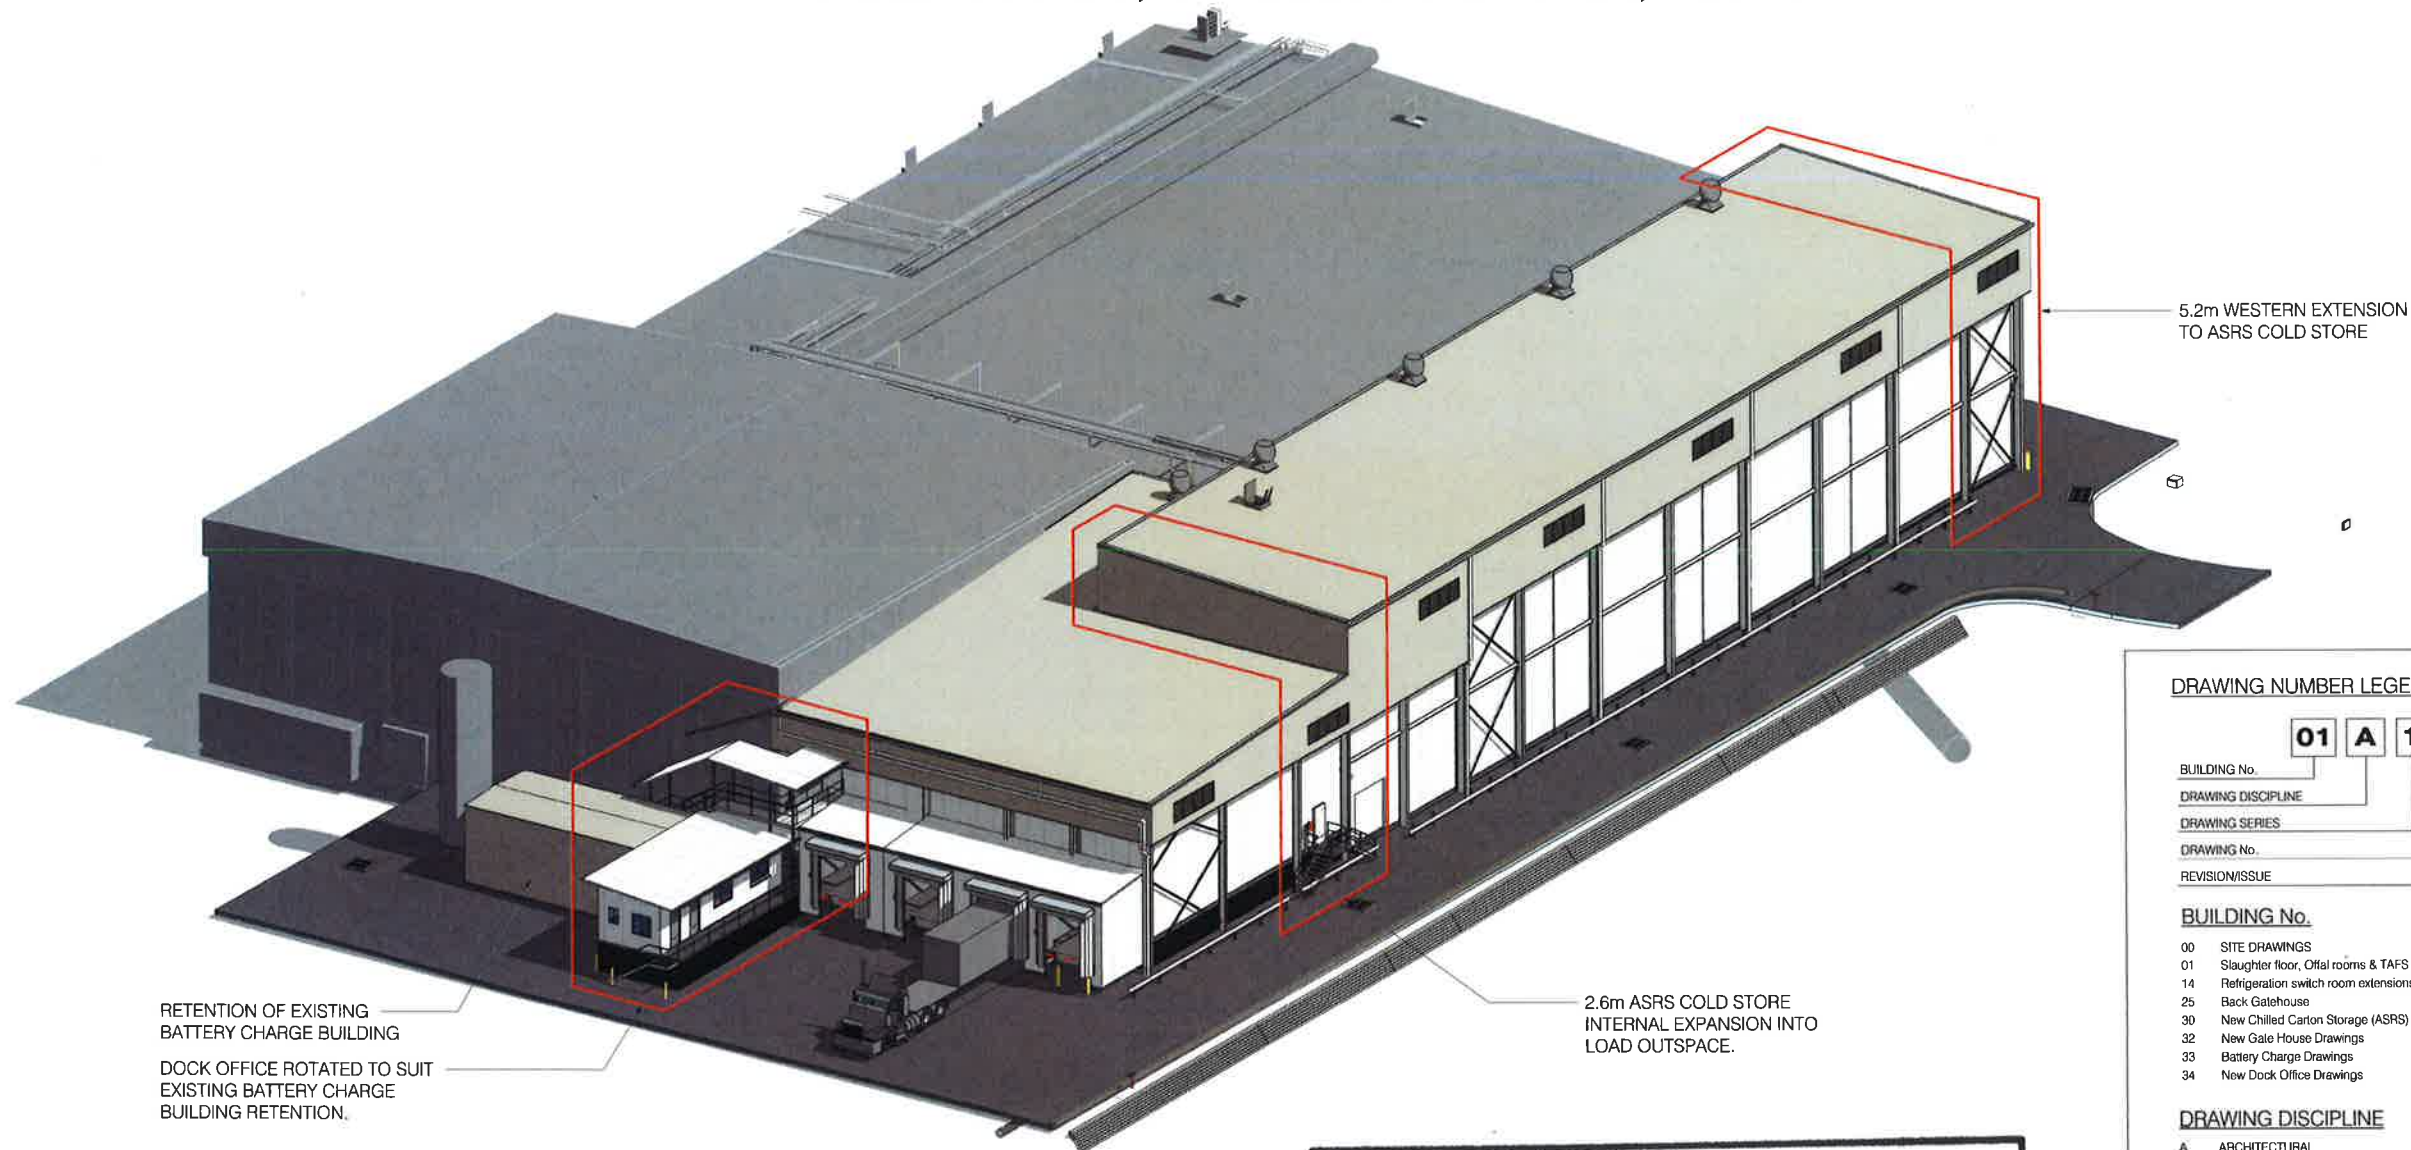

5.2m WESTERN EXTENSION
TO ASRS COLD STORE

2.6m ASRS COLD STORE
INTERNAL EXPANSION INTO
LOAD OUTSPACE.

RETENTION OF EXISTING
BATTERY CHARGE BUILDING
DOCK OFFICE ROTATED TO SUIT
EXISTING BATTERY CHARGE
BUILDING RETENTION.

NSW Planning & Environment
Issued under the Environmental Planning and Assessment Act 1979
Approved Section 4.55 (.1A) Modification Application
No. 10 granted on the 23/10/18
In respect to DA 220-07-2002-i
Signed [Signature]
Sheet No. 1 of 11

DRAWING NUMBER LEGEND

01 A 101 -1

BUILDING No.
DRAWING DISCIPLINE
DRAWING SERIES
DRAWING No.
REVISION/ISSUE

BUILDING No.

00 SITE DRAWINGS
01 Slaughter floor, Offal rooms & TAFS Drawings
14 Refrigeration switch room extensions
25 Back Gatehouse
30 New Chilled Carton Storage (ASRS) Drawings
32 New Gate House Drawings
33 Battery Charge Drawings
34 New Dock Office Drawings

DRAWING DISCIPLINE

A ARCHITECTURAL
C CIVIL
D DEMOLITION
E ELECTRICAL
F FIRE
H HYDRAULICS
K ARCHITECTURAL SKETCH
M MECHANICAL
P PROCESS SKETCH
Q EQUIPMENT
R REFRIGERATION
S STRUCTURAL
X EXISTING

DRAWING SERIES

000 SITE & SITEWORKS
100 PLANS
200 ELEVATIONS
300 SECTIONS
350 DETAILED SECTIONS
400 DETAILED PLANS
500 STAIR DETAILS
600 CONSTRUCTION DETAILS
700 METALWORK DETAILS
800 SERVICES DETAILS
900 SCHEDULES

DRAWING ISSUE / REVISION

1, 2, 3... DRAWING ISSUE / REVISION

ORIGINAL IN COLOUR

© WILEY & CO PTY LTD
ABN 40 010 604 869
This document is the property of Wiley & Co Pty Ltd and is copyright. The subject matter of it is confidential. Do not use, reproduce, copy or disclose except with and only to the extent of the prior written consent of Wiley & Co Pty Ltd. Persons receiving this document are responsible for restricting disclosure as stated above.

Date	Issue	Amendment	Init
03/09/16	4	ISSUE FOR DA MOD	DT
21/08/16	3	ISSUE FOR CLIENT APPROVAL	DT
20/08/16	2	FRONT BUILDING, REAR EXTENSION AND BLD 34 REDESIGN	DT
15/06/16	1	INITIAL ISSUE	JNM




TEYS AUSTRALIA - STAGE 2
COLD MEAT PROJECT
WAGGA WAGGA, NSW
Drawing Title
ASRS BUILDING COVER
PAGE

Scale	Drawn	DT	Date	JUN 2018
Project No.	W21206	Bldg No.	30	
Drawing No.	30A000 - 4	Issue		

PRELIMINARY

	NEW & REFURBISHED BUILDINGS
	NEW PAVEMENT
	EXISTING BUILDING
	EXISTING PAVEMENT
	TEMPORARY HARD STAND
01	EXISTING BUILDING
	30 NEW BUILDING
	2.4m WIDE OVERHEAD ELECTRICITY ZONE
PP	EXISTING POWER POLE
	EXISTING BOUNDARY LINE
	EXISTING FENCE LINE
	CONSTRUCTION SITE TEMPORARY FENCE

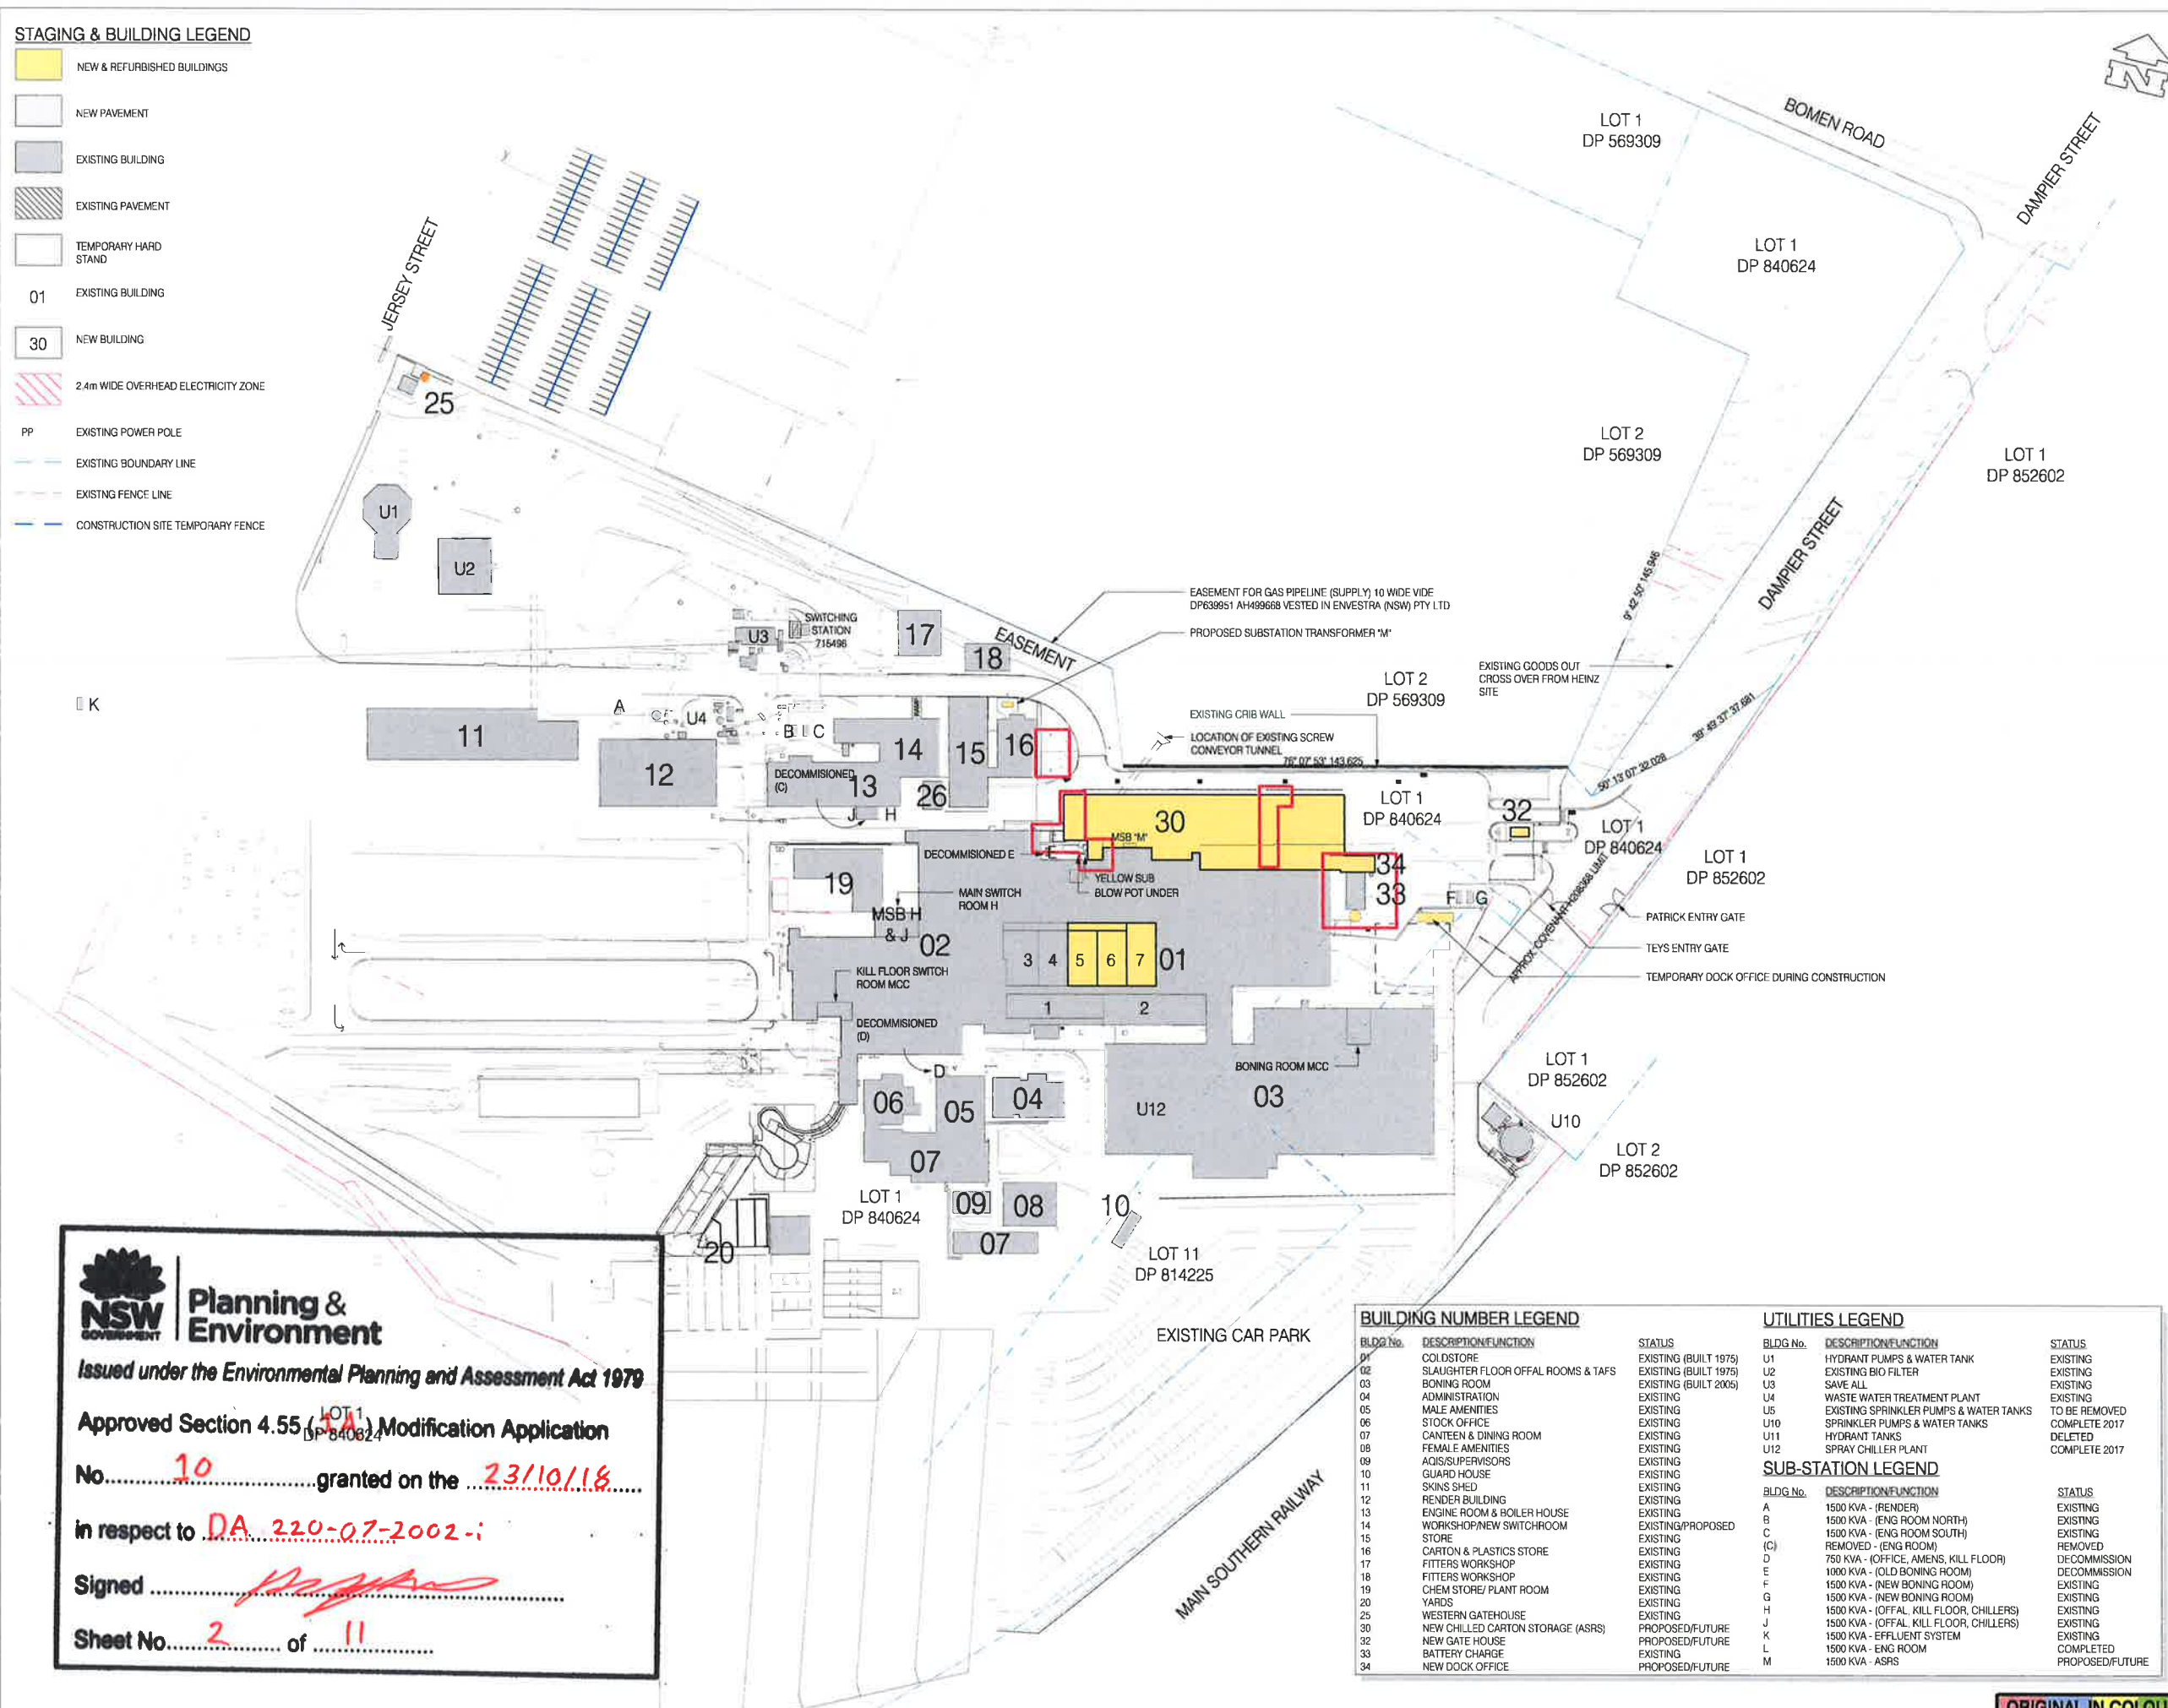

<u>BLDG No.</u>	<u>DESCRIPTION/FUNCTION</u>	<u>STATUS</u>
01	COLIDSTORE	EXISTING (BUILT 1977)
02	SLAUGHTER FLOOR OFFAL ROOMS & TAFS	EXISTING (BUILT 1977)
03	BONING ROOM	EXISTING (BUILT 2000)
04	ADMINISTRATION	EXISTING
05	MALE AMENITIES	EXISTING
06	STOCK OFFICE	EXISTING
07	CANTEEN & DINING ROOM	EXISTING
08	FEMALE AMENITIES	EXISTING
09	AQIS/SUPERVISORS	EXISTING
10	GUARD HOUSE	EXISTING
11	SKINS SHED	EXISTING
12	RENDER BUILDING	EXISTING
13	ENGINE ROOM & BOILER HOUSE	EXISTING
14	WORKSHOP/NEW SWITCHROOM	EXISTING/PROPOSED
15	STORE	EXISTING
16	CARTON & PLASTICS STORE	EXISTING
17	FITTERS WORKSHOP	EXISTING
18	FITTERS WORKSHOP	EXISTING
19	CHEM STORE/ PLANT ROOM	EXISTING
20	YARDS	EXISTING
25	WESTERN GATEHOUSE	EXISTING
30	NEW CHILLED CARTON STORAGE (ASRS)	PROPOSED/FUTURE
31	NEW HOUSE	PROPOSED/FUTURE
32	BATTERY CHARGE	EXISTING
34	NEW DQ/C OFFICE	PROPOSED/FUTURE

<u>BLDG No.</u>	<u>DESCRIPTION/FUNCTION</u>	<u>STATUS</u>
U1	HYDRANT PUMPS & WATER TANK	EXISTING
U2	EXISTING BOI FILTER	EXISTING
U3	SAVE ALL	EXISTING
U4	WASTE WATER TREATMENT PLANT	EXISTING
U5	EXISTING SPRINKLER PUMPS & WATER TANKS	TO BE REMOVED
U10	SPRINKLER PUMPS & WATER TANKS	COMPLETE 2017
U11	HYDRANT TANKS	DELETED
U12	SPRAY CHILLER PLANT	COMPLETE 2017

<u>SUB-STATION LEGEND</u>		
<u>BLDG No.</u>	<u>DESCRIPTION/FUNCTION</u>	<u>STATUS</u>
A	1500 KVA - (RENDER)	EXISTING
B	1500 KVA - (ENG ROOM NORTH)	EXISTING
C	1500 KVA - (ENG ROOM SOUTH)	EXISTING
(C)	REMOVED - (ENG ROOM)	REMOVED
D	750 KVA - (OFFICE, AMENS, KILL FLOOR)	DECOMMISSION
E	1000 KVA - (OLD BOWING ROOM)	DECOMMISSION
F	1500 KVA - (NEW BOWING ROOM)	EXISTING
G	1500 KVA - (NEW BOWING ROOM)	EXISTING
H	1500 KVA - (OFFAL, KILL FLOOR, CHILLERS)	EXISTING
J	1500 KVA - (OFFAL, KILL FLOOR, CHILLERS)	EXISTING
K	1500 KVA - EFFLUENT SYSTEM	EXISTING
L	1500 KVA - ENG ROOM	COMPLETED
M	1500 KVA - ASPRS	PROPOSED/FUTURE

KEY PLAN

General Notes:

30/07/18	2	FOR REVISION (BLD LENGTHEN)
30/07/18	1	INITIAL ISSUE
Date	Issue	Amendment

605B HARRIS ROAD, STERILITE TOWN, QLD 4058
www.wiley.com.au
connect@wiley.com.au
1300 385 988

WILEY

Project



TEYS AUSTRALIA - STAGE 2
COLD MEAT PROJECT
WAGGA WAGGA, NSW
Drawing Title
OVERALL
PROPOSED SITE PLAN

Scale A1 = 1:1000 (A2 = 1:2000) 0 10 20


Drawn	DT	Date	JUN 2018
-------	----	------	----------

Project No. W21206	Bldg No. 00
------------------------------	-----------------------

Drawing No.	Issue
-------------	-------

00A002 - 2

PRELIMINARY

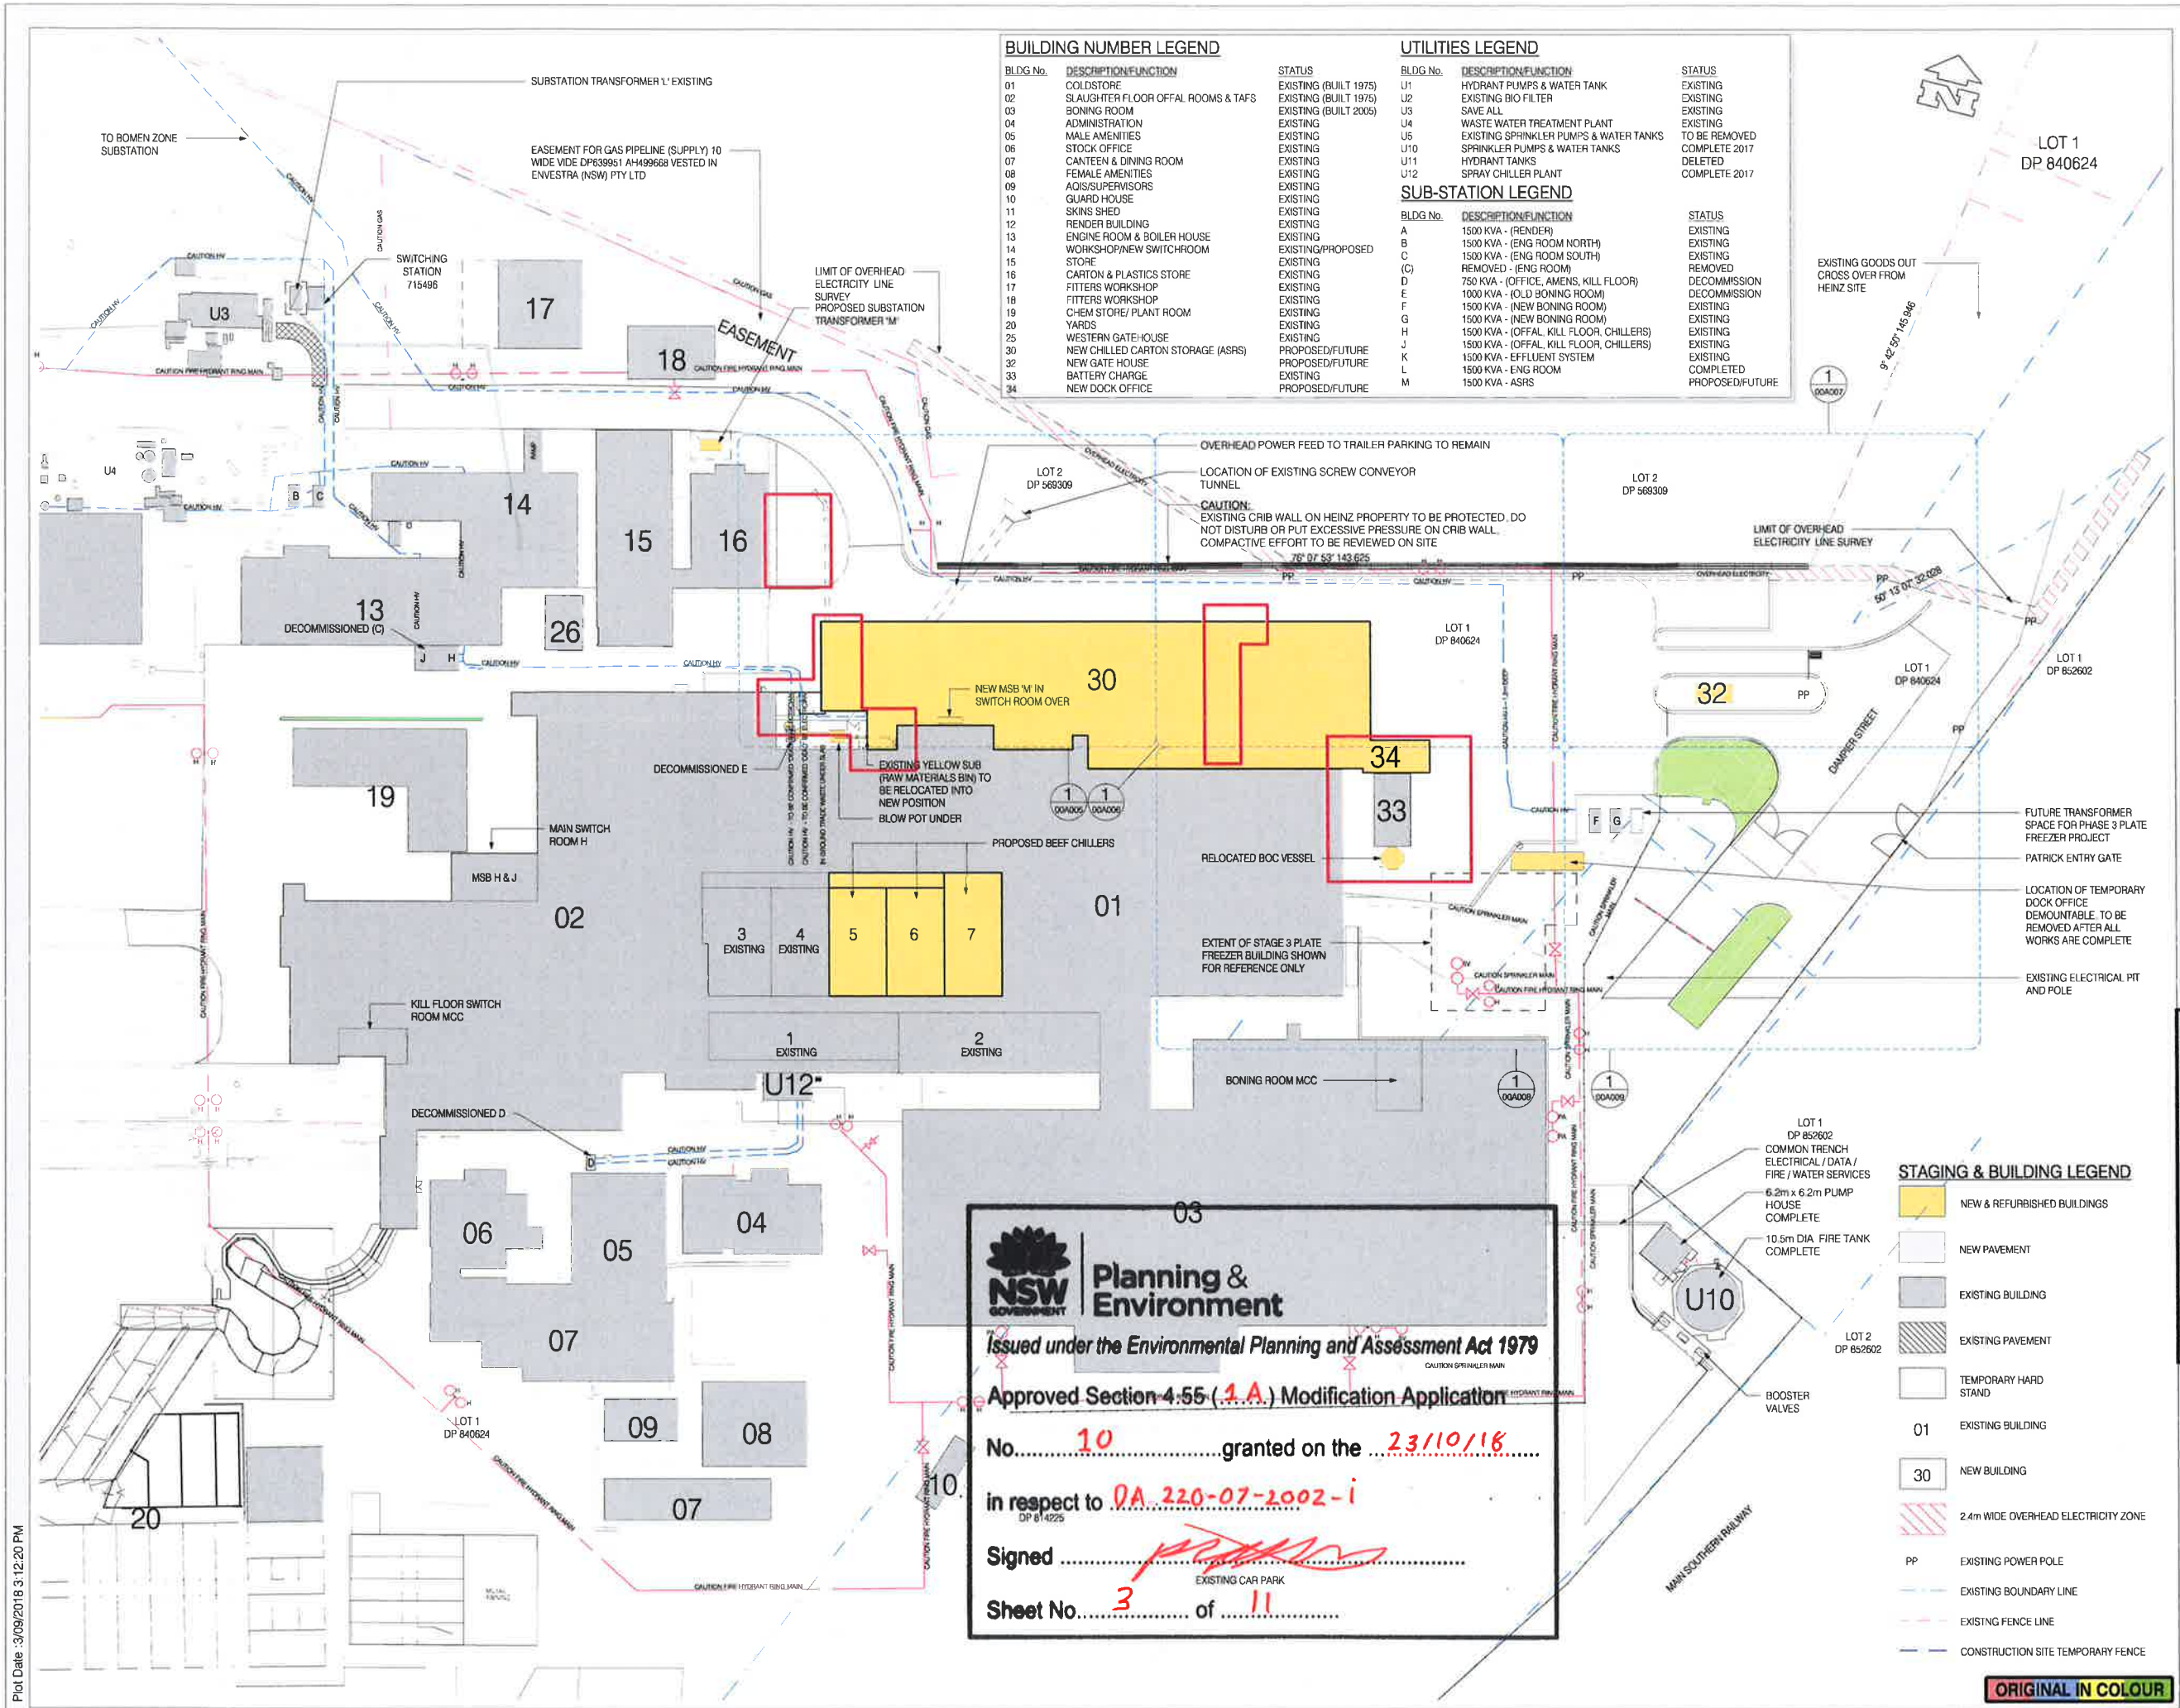

BUILDING NUMBER LEGEND

BLDG No.	DESCRIPTION/FUNCTION	STATUS
01	COLDSTORE	EXISTING (BUILT 1975)
02	SLAUGHTER FLOOR OFFAL ROOMS & TAFS	EXISTING (BUILT 1975)
03	BONING ROOM	EXISTING (BUILT 2005)
04	ADMINISTRATION	EXISTING
05	MALE AMENITIES	EXISTING
06	STOCK OFFICE	EXISTING
07	CANTEEN & DINING ROOM	EXISTING
08	FEMALE AMENITIES	EXISTING
09	AGIS/SUPERVISORS	EXISTING
10	GUARD HOUSE	EXISTING
11	SKINS SHED	EXISTING
12	RENDER BUILDING	EXISTING
13	ENGINE ROOM & BOILER HOUSE	EXISTING
14	WORKSHOP/NEW SWITCHROOM	EXISTING/PROPOSED
15	STORE	EXISTING
16	CARTON & PLASTICS STORE	EXISTING
17	FITTERS WORKSHOP	EXISTING
18	CHEM STORE/PLANT ROOM	EXISTING
19	YARDS	EXISTING
20	WESTERN GATE HOUSE	EXISTING
30	NEW CHILLED CARTON STORAGE (ASRS)	PROPOSED/FUTURE
32	NEW GATE HOUSE	PROPOSED/FUTURE
33	BATTERY CHARGE	EXISTING
34	NEW DOCK OFFICE	PROPOSED/FUTURE

UTILITIES LEGEND


BLDG No.	DESCRIPTION/FUNCTION	STATUS
U1	HYDRANT PUMPS & WATER TANK	EXISTING
U2	EXISTING BIO FILTER	EXISTING
U3	WASTE WATER TREATMENT PLANT	EXISTING
U4	EXISTING SPRINKLER PUMPS & WATER TANKS	EXISTING
U10	SPRINKLER PUMPS & WATER TANKS	TO BE REMOVED
U11	HYDRANT TANKS	COMPLETE 2017
U12	SPRAY CHILLER PLANT	DELETED

SUB-STATION LEGEND

BLDG No.	DESCRIPTION/FUNCTION	STATUS
A	1500 KVA - (RENDER)	EXISTING
B	1500 KVA - (ENG ROOM NORTH)	EXISTING
C	1500 KVA - (ENG ROOM SOUTH)	EXISTING
(C)	REMOVED - (ENG ROOM)	REMOVED
D	750 KVA - (OFFICE, AMENS, KILL FLOOR)	DECOMMISSION
E	1000 KVA - (OLD BONING ROOM)	DECOMMISSION
F	1500 KVA - (NEW BONING ROOM)	EXISTING
G	1500 KVA - (NEW BONING ROOM)	EXISTING
H	1500 KVA - (OFFAL, KILL FLOOR, CHILLERS)	EXISTING
J	1500 KVA - (OFFAL, KILL FLOOR, CHILLERS)	EXISTING
K	1500 KVA - EFFLUENT SYSTEM	EXISTING
L	1500 KVA - ENG ROOM	EXISTING
M	1500 KVA - ASRS	COMPLETED



© WILEY & CO PTY LTD
ABN 40 010 604 869
This document is the property of Wiley & Co Pty Ltd and is copyright. The subject matter of it is confidential. Do not use, reproduce, copy or disclose except with and only to the extent of the prior written consent of Wiley & Co Pty Ltd. Persons receiving this document are responsible for restricting disclosure as stated above.

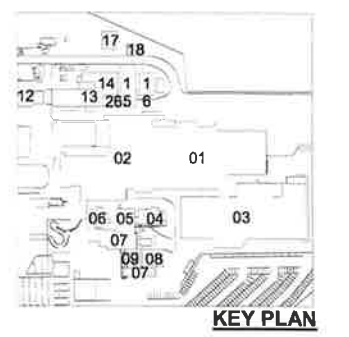

General Notes:
AREA OF DA MODIFICATION

Date	Issue	Amendment	Init
03/09/18	3	ISSUE FOR DA MOD	DT
30/07/18	2	FOR REVISION (BLD LENGTHEN)	DT
30/07/18	1	INITIAL ISSUE	DT

WILEY



TEYS AUSTRALIA - STAGE 2
COLD MEAT PROJECT
WAGGA WAGGA, NSW
Drawing Title
PROPOSED
PART SITE PLAN

Scale	A1 = 1:500 (A0 = 1:1000)	0 5 10
Drawn	DT	Date JUN 2018
Project No.	W21206	Bldg No. 00
Drawing No.	00A004 - 3	Issue

NOT FOR CONSTRUCTION

Planning & Environment

Issued under the Environmental Planning and Assessment Act 1979

Approved Section 4.55 (1A) Modification Application


No. **10** granted on the **23/10/18**

in respect to **DA 220-07-2002-1**

Signed


Sheet No. **3** of **11**

Plot Date : 3/09/2018 3:12:20 PM

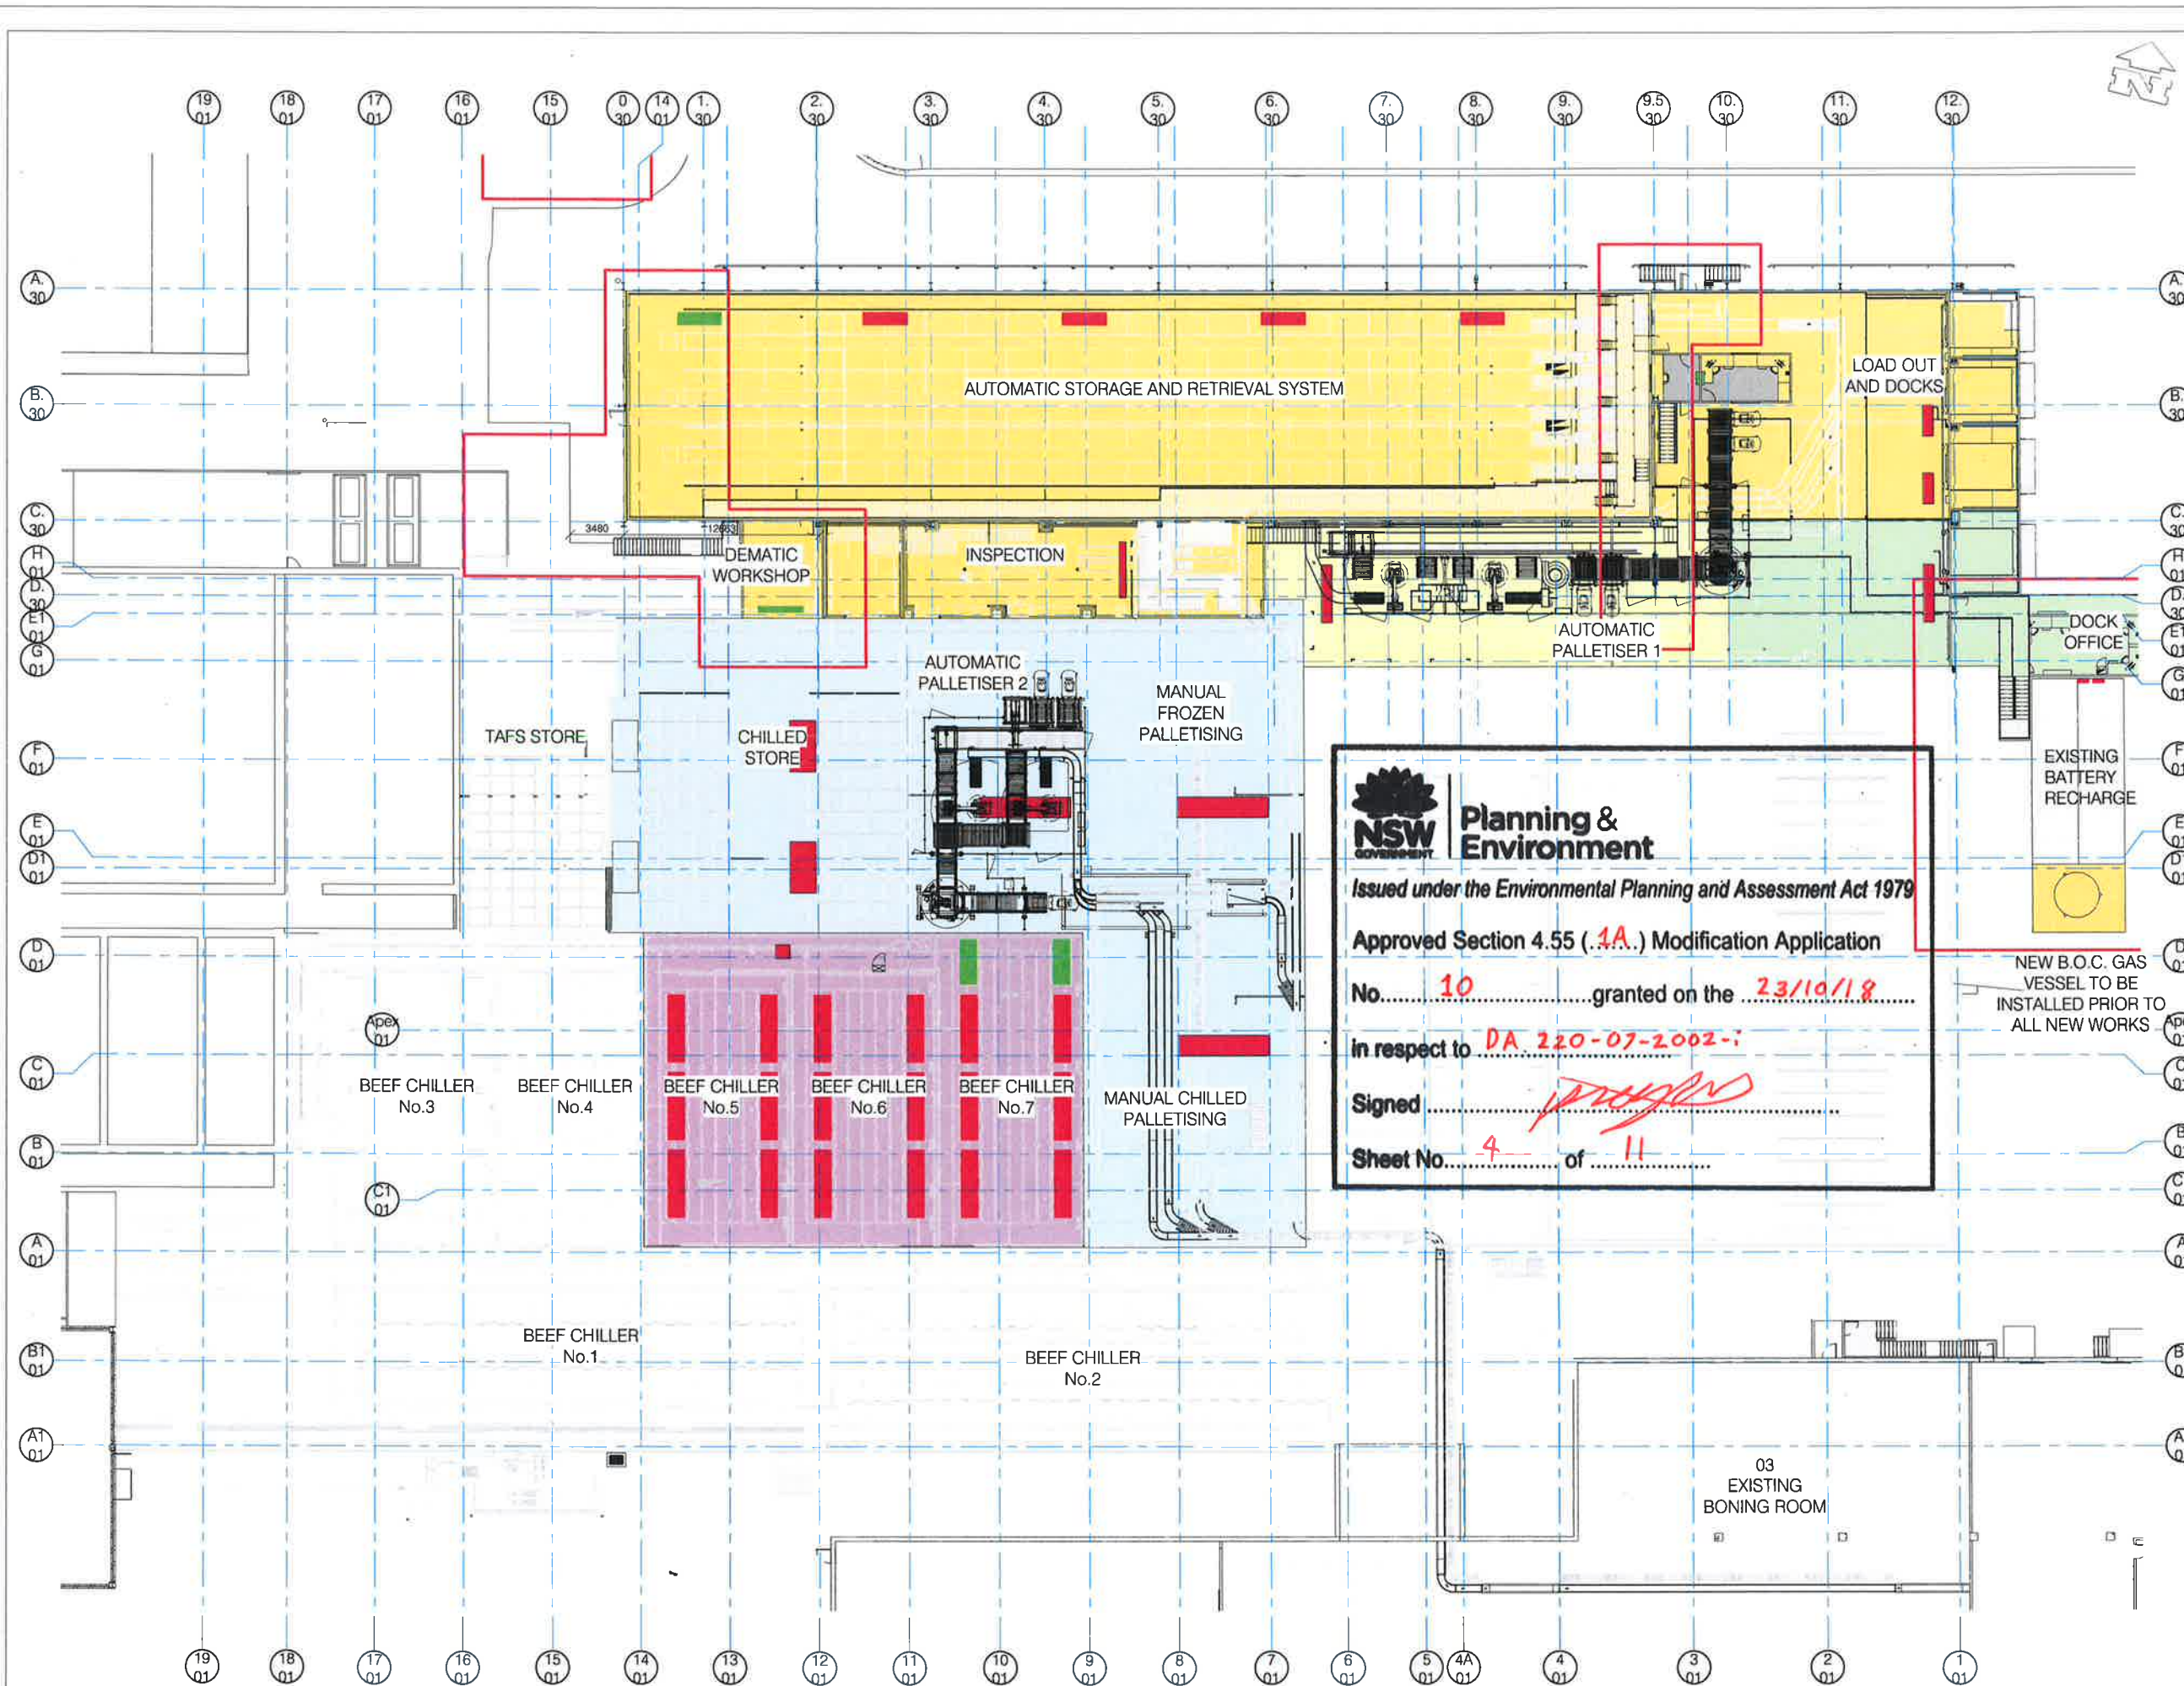

NSW GOVERNMENT Planning & Environment
 Issued under the Environmental Planning and Assessment Act 1979
 Approved Section 4.55 (.1A.) Modification Application
 No. **10** granted on the **23/10/18**
 In respect to **DA 220-07-2002-1**
 Signed *[Signature]*
 Sheet No. **4** of **11**

© WILEY & CO PTY LTD
 ABN 40 010 604 869
 This document is the property of Wiley & Co Pty Ltd and is copyright. The subject matter of it is confidential. Do not use, reproduce, copy or disclose except with and only to the extent of the prior written consent of Wiley & Co Pty Ltd. Persons receiving this document are responsible for restricting disclosure as stated above.

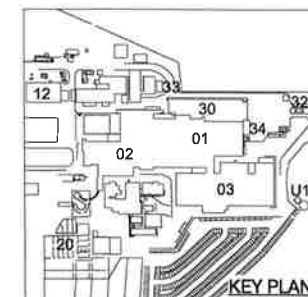

LEGEND

[Yellow Box]	Stage 1
[Light Yellow Box]	Stage 2
[Light Green Box]	Stage 3
[Green Box]	Stage 4
[Dark Green Box]	Stage 5
[Red Dashed Line]	Demolished or Relocated

STAGE 2 REFRIGERATION

[Red Box]	As previously designed for Stage 2
[Green Box]	Possible new units for Stage 2

General Notes:
 [Red Line] AREA OF DA MODIFICATION

03/09/18	7	ISSUE FOR DA MOD	DT
17/08/18	6	AUTOMATIC PALLETISERS UPDATED	DJM
14/08/18	5	GENERAL REVISION	DJM
31/07/18	4	GENERAL REVISION	JNM
27/07/18	3	REFRIGERATION SCOPE ADDED	JNM
30/07/18	2	FOR REVISION (BLD LENGTHEN)	DT
14/06/18	1	UPDATED FROM W14003	JNM
Date	Issue	Amendment	Init



Project **TEYS AUSTRALIA - STAGE 2 COLD MEAT PROJECT WAGGA WAGGA, NSW**
 Drawing Title **PHASE 2 - OVERALL PROJECT STAGING GUIDE**

Scale	A1=1:200 (A3=1:400)	0 2000 4000
Drawn	JNM	Date JUNE 2018
Project No.	W21206	Bldg No. 01
Drawing No.	00Q100- 7	Issue

PRELIMINARY


KENNETH A. WILHELMSON, JR. (VOLUME 1) **WILEY**
 www.wiley.com.au
 connect@wiley.com.au
 1300 385 988

Project




Scale		A1 = 1/200 (A8 = 1/400)	0 2000 4000
Drawn		DT	Date JUN 2018
Project No.		Bidg No.	
W21206		30	
Drawing No.		Issue	
30A101 - 5			
PRELIMINARY			



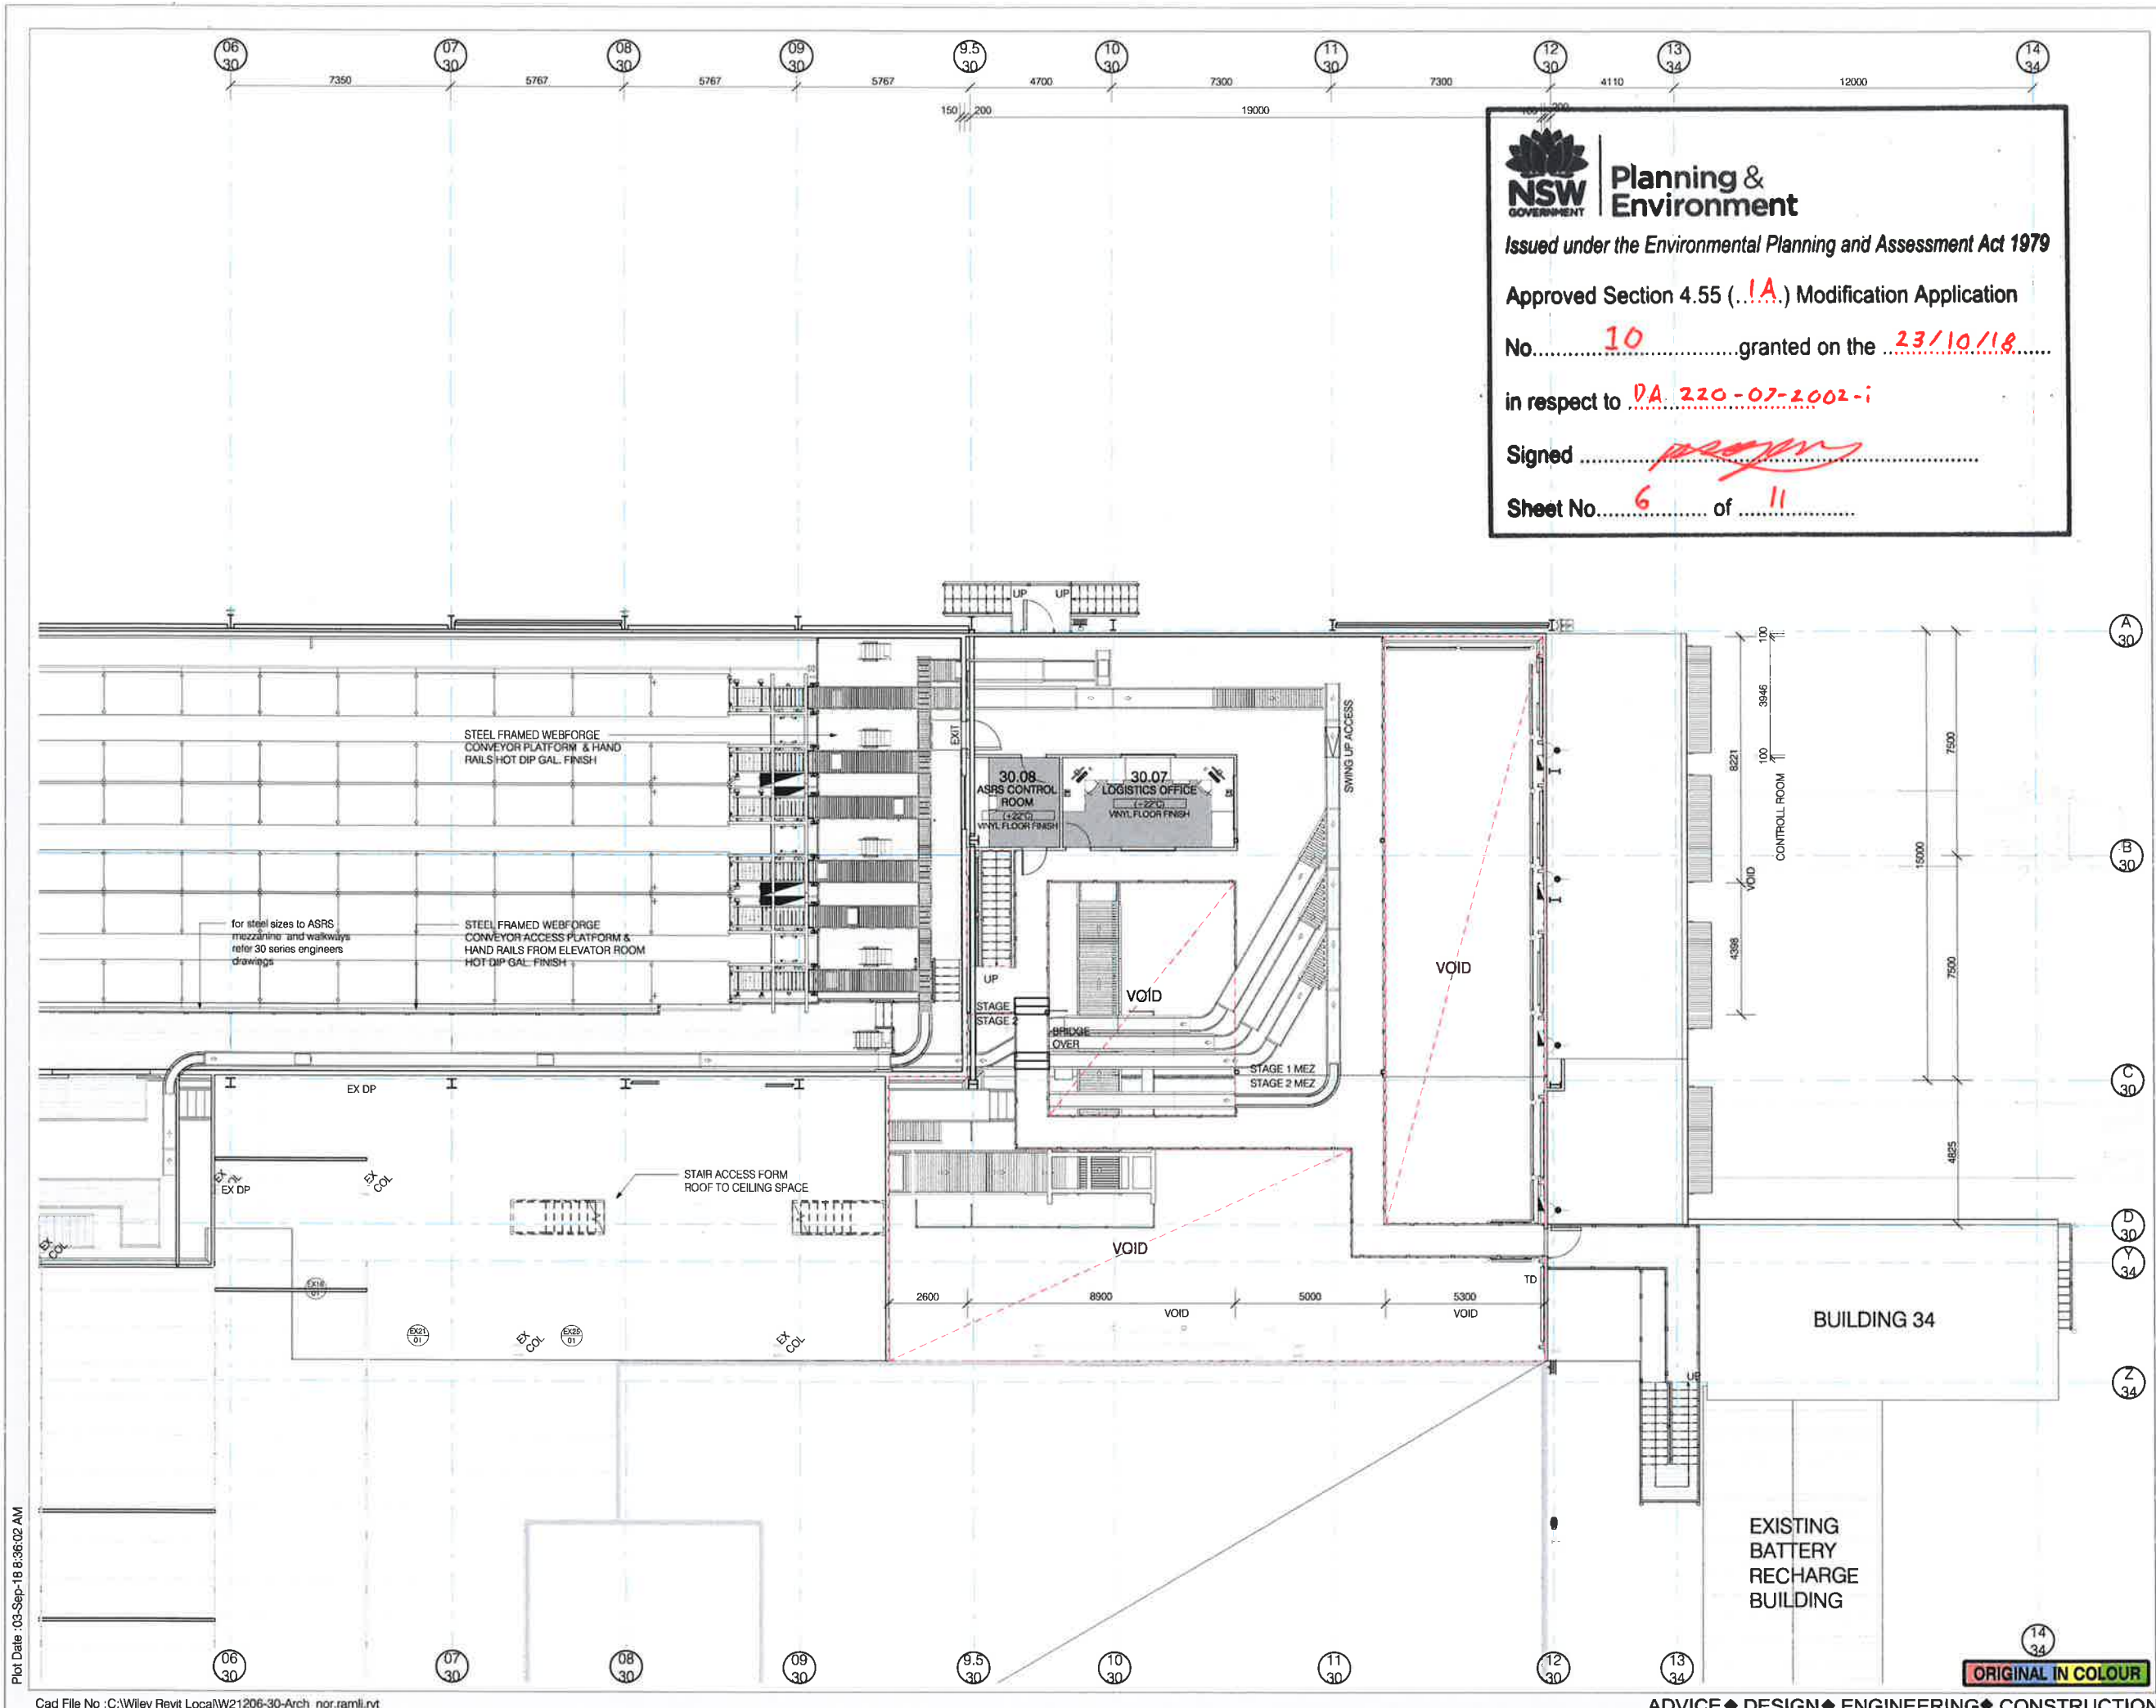

NSW GOVERNMENT **Planning & Environment**
Issued under the Environmental Planning and Assessment Act 1979
Approved Section 4.55 (...IA...) Modification Application
No. 10 granted on the 23/10/18
in respect to DA 220-07-2002-i
Signed [Signature]
Sheet No. 6 of 11

© WILEY & CO PTY LTD
ABN 40 010 604 869
This document is the property of Wiley & Co Pty Ltd and is copyright. The subject matter of it is confidential. Do not use, reproduce, copy or disclose except with and only to the extent of the prior written consent of Wiley & Co Pty Ltd. Persons receiving this document are responsible for restricting disclosure as stated above.

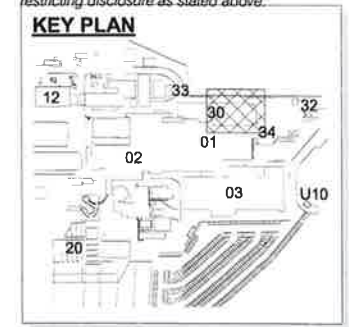

Date	Issue	Amendment	Init
03/09/18	10	ISSUE FOR DA MOD	DT
24/08/18	9	OFFICE LAYOUT FLIPPED, WALKWAYS REVISED.	DT
24/08/18	8	OFFICE LAYOUT REVISED	BM
23/09/18	7	NEW MEZ REDESIGN, NEW STAIRS, DOCK 3 MOVED TO STAGE 1	DT
21/08/18	6	ISSUE FOR CLIENT APPROVAL	DT
20/08/18	5	FRONT BUILDING, REAR EXTENSION AND BLD 34 REDESIGN	DT



Project **TEYS AUSTRALIA - STAGE 2 COLD MEAT PROJECT WAGGA WAGGA, NSW**
Drawing Title **MEZZANINE FLOOR PLAN SHEET 2 OF 2**

Scale	A1 = 1:100 (A8 = 1:200)	0 1000 2000
Drawn	DT	Date JUN 2018
Project No.	W21206	Bldg No. 30
Drawing No.	30A116-10	Issue
PRELIMINARY		

Plot Date 03-Sep-18 8:36:02 AM

Cad File No.: C:\Wiley Revit Local\W21206-30-Arch_nor.raml.rvt

ADVICE ♦ DESIGN ♦ ENGINEERING ♦ CONSTRUCTION

FINISHES NOTES:

ROOF SHEETING:
Trimdek sheeting 0.42 BMT, Colorbond 'Surfmist' finish (to match existing)

FLASHINGS:
0.6 Bmt Colorbond, 'Surfmist' finish TBC

GUTTERS:
Colorbond 'Surfmist' finish - TBC


DOWNPIPES:
PVC paint finish - colour 'Surfmist' TBC

FASCIA SHEETING:
Trimdek sheeting 0.42 Bmt, Colorbond 'Surfmist' finish TBC


INSULATED PANEL - WALL:
PIR (or approved equivalent)
Colorbond 'Surfmist' finish - TBC
Rib / Rib
0.6 Facings

INSULATED PANEL - CEILING:
PIR (or approved equivalent)
Colorbond 'Surfmist' finish - TBC
Rib / Rib
0.6 Facings

NOTE:
• All sheeting to be vermin proof
• Allow for compressible foam filler at top & bottom of fascias
• All fascias to have Colorbond drip mould

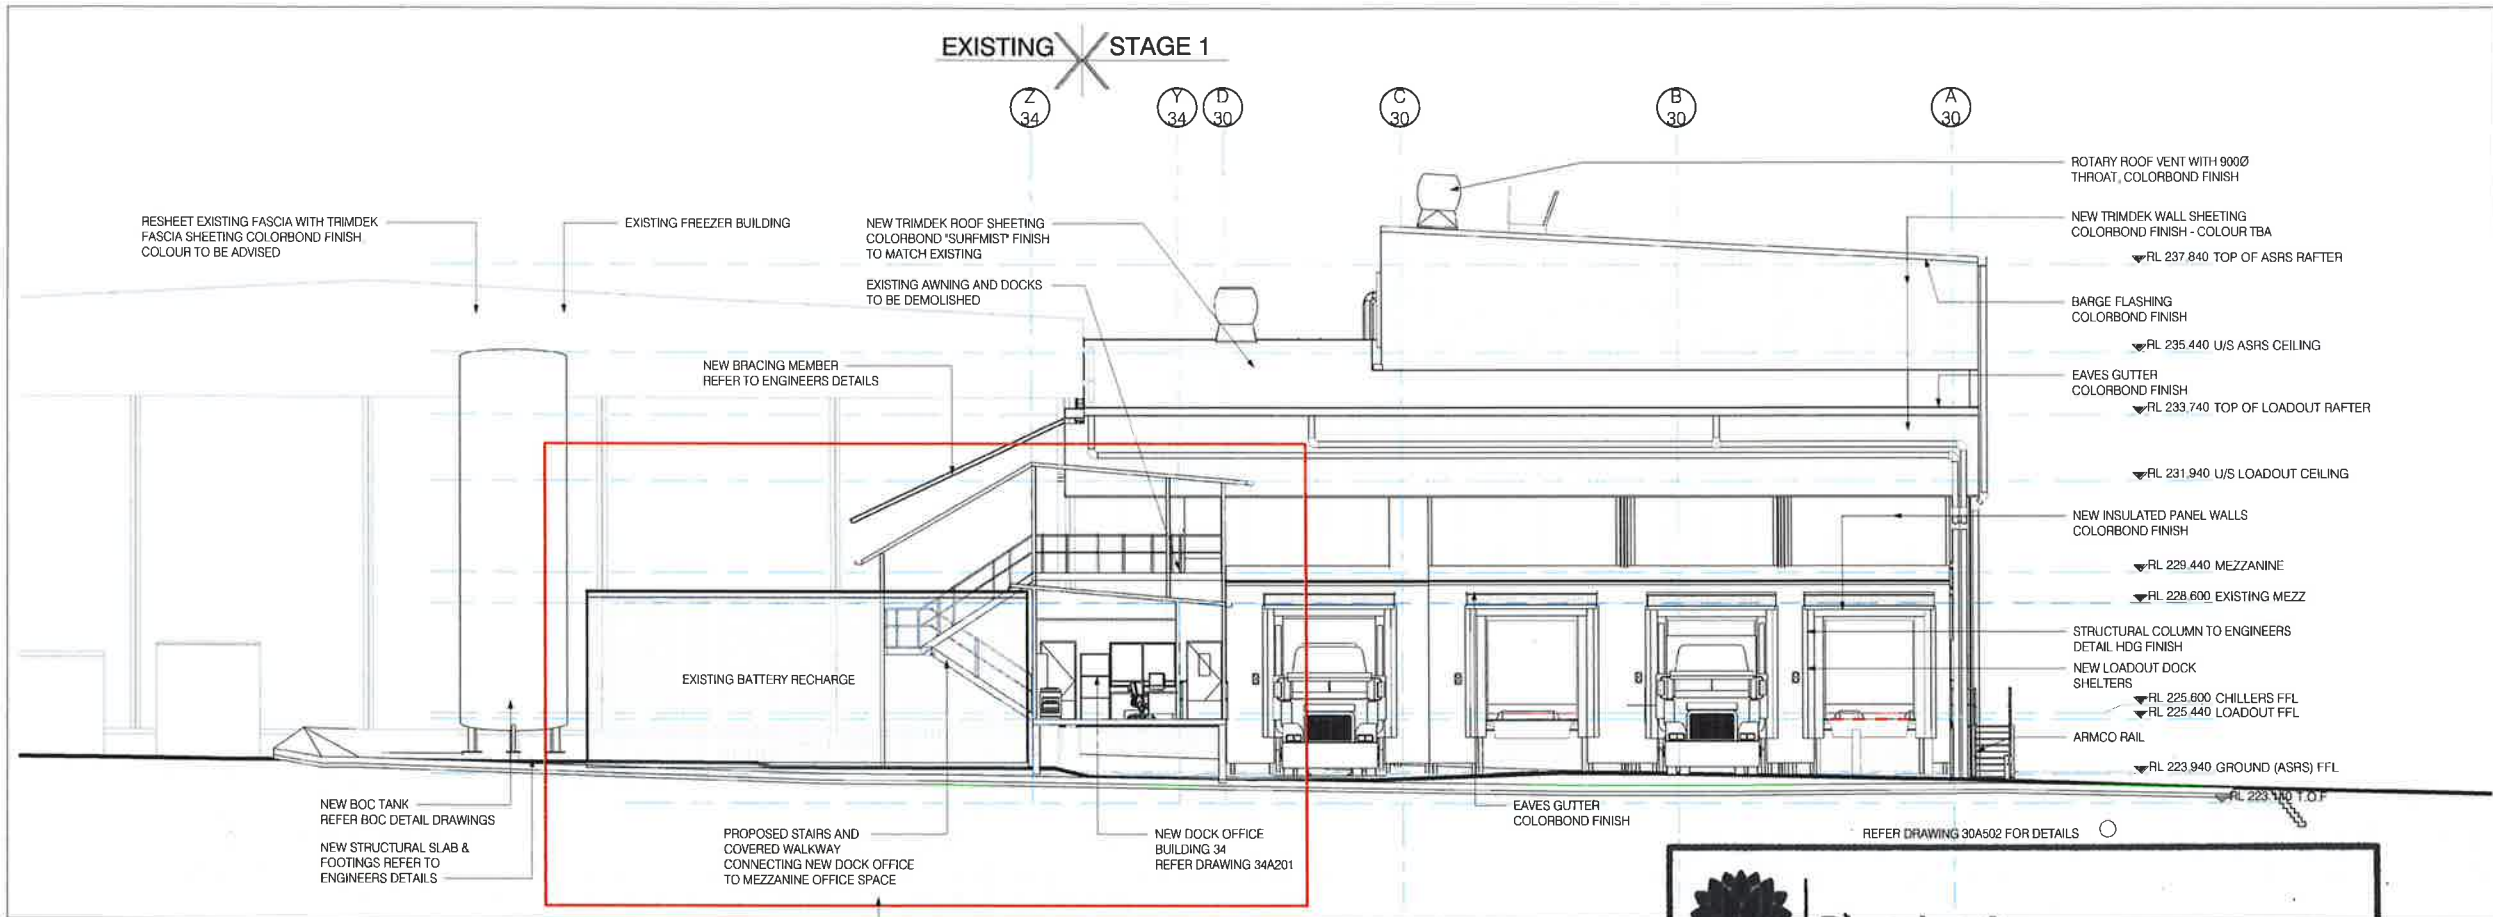

01 EAST ELEVATION
A1 = 1 : 100

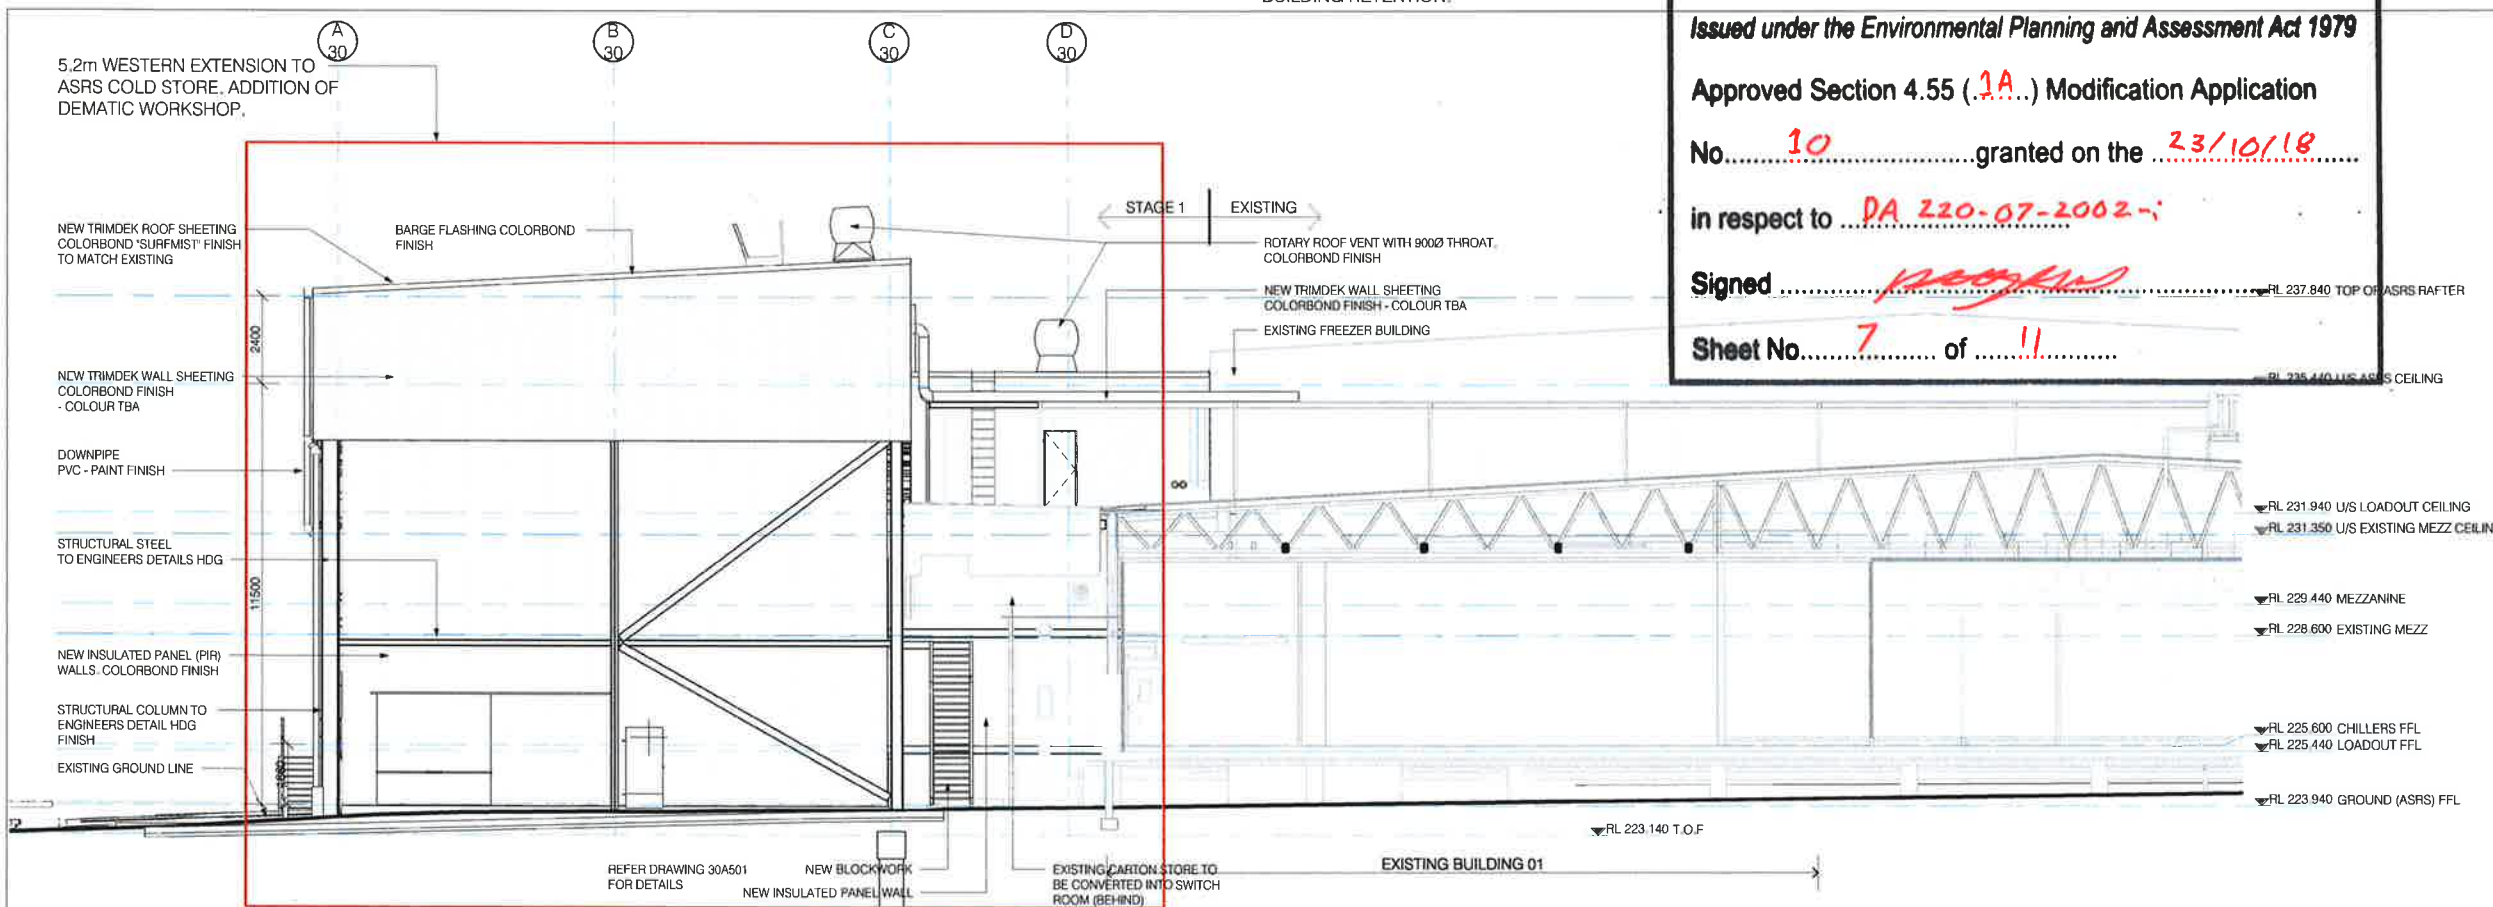

02 WEST ELEVATION
A1 = 1 : 100

NSW GOVERNMENT **Planning & Environment**
Issued under the Environmental Planning and Assessment Act 1979
Approved Section 4.55 (.1A...) Modification Application
No. 10 granted on the 23/10/18
in respect to DA 220-07-2002-1
Signed [Signature]
Sheet No. 7 of 11

Date	Issue	Amendment	Init
03/09/18	4	ISSUE FOR DA MOD	DT
21/08/18	3	ISSUE FOR CLIENT APPROVAL	DT
20/08/18	2	FRONT BUILDING REAR EXTENSION AND BLD 34 REDESIGN	DT
30/07/18	1	INITIAL ISSUE	DT

WILEY & CO PTY LTD
www.wiley.com.au
connect@wiley.com.au
1300 385 988


Project
TEYS AUSTRALIA - STAGE 2
COLD MEAT PROJECT
WAGGA WAGGA, NSW
Drawing Title
ELEVATIONS-SHEET 1 OF 3

Scale A1 = 1:100 (A2 = 1:200) 0 1000 2000
Drawn DT **Date** JUN 2018
Project No. W21206 **Bldg No.** 30
Drawing No. **Issue**
30A201 - 4
PRELIMINARY


Plot Date : 3/09/2018 3:27:48 PM

© WILEY & CO PTY LTD
ABN 40 010 604 869
This document is the property of Wiley & Co Pty Ltd and is copyright. The subject matter of it is confidential. Do not use, reproduce, copy or disclose except with and only to the extent of the prior written consent of Wiley & Co Pty Ltd. Persons receiving this document are responsible for restricting disclosure as stated above.

FINISHES NOTES:
ROOF SHEETING:
Trimdek sheeting 0.42 BMT, Colorbond "Surfmist" finish (to match existing)
FLASHINGS:
0.6 Bmt Colorbond, "Surfmist" finish TBC
GUTTERS:
Colorbond "Surfmist" finish - TBC
DOWNPIPES:
PVC paint finish - colour "Surfmist" TBC
FASCIA SHEETING:
Trimdek sheeting 0.42 Bmt, Colorbond "Surfmist" finish TBC
INSULATED PANEL - WALL:
PIR (or approved equivalent)
Colorbond "Surfmist" finish - TBC
Rib / Rib
0.6 Facings
INSULATED PANEL - CEILING:
PIR (or approved equivalent)
Colorbond "Surfmist" finish - TBC
Rib / Rib
0.6 Facings
NOTE:
• All sheeting to be vermin proof
• Allow for compressible foam filler at top & bottom of fascias
• All fascias to have Colorbond drip mould

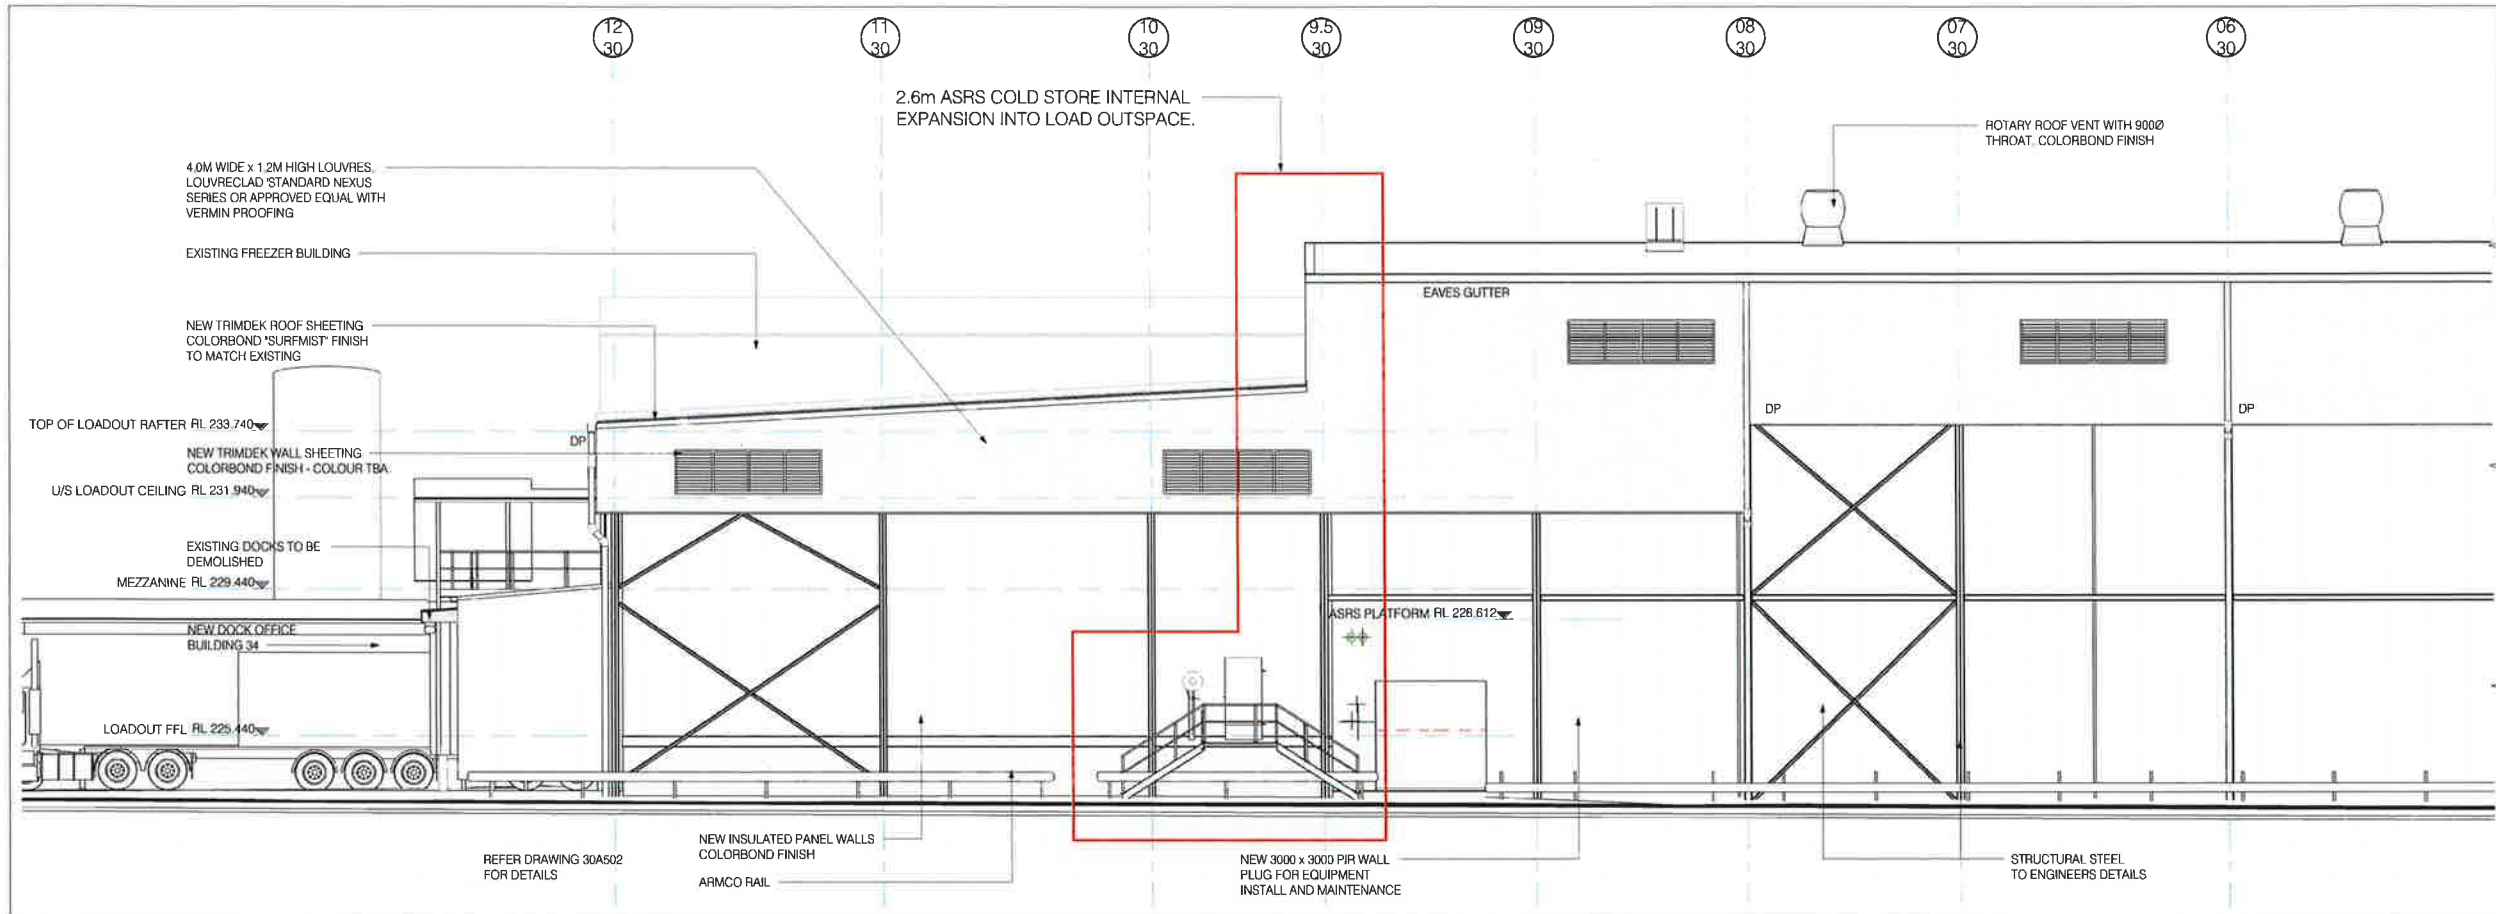

01 NORTH ELEVATION - EAST END
A1 = 1 : 100

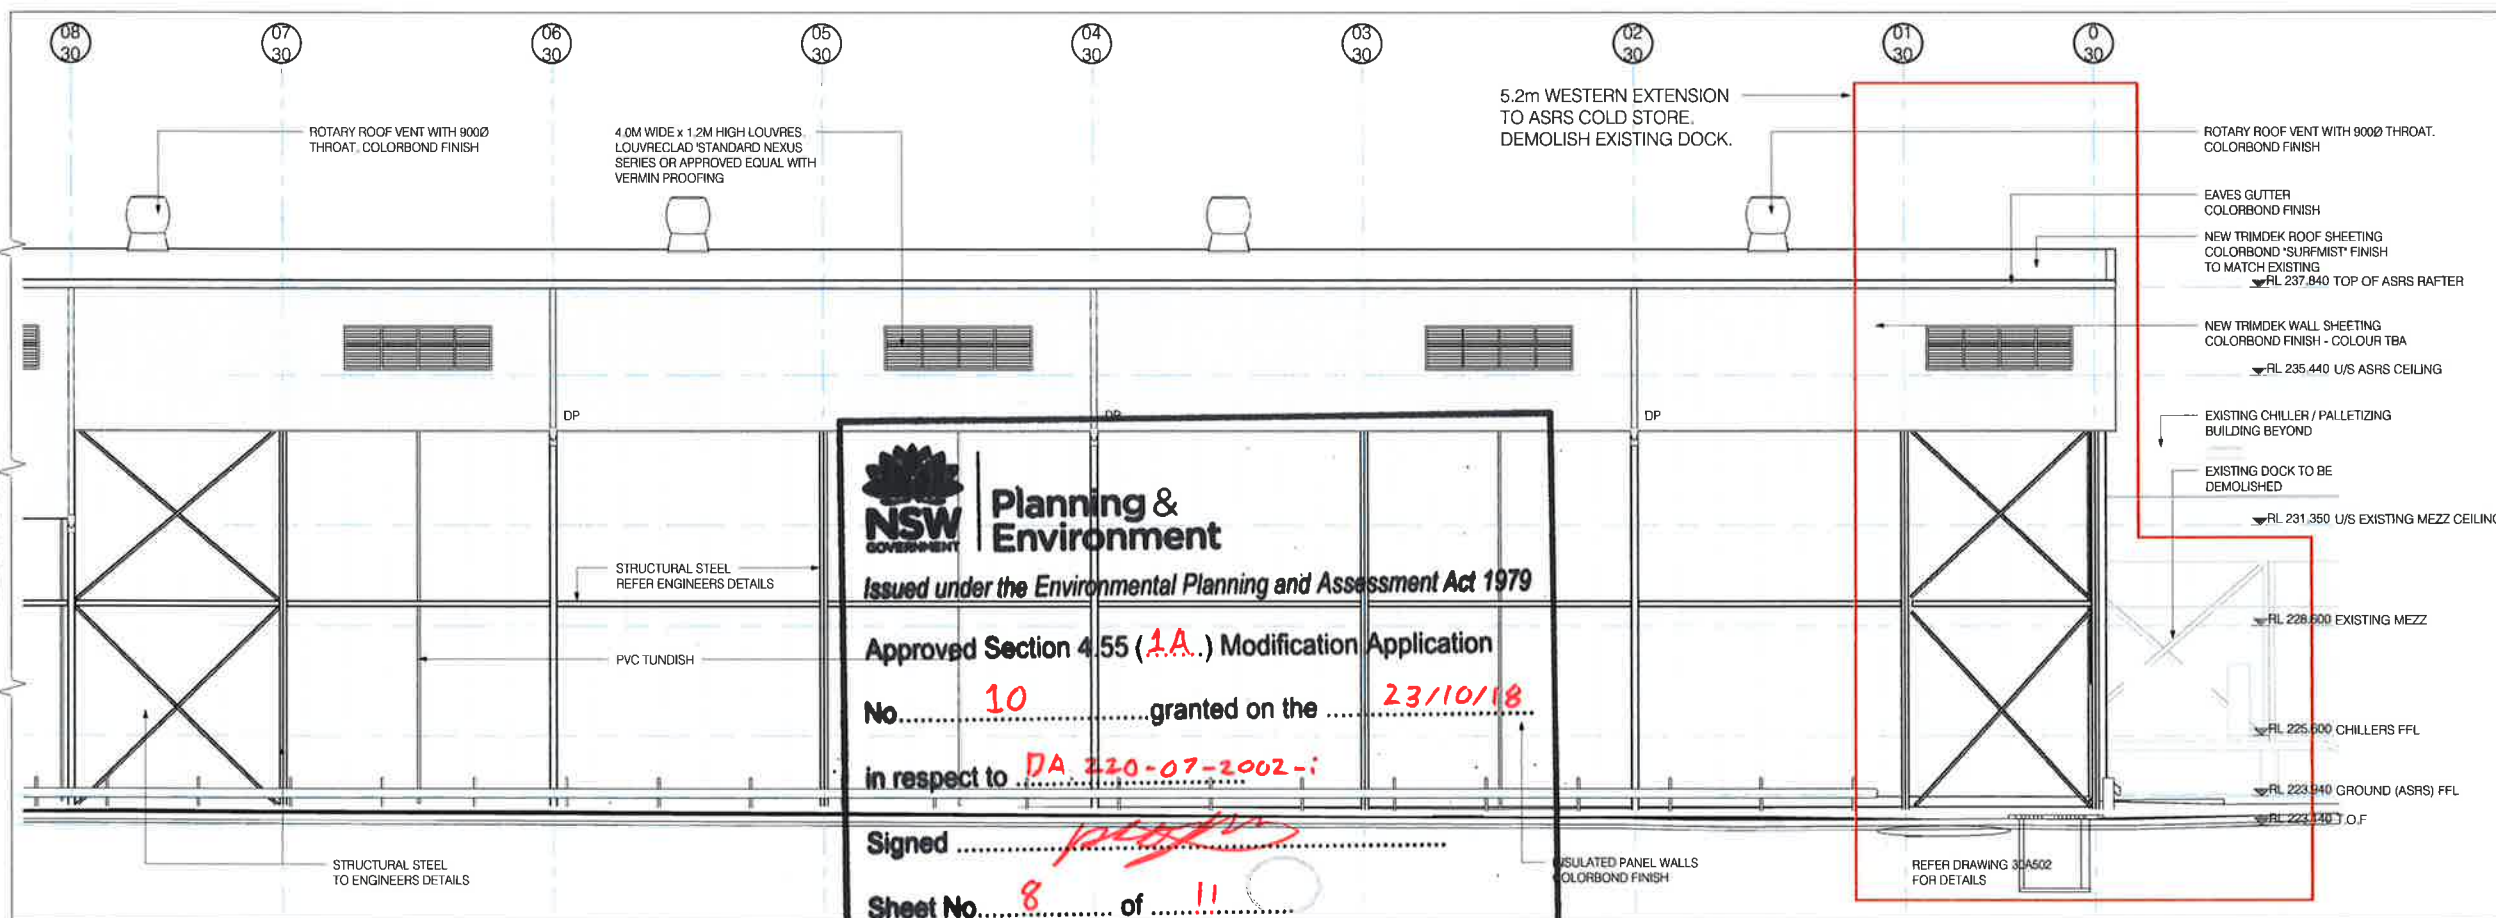

02 NORTH ELEVATION - WEST END
A1 = 1 : 100

NSW GOVERNMENT | **Planning & Environment**
Issued under the Environmental Planning and Assessment Act 1979
Approved Section 4.55 (1A.) Modification Application
No. **10** granted on the **23/10/18**
in respect to **DA 220-07-2002-1**
Signed **[Signature]**
Sheet No. **8** of **11**

03/09/18	4	ISSUE FOR DA MOD	DT
21/08/18	3	ISSUE FOR CLIENT APPROVAL	DT
20/08/18	2	FRONT BUILDING, REAR EXTENSION AND BLD 34 REDESIGN	DT
30/07/18	1	INITIAL ISSUE	DT


Date Issue Amendment Init
www.wiley.com.au
connect@wiley.com.au
1300 385 988

WILEY

Project
TEYS AUSTRALIA - STAGE 2
COLD MEAT PROJECT
WAGGA WAGGA, NSW
Drawing Title
ELEVATIONS-SHEET 2 OF 3

Scale A1 = 1:100 (A3 = 1:200) 0 1000 2000
Drawn DT Date JUN 2018
Project No. W21206 Bldg No. 30
Drawing No. Issue
30A202 - 4
PRELIMINARY

ADVICE ♦ DESIGN ♦ ENGINEERING ♦ CONSTRUCTION

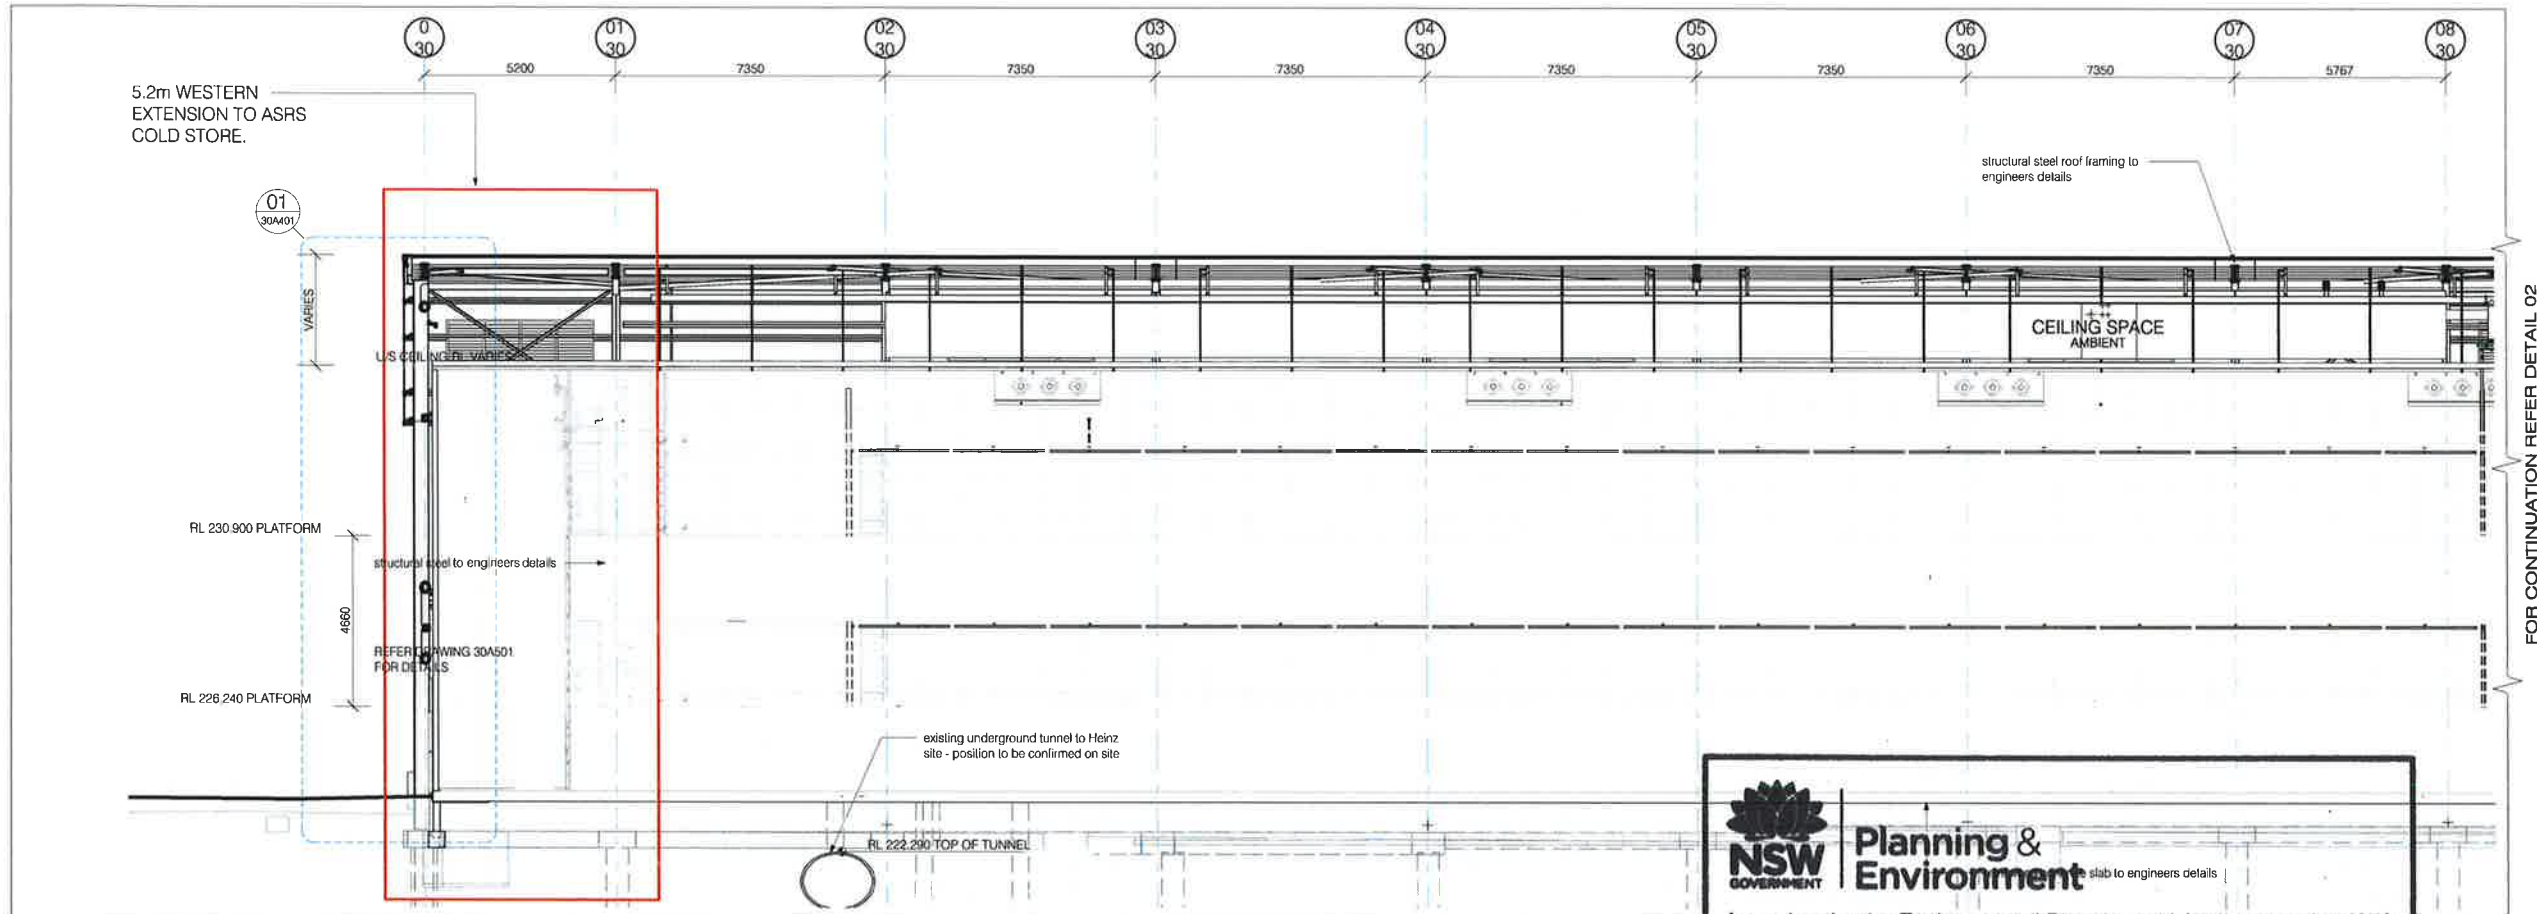

NSW GOVERNMENT Planning & Environment

Issued under the Environmental Planning and Assessment Act 1979


Approved Section 4.55 (.1A) Modification Application

No. 10 granted on the 23/10/18

in respect to DA 220-07-2002-i

Signed [Signature]

Sheet No. 9 of 11

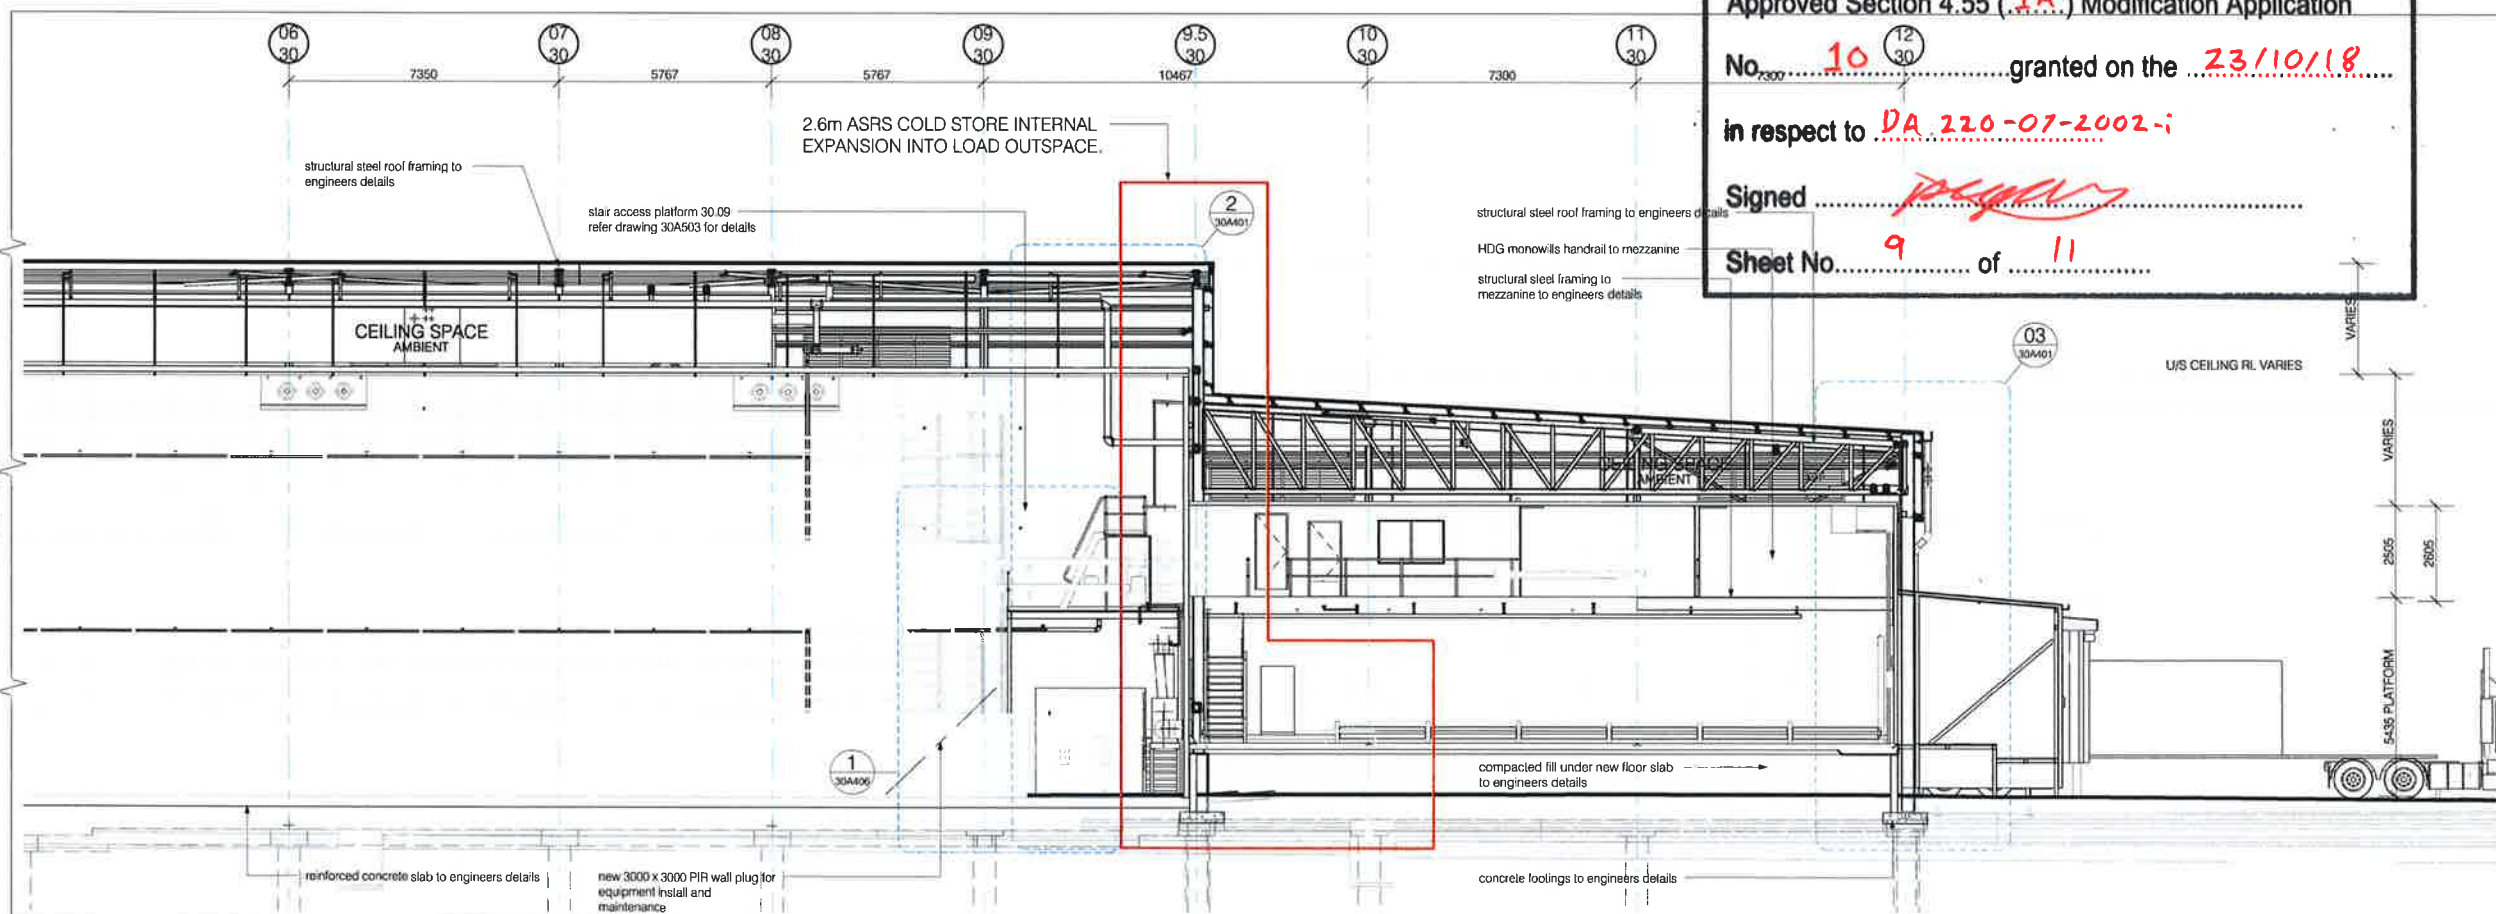

03/09/18	3	ISSUE FOR DA MOD	DT
20/08/18	2	FRONT BUILDING, REAR EXTENSION AND BLD 34 REDESIGN	DT
30/07/18	1	INITIAL ISSUE	DT
Date	Issue	Amendment	Init

BRISBANE MELBOURNE SYDNEY TOWNSHIPS
www.wiley.com.au
connect@wiley.com.au
1300 385 988

WILEY

Project

A CARGILL
TEYS
JOINT VENTURE

TEYS AUSTRALIA - STAGE 2
COLD MEAT PROJECT
WAGGA WAGGA, NSW

Drawing Title
SECTIONS - SHEET 1 OF 4


Scale A1 = 1:100 (A3 = 1200) 0 1000 2000

Drawn DT Date JUN 2018


Project No. W21206 Bldg No. 30

Drawing No. Issue

30A301 - 3
PRELIMINARY

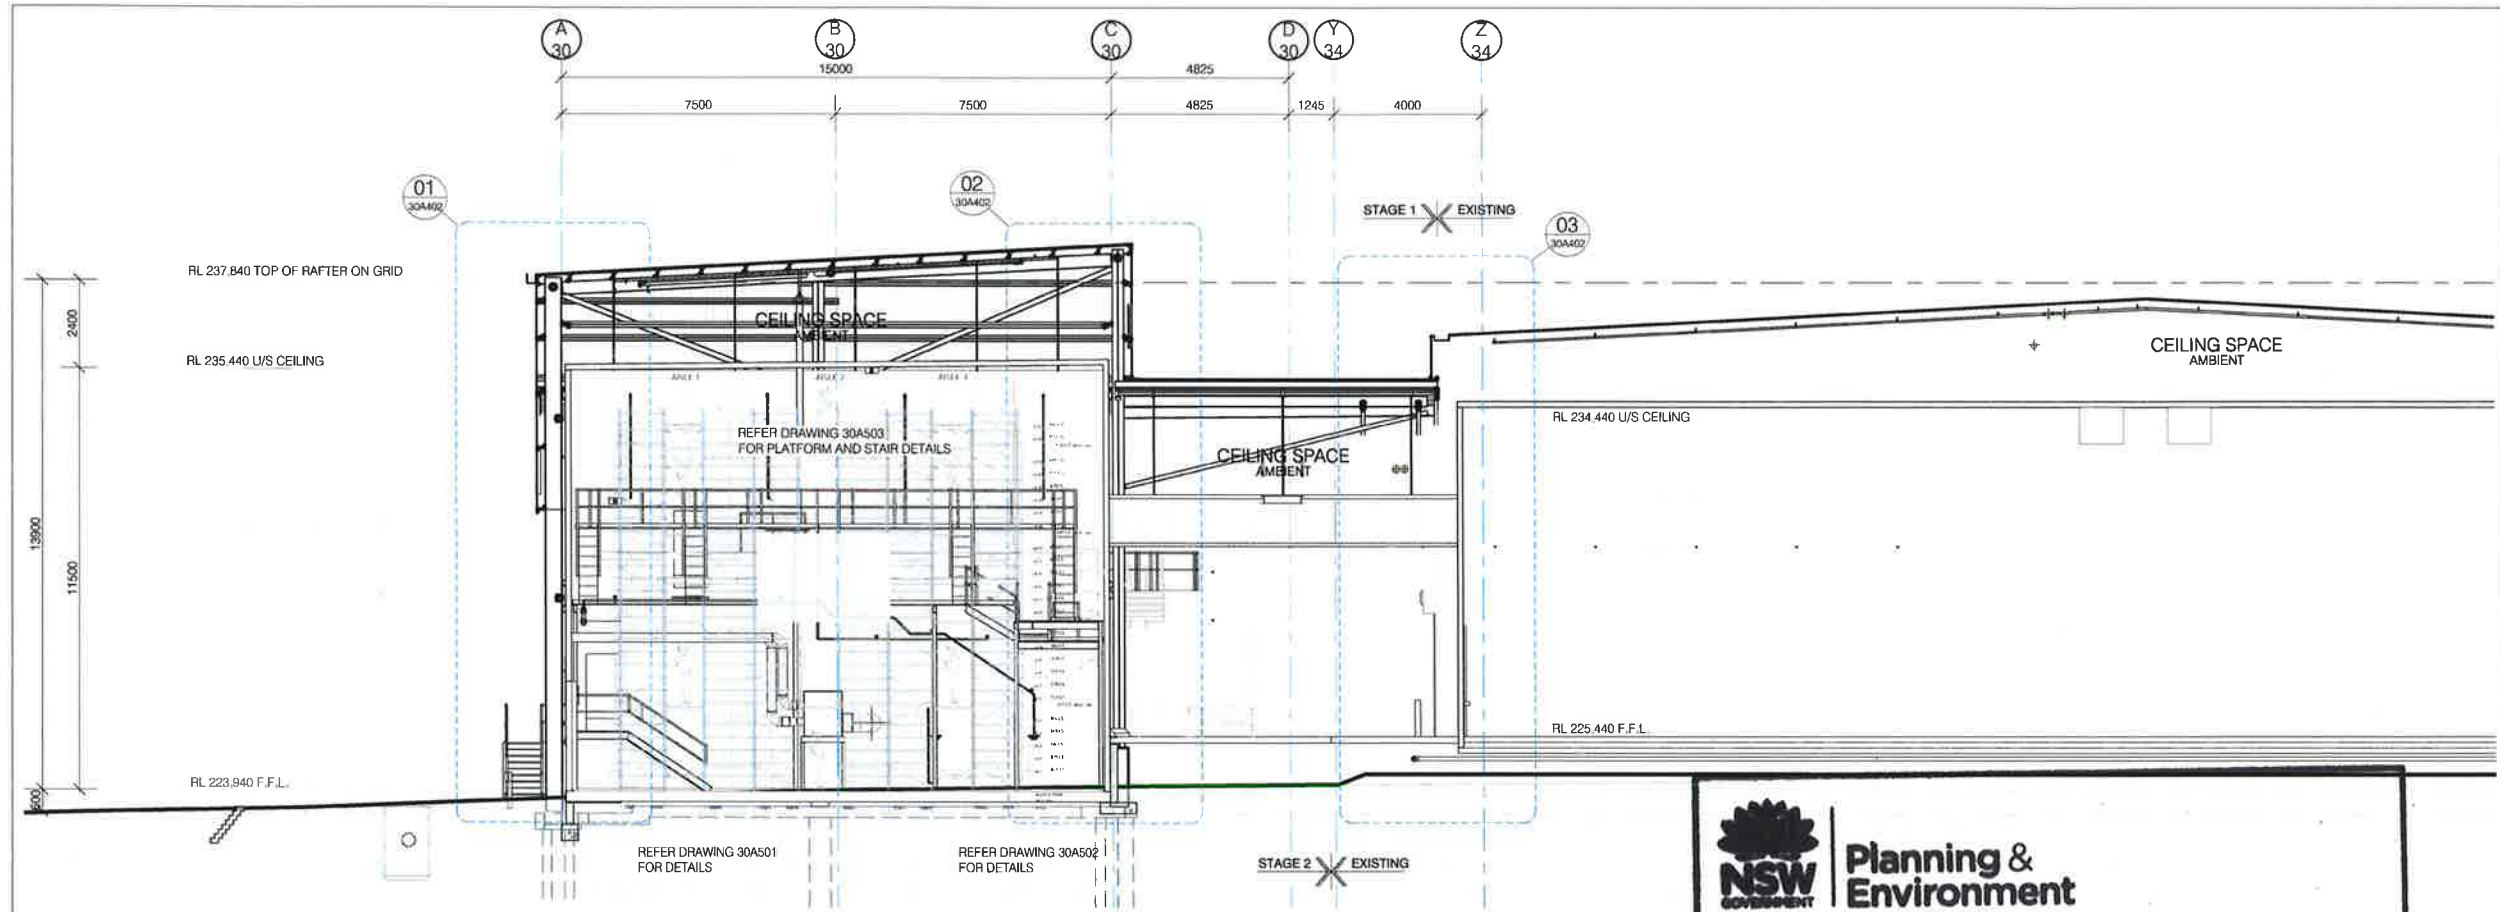

01 SECTION
 A1 = 1:100

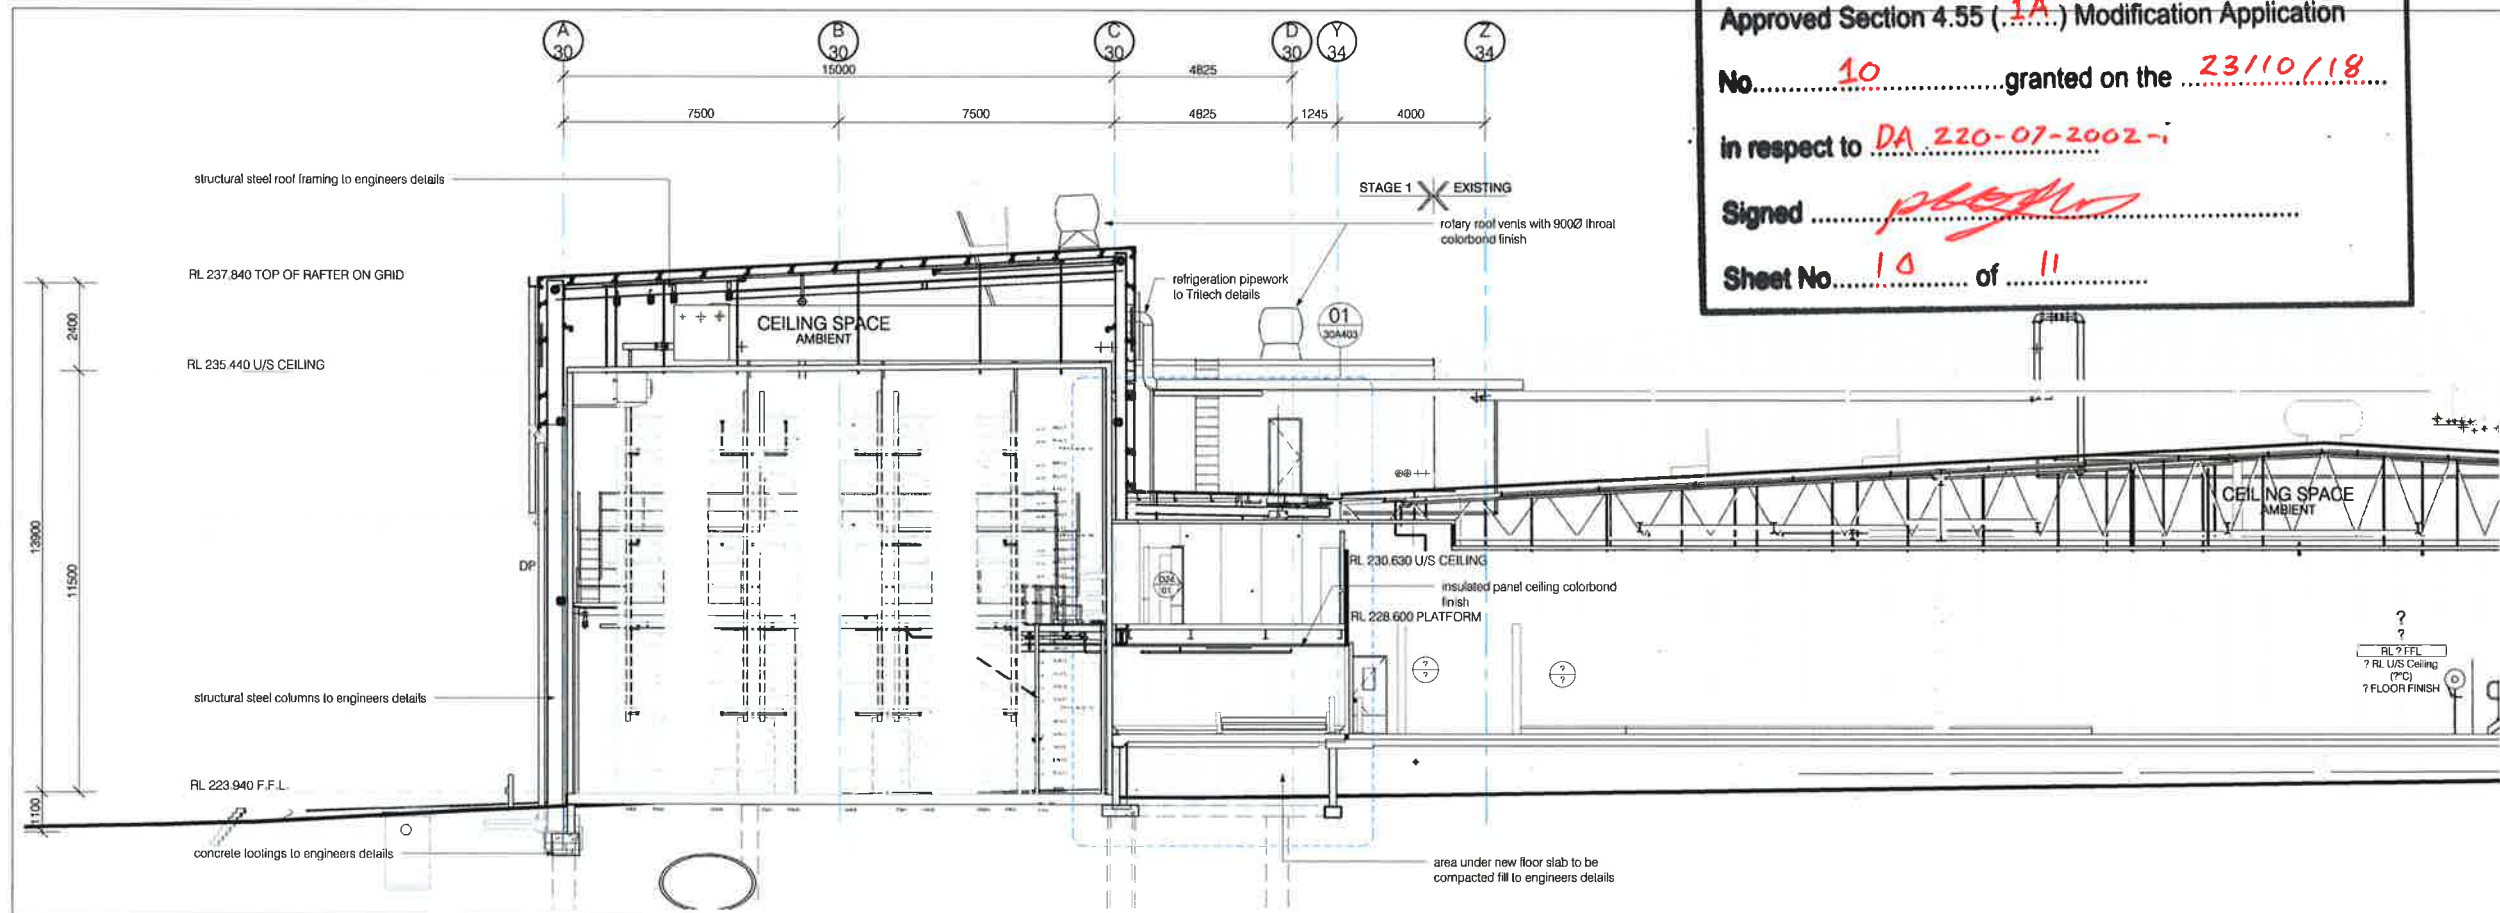

02 SECTION
 A1 = 1:100

NSW GOVERNMENT | **Planning & Environment**

Issued under the Environmental Planning and Assessment Act 1979

Approved Section 4.55 (.1A.) Modification Application

No. 10 granted on the 23/10/18

in respect to DA 220-07-2002-

Signed [Signature]

Sheet No. 10 of 11

03/09/18	3	ISSUE FOR DA MOD	DT
20/08/18	2	FRONT BUILDING, REAR EXTENSION AND BLD 34 REDESIGN	DT
30/07/18	1	INITIAL ISSUE	DT
Date	Issue	Amendment	Init

BREKID, KUALA LUMPUR, WILSON, SYDNEY, TONGGONG
 www.wiley.com.au
 connect@wiley.com.au
 1300 285 988

WILEY

Project

A CARGILL
TEYS AUSTRALIA
 JOINT VENTURE

TEYS AUSTRALIA - STAGE 2
 COLD MEAT PROJECT
 WAGGA WAGGA, NSW


Drawing Title
 SECTIONS - SHEET 2 OF 4

Scale	A1 = 1:100 (A8 = 1:200)	0 1000 2000
Drawn	DT	Date JUN 2018
Project No.	W21206	Bldg No. 30
Drawing No.	30A302 - 3	Issue


PRELIMINARY

© WILEY & CO PTY LTD
ABN 40 010 604 869
This document is the property of Wiley & Co Pty Ltd and is copyright. The subject matter of it is confidential. Do not use, reproduce, copy or disclose except with and only to the extent of the prior written consent of Wiley & Co Pty Ltd. Persons receiving this document are responsible for restricting disclosure as stated above.

FINISHES NOTES:
ROOF SHEETING:
Trimdek sheeting 0.42 BMT, Colorbond 'Surfmist' finish (to match existing)
FLASHINGS:
0.6 Bmt Colorbond, 'Surfmist' finish TBC
GUTTERS:
Colorbond 'Surfmist' finish - TBC
DOWNPIPES:
PVC paint finish - colour 'Surfmist' TBC
FASCIA SHEETING:
Trimdek sheeting 0.42 Bmt, Colorbond 'Surfmist' finish TBC
INSULATED PANEL - WALL:
PIR (or approved equivalent)
Colorbond 'Surfmist' finish - TBC
Rib / Rib
0.6 Facings
INSULATED PANEL - CEILING:
PIR (or approved equivalent)
Colorbond 'Surfmist' finish - TBC
Rib / Rib
0.6 Facings
NOTE:
• All sheeting to be vermin proof
• Allow for compressible foam filler at top & bottom of fascias
• All fascias to have Colorbond drip mould

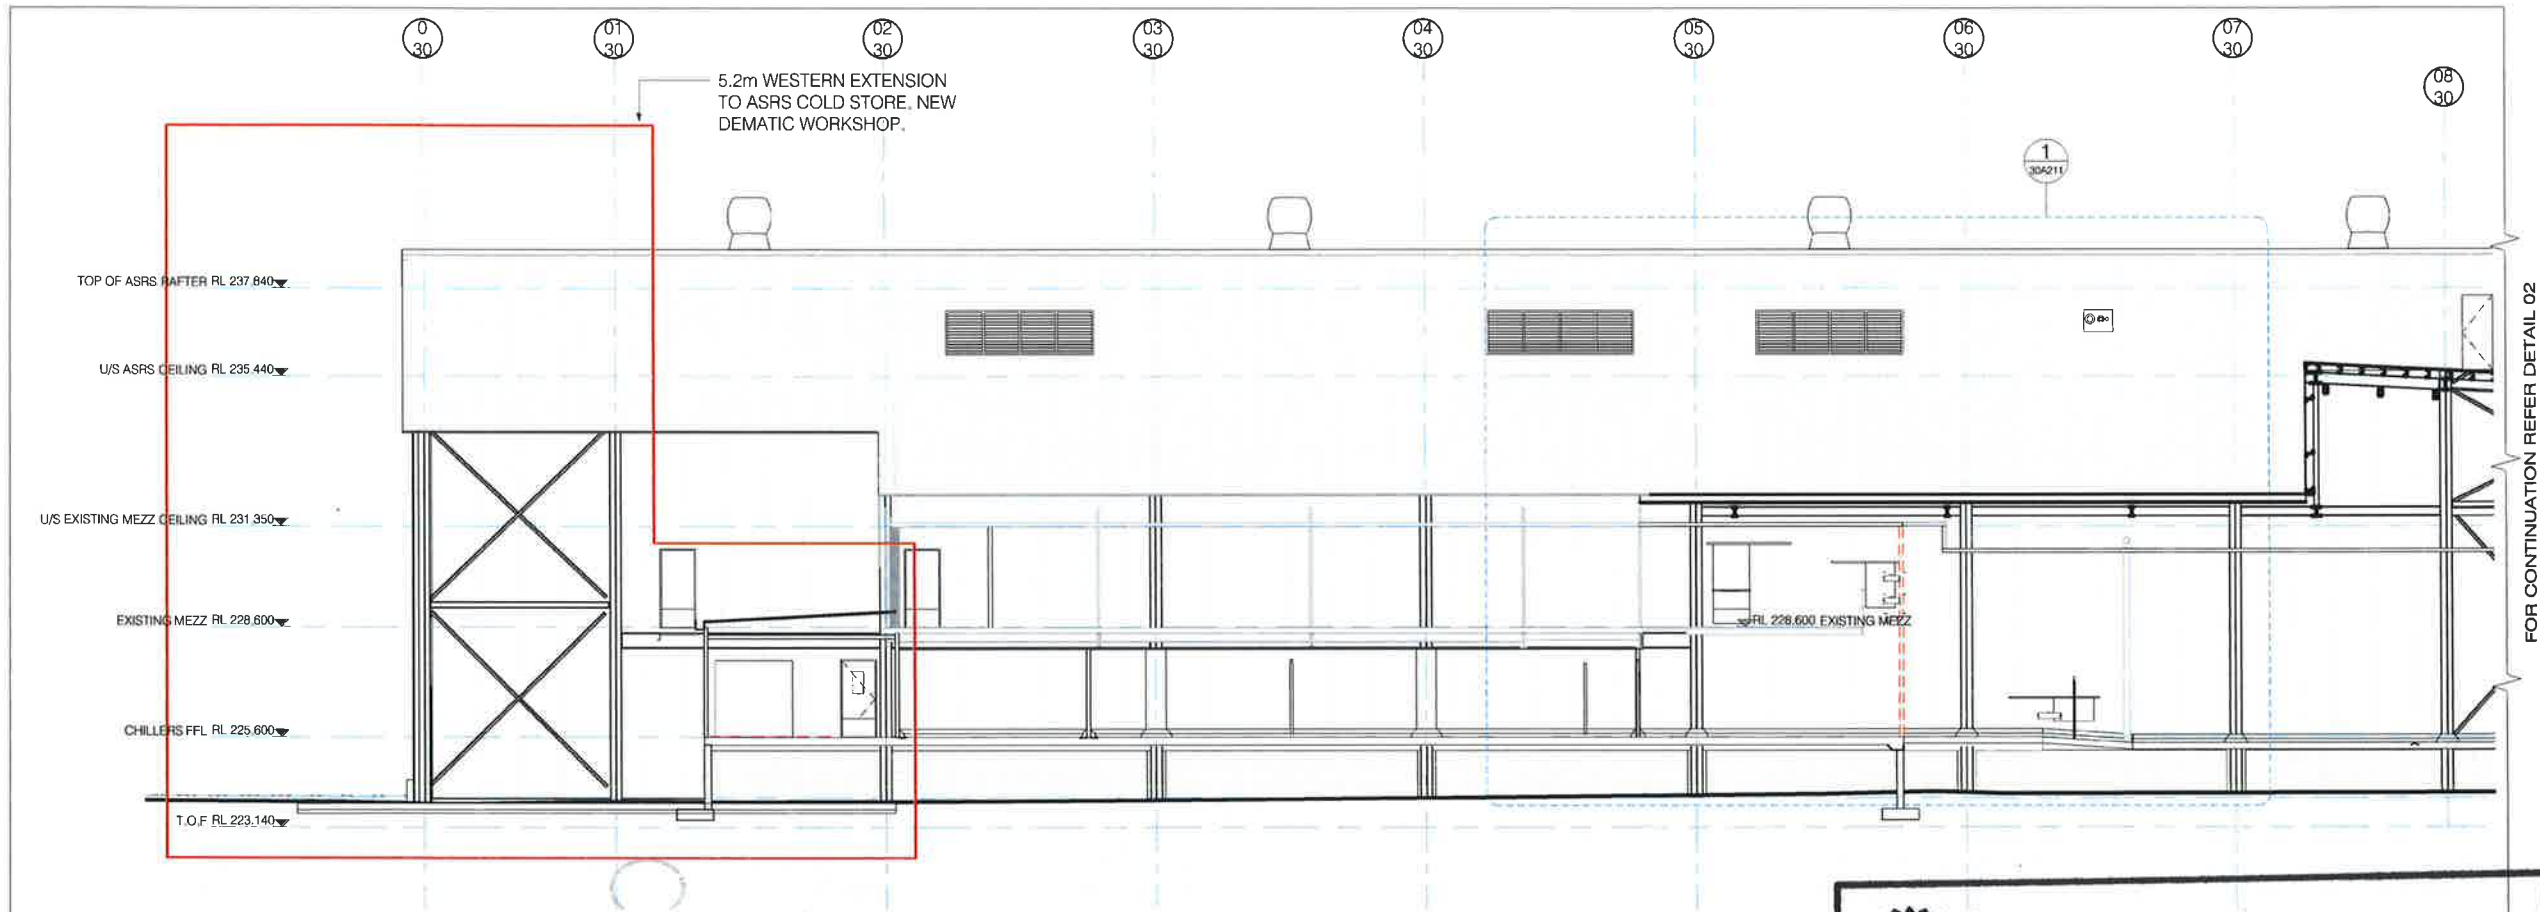

01 SOUTH ELEVATION - WEST END
A1 = 1 : 100

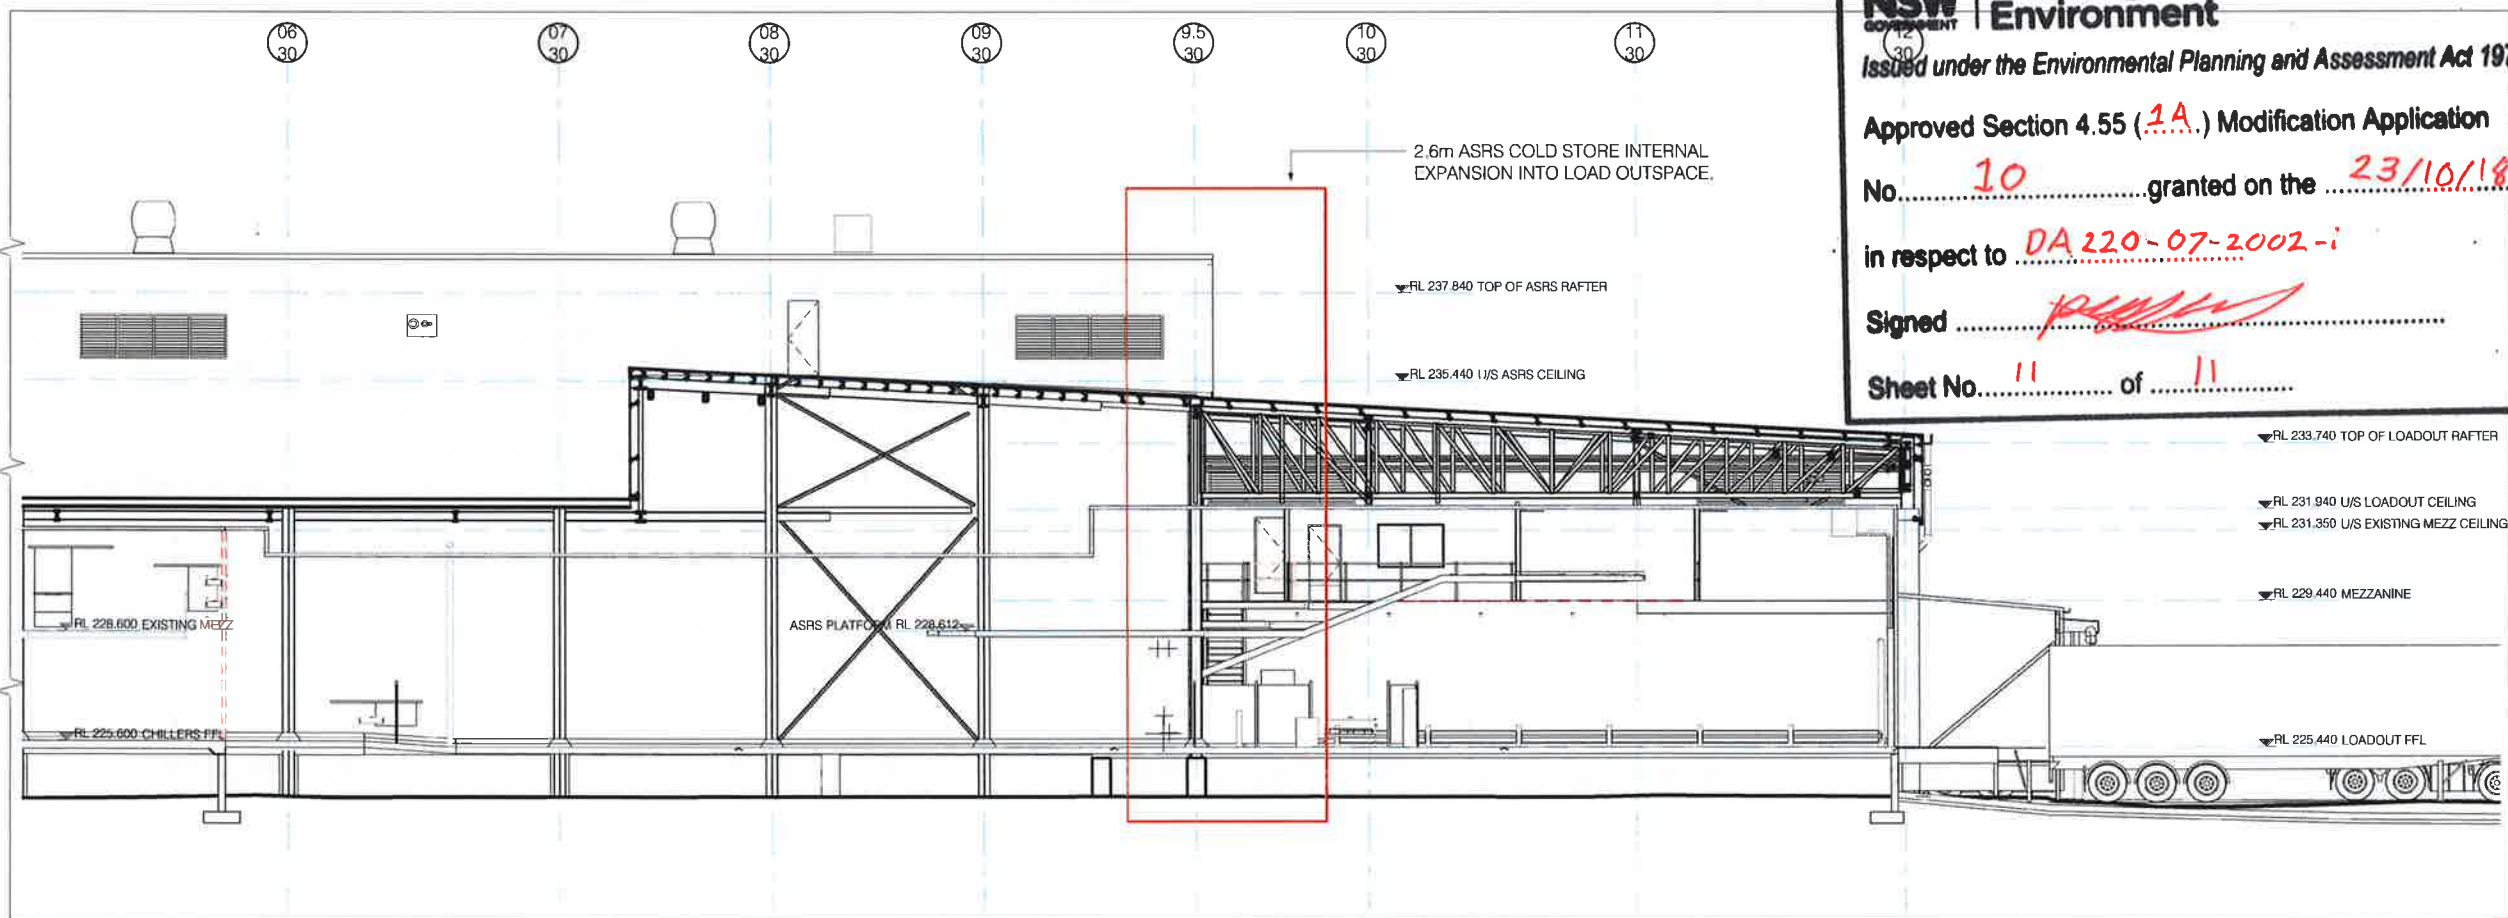

02 SOUTH ELEVATION - EAST END
A1 = 1 : 100

NSW GOVERNMENT | **Planning & Environment**
Issued under the Environmental Planning and Assessment Act 1979
Approved Section 4.55 (.1A.) Modification Application
No. **10** granted on the **23/10/18**
in respect to **DA 220-07-2002-i**
Signed **[Signature]**
Sheet No. **11** of **11**

03/09/18	4	ISSUE FOR DA MOD	DT
21/08/18	3	ISSUE FOR CLIENT APPROVAL	DT
20/08/18	2	FRONT BUILDING, REAR EXTENSION AND BLD 34 REDESIGN	DT
30/07/18	1	INITIAL ISSUE	DT
Date	Issue	Amendment	Init

WILEY & CO PTY LTD
www.wiley.com.au
connect@wiley.com.au
1300 385 986

Project **TEYS AUSTRALIA - STAGE 2 COLD MEAT PROJECT WAGGA WAGGA, NSW**
Drawing Title **ELEVATIONS-SHEET 3 OF 3**

Scale A1 = 1:100 (A4 = 1:200) 0 1000 2000
Drawn DT Date JUN 2018
Project No. W21206 Bldg No. 30
Drawing No. Issue
30A203 - 4
PRELIMINARY

Plot Date: 3/09/2018 3:24:50 PM

Cad File No.: D:\My Documents\DW21206-30-Arch_ben.mckay@wiley.com.au.rvt

ADVICE ♦ DESIGN ♦ ENGINEERING ♦ CONSTRUCTION