

Consultant Advice



**Norman
Disney &
Young**
A TETRA TECH COMPANY

From: Ashwin Muralidharan **Date:** 17 Jul. 19 **File No:** S25504\148\H-421\ca190717s0010 **Pages:** 2
Project: Qantas Flight Training & Simulator Centre (Tender No. 9760) **No:** H-003[1.0]

	Attention	Company	Email
To:	Michael Terrett	APP Corporation Pty Limited	michael.terrett@app.com.au
	Charlie Westgarth	Qantas Airways Limited	charlie.westgarth@qantas.com.au
cc:	Alan Edler	Norman Disney & Young	a.edler@ndy.com
	Michael Lewis	Norman Disney & Young	m.lewis@ndy.com

Hydraulics – Water Supply Reticulation

This CAN is being issued in relation to the new 150mm water supply pipework route to the proposed Qantas Flight Training Centre and Car Park Building in response to ARTC comments received during the public exhibition of the SSD 10154 for the development of a new flight training centre at 297 King Street, Mascot. This CAN shall be read in conjunction with NDY SEARs Infrastructure Report G-006_ca190130s0001 [Rev 3.0].

Proposed Water Supply Reticulation Design:

To meet the potable water and fire services water supply demand for the proposed Qantas Flight Training Centre and Car Park Building a new 150mm galvanised mild steel water main will be installed. The proposed new 150mm water main will be:

1. Connected into the existing 250mm in-ground private water supply at the corner of the Qantas Service Road;
2. The inground pipework will be extended from the point of connection and rise above ground adjacent to the nature strip inside the Qantas boundary fence;
3. 150mm GMS pipework reticulates above ground wholly within Qantas land between the boundary fence and the trees.
4. Bollard protection will be provided as required to prevent mechanical damage to the above ground pipework.

Please see the 3 attached sketches (SKH-010A, b and C) identifying the above items 1-3.

Justification of Current Design:

During the detailed design process, options were explored to reticulate the water supply to the proposed building. The basis for the proposed water reticulation strategy was mainly due to the following constraints:

1. Soil Contamination Issues: Inground reticulation of the 150mm water supply within the access road leading to the proposed car park building. This option was considered at length but could not be pursued due to the existing soil contamination in the area.;



2. Ownership of Access Road: Reticulation of the water supply below ground under the current access road outside the Qantas fence leading to the proposed Qantas Flight Training Centre Building was assessed as a secondary option. Due to land ownership issues this option was not considered.

Protection of above ground pipework:

The above ground pipework is to be proposed to be protected using the measures listed below. The measures prescribed below are in addition to provide protection to the pipework from mechanical damage and are recommended to address the concerns raised by ARTC with regards to water damage / spill over into the rail corridor.

In our understanding the primary risk associated with water spillage into the rail corridor is mainly from damage / rupture to the above ground pipework in the event of mechanical damage to the pipework from vehicular traffic in the area.

1. An existing continuous metal crash barrier will protect the pipework along the southern end outside the Qantas fence line and adjacent to the access road leading into the proposed Qantas Flight Training Centre.
2. A new continuous metal crash barrier is proposed along the northern end of the above ground pipework adjacent to the access road leading into catering building loading dock and proposed carpark building.
3. Provision of a new continuous concrete culvert over the new pipework.
4. Provision of an above ground isolation for ease of access to shut down supply in the event of pipe damage. This arrangement will be implemented in conjunction with the measures listed above.

Please feel free to contact me if you have any questions.


NORMAN DISNEY & YOUNG

Ashwin Muralidharan
Senior Project Engineer
a.muralidharan@ndy.com

ATTACHMENTS

SKETCHES:

- SKH-010A - PROPOSED WATER SUPPLY ROUTE - OVERALL SITE PLAN
- SKH-010B - PROPOSED WATER SUPPLY ROUTE – SURVEY PLAN – SHEET 1 OF 2
- SKH-010C - PROPOSED WATER SUPPLY ROUTE – SURVEY PLAN – SHEET 2 OF 2

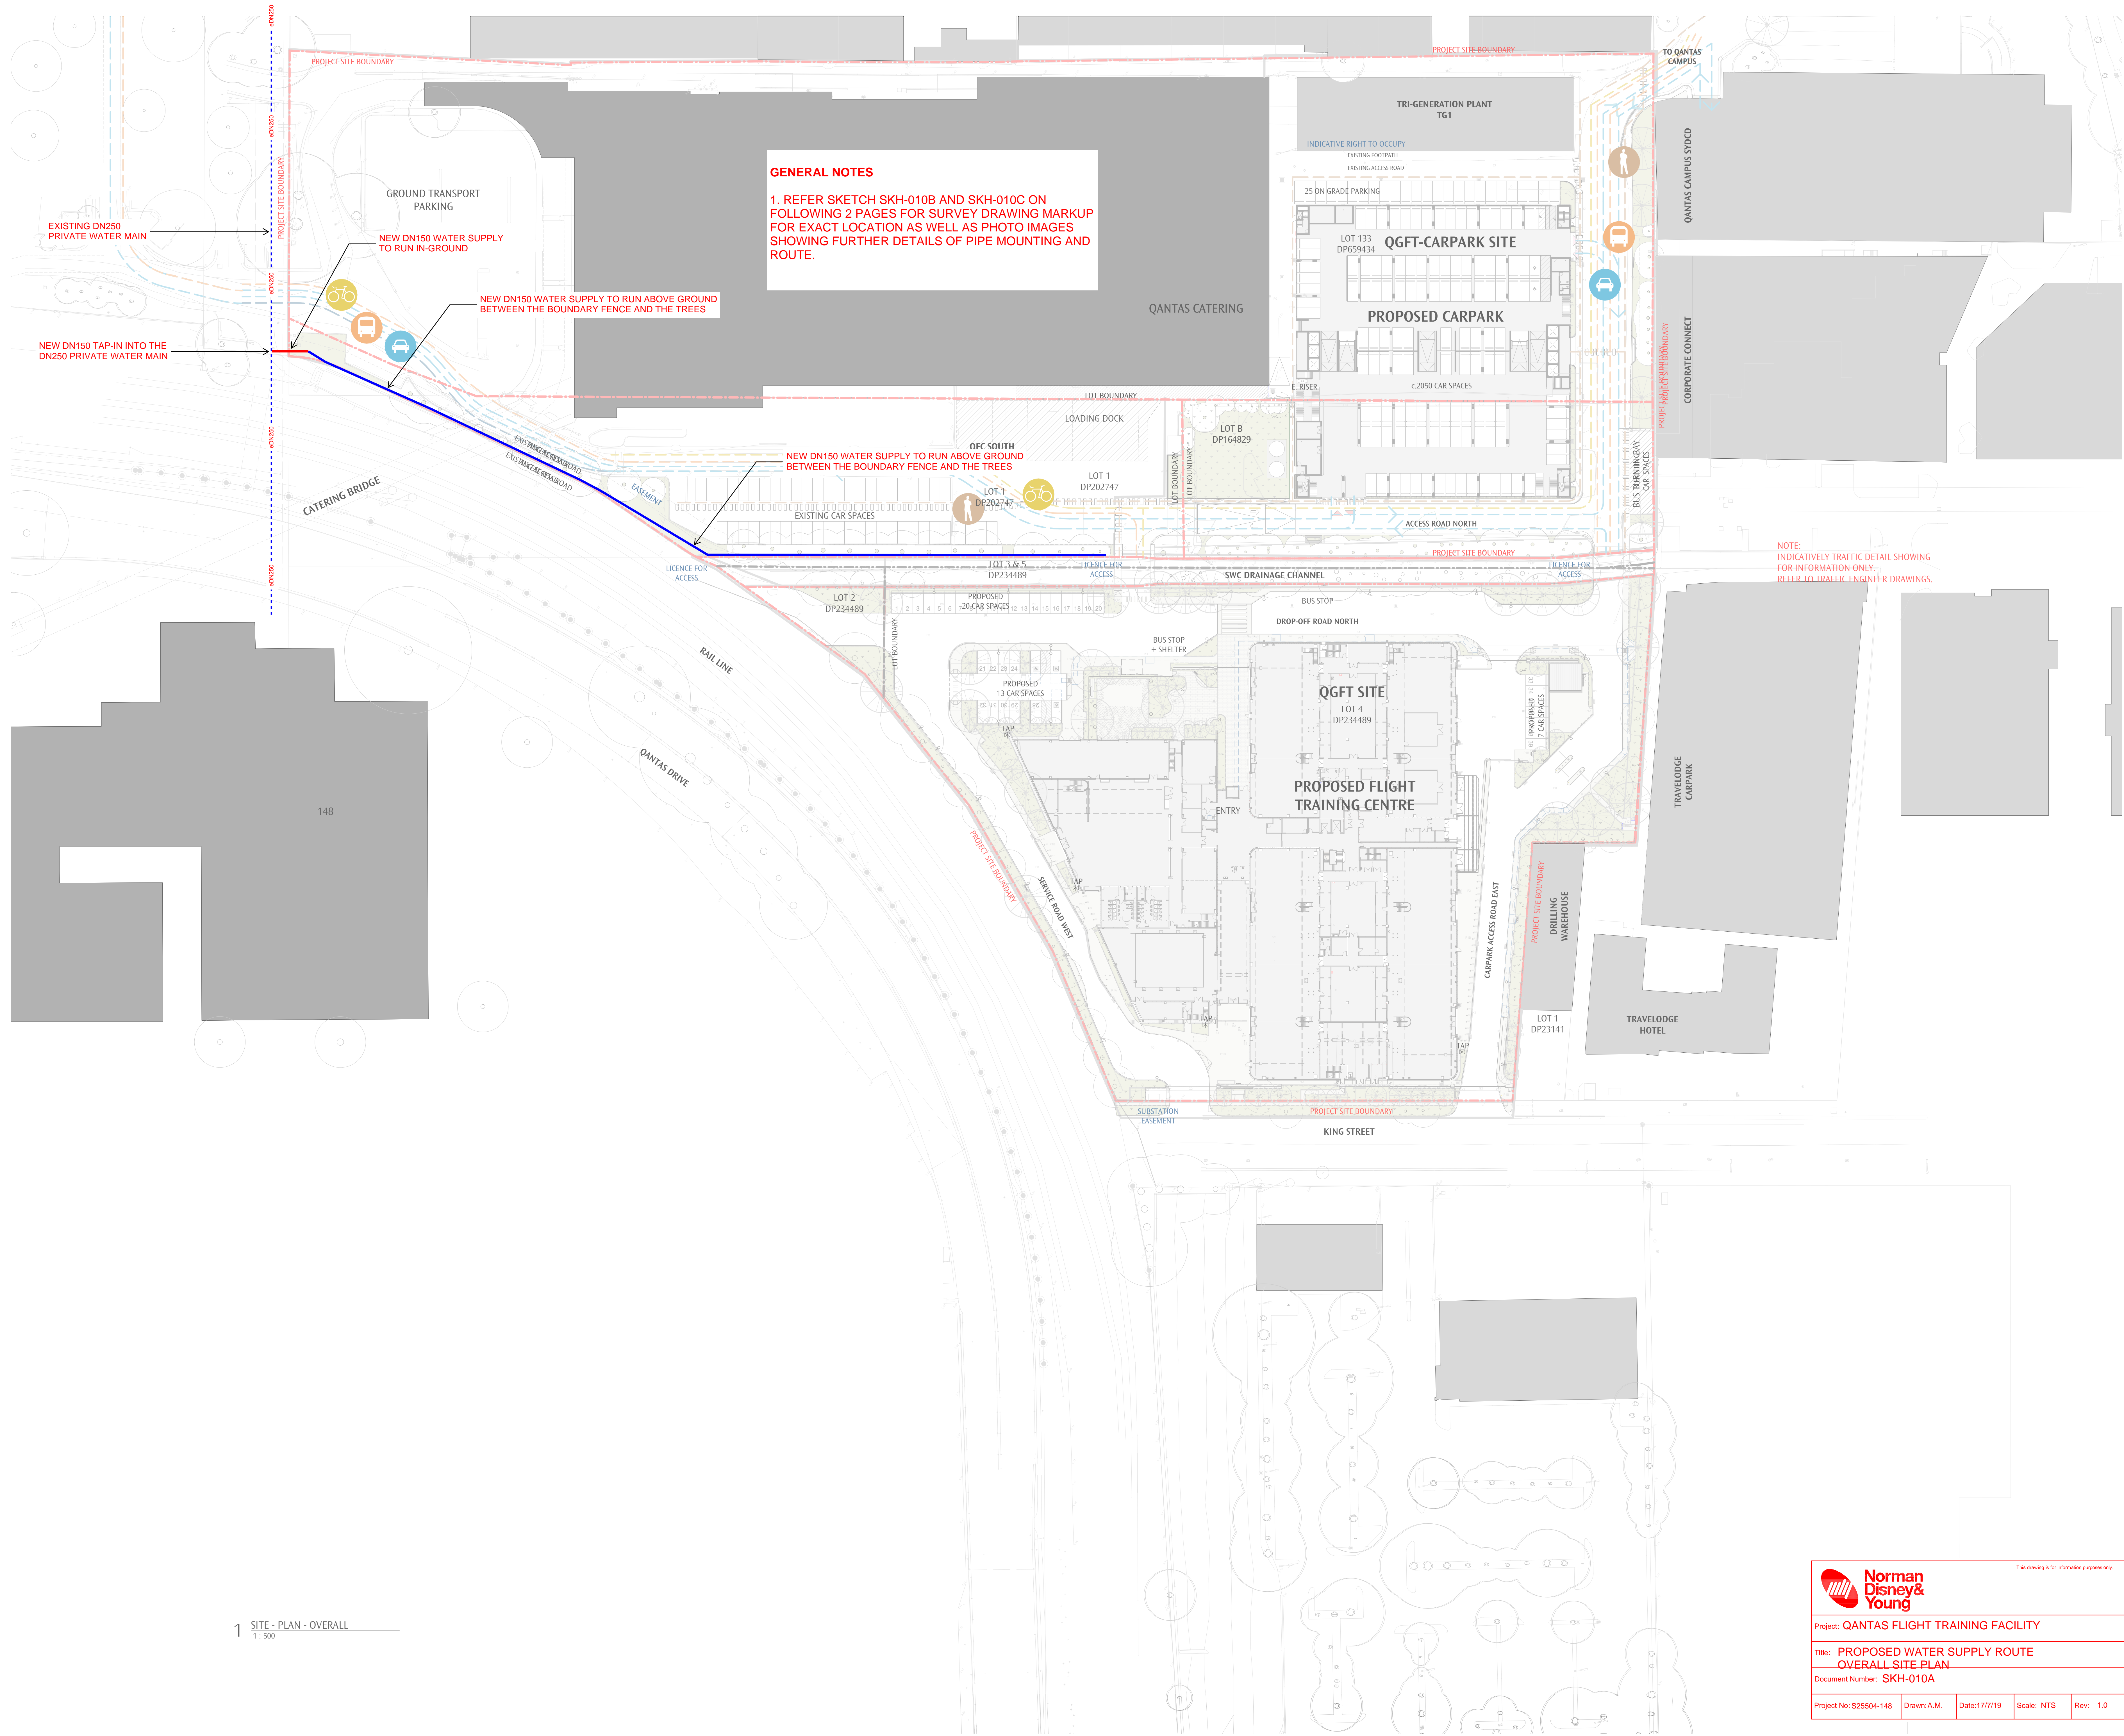



GENERAL NOTES

1. REFER SKETCH SKH-010B AND SKH-010C ON FOLLOWING 2 PAGES FOR SURVEY DRAWING MARKUP FOR EXACT LOCATION AS WELL AS PHOTO IMAGES SHOWING FURTHER DETAILS OF PIPE MOUNTING AND ROUTE.

NOTE:
INDICATIVELY TRAFFIC DETAIL SHOWING
FOR INFORMATION ONLY.
REFER TO TRAFFIC ENGINEER DRAWINGS.

DO NOT SCALE OFF THIS DRAWING. USE FIGURED DIMENSIONS ONLY. VERIFY ALL DIMENSIONS ON SITE. ANY DISCREPANCIES SHALL BE BROUGHT TO THE ATTENTION OF THE ARCHITECT.

PRELIMINARY
NOT FOR CONSTRUCTION

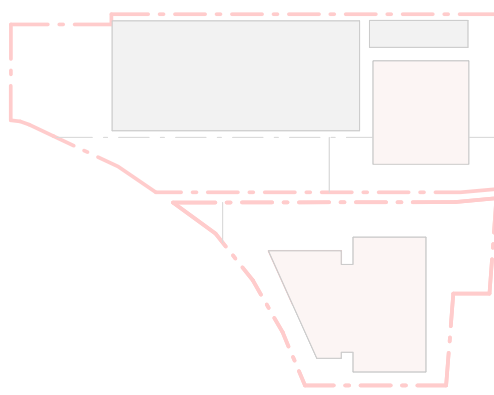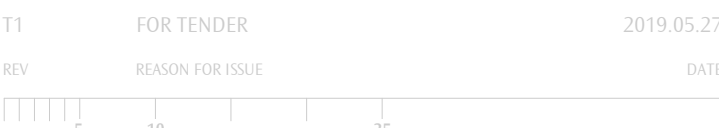

SCHEDULES LEGEND

SUPPLIER	CATEGORY	ELEMENT	ITEM	TYPE
GROUP 1: SING	D. DEMOGRAPH	FL. FLOOR	G1	EL-IT
GROUP 2: SING	M. MATERIALS	CE. CEILING	C1	EL-IT
GROUP 3: SING	C. CONSTRUCTION	ME. MECH	M1	EL-IT
GROUP 4: SING	F. FITTINGS	EL. ELECT	E1	EL-IT
GROUP 5: SING	L. LANDSCAPE	PL. PLANT	P1	EL-IT
GROUP 6: SING	S. SERVICES	SW. SWIT	S1	EL-IT

noxongiffen

Sydney - Nominated Architect Darren Giffen ARB NSW #1274
Melbourne - Nominated Architect Justin Norman ARB VIC #6277
ABN 54 109 252 360 | www.noxongiffen.com
T 61 2 9262 9066 | sydney@noxongiffen.com
T 61 3 9630 5889 | melbourne@noxongiffen.com





QANTAS

QANTAS GROUP FLIGHT
TRAINING CENTRE
297 KING STREET MASCOY

SITE - PLAN - OVERALL -
PROPOSED

Project: QANTAS FLIGHT TRAINING FACILITY				
Title: PROPOSED WATER SUPPLY ROUTE OVERALL SITE PLAN				
Document Number: SKH-010A				
Project No: S25504-148	Drawn: A.M.	Date: 17/7/19	Scale: NTS	Rev: 1.0

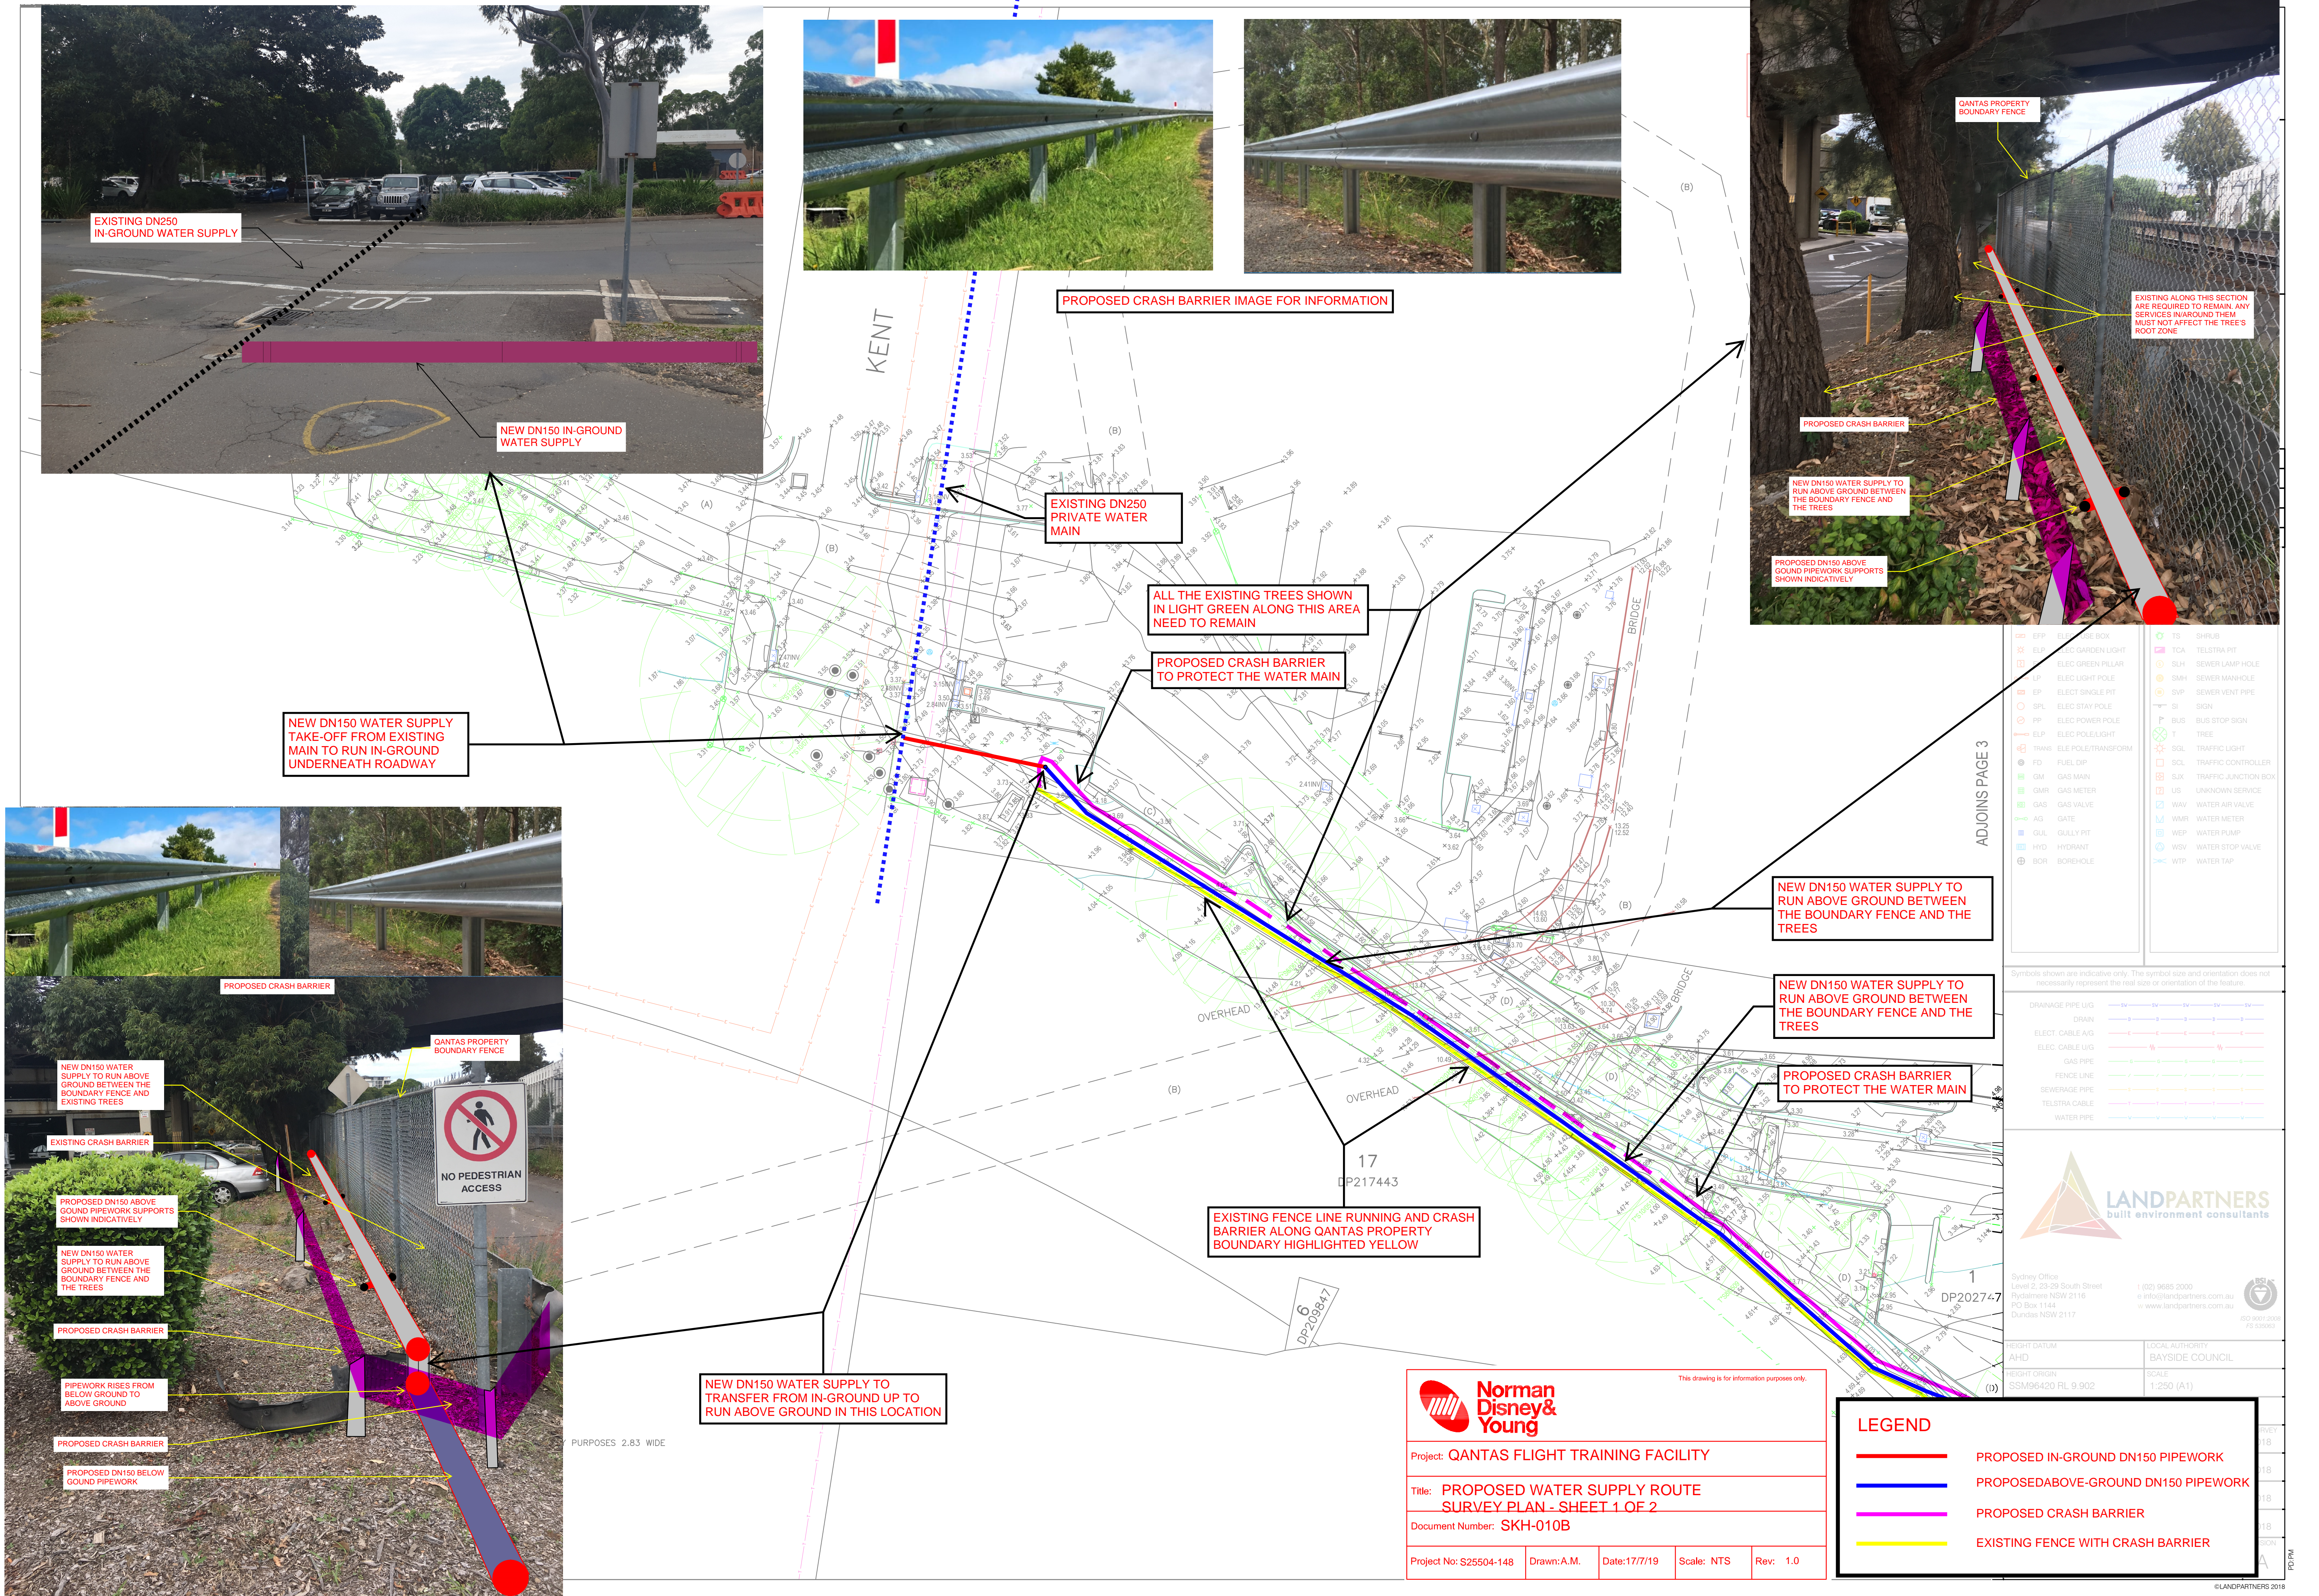

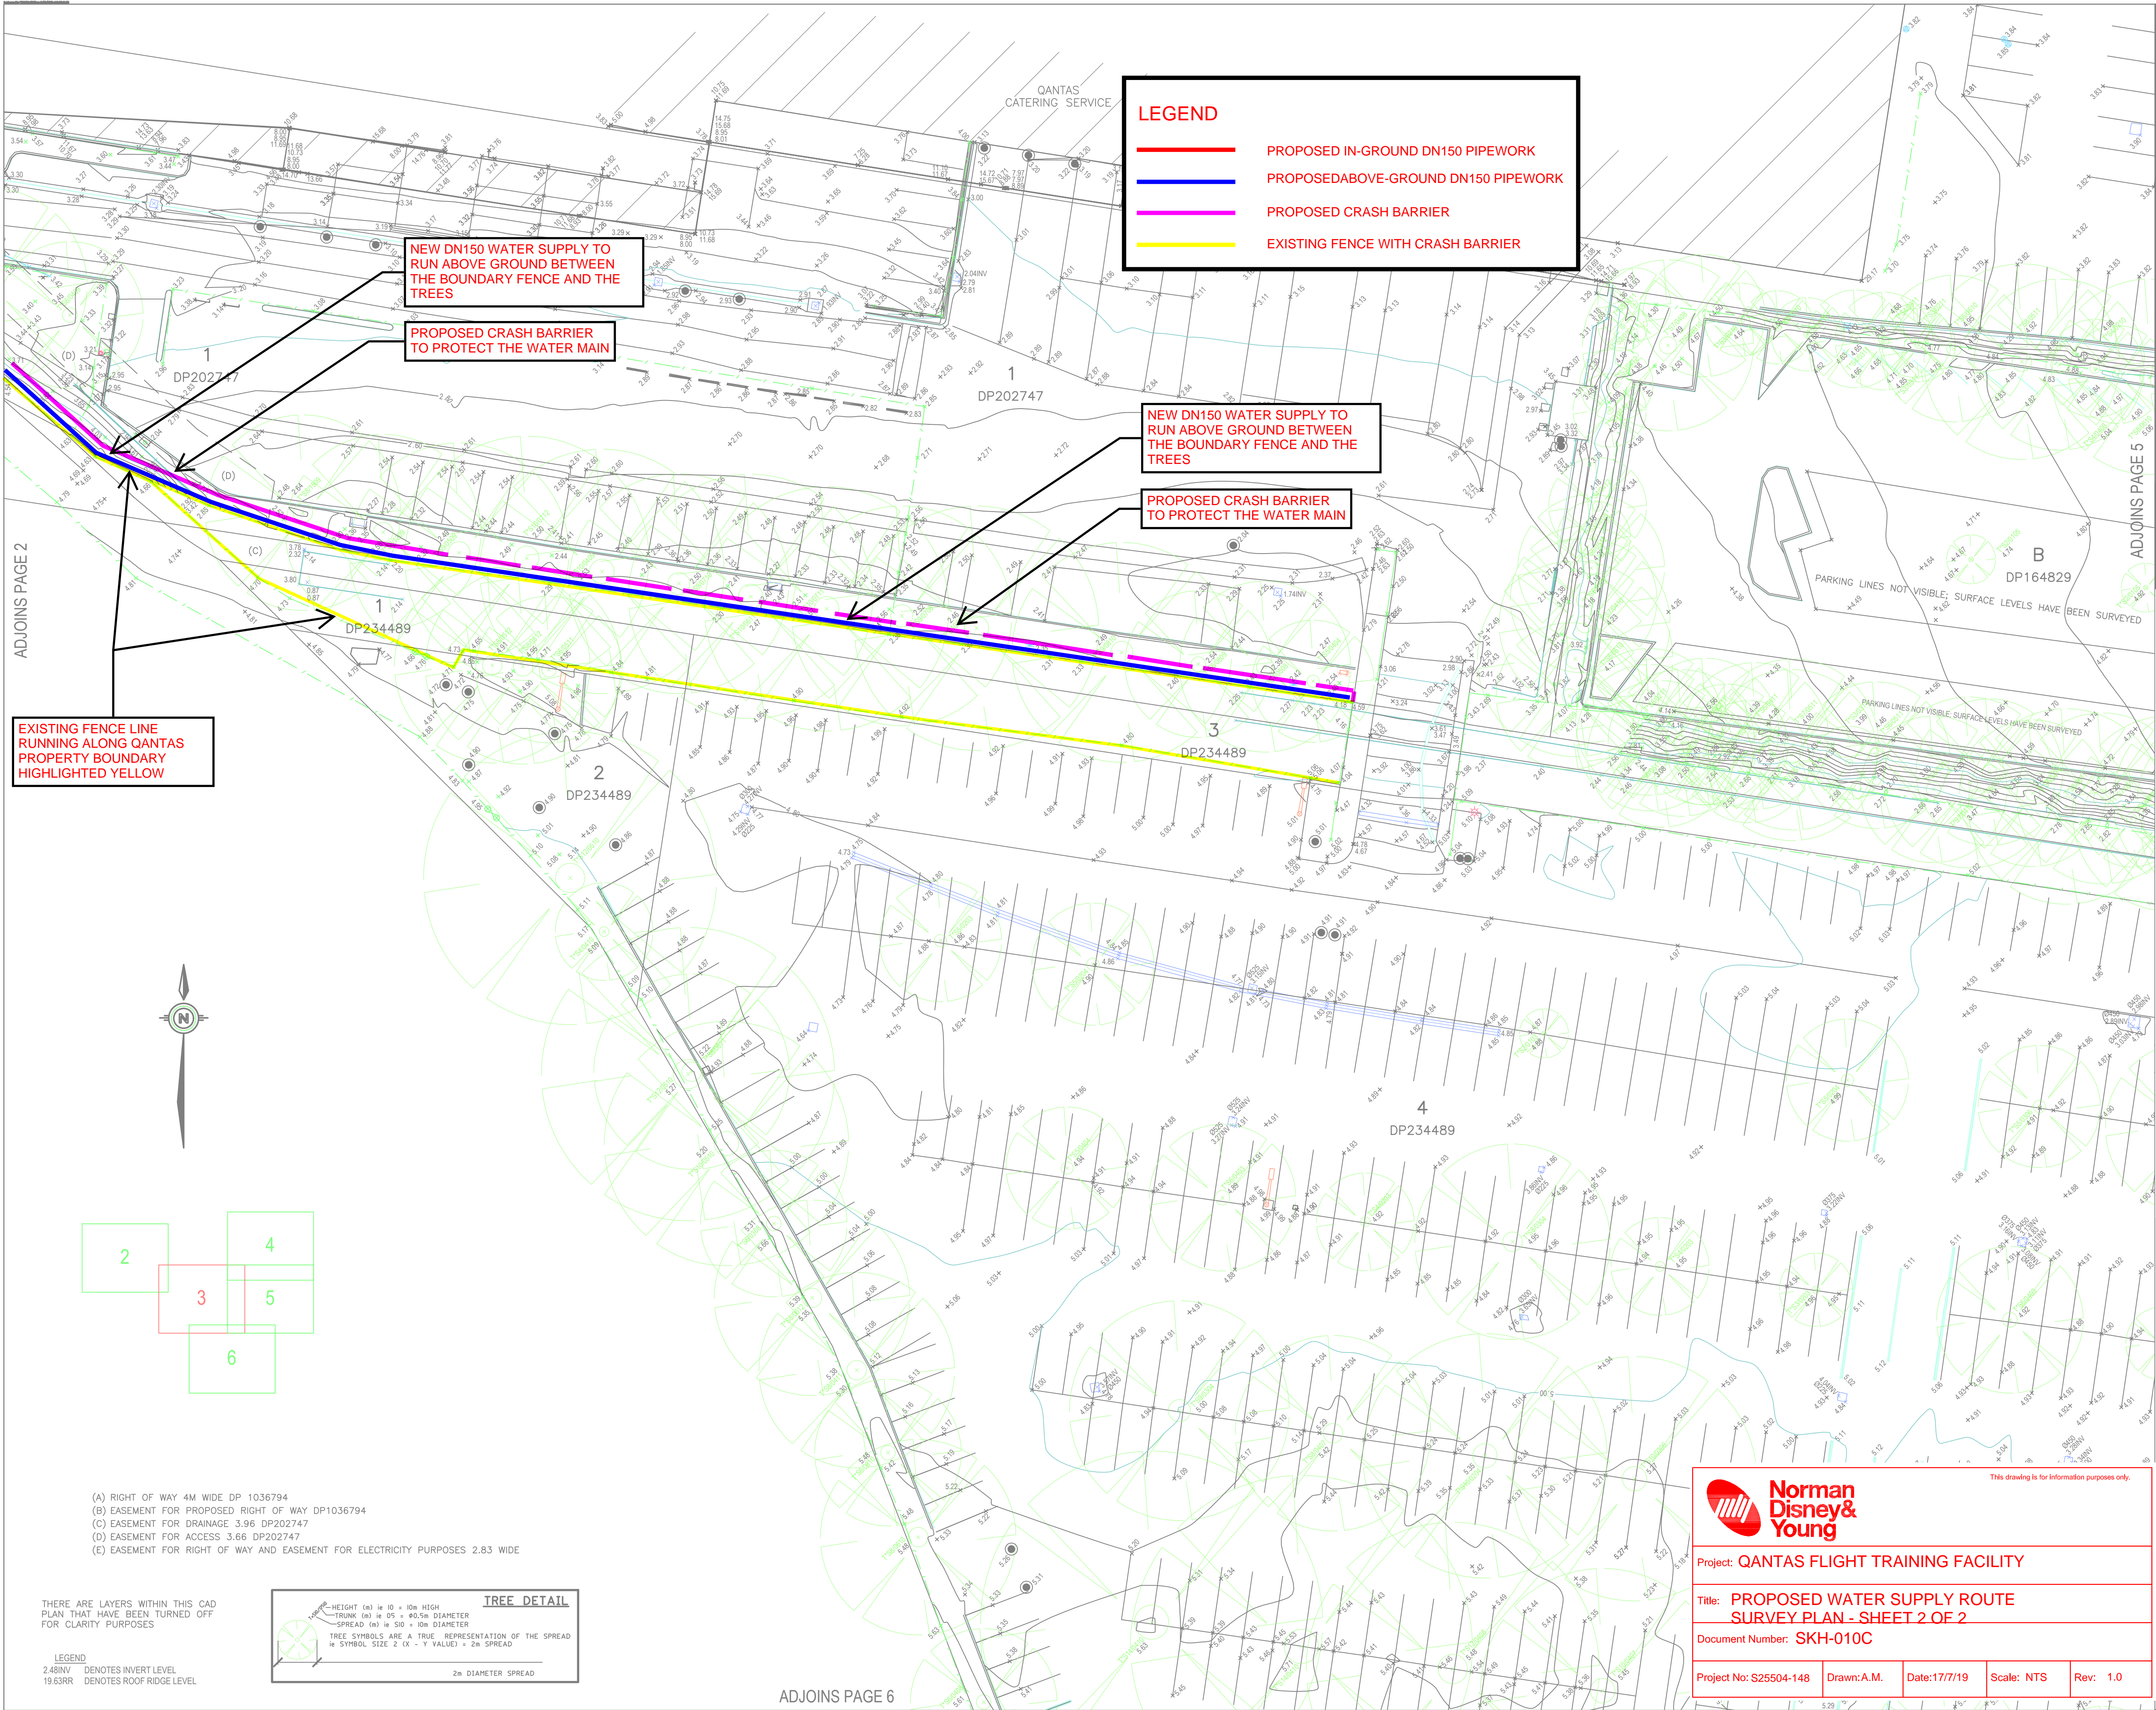

CLIENT

QANTAS

PROJECT

DETAIL SURVEY
OF
QANTAS CATERING
FACILITY CARPARK AREA

NOTES

The title boundaries shown hereon were not marked at the time of survey and have been determined by plan dimensions only and not by field survey.
Services shown hereon have been located where possible by field survey. If not able to be so located, services have been plotted from the records of relevant authorities where available and have been noted accordingly on the plan. Where such records do not exist or are inadequate a notation has been made hereon.
Prior to any demolition, excavation or construction on the site, the relevant authority should be contacted for possible location of further underground services and detailed locations of all services.

A	GKO	03/10/2018	CLIENT ISSUE
PPP/CF	LPL	DD/MM/YY	COMMENT



Sydney Office
Level 2, 23-29 South Street
Pyralme NSW 2116
PO Box 1144
Dundas NSW 2117

(02) 9685 2000
e info@landpartners.com.au
w www.landpartners.com.au



BSI
BSI 55993

HEIGHT DATUM
AHD

HEIGHT ORIGIN
SSM96420 RL 9.902

MERIDIAN
ZONE 56

COORD SYSTEM
MGA

LOAD FILE
SY074560.000

AUTOCAD FILE
SY074560

ARCHIVE FILE
SY074560

PLAN NUMBER

LOCAL AUTHORITY
BAYSIDE COUNCIL

SCALE
1:250 (A1)

CONTOUR INTERVAL
0.2 Metre

SURVEYOR
SA

DATE OF SURVEY
26/09/2018

DRAWN
TF

DATE
11/10/2018

CHECKED
GKO

DATE
08/10/2018

APPROVED
GKO

DATE
08/10/2018

SHEET 3 OF 6

REVISION
A



This drawing is for information purposes only.

Project: QANTAS FLIGHT TRAINING FACILITY

Title: PROPOSED WATER SUPPLY ROUTE
SURVEY PLAN - SHEET 2 OF 2

Document Number: SKH-010C

Project No: S25504-148

Drawn:A.M.

Date:17/7/19

Scale: NTS

Rev: 1.0

(A) RIGHT OF WAY 4M WIDE DP 1036794
(B) EASEMENT FOR PROPOSED RIGHT OF WAY DP1036794
(C) EASEMENT FOR DRAINAGE 3.96 DP202747
(D) EASEMENT FOR ACCESS 3.66 DP202747
(E) EASEMENT FOR RIGHT OF WAY AND EASEMENT FOR ELECTRICITY PURPOSES 2.83 WIDE

THERE ARE LAYERS WITHIN THIS CAD PLAN THAT HAVE BEEN TURNED OFF FOR CLARITY PURPOSES

LEGEND
2.48INV DENOTES INVERT LEVEL
19.63RR DENOTES ROOF RIDGE LEVEL

TREE DETAIL



HEIGHT (m) is 10 + 10m HIGH
TRUNK (m) is 0.5 + 0.5m DIAMETER
SPREAD (m) is 5.0 + 10m DIAMETER
TREE SYMBOLS ARE A TRUE REPRESENTATION OF THE SPREAD
SYMBOL SIZE 2 (X - Y VALUE) = 2m SPREAD
2m DIAMETER SPREAD

ADJOINS PAGE 2

ADJOINS PAGE 5

ADJOINS PAGE 6

SY074560.000

©LANDPARTNERS 2018