


Blue lines show continuous flows
Red lines need traffic lights

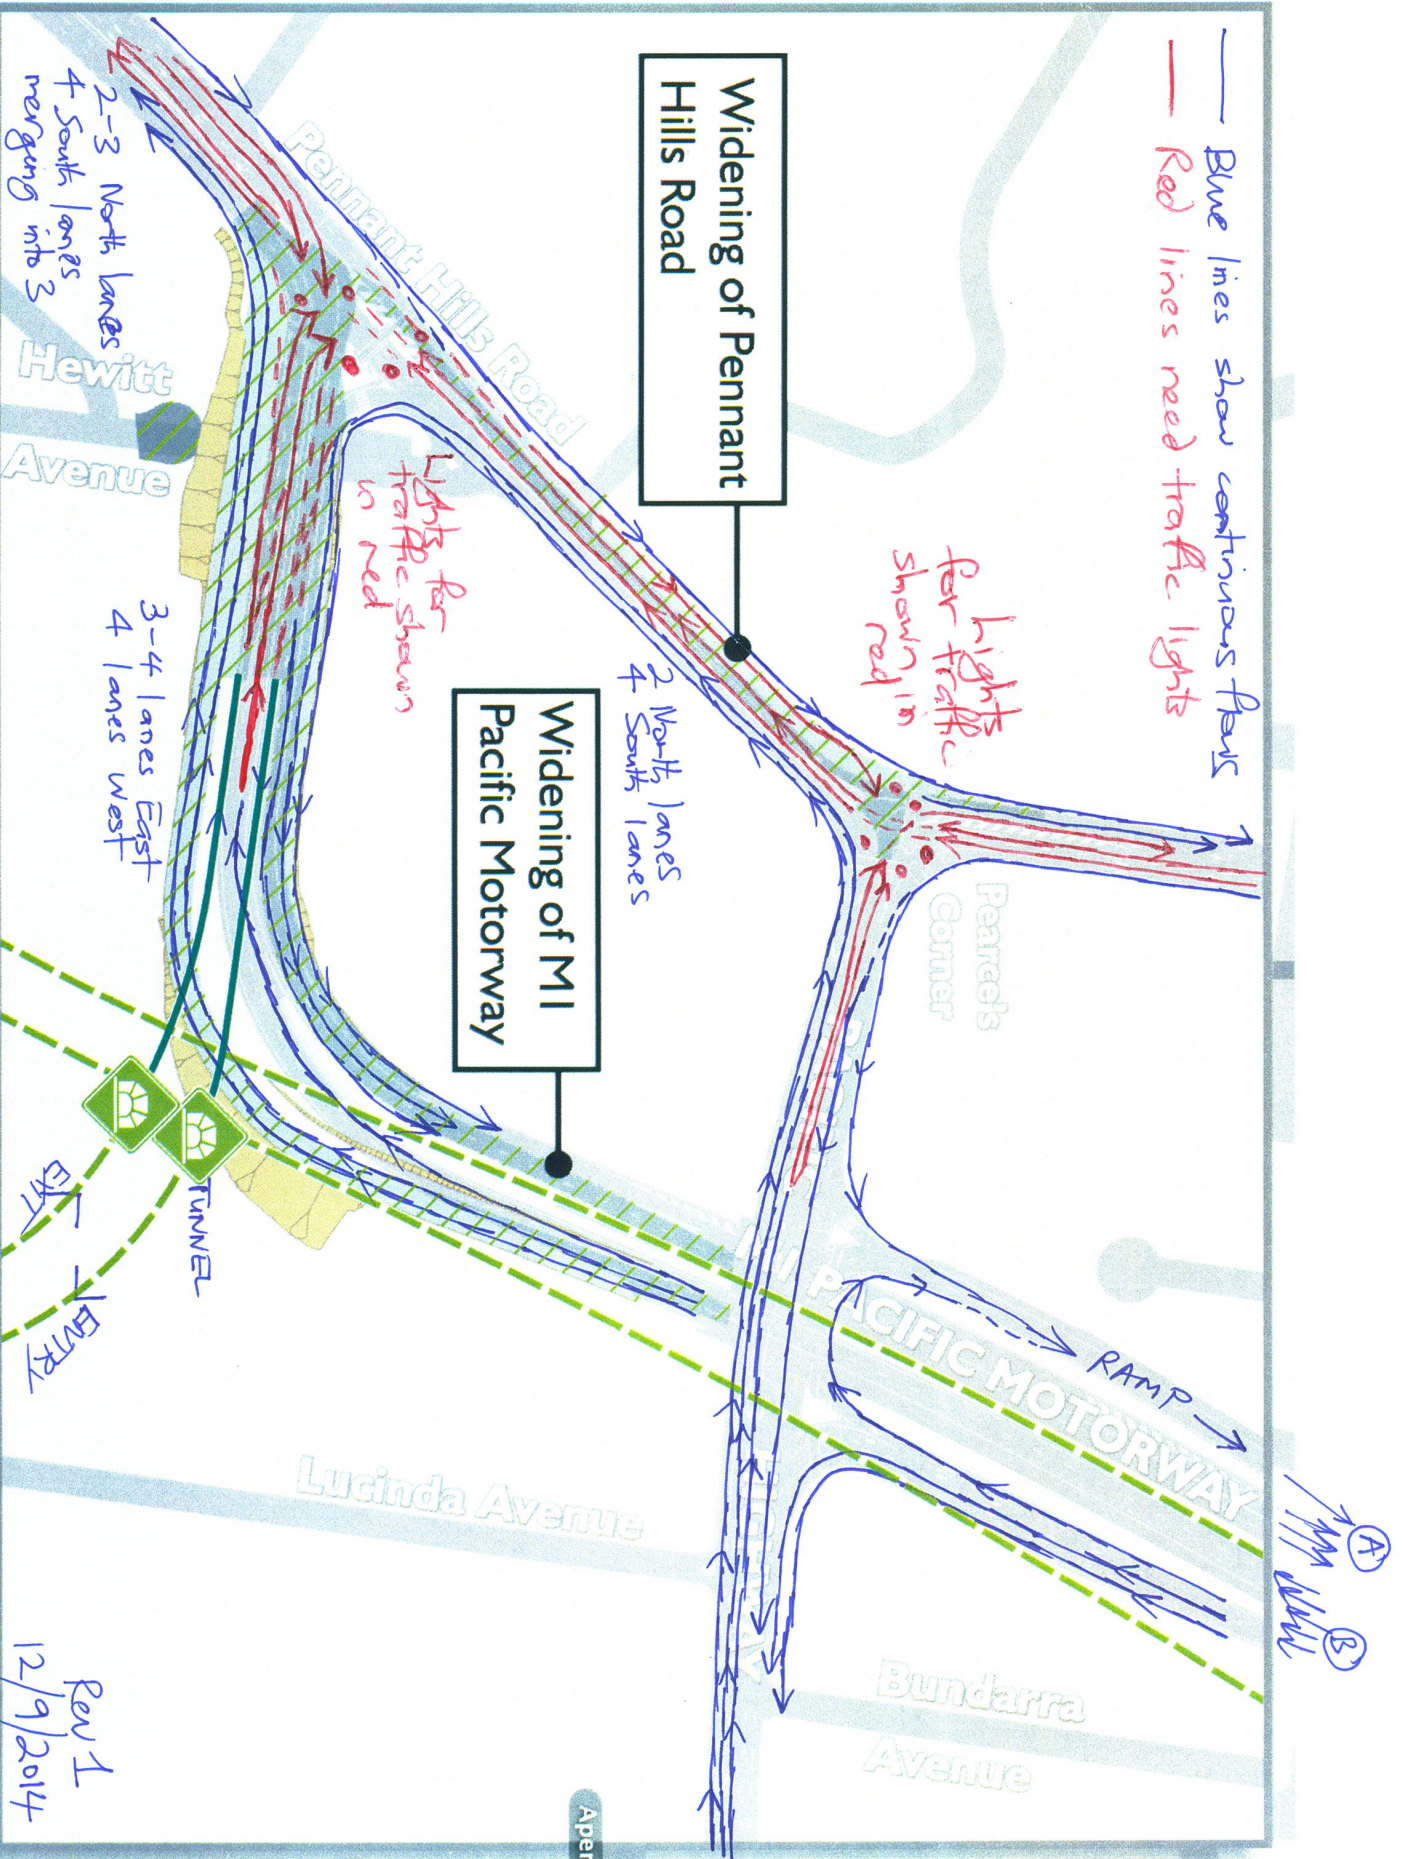

Rev 1
12/9/2014