
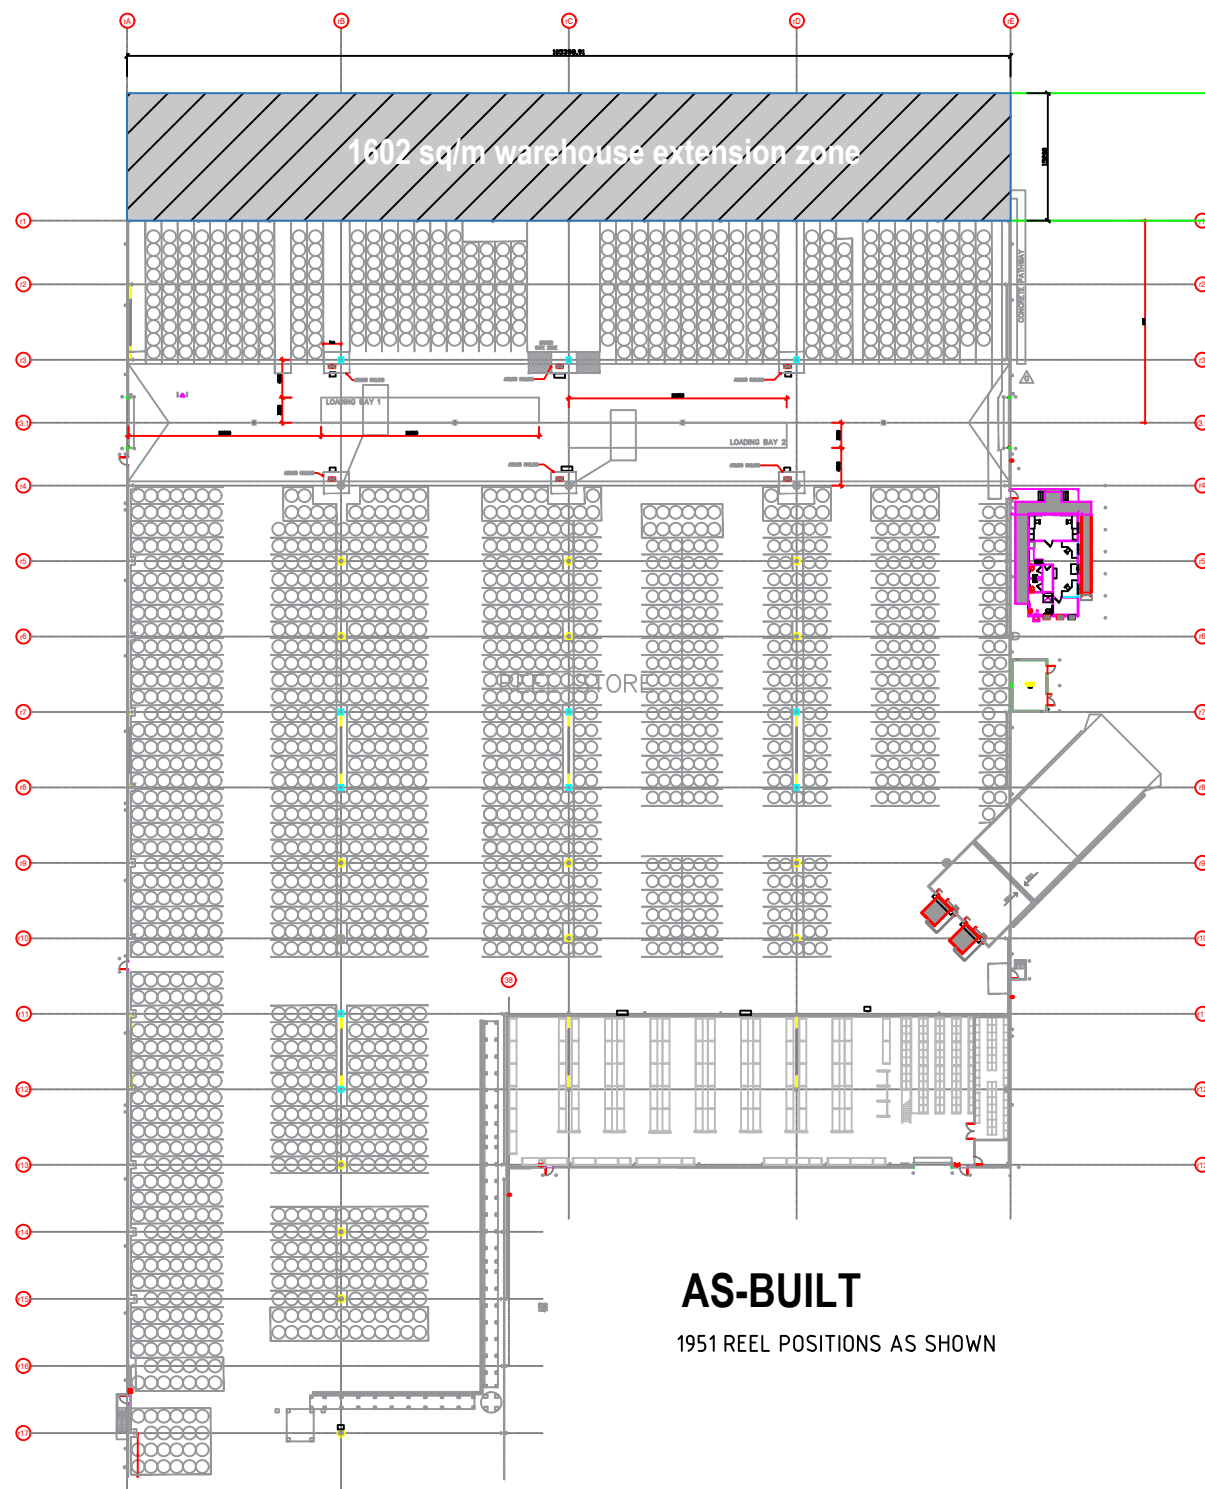


DIMENSIONS IN MILLIMETRES

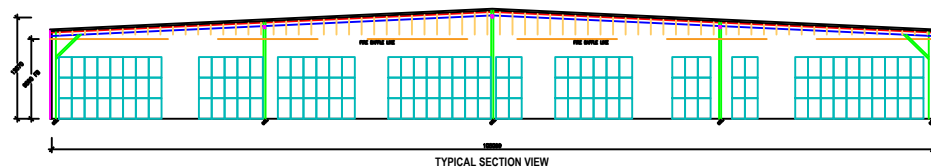


AS-BUILT

1951 REEL POSITIONS AS SHOWN

PRELIMINARY

PROPOSED EXTENSION ARRANGEMENT

Truck exit re-design by
traffic engineer required

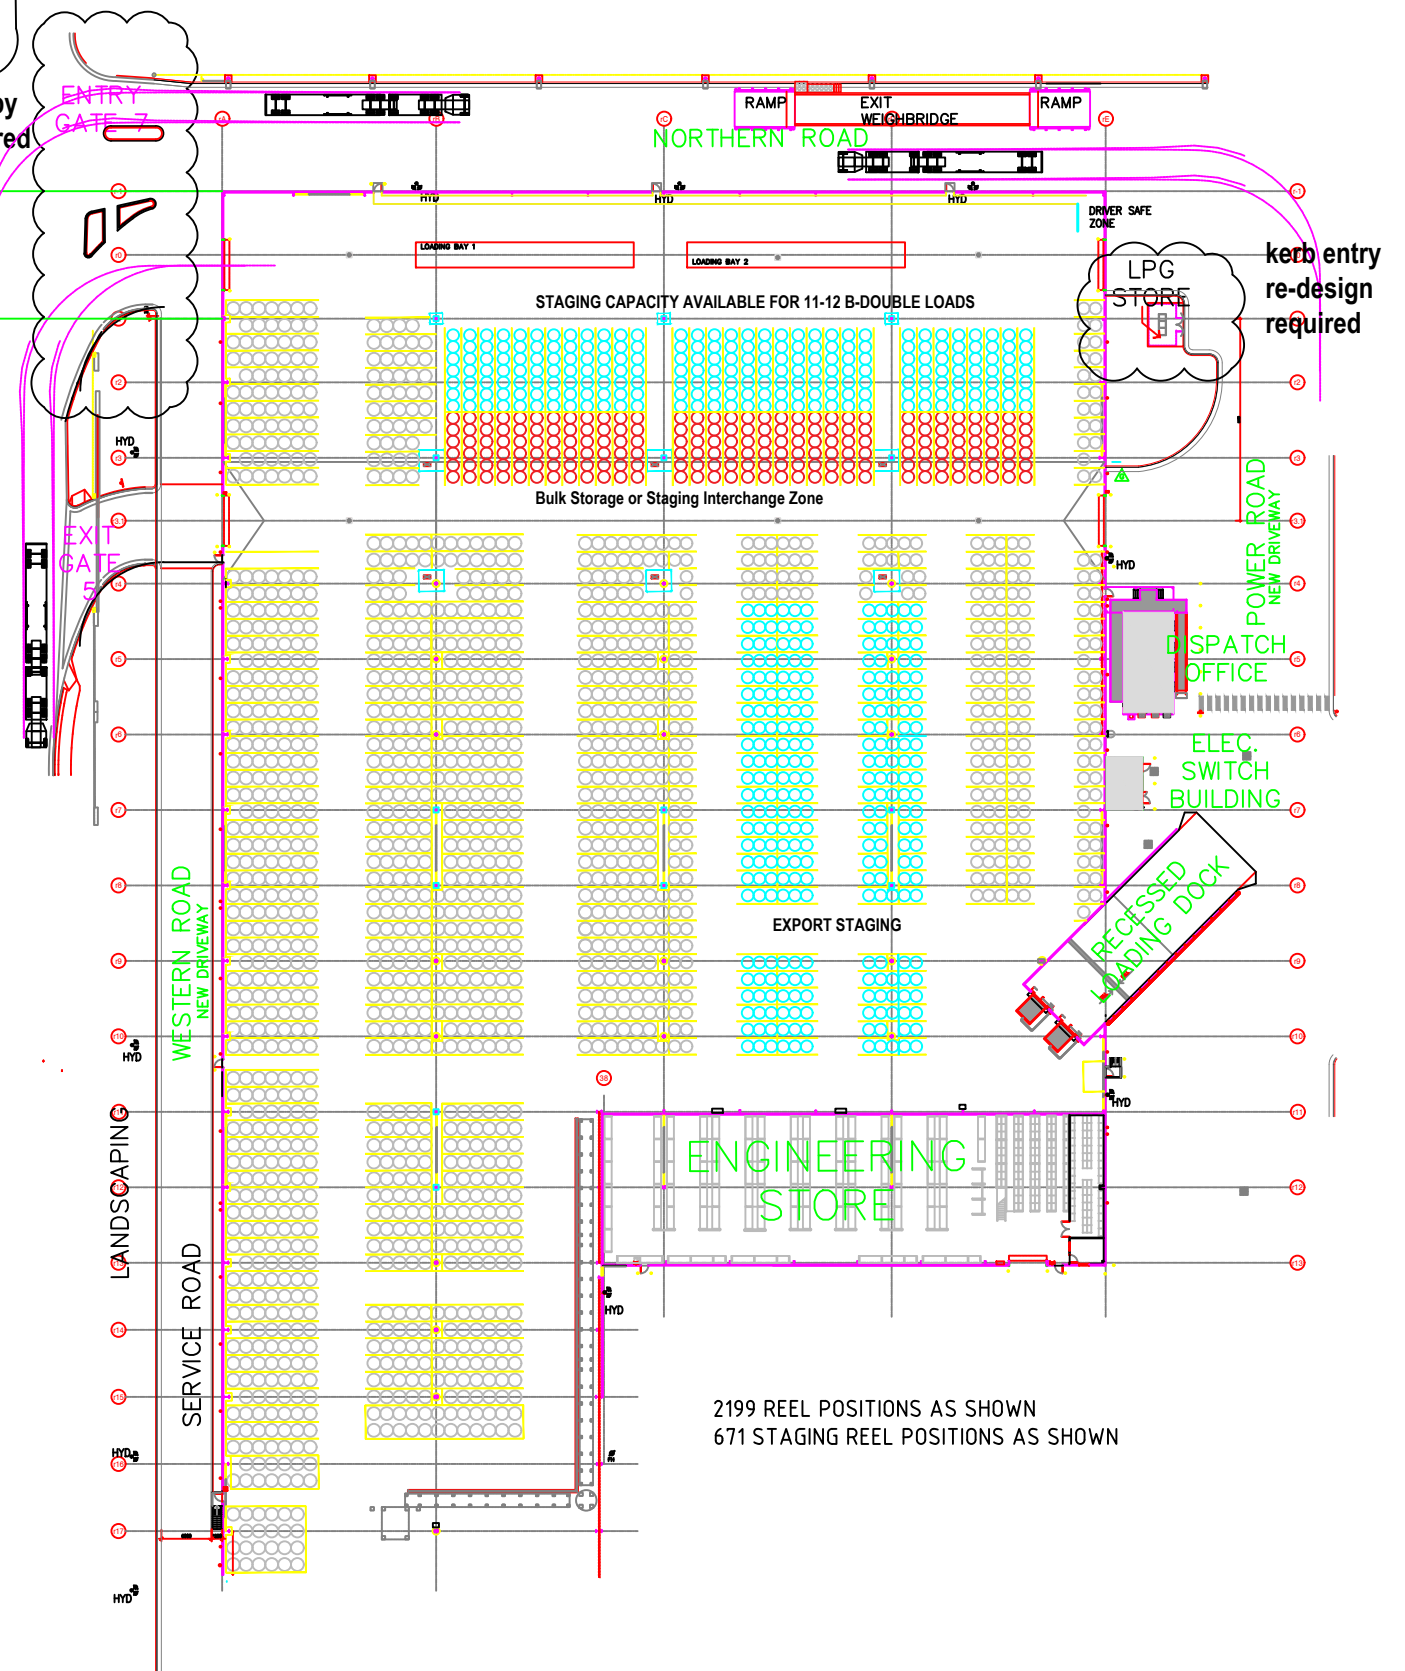

kerb entry
re-design
required

2199 REEL POSITIONS AS SHOWN
671 STAGING REEL POSITIONS AS SHOWN

NOT FOR CONSTRUCTION - DIMENSIONS ARE NOMINAL

SHEET	A3
SCALE	NTS