


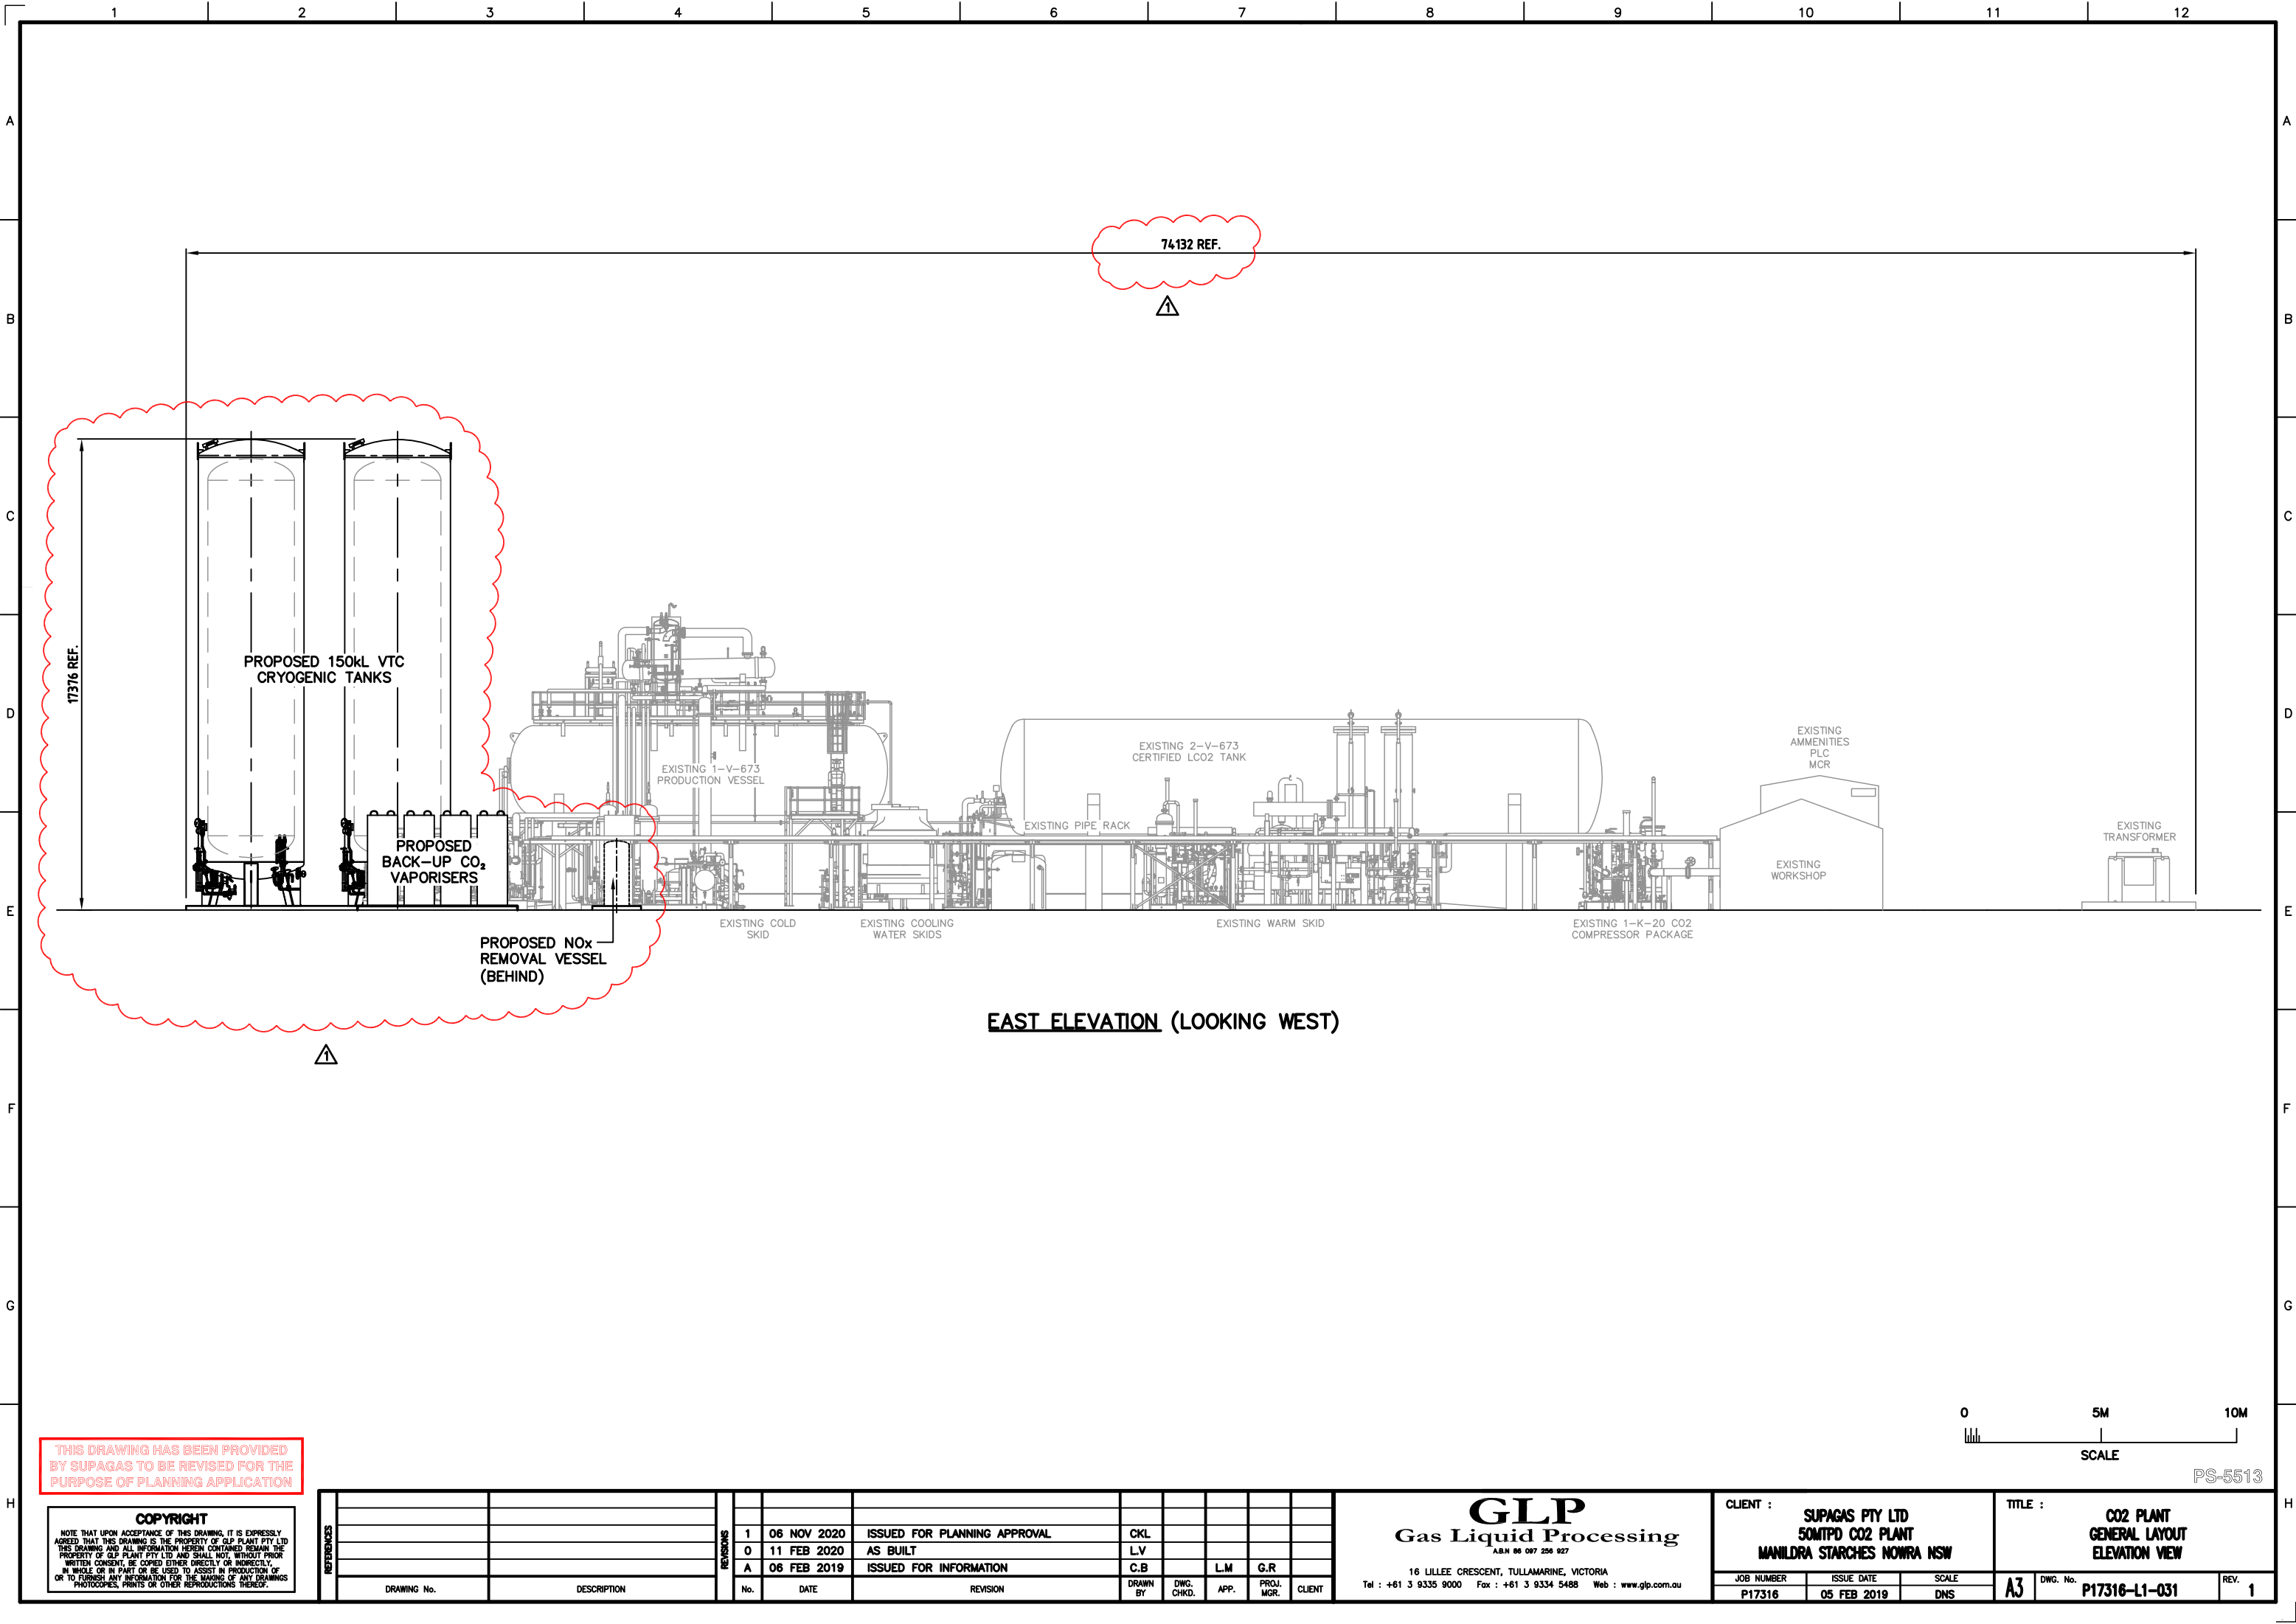

EAST ELEVATION (LOOKING WEST)

THIS DRAWING HAS BEEN PROVIDED BY SUPAGAS TO BE REVISED FOR THE PURPOSE OF PLANNING APPLICATION

COPYRIGHT
NOTE THAT UPON ACCEPTANCE OF THIS DRAWING, IT IS EXPRESSLY AGREED THAT THIS DRAWING IS THE PROPERTY OF GLP PLANT PTY LTD. THIS DRAWING AND ALL INFORMATION HEREIN CONTAINED REMAIN THE PROPERTY OF GLP PLANT PTY LTD AND SHALL NOT, WITHOUT PRIOR WRITTEN CONSENT, BE COPIED EITHER DIRECTLY OR INDIRECTLY, IN WHOLE OR IN PART OR BE USED TO ASSIST IN PRODUCTION OF OR TO FURNISH ANY INFORMATION FOR THE MAKING OF ANY DRAWINGS, PHOTOCOPIES, PRINTS OR OTHER REPRODUCTIONS THEREOF.


REV.	No.	DATE	REVISION	DRAWN BY	DWG. CHKD.	APP.	PROJ. MGR.	CLIENT
1	06 NOV 2020		ISSUED FOR PLANNING APPROVAL	CKL				
0	11 FEB 2020		AS BUILT	LV				
A	06 FEB 2019		ISSUED FOR INFORMATION	C.B		L.M	G.R	

GLP
Gas Liquid Processing
A.B.N 88 097 256 927


16 LILLIE CRESCENT, TULLAMARINE, VICTORIA
Tel : +61 3 9335 9000 Fax : +61 3 9334 5488 Web : www.glp.com.au

CLIENT : SUPAGAS PTY LTD 50MTPD CO2 PLANT MANILDRA STARCHES NOWRA NSW		
JOB NUMBER	ISSUE DATE	SCALE
P17316	05 FEB 2019	DNS

TITLE : CO2 PLANT GENERAL LAYOUT ELEVATION VIEW		
DWG. No.	REV.	
A3 P17316-L1-031	1	

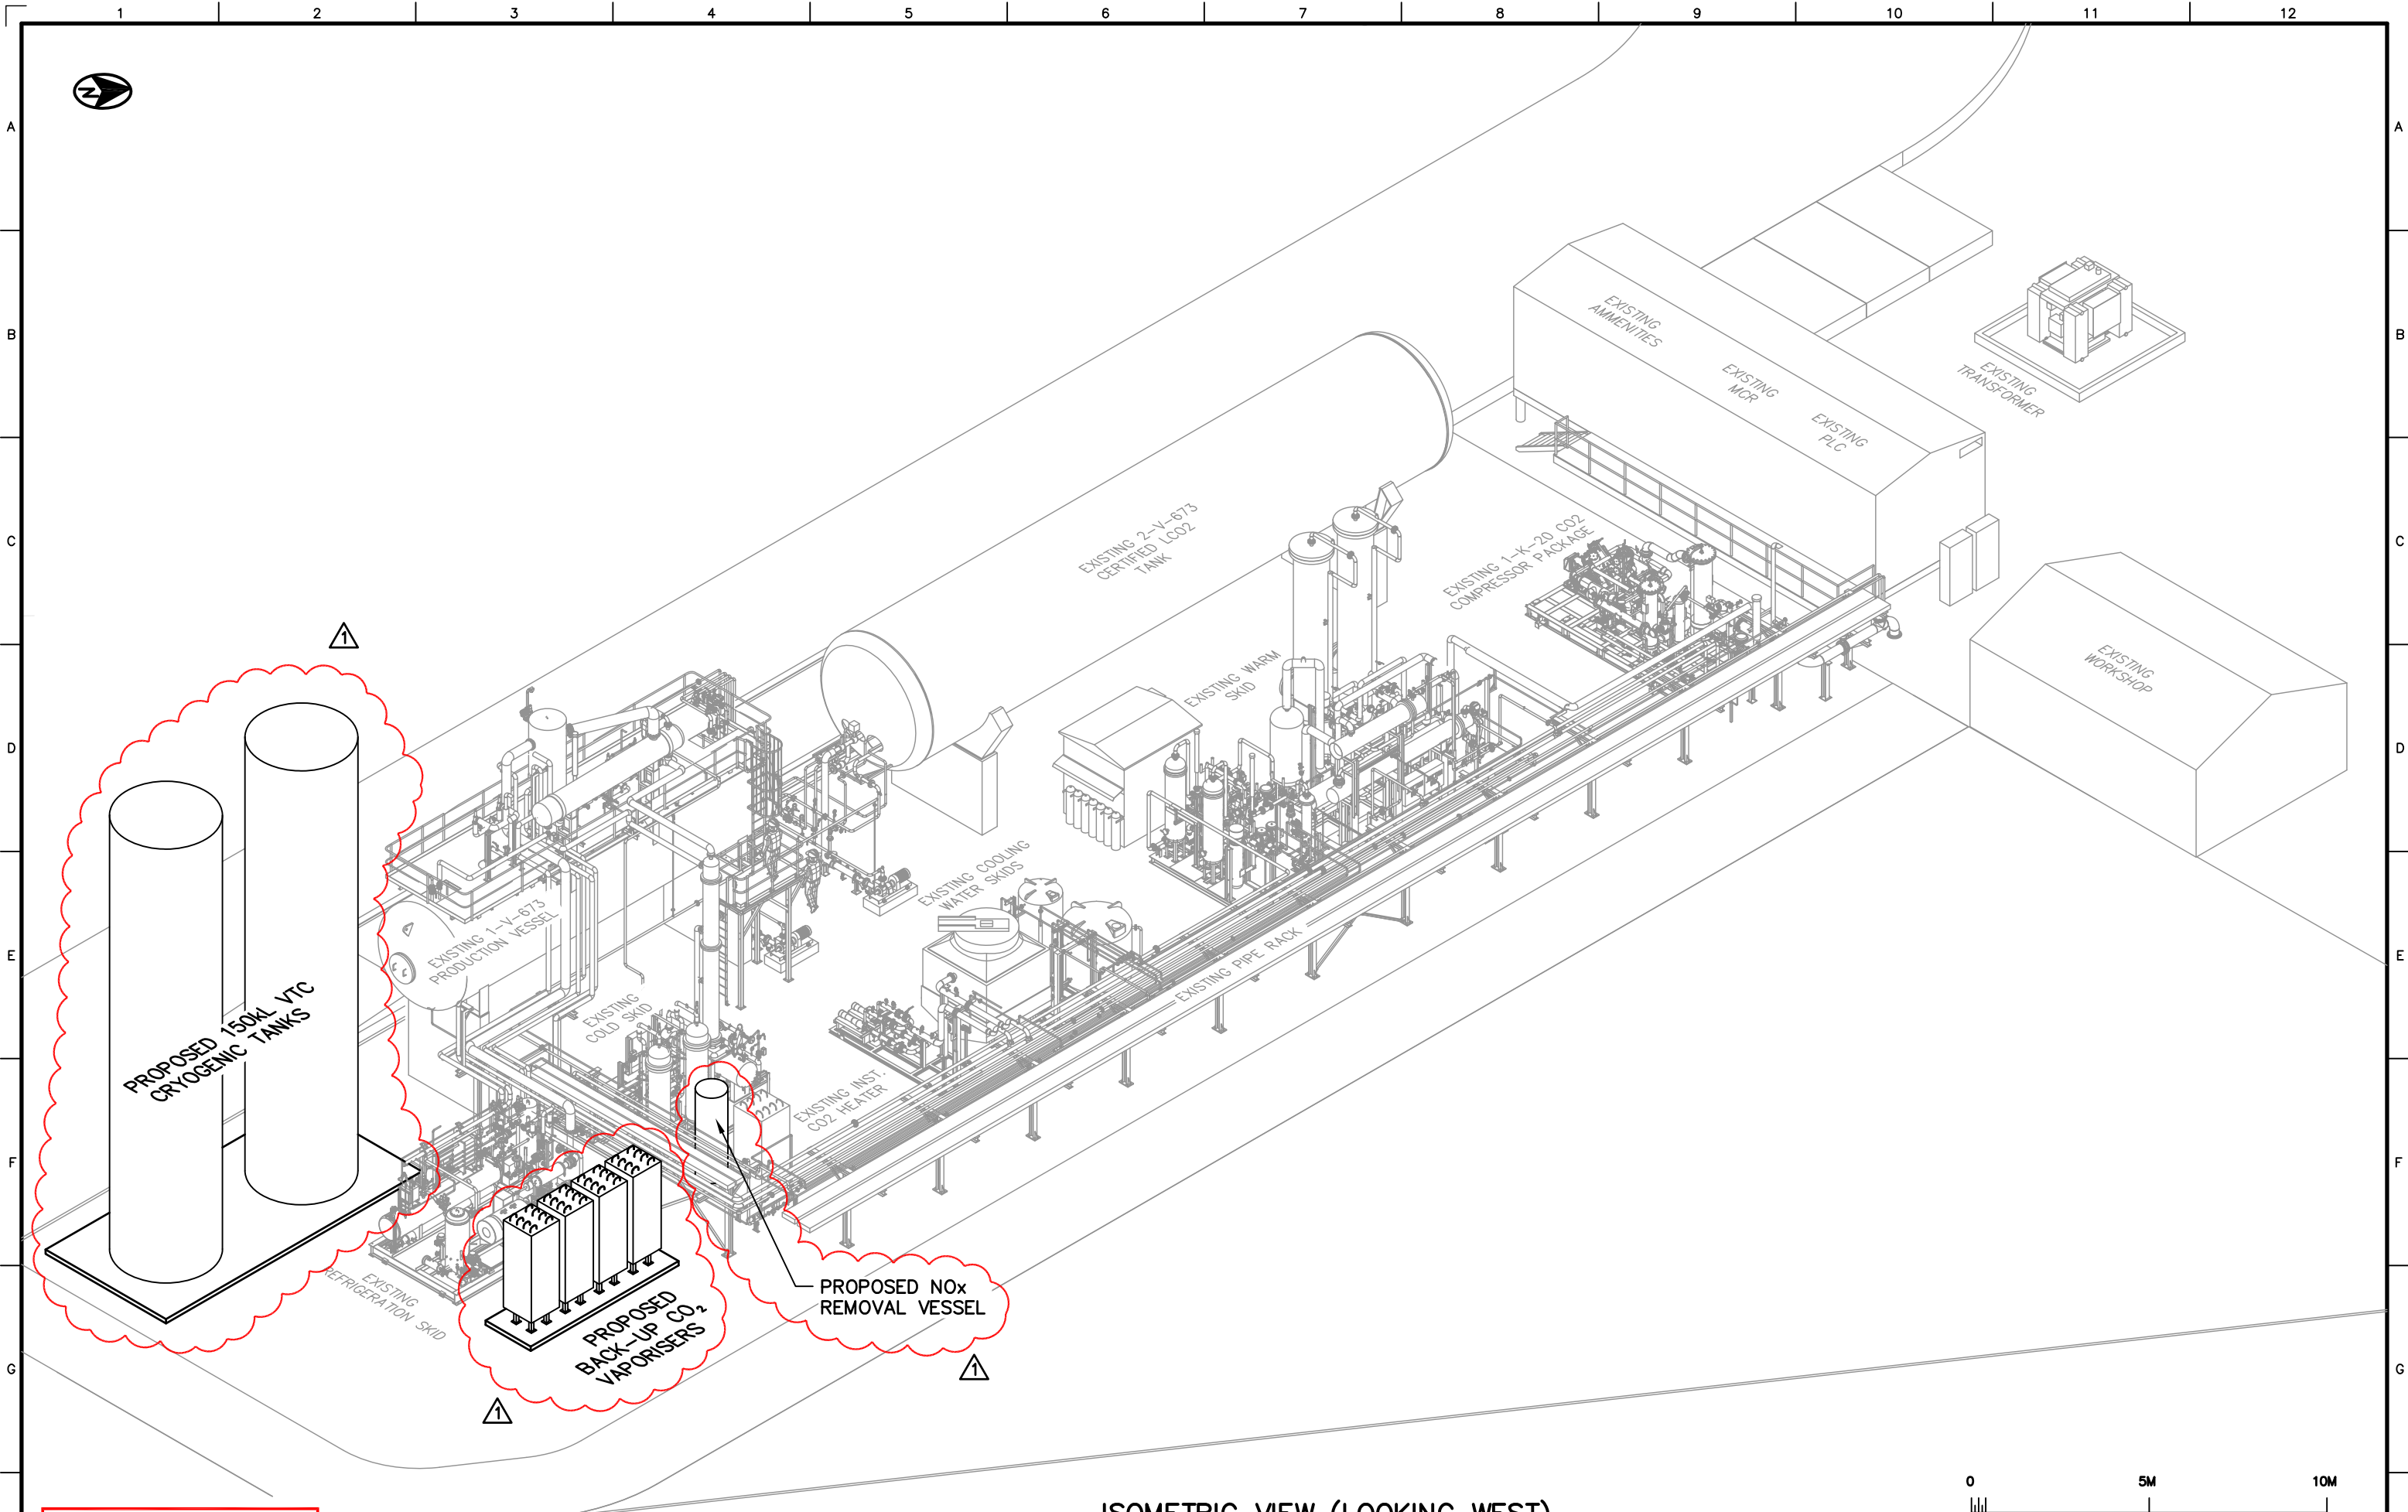

ISOMETRIC VIEW (LOOKING WEST)

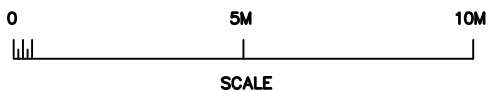

THIS DRAWING HAS BEEN PROVIDED BY SUPAGAS TO BE REVISED FOR THE PURPOSE OF PLANNING APPLICATION

COPYRIGHT
NOTE THAT UPON ACCEPTANCE OF THIS DRAWING, IT IS EXPRESSLY AGREED THAT THIS DRAWING IS THE PROPERTY OF GLP PLANT PTY LTD. THIS DRAWING AND ALL INFORMATION HEREIN CONTAINED REMAIN THE PROPERTY OF GLP PLANT PTY LTD AND SHALL NOT, WITHOUT PRIOR WRITTEN CONSENT, BE COPIED EITHER DIRECTLY OR INDIRECTLY, IN WHOLE OR IN PART OR BE USED TO ASSIST IN PRODUCTION OF OR TO FURNISH ANY INFORMATION FOR THE MAKING OF ANY DRAWINGS, PHOTOCOPIES, PRINTS OR OTHER REPRODUCTIONS THEREOF.


No.	DATE	REVISION	DRAWN BY	DWG. CHKD.	APP.	PROJ. MGR.	CLIENT
1	06 NOV 2020	ISSUED FOR PLANNING APPROVAL	CKL				
0	11 FEB 2020	AS BUILT	LV				
A	06 FEB 2019	ISSUED FOR INFORMATION	C.B		L.M	G.R	

GLP
Gas Liquid Processing
A.B.N 88 097 256 927

16 LILLEE CRESCENT, TULLAMARINE, VICTORIA
Tel : +61 3 9335 9000 Fax : +61 3 9334 5488 Web : www.glp.com.au

CLIENT : SUPAGAS PTY LTD 50MTPD CO2 PLANT MANILDRA STARCHES NOWRA NSW			TITLE : CO2 PLANT GENERAL LAYOUT ISOMETRIC VIEW #1		
JOB NUMBER	ISSUE DATE	SCALE	A3	DWG. No. P17316-L1-032	REV. 1
P17316	06 FEB 2019	DNS			

PS-5513

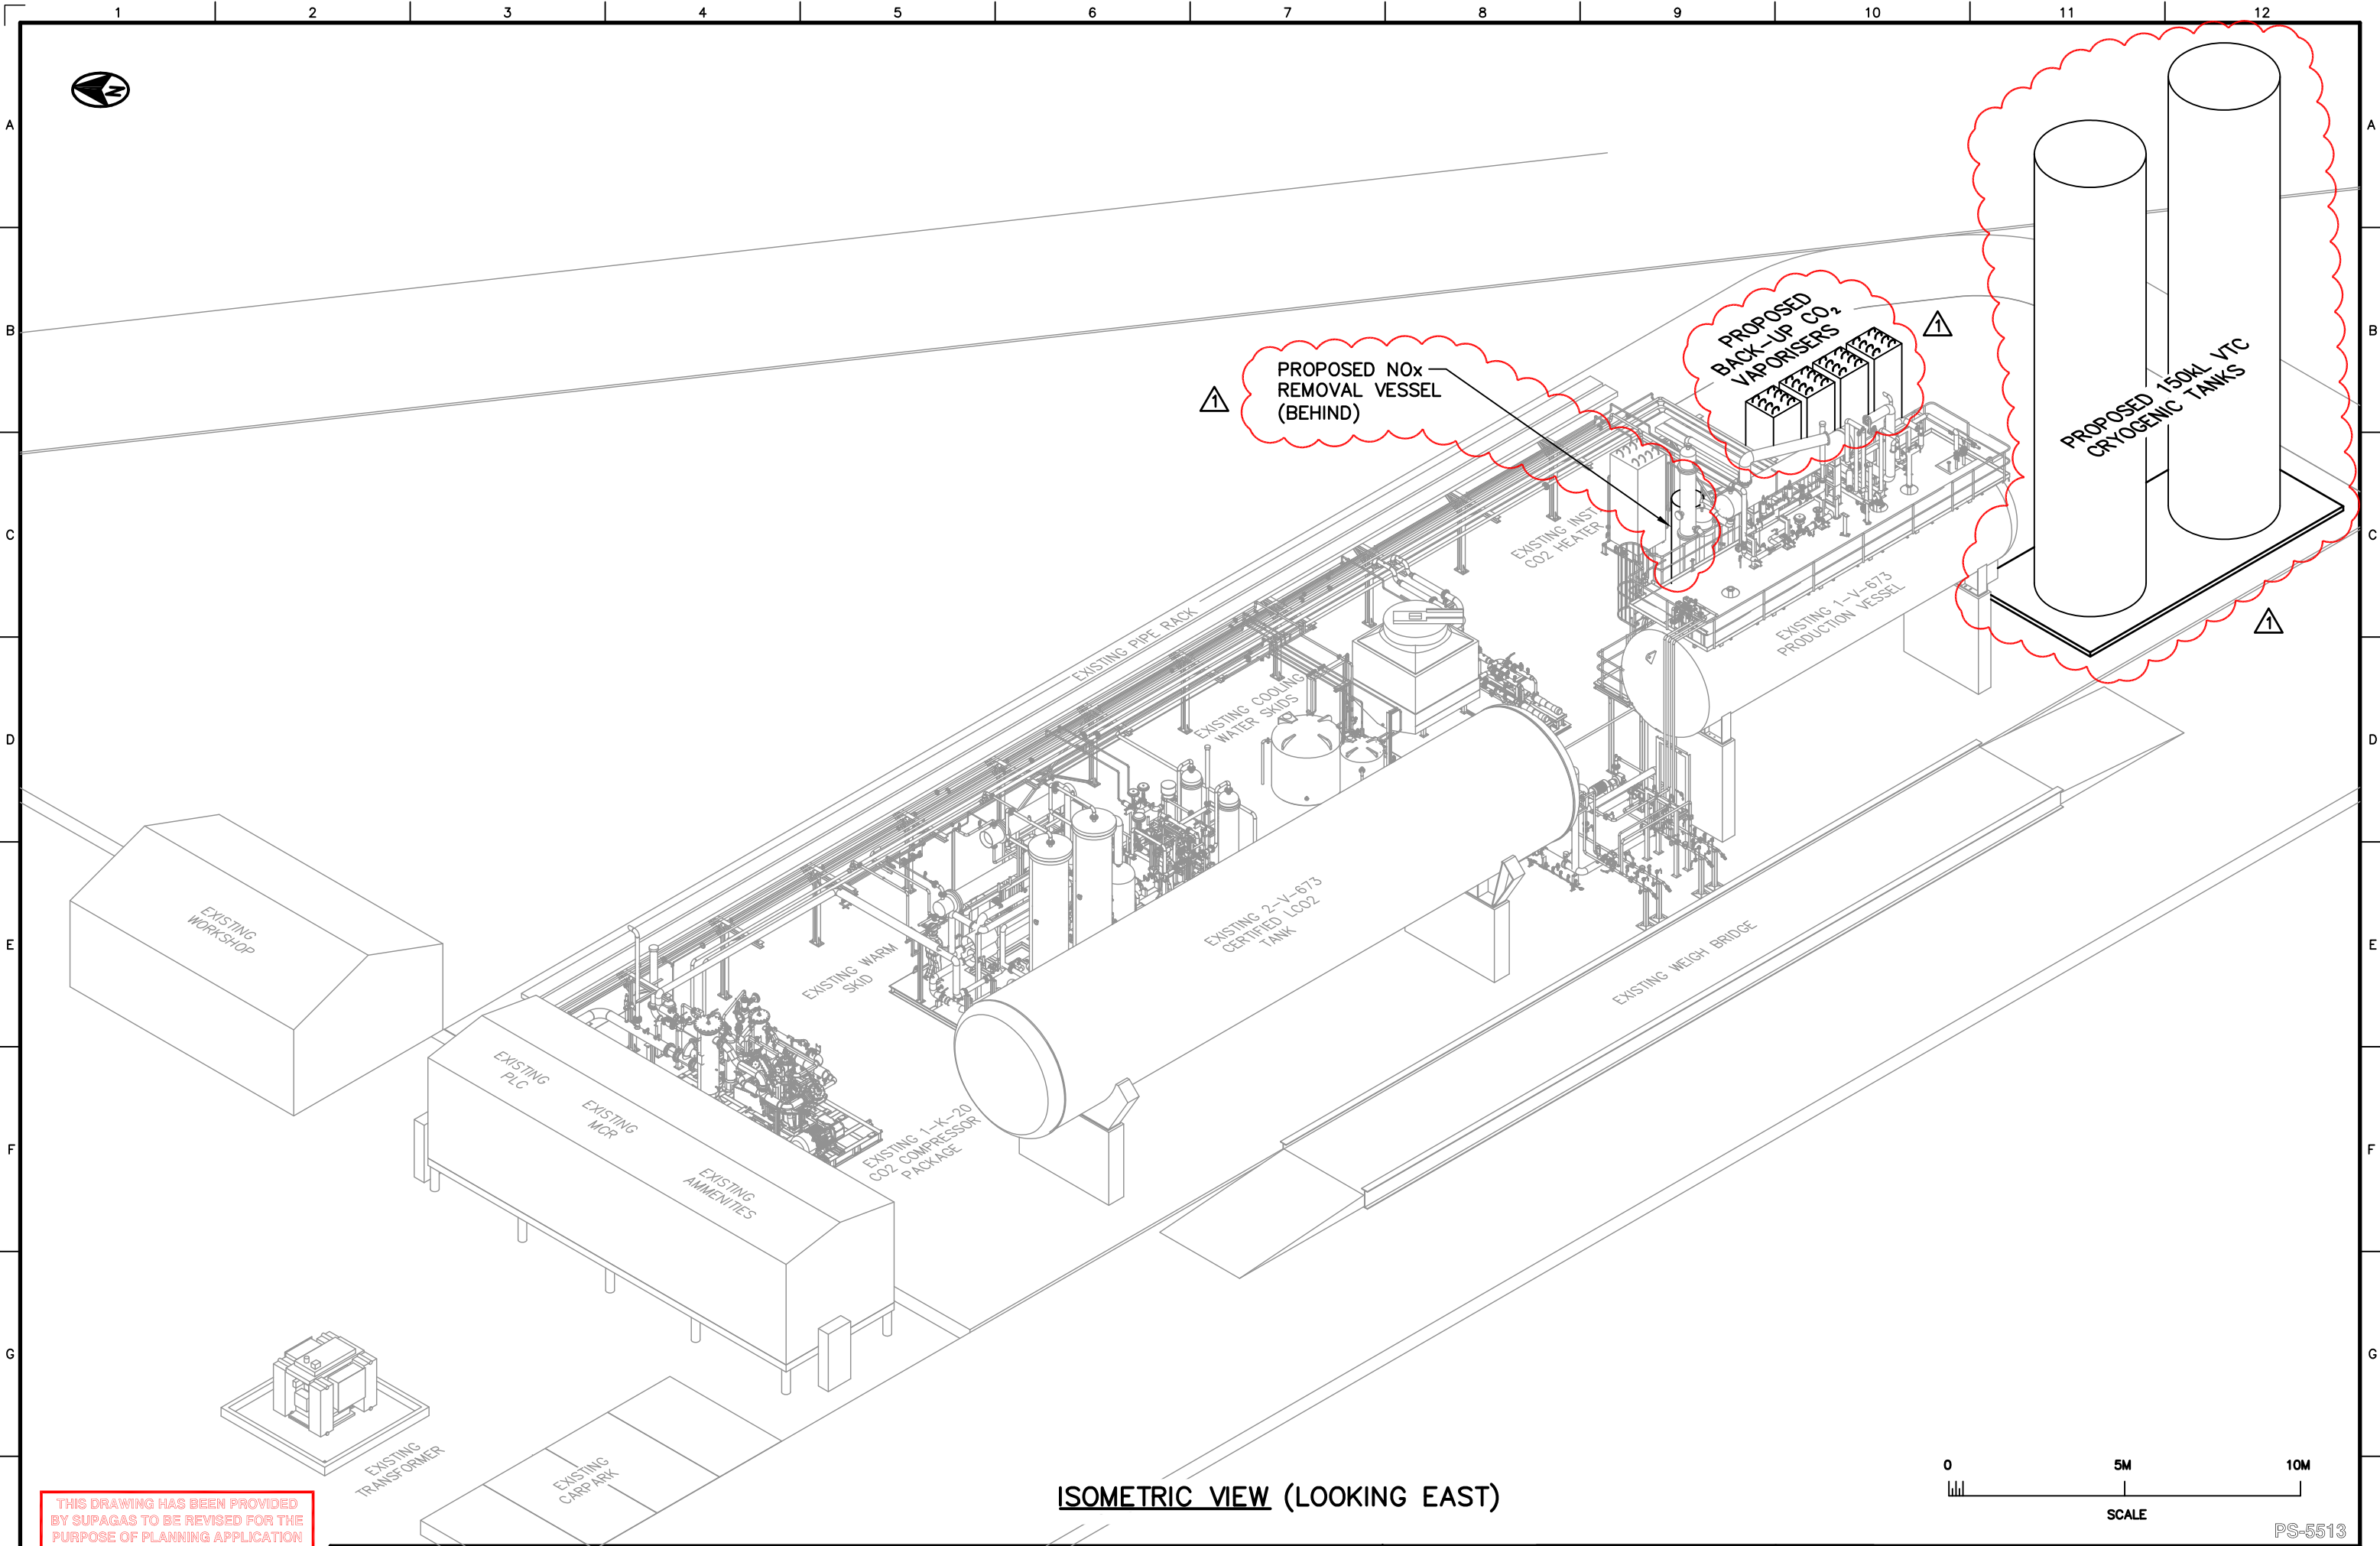

ISOMETRIC VIEW (LOOKING EAST)

THIS DRAWING HAS BEEN PROVIDED BY SUPAGAS TO BE REVISED FOR THE PURPOSE OF PLANNING APPLICATION

COPYRIGHT
NOTE THAT UPON ACCEPTANCE OF THIS DRAWING, IT IS EXPRESSLY AGREED THAT THIS DRAWING IS THE PROPERTY OF GLP PLANT PTY LTD. THIS DRAWING AND ALL INFORMATION HEREIN CONTAINED REMAIN THE PROPERTY OF GLP PLANT PTY LTD AND SHALL NOT, WITHOUT PRIOR WRITTEN CONSENT, BE COPIED EITHER DIRECTLY OR INDIRECTLY, IN WHOLE OR IN PART OR BE USED TO ASSIST IN PRODUCTION OF OR TO FURNISH ANY INFORMATION FOR THE MAKING OF ANY DRAWINGS, PHOTOCOPIES, PRINTS OR OTHER REPRODUCTIONS THEREOF.


REV	No.	DATE	REVISION	DRAWN BY	DWG. CHKD.	PROJ. ENG.	PROJ. MGR.	CLIENT
1	06 NOV 2020		ISSUED FOR PLANNING APPROVAL	CKL				
0	18 FEB 2020		AS BUILT	LV				
A	07 FEB 2019		ISSUED FOR INFORMATION	C.B		L.M		

GLP
Gas Liquid Processing
A.B.N 55 097 255 927

16 LILLEE CRESCENT, TULLAMARINE, VICTORIA
Tel : +61 3 9335 9000 Fax : +61 3 9334 5488 Web : www.glp.com.au

CLIENT : SUPAGAS PTY LTD 50MTPD CO2 PLANT MANILDRA STARCHES NOWRA NSW			TITLE : CO2 PLANT GENERAL LAYOUT ISOMETRIC VIEW #2		
JOB NUMBER P17316	ISSUE DATE 07 FEB 2019	SCALE DNS	A3	DWG. No. P17316-L1-033	REV. 1

PS-5513

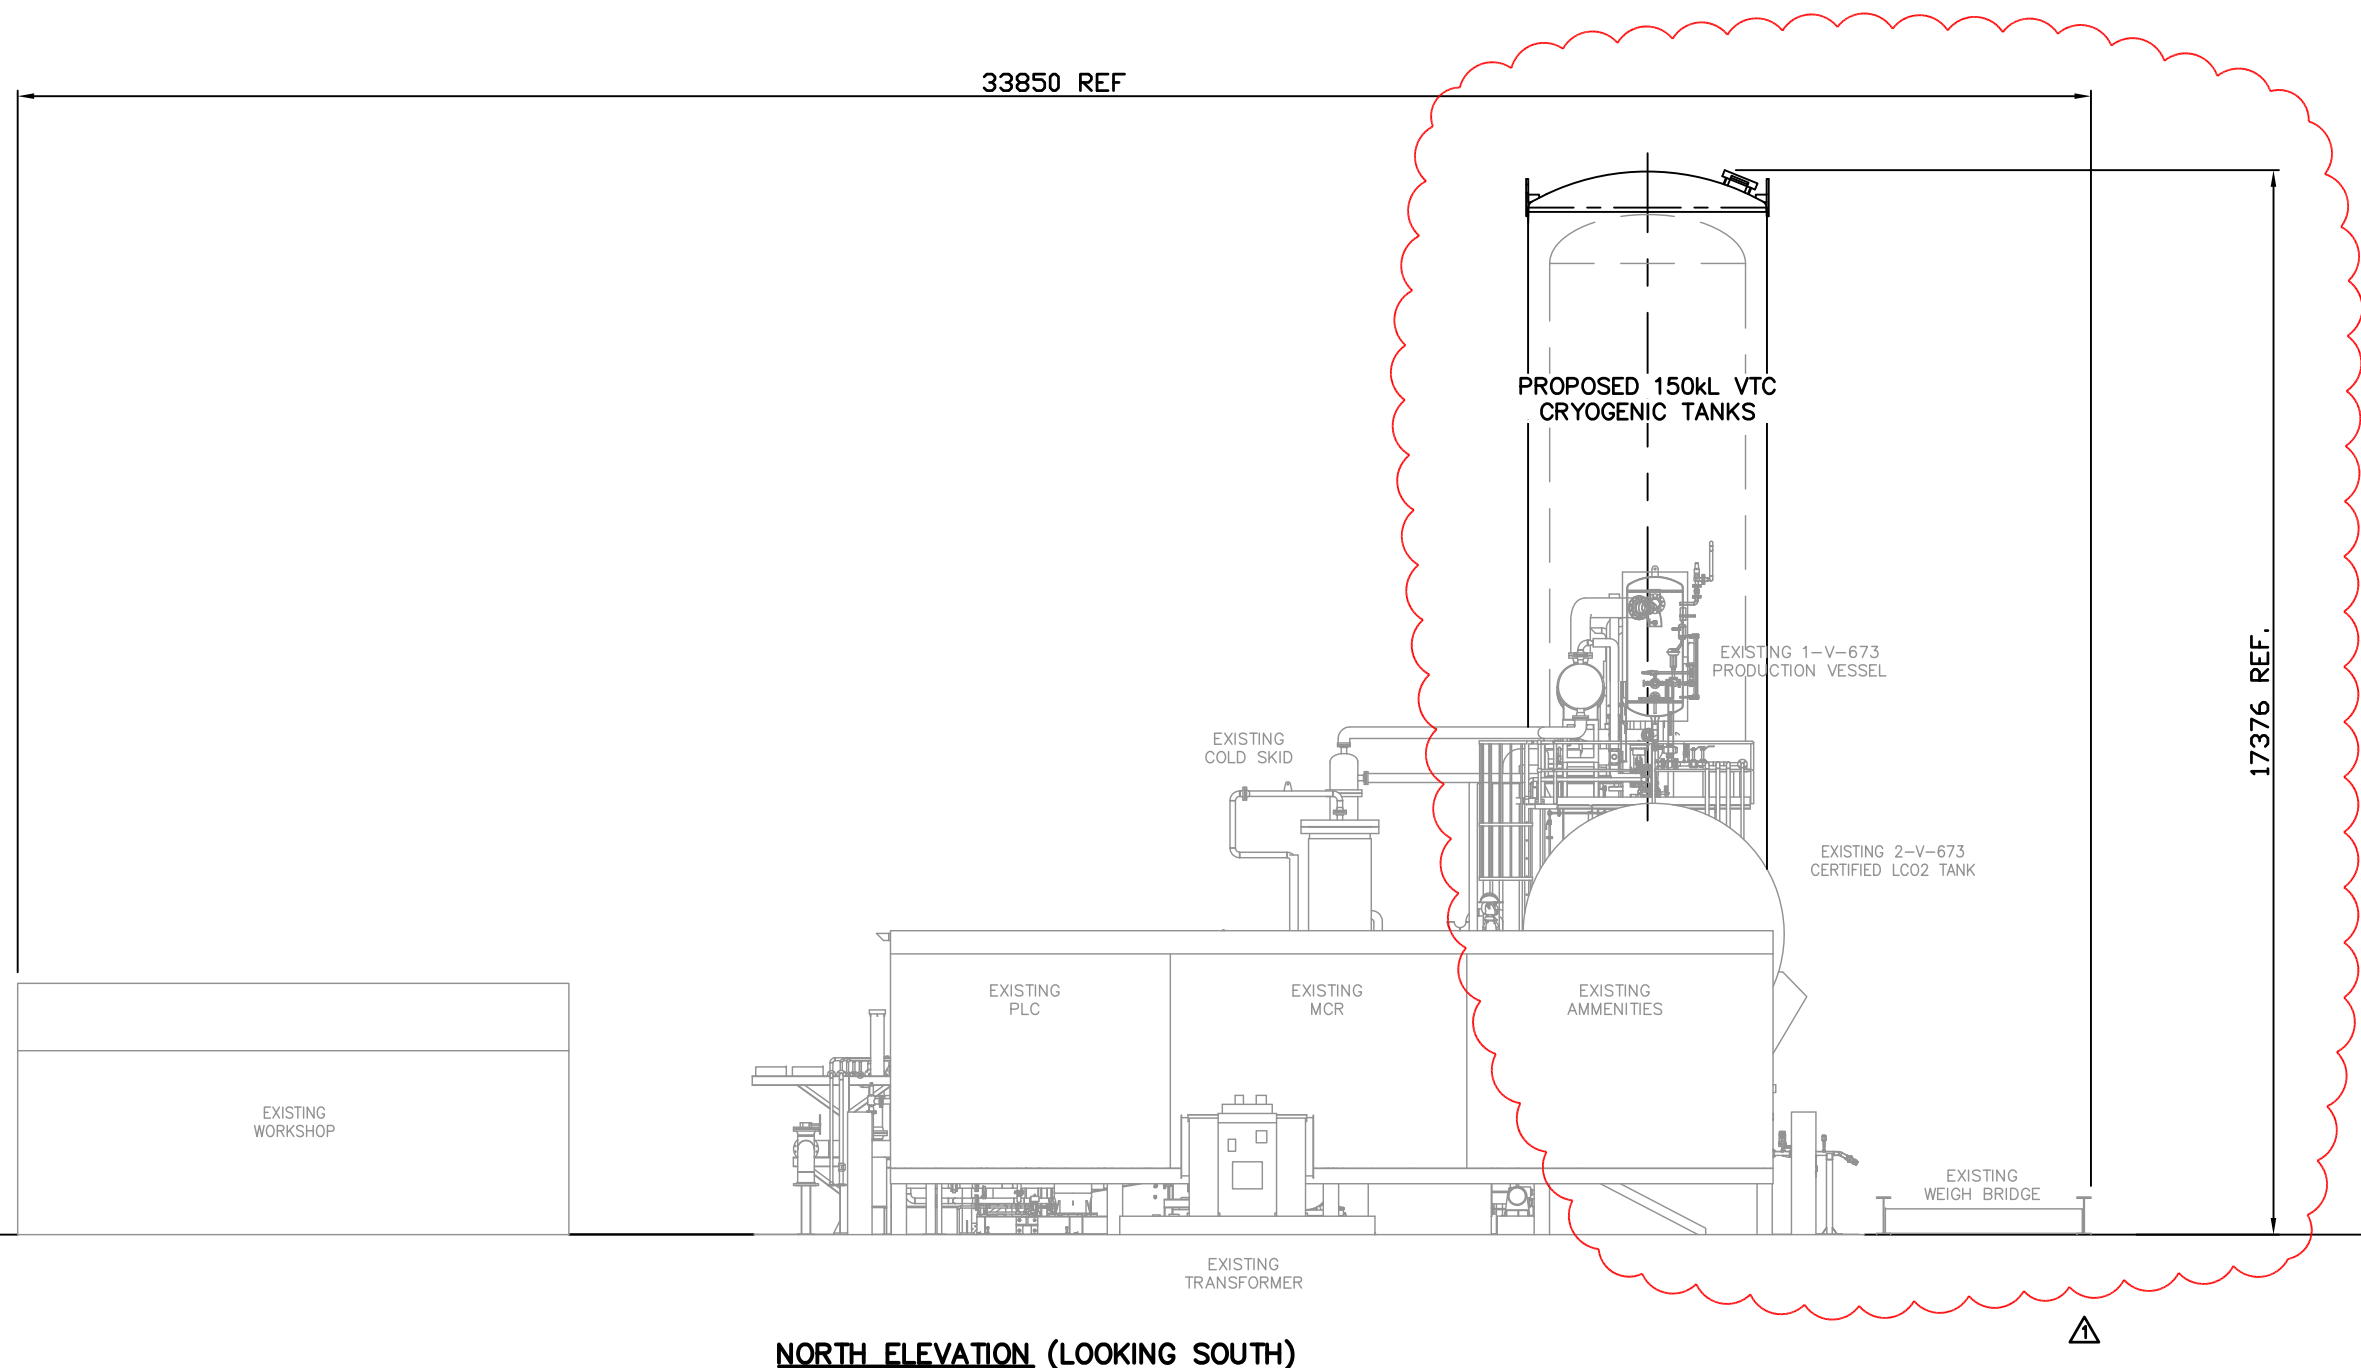


THIS DRAWING HAS BEEN PROVIDED
BY SUPAGAS TO BE REVISED FOR THE
PURPOSE OF PLANNING APPLICATION

COPYRIGHT

NOTE THAT UPON ACCEPTANCE OF THIS DRAWING, IT IS EXPRESSLY AGREED THAT THIS DRAWING IS THE PROPERTY OF GLP PLANT PITY LTD. THIS DRAWING AND ALL INFORMATION HEREIN CONTAINED REMAIN THE PROPERTY OF GLP PLANT PITY LTD. AND SHALL NOT, WITHOUT PRIOR WRITTEN CONSENT, BE COPIED EITHER DIRECTLY OR INDIRECTLY, IN WHOLE OR IN PART OR BE USED TO ASSIST IN PRODUCTION OF OR TO FURNISH ANY INFORMATION FOR THE MAKING OF ANY DRAWINGS, PHOTOCOPIES, PRINTS OR OTHER REPRODUCTIONS THEREOF.

[illegible]

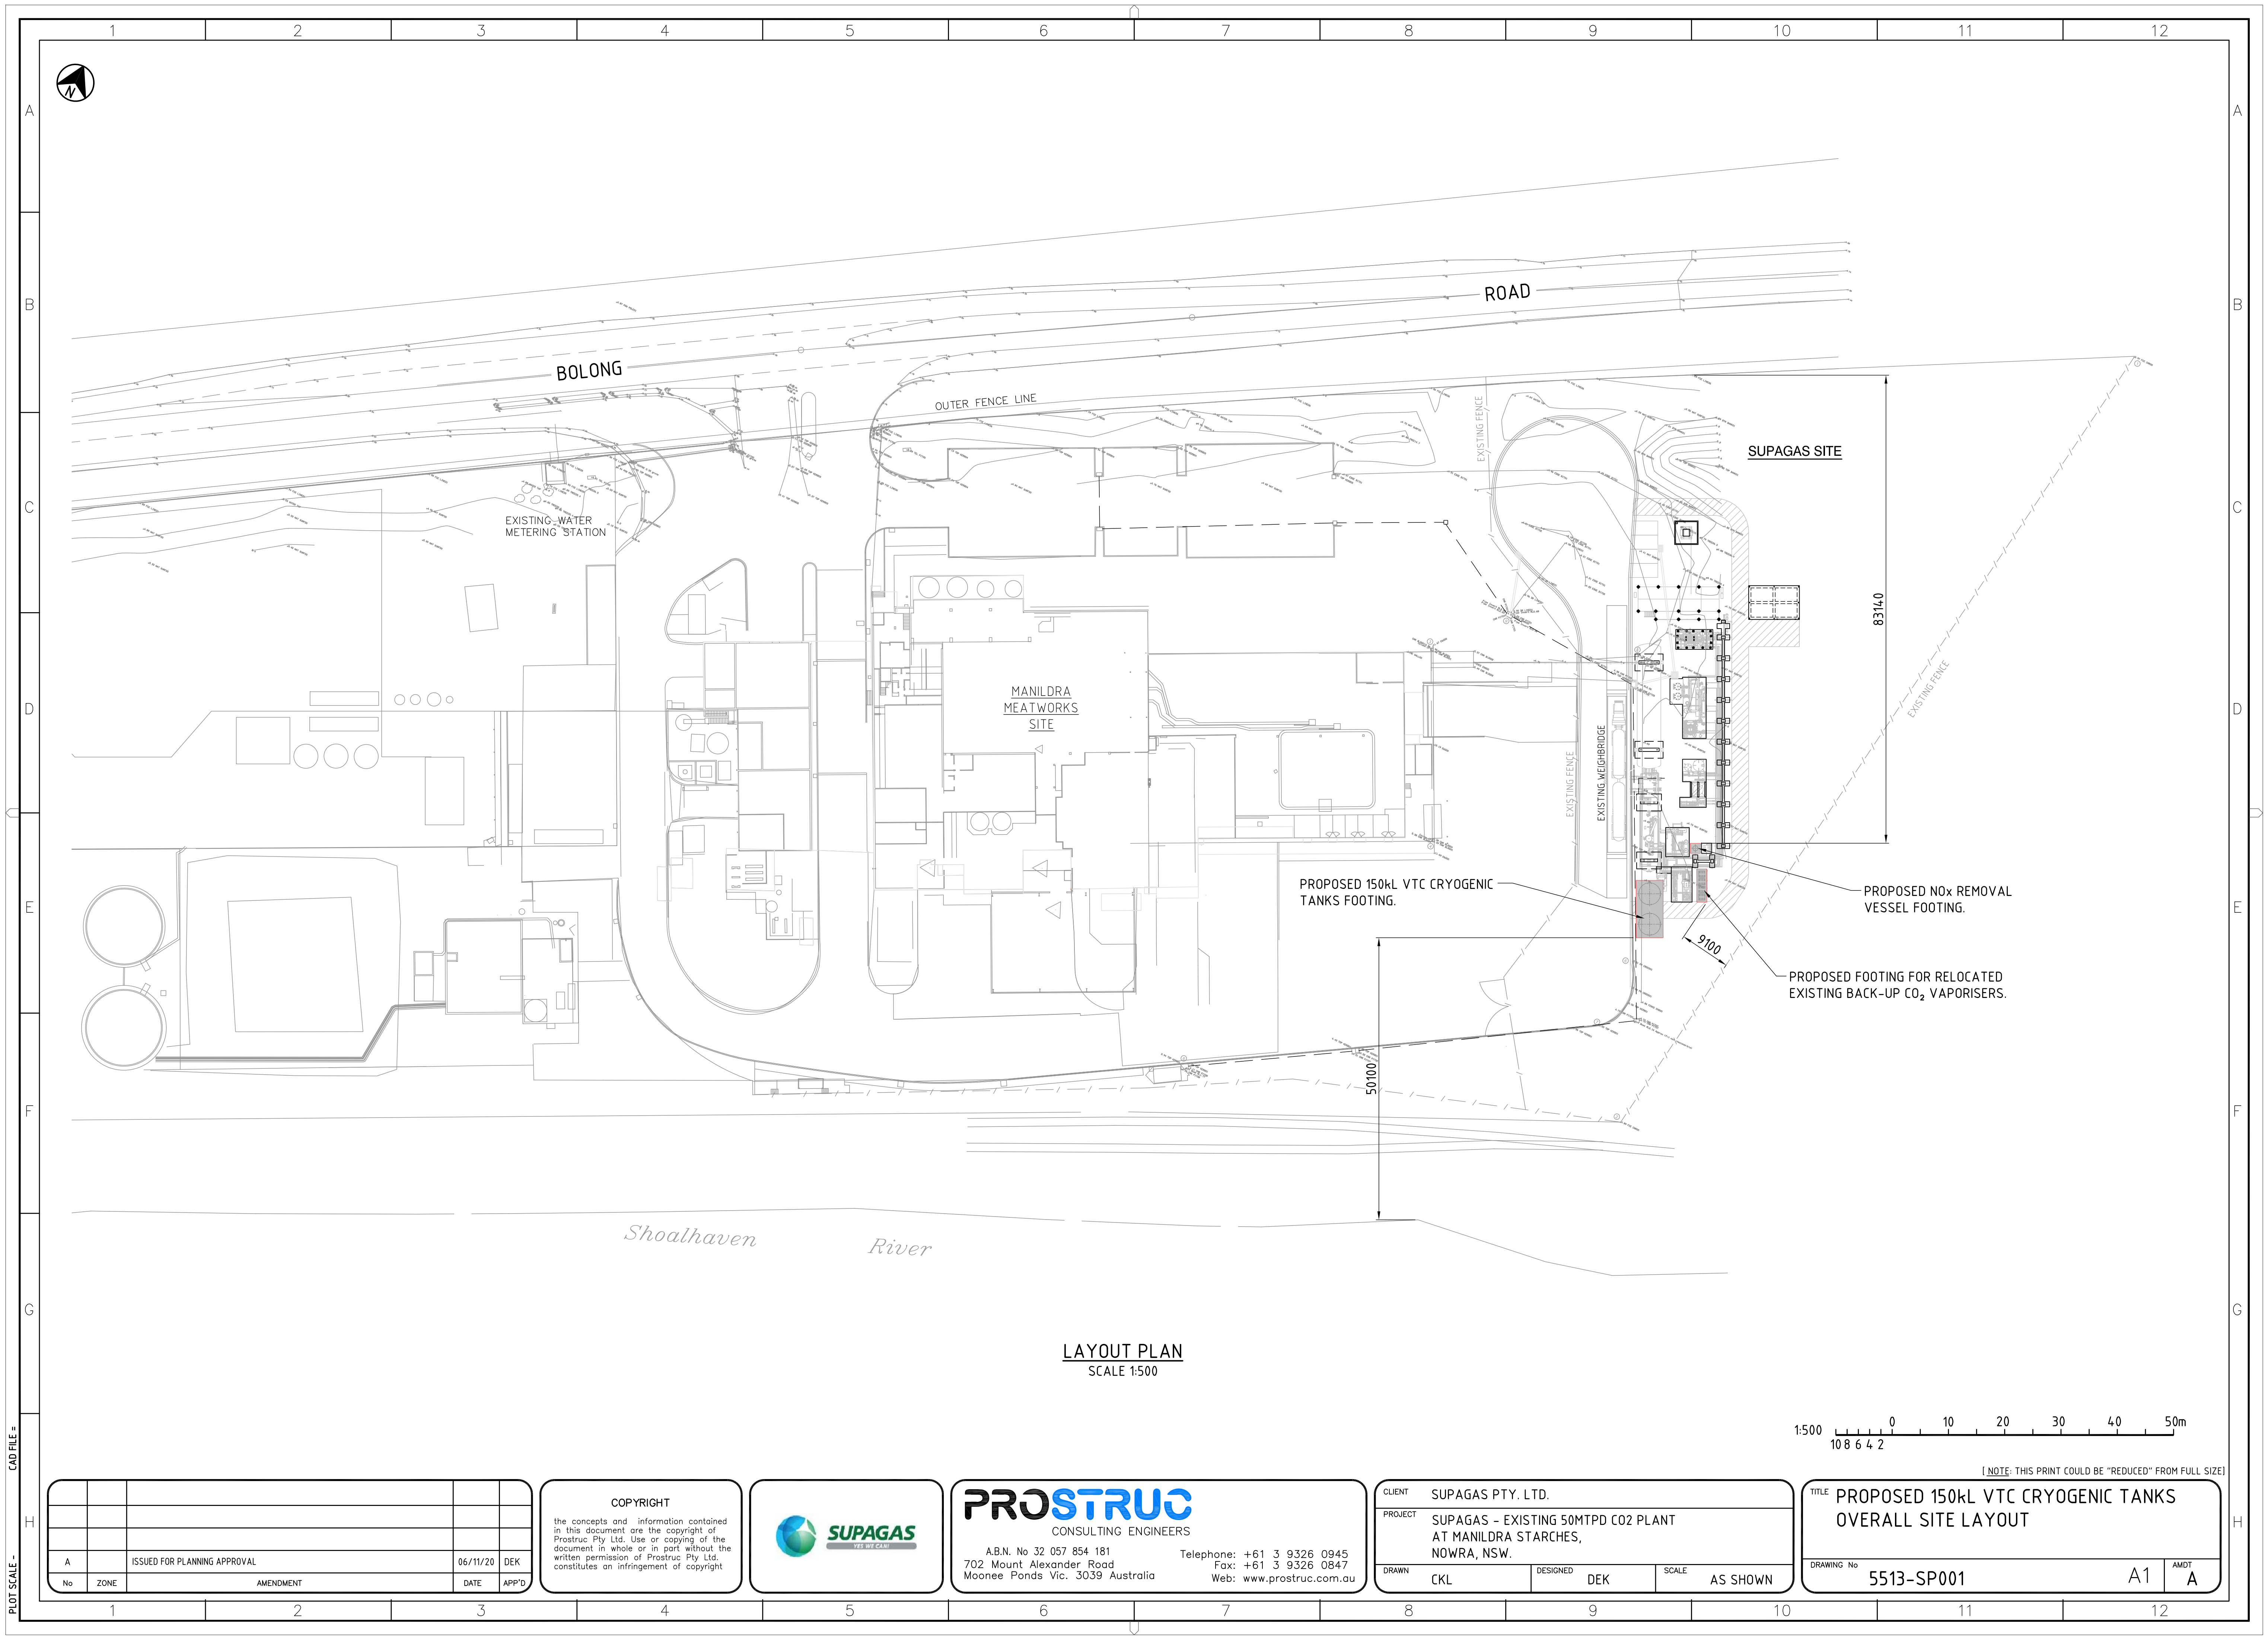

PLOT SCALE =
CAD FILE =

A		ISSUED FOR PLANNING APPROVAL	06/11/20	DEK	
No	ZONE	AMENDMENT	DATE	APP'D	

COPYRIGHT
the concepts and information contained in this document are the copyright of Prostruc Pty Ltd. Use or copying of the document in whole or in part without the written permission of Prostruc Pty Ltd, constitutes an infringement of copyright



PROSTRUC
CONSULTING ENGINEERS
A.B.N. No 32 057 854 181
702 Mount Alexander Road
Moonee Ponds Vic. 3039 Australia
Telephone: +61 3 9326 0945
Fax: +61 3 9326 0847
Web: www.prostruc.com.au

CLIENT	SUPAGAS PTY. LTD.
PROJECT	SUPAGAS - EXISTING 50MTPD CO2 PLANT AT MANILDRA STARCHES, NOWRA, NSW.
DRAWN	CKL
DESIGNED	DEK
SCALE	AS SHOWN

TITLE	PROPOSED 150kL VTC CRYOGENIC TANKS OVERALL SITE LAYOUT
DRAWING No	5513-SP001
A1	AMD A