



NOTES:  
Only use figured dimensions. Do not scale from drawings.

ABBREVIATIONS

AP	ACCESS PANEL
B	BASIN
BCT	BATH CHANGE TABLE
BKS	BACKREST
BR	BRUSH RAIL
BT	BALLUSTRADE TYPE
CH	CHARTER
COS	CHECK ON SITE
CS	CLEANERS SINK
CT	CEILING TYPE: SEE SCHEDULE
D	DOOR
DP	DOWN TYPE
FF	FLOOR FINISH TYPE: SEE SCHEDULE
FFL	FINISHED FLOOR LEVEL
FG	FIXED GLASS
FP	FIXED PANEL
FS	FOLDING SHOWER SEAT
FW	FLOOR WASTE
GR	GRAB RAIL TO AS 1428
GT	GREASE TRAP
HC	HOSE COCK
HD	HAND DRYER
HT	HANDRAIL TYPE
L	LOUVER
M	MIRROR
MH	MANHOLE
MT	MATER TAP
NC	NO CEILING
PJ	PANEL JOINT
PTD	PAPER TOWEL DISPENSER
R	REVEAL
RL	RELATIVE LEVEL
RWO	RAIN WATER OUTLET
SD	SOAP DISPENSER
SF	SHIELD
SH	SHOWER
SL	STRUCTURAL LEVEL
SRI	SHOWER RAIL & HEAD
TB	TROLLEY BAY
TBC	TO BE CONFIRMED
TM	TOILET PAPER HOLDER
UR	URINAL
VB	VANITY BASIN
W	WINDOY
WC	TOILET
WF	WALL FINISH TYPE: SEE SCHEDULE
WT	WALL TYPE: SEE SCHEDULE

30.08.14	D	DRAWINGS UPDATED	IF
07.05.13	C	AS CONSTRUCTED	IF
15.03.13	B	AS CONSTRUCTED	IF
28.08.12	A	FOR CONSTRUCTION	IF
08.08.12	A	FOR CONSTRUCTION	IF



project client  
**WOOLWORTHS  
CABARITA**  
**TWEED COAST RD,  
CABARITA**  
FOR  
**MAINBRACE CONSTRUCTIONS**

**Cameron  
Chisholm &  
Nicol**  
6/18 Kilme Street  
Milton QLD 4064  
GPO Box 2737  
Brisbane QLD 4001  
Telephone (07) 3867 7000  
Facsimile (07) 3367 0942  
info@cameronchisholmnicol.com.au

drawing title  
**SITE PLAN**


project no.	Q1201	scale	1:200	@A0
discipline	AB	sheet no.	0001	D

**AS CONSTRUCTED**






REFER TO 1202 FOR CONTINUATION

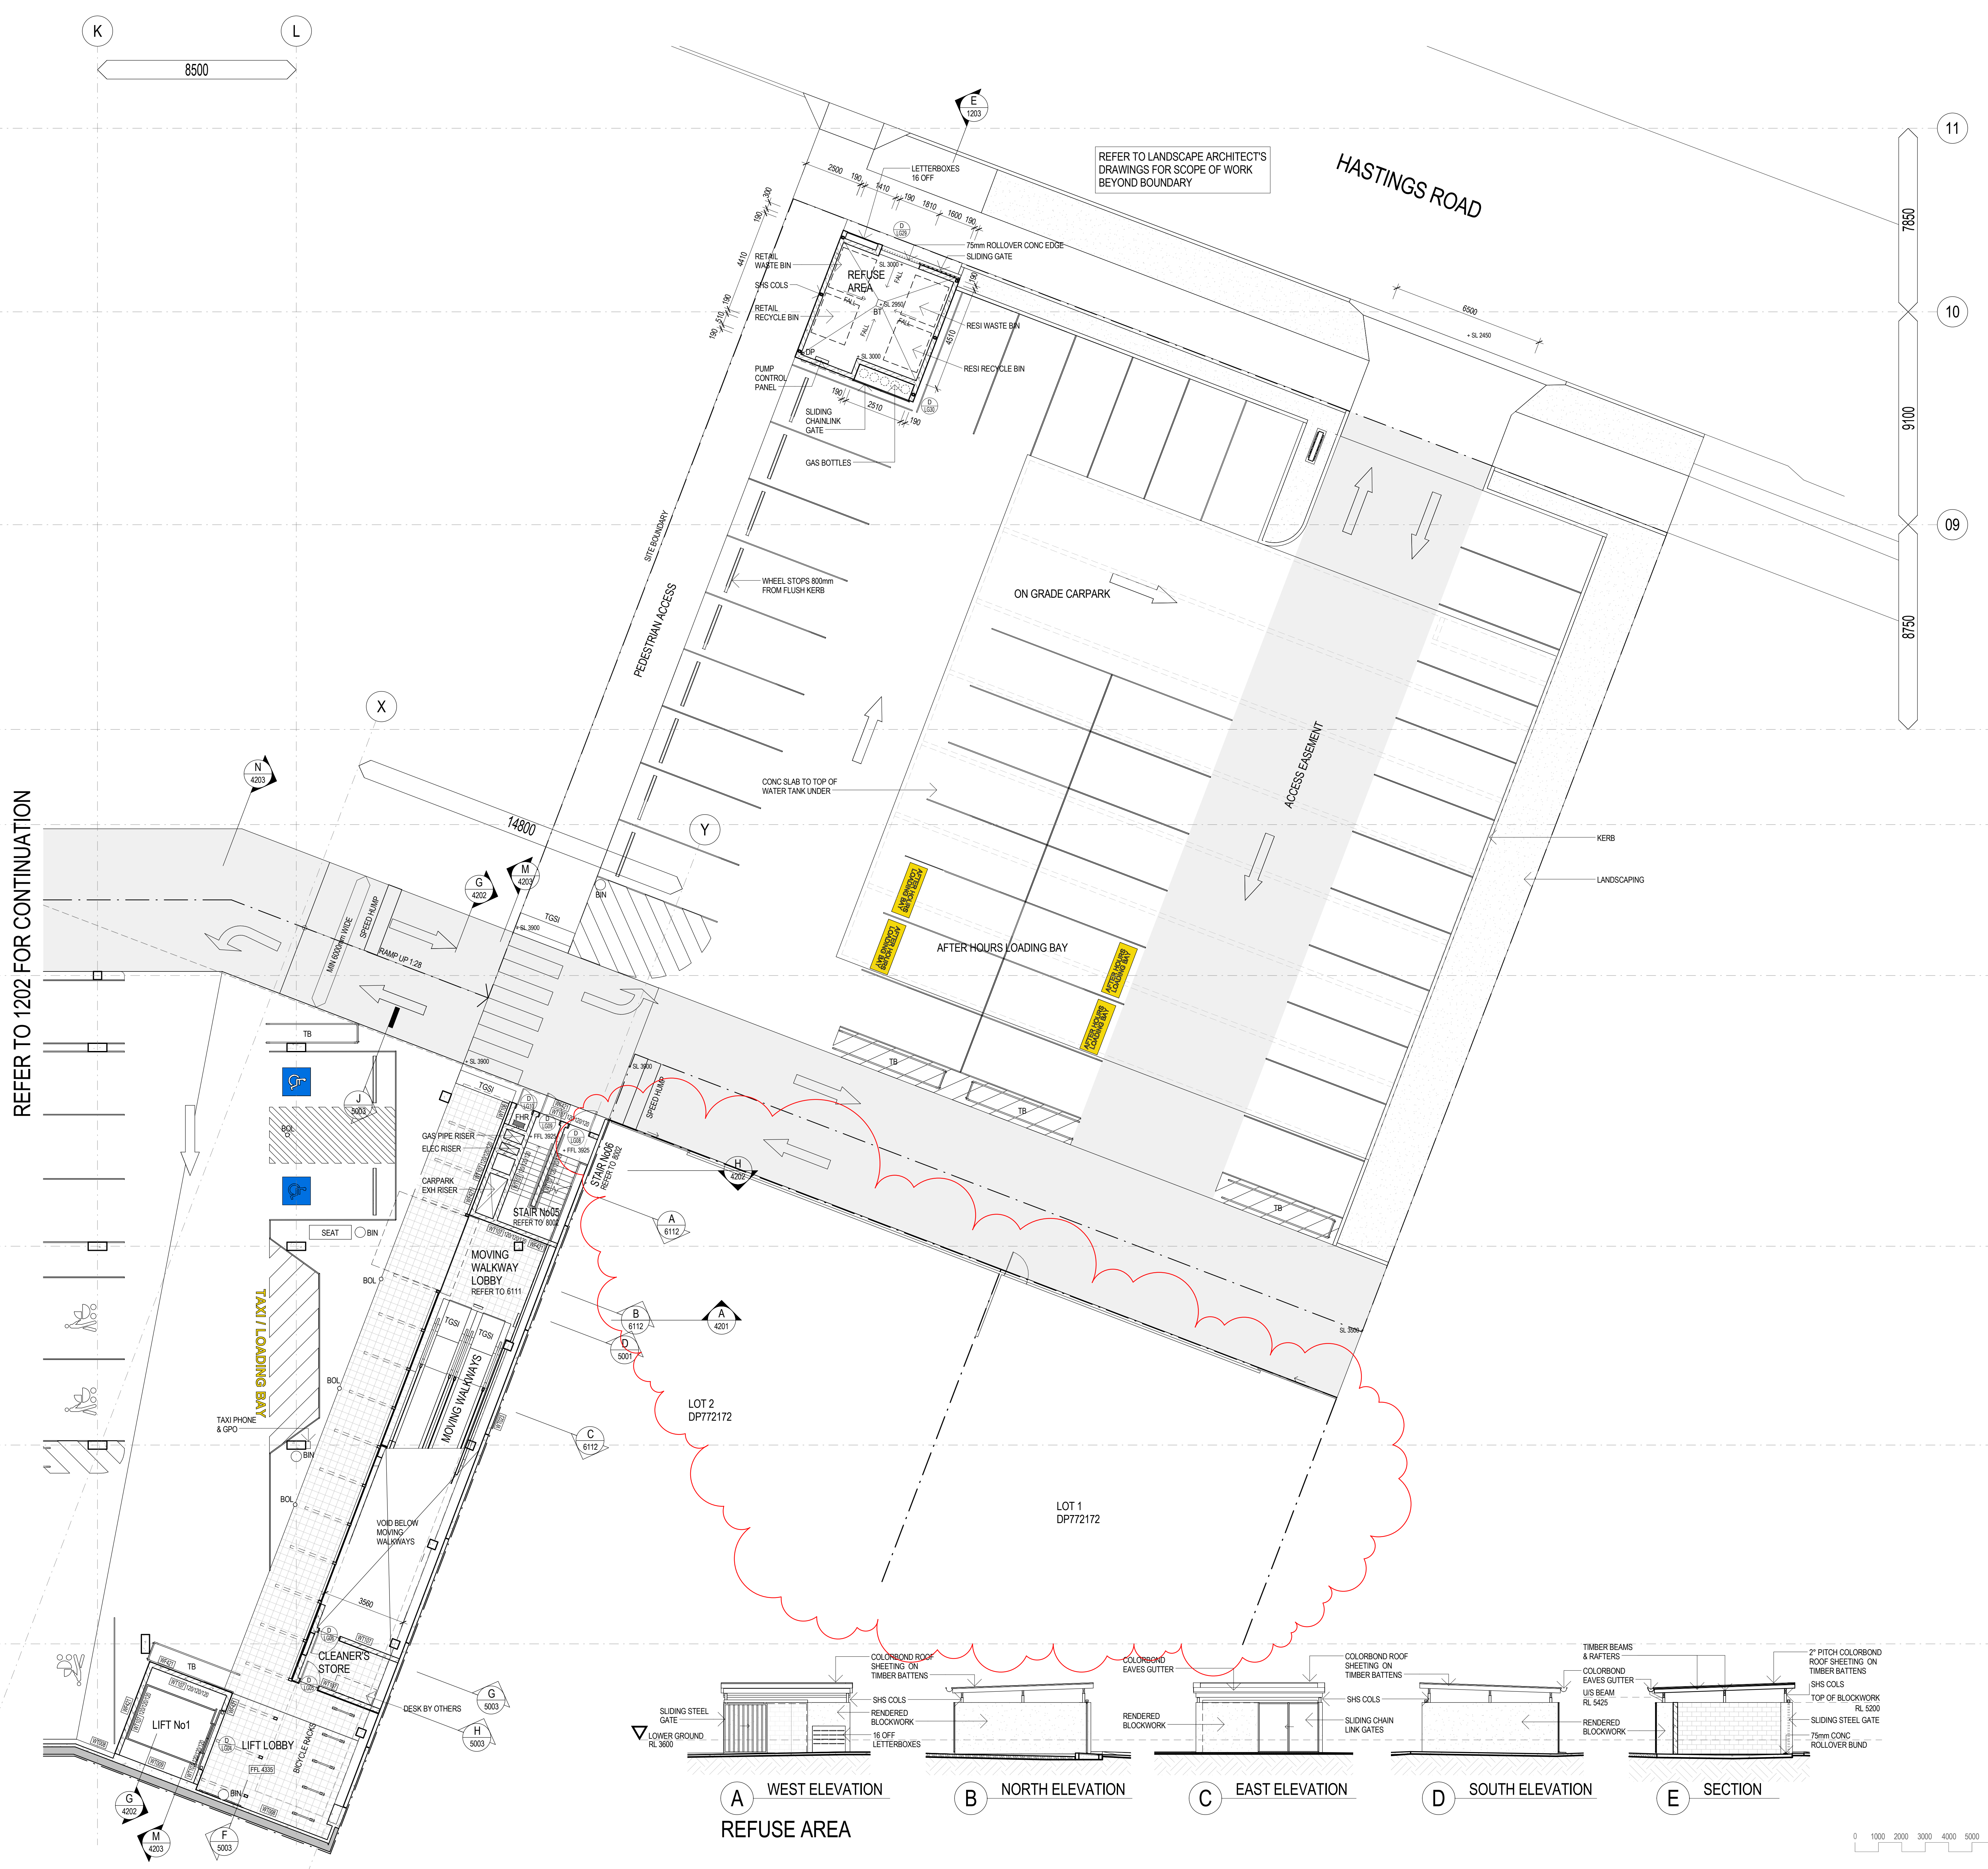

WALL TYPES	
WT001	400mm DIA SECANT PILES WITH 125 mm CONC LINING
WT005	170mm SHEET PILING W 125mm CONC LINING
WT006	170mm SHEET PILING W 150mm CONC LINING
WT007	170mm SHEET PILING W 300mm CONC LINING
WT008	320mm SHEET PILING W 125mm CONC LINING
WT009	320mm SHEET PILING W 300mm CONC LINING
WT012	125mm CAST IN SITU CONCRETE
WT013	150mm CAST IN SITU CONCRETE
WT015	200mm CAST IN SITU CONCRETE
WT017	300mm CAST IN SITU CONCRETE
WT023	150mm TILT-UP CONCRETE PANEL
WT106	150mm CONCRETE BLOCKS
WT107	150mm CONCRETE BLOCK REINFORCED & CORE FILLED
WT202	64mm STEEL STUD WITH 10mm WATER RESISTANT PLASTERBOARD TO ONE SIDE
WT203	64mm STEEL STUDS WITH 10mm PLASTERBOARD TO ONE SIDE
WT206	64mm STEEL STUDS WITH 2 LAYERS 15mm FIRE RATED PLASTERBOARD TO ONE SIDE
WT207	64mm STEEL STUDS WITH 3 LAYERS 15mm FIRE RATED PLASTERBOARD TO ONE SIDE
WT221	64mm STEEL STUDS WITH 10mm PLASTERBOARD TO BOTH SIDES
WT261	50mm STEEL STUD WITH 6mm FIBRE CEMENT TO ONE SIDE
WT261a	50mm STEEL STUD WITH 9mm FIBRE CEMENT TO ONE SIDE
WT264	50mm STEEL STUDS WITH 13mm PLASTERBOARD TO ONE SIDE
WT271a	50mm STEEL STUDS WITH 9mm FIBRE CEMENT TO BOTH SIDES
WT272	50mm STEEL STUDS WITH 6mm FIBRE CEMENT TO ONE SIDE & 10mm PLASTERBOARD TO ONE SIDE
WT281	50mm STEEL STUDS WITH 10mm PLASTERBOARD TO BOTH SIDES
WT411	PERFORATED METAL WITH 50mm BRADFORD ULTRATEL INSULATION & ULTRAPHON FACING
WT501	30mm LAMINATED TOILET PARTITION FRAMING
WT521	10mm PLASTERBOARD B/HEAD ON STEEL FRAMING
WT522	10mm PLASTERBOARD B/HEAD ON STEEL FRAMING
WT543	12mm PLYWOOD PANEL ON 22mm FURRING CHANNELS
WT702	9mm FIBRE CEMENT
WT725	9mm FIBRE CEMENT ON 22mm FURRING CHANNELS
WT726	9mm COMPRESSED FIBRE CEMENT ON 22mm FURRING CHANNELS
WT728	9mm COMPRESSED FIBRE CEMENT ON 35mm FURRING CHANNELS
WT743	10mm PLASTERBOARD ON 22mm FURRING CHANNELS
WALL FINISH TYPES	
WF114	CERAMIC TILES
WF116	CERAMIC TILES
WF201	6mm GLASS MIRROR
WF421	10mm CEMENT RENDER

ABBREVIATIONS	
AP	ACCESS PANEL
B	BASIN
BCT	BIBBY CHANGE TABLE
BKR	BACKREST
BR	BUSHING RAIL
BT	BALLSTRADE TYPE
CH	CHART ROOM
COS	CHECK ON SITE
CS	CLEANERS SINK
CT	CEILING TYPE: SEE SCHEDULE
D	DOOR
DP	DOWN PIPE
FF	FLOOR FINISH TYPE: SEE SCHEDULE
FLL	FINISHED FLOOR LEVEL
FG	FIXED GLASS
FP	FLORED PANEL
FS	FOLDING SHOWER SEAT
FW	FLOOR WASTE
GR	GRAB RAIL TO AS 1428
GT	GREASE TRAP
HC	HOSE COCK
HD	HAND DRYER
HT	HANDRAIL TYPE
L	LOUVER
M	MIRROR
MH	MANHOLE
MT	MATER TAP
NC	NO CEILING
PJ	PANEL JOINT
PTD	PAPER TOWEL DISPENSER
R	REVEAL
RL	RELATIVE LEVEL
RWO	RAIN WATER OUTLET
SD	SOAP DISPENSER
SH	SHOWER
SH	SHOWER
SL	STRUCTURAL LEVEL
SRH	SHOWER RAIL & HEAD
TB	TROUSER BAR
TBC	TO BE CONFIRMED
THH	TOILET PAPER HOLDER
UR	URNAL
VB	VANITY BASIN
W	WINDOW
WC	TOILET
WF	WALL FINISH TYPE: SEE SCHEDULE
WT	WALL TYPE: SEE SCHEDULE

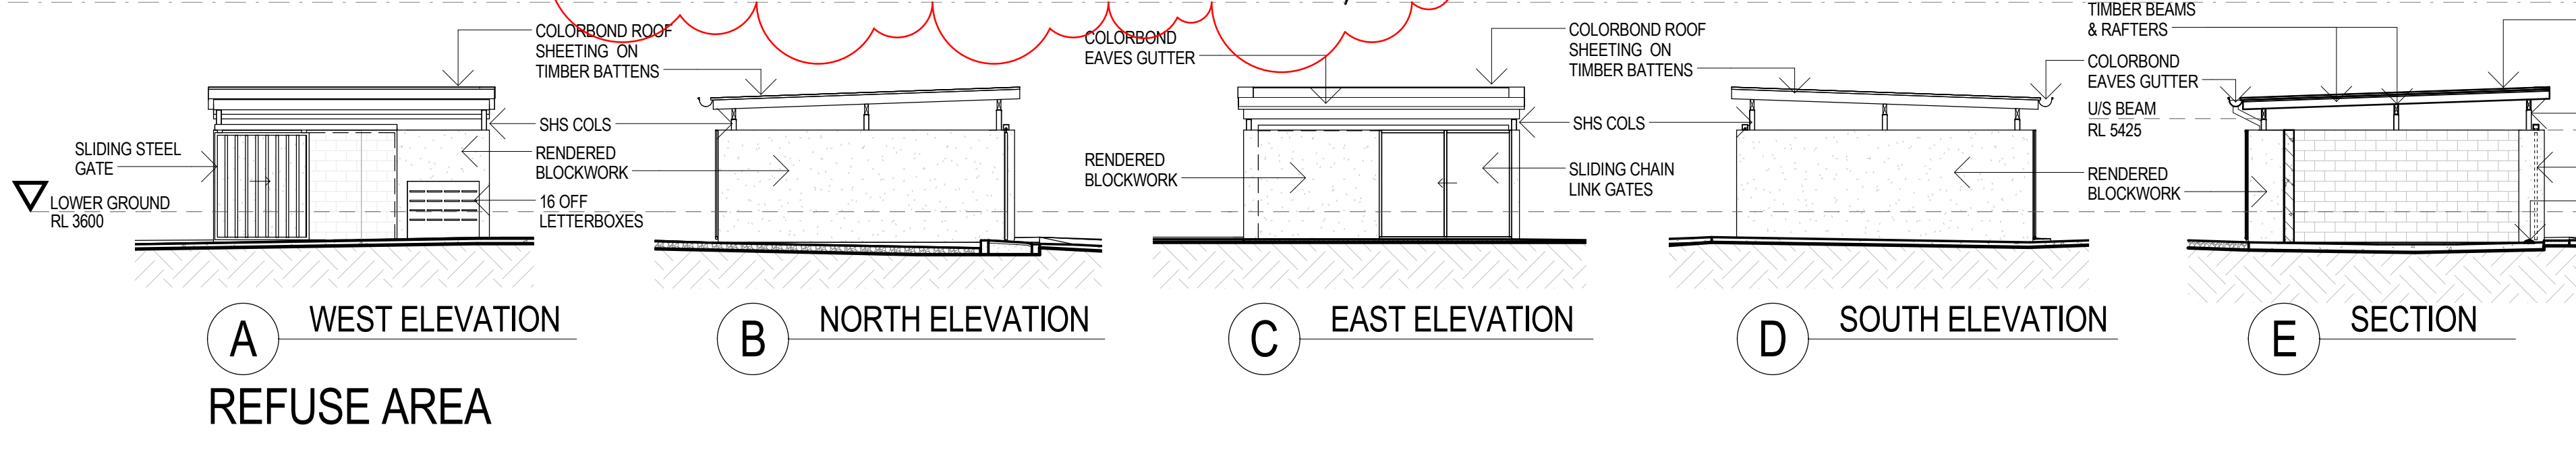

AS CONSTRUCTED



30.08.14 F DRAWING UPDATED

07.05.13 E AS CONSTRUCTED

12.05.12 D 1000mm & RL 4200

02.10.12 C ACCESS DRIVEWAY CHANGES

18.09.12 B REFUSE AREA DETAILS ADDED

05.08.12 A FOR CONSTRUCTION ISSUE

0000 F Revision history

key plan

project client

**WOOLWORTHS**  
**CABARITA**

**TWEED COAST RD,**  
**CABARITA**

FOR  
**MAINBRACE CONSTRUCTIONS**

**Cameron**  
**Chisholm & Nicol**

6/18 Kilmorie Street  
Milton QLD 4054  
GPO Box 2737  
Brisbane QLD 4001  
Telephone (07) 3867 7000  
Facsimile (07) 3307 0942  
info@cameronchisholm.com.au

Drawing title

**LOWER GROUND**  
**LEVEL PART B**  
**FLOOR PLAN**

project no.	Q1201	scale	1 : 100	date	04/10
discipline	AB	sheet no.	1203	rev no.	F