


NOTE: GRID LINE S1 IS PARALLEL TO S2
AND NOT PARALLEL TO BROADWAY

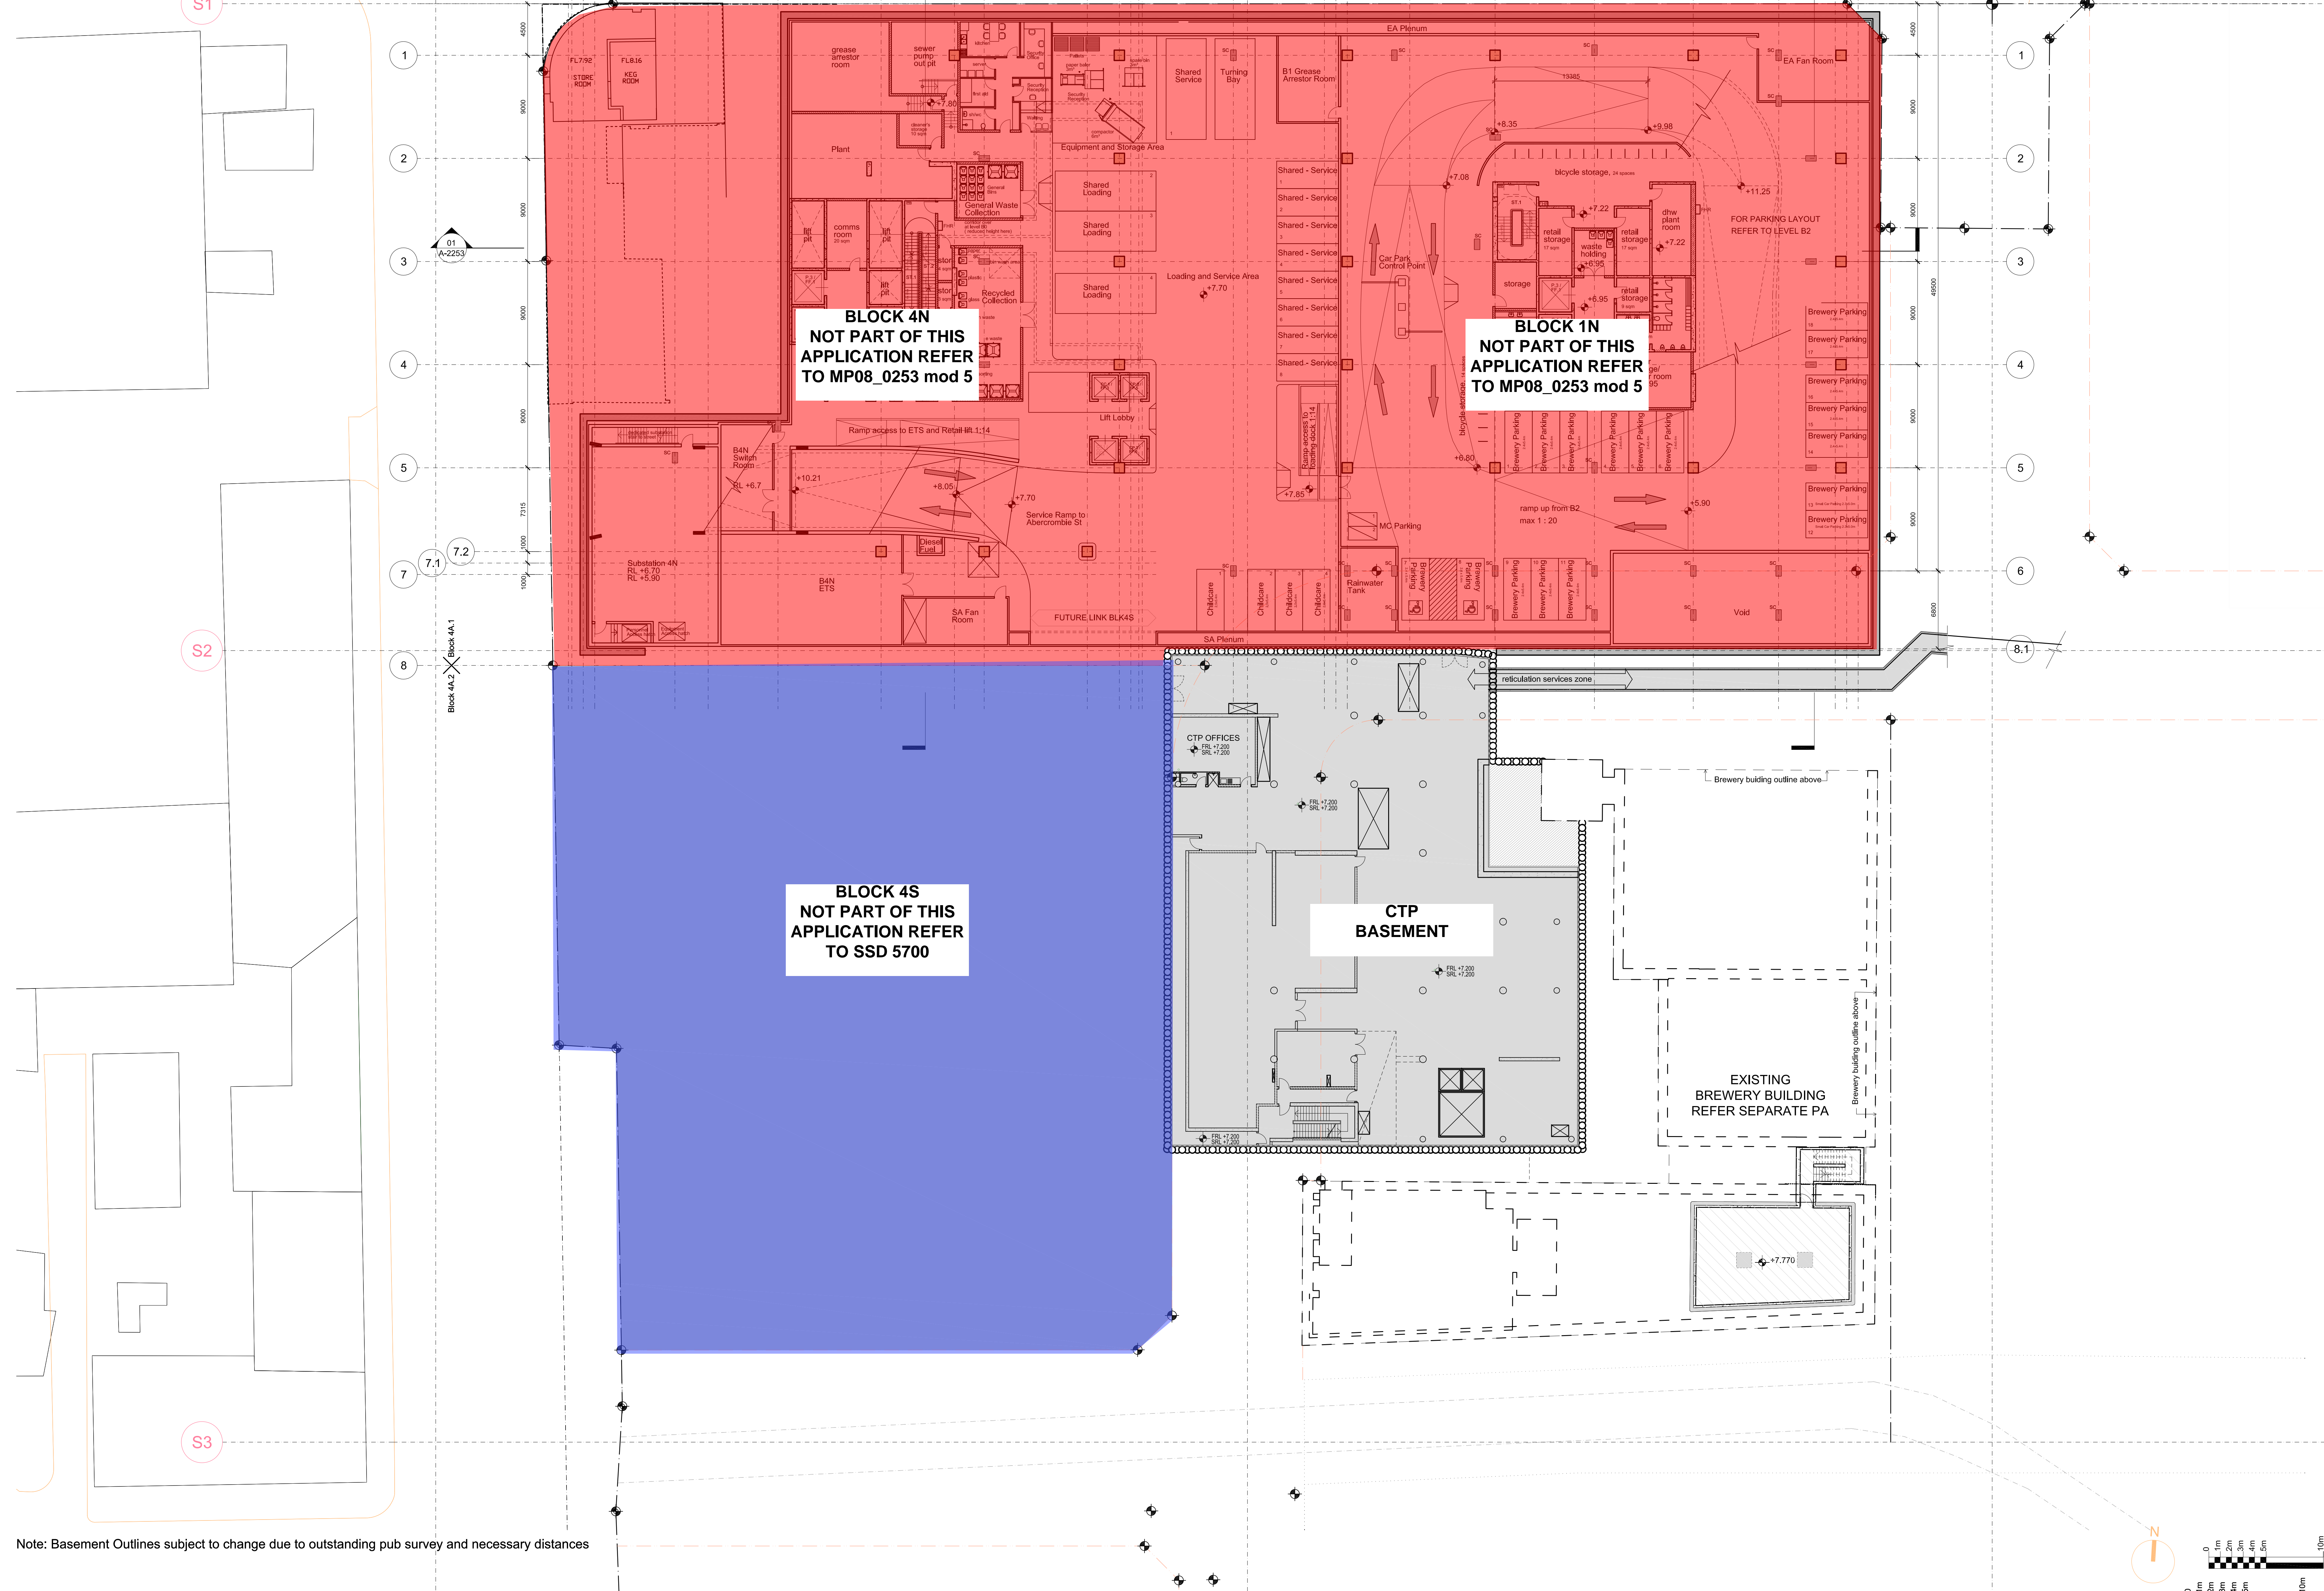

- General Notes
1. Do not scale drawings. Dimensions govern.
 2. All dimensions are in millimetres unless noted otherwise.
 3. All dimensions shall be verified on site before proceeding with the work.
 4. Foster + Partners shall be notified in writing of any discrepancies.
 5. Any areas indicated on this sheet are approximate and indicative only.

Key	
---	Concept plan development boundary
---	PA boundary

Rev.	Date	Reason For Issue	Chk.
09	19/12/12	SW75 IV OD 4 - Final	TB
08	19/12/12	SW75 IV OD 4 - Final	RP
07	19/11/12	SW75 IV OD 4	RP
06	07/09/12	For Information	RP
05	27/01/12	S75w Application-CTP (2 x levels)	
04	11/04/11	S75w Application-CTP	
03	26/05/09	Planning Application Update	
02	21/05/09	Planning Application Update	
01	15/01/09	Planning Application Update	CAD
00	28/11/08	Planning Application	CAD

For information



PROPERTY

Project Frasers Broadway
20 - 102 Broadway Sydney NSW 2000

Client Frasers Broadway
L11, 488 Kent Street Sydney NSW 2000
T: 02 8623 8800 F: 02 8623 8801

Architect
Foster + Partners
Riverside, 22 Hester Road
London SW11 4AN
T +44 (0)20 7738 0455
F +44 (0)20 7738 1107

Local Collaborating Architect
PTW Architects
Level 13, 9 Castlereagh St
Sydney NSW 2000 Australia
T +61 (0)2 92326877
F +61 (0)2 9221 4138
www.ptw.com.au

**FPMA MARK UP OF
MP08_0523 DRAWING
FOR CTP S75W (second
gas engine)**

Title
**Block 1+4
Level B1 - Basement
FFL +6.80**

Project No.	Scale @ A0	Date	Drawn By
1645	1:200	28/11/08	PTW
Number	Revision		
PA - A - 1758	09		