



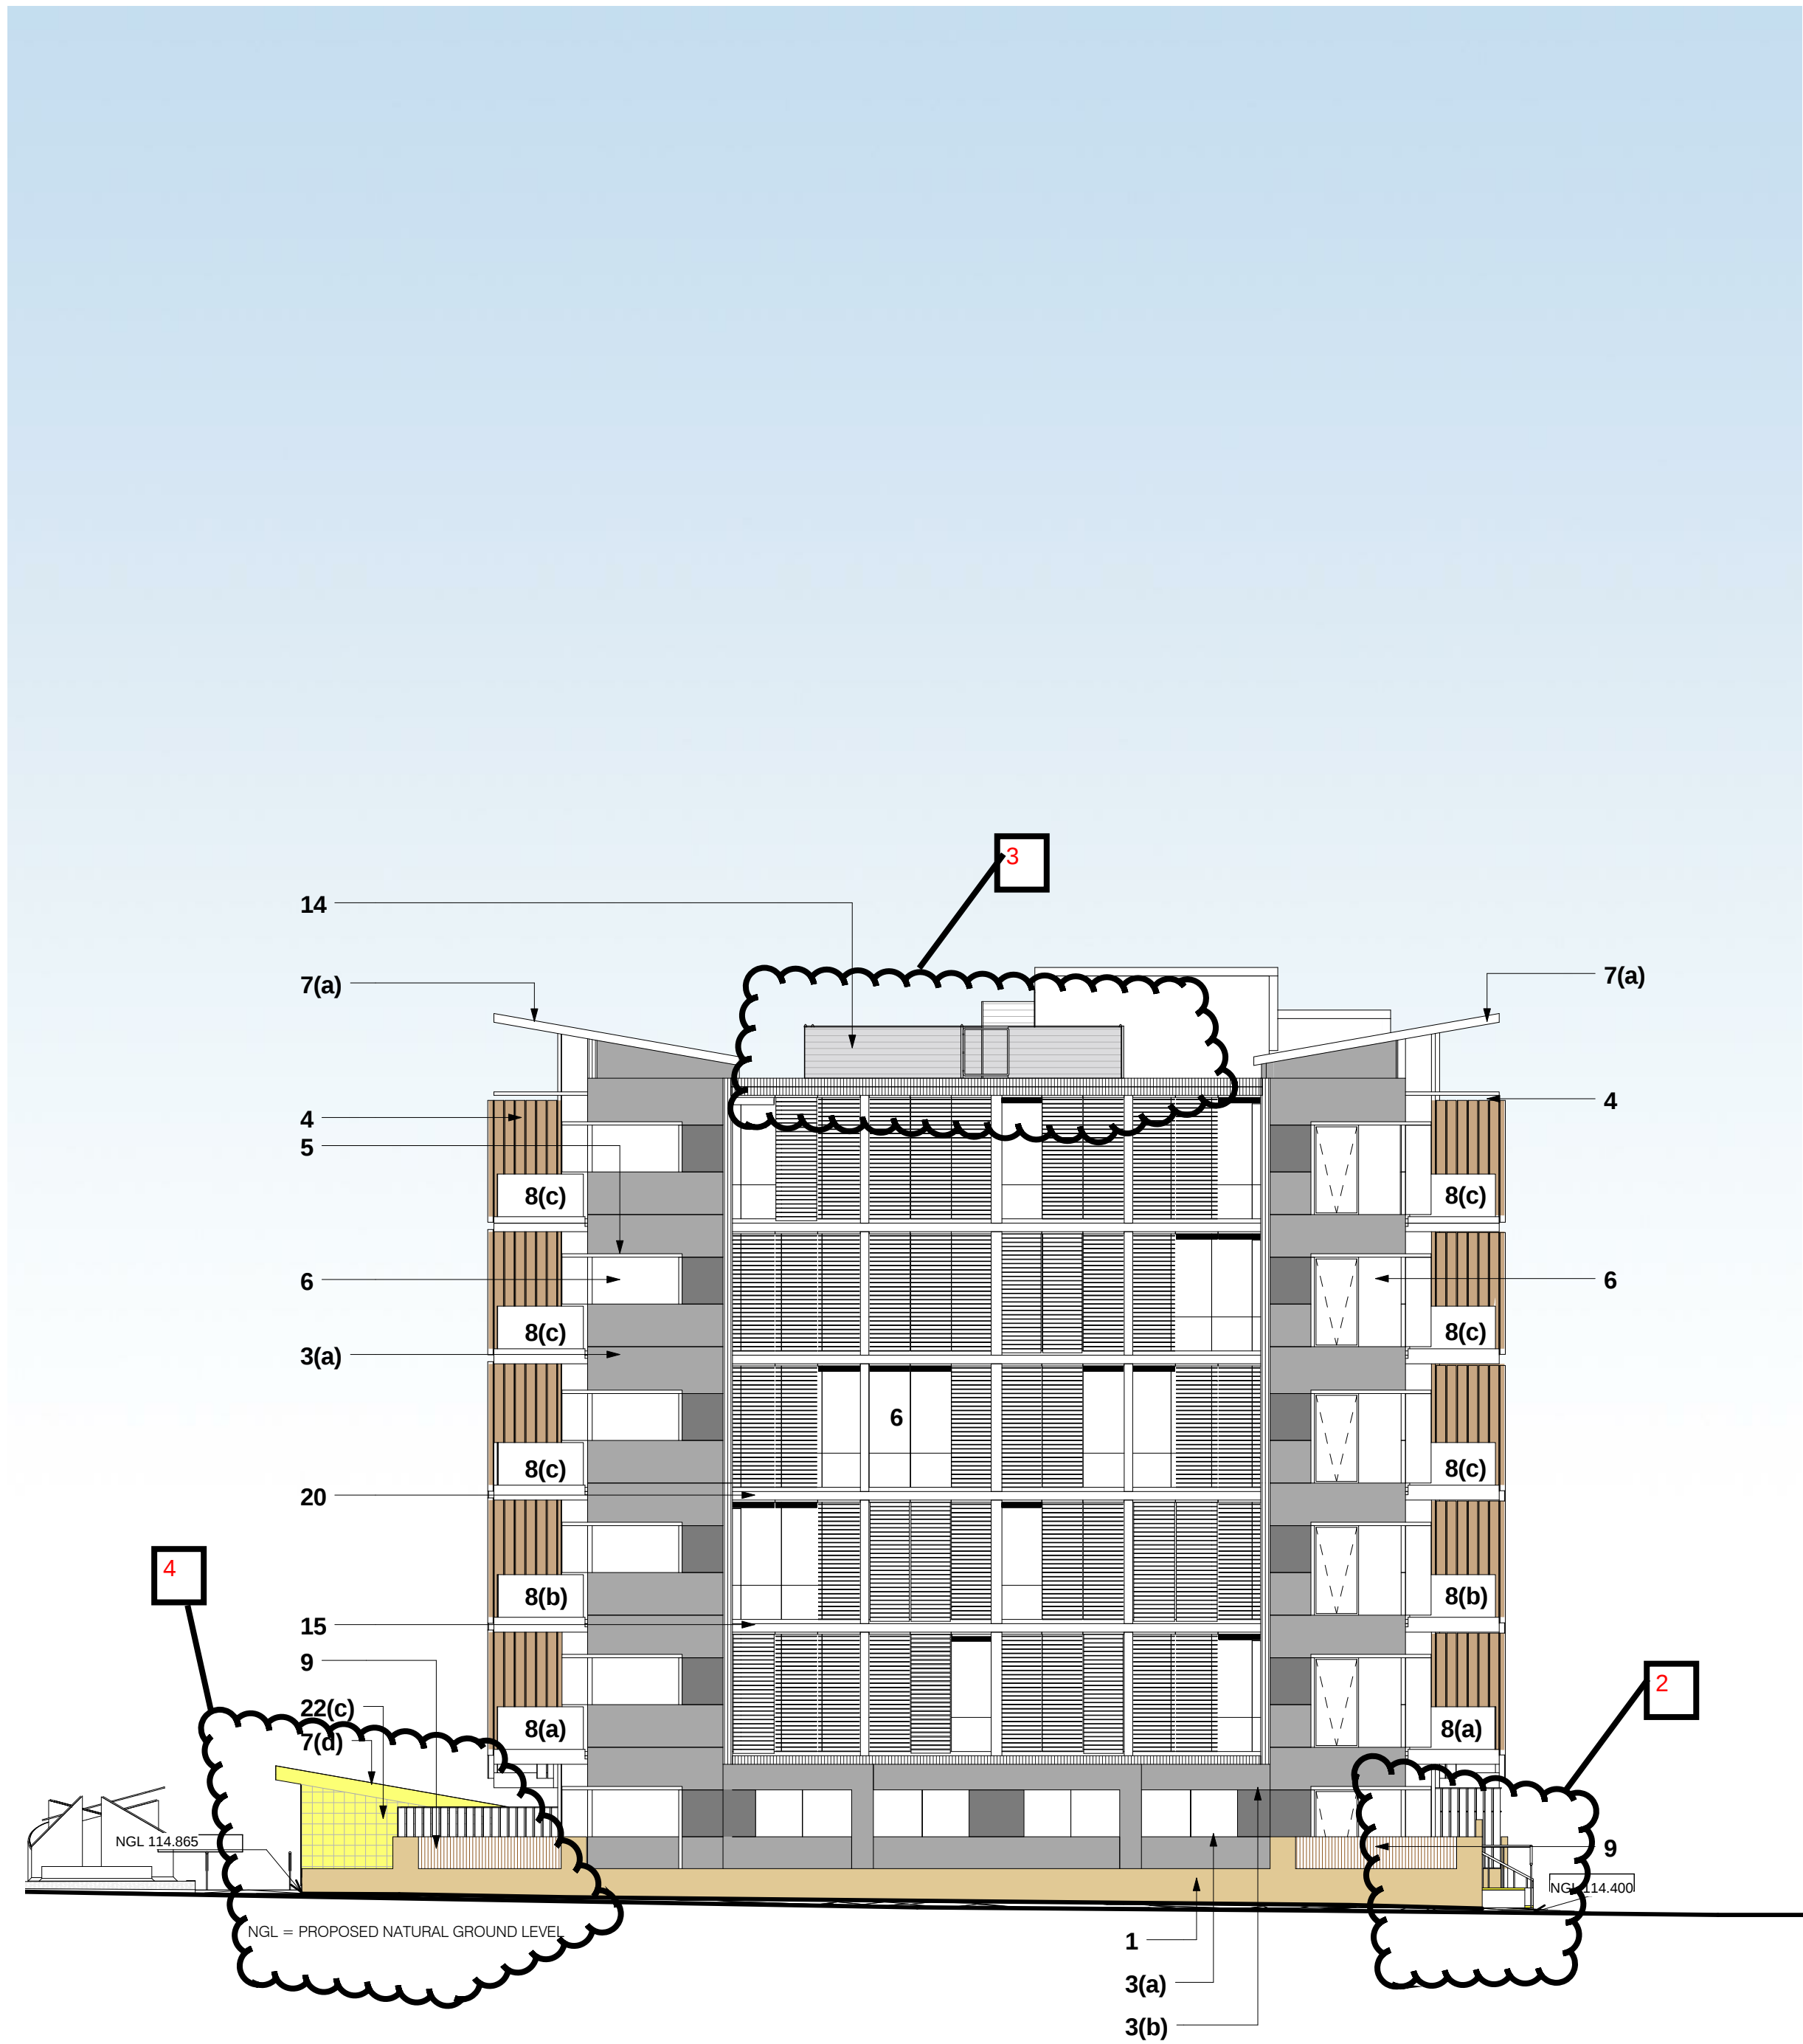

Building 5 Elevation North
SHADOWS SHOWN INDICATIVELY ONLY

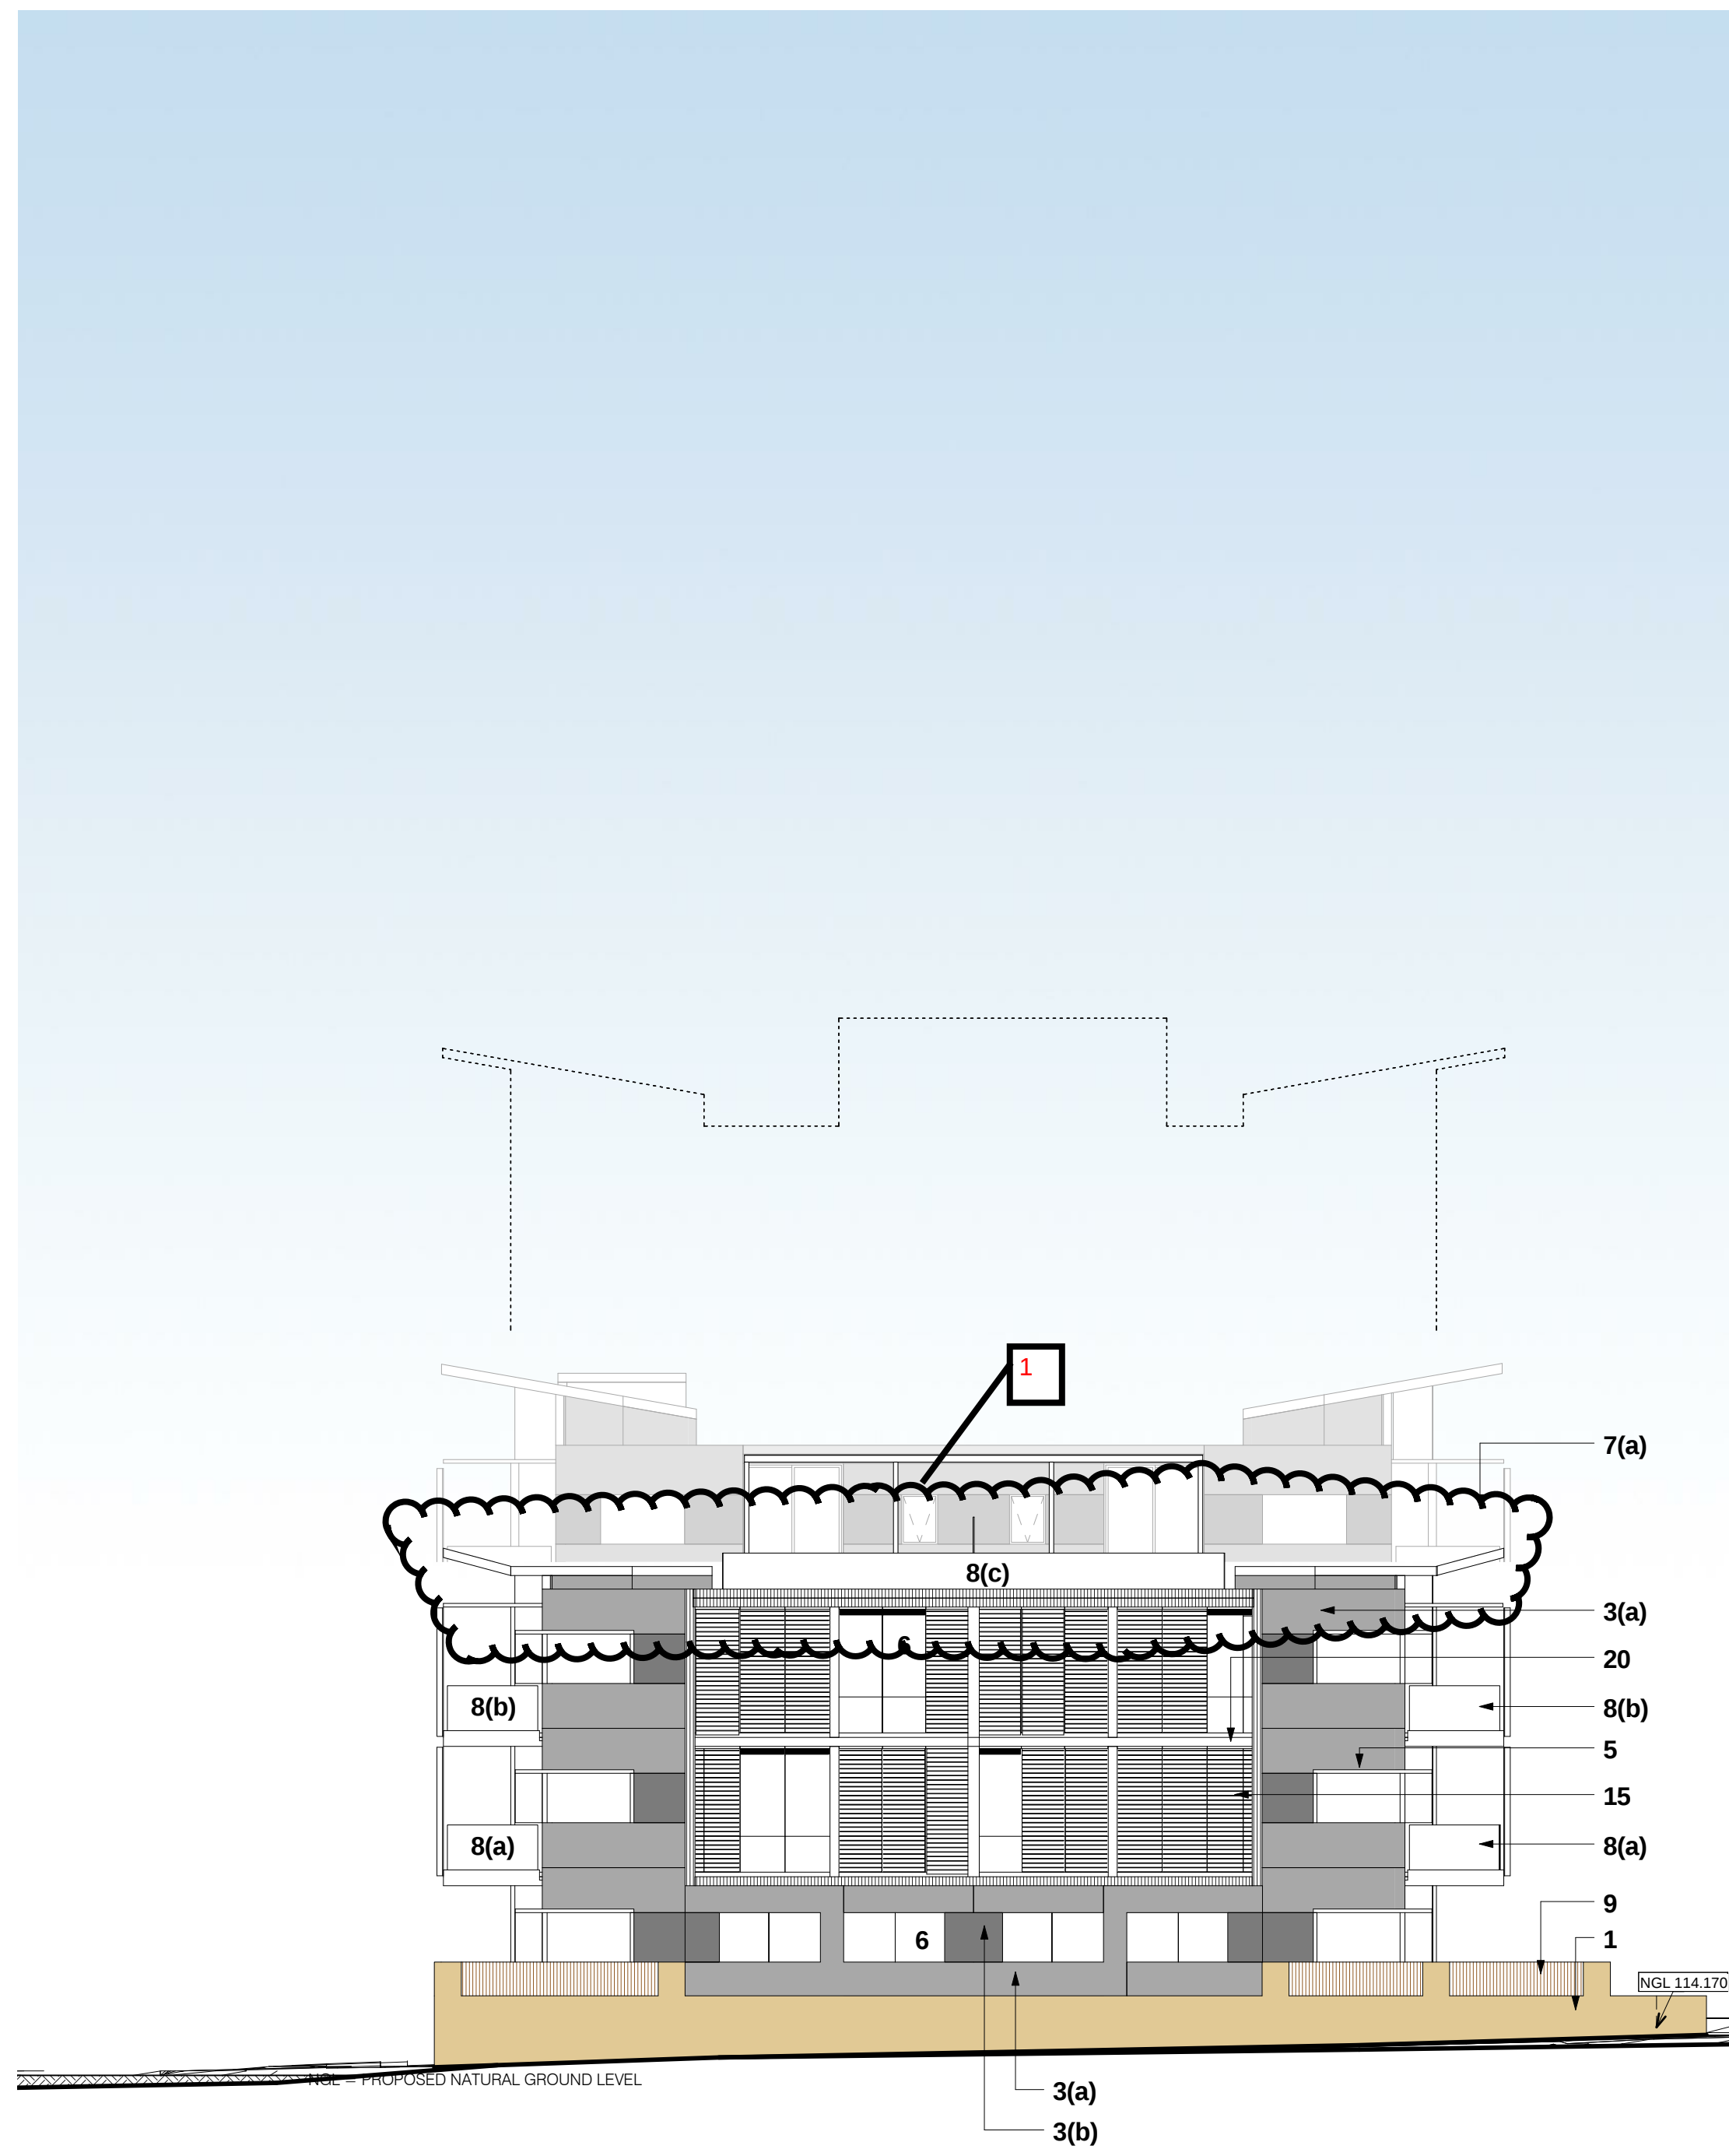

Building 5 Elevation South
SHADOWS SHOWN INDICATIVELY ONLY

LEGEND

- | | | | |
|------|---|----|---|
| 1 | SPLIT FACE CONCRETE BLOCK | 12 | LOBBY GLAZING (VANCEVA GLAZING) |
| 2 | TEXTURED/GROOVED PRECAST CONCRETE PANEL W/ PAINT FINISH | | (a) COLOUR 1 |
| 3 | PRECAST CONCRETE PANEL AND PAINT FINISH | | (b) COLOUR 2 |
| | (a) COLOUR 1 | | (c) COLOUR 3 |
| | (b) COLOUR 2 | | (d) COLOUR 4 |
| 4 | VERTICAL FIXED ALUMINIUM LOUVRES | 13 | LOBBY OPERABLE WINDOW |
| 5 | ALUMINIUM EXTERNAL SUNSHADE | | (a) COLOUR 1 |
| 6 | GLAZING WITH ALUMINIUM FRAMED DOORS AND WINDOWS | | (b) COLOUR 2 |
| 7 | CONCRETE ROOF PAINT FINISH | | (c) COLOUR 3 |
| | (a) COLOUR 1 | | (d) COLOUR 4 |
| | (b) COLOUR 2 | 14 | ROOF PLANT ALUMINIUM LOUVRED SCREENS |
| | (c) COLOUR 3 | 15 | OPERABLE EXTERNAL HORIZONTAL SCREEN |
| | (d) COLOUR 4 | 16 | PAINT FINISH |
| | (e) COLOUR 5 | 17 | METAL BALUSTRADE |
| 8 | ALUMINIUM FRAMED GLASS BALUSTRADE | 18 | CARPARK VENTILATION LOUVRES |
| | (a) OPACITY / TONE 1 | 19 | TRELLIS / PERGOLA |
| | (b) OPACITY / TONE 2 | 20 | SPANDREL PANEL PAINT FINISH |
| | (c) OPACITY / TONE 3 | 21 | GARBAGE ROOM ROLLER SHUTTER |
| 9(a) | FENCE TYPE A - POWDERCOATED ALUM. | 22 | WALL TILES |
| 9(b) | FENCE TYPE B | | (a) COLOUR 1 |
| 11 | LOBBY SPANDREL PANEL | | (b) COLOUR 2 |
| | (a) COLOUR 1 | | (c) COLOUR 3 |
| | (b) COLOUR 2 | | (d) COLOUR 4 |
| | (c) COLOUR 3 | 23 | OPAQUE WINDOW |
| | (d) COLOUR 4 | 24 | CARPARK ENTRY DOOR (MAGIC DOOR INDUSTRY) |
| | | 25 | METAL WALL CLADDING - GALVANISED STEEL COLOUR |

NOTE:

COLOURS NOMINATED ARE DESIGN INTENT AND ARE INDICATIVE ONLY.

 
FINAL BUILDING COLOURS MAY VARY FROM THOSE INDICATED & ARE SUBJECT TO MATERIAL COLOUR AVAILABILITY

NOTE:

PLEASE REFER TO A-4030 AND A-4031 FOR COLOUR SPECIFICATION

NOTE:

- Furniture layout shown indicative only.
- Site and Landscape shown for context only. Refer to Landscape Drawings .

Revision			Revision			Revision			Key Plan			Consultants			Client			Architect			Drawing			Project																										
- PROJECT APPLICATION 28.06.2010			A HEIGHT MARKUP 16.08.2010			B UPDATE DRAWING SECTION 75W ISSUE 14.04.2011						Landscape Architects Sturt Associates Suite 91, Level 5, 330 Watlie Street, Ultimo NSW 2007 Tel : 9211 3744			Waste Management Elephants Foot 60B Kent Road, Mascot NSW 2020 Tel : 9667 4881			Structural Meriton Level 11, 528 Kent Street, NSW 2000 Tel : 9287 2888			Daylight/Solar Access Heggies 2 Lincon Street, Lane Cove NSW 2066 Tel : 9427 6100			Traffic Halcrow Suite 20, 809 Pacific HWY, Chateau NSW 2067 Tel : 9410 4100			Nathans/Basix Efficient Living 24B/176 South Creek Road, Cromer NSW 2099 Tel : 9944 0332			Meriton Apartments Pty Ltd			PTW Architects			Level 11, 528 Kent Street Sydney NSW 2000 T (02) 92872888 F (02) 92872777 www.meriton.com.au			Level 17, 9 Castlereagh St Sydney NSW Australia 2000 T 612 9292 5877 F 612 9221 4139 www.ptw.com.au			PROJ NO : 209002.3 SCALE : 1:100 @A0 DATE : 02.06.2010			Epping Park 61 Mobbs Lane, Epping Stage 1 (Building 4+5)			REVISION B		
Do not scale from drawings. Verify all dimensions on site before commencing work. Copying or the reproduction of this drawing is strictly prohibited without the consent of Peddie Thorp & Walker P/L.																					PTW			Title Building 5 North & South Elevations			APPROVED: SP			A5202 SECTION 75W ISSUE																				
																								1 2 1:100 @ A0																										