


MP_09_0153-01-75w submission
Floor plan mark-ups

Level 1 - no changes

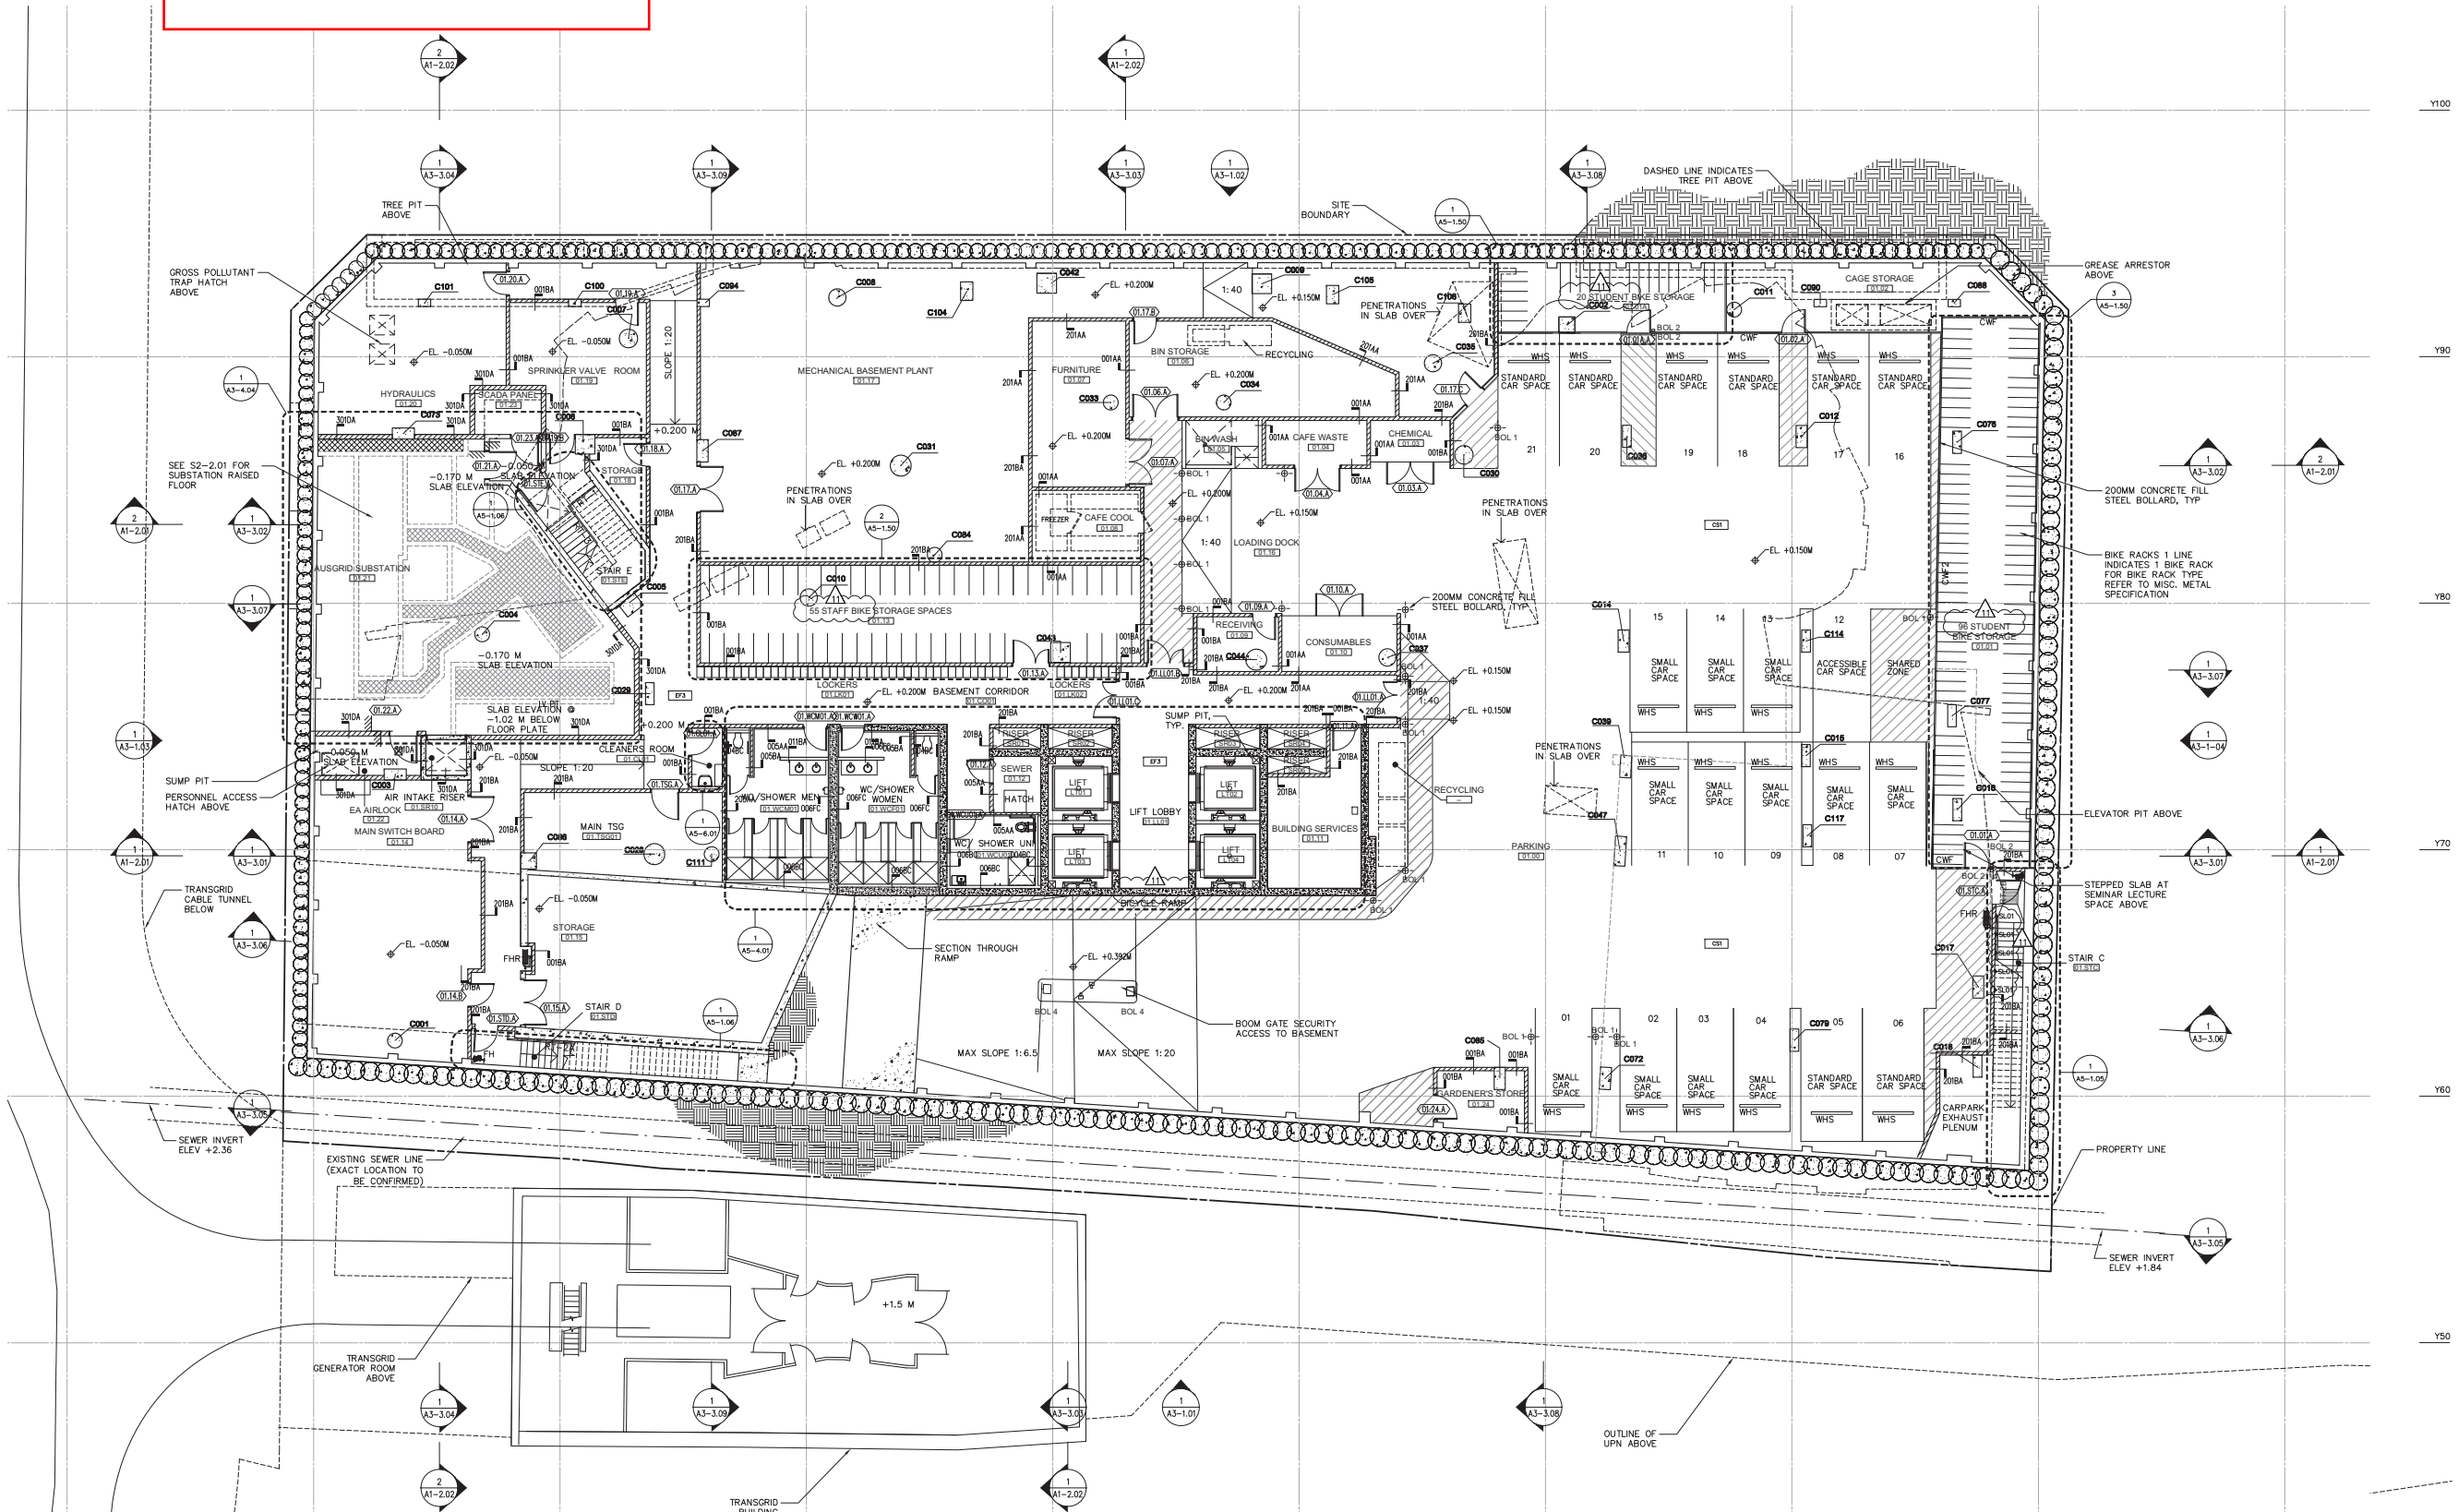

MISC. METALWORK LEGEND	RAIL & BALUSTRADE LEGEND	ROOF LEGEND	ELEVATION LEGEND	SYMBOL LEGEND	FLOOR TYPES	GENERAL NOTES
BOL FOR BOLLARD TYPES REFER TO A5-1.60 CWF FOR CHAIN WIRE FENCE DETAILS REFER TO A5-1.50 CWS FOR CAR WHEELSTOP DETAILS REFER TO A5-1.60	1. SEE A5-1.2X SERIES FOR RAILING AND BALUSTRADE DETAILS 2. RAILINGS WITH INTEGRATED LIGHTING CONTAIN "L" IN THEIR NOMENCLATURE. EXAMPLE: BT-6L BT-1 EXT. GLASS BALUSTRADE BT-2 PB BALUSTRADE WITH PLYWOOD CAP PTD STEEL HANDRAIL BT-3 FEATURE BALUSTRADE WITH SS HANDRAIL BT-4 GLASS BALUSTRADE WITH SS HANDRAIL ON GULUM TIMBER BT-5 PLYWOOD BALUSTRADE WITH PTD. STL. HANDRAIL BT-6 PAINTED STEEL BALUSTRADE BT-7 PB BALUSTRADE WITH PLYWOOD CAP AND PTD. STL. HANDRAIL BT-8 PB BALUSTRADE WITH PLYWOOD CAP AND PTD STEEL HANDRAIL BT-9 INTERNAL GLASS BALUSTRADE BT-10 PAINTED SS HANDRAIL BT-11 INT. WALL MTD. PTD. STL. HANDRAIL BT-12 EXT. WALL MTD. SS HANDRAIL BT-13 PAINTED STEEL HANDRAIL BT-14 EXT. SS GUARDRAIL	PLANTING AREA AREA DRAIN PLANTER DRAIN ROOF DRAIN DIRECTION OF SLOPE DAVT PEDAL FLOOR BOXES FIRE HYDRANTS FIRE HOSE REEL	EL = +X-X' (TOP OF FF) NOTE: IF STRUCT. IS EXPOSED, F.F. = TOP OF STRUCT. ELEV CHANGE IN STRUCT. SLAB EL +5.00M EXT. SPOT ELEVATION	DOOR ID TAG INTERIOR WINDOW ID TAG PARTITION ID TAG COLUMN ID TAG WORKSTATION ID WINDOW BOX TAG SEE A4-4.02 FOR WINDOW BOX SCHEDULE	FOR FURTHER FLOOR FINISHES, REFER TO A6-3 SERIES FLOOR FINISHES SCHEDULE [PAV-1] ASPHALT PAVEMENT TYPE 1 [CPT-1] CARPET TYPE 1 - CARPET TILE [CPT-2] CARPET TYPE 1 - BROADLOOM [TR-1] TIMBER - RED OAK [RES-1] RESILIENT FLOOR FINISHES - TYPE 1 [EP-3] EPOXY FINISHES - TYPE 3 [CS-1] CONCRETE SEALER SEE A0-1.04 FOR EXTERIOR SYSTEMS [BPM] BROOM FINISH CONCRETE [EP-2] EXT. PAVING ASSEMBLY TYPE 2 [EP-3] EXT. PAVING ASSEMBLY TYPE 3 [EP-4] EXT. PAVING ASSEMBLY TYPE 4	1. SEE A6-2 SERIES FOR PARTITION TYPES 2. SEE A6-3 SERIES FOR INTERIOR FINISH SCHEDULE 3. SEE A6-4 SERIES FOR INTERIOR DOOR SCHEDULE 4. SEE A6-5 SERIES FOR INTERIOR WINDOW SCHEDULE 5. SEE A6-2 SERIES FOR FURNITURE PLANS 6. SEE A0-2.1 SERIES FIRE-RATED WALL DIAGRAMS 7. SEE A0-4.1 FOR NOISE CRITICAL WALL, FLOOR AND ROOF DIAGRAMS 8. SEE A1-1.02 FOR SITE INFORMATION 9. SEE ELECTRICAL DRAWINGS FOR ALL LIGHTING FIXTURE TYPES, SCHEDULES, SPECIFICATION & CIRCUITING 10. SEE A4 SERIES FOR EXTERIOR WALL SYSTEMS 11. REFER TO 3D DATABASE FOR DIMENSIONAL CONTROL OF ALL CONCRETE ELEMENTS 12. SEE A2-4 SERIES FOR CONCRETE PLAN SETOUT DWG. 13. SEE A4-6.01 FOR EXT. DOOR AND LOUVER SCHED. 14. SEE A0-1 SERIES FOR MATERIALS SYSTEMS LEGEND

GEHRY PARTNERS, LLP.
DESIGN ARCHITECT
12541 BEATRICE STREET
LOS ANGELES, CALIFORNIA 90066 USA
TEL: 310-482-3000
FAX: 310-482-3008
EXECUTIVE ARCHITECT
84 ROSE STREET
CHIPPENDALE, NSW 2008
TEL: +61 (2) 9377 1051
FAX: +61 (2) 9377 1080
NOMINATED ARCHITECT: ROBIN DYKE
NSW REG NO. 3739
UTS
University of Technology, Sydney
FACILITIES MANAGEMENT OPERATIONS
BUILDING 1, LEVEL 19, 15 BROADWAY
Broadway NSW 2007
Ph: 9514-2830 Fax: 9514-4690

HIGHGATE MANAGEMENT
PROJECT MANAGER
08/10 LOTUS STREET
CAMPSBORN, NSW 2050
TEL: +61 (2) 9377 1051
FAX: +61 (2) 9377 1080
ARUP
STRUCTURAL CONSULTANT
201 KENT STREET
SYDNEY, NSW 2000
TEL: +61 (2) 9320 9320
FAX: +61 (2) 9320 9321
AECOM
BUILDING SERVICES CONSULTANT
LEVEL 21, 420 GEORGE ST
SYDNEY, NSW 2000
TEL: +61 (2) 9254 0000
FAX: +61 (2) 9254 0001
L'OBSEVATOIRE INTERNATIONAL
LIGHTING DESIGN CONSULTANT
295 LAFAYETTE STREET, SUITE 915
NEW YORK, NY 10012 USA
TEL: +1 (212) 255 4463
FAX: +1 (212) 255 8348
QUANTITY SURVEYOR
RIDER LEVETT BUCKNALL NSW PTY LTD
41 MCLEOD STREET
SYDNEY, NSW 2060
AUSTRALIA
TEL: +61 (2) 9622 2277
FAX: +61 (2) 9622 4197
MARSHALL DAY ACOUSTICS
ACOUSTICAL CONSULTANT
SUITE 4, 46 BALFOUR STREET
CHIPPENDALE, NSW 2008
TEL: +61 (2) 9282 8422
FAX: +61 (2) 9281 3611
MORRIS GODDING ACCESSIBILITY CONSULTING
ACCESSIBILITY CONSULTANT
STUDIO 106/56 BOHMAN STREET
PYRMONT, NSW 2009
TEL: +61 (2) 9692 9322
FAX: +61 (2) 9692 9433
BLACKETT MAGUIRE + GOLDSMITH
CODE CONSULTANT
SUITE 2.01, 22-26 MOUNTAIN STREET
ULTIMO NSW 2007
TEL: +61 (2) 9211 7777
FAX: +61 (2) 9211 7774

NO. ISSUE	DATE
50% SCHEMATIC DESIGN	06 OCT 10
SCHEMATIC DESIGN ISSUE	10 DEC 10
50% DESIGN DEVELOPMENT	08 APR 11
DESIGN DEVELOPMENT ISSUE	01 JUL 11
01 CD PHASE PROGRESS ISSUE	02 SEP 11
02 CD PHASE PROGRESS ISSUE	21 OCT 11
03 CD PHASE PROGRESS ISSUE	09 DEC 11
04 ISSUE FOR TENDER	12 JAN 12
- ALL INTERMEDIATE REVISIONS NOT USED -	
10 ISSUE FOR CONSTRUCTION	30 MAR 12
11 DR-001	22 MAY 12

PROJECT NAME
UTS
DR CHAU CHAK WING
BUILDING
SYDNEY, AUSTRALIA

DRAWING TITLE
CITY CAMPUS HAYMARKET
DR CHAU CHAK WING BUILDING
LEVEL_01 ARCH PLAN

CONSULTANTS DRAWING NAME
FIRST FLOOR PLAN
BASEMENT LEVEL


CONSULTANTS DRAWING NUMBER	CONSULTANT PROJECT NO.
A2-2.01	2009-022
FNO PROJECT NUMBER	CONSULTANT PROJECT NO.
02106-09	2009-022
DRAWN BY	CHECKED
EH	DB
DATE APP.	DATE APP.
30 MAY 12	30 MAY 12
DRAWING STATUS	SHEET SIZE
IFC	A0
UTS DRG FILE NAME	DRAWING SCALE
CM1201AP	1:100
UTS DRG FILE NO	REV NO.
26201	11

© GEHRY PARTNERS, LLP

Level 2 - no changes

DESIGN ARCHITECT
12541 BEATRICE STREET
LOS ANGELES, CALIFORNIA 90066 USA
TEL: 310-482-3000
FAX: 310-482-3006

DARYL JACKSON ROBIN DYKE ARCHITECTS
EXECUTIVE ARCHITECT
64 ROSE STREET
CHIPPENDALE, NSW 2008
TEL +61 (2) 9319 2955
NOMINATED ARCHITECT: ROBIN DYKE
NSW REG. NO. 3719

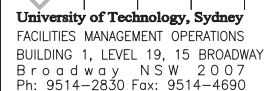

HIGH-GATE MANAGEMENT
PROJECT MANAGERS
LOW 10 LOTUS STREET
CAMDEN, NSW 2050
TEL +61 (2) 9377 1051
FAX +61 (2) 9377 1088
ARUP
STRUCTURAL CONSULTANT
201 KENT STREET
SYDNEY, NSW 2000
TEL +61 (2) 9320 9320
FAX +61 (2) 9320 9321
AECOM
BUILDING SERVICES CONSULTANT
LEVEL 21, 420 GEORGE ST
SYDNEY, NSW 2000
TEL +61 (2) 8534 0000
FAX +61 (2) 8534 0001
L'OBSERVATOIRE INTERNATIONAL
LIGHTING DESIGN CONSULTANT
25 LAKE STREET, SUITE 915
NEW YORK NY 10012 U.S.A.
TEL +1 (212) 255 4463
FAX +1 (212) 255 8346
RIDER LEVETT BELLMAN NSW PTY LTD
QUANTITY SURVEYOR
41 MCILHARE STREET
NORTH SYDNEY, NSW 2060
AUSTRALIA
TEL +61 (2) 9922 2277
FAX +61 (2) 9957 4197
MARSHALL DAY ACOUSTICS
ACOUSTICAL CONSULTANT
SUITE 46 BALFOUR STREET
CHIPPENDALE NSW 2008
AUSTRALIA
TEL +61 (2) 9528 9422
FAX +61 (2) 9281 3611
MORRIS GOSWOLD ACCESSIBILITY CONSULTING
ACCESSIBILITY CONSULTANT
STUDIO 106/56 BOMAN STREET
FREMONT NSW 2160
TEL +61 (2) 8692 9322
FAX +61 (2) 8692 8433
BLACKMORES ACQUISURE + GOLDSMITH
CODE CONSULTANT
SUITE 2.01, 22-26 MOUNTAIN STREET
ULTIMO NSW 2007
TEL +61 (2) 9211 7773
FAX +61 (2) 9211 7773

[illegible]

PROJECT NAME

**UTS
DR CHAU CHAK WING
BUILDING**

SYDNEY, AUSTRALIA

DRAWING TITLE

**CITY CAMPUS HAYMARKET
DR CHAU CHAK WING BUILDING
LEVELS 02 ARCH PLAN**

CONSULTANTS DRAWING NAME


SECOND FLOOR GROUND LEVEL

CONSULTANTS DRAWING NUMBER
A8-2.02

PMO PROJECT NUMBER		CONSULTANT PROJECT NO.	
02106-09		2009-022	
DRAWN BY	CHECKED	APP. BY	DATE APP.
YL	DB	DB	30 MAY 12
DRAWING STATUS			SHEET SIZE
IFC			A0
UTS DRG FILE NAME			DRAWING SCALE
CM1202AP			1:100
UTS DRG FILE NO			REV NO.
26812			11

MP_09_0153-01-75w submission
Floor plan mark-ups

Level 3 - changes to eastern facade
stair

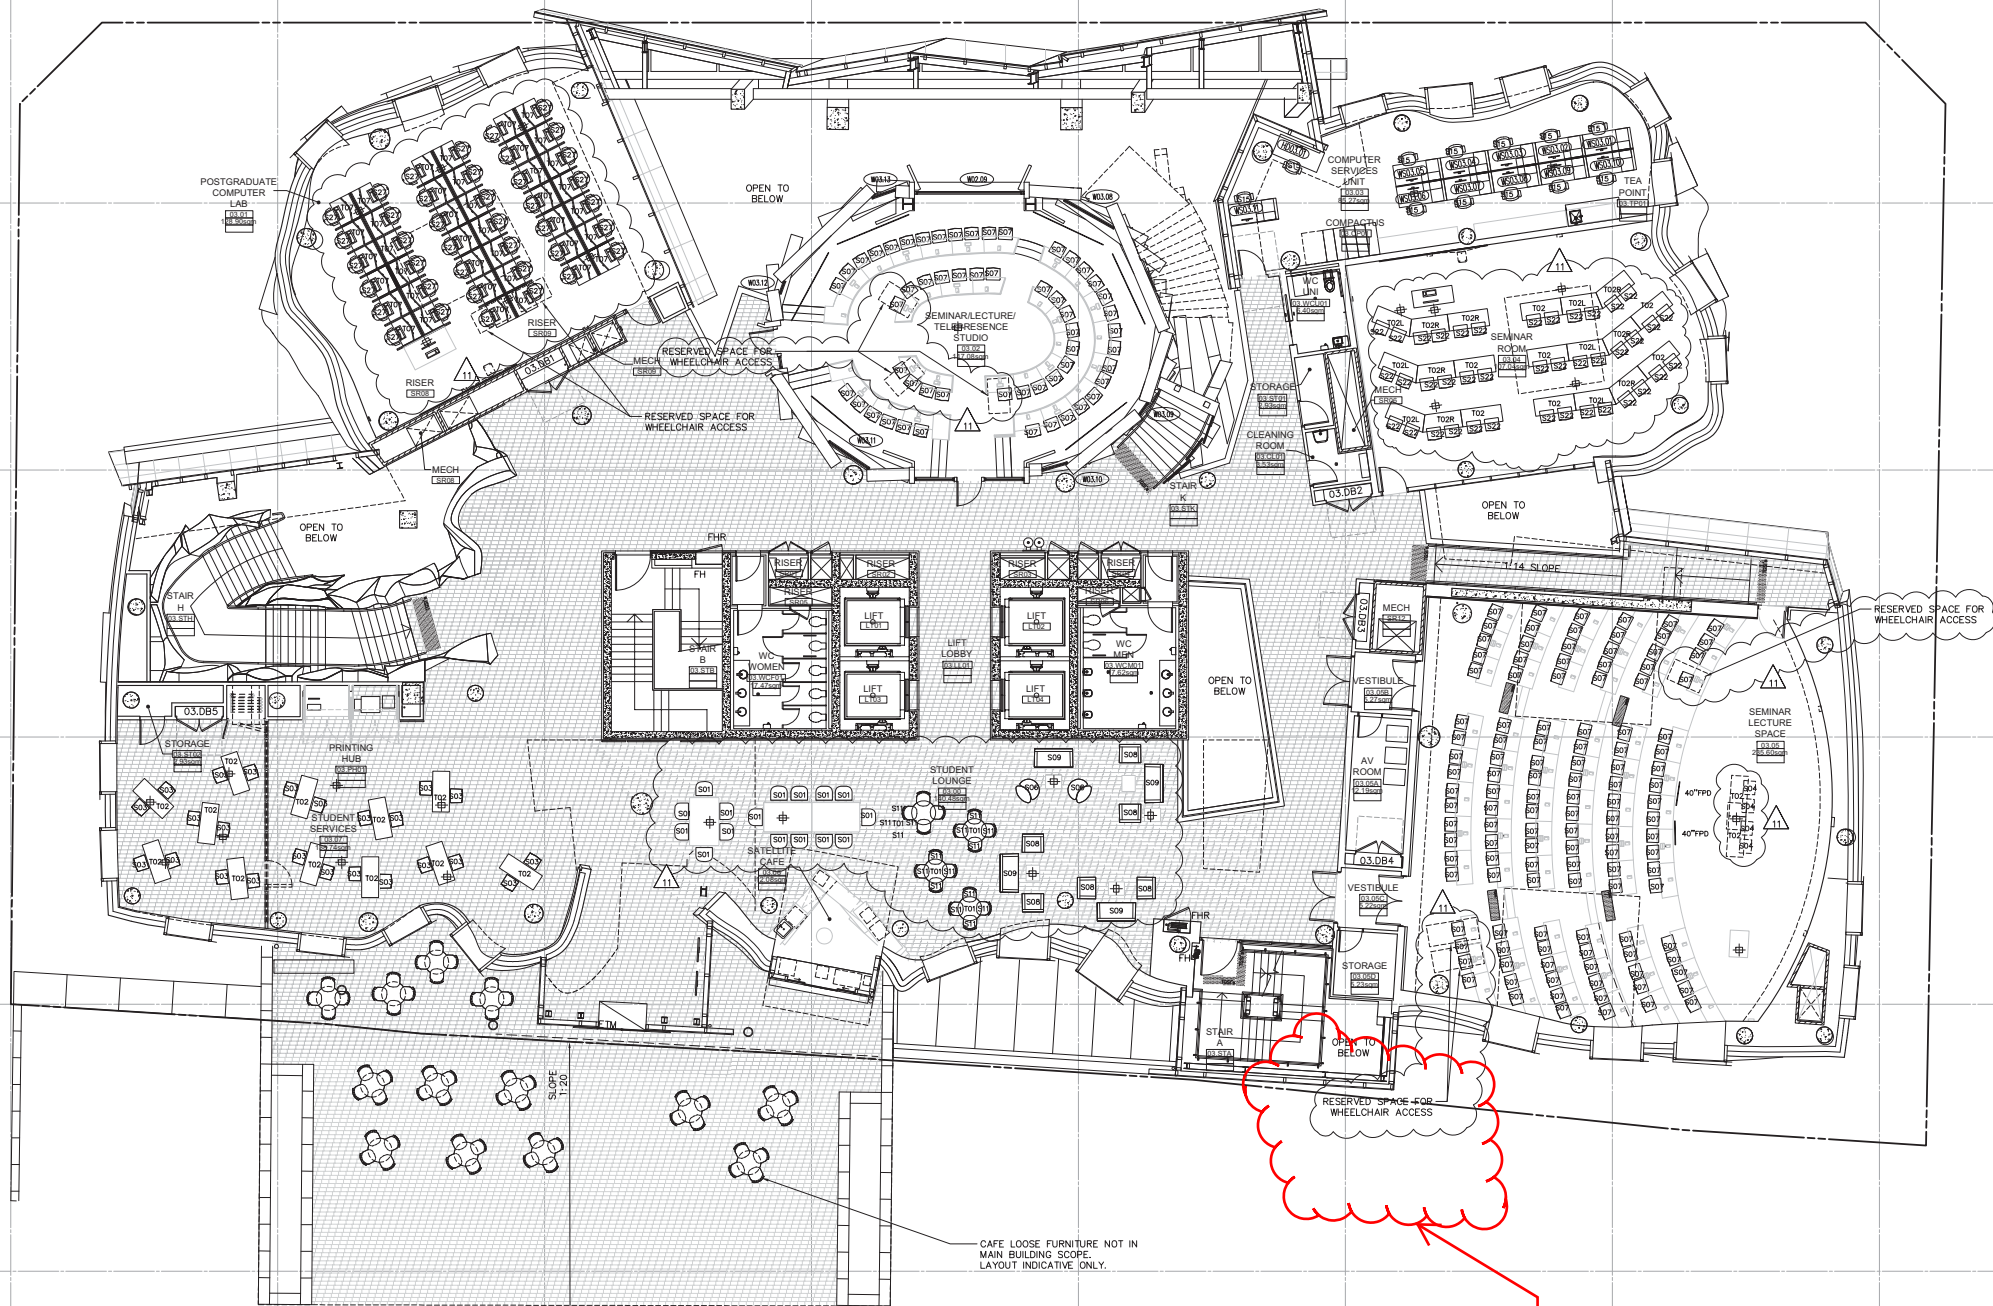

GEHRY PARTNERS, LLP.
DESIGN ARCHITECT
12541 BEATRICE STREET
LOS ANGELES, CALIFORNIA 90066 USA
TEL: 310-482-3008
FAX: 310-482-3006

DARYL JACKSON ROBIN DYKE ARCHITECTS
EXECUTIVE ARCHITECT
64 ROSE STREET
CHIPPENDALE, NSW 2008
TEL: +61 (2) 9319 2955
NOMINATED ARCHITECT: ROBIN DYKE
NSW REG NO. 3739

UTS
University of Technology, Sydney
FACILITIES MANAGEMENT OPERATIONS
BUILDING 1, LEVEL 19, 15 BROADWAY
Broadway NSW 2007
Ph: 9514-2830 Fax: 9514-4690

- HIGHGATE MANAGEMENT
PROJECT MANAGERS
109/10 LOTUS STREET
CAMPERDOWN, NSW 2050
TEL: +61 (2) 9377 1051
FAX: +61 (2) 9377 1080
ARUP
STRUCTURAL CONSULTANT
201 KENT STREET
SYDNEY, NSW 2000
TEL: +61 (2) 9330 9320
FAX: +61 (2) 9320 9321
AECOM
BUILDING SERVICES CONSULTANT
LEVEL 21, 420 GEORGE ST
SYDNEY, NSW 2000
TEL: +61 (2) 8934 0000
FAX: +61 (2) 8934 0001
L'OBSERVATOIRE INTERNATIONAL
LIGHTING DESIGN CONSULTANT
295 LAFAYETTE STREET, SUITE 915
NEW YORK NY 10012
USA
TEL: +1 (212) 255 4463
FAX: +1 (212) 255 8346
RIDER LEVETT BUCKNALL NSW PTY LTD
QUANTITY SURVEYOR
41 MCILKIN STREET
NORTH SYDNEY, NSW 2060
AUSTRALIA
TEL: +61 (2) 9922 2277
FAX: +61 (2) 9957 4197
MARSHALL DAY ACoustICS
ACOUSTICAL CONSULTANT
SUITE 46 BAUFOR STREET
CHIPPENDALE NSW 2008
TEL: +61 (2) 9282 9422
FAX: +61 (2) 9281 3611
MORRIS GODDING ACCESSIBILITY CONSULTING
ACCESSIBILITY CONSULTANT
PYRMONT NSW 2009
TEL: +61 (2) 9492 9322
FAX: +61 (2) 9692 8433
BLACKETT MAGUIRE + GOLDSMITH
CODE CONSULTANT
SUITE 2.01, 22-36 MOUNTAIN STREET
ULTIMO NSW 2007
TEL: +61 (2) 9211 7777
FAX: +61 (2) 9211 7774

NO.	ISSUE	DATE
1	50R SCHEMATIC DESIGN	06 OCT 10
2	SCHEMATIC DESIGN ISSUE	10 DEC 10
3	PROGRESS ISSUE	11 JAN 11
4	50R DESIGN DEVELOPMENT	08 APR 11
5	DESIGN DEVELOPMENT ISSUE	01 JUL 11
6	01 CD PHASE PROGRESS ISSUE	02 SEP 11
7	02 CD PHASE PROGRESS ISSUE 02	21 OCT 11
8	03 CD PHASE PROGRESS ISSUE 03	09 DEC 11
9	04 ISSUE FOR TENDER	31 JAN 12
10	- ALL INTERMEDIATE REVISIONS NOT USED -	
11	10 ISSUE FOR CONSTRUCTION	30 MAR 12
12	11 DR-001	30 MAY 12

PROJECT NAME
**UTS
DR CHAU CHAK WING
BUILDING**
SYDNEY, AUSTRALIA

DRAWING TITLE
**CITY CAMPUS HAYMARKET
DR CHAU CHAK WING BUILDING
LEVELS_02 ARCH PLAN**

CONSULTANTS DRAWING NAME
THIRD FLOOR UPN LEVEL

CONSULTANTS DRAWING NUMBER A8-2.03	
PNO PROJECT NUMBER 02106-09	CONSULTANT PROJECT NO. 2009-022
DRAWN BY YL	CHECKED DB
APP. BY DB	DATE APP. 30 MAY 12
DRAWING STATUS IFC	SHEET SIZE A0
UTS DRG FILE NAME CM1203AP	DRAWING SCALE 1:100
UTS DRG FILE NO. 26813	REV NO. 11

Level 4 - changes to fly bys and brick geometry

Brickwork
geometry slightly
flattened.

Brickwork
geometry slightly
flattened.

Fly by reduced

JEHRY PARTNERS, LLP.
DESIGN ARCHITECTS
12541 BEATRICE STREET
LOS ANGELES, CALIFORNIA 90066 USA
TEL: 310-482-3000
FAX: 310-482-3006

DARYL JACKSON ROBIN DYKE ARCHITECTS
EXECUTIVE ARCHITECTS
64 ROSE STREET
CHIPPENDALE NSW 2008
TEL: +61 (0) 9319 2955
FAX: +61 (0) 9319 2955
WWW.ARCHITECTS-ROBIN-DYKE.COM
NSW REG NO. 3739

T S

University of Technology, Sydney
FACILITIES MANAGEMENT OPERATIONS
BUILDING 1, LEVEL 19, 15 BROADWAY
Broadway NSW 2007
Ph: 9514-2830 Fax: 9514-4690

HIGHGATE MANAGEMENT
PROJECT MANAGERS
109/1 LOFTUS STREET
CAMPERDOWN NSW 2050
TEL: +61 (0) 9377 1051
FAX: +61 (0) 9377 1080
ARUP

STRUCTURAL CONSULTANT
201 HENT STREET
SYDNEY NSW 2000
TEL: +61 (0) 9320 8300
FAX: +61 (0) 9320 8321
AECOM

BUILDING SERVICES CONSULTANT
LEVEL 2, 420 GEORGE ST
SYDNEY NSW 2000
TEL: +61 (0) 9634 0000
FAX: +61 (0) 8934 0001

ILLUMINATIONS INTERNATIONAL
LIGHTING DESIGN CONSULTANT
295 LAFFAYETTE STREET, SUITE 910
NEW YORK NY 10012
USA
TEL: +1 (212) 255-4463
FAX: +1 (212) 255-8546

RIIDER LEVETT BUTCHALL NSW PTY LTD
QUALITY SURVEYOR
41 MULHLEN STREET
NORTH SYDNEY NSW 2060
AUSTRALIA
TEL: +61 (0) 9922 2277
FAX: +61 (0) 9957 8197

MARSHALL DAY ACOUSTICS
ACOUSITCAL CONSULTANT
SUITE 101 6285 LAKEVIEW STREET
CHIPPENDALE NSW 2008
TEL: +61 (0) 9236 9422
FAX: +61 (0) 9281 3611

MORRIS CONSULTING ACCESSIBILITY CONSULTING
CONSULTANTS
STUDIO 106/106 BOWMAN STREET
PARRAMATTA NSW 2009
TEL: +61 (0) 9692 9322
FAX: +61 (0) 9692 9433

BLACKETT MAGUIRE + GOLDSMITH
COE CONSULTANT
SUITE 201 200 MOUNTAIN STREET
ULTIMO NSW 2007
TEL: +61 (0) 9211 7777
FAX: +61 (0) 9211 7774

NO.	ISSUE	DATE
	50% SCHEMATIC DESIGN	06 OCT 10
	SCHEMATIC DESIGN ISSUE	10 DEC 11
	PROGRESS ISSUE	11 JAN 11
	50% DESIGN DEVELOPMENT	08 APR 11
	DESIGN DEVELOPMENT ISSUE	01 JUL 11
01	CD PHASE PROGRESS ISSUE	02 SEP 11
02	CD PHASE PROGRESS ISSUE 02	21 OCT 11
03	CD PHASE PROGRESS ISSUE 03	09 DEC 11
04	ISSUE FOR TENDER	31 JAN 12
	— ALL INTERMEDIATE REVISIONS NOT USED—	
10	ISSUE FOR CONSTRUCTION	30 MAR 12
11	DR—001	30 MAY 12

PROJECT NAME
**JTS
DR CHAU CHAK WING
BUILDING**
SYDNEY, AUSTRALIA

DRAWING TITLE
**CITY CAMPUS HAYMARKET
DR CHAU CHAK WING BUILDING
LEVELS_04 ARCH PLAN**


CONSULTANTS DRAWING NAME
FOURTH FLOOR FURNITURE PLAN

CONSULTANTS DRAWING NUMBER				
A8-2.004				
PMO PROJECT NO.			CONSULTANT PROJECT NO.	
02106-09			2009-022	
DRAWN BY	CHECKED	APP. BY	DATE APP.	
YL	DB	DB	30 MAY 12	
DRAWING STATUS			SHEET SIZE	
IFC			A0	
UTS DRG FILE NAME			DRAWING SCALE	
CM1204AP			1:100	
UTS DRG FILE NO			REV. NO.	
26814			11	

Level 5 - changes to brick geometry



Level 6 - changes to brick geometry

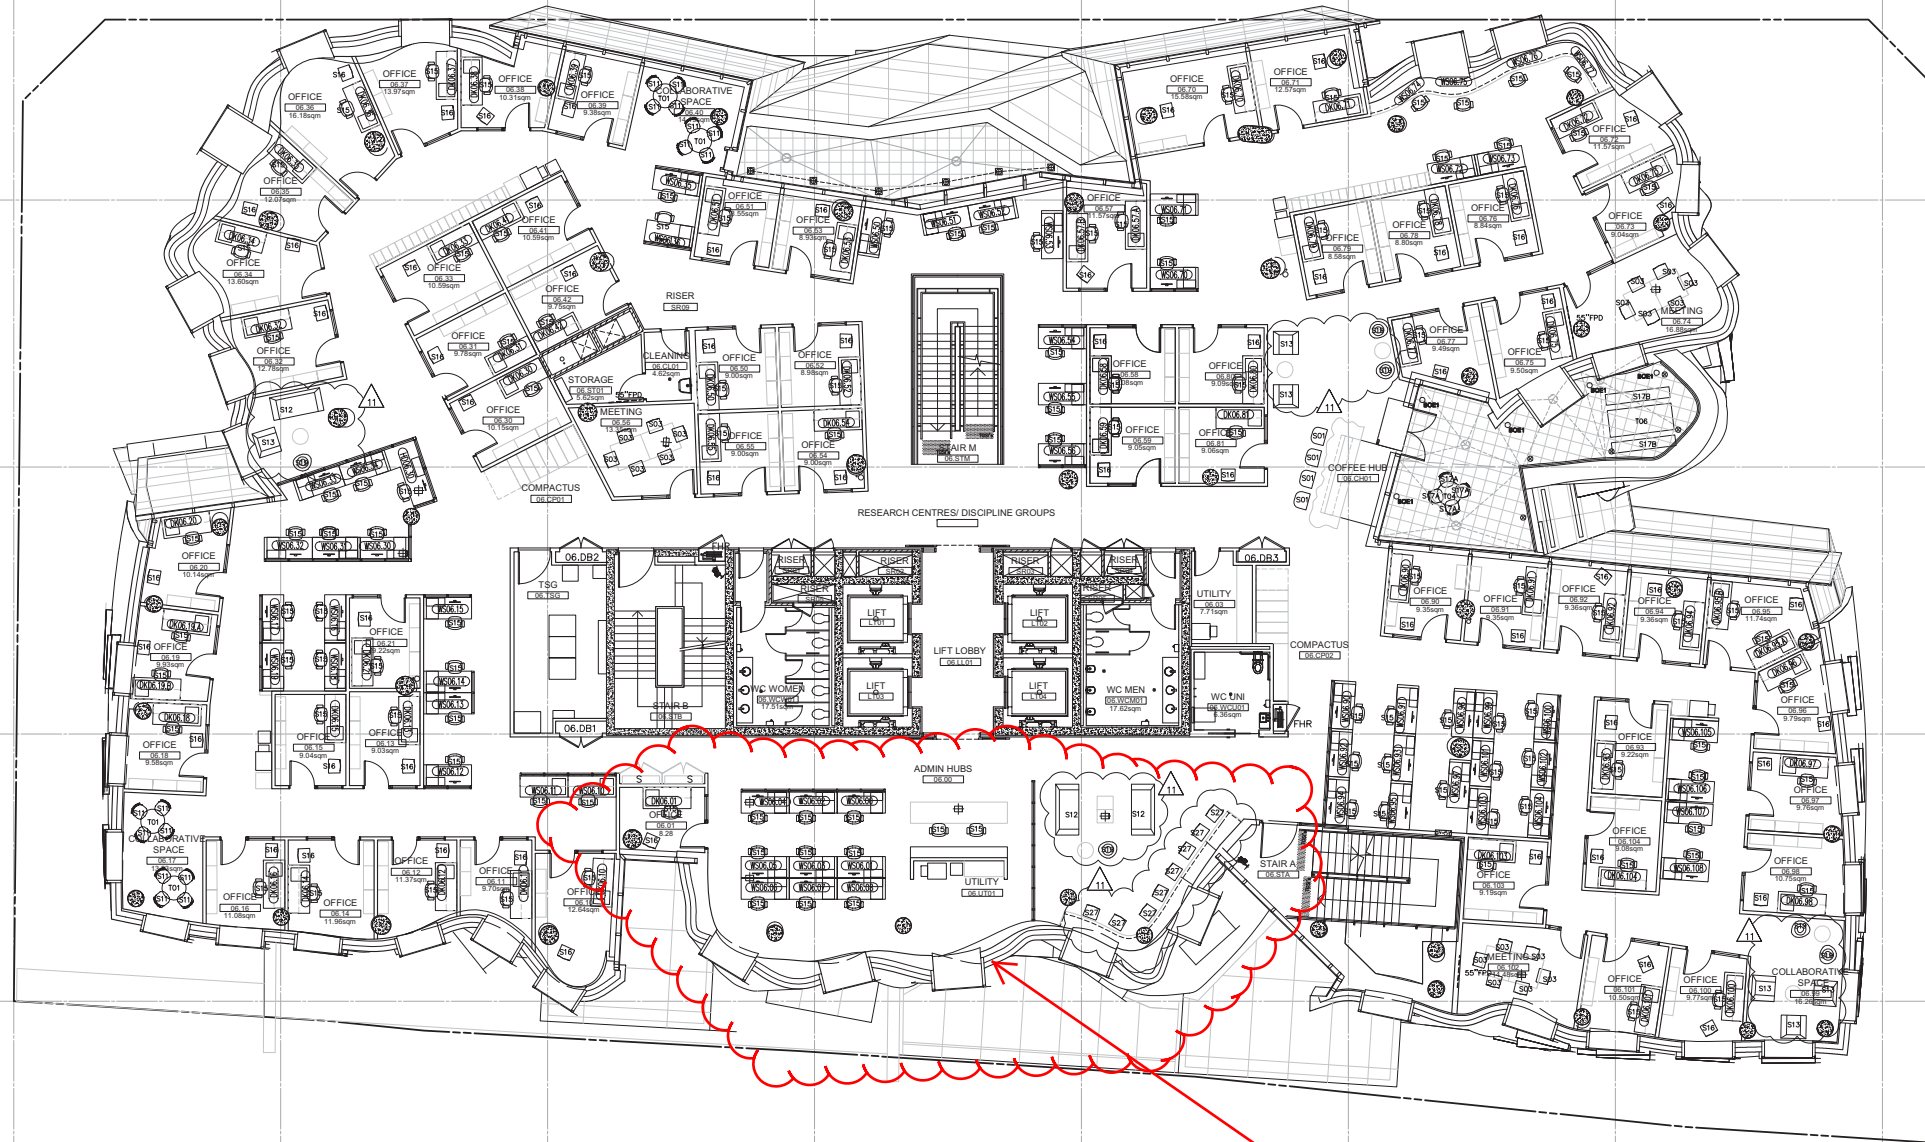

Brickwork geometry amended slightly.

© GEHRY PARTNERS, LLP

MP_09_0153-01-75w submission
Floor plan mark-ups

Level 7 - changes to brick geometry

Brickwork
geometry levelled
slightly.

Brickwork geometry
amended slightly.

GEHRY PARTNERS, LLP.

DESIGN ARCHITECT
12541 BEATRICE STREET
LOS ANGELES, CALIFORNIA 90066 USA
TEL: 310-482-3000
FAX: 310-482-3006
EXECUTIVE ARCHITECT
DARYL JACKSON ROBIN DYKE ARCHITECTS
64 ROSE STREET
CHIPPENDALE, NSW 2008
TEL: +61 (2) 9319 2955
NOMINATED ARCHITECT: ROBIN DYKE
NSW REG NO. 3739

UTS
University of Technology, Sydney
FACILITIES MANAGEMENT OPERATIONS
BUILDING 1, LEVEL 19, 15 BROADWAY
BROADWAY NSW 2007
Ph: 9514-2830 Fax: 9514-4690

HIGHGATE MANAGEMENT
PROJECT MANAGERS
LOW/10 LOTUS STREET
CAMPERDOWN, NSW 2050
TEL: +61 (2) 9377 1051
FAX: +61 (2) 9377 1080
ARUP
STRUCTURAL CONSULTANT
201 KENT STREET
SYDNEY, NSW 2000
TEL: +61 (2) 9330 9320
FAX: +61 (2) 9320 9321
AECOM
BUILDING SERVICES CONSULTANT
LEVEL 21, 420 GEORGE ST
SYDNEY, NSW 2000
TEL: +61 (2) 8934 0000
FAX: +61 (2) 8934 0001
L'OBSERVATOIRE INTERNATIONAL
LIGHTING DESIGN CONSULTANT
295 LAFAYETTE STREET, SUITE 915
NEW YORK NY 10012
USA
TEL: +1 (212) 255 4463
FAX: +1 (212) 255 8346
RIDER LEVETT BUCKNALL NSW PTY LTD
QUANTITY SURVEYOR
41 MCILHIN STREET
NORTH SYDNEY, NSW 2060
AUSTRALIA
TEL: +61 (2) 9922 2277
FAX: +61 (2) 9957 4197
MARSHALL DAY ACOUSTICS
ACOUSTICAL CONSULTANT
SUITE 46 BALFOUR STREET
CHIPPENDALE NSW 2008
TEL: +61 (2) 9282 9422
FAX: +61 (2) 9281 3611
MORRIS GODDING ACCESSIBILITY CONSULTING
ACCESSIBILITY CONSULTANT
STUDIO 106/106 BORMAN STREET
PYRMONT NSW 2009
TEL: +61 (2) 9492 9322
FAX: +61 (2) 9692 8433
BLACKETT MAGUIRE + GOLDSMITH
CODE CONSULTANT
SUITE 2.01, 22-36 MOUNTAIN STREET
ULTIMO NSW 2007
TEL: +61 (2) 9211 7777
FAX: +61 (2) 9211 7774

NO.	ISSUE	DATE
1	50% SCHEMATIC DESIGN	06 OCT 10
2	SCHEMATIC DESIGN ISSUE	10 DEC 10
3	PROGRESS ISSUE	11 JAN 11
4	50% DESIGN DEVELOPMENT	08 APR 11
5	DESIGN DEVELOPMENT ISSUE	01 JUL 11
6	01 CD PHASE PROGRESS ISSUE	02 SEP 11
7	02 CD PHASE PROGRESS ISSUE 02	21 OCT 11
8	03 CD PHASE PROGRESS ISSUE 03	09 DEC 11
9	04 ISSUE FOR TENDER	31 JAN 12
10	- ALL INTERMEDIATE REVISIONS NOT USED -	
11	10 ISSUE FOR CONSTRUCTION	30 MAR 12
12	11 DR-001	30 MAY 12

PROJECT NAME
UTS
DR CHAU CHAK WING
BUILDING
SYDNEY, AUSTRALIA
DRAWING TITLE
CITY CAMPUS HAYMARKET
DR CHAU CHAK WING BUILDING
LEVELS_07 ARCH PLAN

CONSULTANTS DRAWING NUMBER
FURNITURE PLAN SEVENTH FLOOR

CONSULTANTS DRAWING NUMBER A8-2.07			
FMO PROJECT NUMBER 02106-09		CONSULTANT PROJECT NO. 2009-022	
DRAWN BY YL	CHECKED DB	APP. BY DB	DATE APP. 30 MAY 12
DRAWING STATUS IFC		SHEET SIZE A0	
UTS DRG FILE NAME CM1207AP		DRAWING SCALE 1:100	
UTS DRG FILE NO. 26817		REV NO. 11	

© GEHRY PARTNERS, LLP

Level 8 - changes to fly-bys and brick geometry

Fly-by reduced

Brickwork
geometry slightly
altered

DEEHY PARTNERS, LLP.
DESIGN ARCHITECT
12541 BEATRICE STREET
LOS ANGELES, CALIFORNIA 90066 USA
TEL +1 310 482-3000
FAX +1 310 482-3006
DARYL JACKSON ROBYN DYKE ARCHITECTS
EXECUTIVE OFFICE
64 ROSE STREET
CHIPPENDALE NSW 2008
TEL +61 (0) 9319 2955
FAX +61 (0) 9319 2955
ROBYN DYKE ARCHITECT: ROBYN DYKE
NSW REG NO. 3739

TS

University of Technology, Sydney
FACILITIES MANAGEMENT OPERATIONS
BUILDING 1, LEVEL 19, 15 BROADWAY
Broadway NSW 2000
Ph: 9514-2830 Fax: 9514-4690

HIGHGATE MANAGEMENT
PROJECT MANAGERS
LOWY LOFTUS STREET
CAMPERDOWN NSW 2050
TEL +61 (0) 9377 1051
FAX +61 (0) 9377 1080
STRUCTURAL CONSULTANT
201 HENT STREET
SYDNEY NSW 2000
TEL +61 (0) 9320 9320
FAX +61 (0) 9320 9321
AECOM
BUILDING SERVICES CONSULTANT
LEVEL 2, 420 GEORGE ST
SYDNEY NSW 2000
TEL +61 (0) 8934 0000
FAX +61 (0) 8934 0001
L'ESPACE/ETERN INTERNATIONAL
LIGHTING DESIGN CONSULTANT
55 LAFFRANQUE STREET, SUITE 915
NEW YORK NY 10012
TEL +1 (212) 255 4463
FAX +1 (212) 255 8366
RIDER LEVY BUCKNALL NSW PTY LTD
QUALITY SURVEYOR
41 MCILHEN STREET
NORTH SYDNEY NSW 2060
AUSTRALIA
TEL +61 (0) 9922 2277
FAX +61 (0) 9927 4197
MARSHALL DAY ACOUSTICS
ACOUSTICAL CONSULTANT
SUITE 66 BALFOUR STREET
CHIPPENDALE NSW 2008
TEL +61 (0) 9262 9422
FAX +61 (0) 9281 3611
MORRIS CONSULTING ACCESSIBILITY CONSULTING
CONSULTANT
STUDIO 106/56 BOWMAN STREET
PIMBORO NSW 2009
TEL +61 (0) 9692 9322
FAX +61 (0) 9692 9433
BLACKETT MCGILVER + GOLDSMITH
DESIGN CONSULTANT
SUITE 101/100 MOUNTAIN STREET
ULTIMO NSW 2007
TEL +61 (0) 9211 7771
FAX +61 (0) 9211 7774

NO.	ISSUE	DATE
	50% SCHEMATIC DESIGN	06 OCT 10
	SCHEMATIC DESIGN ISSUE	10 DEC 10
	PROGRESS ISSUE	11 JAN 11
	50% DESIGN DEVELOPMENT	08 APR 11
	DESIGN DEVELOPMENT ISSUE	01 JUL 11
01	CD PHASE PROGRESS ISSUE	02 SEP 11
02	CD PHASE PROGRESS ISSUE 02	21 OCT 11
03	CD PHASE PROGRESS ISSUE 03	09 DEC 11
04	ISSUE FOR TENDER	31 JAN 12
	— ALL INTERMEDIATE REVISIONS NOT USED—	
10	ISSUE FOR CONSTRUCTION	30 MAR 12
11	DR—001	30 MAY 12

PROJECT NAME
JTS
DR CHAU CHAK WING
BUILDING
SYDNEY, AUSTRALIA

DRAWING TITLE
CITY CAMPUS HAYMARKET
DR CHAU CHAK WING BUILDING
LEVELS_08 ARCH PLAN

CONSULTANTS DRAWING NAME
FURNITURE PLAN EIGHTH FLOOR

CONSULTANTS DRAWING NUMBER				
A8-2.08				
FMO PROJECT NUMBER			CONSULTANT PROJECT NO.	
02106-09			2009-022	
DRAWN BY	CHECKED	APP. BY	DATE APP.	
YL	DB	DB	30 MAY 12	
DRAWING STATUS			SHEET SIZE	
IFC			A0	
UTS DRG FILE NAME			DRAWING SCALE	
CM1208AP			1:100	
UTS DRG FILE NO			REV. NO.	
26818			11	

Level 9 - changes to fly-bys

Fly by reduced

Fly by reduced

DEHRY PARTNERS, LLP.
DESIGN ARCHITECT
12541 BEATRICE STREET
LOS ANGELES, CALIFORNIA 90066 USA
TEL: 310-462-3000
FAX: 310-462-3006
DARYL JACKSON ROBIN DYKE ARCHITECTS
EXECUTIVE ARCHITECTS
64 ROSE STREET
CHIPPENDALE NSW 2008
TEL: +61 (0) 2 9319 2955
NOMINEE ARCHITECT: ROBIN DYKE
NSW REG NO. 3739

UNITED STATES

University of Technology, Sydney
FACILITIES MANAGEMENT OPERATIONS
BUILDING 1, LEVEL 19, 15 BROADWAY
Broadway NSW 2000
Ph: 9514-2830 Fax: 9514-4690

HIGHCAMP MANAGEMENT
PROJECT MANAGERS
LOW 10 LOTFUS STREET
CAMPERDOWN NSW 2050
TEL: +61 (0) 2 9377 1051
FAX: +61 (0) 2 9377 1080
STRUCTURAL
201 KENT STREET
SYDNEY NSW 2000
TEL: +61 (0) 2 9320 9320
FAX: +61 (0) 2 9320 9321
AECOM
BUILDING SERVICES CONSULTANT
LEVEL 2, 420 GEORGE ST
SYDNEY NSW 2000
TEL: +61 (0) 2 8534 0000
FAX: +61 (0) 2 9534 0000
L'OBSEVATORE INTERNATIONAL
LIGHTING DESIGN CONSULTANT
SUITE LAFFAYETTE STREET, SUITE 915
NEW YORK NY 10012
TEL: +1 (212) 255 4463
FAX: +1 (212) 255 8546
RIDER LEVY BUCKNALL NSW PTY LTD
QUALITY SURVEYOR
41 MCILHEN STREET
NORTH SYDNEY NSW 2060
AUSTRALIA
TEL: +61 (0) 2 9522 2277
FAX: +61 (0) 2 9057 4197
MARSHALL DAY ACOUSTICS
CHIPPENDALE NSW 2008
TEL: +61 (0) 2 9582 9422
FAX: +61 (0) 2 9281 3611
MORRIS GOODRICH ACCESSIBILITY CONSULTING
ACCESSIBILITY CONSULTANT
STUDIO 106/106 BOWMAN STREET
PARRAMATTA NSW 2009
TEL: +61 (0) 2 9692 9522
FAX: +61 (0) 2 9692 9453
BLACKETT MCGILVER + GOLDSMITH
COST CONSULTANT
SUITE 22-36 MOUNTAIN STREET
ULTIMO NSW 2007
TEL: +61 (0) 2 9211 7771
FAX: +61 (0) 2 9211 7774

NO.	ISSUE	DATE
	50% SCHEMATIC DESIGN	06 OCT 10
	SCHEMATIC DESIGN ISSUE	10 DEC 10
	PROGRESS ISSUE	11 JAN 11
	50% DESIGN DEVELOPMENT	08 APR 11
	DESIGN DEVELOPMENT ISSUE	01 JUL 11
01	CD PHASE PROGRESS ISSUE	02 SEP 11
02	CD PHASE PROGRESS ISSUE 02	21 OCT 11
03	CD PHASE PROGRESS ISSUE 03	09 DEC 11
04	ISSUE FOR TENDER	31 JAN 12
	— ALL INTERMEDIATE REVISIONS NOT USED —	
10	ISSUE FOR CONSTRUCTION	30 MAR 12
11	DR—001	30 MAY 12

PROJECT NAME
JTS
OR CHAU CHAK WING
BUILDING
SYDNEY, AUSTRALIA

DRAWING TITLE
CITY CAMPUS HAYMARKET
OR CHAU CHAK WING BUILDING
LEVELS_09 ARCH PLAN

CONSULTANTS DRAWING NAME
FURNITURE PLAN NINTH FLOOR

CONSULTANTS DRAWING NUMBER				
A8-2.09				
PMO PROJECT NUMBER			CONSULTANT PROJECT NO.	
02106-09			2009-022	
DRAWN BY	CHECKED	APP. BY	DATE APP.	
YL	DB	DB	30 MAY 12	
DRAWING STATUS			SHEET SIZE	
IFC			A0	
UTS DRO FILE NAME			DRAWING SCALE	
CM1209AP			1:100	
UTS DRO FILE NO			REV NO.	
26819			11	

Level 10 - changes to fly bys and brick geometry

Fly by reduced

Brickwork
geometry levelled
slightly

[illegible]

PROJECT NAME

UTS
DR CHAU CHAK WING
BUILDING

SYDNEY, AUSTRALIA

DRAWING TITLE

CITY CAMPUS HAYMARKET
DR CHAU CHAK WING BUILDING
LEVELS_10 ARCH PLAN

CONSULTANTS DRAWING NAME

FURNITURE PLAN TENTH FLOOR

CONSULTANTS DRAWING NUMBER
A8-2.10

PMO PROJECT NUMBER 02106-09		CONSULTANT PROJECT NO. 2009-022	
DRAWN BY YL	CHECKED DB	APP. BY DB	DATE APP. 30 MAY 12
DRAWING STATUS IFC			SHEET SIZE A0
UTS DRG FILE NAME CM1210AP			DRAWING SCALE 1:100
UTS DRG FILE NO 26820			REV. NO. 11

Level 11 - changes to fly bys and brick geometry

HIGHGATE MANAGEMENT
PROJECT MANAGERS
LOW LO LOFTUS STREET
CAMPERDOWN, NSW 2050
TEL +61 (0) 8377 1050
FAX +61 (0) 8377 1050
TEL +61 (0) 8377 1080

201 KENT
STRUCTURAL CONSULTANT
201 KENT STREET
SYDNEY, NSW 2000
TEL +61 (2) 9320 9320
TEL +61 (2) 9320 9321
TEL +61 (2) 9320 9321

2525
JESCON
BUILDING SERVICES CONSULTANT
LEVEL 4, 480 GEORGE ST
SYDNEY, NSW 2000
TEL +61 (2) 9834 0000
FAX +61 (2) 9834 0001

2525
THE OBSCURA COMPANY
LEVEL 4, 480 GEORGE ST
SYDNEY, NSW 2000
TEL +61 (2) 9834 0000
FAX +61 (2) 9834 0001

2525
LIGHTING DESIGN CONSULTANT
2525 LAURENCE STREET, SUITE 915
NEW YORK CITY NY 10012
USA
TEL +1 (212) 255 4463
TEL +1 (212) 255 4546

2525
RIDER LEVETT BUCKNALL NSW PTY LTD
QUADRANT OFFICE
41 McLaren Street
NORTH SYDNEY, NSW 2060
AUSTRALIA
TEL +61 (2) 9922 2277
TEL +61 (2) 9927 4197

2525
MARSHALL DAY ACOUSTICS
ACOUSTICAL CONSULTANT
SUITE 4, 46 BALFOUR STREET
CHIPPENDALE, NSW 2008
TEL +61 (2) 9922 9442
TEL +61 (2) 9281 3611

2525
MCKENZIE CODDING A/C ACCESSIBILITY CONSULTING
ACCESSIBILITY CONSULTANT
STUDIO 106/106 BOWMAN STREET
PARRAMATTA, NSW 2150
TEL +61 (2) 9692 9322
TEL +61 (2) 9602 9433

2525
BLACKETT MAGUIRE + GOLDSMITH
COE CONSULTANT
SUITE 102/122-126 MOUNTAIN STREET
ULTIMO NSW 2007
TEL +61 (2) 9211 7771
TEL +61 (2) 9211 7774

NO.	ISSUE	DATE
	50% SCHEMATIC DESIGN	06 OCT 10
	SCHEMATIC DESIGN ISSUE	10 DEC 10
	PROGRESS ISSUE	11 JAN 11
	50% DESIGN DEVELOPMENT	08 APR 11
	DESIGN DEVELOPMENT ISSUE	01 JUL 11
01	CD PHASE PROGRESS ISSUE	02 SEP 11
02	CD PHASE PROGRESS ISSUE 02	21 OCT 11
03	CD PHASE PROGRESS ISSUE 03	09 DEC 11
04	ISSUE FOR TENDER	31 JAN 12
	ALL INTERMEDIATE REVISIONS NOT USED	
10	ISSUE FOR CONSTRUCTION	30 MAR 12
11	DR-001	30 MAY 12

PROJECT NAME
**JTS
DR CHAU CHAK WING
BUILDING**
SYDNEY, AUSTRALIA

DRAWING TITLE
**CITY CAMPUS HAYMARKET
DR CHAU CHAK WING BUILDING
LEVELS_10 ARCH PLAN**

CONSULTANTS DRAWING NAME
**FURNITURE PLAN
ELEVENTH FLOOR**

CONSULTANTS DRAWING NUMBER				
A8-2.11				
PMO PROJECT NUMBER			CONSULTANT PROJECT NO.	
02106-09			2009-022	
DRAWN BY	CHECKED	APP. BY	DATE APP.	
YL	DB	DB	30 MAY 12	
DRAWING STATUS			SHEET SIZE	
IFC			A0	
UTS DRG FILE NAME			DRAWING SCALE	
CM1210AP			1:100	
UTS DRG FILE NO			REV NO.	
26821			11	

Level 12 - changes to fly bys